
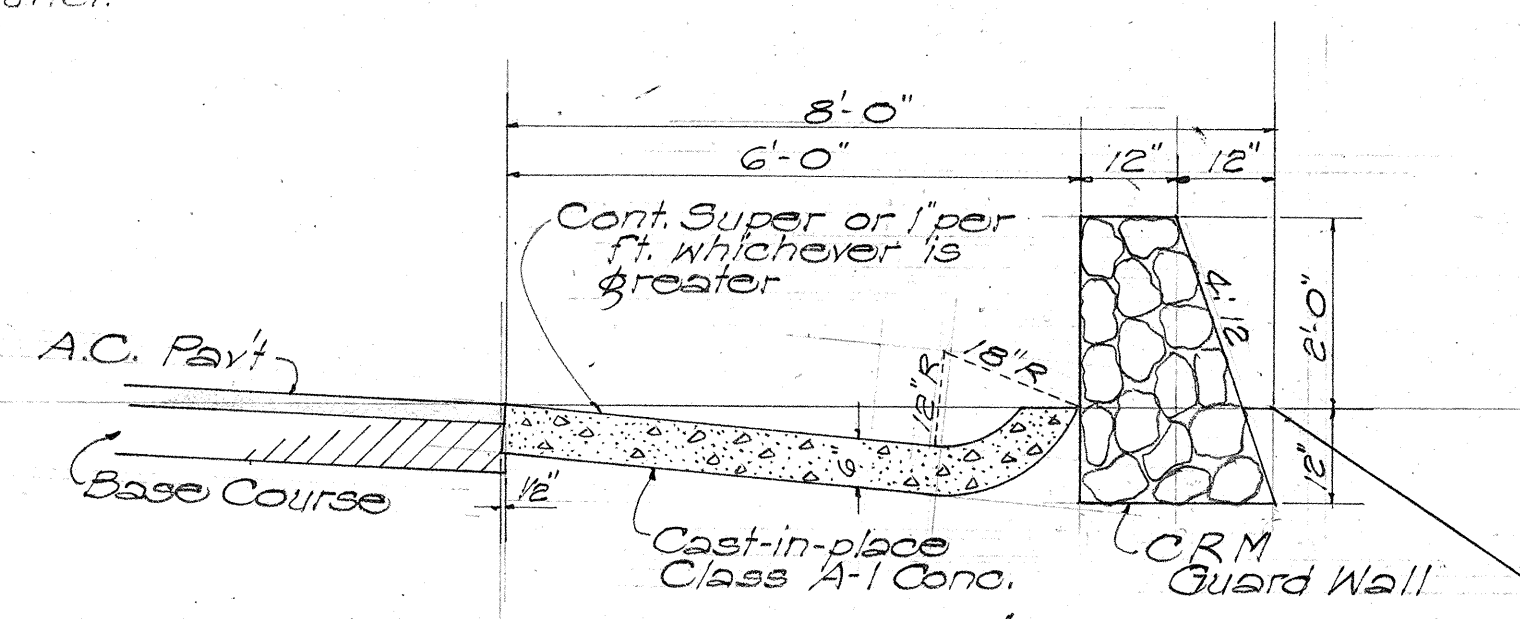
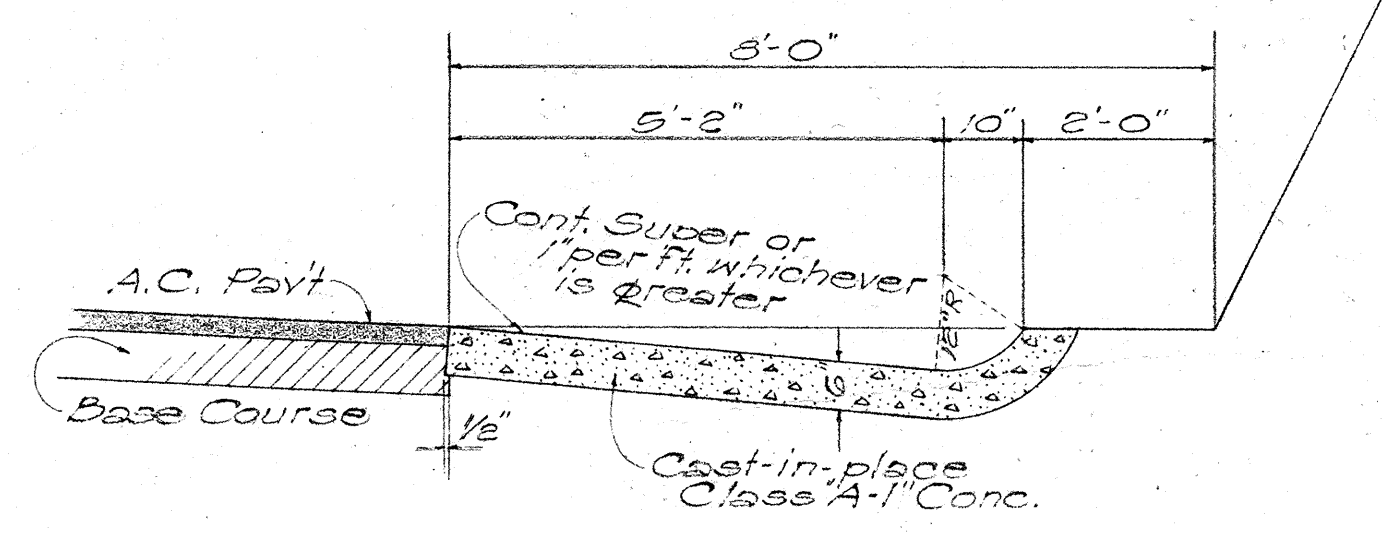
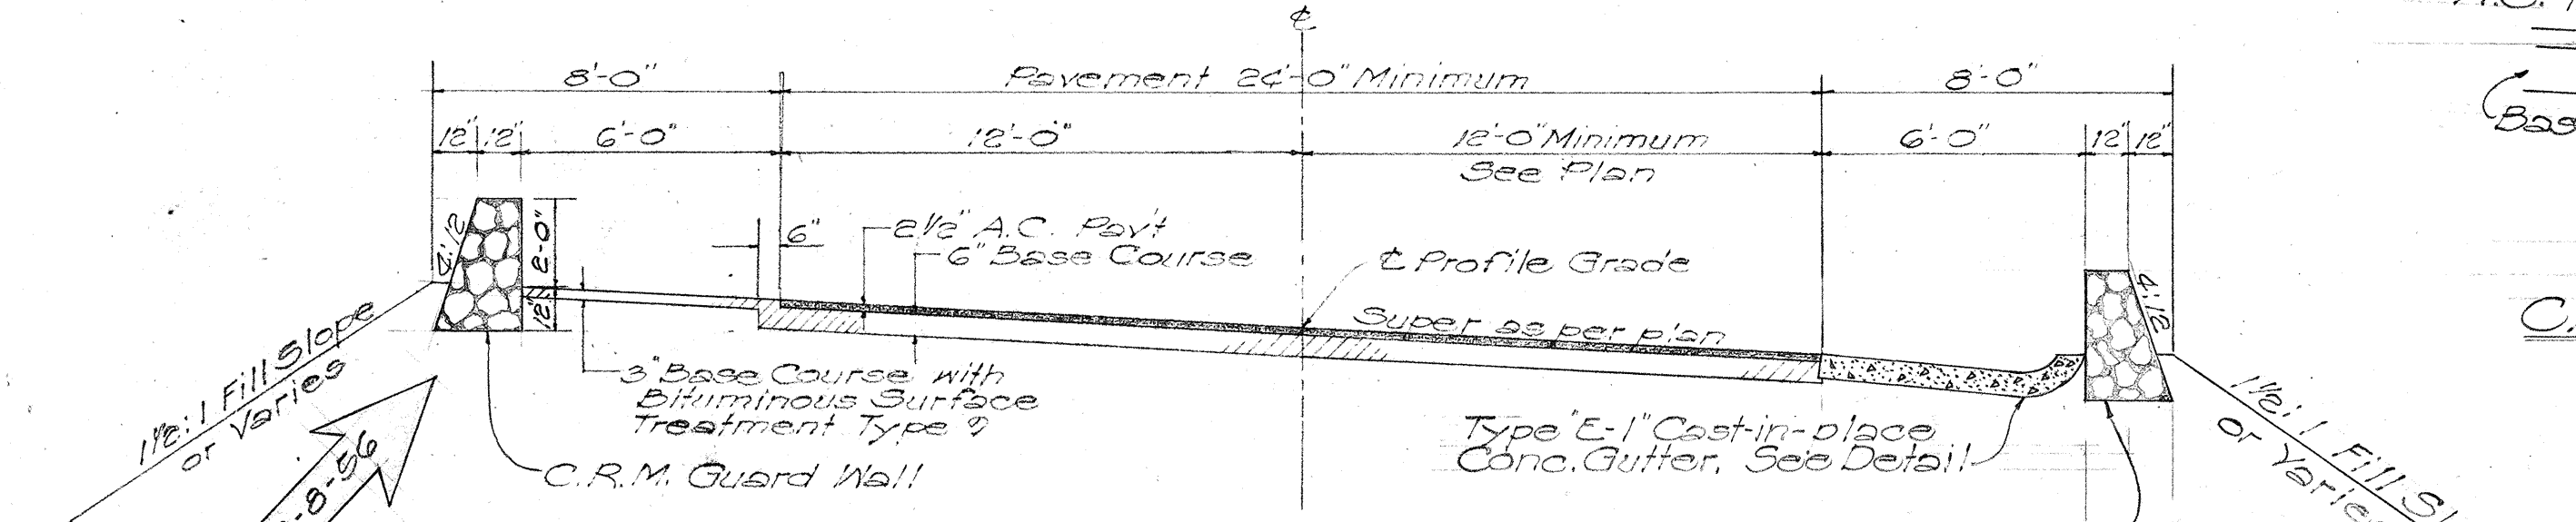
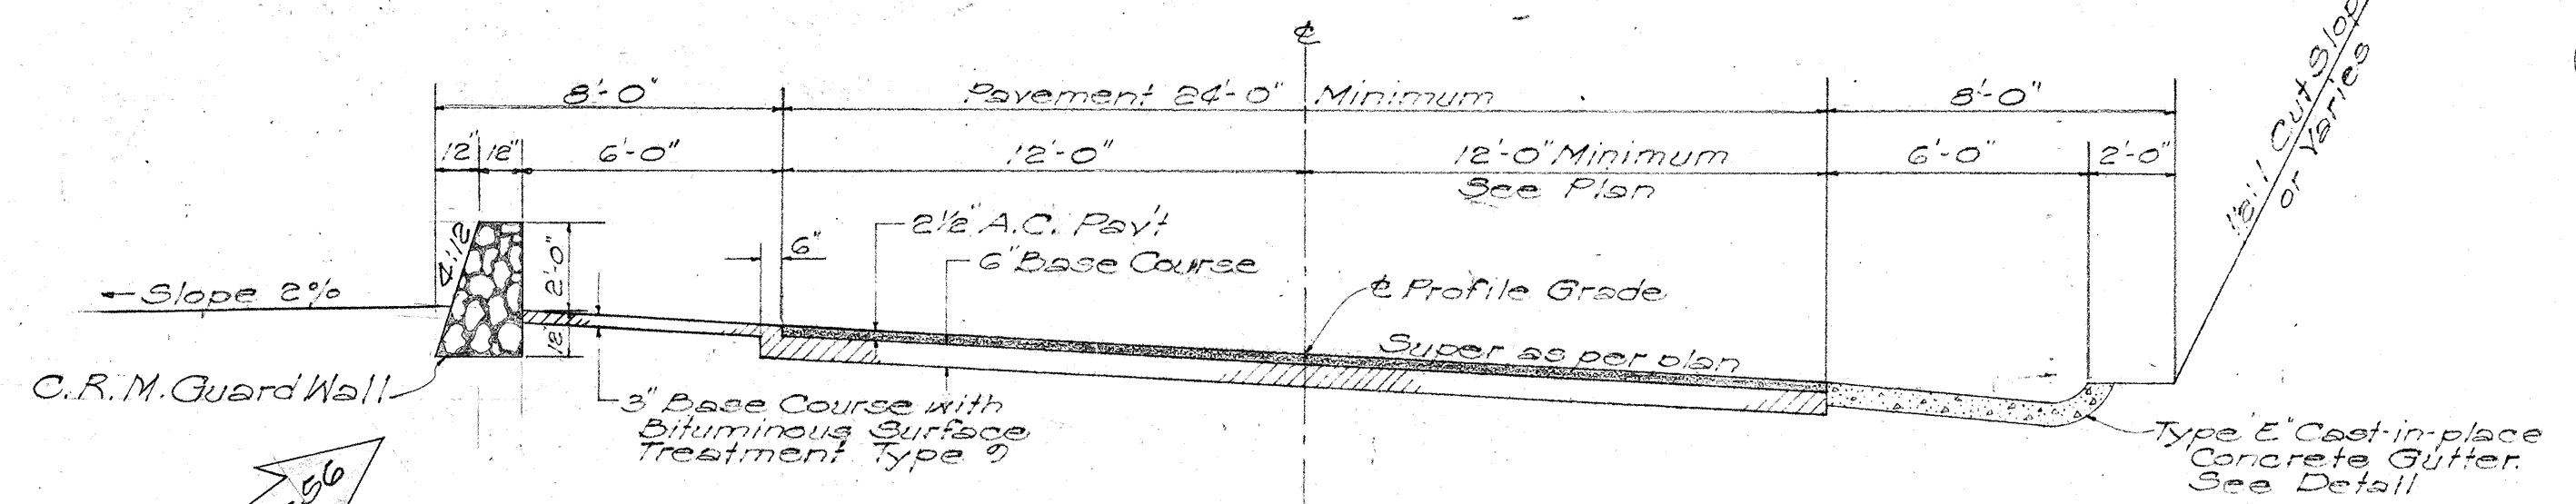
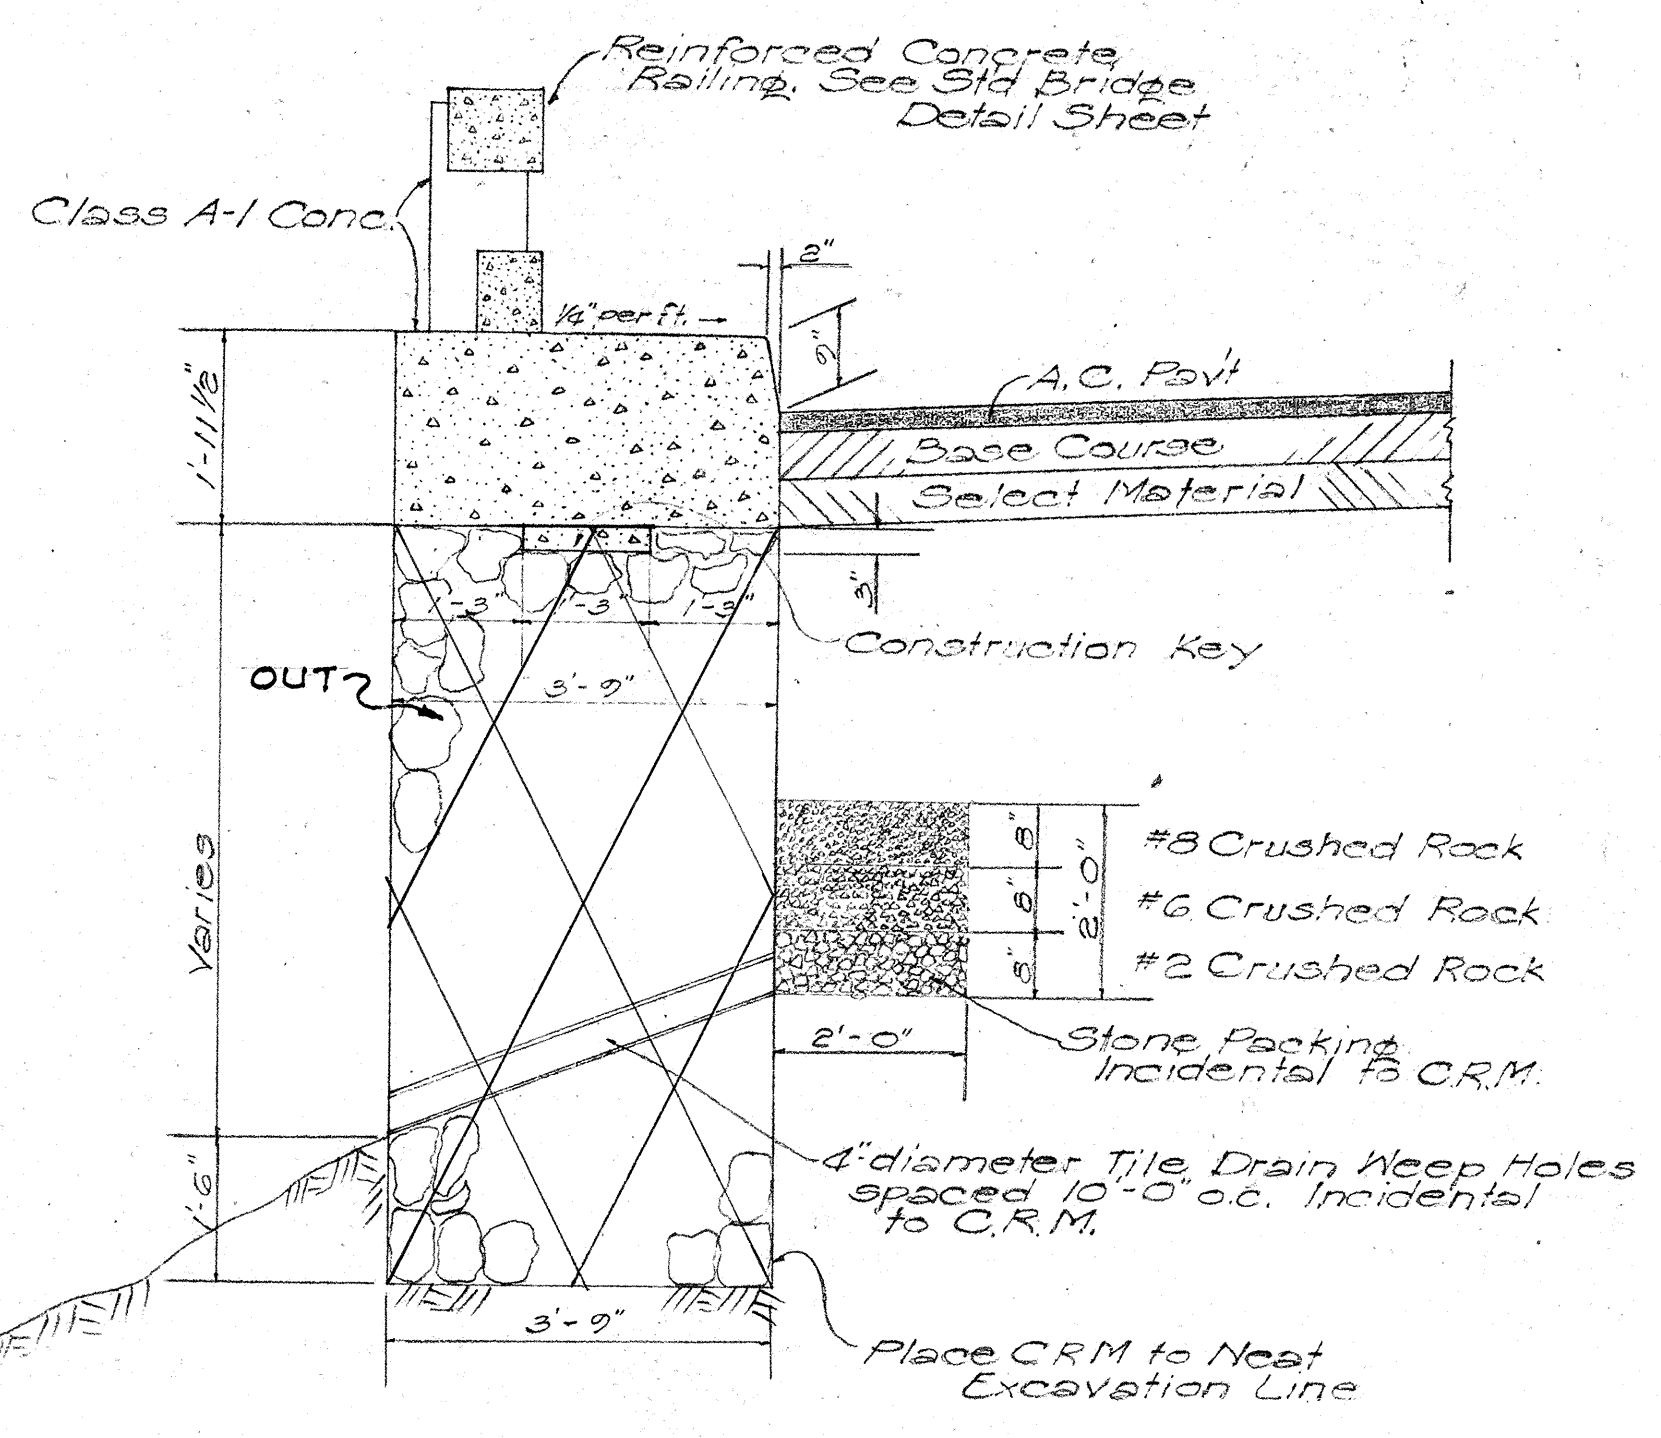





FED. ROAD DIST. NO.	STATE	FED. AID PROJ. NO.	FISCAL YEAR	SHEET NO.	TOTAL SHEETS
HAWAII	HAW	5-0610(1)	1955	3	54

NOTE:
For Highway Lighting Details
See Sheet 5752.8 and 8A


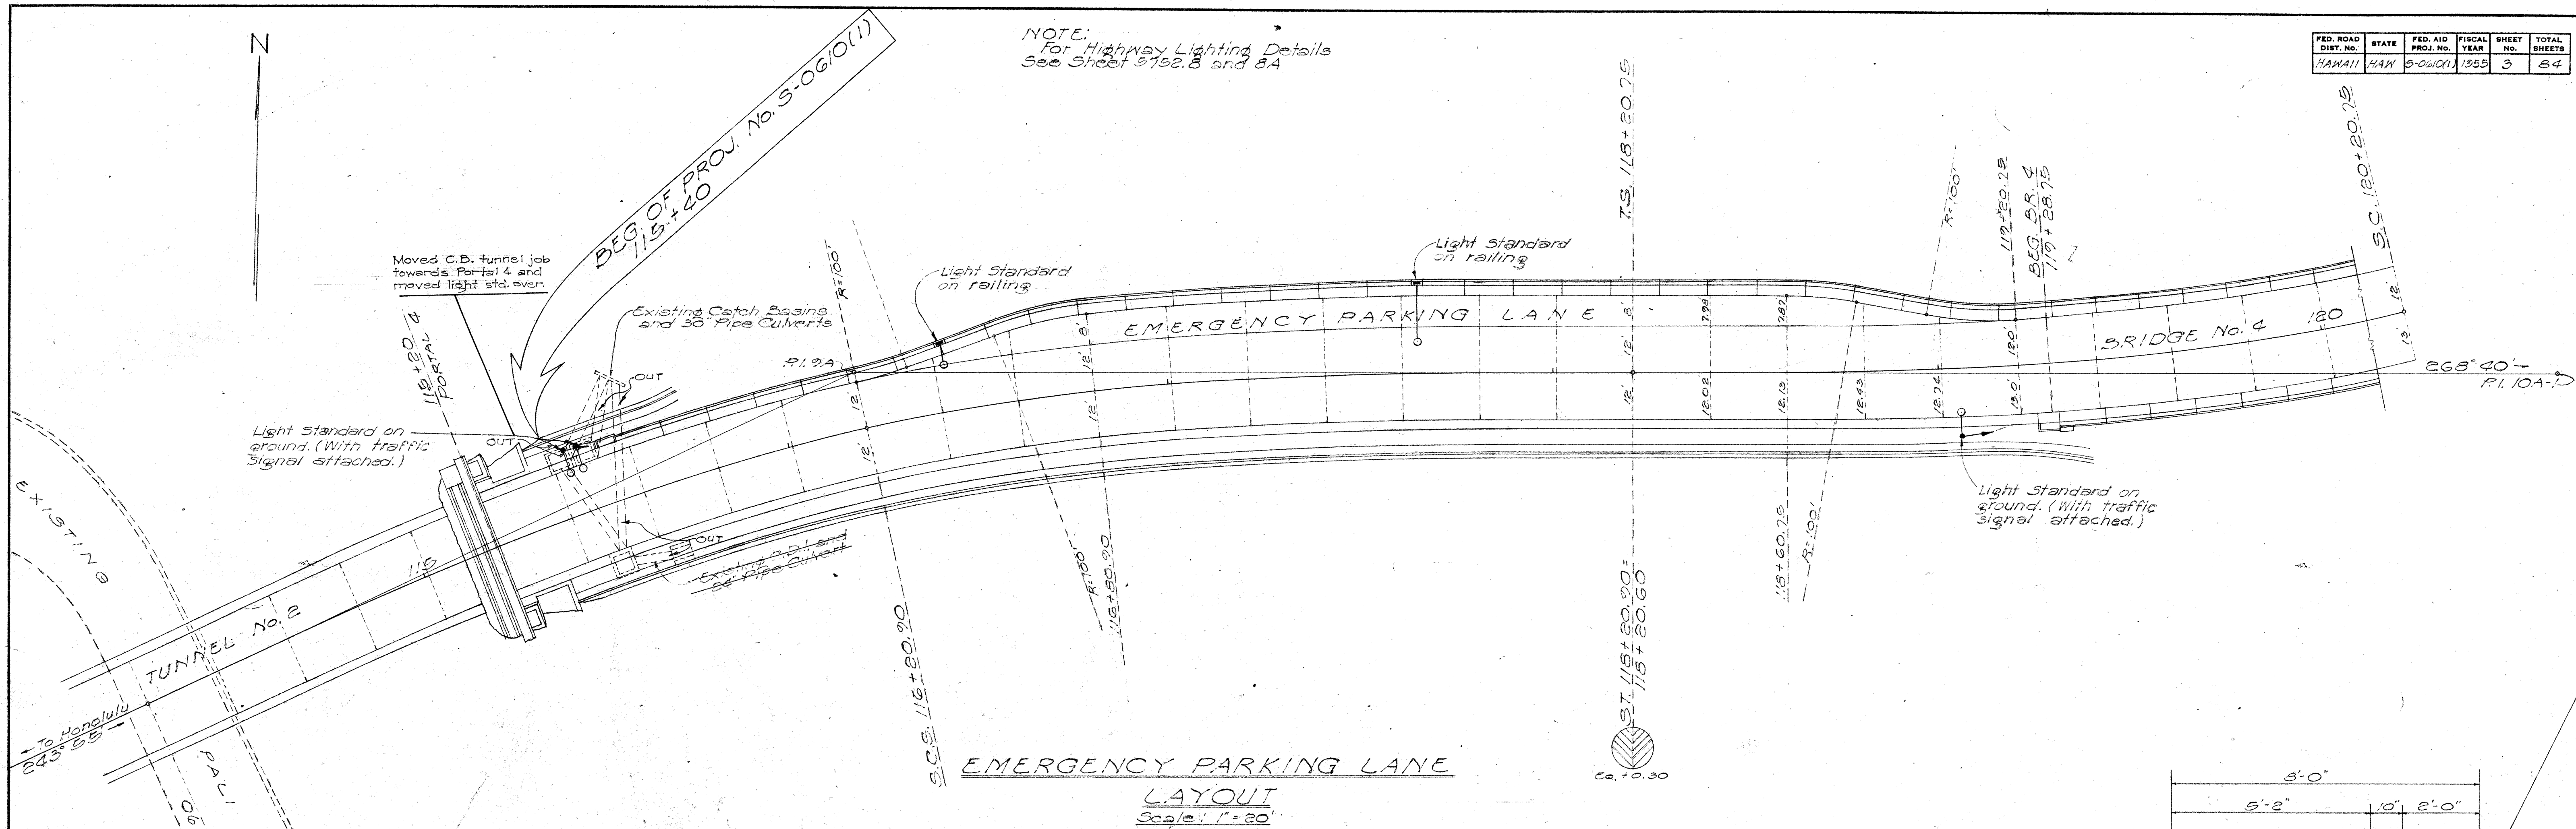


TERRITORIAL HIGHWAY DEPARTMENT
TERRITORY OF HAWAII
EMERGENCY PARKING LANE LAYOUT
C.R.M. RETAINING WALL DETAIL
TYPICAL SECTION FOR CONNECTION
DETAIL OF TYPE 'E' CONC. GUTTER
PALI ROAD
PROJ. No. 5-0610(1)
Scales: As noted May 18, 1955



SURVEY PLOTTED BY	DATE
DESIGNED BY	5-1-55
DRAWN BY	5-1-55
TRACED BY	5-1-55
QUANTITIES CHECKED BY	5-1-55
NOTE BOOK	
No.	

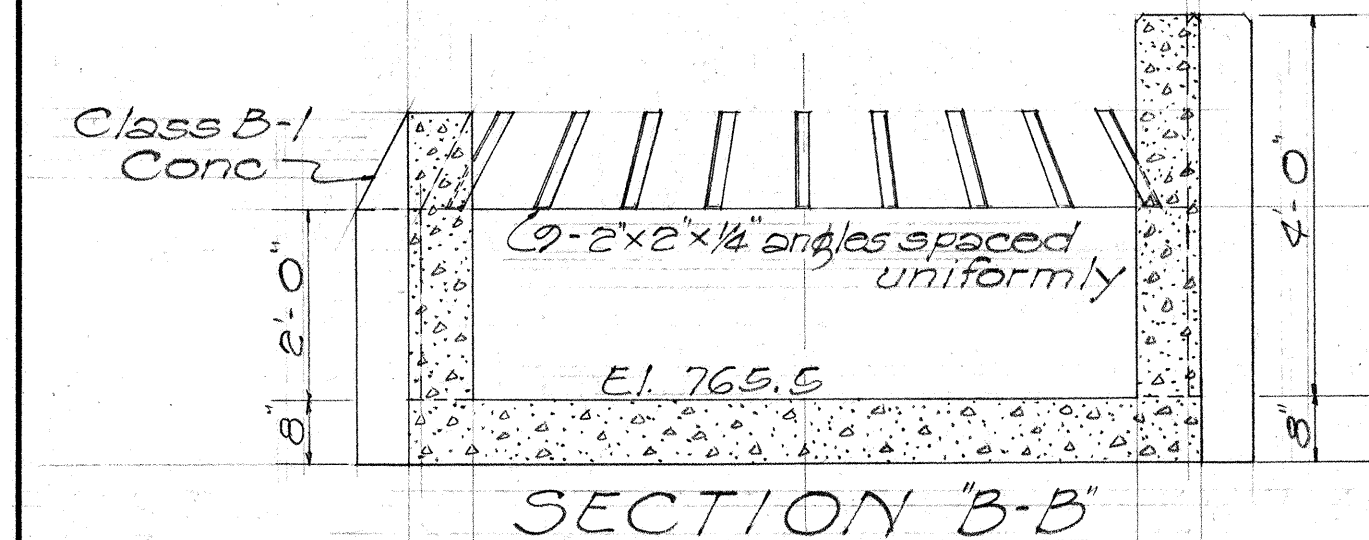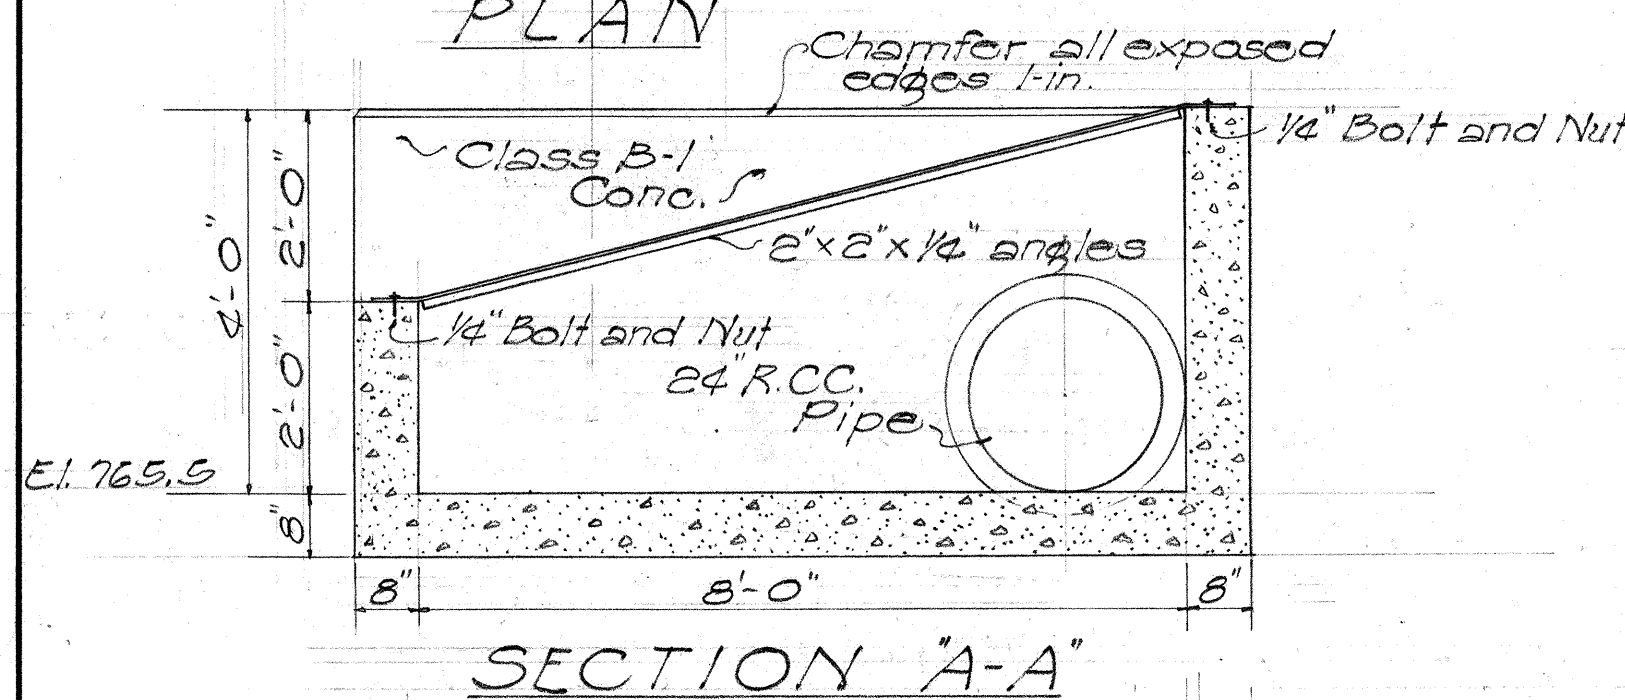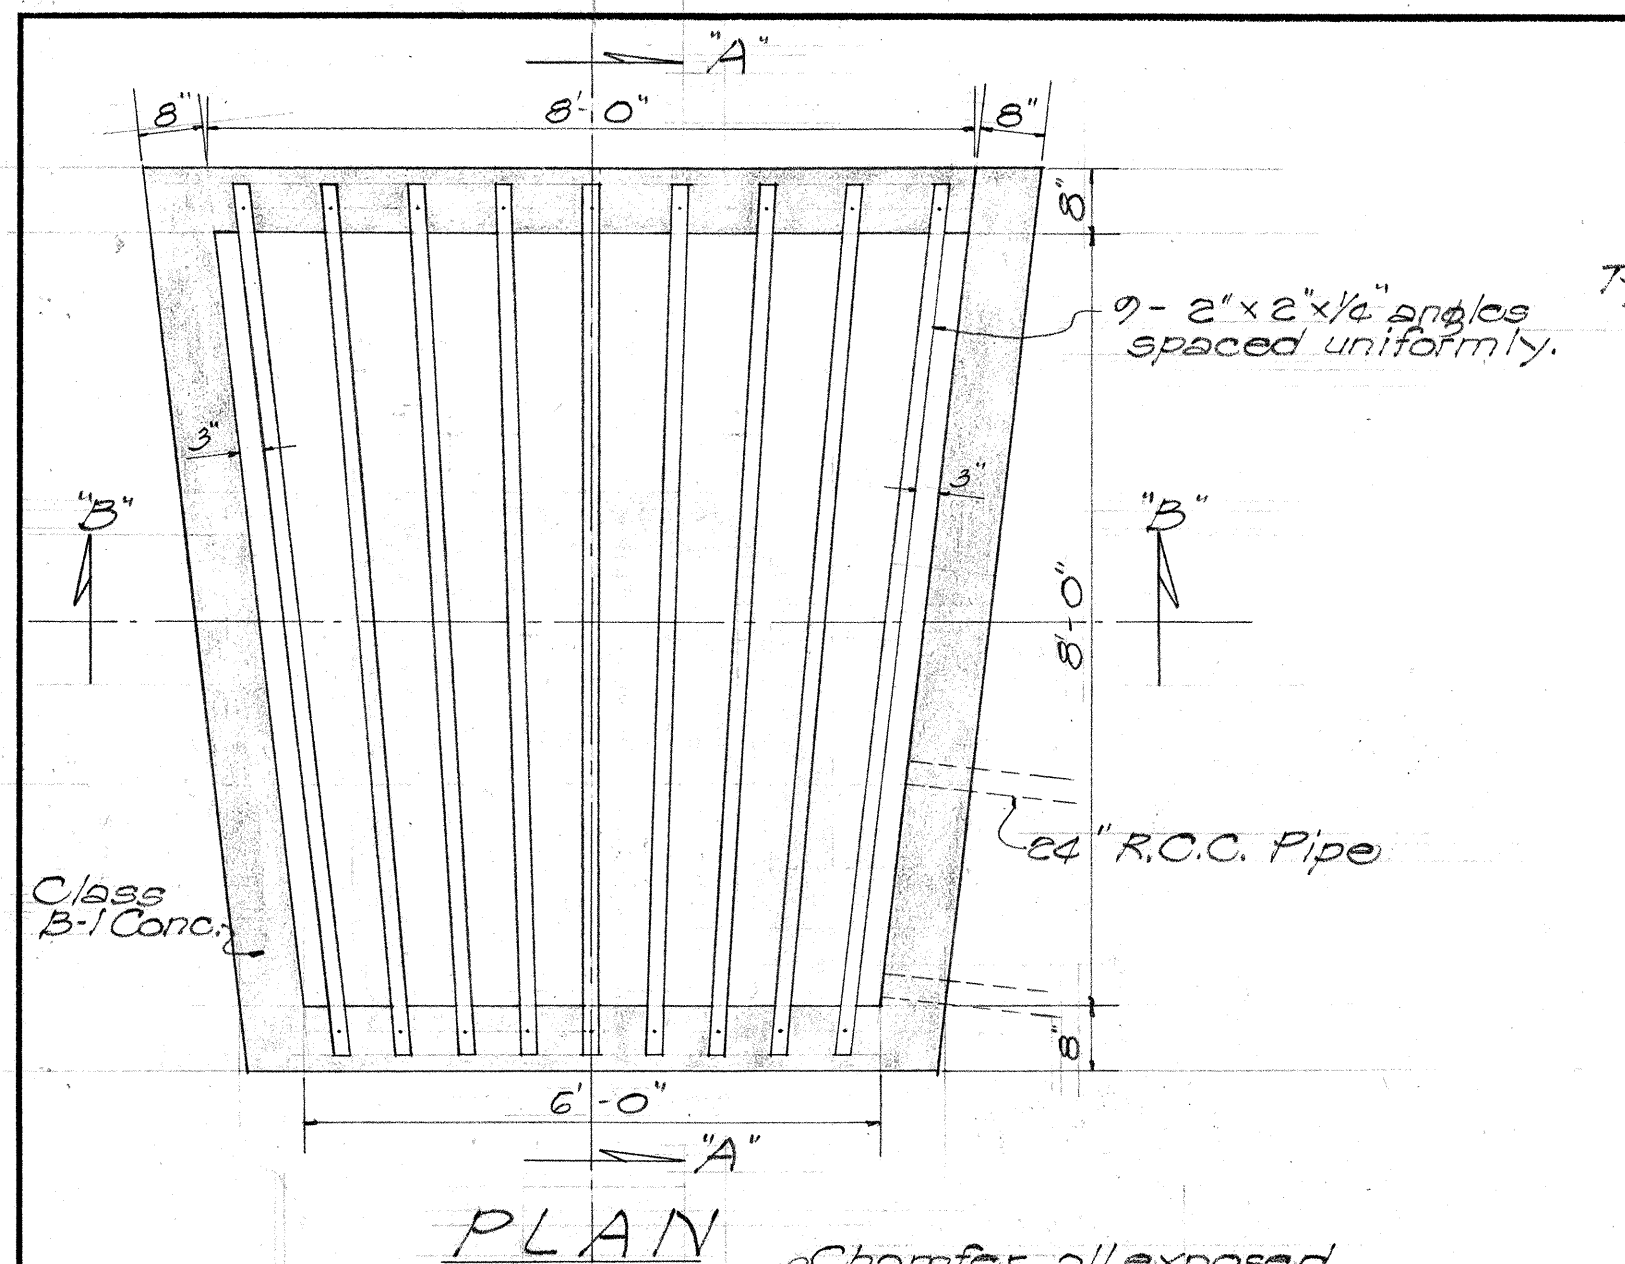

DETAIL OF SPECIAL CONC. DROP INTAKE
Scale: 1/2" = 1'-0"

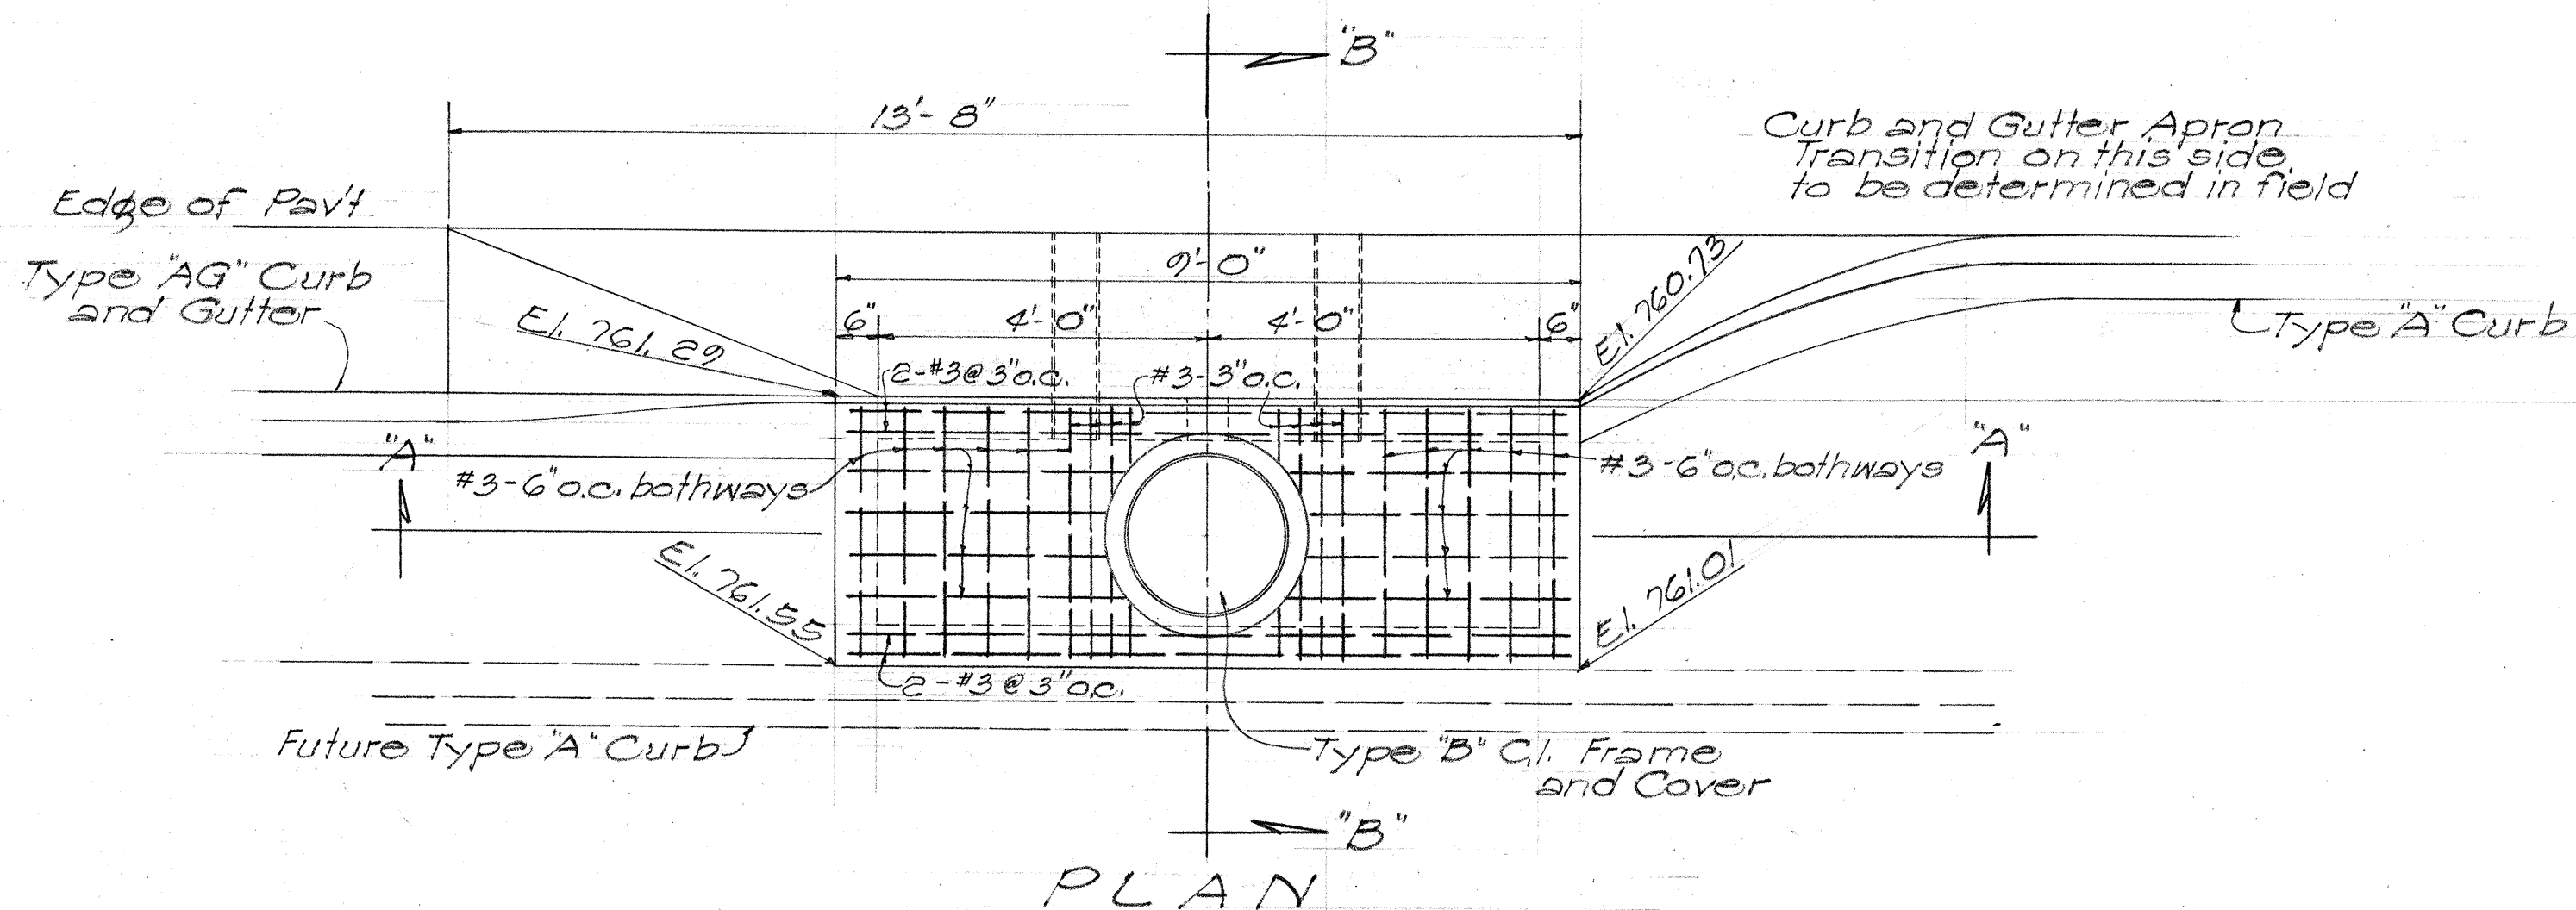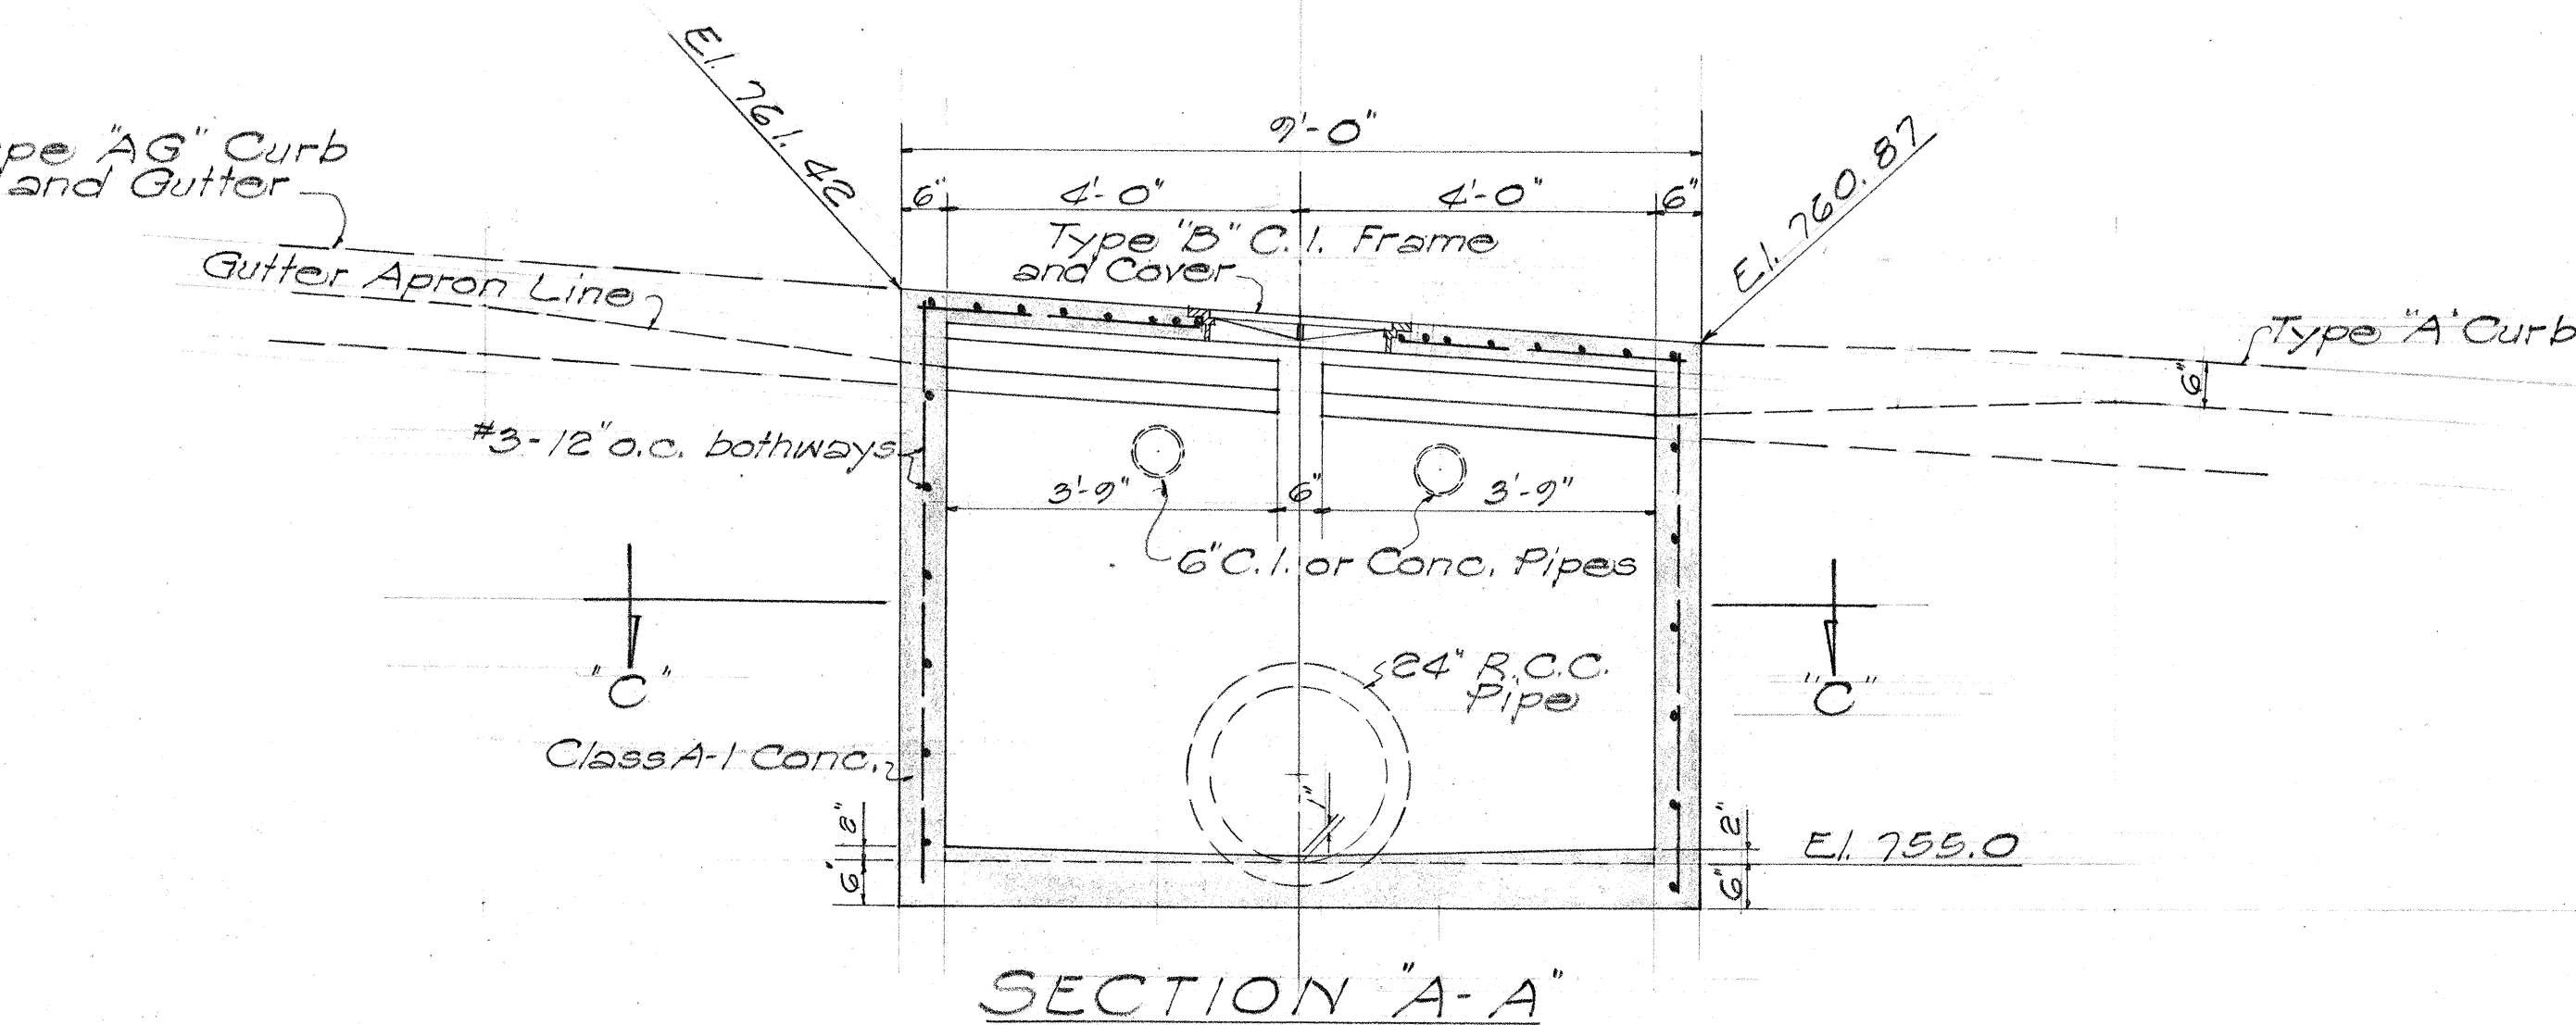


DETAIL OF SPECIAL CATCH BASIN AT 141+50
Scale: 1/2" = 1'-0"

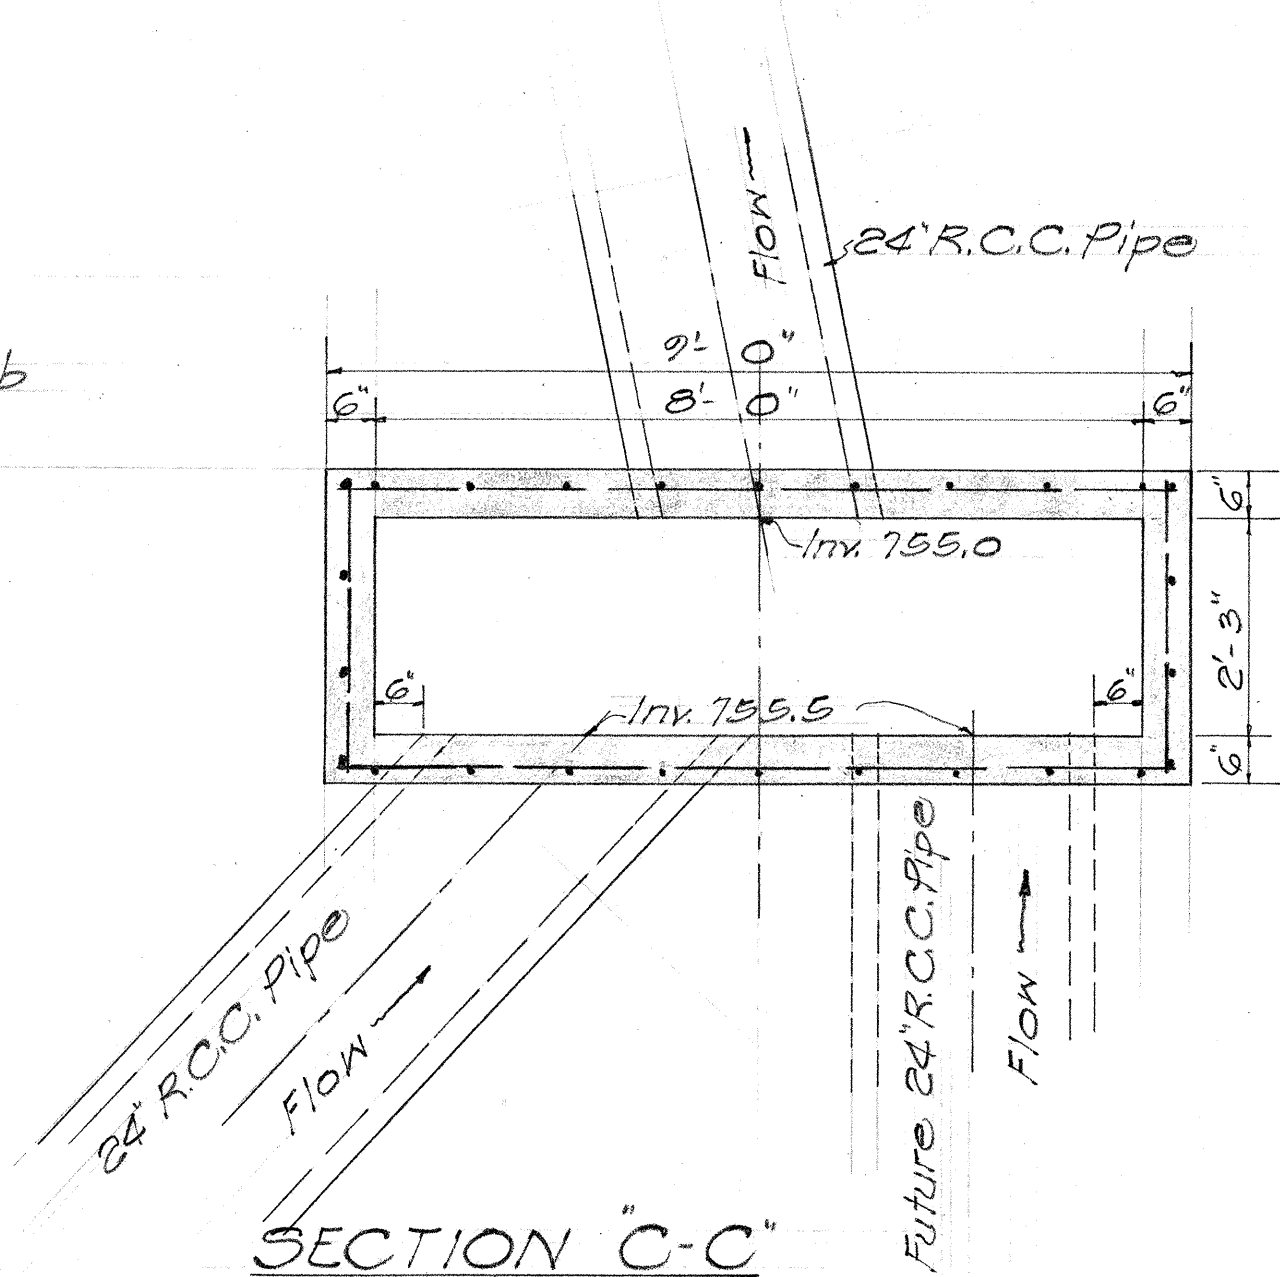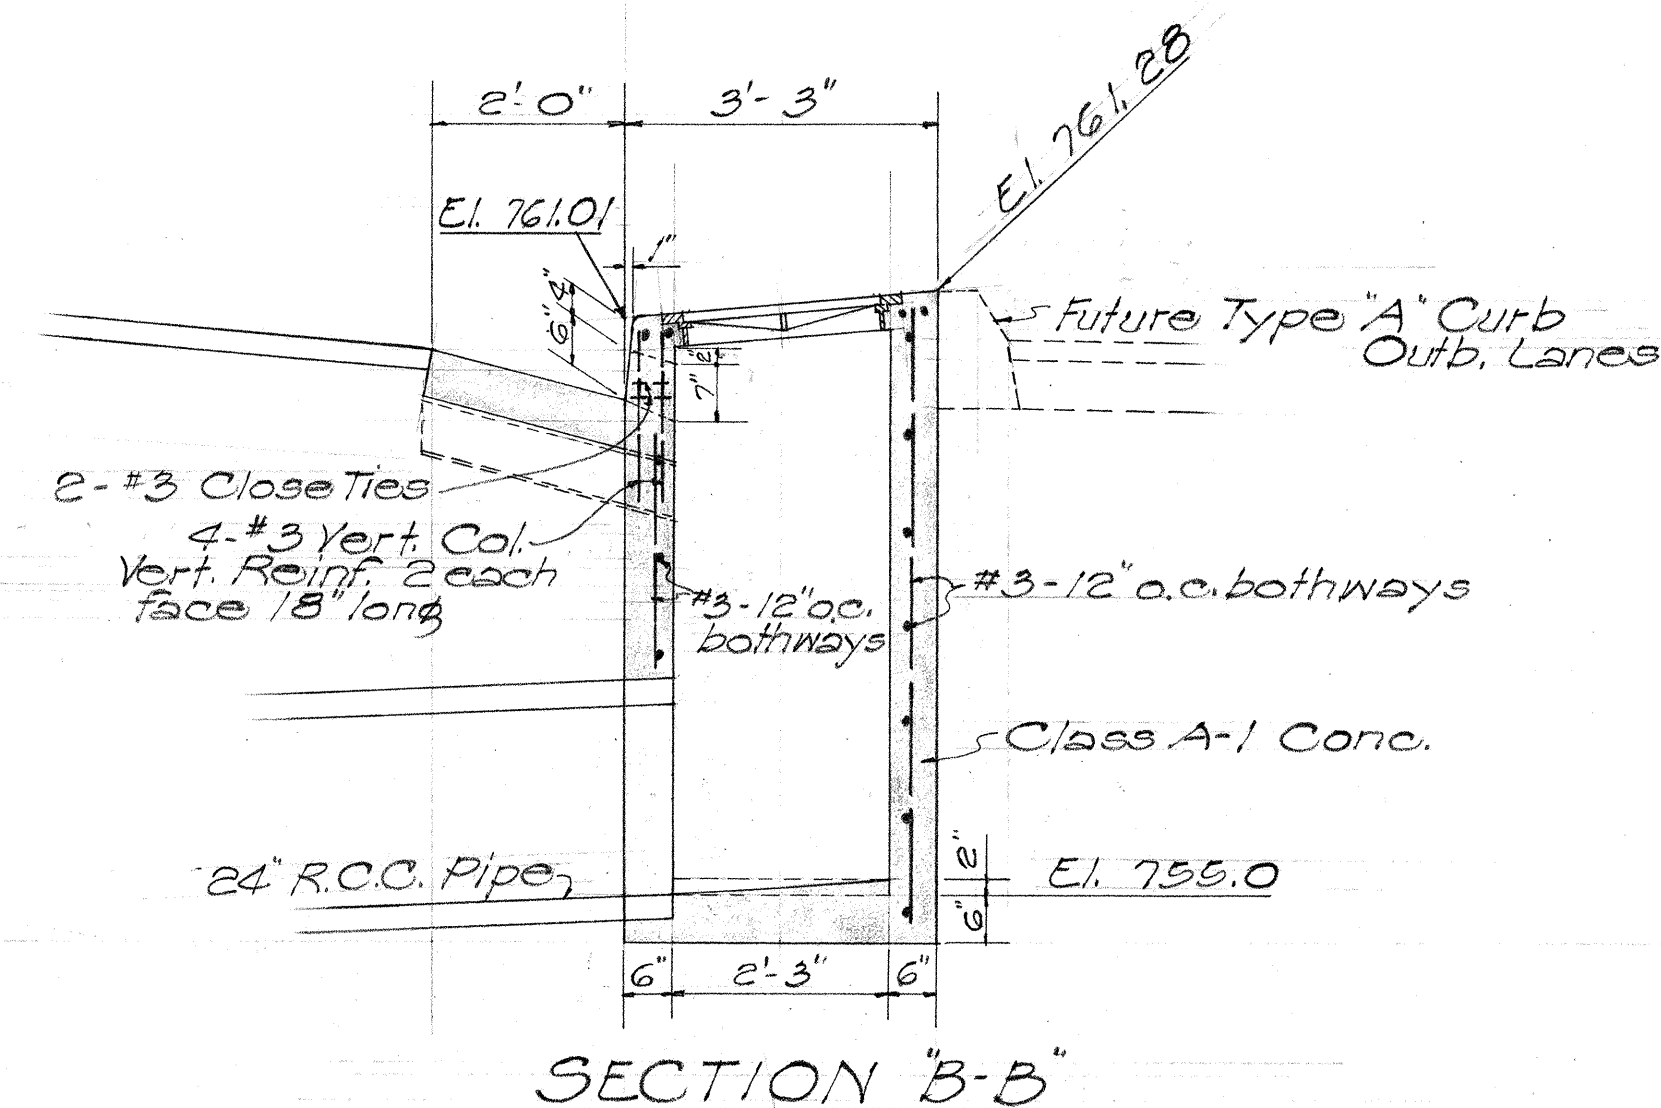

NOTE:
Install 24" S.S. and E.S. R.C.C. Pipes,
1- Special Catch Basin, 1- Special
Concrete Drop Intake, 1- Concrete
Headwall

EST. QUANT.
24" S.S. R.C.C. Pipe 200 = 33 L.F.
24" E.S. R.C.C. Pipe 240 = 60 L.F.
Class A-1 Conc. 5 = 3.5 c.y.
Class B-1 Conc. 6.0 = 6.0 c.y.
Reinf. Steel 362 = 142 lb.
Struc. Exc. 746 = 476 c.y.
Uncl. Exc. 11 = 11 c.y.
Type "C" C.I. Frame and Cover 1 = 1 c.y.
G.R.P. 4 = 4 c.y.
Struc. Steel 268 = 268 lb.

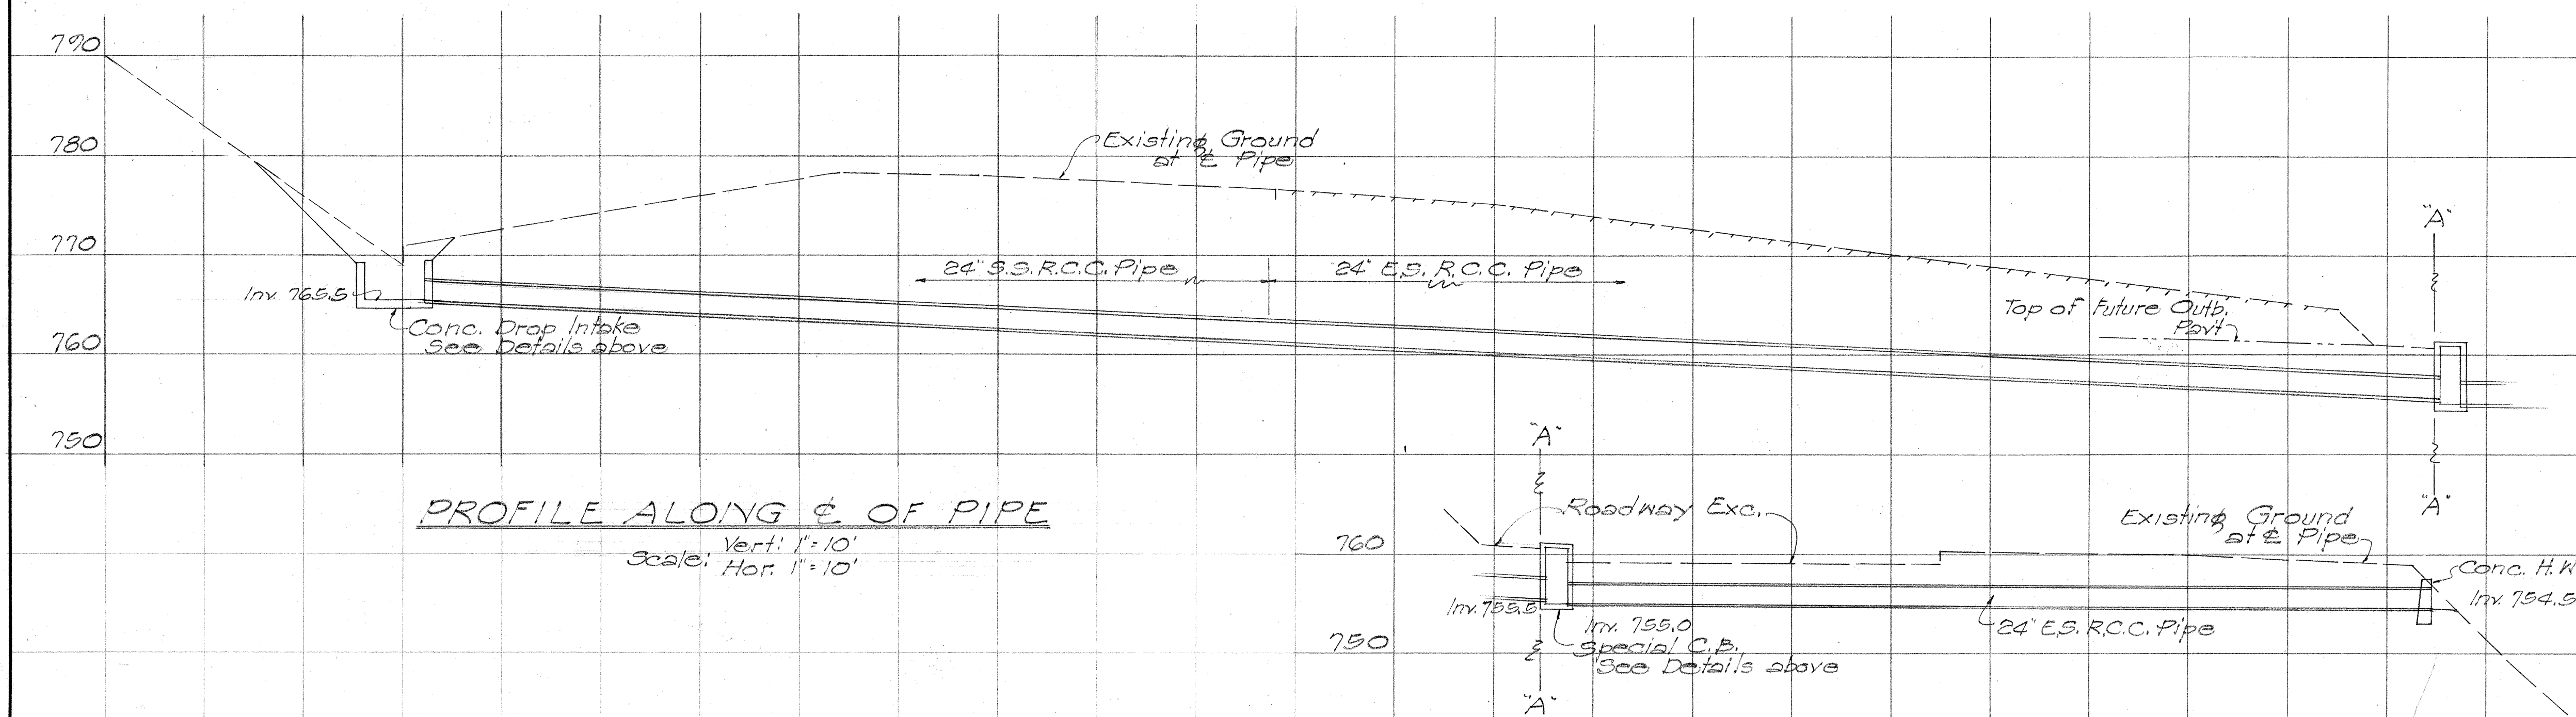


THIS SHEET INSERTED 3-16-56

TERRITORIAL HIGHWAY DEPARTMENT
TERRITORY OF HAWAII


DETAILS OF SPECIAL
CATCH BASIN AT 141+50
CONC. DROP INTAKE
NUUANU AVE.
PROJ. No. 3-0610 (1)
Scale: As noted Mar. 16, 1956

SHEET No. OF SHEETS

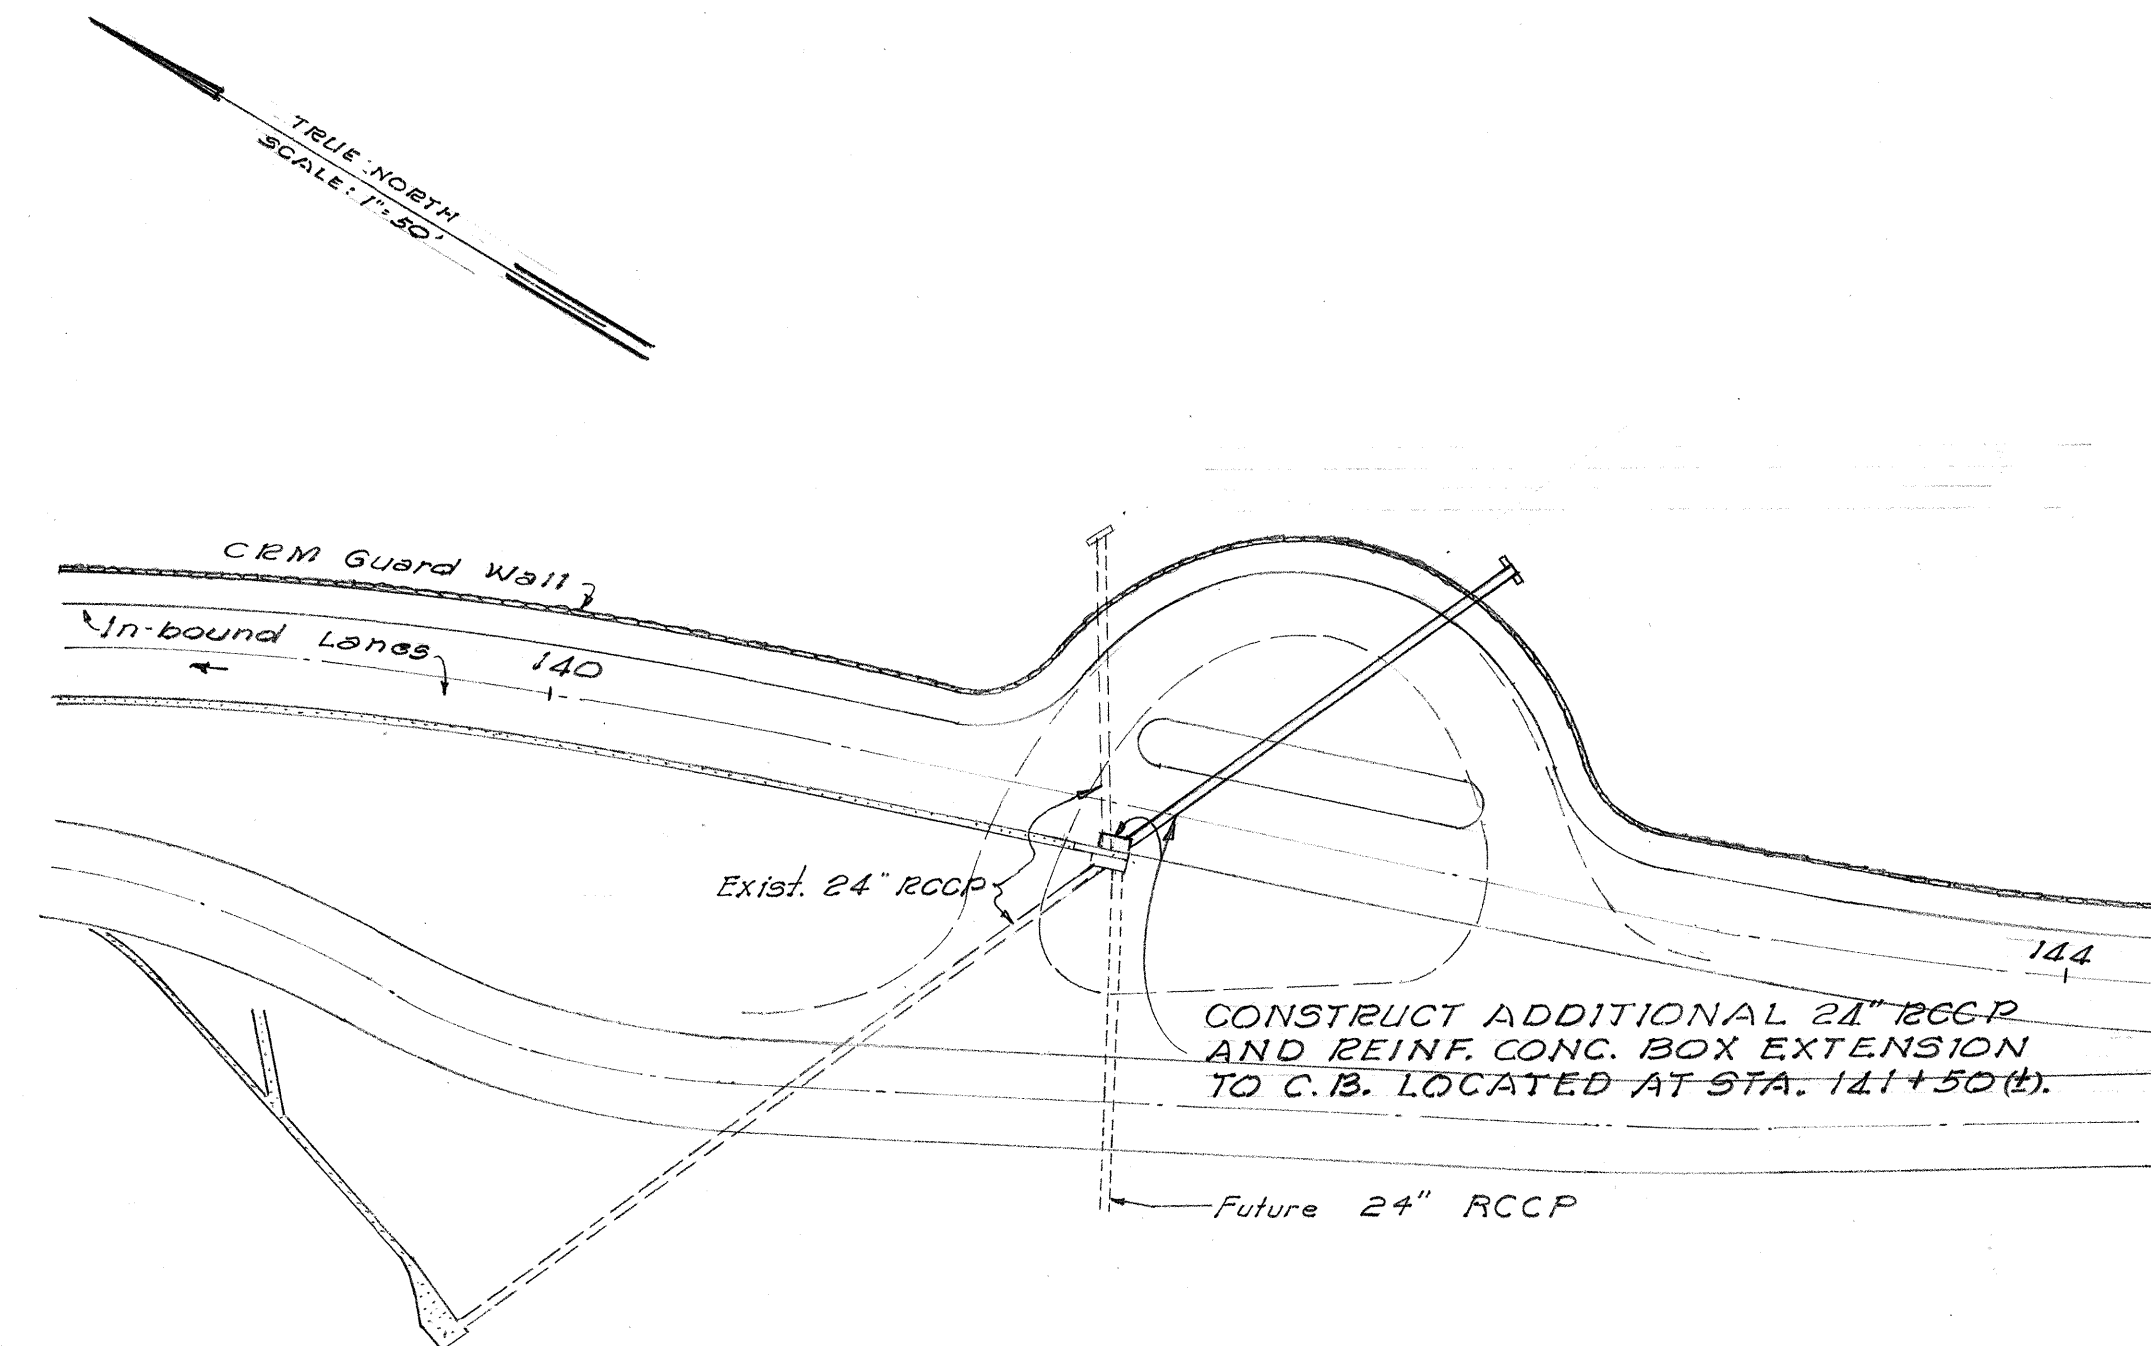


PLAN

Scale: 1"=50'

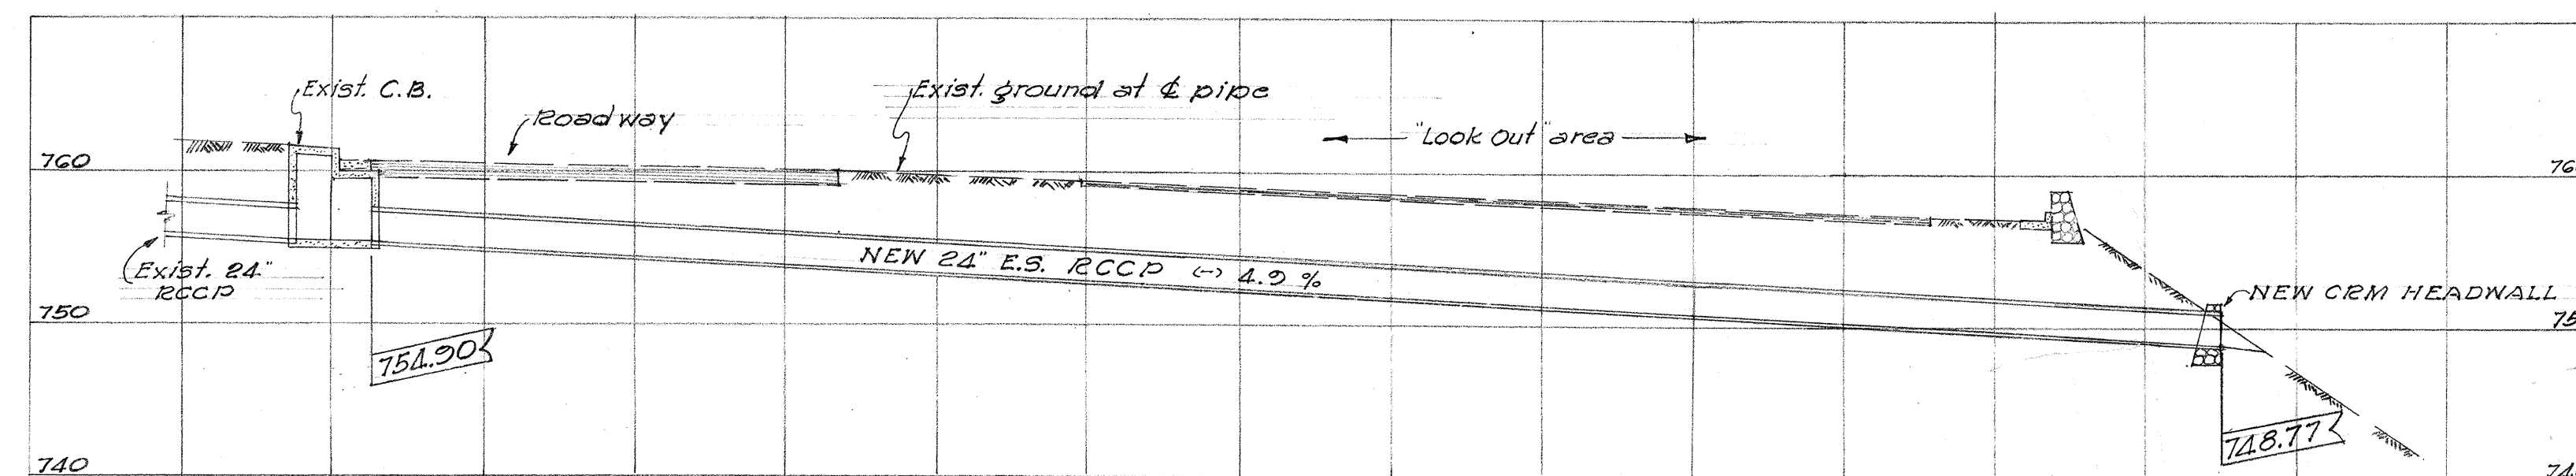


PROFILE

Scale: 1"=10' Horiz.
1"=10' Vert.

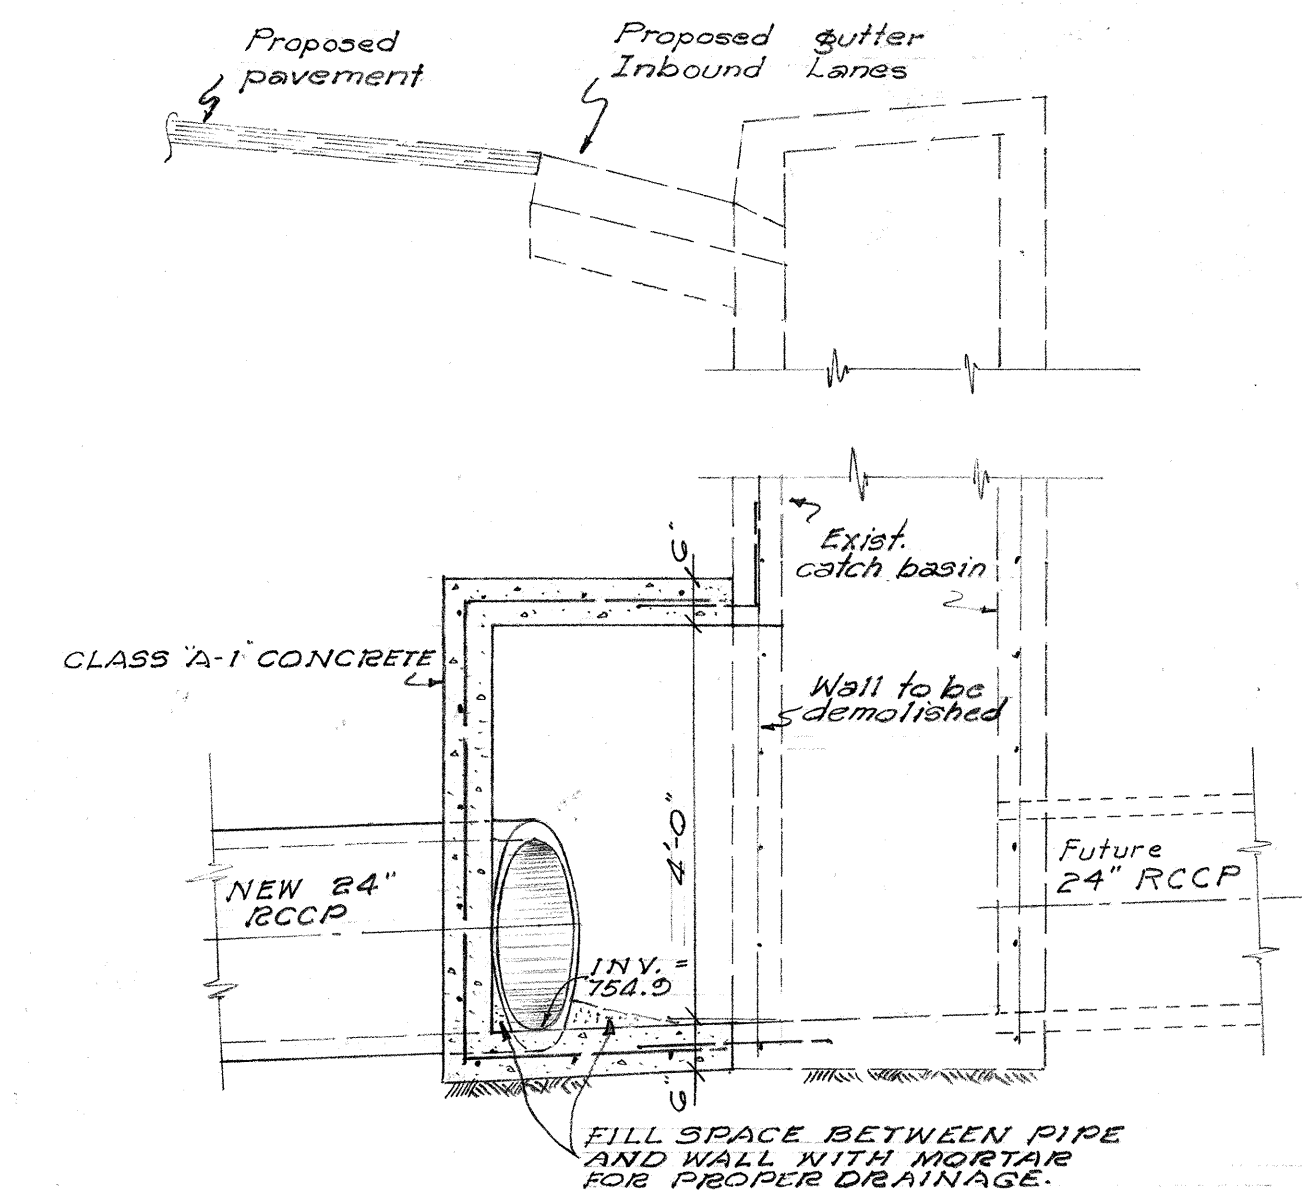

SECTION A-A

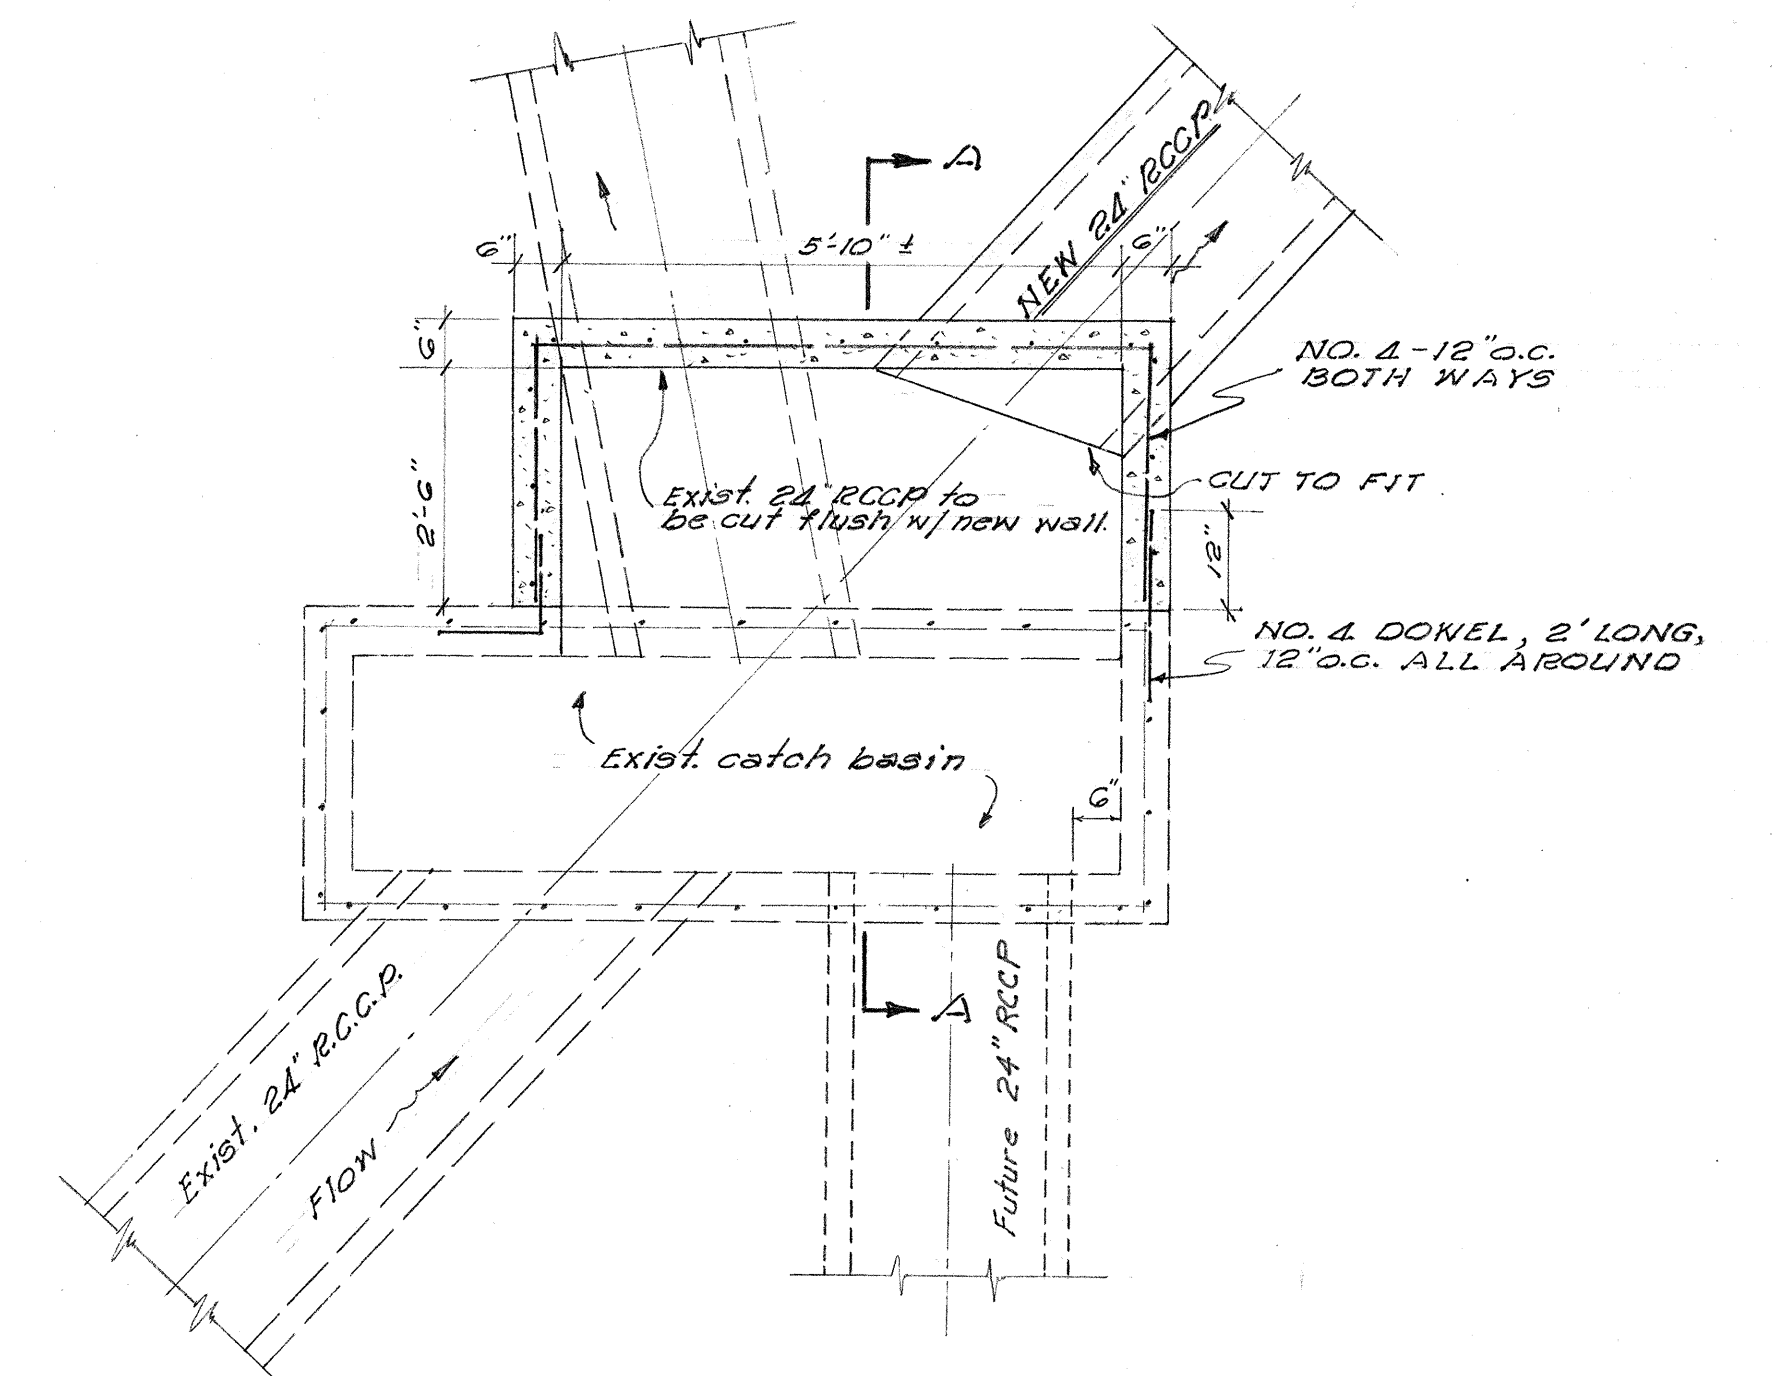

PLAN

DETAILS - EXTENSION OF EXIST. CATCH BASIN

Scale: 1/2"=1'-0"

TERRITORIAL HIGHWAY DEPARTMENT
TERRITORY OF HAWAII
DETAILS OF
ADDITIONAL 24" RCCP
AND CATCH BASIN EXTENSION
AT STA. 141+50 (±)
PALI ROAD - FAP NO. S0610(1)

OCT. 8, 1956
SHEET NO. 1 OF 1 SHEETS

5752.313