

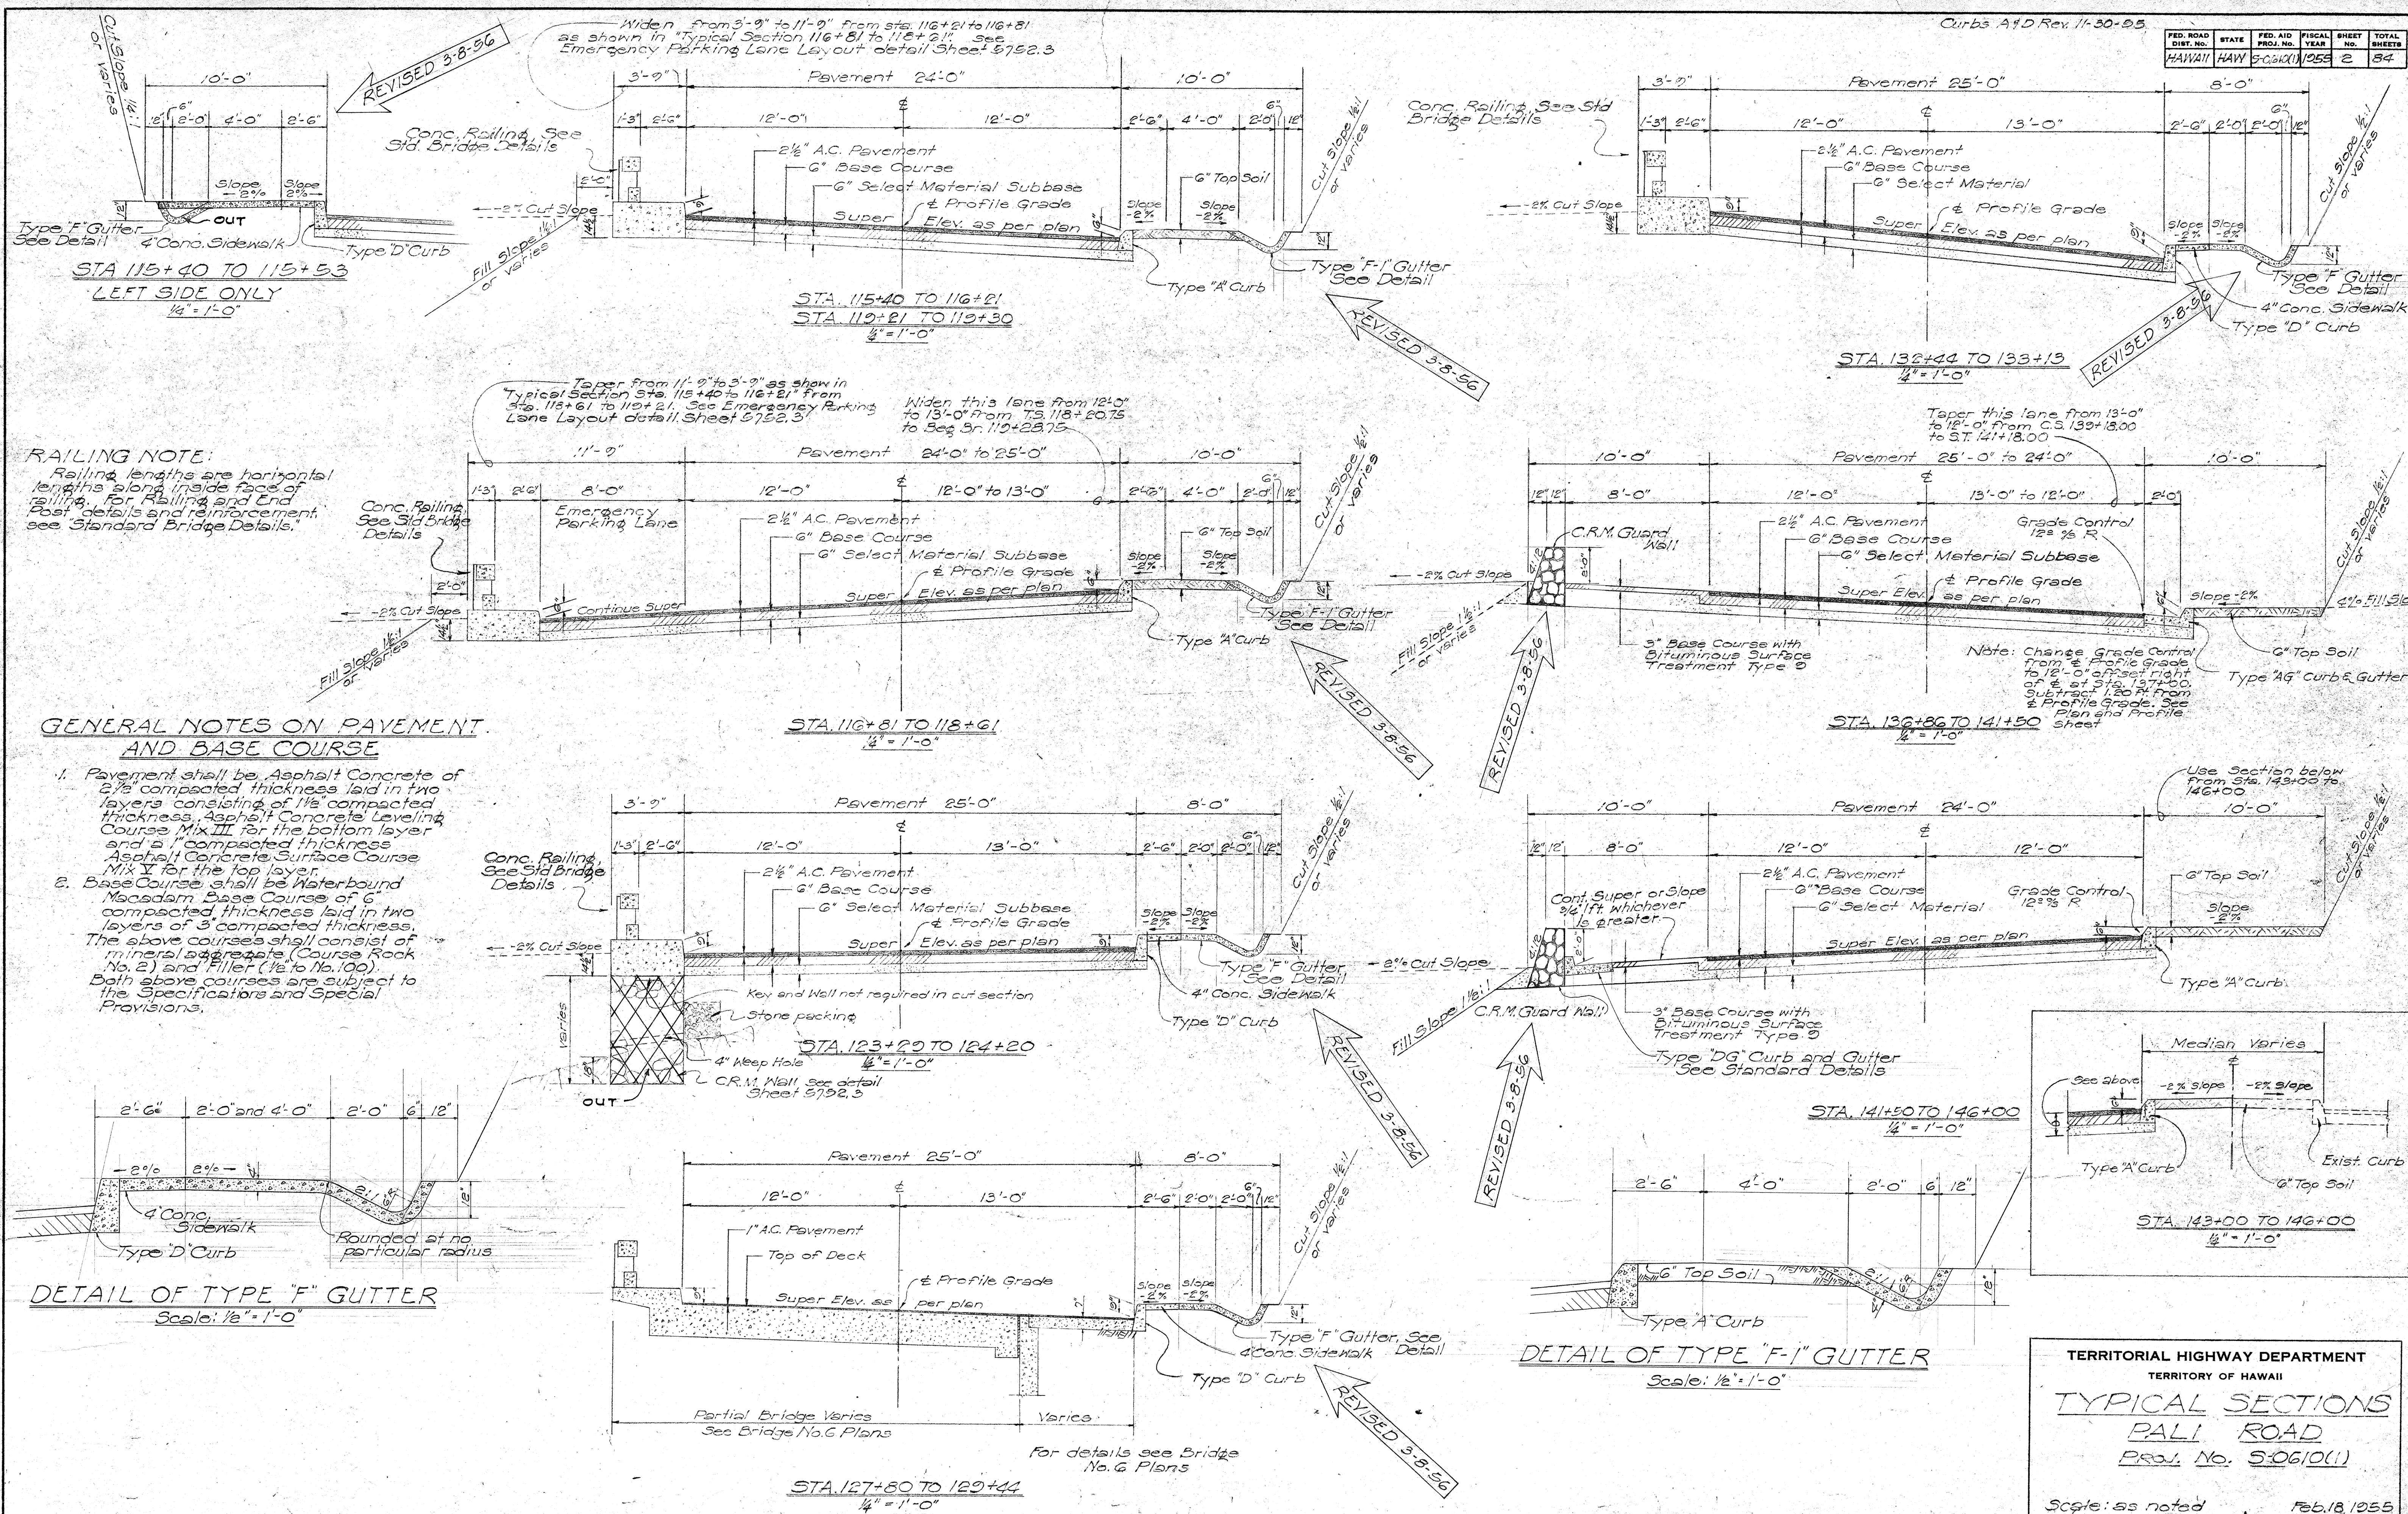


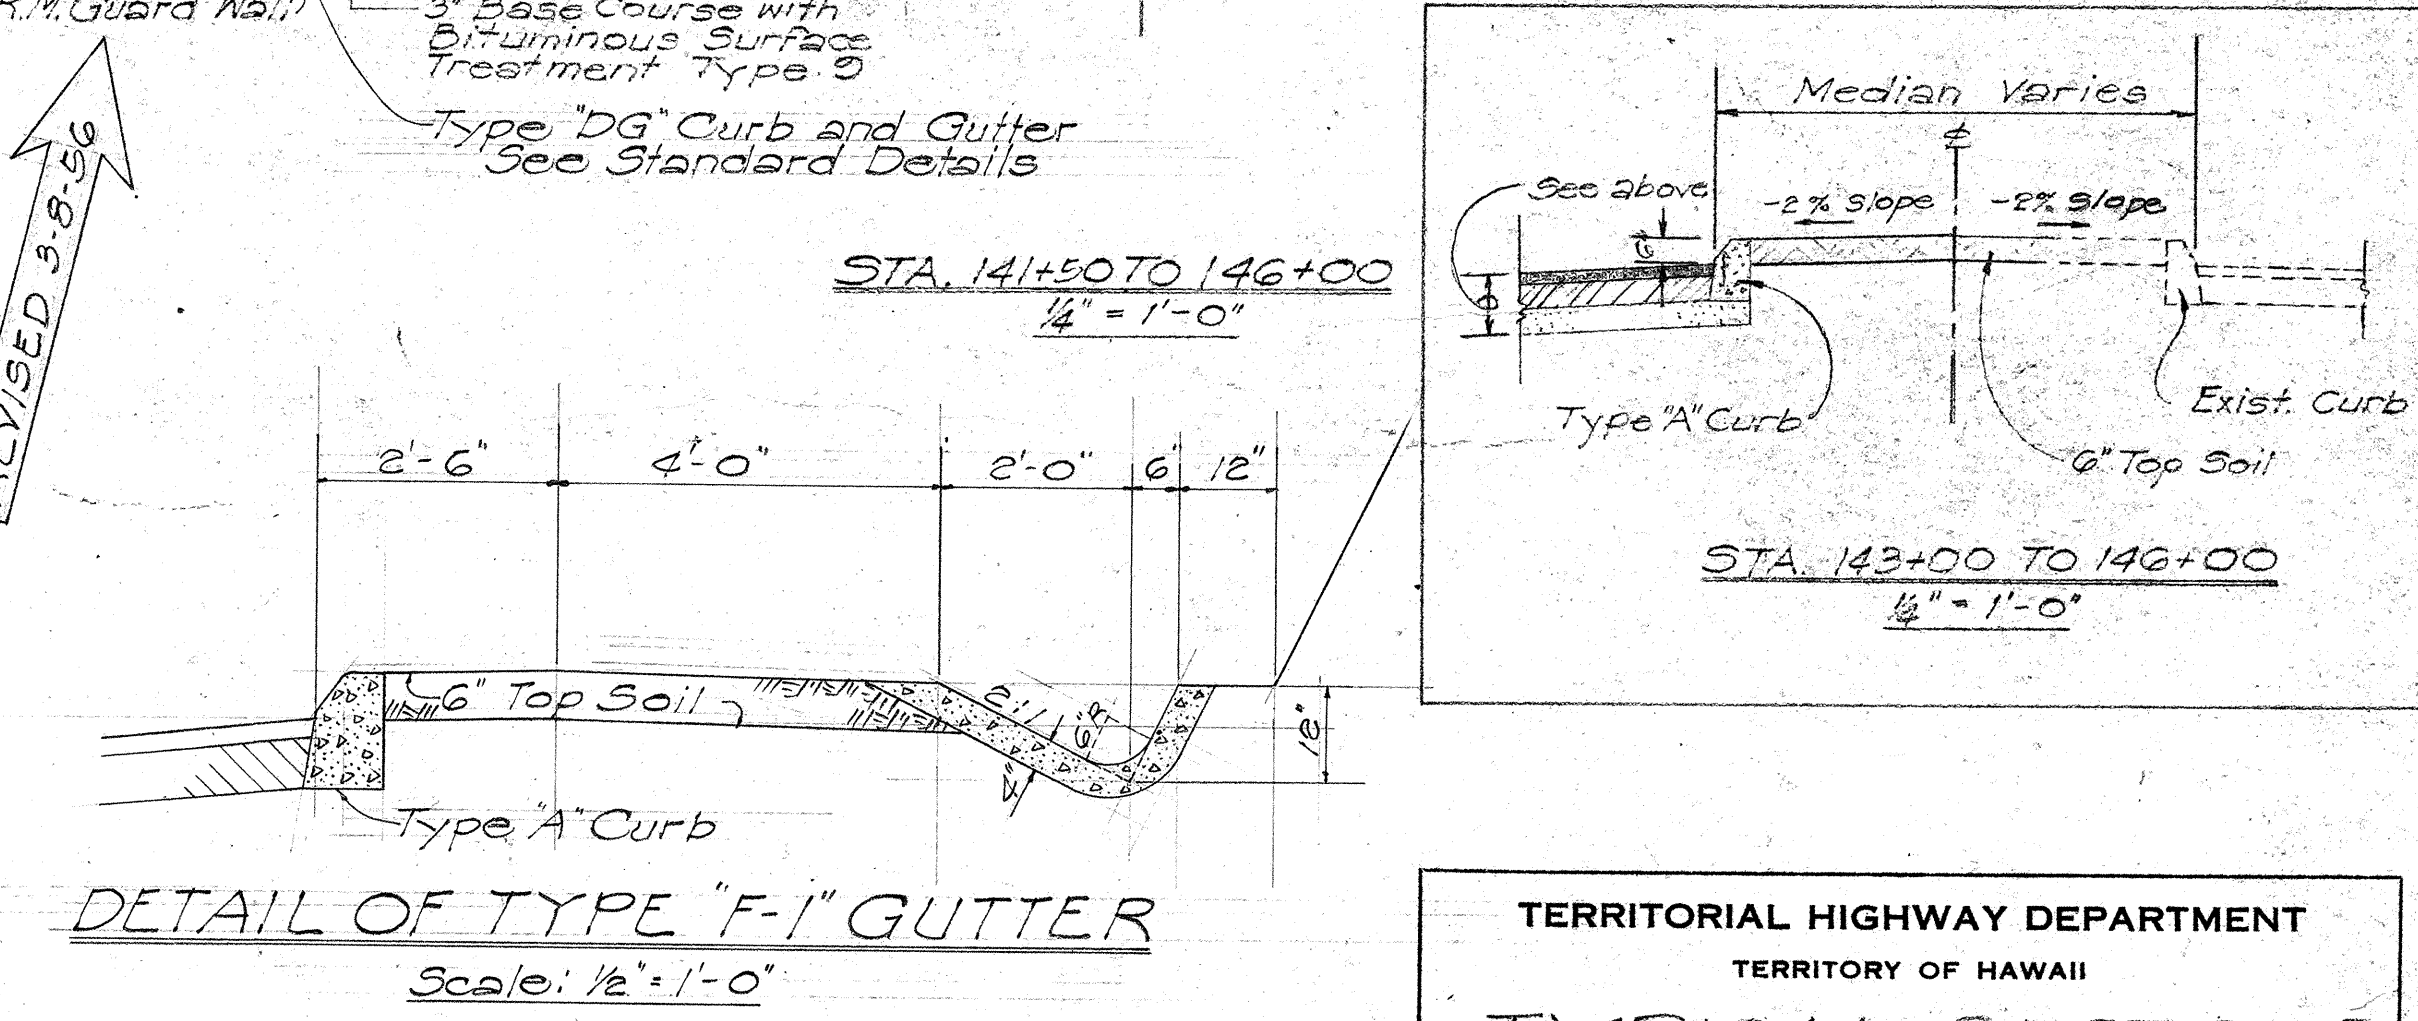

RAILING NOTE:
 Railing lengths are horizontal lengths along inside face of railing. For Railing and End Post details and reinforcement, see Standard Bridge Details.

GENERAL NOTES ON PAYEMENT AND BASE COURSE

1. Pavement shall be Asphalt Concrete of 2 1/2 inch compacted thickness laid in two layers consisting of 1 1/2 inch compacted thickness Asphalt Concrete Leveling Course, Mix III for the bottom layer and a 1 inch compacted thickness Asphalt Concrete Surface Course, Mix V for the top layer.
2. Base Course shall be Waterbound Macadam Base Course of 6 inch compacted thickness laid in two layers of 3 inch compacted thickness. The above courses shall consist of mineral aggregate (Course Rock No. 2) and Filler (1/2 to No. 100). Both above courses are subject to the Specifications and Special Provisions.

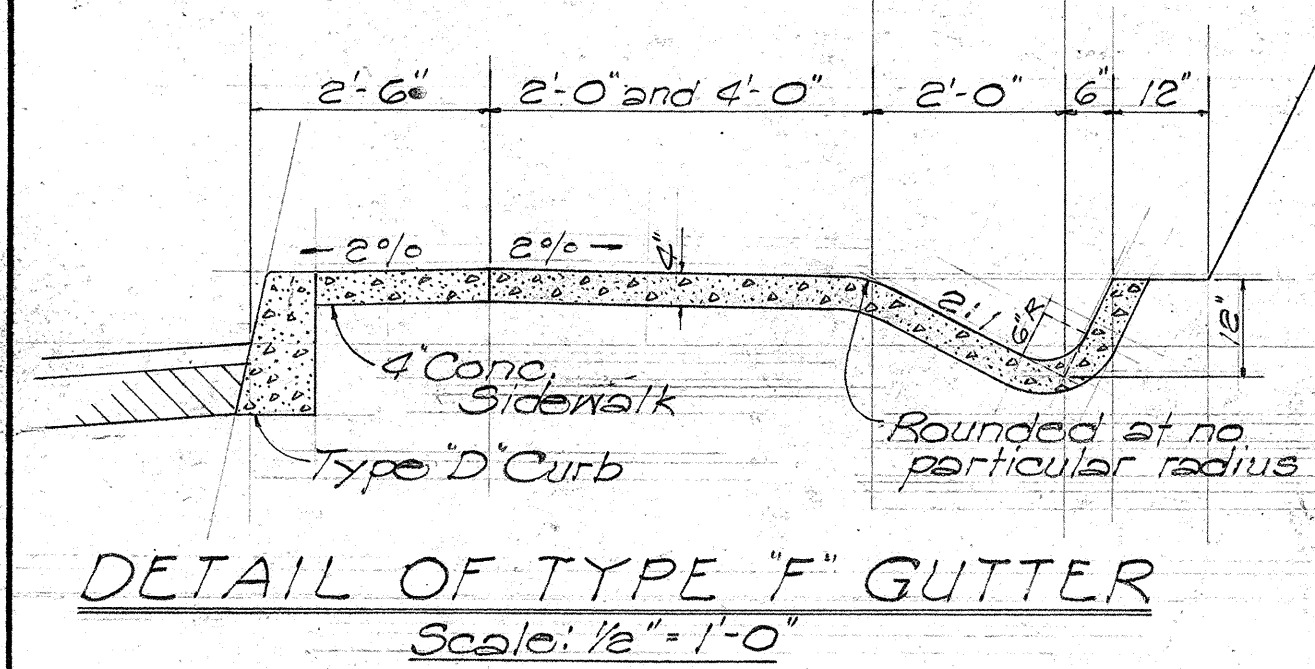

TERRITORIAL HIGHWAY DEPARTMENT
 TERRITORY OF HAWAII
TYPICAL SECTIONS
PALI ROAD
 PROJ. No. 5-0610(1)
 Scale: as noted Feb. 18, 1955
SHEET No. 1 OF 2 SHEETS

DESIGNED BY	DATE
DRAWN BY	8-56
CHECKED BY	
QUANTITIES CHECKED BY	
NOTE BOOK	
No.	