


FED. ROAD DIST. NO.	STATE	FED. AID PROJ. NO.	FISCAL YEAR	SHEET NO.	TOTAL SHEETS
HAWAII	HAW	US 0610(2)	1956	6	36

DATE	
SURVEY PLOTTED BY	
DESIGNED BY	
DRAWN BY	
NOTE BOOK	
QUANTITIES CHECKED BY	
CHECKED BY	
NO.	

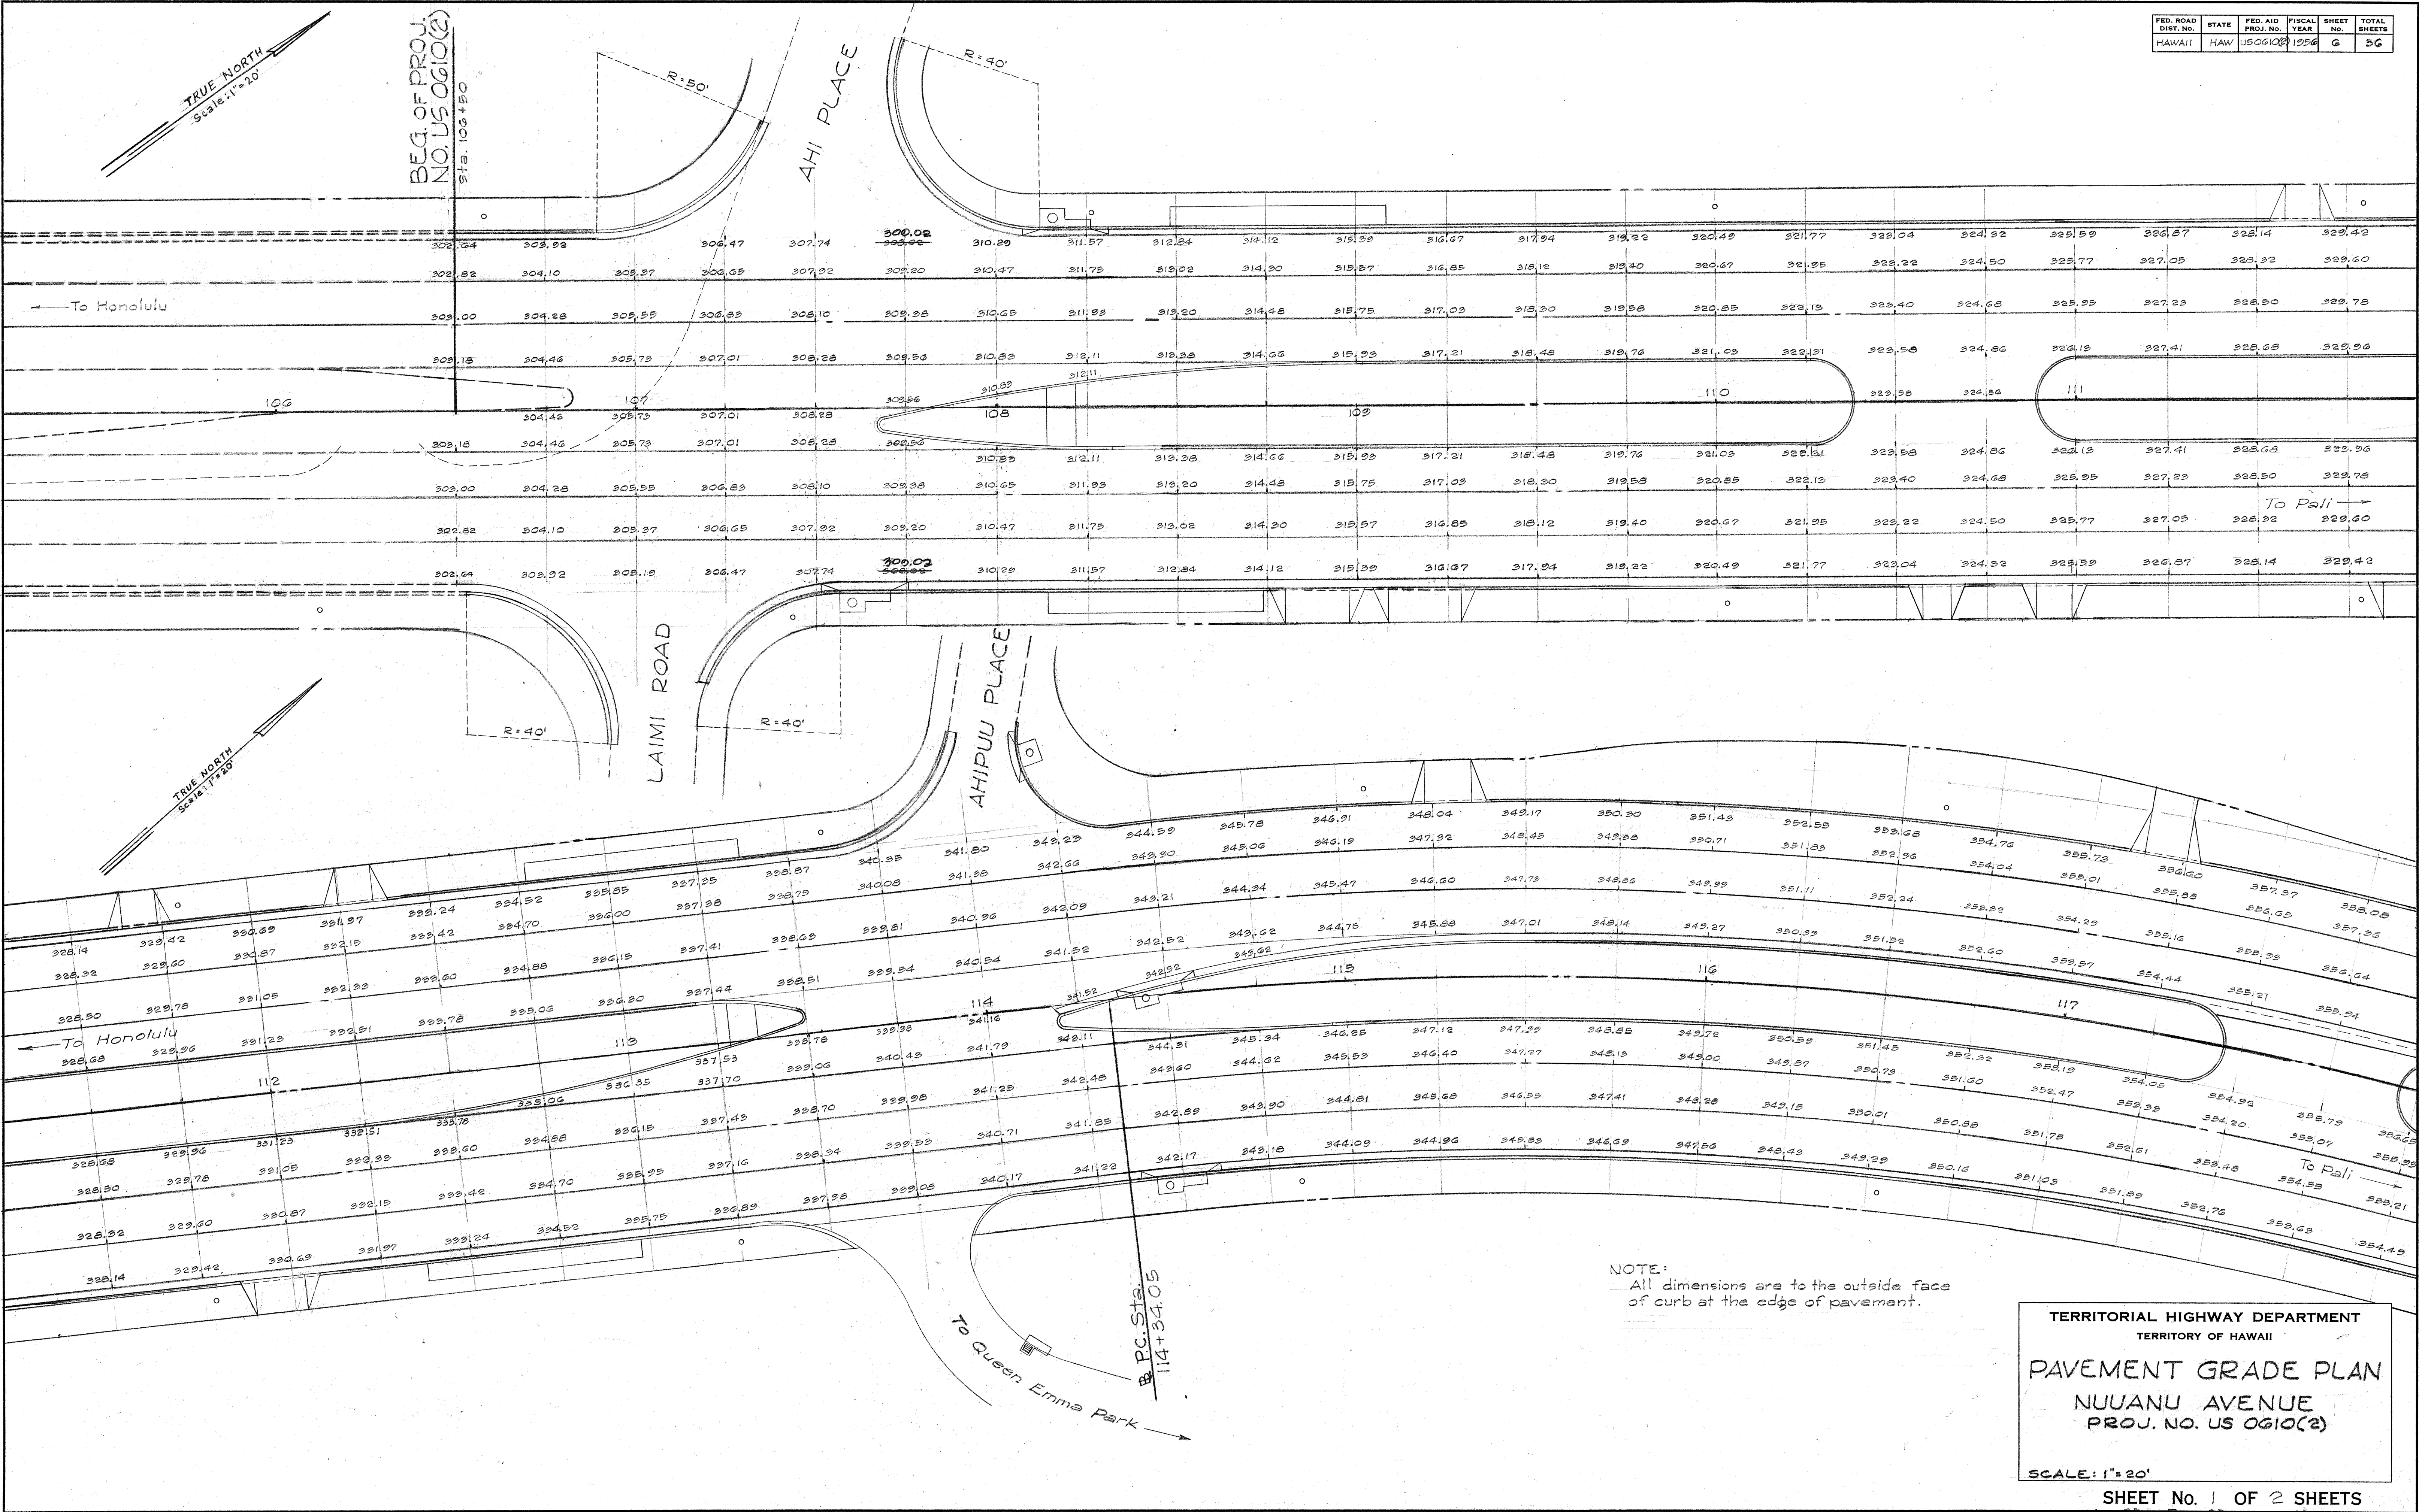

TERRITORIAL HIGHWAY DEPARTMENT
TERRITORY OF HAWAII
PAVEMENT GRADE PLAN
NUUANU AVENUE
PROJ. NO. US 0610(2)

SCALE: 1"=20'
SHEET No. 1 OF 2 SHEETS



5819.6

FED. ROAD DIST. NO.	STATE	FED. AID PROJ. NO.	FISCAL YEAR	SHEET NO.	TOTAL SHEETS
HAWAII	HAW	US 0610(2)	1956	7	36

Revised 10/24/56

GENERAL NOTES

1. All clearing and grubbing shall be incidental to Unclassified Excavation.
2. Smooth riding connections shall be made at all connections with existing roadway.
3. Existing manhole covers shall be adjusted to new grades as directed by the Engineer.
4. Location of existing utilities are approximate only and must be verified by the Contractor where required by the Engineer before construction.
5. All existing lava rock curbing shall be salvaged by the Contractor and reconstructed where indicated by the plans. See note on Sheet 5819.28.
6. Connections between new curbing and existing curbing shall have a transition not less than 10'-0" in length and constructed in a smooth workmanlike manner. Payment for the new curb shall be made to the beginning of the existing curb.
7. Connections between new curbing of different cross-sections shall have a transition not less than 50' in length and constructed in a smooth and workmanlike manner.
8. Origin of Azimuth referred to Wyllie A.
9. Datum-Elevation based on mean sea level.

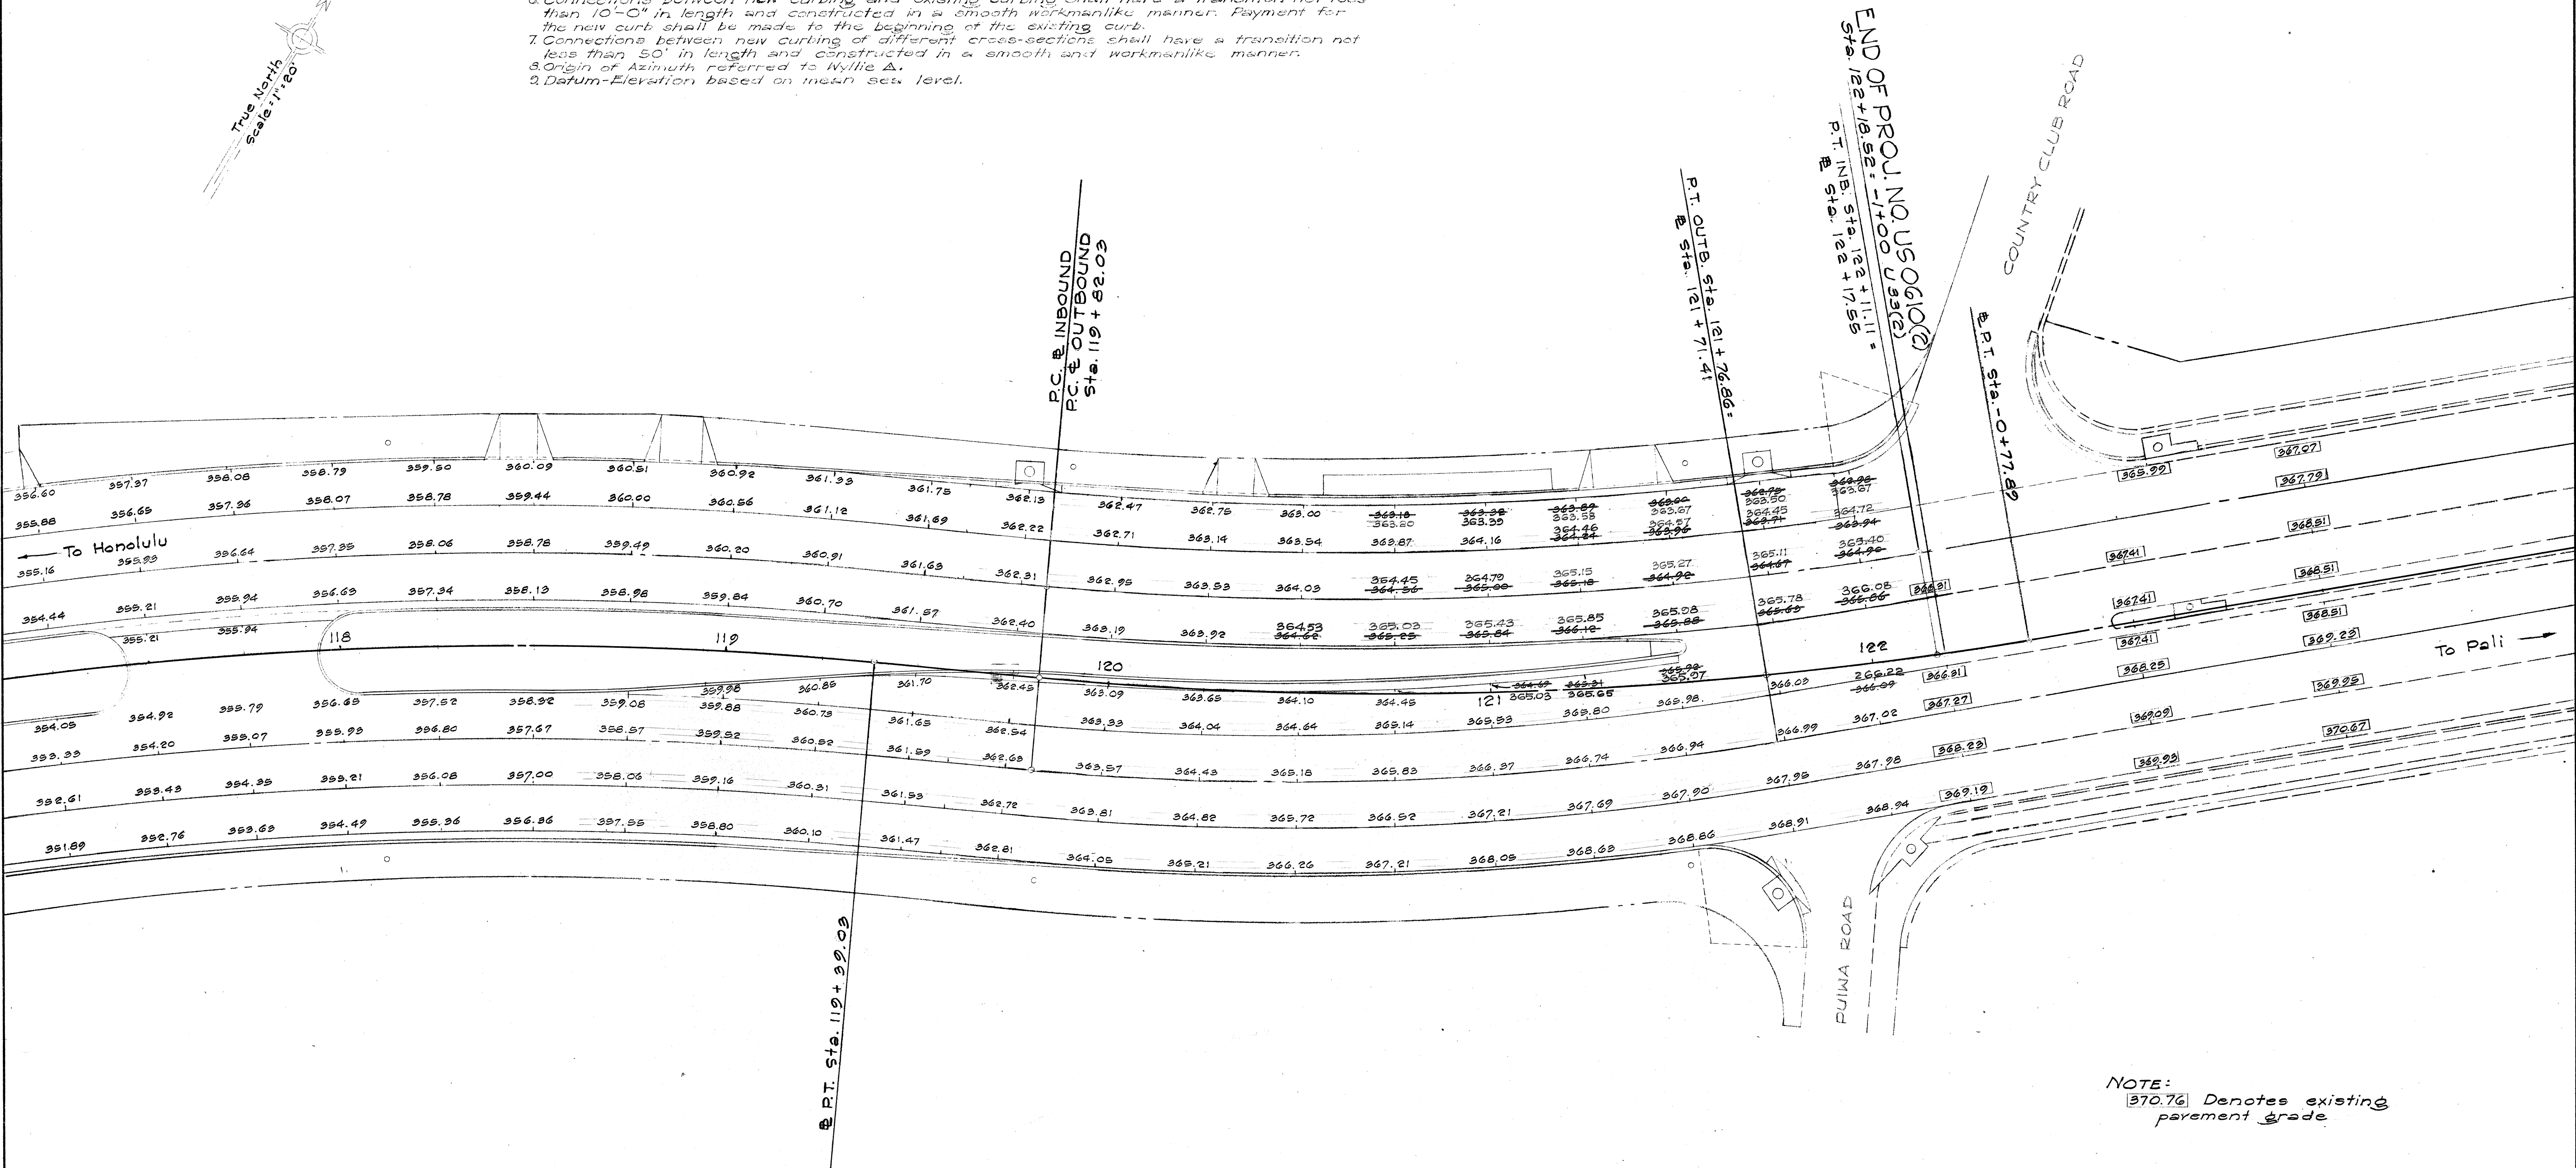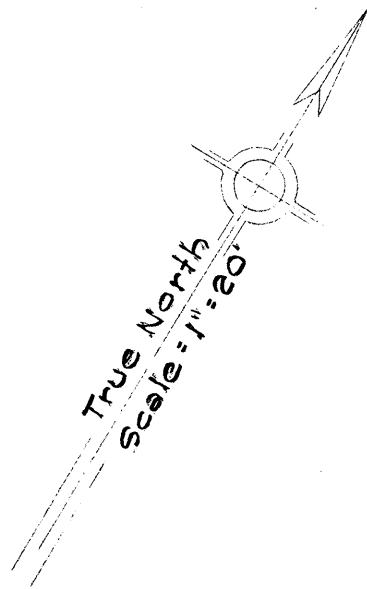

NOTE:
370.76 Denotes existing
pavement grade

ORIGINAL PLAN	DESIGNED BY	DATE
NOTE BOOK	DRAWN BY	
NO.	QUANTITIES CHECKED BY	
	CHECKED BY	

TERRITORIAL HIGHWAY DEPARTMENT
TERRITORY OF HAWAII
PAVEMENT GRADE PLAN
NUUANU AVENUE
PROJ. NO. US 0610(2)

SCALE: 1"=20'
SHEET No. 2 OF 2 SHEETS

5819.7