

FED. ROAD DIST. NO.	STATE	FED. AID PROJ. NO.	FISCAL YEAR	SHEET NO.	TOTAL SHEETS
HAWAII	HAW	US 0610	1956	17	36



W-19


W-19

W-19


TERRITORIAL HIGHWAY DEPARTMENT
TERRITORY OF HAWAII
LAYOUT OF
REGULATORY & WARNING
SIGNS
PAVEMENT MARKINGS
NUUANU AVENUE
PROJ. NO. US 0610(2)
Scale: 1" = 20' Mar. 1956

SHEET No. 1 OF 2 SHEETS

5819.17

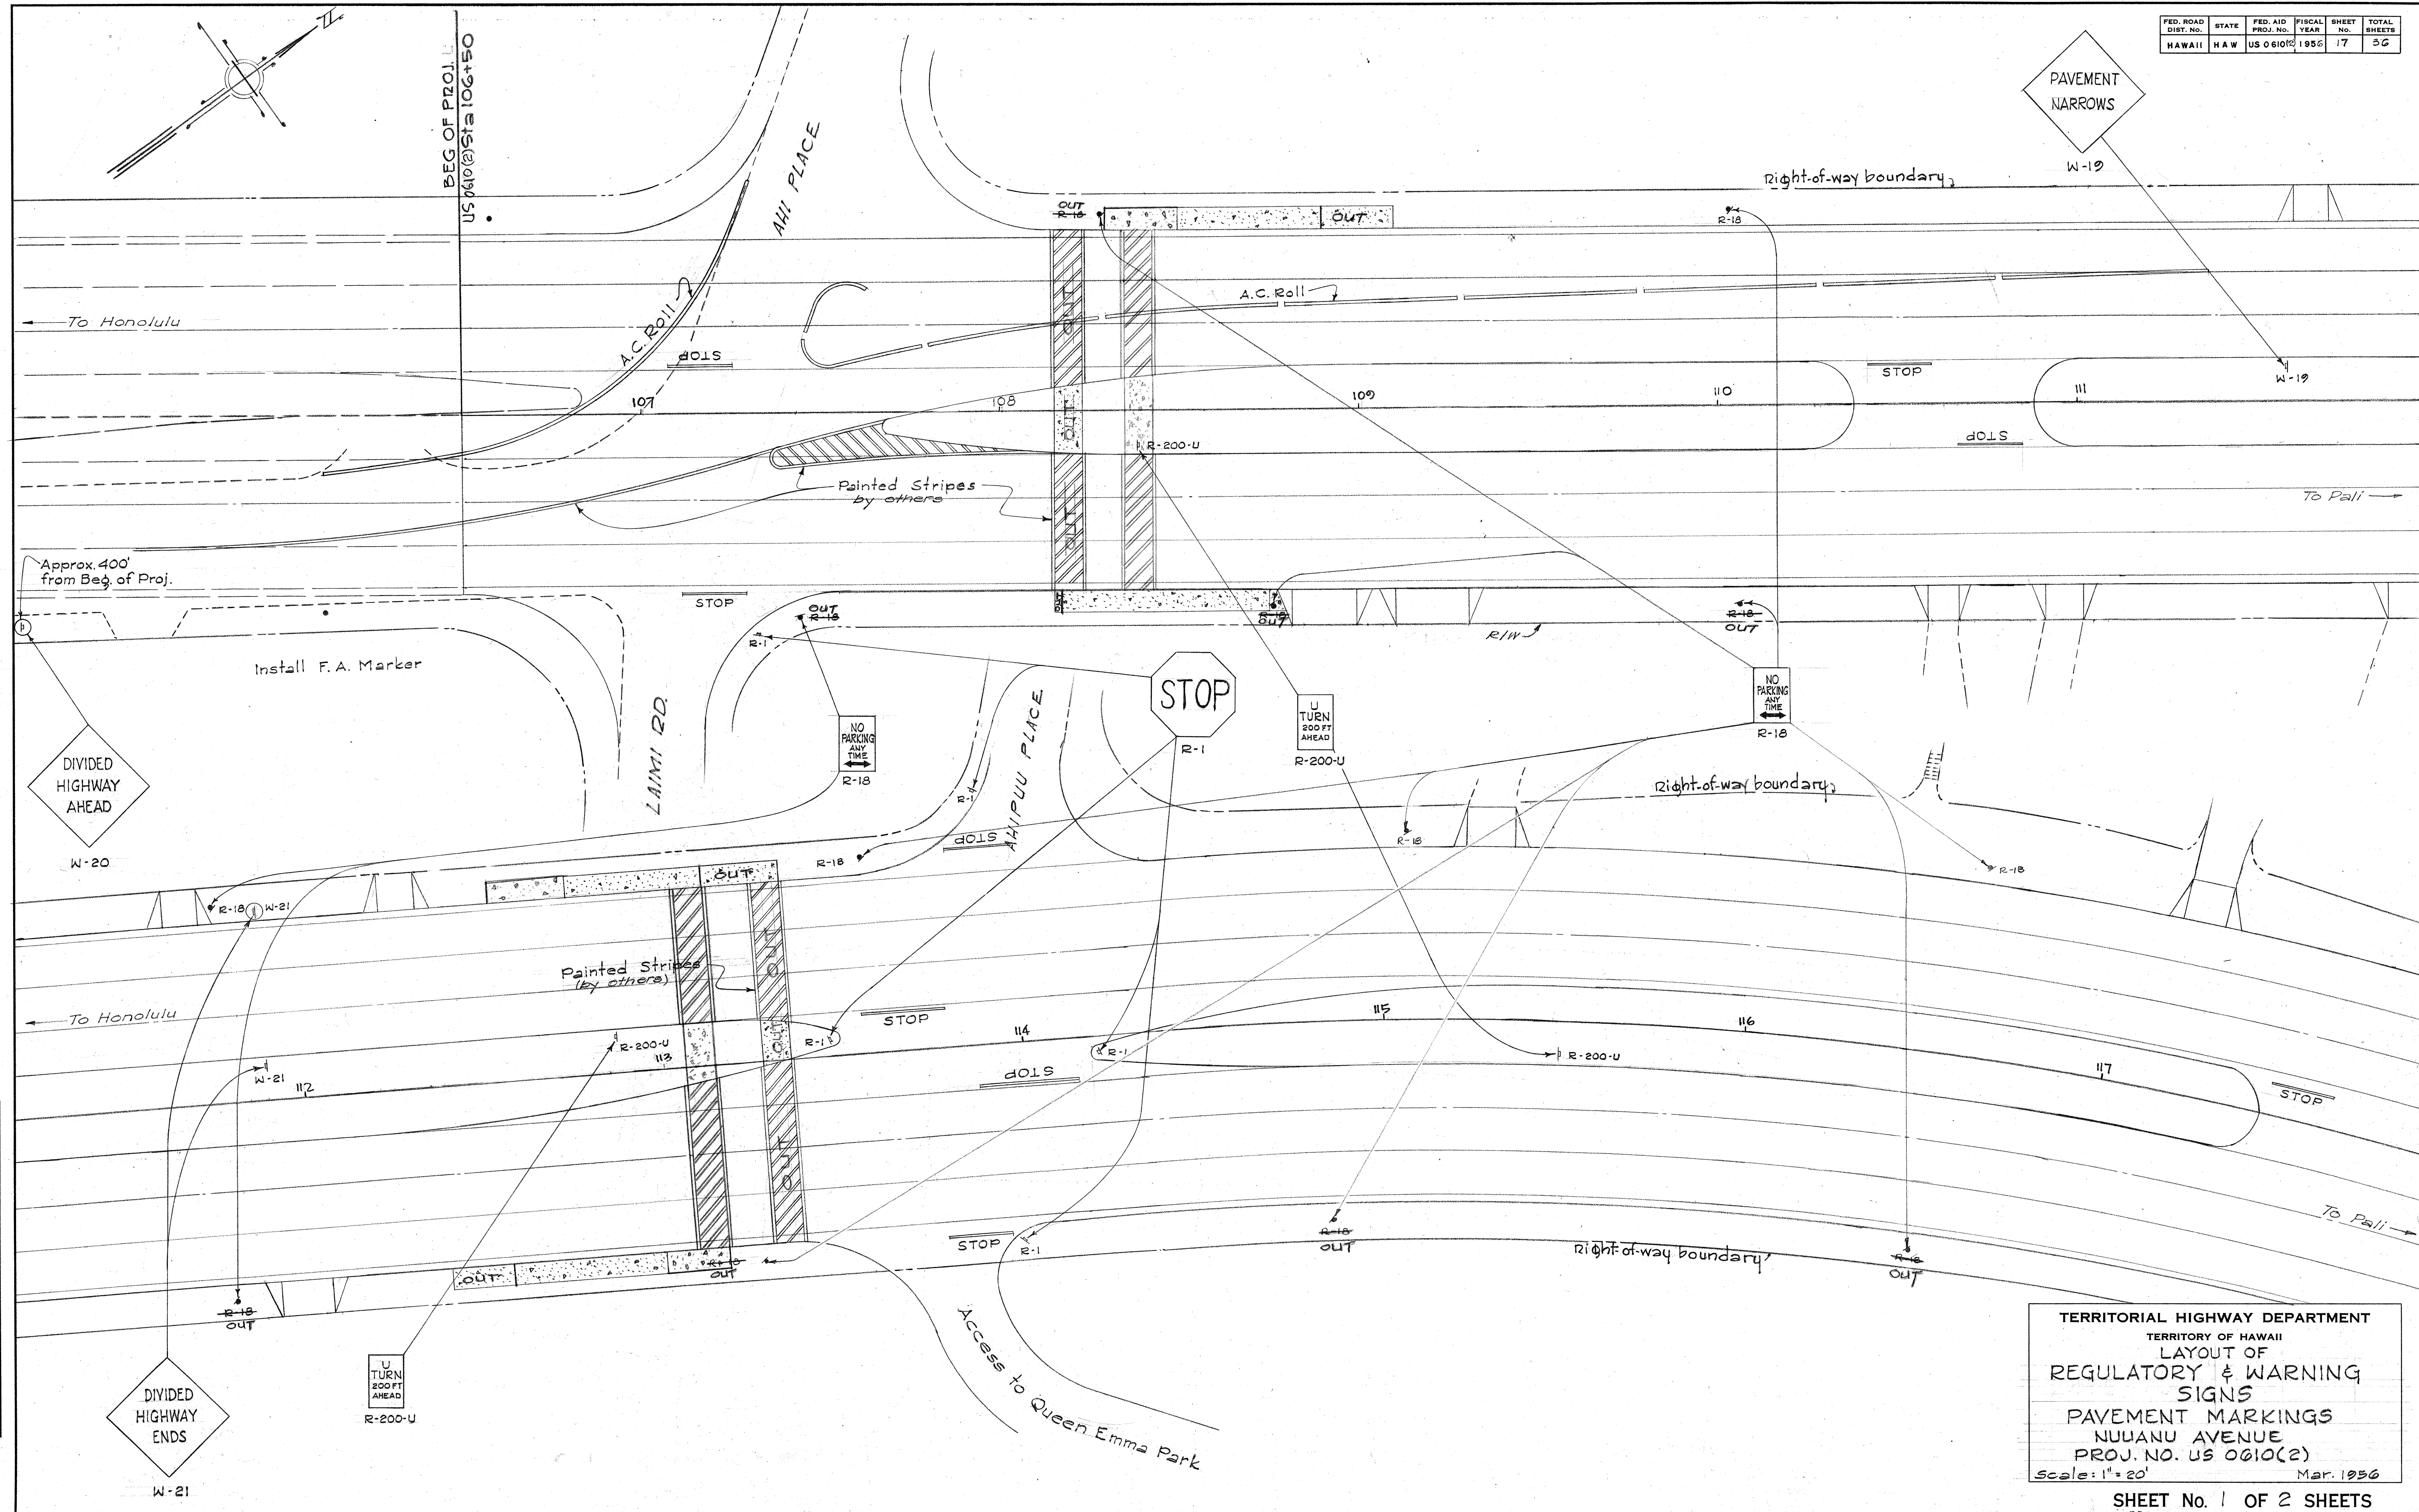

SURVEY PLANNED BY	DATE
DESIGNED BY	DATE
DRAWN BY	DATE
CHECKED BY	DATE
NOTE BOOK	NO.
QUANTITIES CHECKED BY	DATE

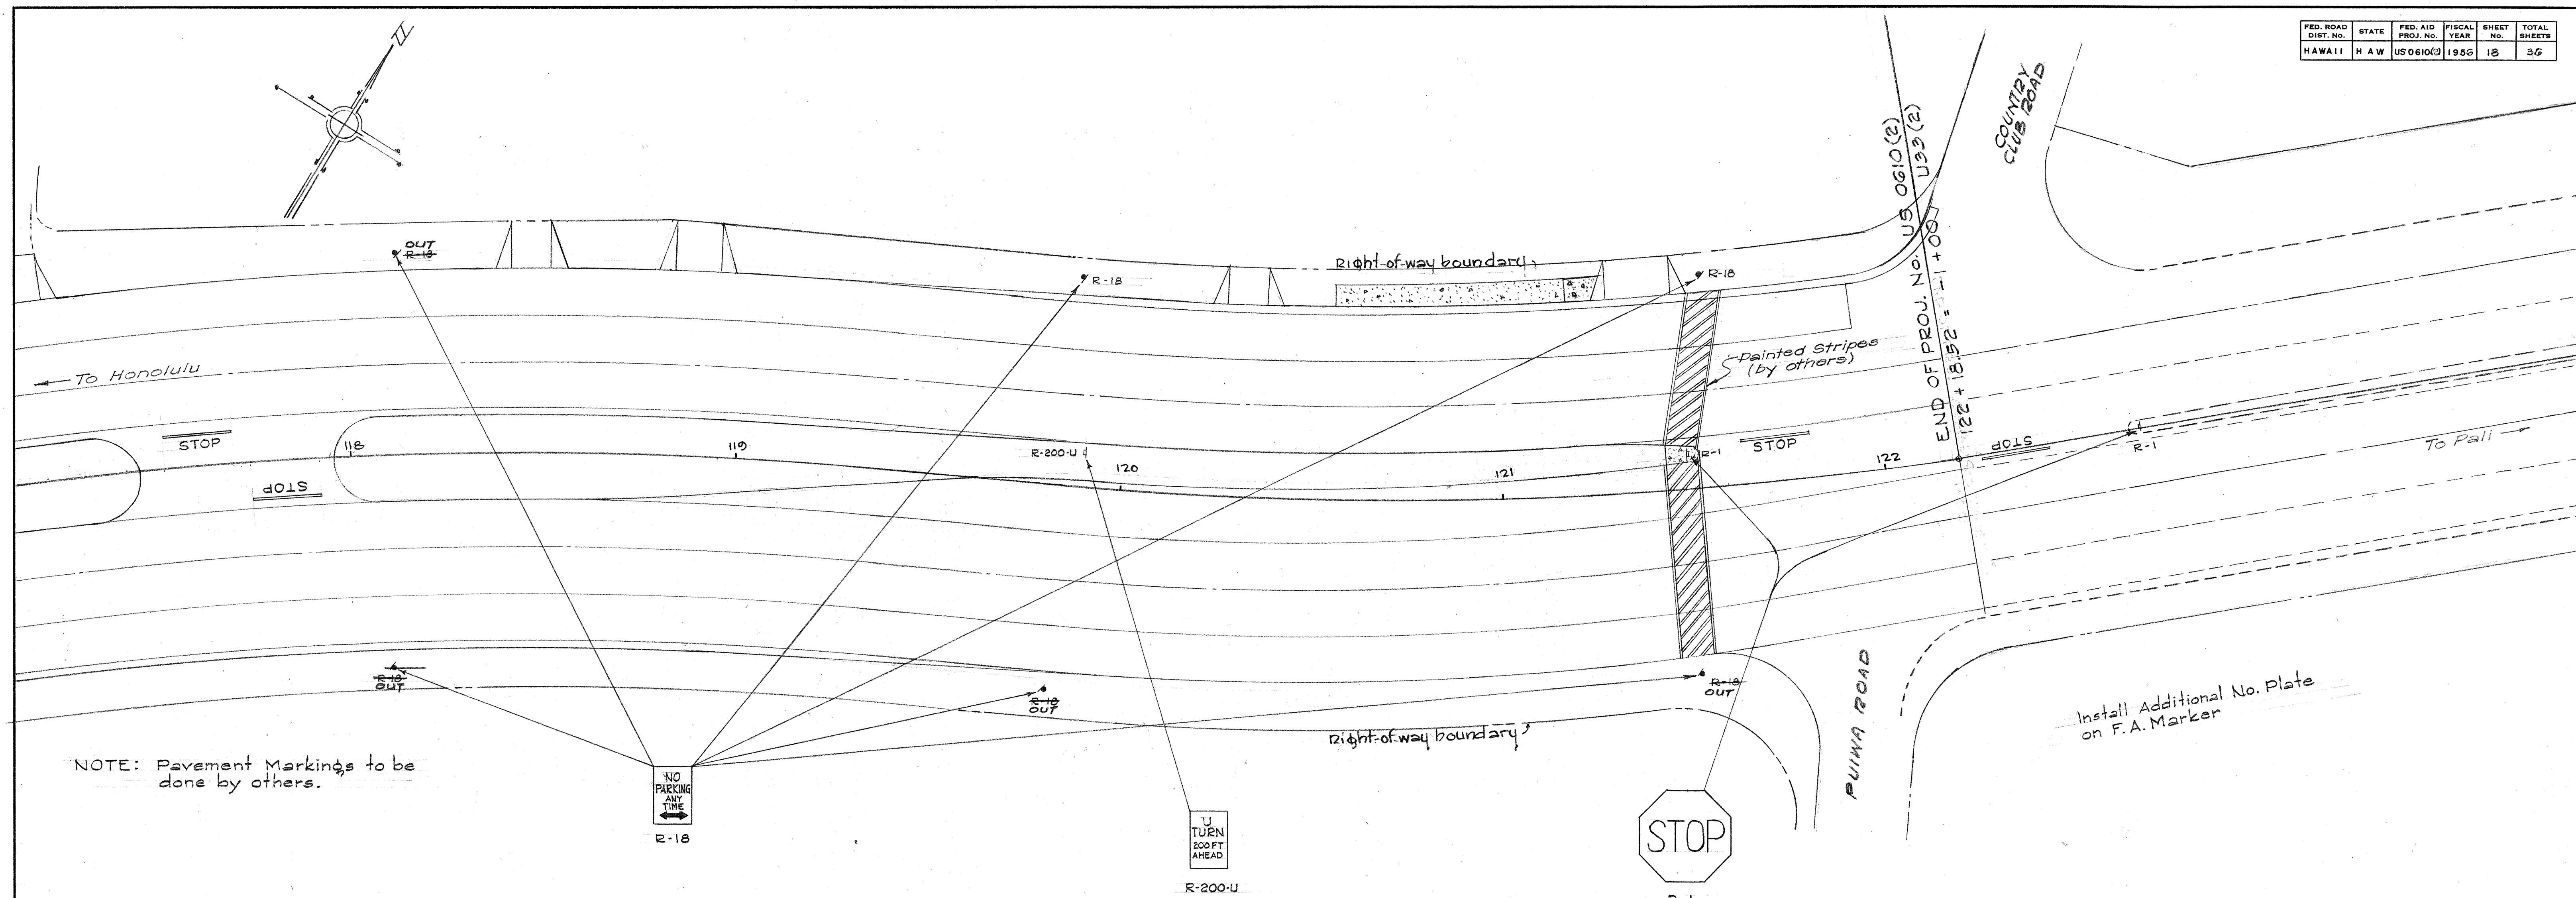

NOTE: Pavement Markings to be done by others.

Install Additional No. Plate on F.A. Marker

LEGEND

- UTILITY POLE
- SIGNS ATTACHED TO UTILITY POLE
- SIGNS WITH REGULAR SIGN POSTS
- ⊕ RESET SIGNS

NOTE:
Attach Signs to Utility Poles Whenever Possible.

SUMMARY OF SIGNS			
SIGN NO.	WORDINGS	TOTAL	
		NEW	RESET
R-1	STOP	7	
R-18	NO PARKING ANY TIME	15 7	
R-200-U	U - TURN 200 FT AHEAD	4	
W-19	PAYEMENT NARROWS	1	
W-20	DIVIDED HIGHWAY AHEAD		1
W-21	DIVIDED HIGHWAY END	1	1
TOTALS		32	2
SIGNS TO BE SALVAGED W-41 & R-14 (INCIDENTAL)			

DATE	_____
SURVEY PLOTTED BY	_____
DESIGNED BY	_____
DRAWN BY	_____
CHECKED BY	_____
NOTE BOOK NO.	_____

TERRITORIAL HIGHWAY DEPARTMENT
TERRITORY OF HAWAII
LAYOUT OF
REGULATORY & WARNING
SIGNS
PAYEMENT MARKINGS
NUUANU AVENUE
PROJ. NO. US 0610 (2)
Scale: 1" = 20' Mar. 1956

SHEET No. 2 OF 2 SHEETS

5819.18