


INDEX TO DRAWINGS	
SHEET NO.	DESCRIPTION
1	Title Sheet
2	Typical Sections
3-5	Plan and Profile
6-7	Pavement Grades
8-11	Utilities-Highway Lighting
12-16	Water
17-18	Regulatory & Warning Signs
19	Retaining Walls
20-21	Landscaping
22-27	Standard Details
28-31	Adjustment of R/W
32-36	Cross Sections

CONVENTIONAL SIGNS	
Centerline	125
Boundary Lines	or
Fences (Named)	
Existing Roadways	
Circular Culvert	
Box Culvert	
Bridge	
Telephone Pole	T.P.
Electric Power Pole	E.P.
Water Main	W ₂ (W. 4, 8, 12, Etc.)
Storm Drain	SD ₁₂ (SD 12, 24, Etc.)
Concrete Drop Intake	C.D.I.
Standard Catch Basin	S.C.B.
Standard Manhole	M.H.
Sewer Manhole	S.M.H.
Telephone Manhole	T.M.H.
Fire Hydrant	F.H.
Tree (Large, named)	Mango, Cocoa
Railroad	
Haw. Telephone Underground Cable	HTC
Water Meter	WM

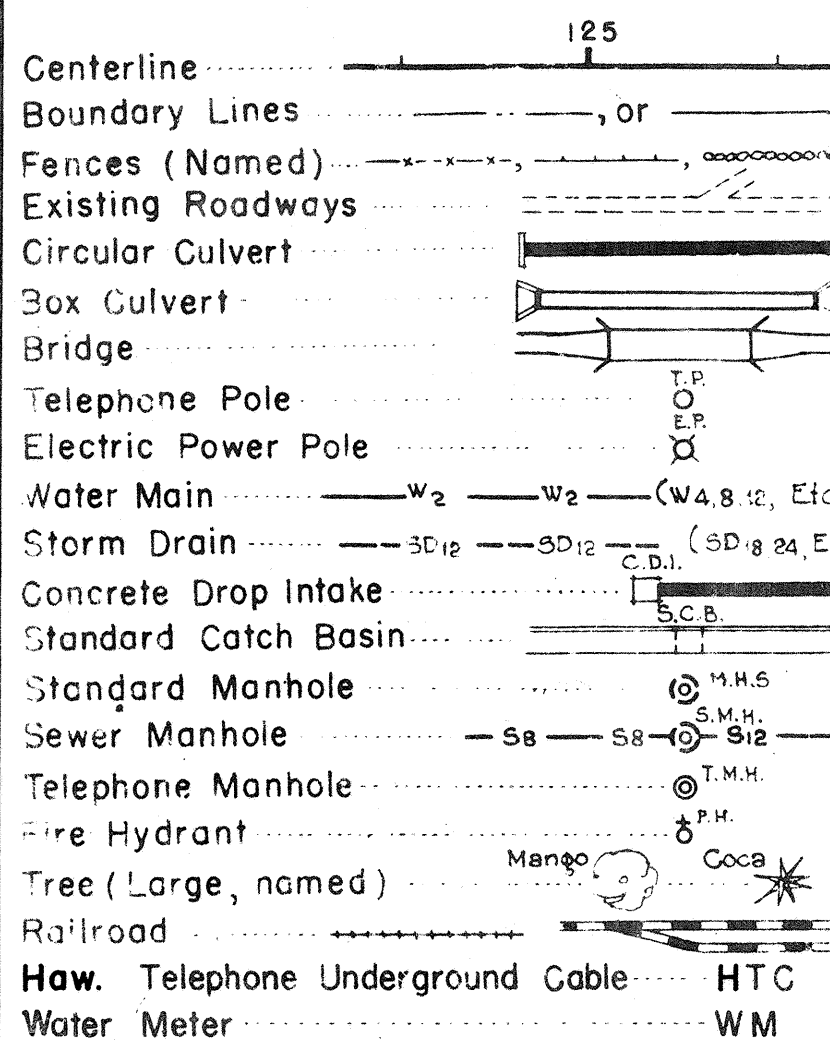

TERRITORY OF HAWAII
TERRITORIAL HIGHWAY DEPARTMENT
HONOLULU, OAHU, T. H.



"AS BUILT" PLANS OF NUUANU AVENUE

FEDERAL AID SECONDARY PROJECT NO. US 0610(2)

DISTRICT OF HONOLULU ISLAND OF OAHU

SCALES


PLAN	1" = 20'-0"
PROFILE	HOR 1" = 20'-0" VER 1" = 10'-0"
CROSS SECTION	HOR 1" = 10'-0" VER 1" = 10'-0"

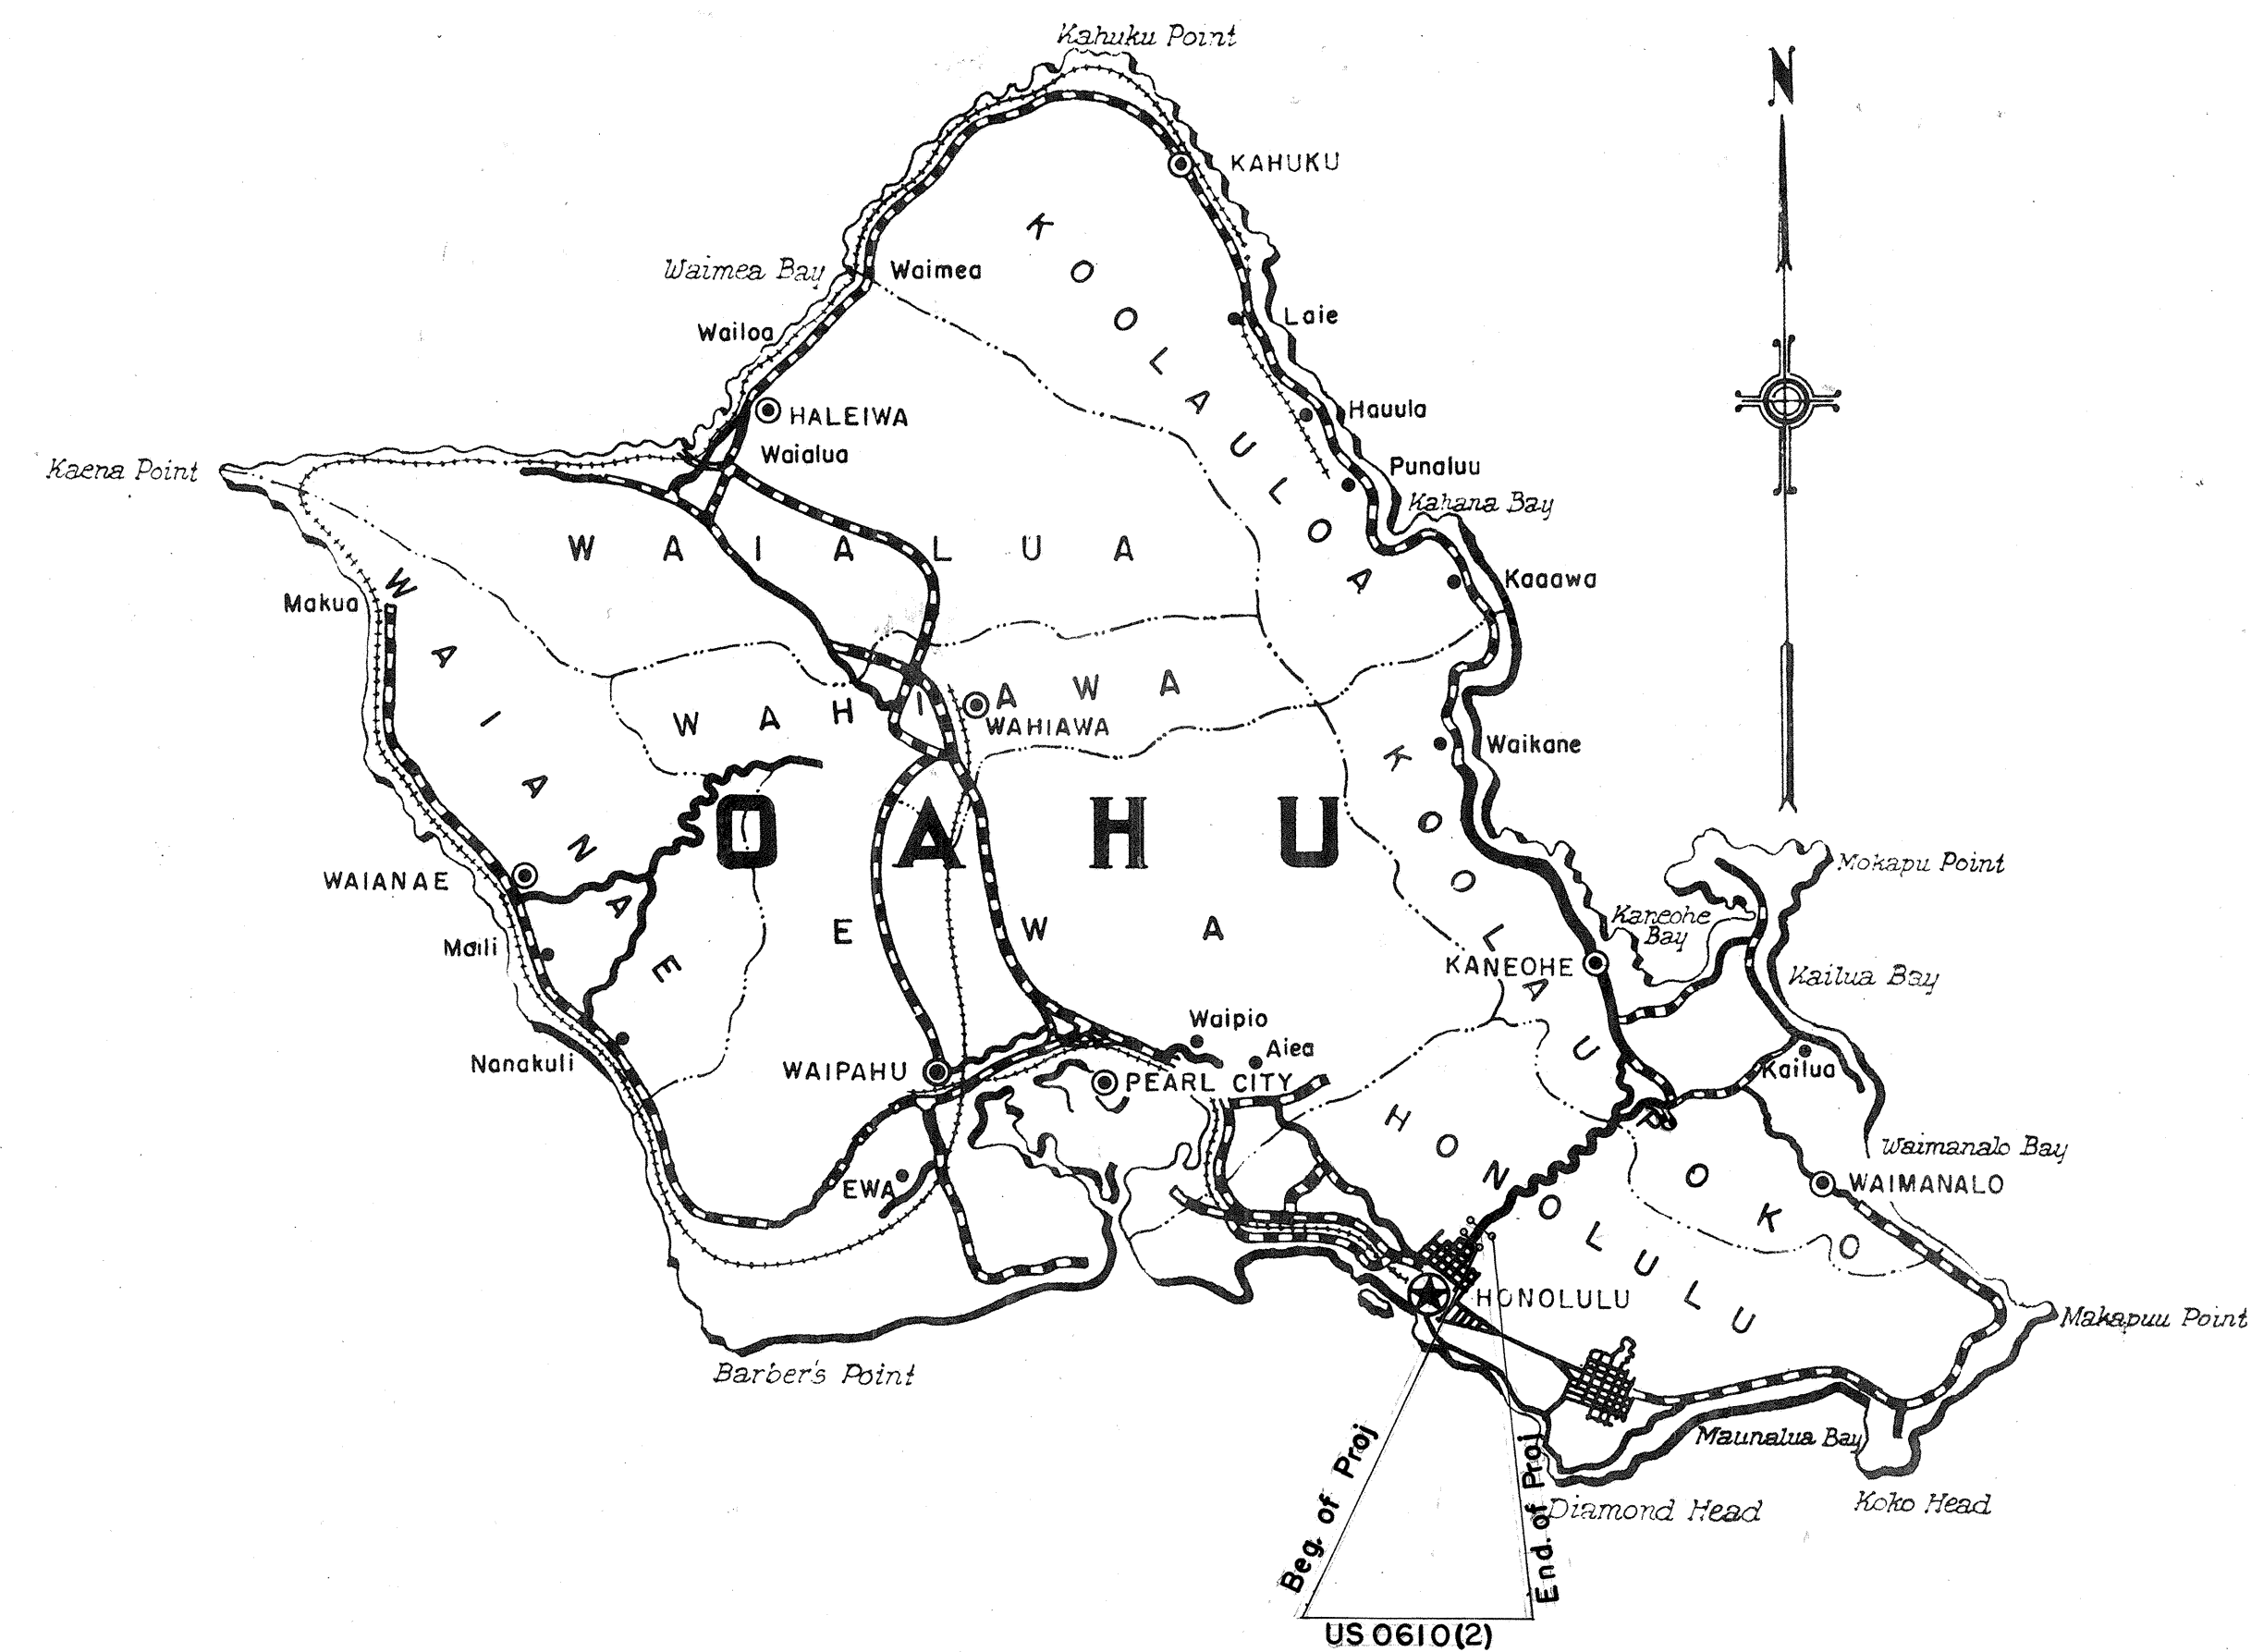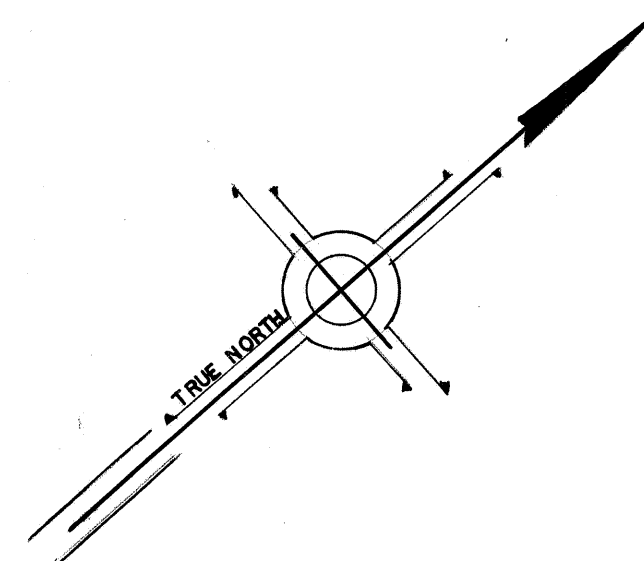

Federal Aid Projects Previously Constructed Or Under Construction

NOTE:
ALL CHANGES MADE DURING CONSTRUCTION
HAVE BEEN NOTED IN RED ON THESE TRACINGS
AND CHECKED BY:

Ted R. Lopez
RESIDENT ENGINEER
Jan. 7, 1958
DATE

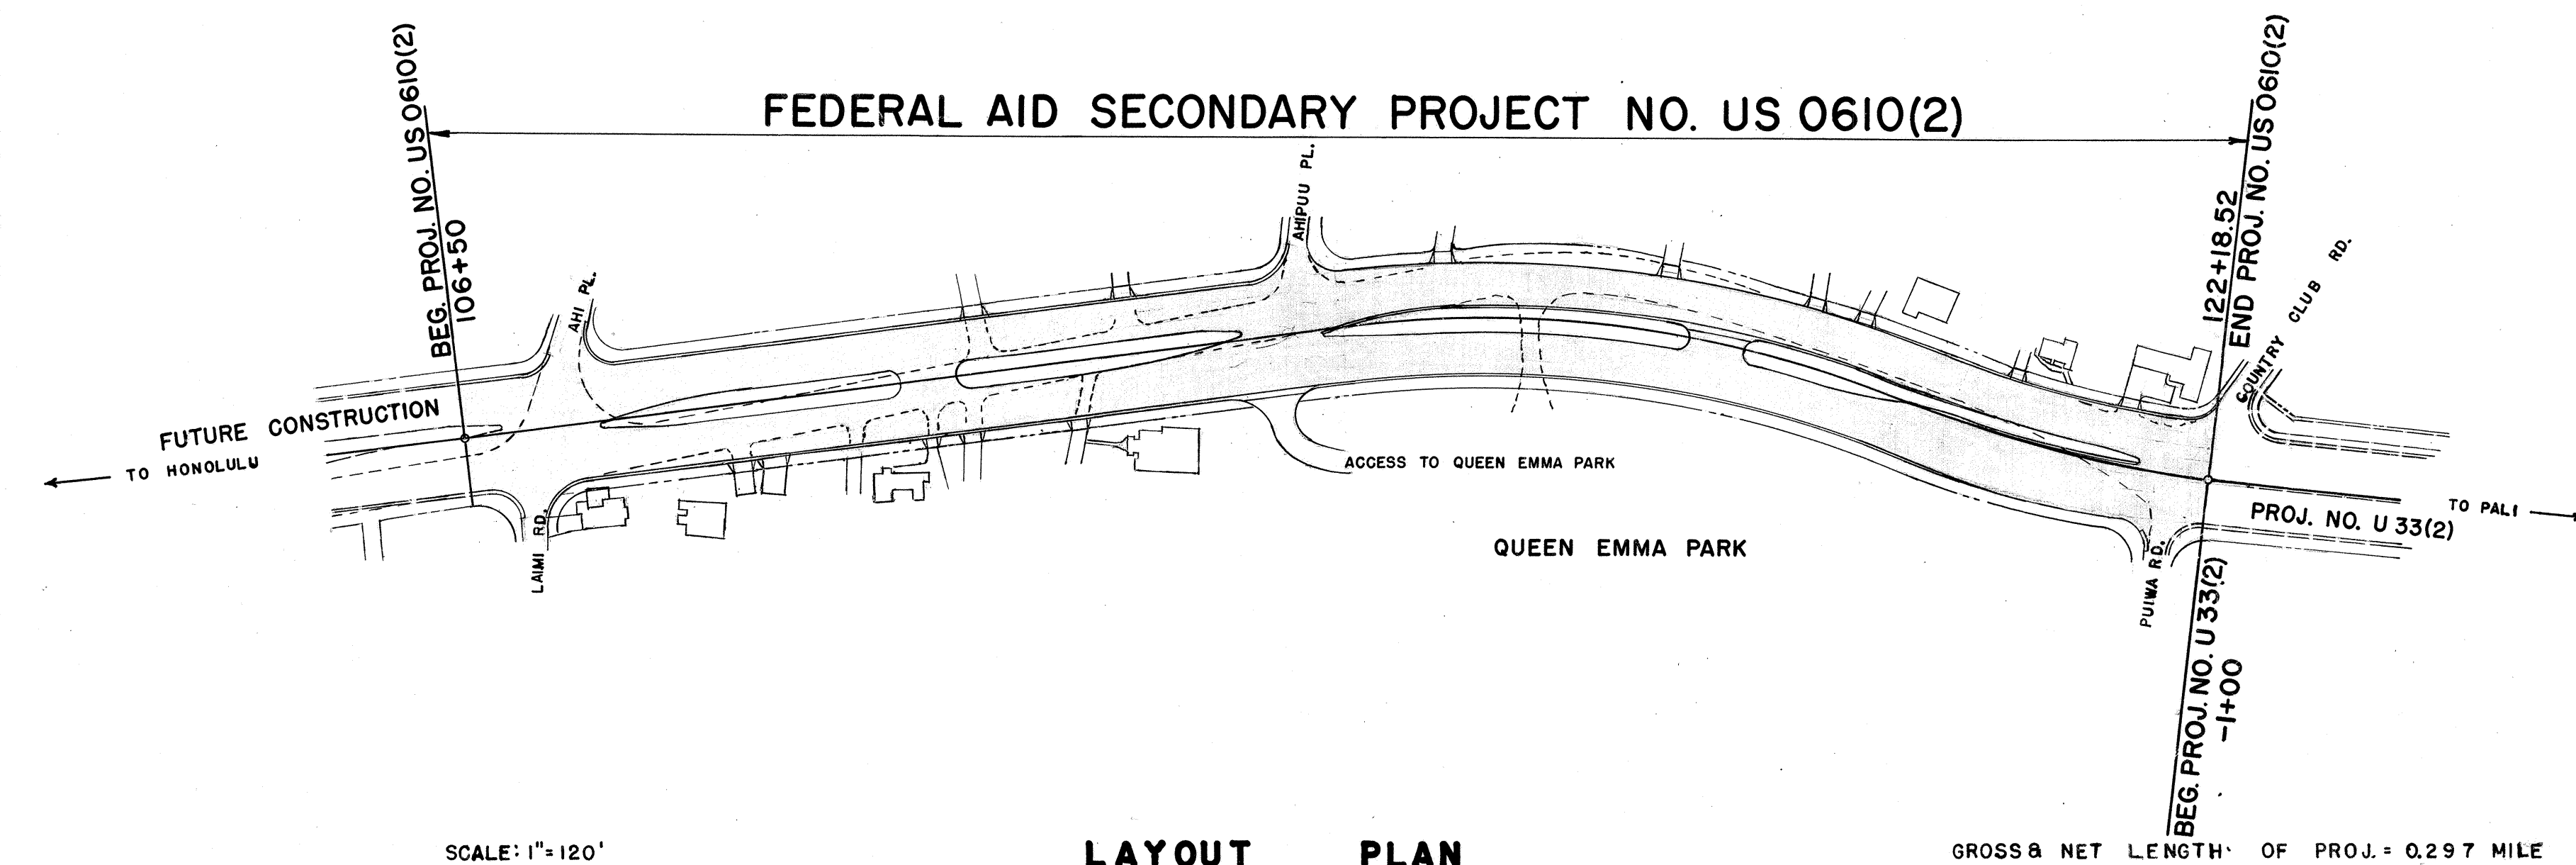

LAYOUT PLAN

GROSS & NET LENGTH OF PROJ. = 0.297 MILE

APPROVED *R. E. Nathan* DATE **5/3/56**
TERRITORIAL HIGHWAY ENGINEER

DEPARTMENT OF COMMERCE
BUREAU OF PUBLIC ROADS
APPROVED _____
DISTRICT ENGINEER DATE