
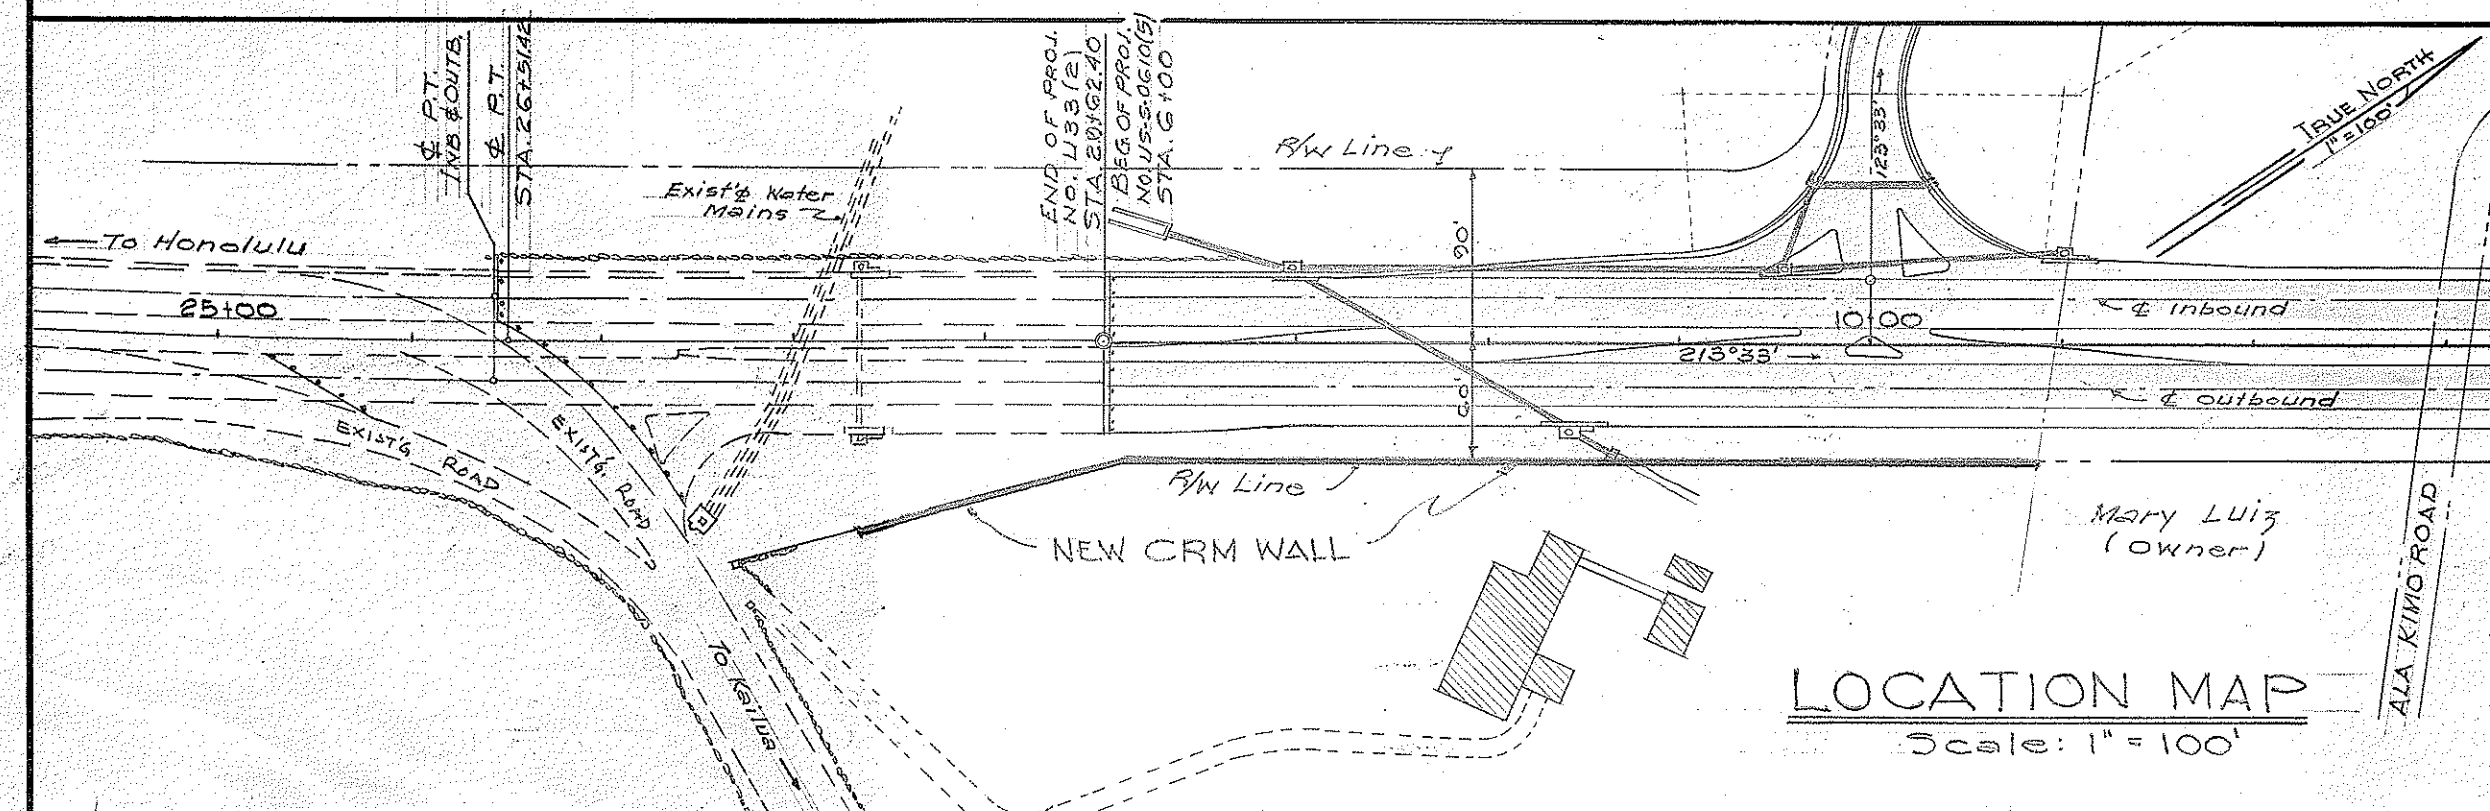


FED. ROAD DIST. No.	STATE	FED. AID PROJ. No.	FISCAL YEAR	SHEET No.	TOTAL SHEETS

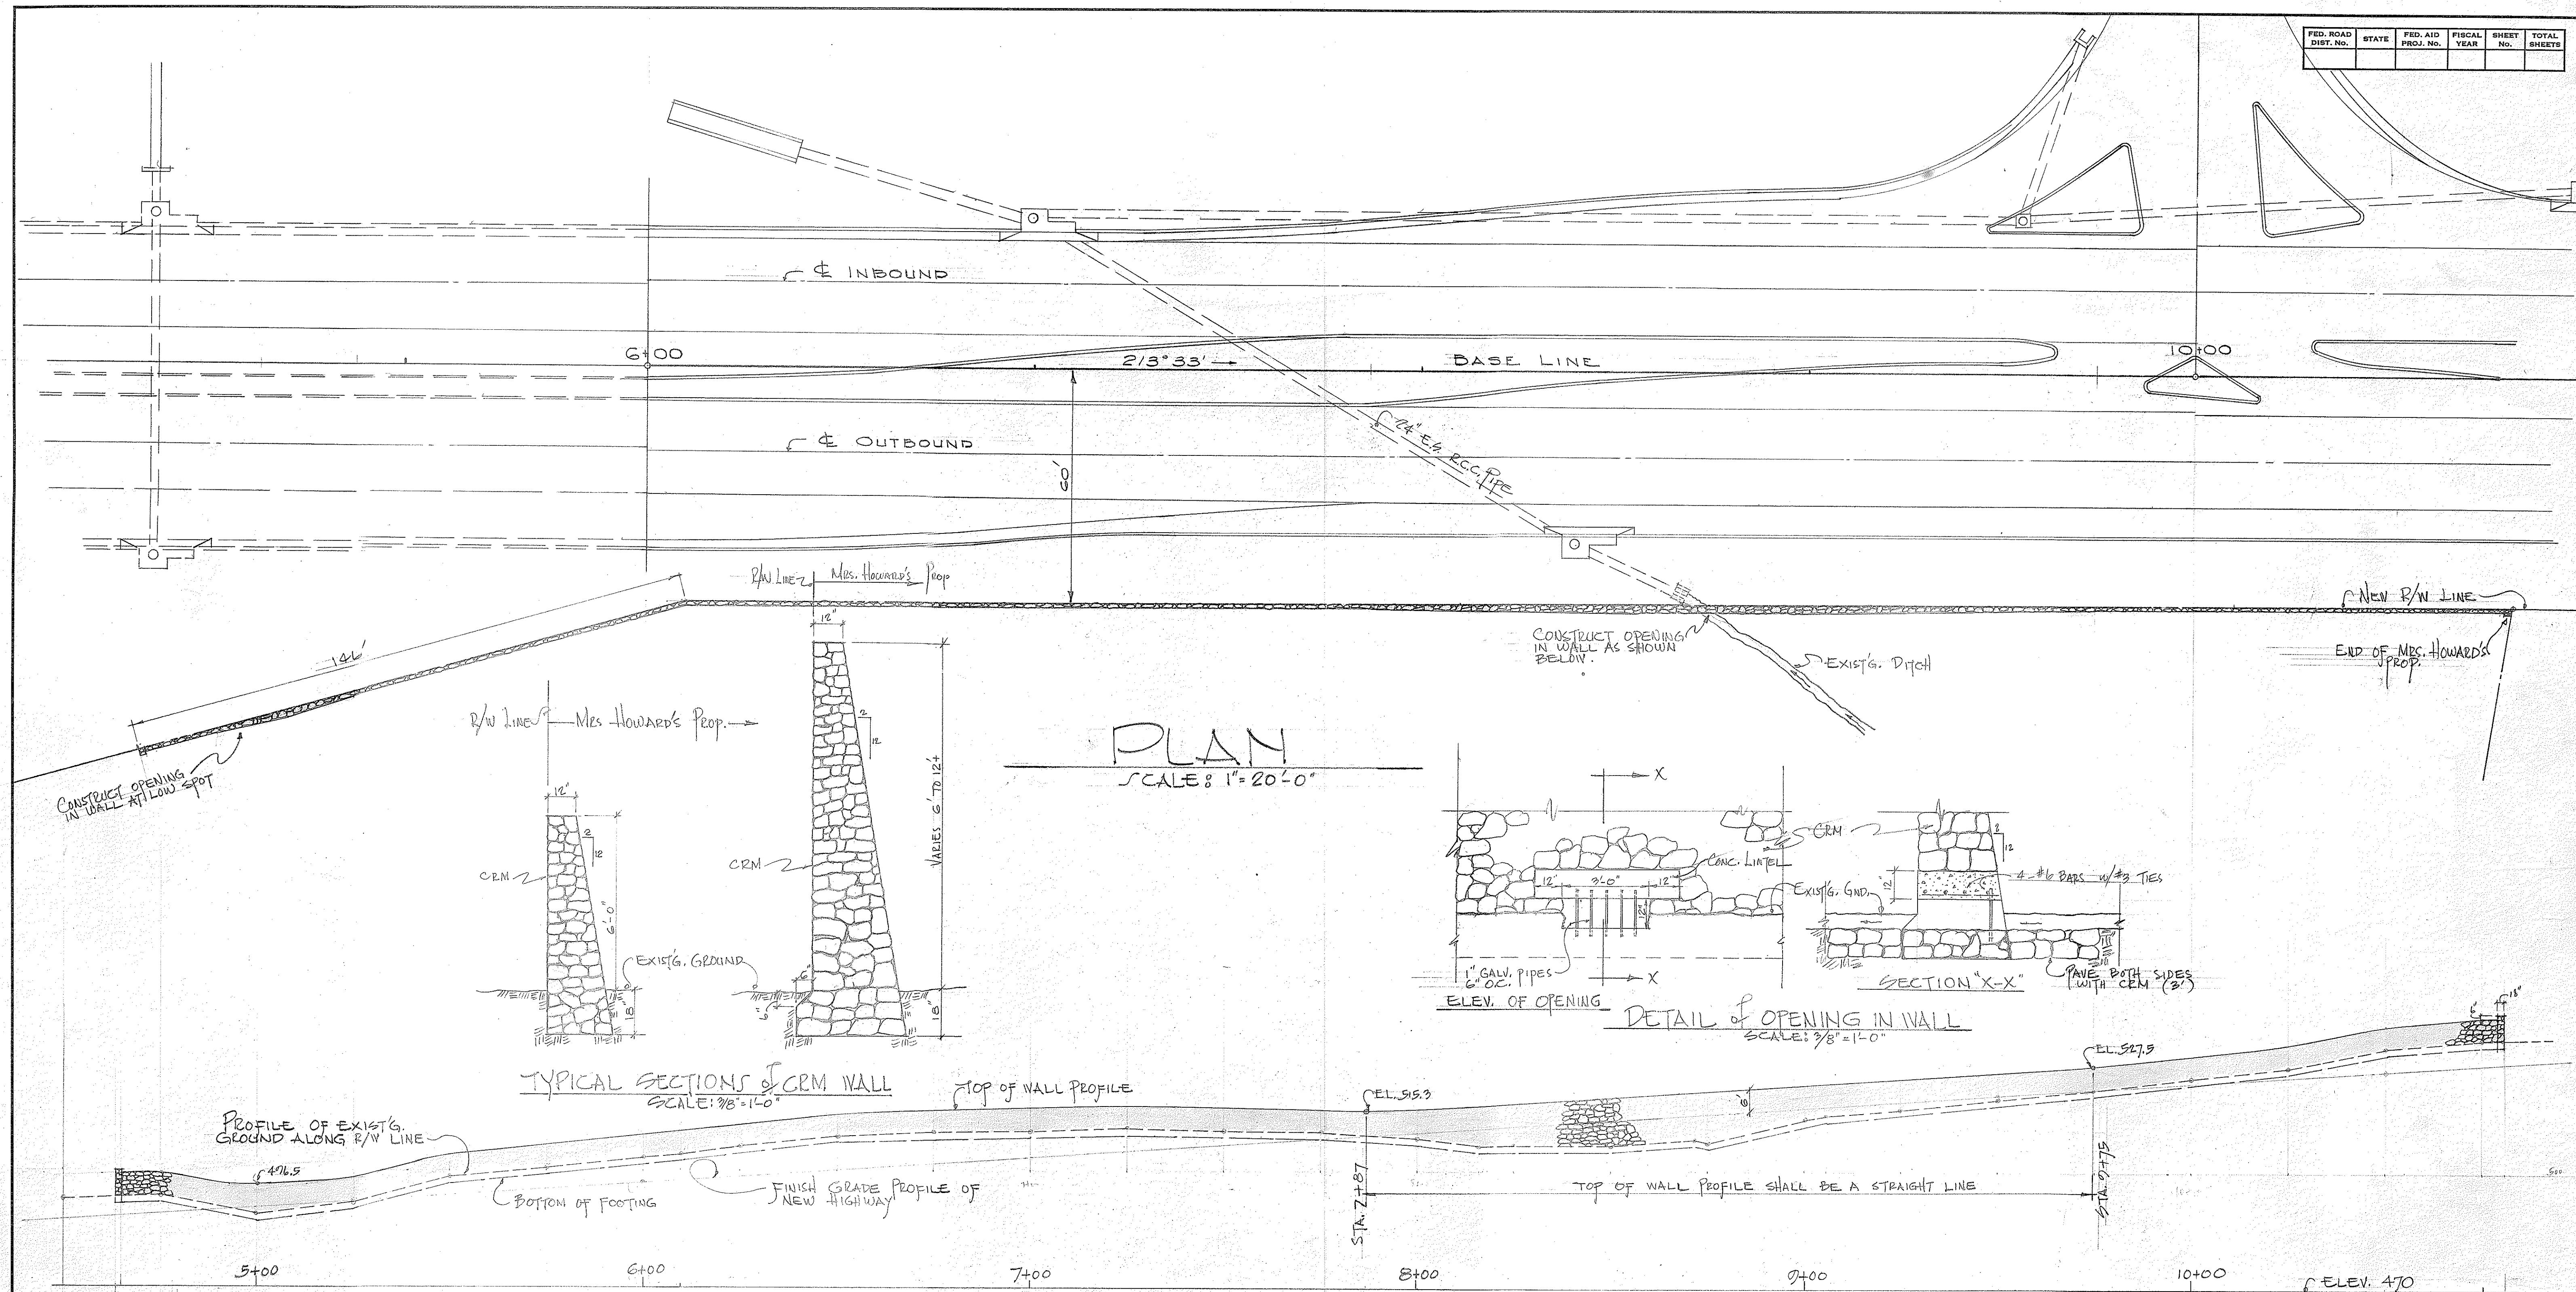

ELEVATION
SCALE: 1" = 20'-0"

GENERAL NOTES:

1. UNLESS SPECIFIED OTHERWISE THE 6' HIGH WALL SHALL FOLLOW THE EXIST. GROUND PROFILE.
2. THE TOP OF WALL PROFILE SHALL BE ROUNDED AT ALL BREAKS.
3. STATIONS BASED ON HIGHWAY BASELINE STATIONS

TERRITORIAL HIGHWAY DEPARTMENT
TERRITORY OF HAWAII

CONSTRUCTION OF NEW
CEMENT RUBBLE MASONRY
WALL ON LOT TAX KEY: 1-9-02:10

UOP No. 5888

SCALE: AS NOTED JAN. 1957

SHEET No. 1 OF 1 SHEETS