


INDEX TO DRAWINGS	
SHEET NO.	DESCRIPTION
1	TITLE SHEET
2-4	TYPICAL SECTIONS
5-12	PLAN & PROFILE
13	SOIL PROFILE
14-16	INTERSECTION DETAILS
17	WATER
18-19	WATER STANDARD DETAILS
20-21	DRAINAGE DETAILS
22-23	BOX CULVERT
30-48	CROSS SECTIONS

CONVENTIONAL SIGNS	
Baseline	125
Boundary Lines	or
Fences (Named)	
Existing Roadways	
Circular Culvert	
Box Culvert	
Bridge	
Telephone Pole	
Electric Power Pole	
Water Main	W ₂ W ₂ (W ₄ , 8, 12, Etc.)
Storm Drain	SD ₁₂ SD ₁₂ (SD ₁₈ , 24, Etc.)
Concrete Drop Intake	
Standard Catch Basin	
Standard Manhole	M.H.S.
Sewer Manhole	Sa Sa (S ₁₂)
Telephone Manhole	T.M.H.
Fire Hydrant	P.H.
Tree (Large, named)	Mango
Railroad	
Haw'n. Telephone Underground Cable	HTC
Water Meter	WM
Wood Guard Rail With Conc. Posts	

TERRITORY OF HAWAII
TERRITORIAL HIGHWAY DEPARTMENT
HONOLULU, OAHU, T. H.
AS BUILT
PLANS OF

PALI ROAD FEDERAL AID PROJECT NO. BF-BU-061-1(2) DISTRICT OF HONOLULU ISLAND OF OAHU

SCALE	
PLAN	1 INCH = 50 FEET
PROFILE	1 INCH = 50 FEET
	1 INCH = 10 FEET
CROSS SECTION	1 INCH = 10 FEET
	1 INCH = 10 FEET

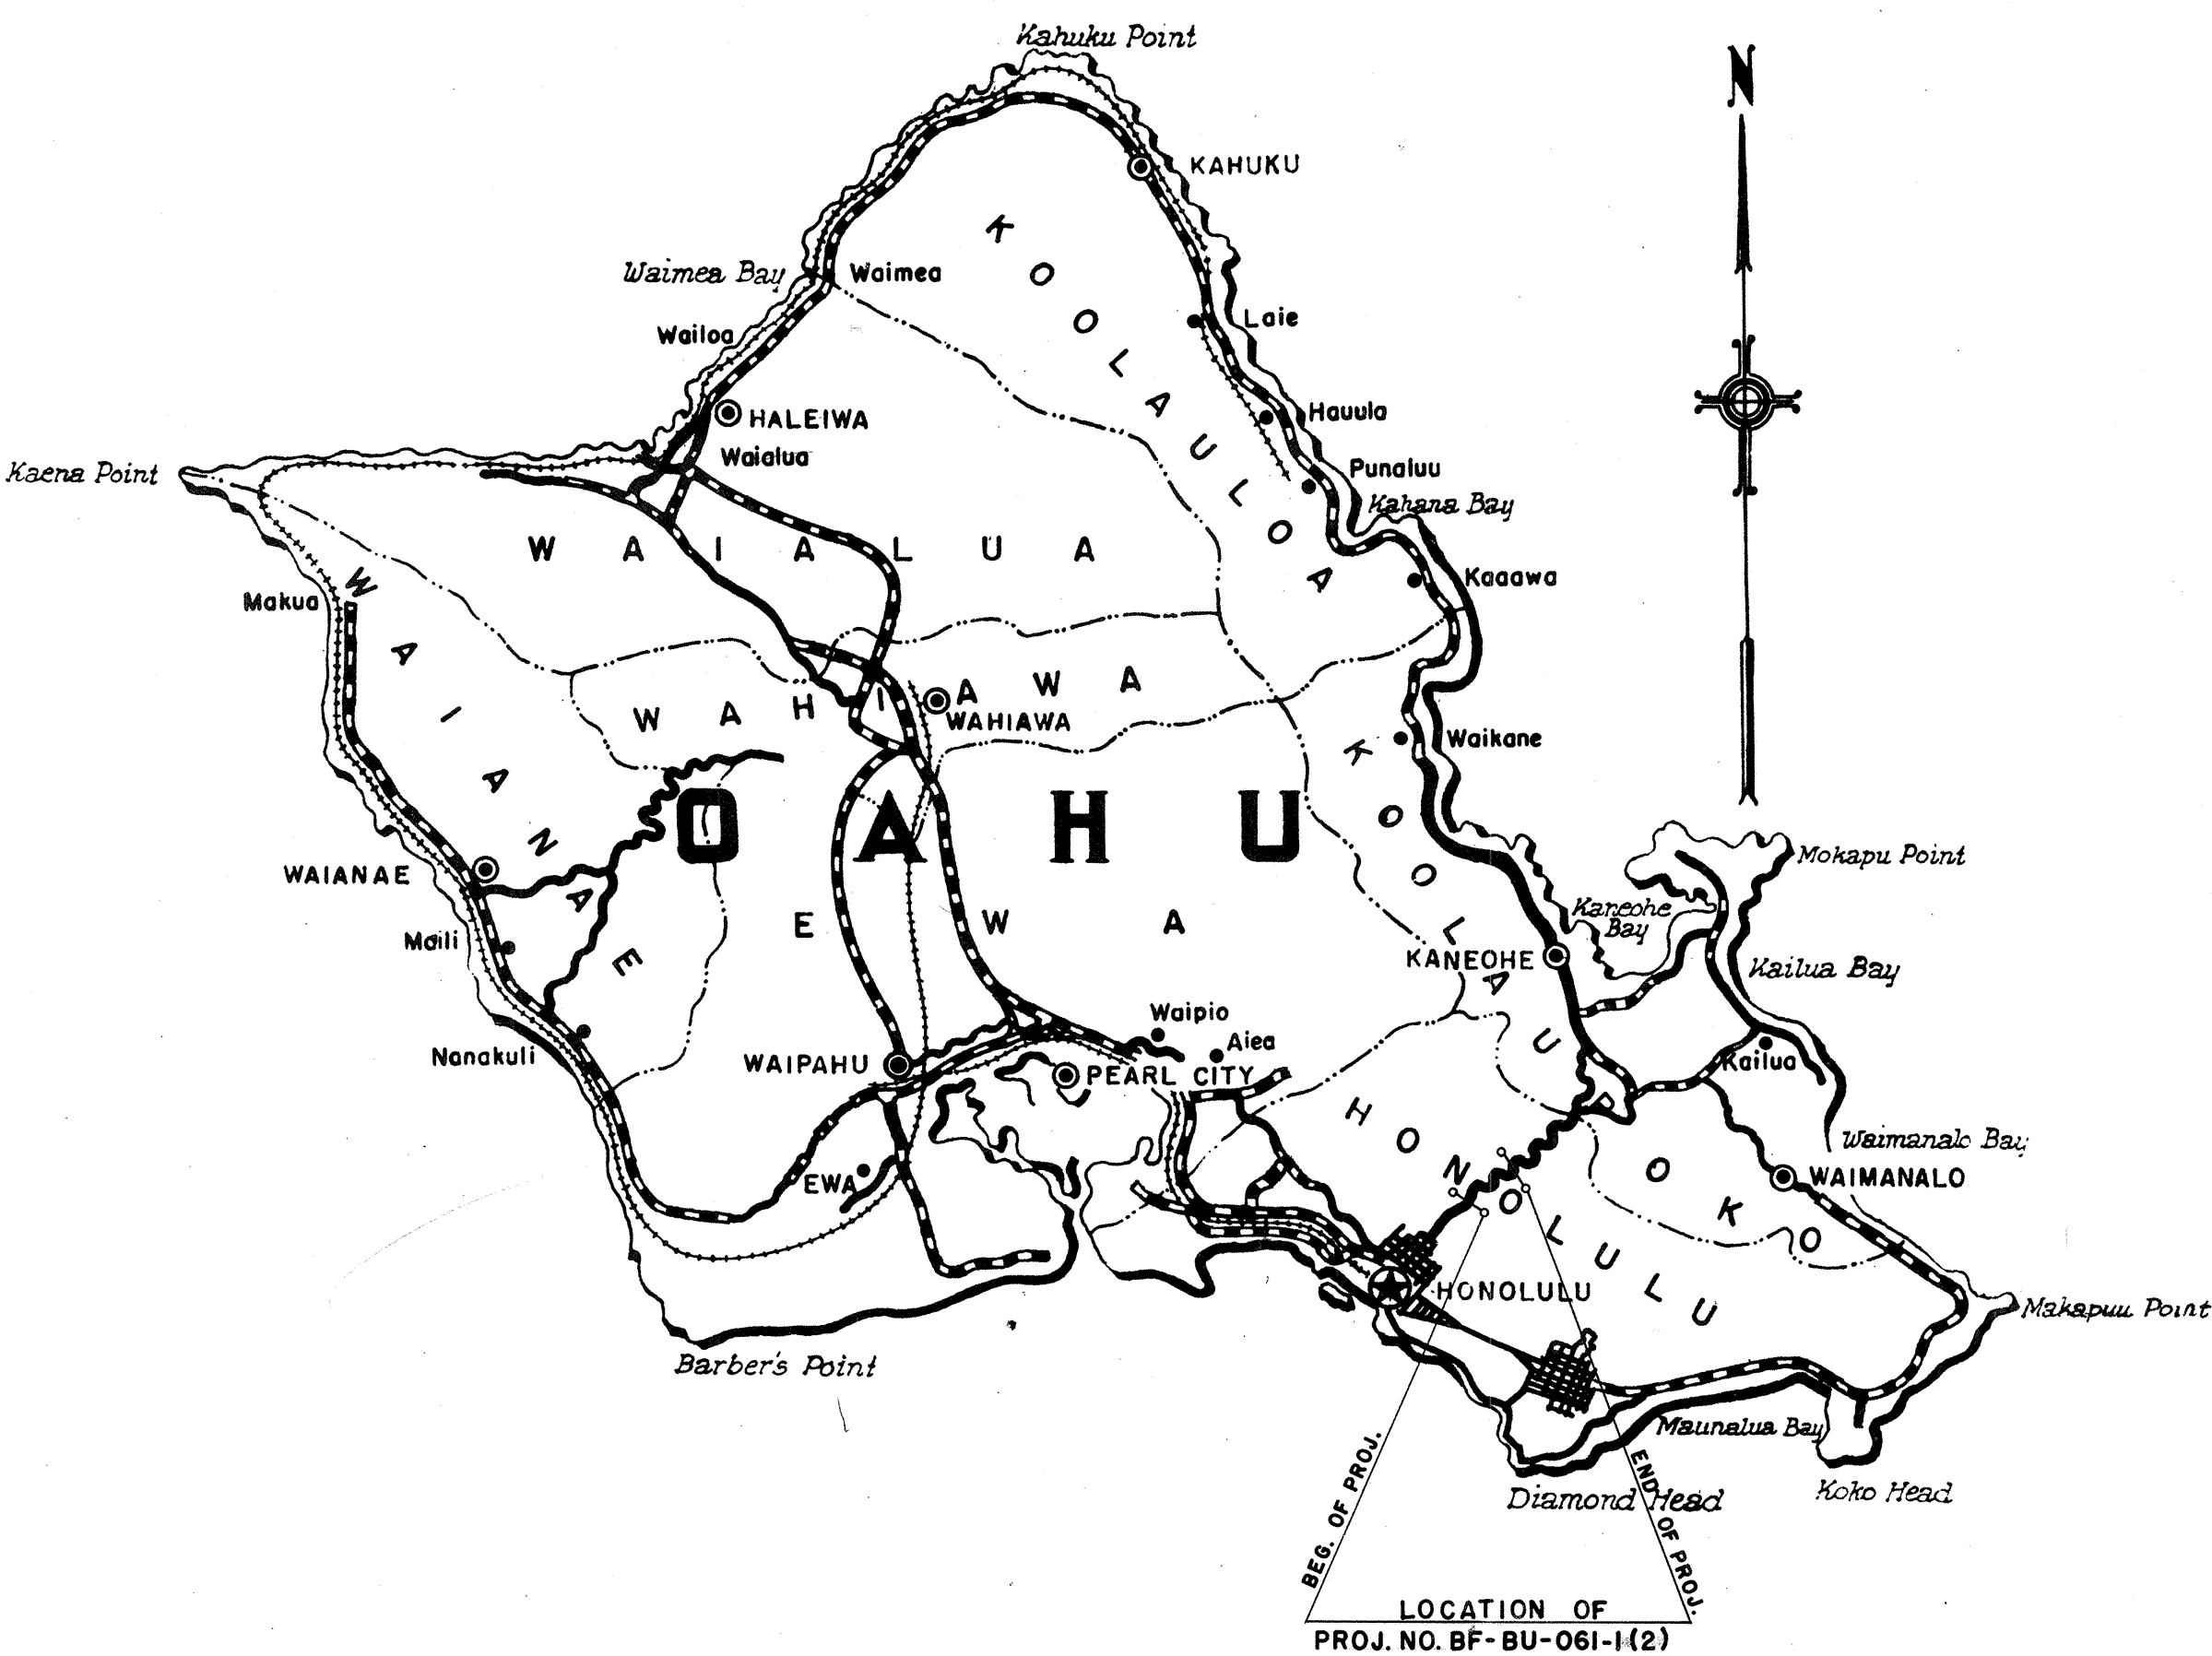

Federal Aid Projects Previously Constructed Or Under Construction


NOTE: ALL CHANGES MADE DURING CONSTRUCTION
HAVE BEEN NOTED IN RED ON THESE
TRACINGS AND CHECKED BY:

R. W. Hendry
DISTRICT ENGINEER
12-4-59
DATE

APPROVED: DATE 4/3/57
Wm. Wachtel
TERRITORIAL HIGHWAY ENGINEER

DEPARTMENT OF COMMERCE
BUREAU OF PUBLIC ROADS
APPROVED:
DISTRICT ENGINEER DATE

DATE	
SURVEY PLOTTED BY	
DESIGNED BY	
DRAWN BY	
CHECKED BY	
NOTE BOOK	
QUANTITIES CHECKED BY	
CHECKED BY	

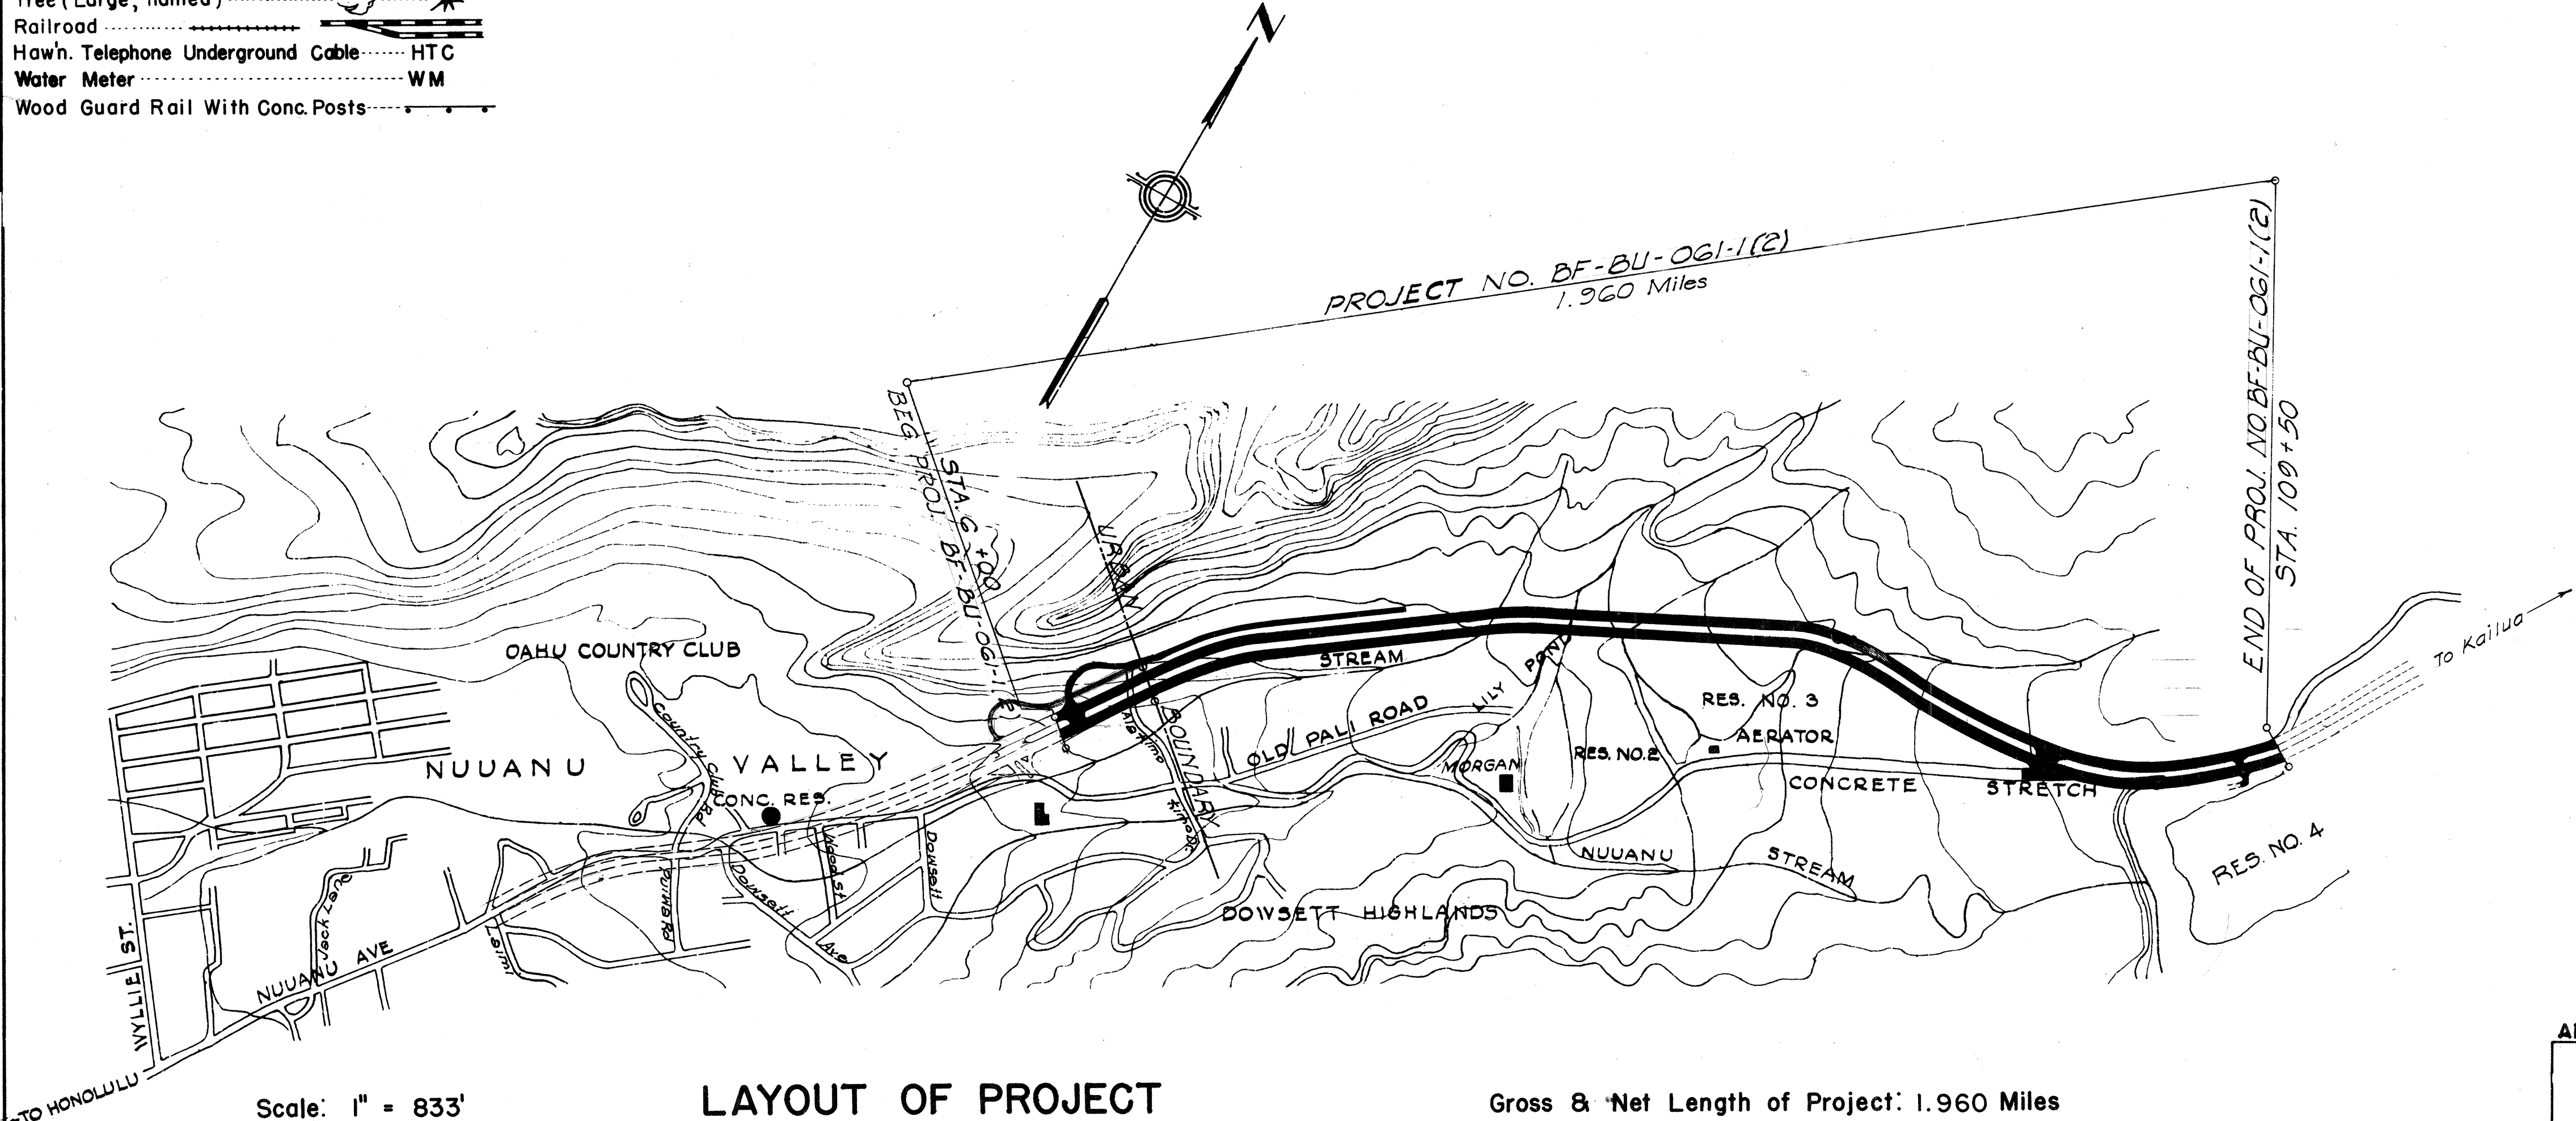

LAYOUT OF PROJECT

Gross & Net Length of Project: 1.960 Miles