


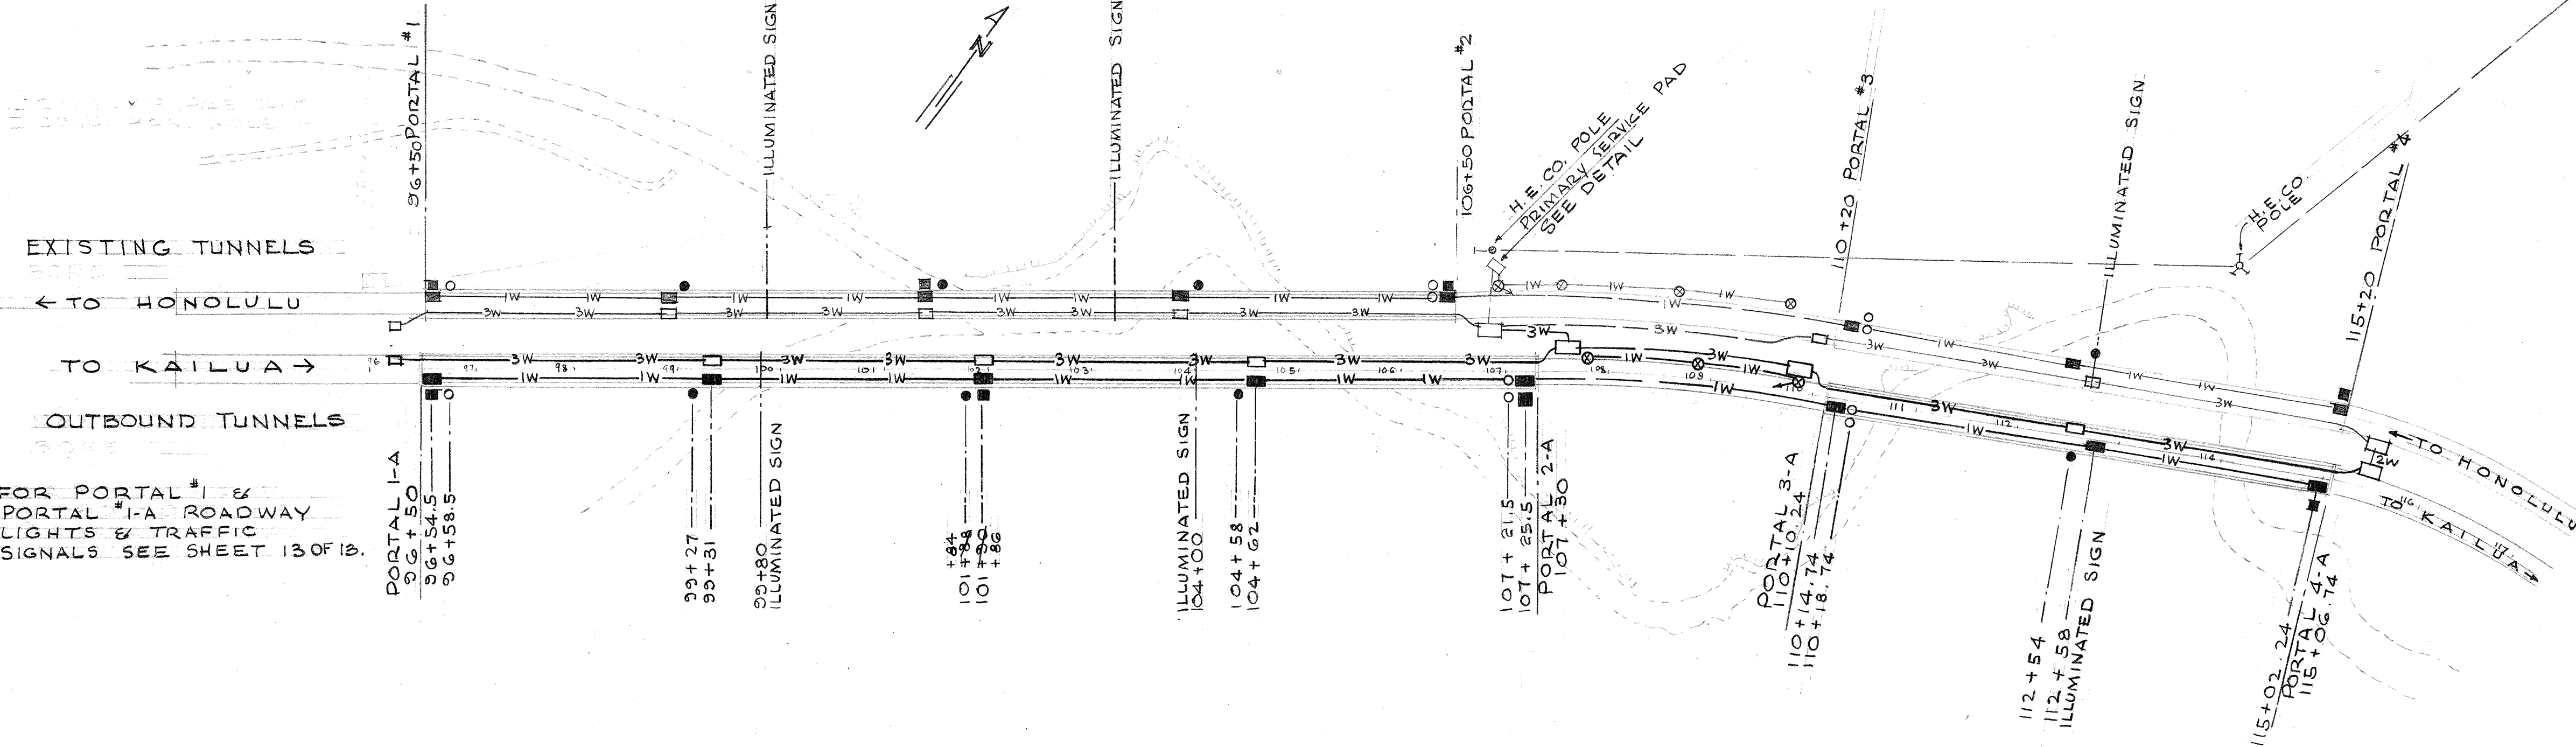

FOR PORTAL 1-A & PORTAL 1-A ROADWAY LIGHTS & TRAFFIC SIGNALS SEE SHEET 13 OF 13.

LEGEND



- H.T. CO. HANDHOLE
- H.T. CO. WALL PHONE BOX, FIRE EXTINGUISHER & EMERGENCY LIGHT STATION.
- H.T. CO. SIDEWALK JUNCTION BOX
- T.H.D. SIDEWALK ELECTRIC JUNCTION BOX
- T.H.D. HANDHOLE
- C.O. SAMPLER
- C.O. SIDEWALK OR WALL JUNCTION BOX.
- ⊗ ROADWAY LIGHT FOR STATION NUMBER SEE LIGHTING PLAN.
- ⊗ ROADWAY LIGHT WITH TRAFFIC SIGNAL
- 3W — CONDUIT RUN - 3W INDICATES 3-2" C, 2W INDICATES 2-2" C, ETC.

NOTE:
ELECTRICAL SYSTEM SHOWN ON THE INBOUND OR HONOLULU BOUND LANES IS EXISTING.

ELECTRICAL KEY MAP - OUTBOUND TUNNELS

SCALE: 1" = 100'-0"

SCHEDULE OF DRAWINGS	
SHEET	TITLE
1	ELECTRICAL KEY MAP & SCHEDULE OF DWGS.
2	ELECTRIC DISTRIBUTION SYSTEM
3	LIGHTING PLAN
4	LIGHTING CONTROLS SCHEMATIC DIAGRAMS
5	TUNNEL SECTION & TYPICAL LUMINAIRE WIRING
6	PORTAL 1-A
7	PORTAL 2-A & PORTAL 3-A
8	PORTAL 4-A
9	CARBON MONOXIDE SAMPLING SYSTEM
10	ELECTRICAL DETAILS
11	ELECTRICAL DETAILS
12	ELECTRICAL DETAILS
13	HIGHWAY LIGHTING, TRAFFIC LIGHTS LAYOUT & DETAILS

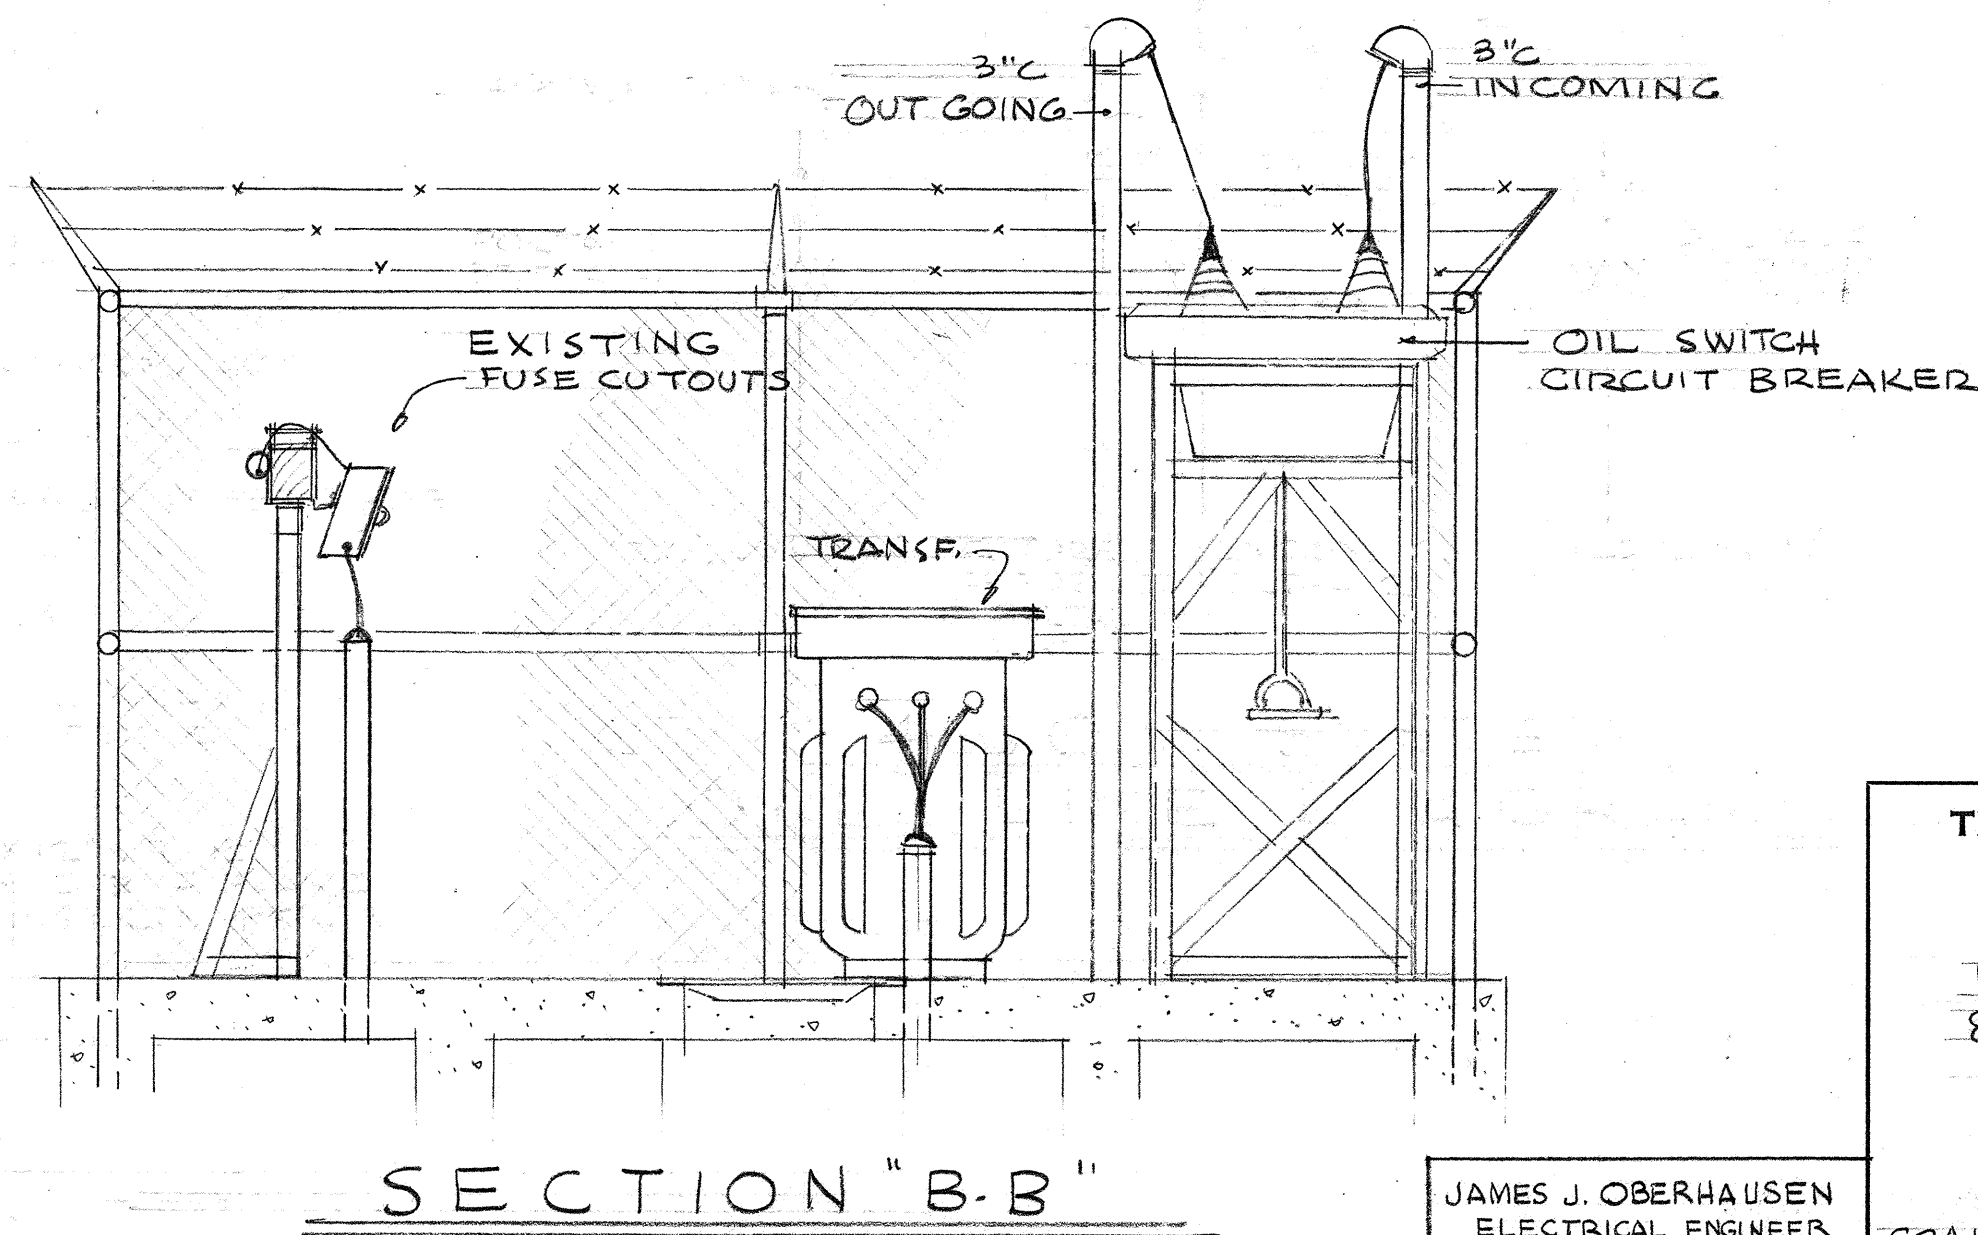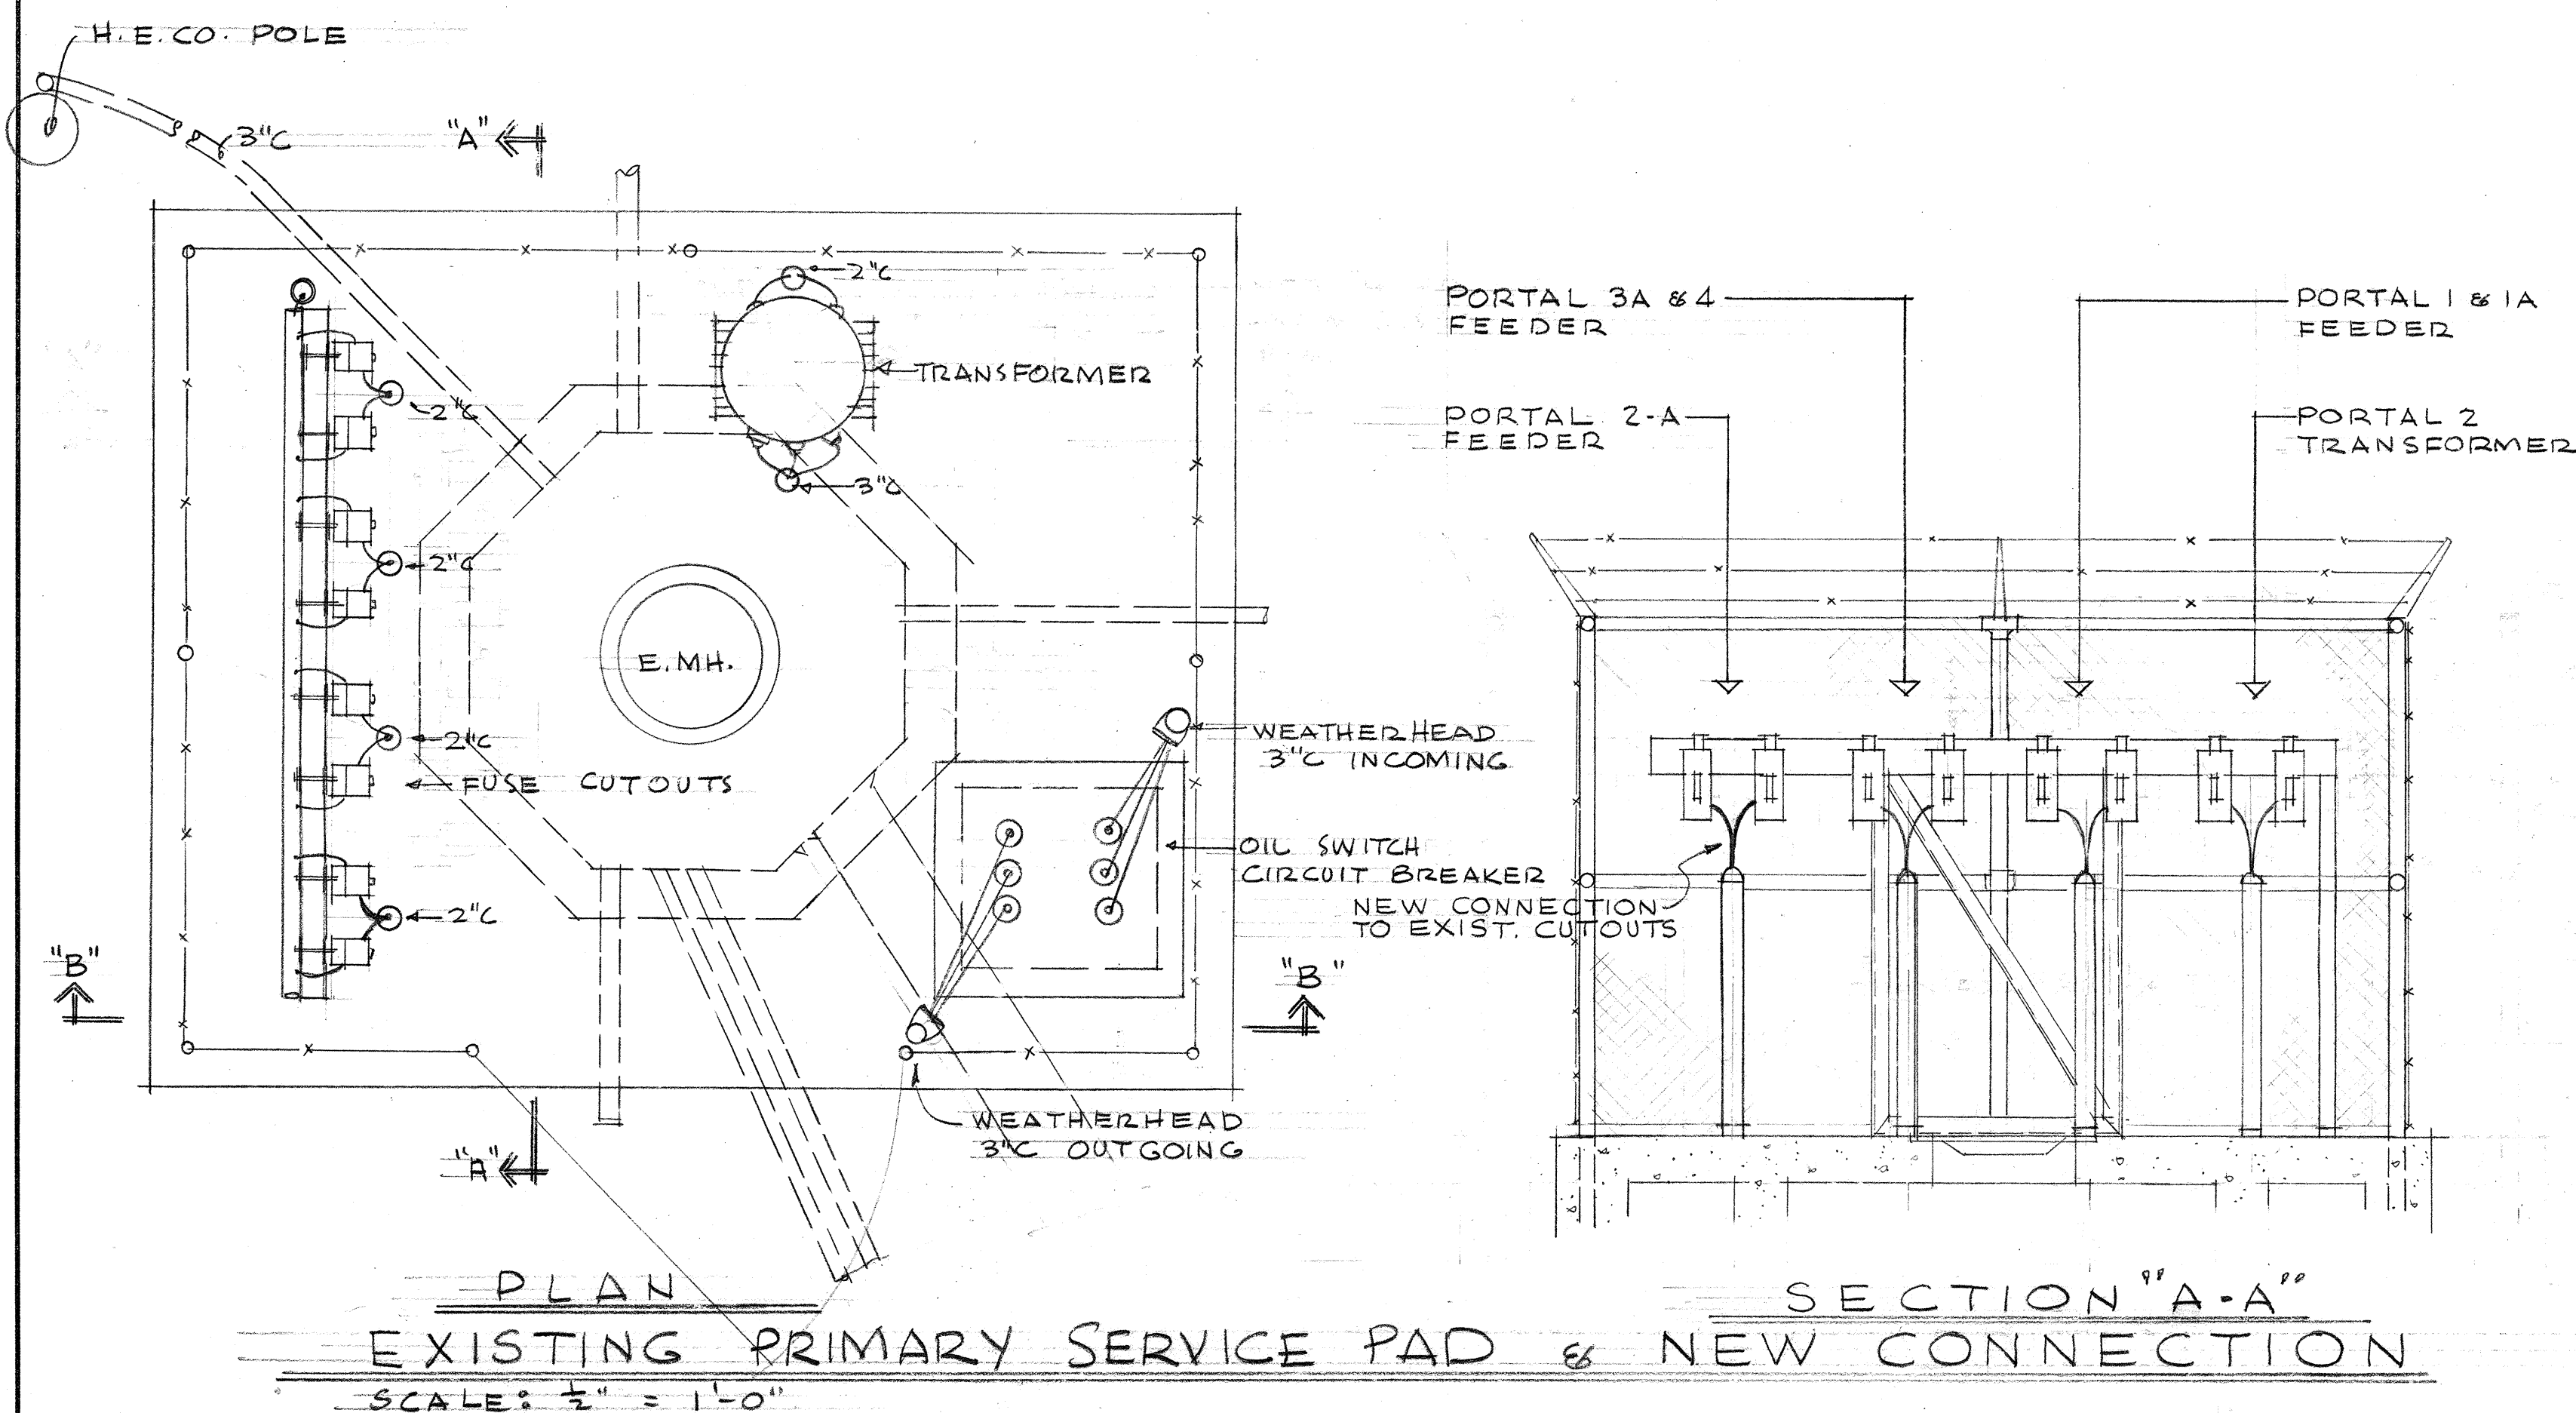

TERRITORIAL HIGHWAY DEPARTMENT
TERRITORY OF HAWAII

ELECTRICAL

ELECTRICAL KEY MAP
& SCHEDULE OF DWGS.

PALANI ROAD
OUTBOUND TUNNELS
PROJ. NO. BF-061-1(5)

JAMES J. OBERHAUSEN
ELECTRICAL ENGINEER

SCALE: AS NOTED DATE: MAY 1957

LEGEND

- H.T. CO. HANDHOLE
- H.T. CO. WALL PHONE BOX, FIRE EXTINGUISHER & EMERGENCY LIGHT STATION.
- H.T. CO. SIDEWALK JUNCTION BOX
- T.H.D. SIDEWALK ELECTRIC JUNCTION BOX
- T.H.D. HANDHOLE
- C.O. SAMPLER
- C.O. SIDEWALK OR WALL JUNCTION BOX
- ⊗ ROADWAY LIGHT FOR STATION NUMBER SEE LIGHTING PLAN.
- ⊗ ROADWAY LIGHT WITH TRAFFIC SIGNAL
- 3W — CONDUIT RUN - 3W INDICATES 3-2" C, 2W INDICATES 2-2" C, ETC.




NOTE: ELECTRICAL SYSTEM SHOWN ON THE INBOUND OR HONOLULU BOUND LANES IS EXISTING.

FOR TEMPORARY SIGNAL INSTALLATION AND HOOK-UP OUTSIDE PORTAL 4-A, SEE 5896.50
FOR WIRING DIAGRAM, SEE 5896.46

ELECTRICAL KEY MAP - OUTBOUND TUNNELS

SCALE: 1" = 100'-0"

SCHEDULE OF DRAWINGS	
SHEET	TITLE
1	ELECTRICAL KEY MAP & SCHEDULE OF DWGS.
2	ELECTRIC DISTRIBUTION SYSTEM
3	LIGHTING PLAN
4	LIGHTING CONTROLS SCHEMATIC DIAGRAMS
5	TUNNEL SECTION & TYPICAL LUMINAIRE WIRING
6	PORTAL 1-A
7	PORTAL 2-A & PORTAL 3-A
8	PORTAL 4-A
9	CARBON MONOXIDE SAMPLING SYSTEM
10	ELECTRICAL DETAILS
11	ELECTRICAL DETAILS
12	ELECTRICAL DETAILS
13	HIGHWAY LIGHTING, TRAFFIC LIGHTS LAYOUT & DETAILS

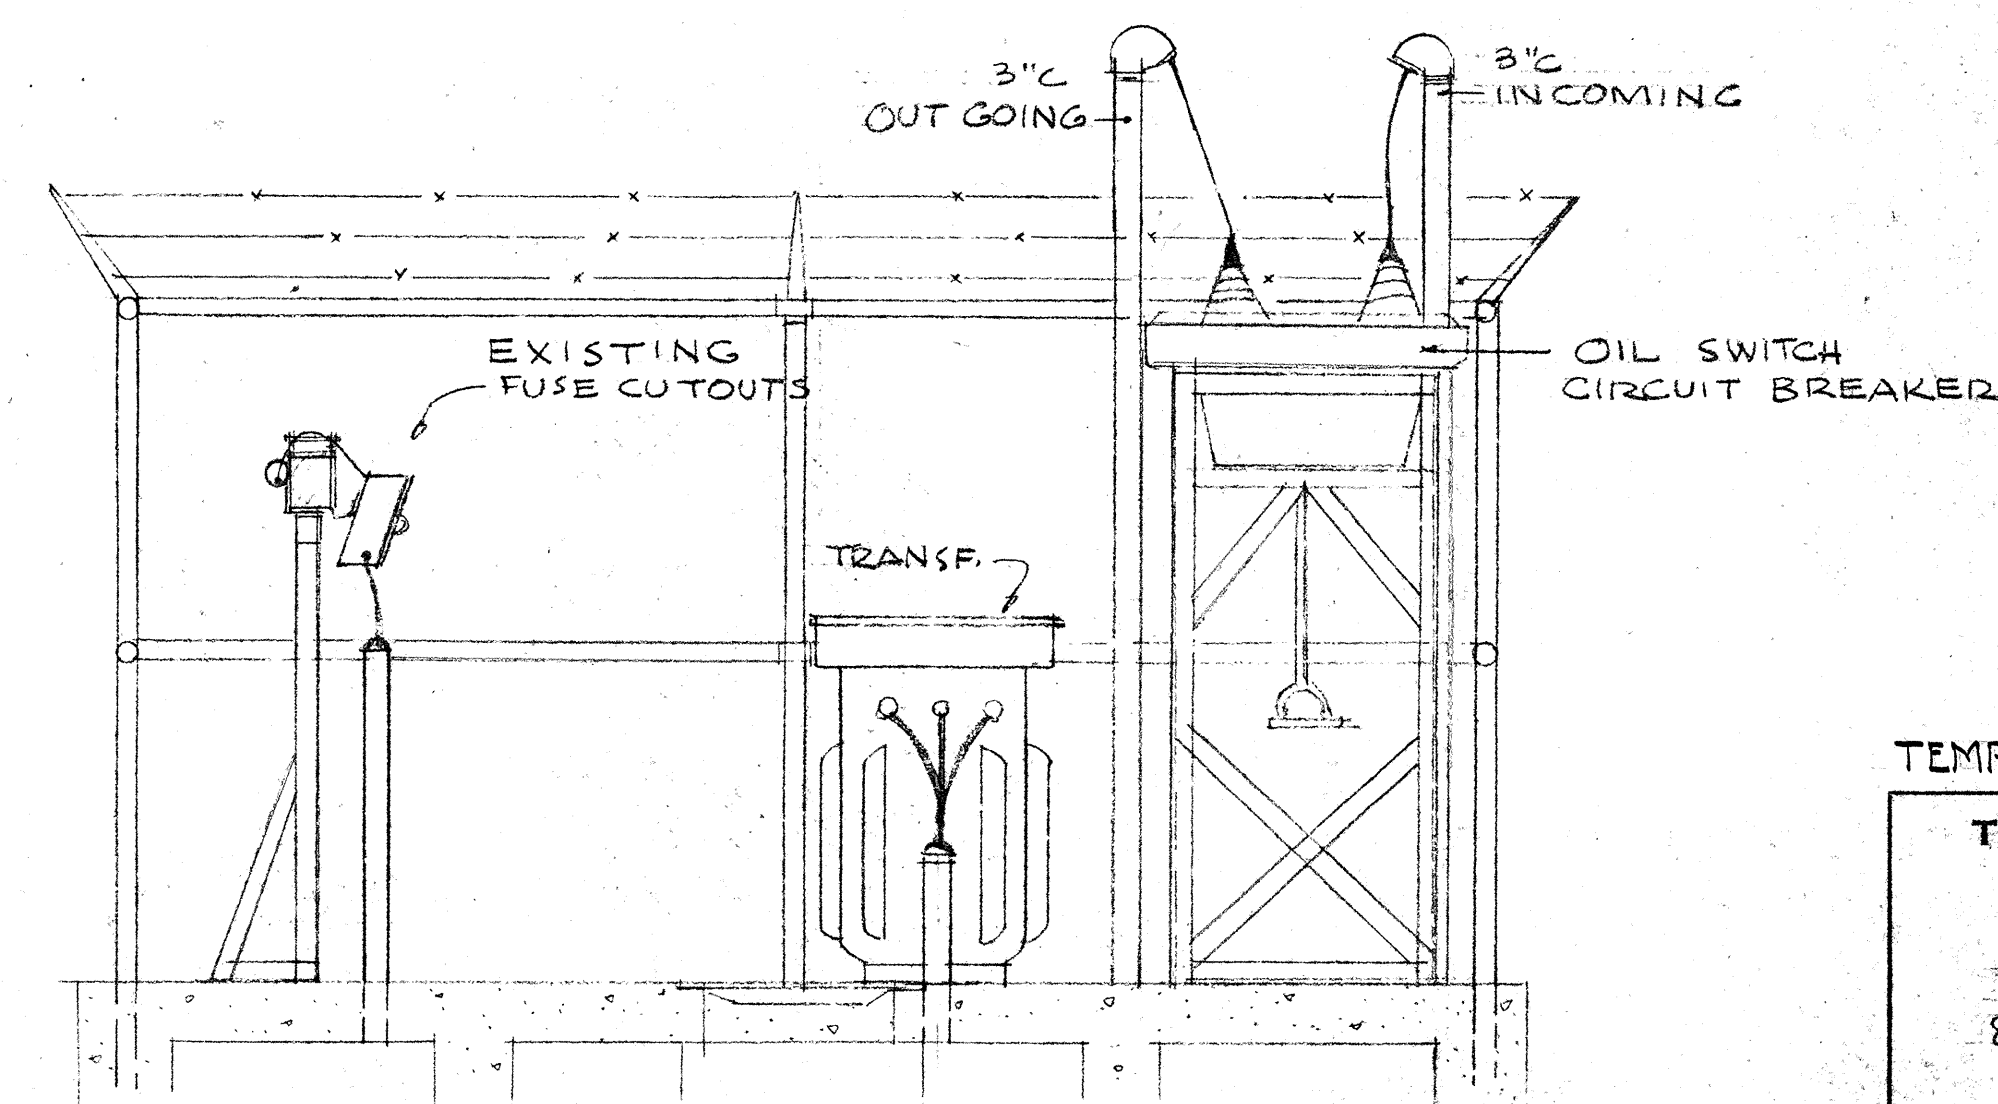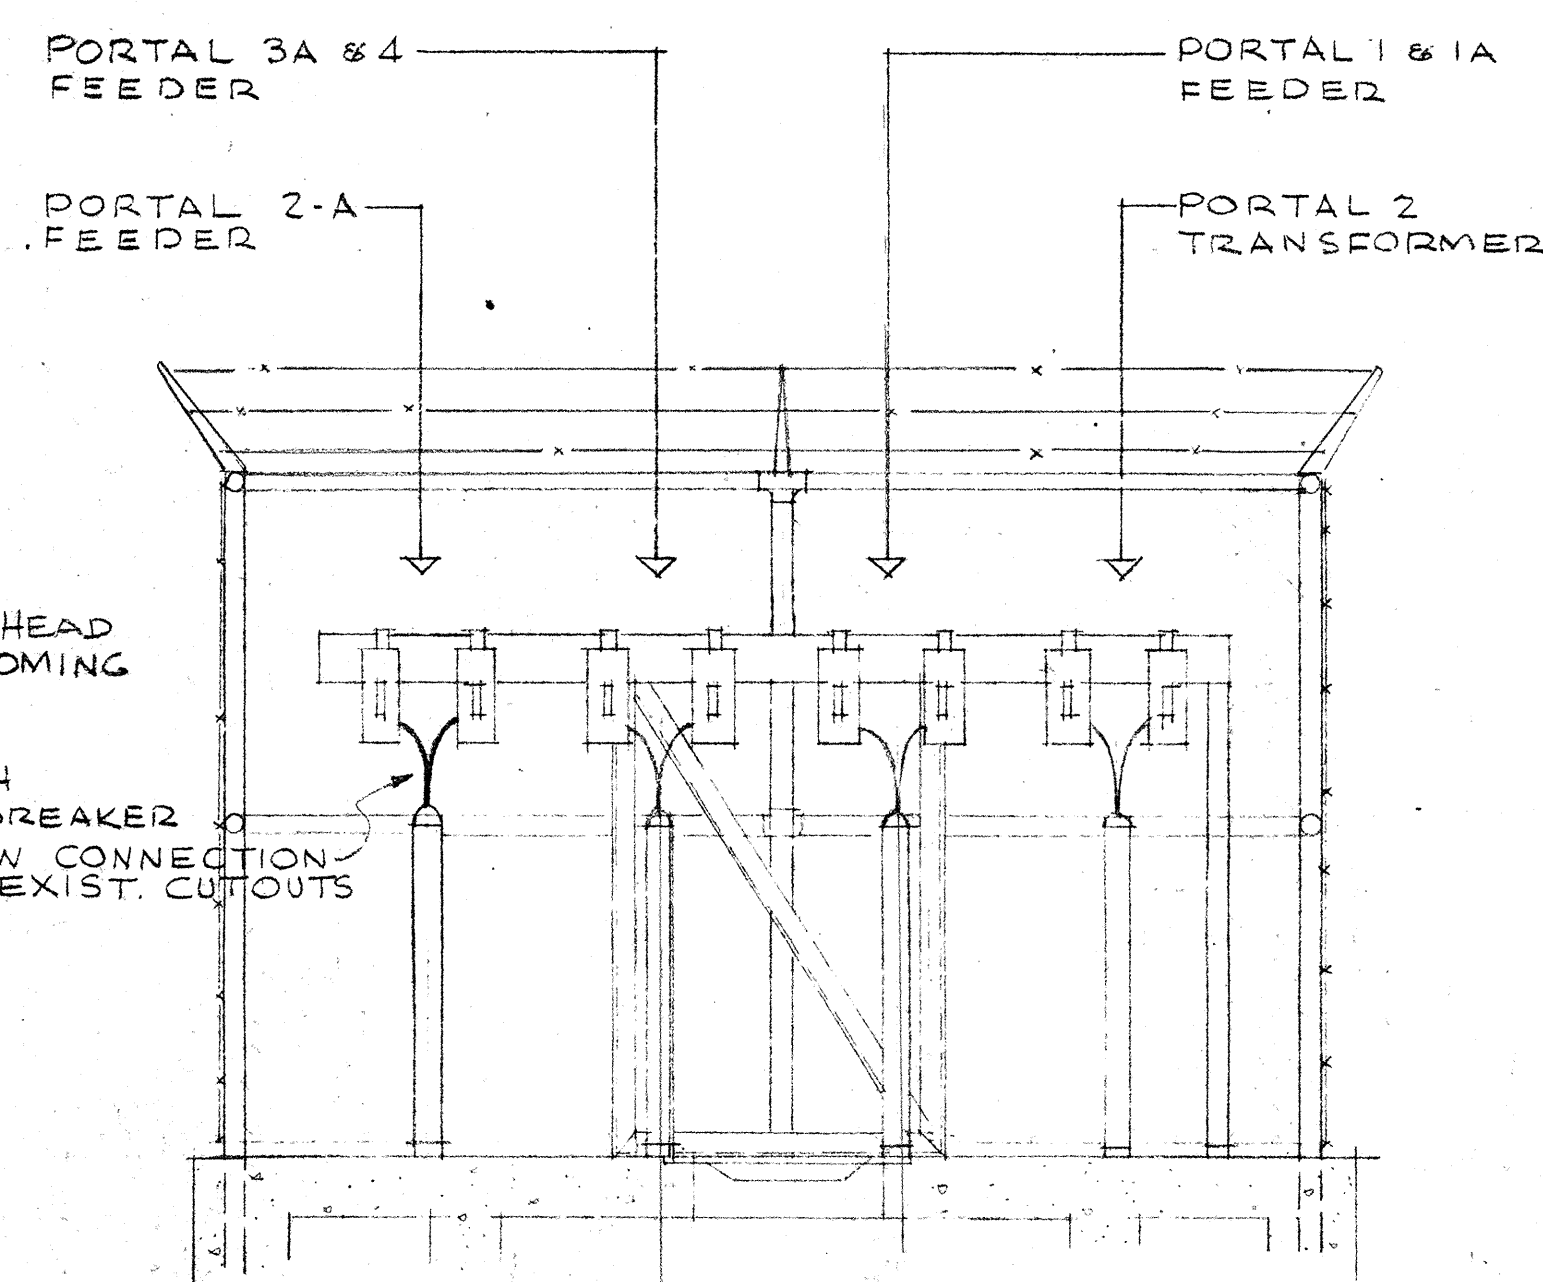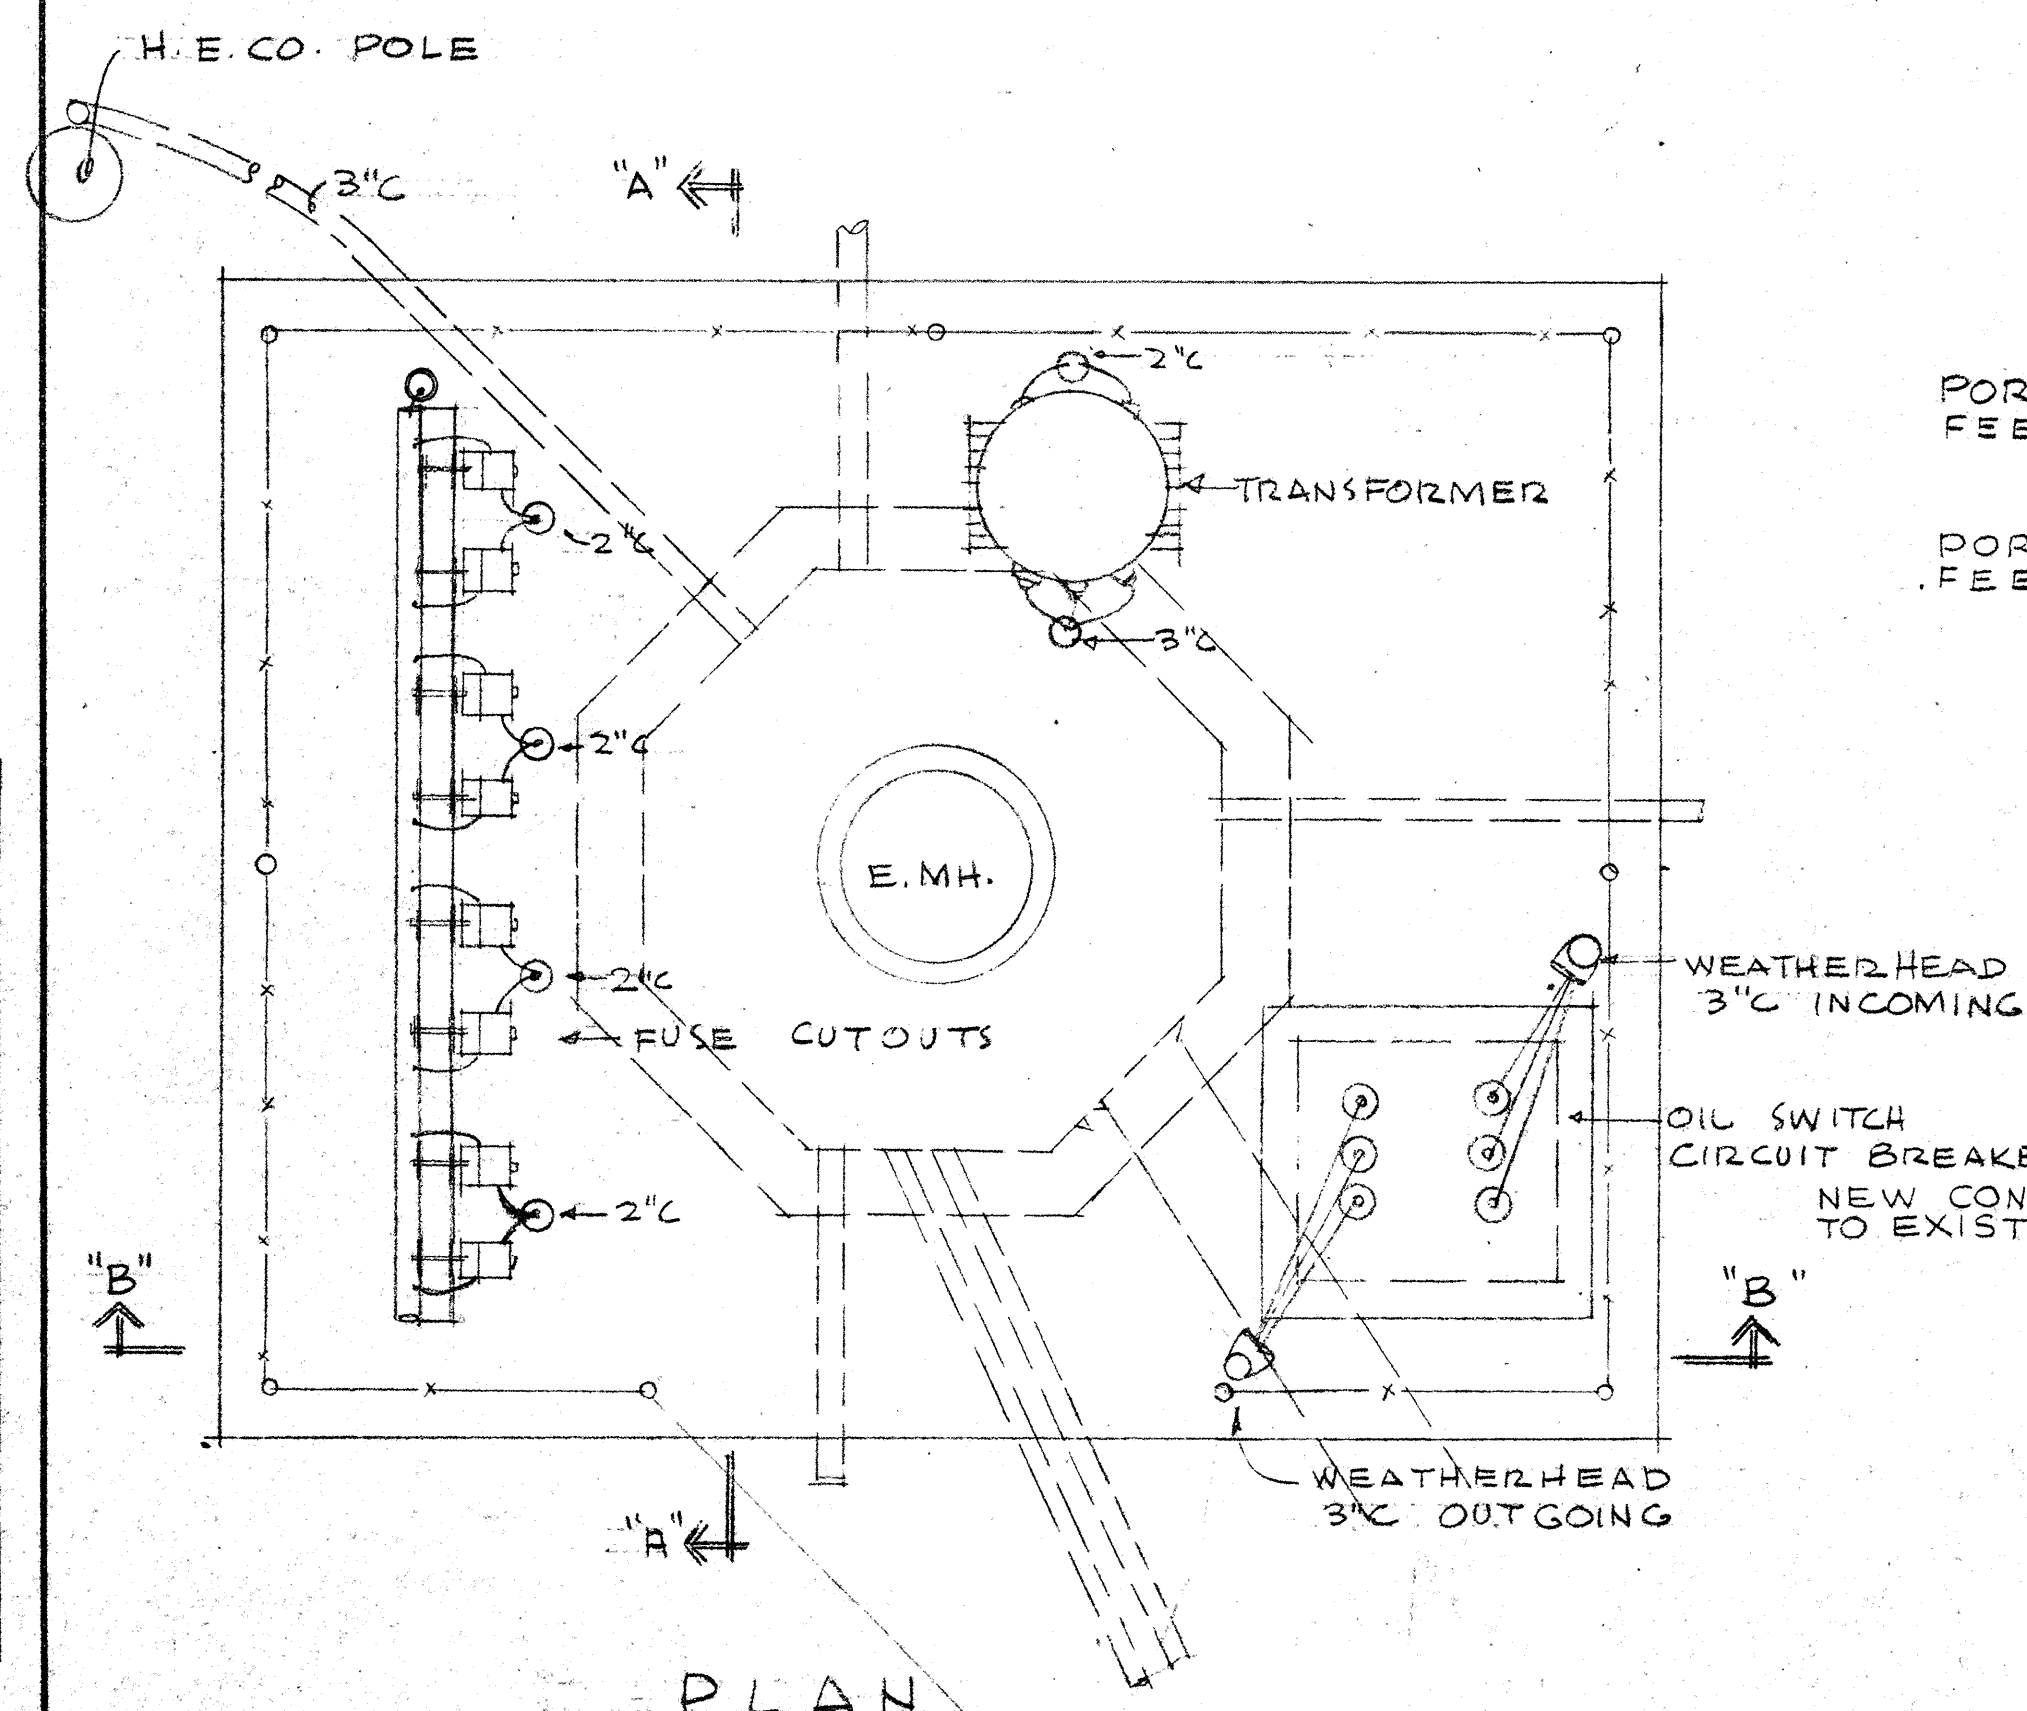

TEMPORARY REVERSE TRAFFIC CONTROL

TERRITORIAL HIGHWAY DEPARTMENT
TERRITORY OF HAWAII
ELECTRICAL
ELECTRICAL KEY MAP
& SCHEDULE OF DWGS.


PALI ROAD
OUTBOUND TUNNELS
PROJ. NO. BF-061-1(5)

JAMES J. OBERHAUSEN
ELECTRICAL ENGINEER

SCALE: AS NOTED DATE: MAY 1957

SHEET No. 1 OF 13 SHEETS

5896.43A

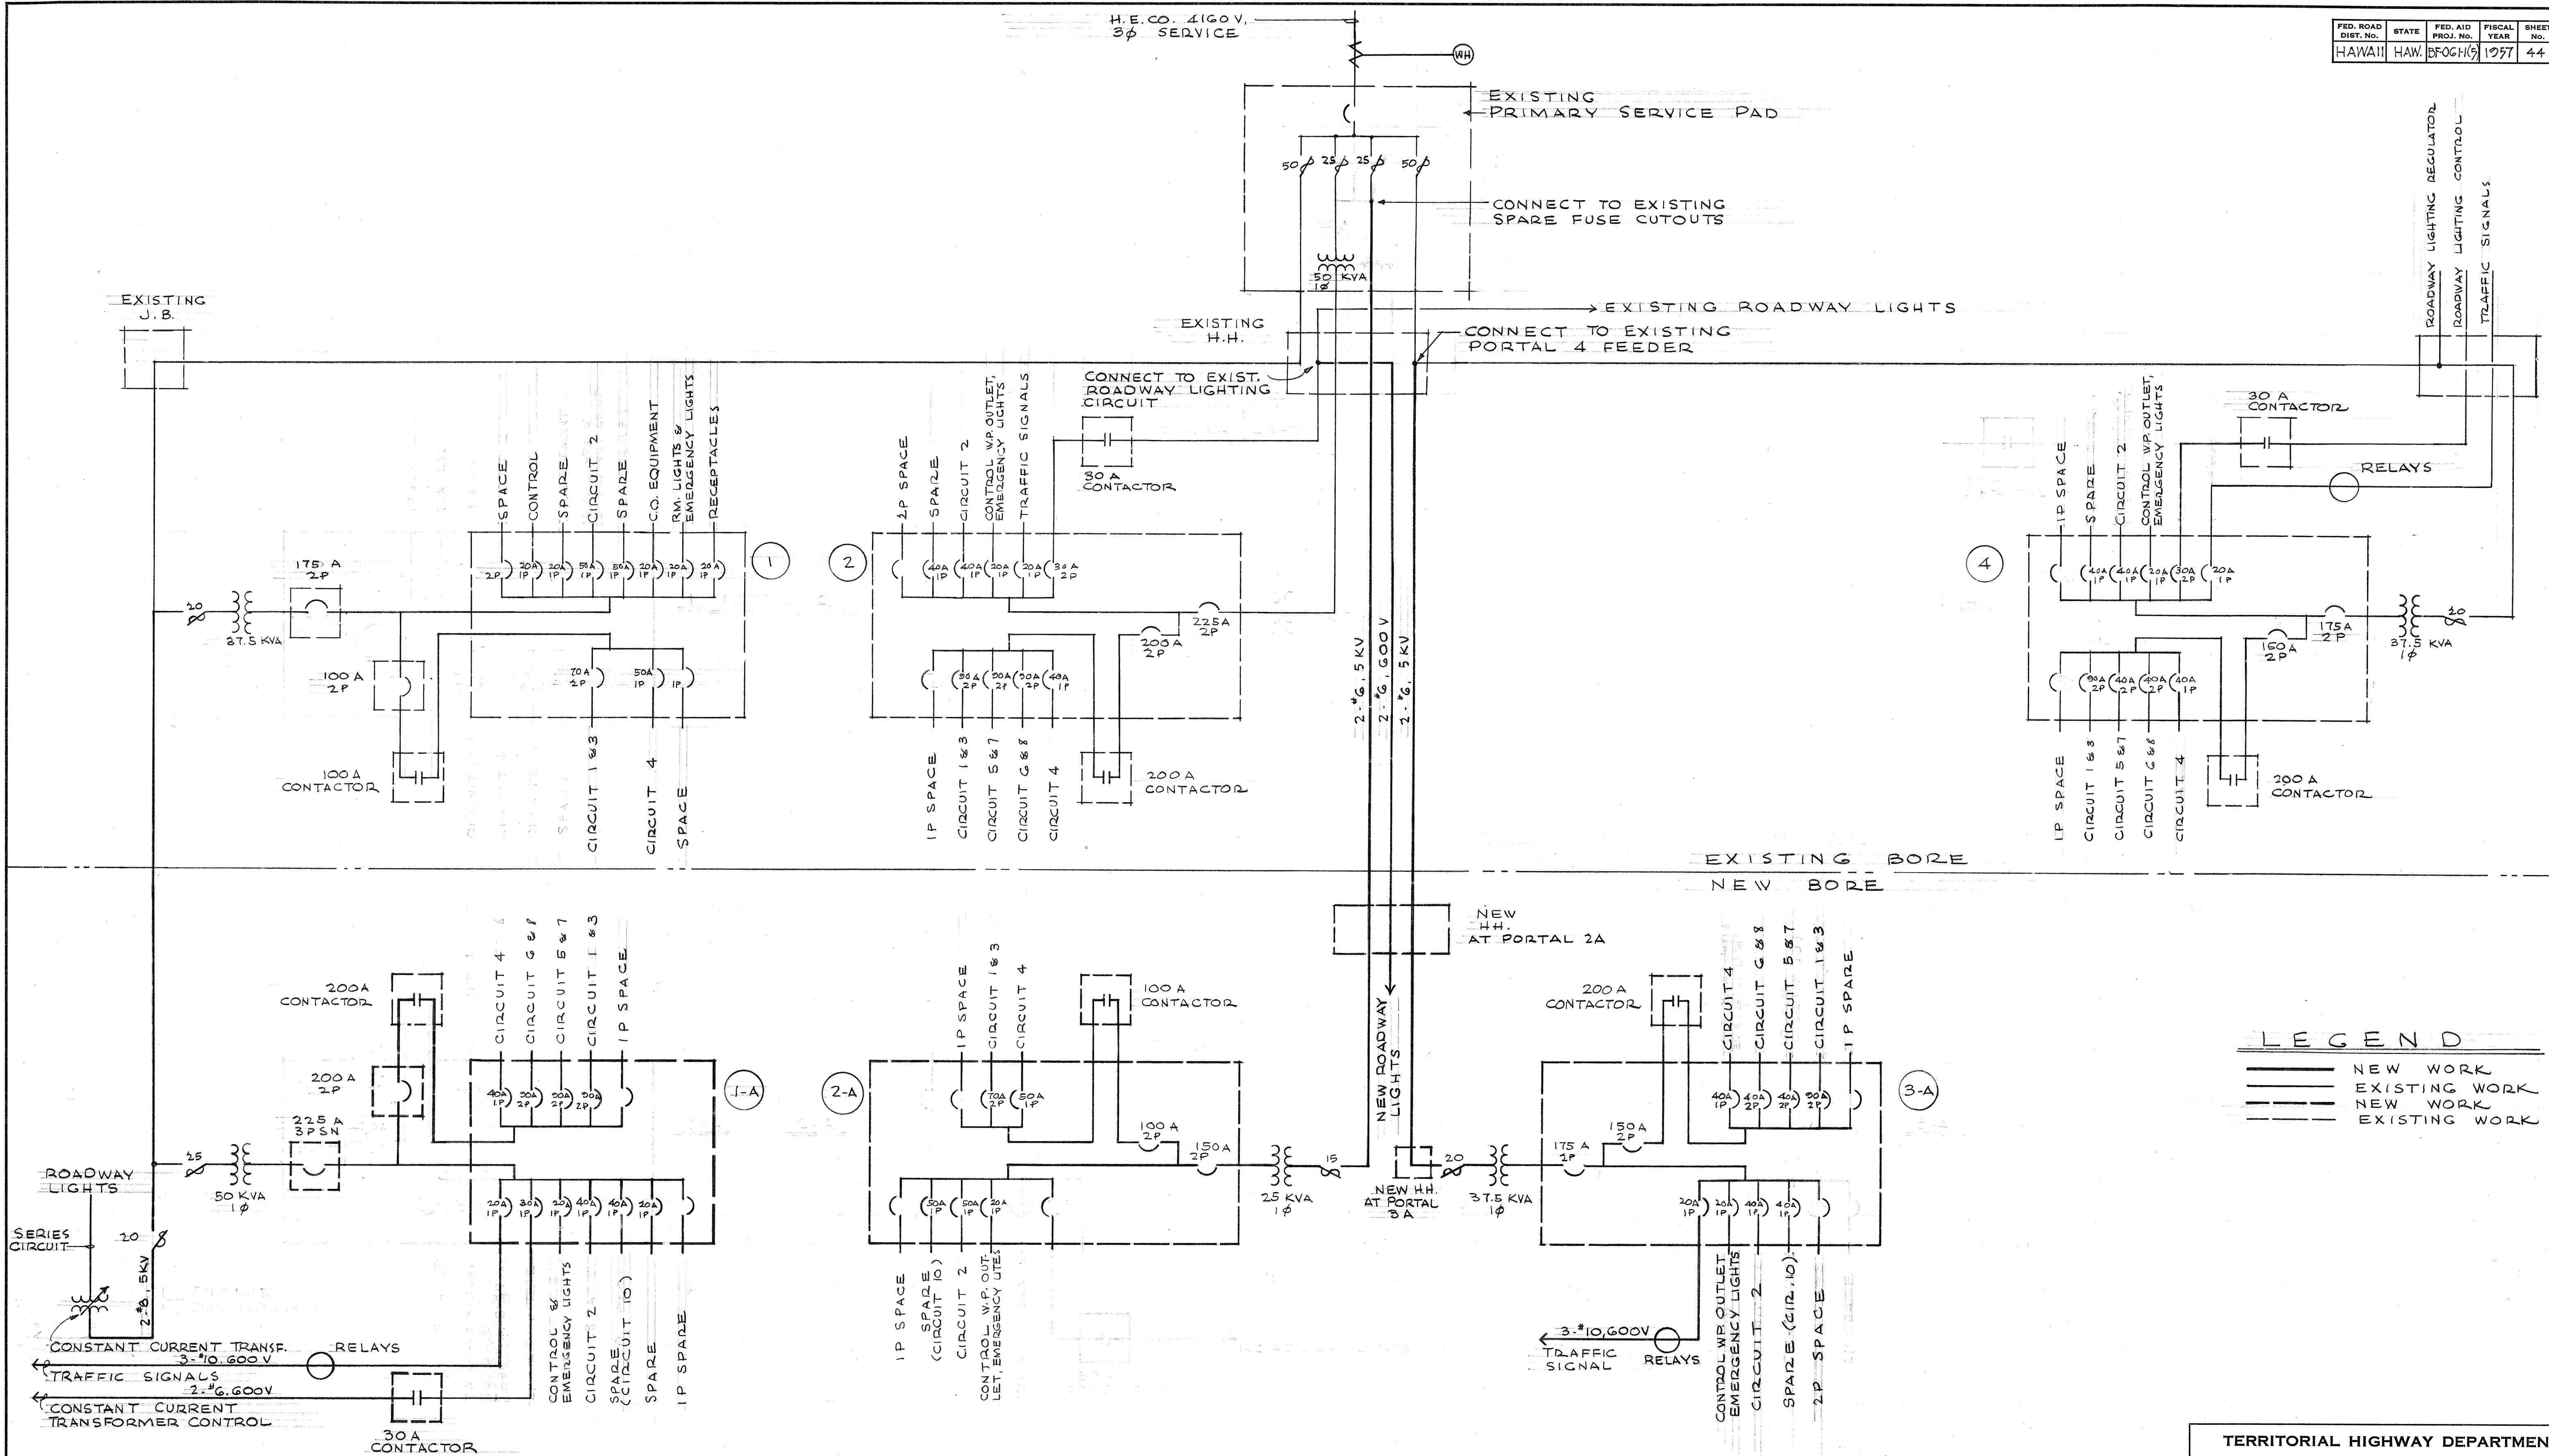


ONE LINE DIAGRAM - ELECTRIC DISTRIBUTION SYSTEM


NOTE :

CONSTRUCTION OF SPLIT BUS PANELS SHALL BE SUCH THAT BOTH CIRCUIT 4 AND CIRCUIT 10 ARE OF OPPOSITE POLARITY FROM CIRCUIT 2.

TERRITORIAL HIGHWAY DEPARTMENT
TERRITORY OF HAWAII
ELECTRICAL
ONE LINE DIAGRAM
ELECTRIC DISTRIBUTION SYSTEM
PALANI ROAD
OUTBOUND TUNNELS
PROJ. NO. BF-OG-1(5)
JAMES J. OBERHAUSEN
ELECTRICAL ENGINEER
SCALE: AS NOTED
DATE: MAY 1957

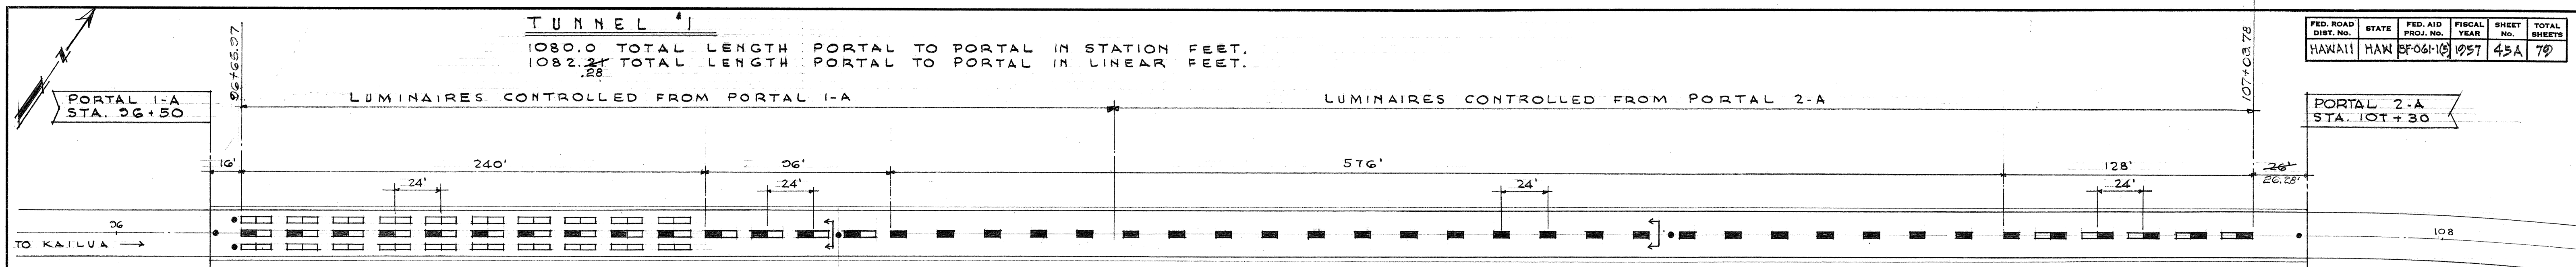

NOTE:
DISTANCES SHOWN ON TUNNEL LIGHTING LAYOUT ARE SLOPE DISTANCES.

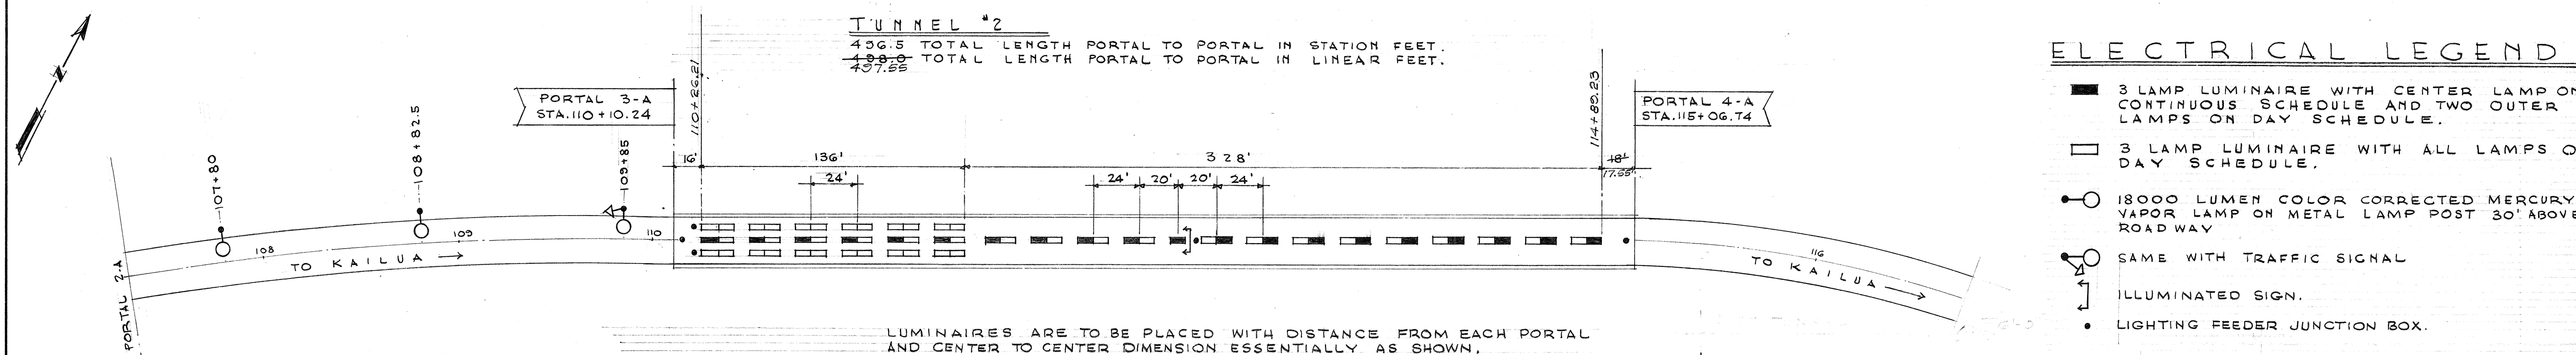

LUMINAIRES ARE TO BE PLACED WITH DISTANCE FROM EACH PORTAL AND CENTER TO CENTER DIMENSION ESSENTIALLY AS SHOWN.

TUNNEL LIGHTING LAYOUT

SCALE: 1" = 40'

ELECTRICAL LEGEND

- 3 LAMP LUMINAIRE WITH CENTER LAMP ON CONTINUOUS SCHEDULE AND TWO OUTER LAMPS ON DAY SCHEDULE.
- 3 LAMP LUMINAIRE WITH ALL LAMPS ON DAY SCHEDULE.
- 18000 LUMEN COLOR CORRECTED MERCURY VAPOR LAMP ON METAL LAMP POST 30' ABOVE ROADWAY
- SAME WITH TRAFFIC SIGNAL
- ILLUMINATED SIGN.
- LIGHTING FEEDER JUNCTION BOX.


IN ADDITION TO FEEDER WIRES, A #8 BARE GROUND WIRE SHALL BE RUN THROUGH FEEDER CONDUITS AND JUNCTION BOXES FROM CONTROL NICHE.

WIRE SIZE & LAMP HOOK-UP SCHEDULE (BASED ON 26" - 800 MA LAMPS)	PORTAL 1-A				PORTAL 2-A				PORTAL 3-A			
	SOUTH ROW		CENTER ROW		NORTH ROW		CENTER ROW		SOUTH ROW		CENTER ROW	
CIRCUIT NUMBER	N 5 7	N 1 3 2 4	N 6 8	N 1 3 2 10	N 5 7	N 1 3 2 4	N 6 8	N 5 7	N 1 3 2 4	N 6 8	N 5 7	N 1 3 2 4
MAIN LIGHTING FEEDER WIRE SIZE	#4	#4	#4	#2	#2	#2	#4	#4	#4	#4	#2	#2
CONTINUOUS SCHEDULE LAMPS				33	33				33	32	13	12
DAY SCHEDULE LAMPS	30	30							18	18		
DAY SCHEDULE LAMPS											38	40
MAIN LIGHTING FEEDER CONDUIT SIZE	1 1/2"	2"	1 1/2"	2"	1"	2"	1"	2"	1"	2"	1"	2"
TYPE JUNCTION BOX FOR LUMINAIRE TAP *	PRX 53	PRX G3	PRX 53	PRX G3	PRT	PRX G3	PRT	PRX G3	PRT	PRX G3	PRT	PRX G3

* CROUSE HINDS DESIGNATIONS USED FOR DESCRIPTIVE PURPOSES.


NOTE:
CIRCUIT LEGS OF OPPOSITE POLARITY SHALL BE TAPPED IN ADJACENT JUNCTION BOXES TO PROVIDE CONTINUOUS BALANCE OF LOAD ON MAIN LIGHTING FEEDER CONDUCTORS.

NOTE:
CONTRACTOR MAY USE ANY TYPE OF BOLTED FITTING THAT DOES NOT REQUIRE CUTTING OF THE MAIN FEEDER CONDUCTORS AND STILL LEAVES AMPLE SPACE IN THE JUNCTION BOX AFTER TAPING.

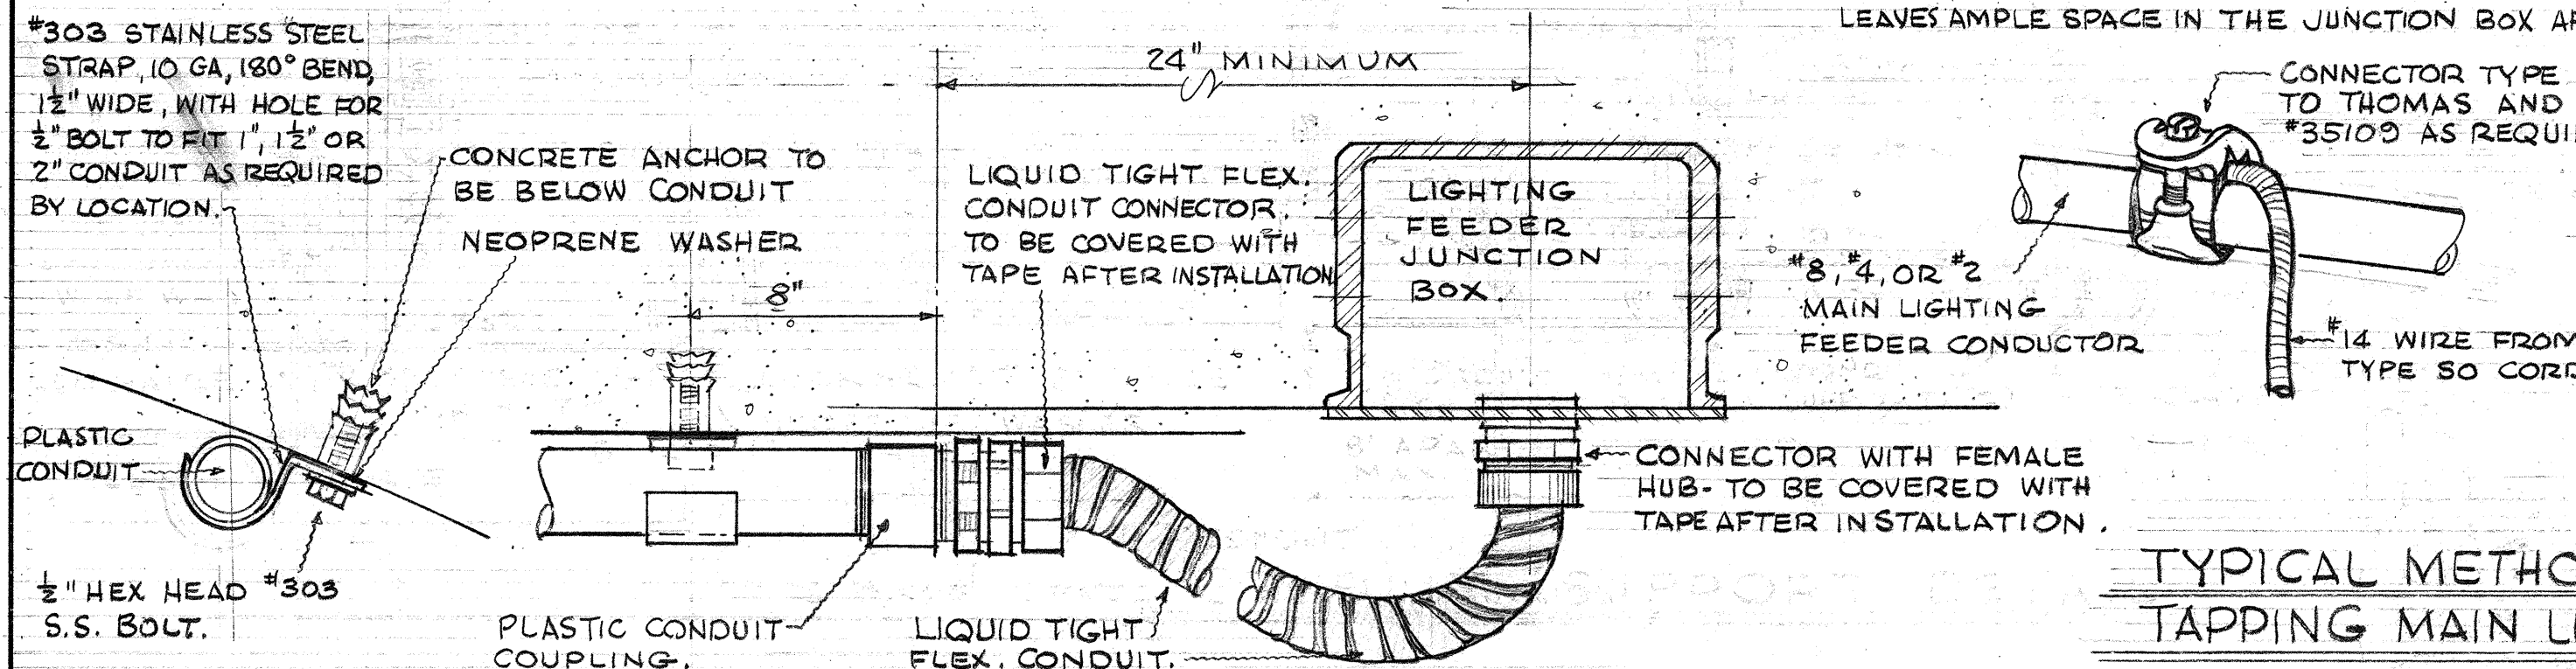

TYPICAL METHOD FOR TAPPING MAIN LIGHTING FEEDER IN JUNCTION BOX

NOT TO SCALE

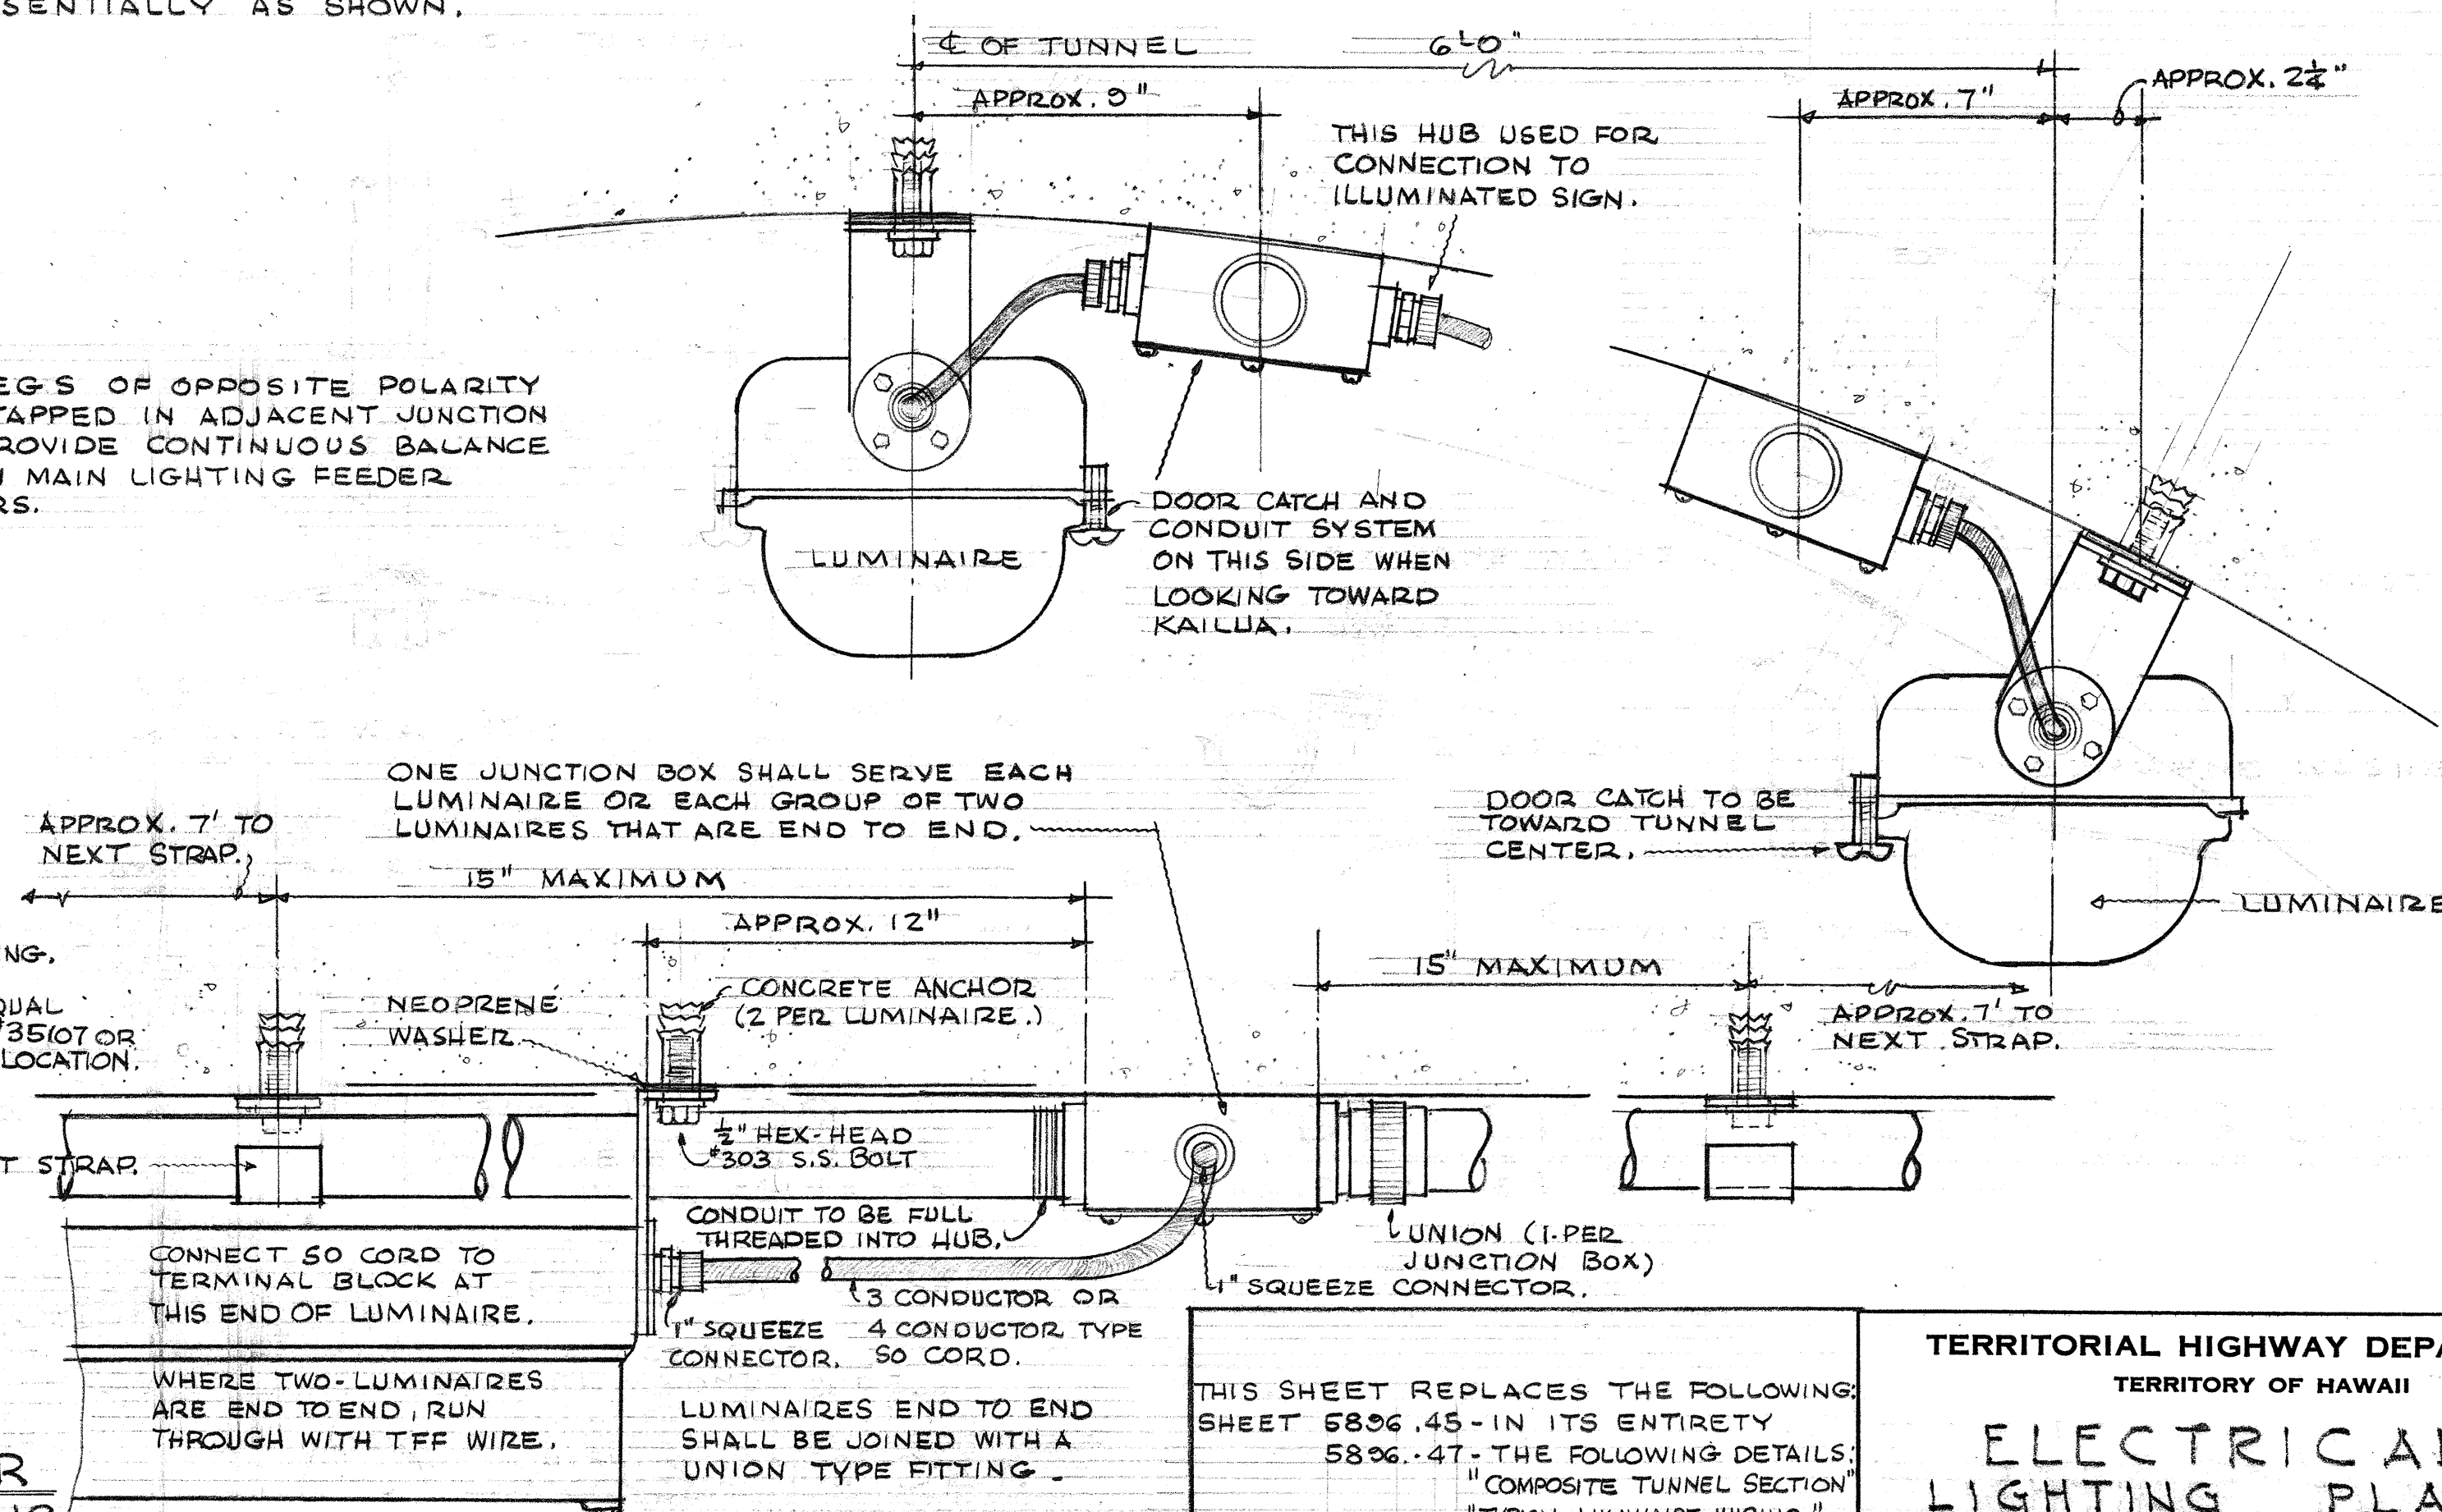

CONDUIT, JUNCTION BOX AND LUMINAIRE MOUNTING DETAIL

SCALE: 3" = 1'-0"

THIS SHEET REPLACES THE FOLLOWING SHEET 5836.45 IN ITS ENTIRETY 5836.47 THE FOLLOWING DETAILS: "COMPOSITE TUNNEL SECTION" "TYPICAL LUMINAIRE WIRING" 5836.53 - DETAIL (B)

JAMES J. OBERHAUSEN
ELECTRICAL ENGINEER


TERRITORIAL HIGHWAY DEPARTMENT
TERRITORY OF HAWAII
ELECTRICAL LIGHTING PLAN
PALI ROAD
OUTBOUND TUNNELS
PROJ. NO. BF-061-1(5)

SCALE: AS NOTED

DATE: SEPT. 1958

SHEET No. OF SHEETS

5836.45A

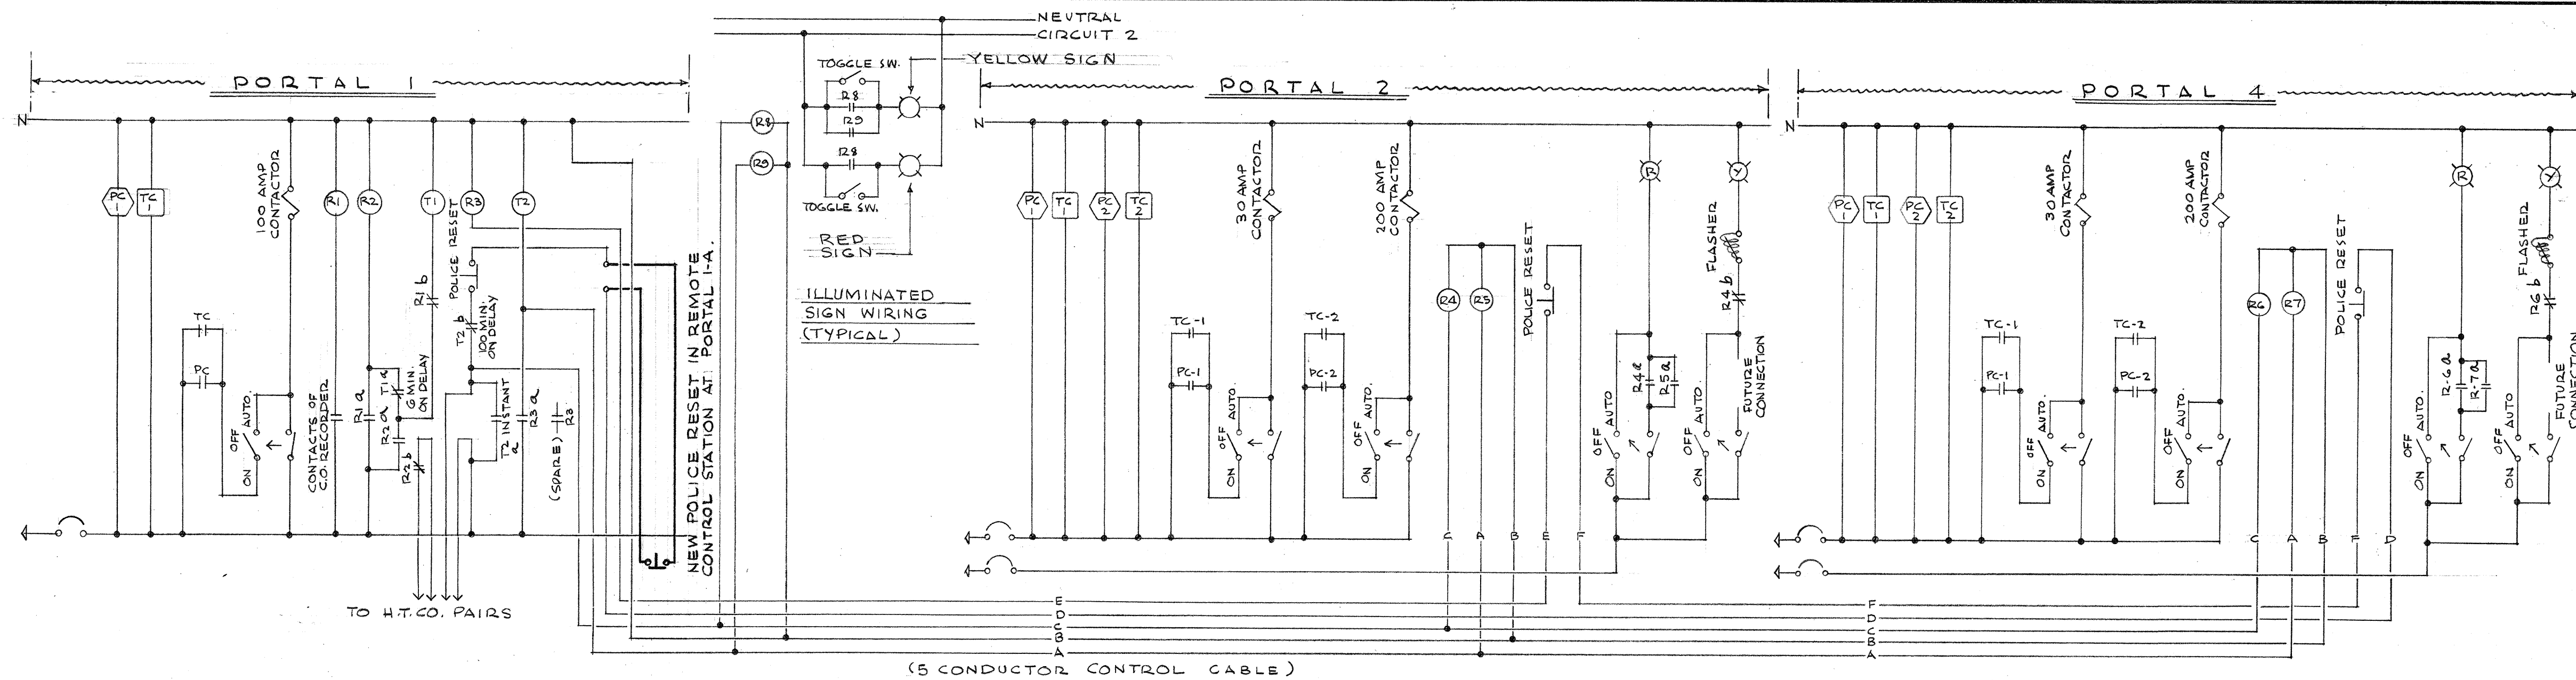


CONTROL LEGEND

- 3 POSITION SELECTOR SWITCH
- OIL TIGHT
- RELAY - FOR CHARACTERISTICS, SEE RELAY SCHEDULE
- TRAFFIC SIGN OR ILLUMINATED SIGN
- OPERATING COIL OF MAGNETICALLY HELD CONTACTOR
- PHOTO-CELL
- TIME SWITCH
- NORMALLY OPEN CONTACTS
- NORMALLY CLOSED CONTACTS
- CIRCUIT BREAKER
- PUSH BUTTON, NORMALLY CLOSED, OIL TIGHT

EXISTING TUNNELS

FOR CONTROL OF NEW APPROACH ROAD LIGHTING

POLICE RESET AND SELECTOR SWITCHES TO BE LOCATED IN PORTAL 1-A REMOTE CONTROL STATION.

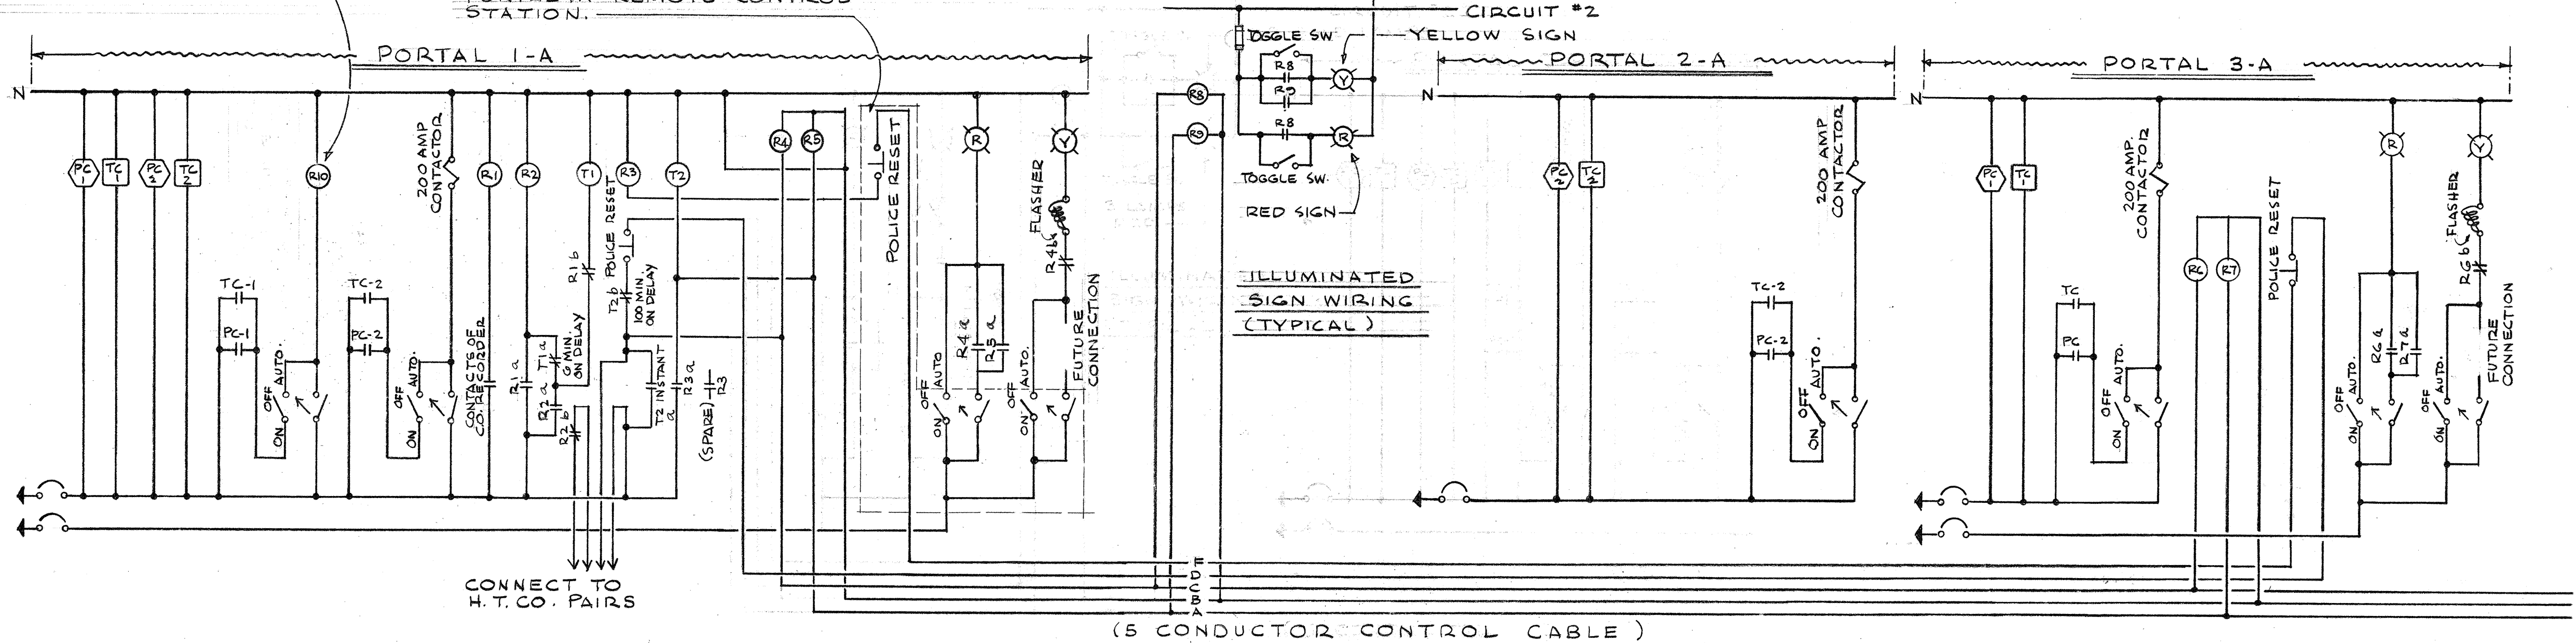

RELAY SCHEDULE


- R1, R2, R4 - 1 SET OF N.O. & 1 SET OF N.C. CONTACTS.
- R5, R7, R9 - 1 SET OF N.O. CONTACTS
- R10 - 1 SET OF N.O. CONTACTS
- R3, R8 - 2 SET OF N.O. CONTACTS
- T2 - TIMING RELAY, 3 TO 100 MIN. 1 INSTANTANEOUS CONTACT; 1 N.O. & 1 N.C. TIMED CONTACT.
- T1 - TIMING RELAY, 12 SECONDS TO 6 2/3 MINUTES, 1 INSTANTANEOUS CONTACT, 1 N.O. & 1 N.C. TIMED CONTACT.

OUTBOUND TUNNELS

LIGHTING CONTROLS SCHEMATIC DIAGRAM



SURVEY BOUGHT BY	DATE
DESIGNED BY	
DRAWN BY	
QUANTITIES CHECKED BY	
NOTE BOOK	
CHECKED BY	
No.	

TERRITORIAL HIGHWAY DEPARTMENT
TERRITORY OF HAWAII
ELECTRICAL
LIGHTING CONTROLS SCHEMATIC
WIRING DIAGRAMS
PALI ROAD
OUTBOUND TUNNELS
PROJ. NO. BF-061-1(5)
JAMES J. OBERHAUSEN
ELECTRICAL ENGINEER
SCALE: AS NOTED
DATE: MAY 1957

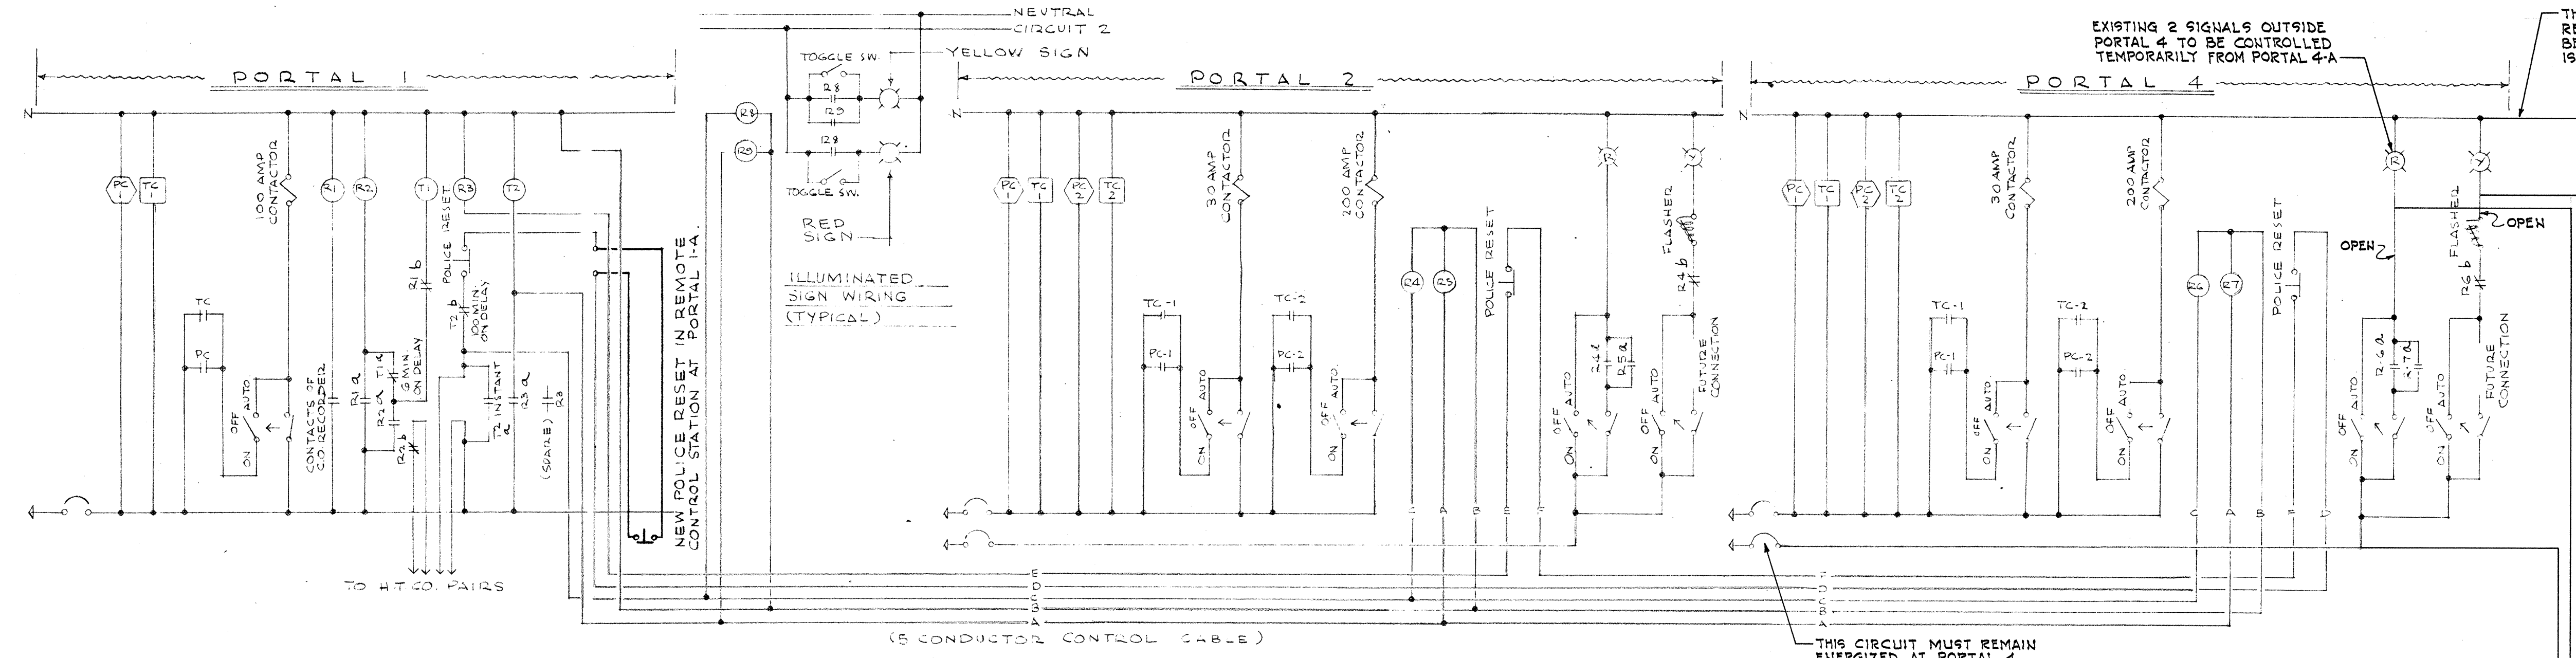

- ### CONTROL LEGEND
- 3 POSITION SELECTOR SWITCH.
 - OIL TIGHT
 - RELAY - FOR CHARACTERISTICS, SEE RELAY SCHEDULE
 - TRAFFIC SIGN OR ILLUMINATED SIGN
 - OPERATING COIL OF MAGNETICALLY HELD CONTACTOR
 - PHOTO-CELL
 - TIME SWITCH
 - NORMALLY OPEN CONTACTS
 - NORMALLY CLOSED CONTACTS
 - CIRCUIT BREAKER
 - PUSH BUTTON, NORMALLY CLOSED, OIL TIGHT


EXISTING TUNNELS

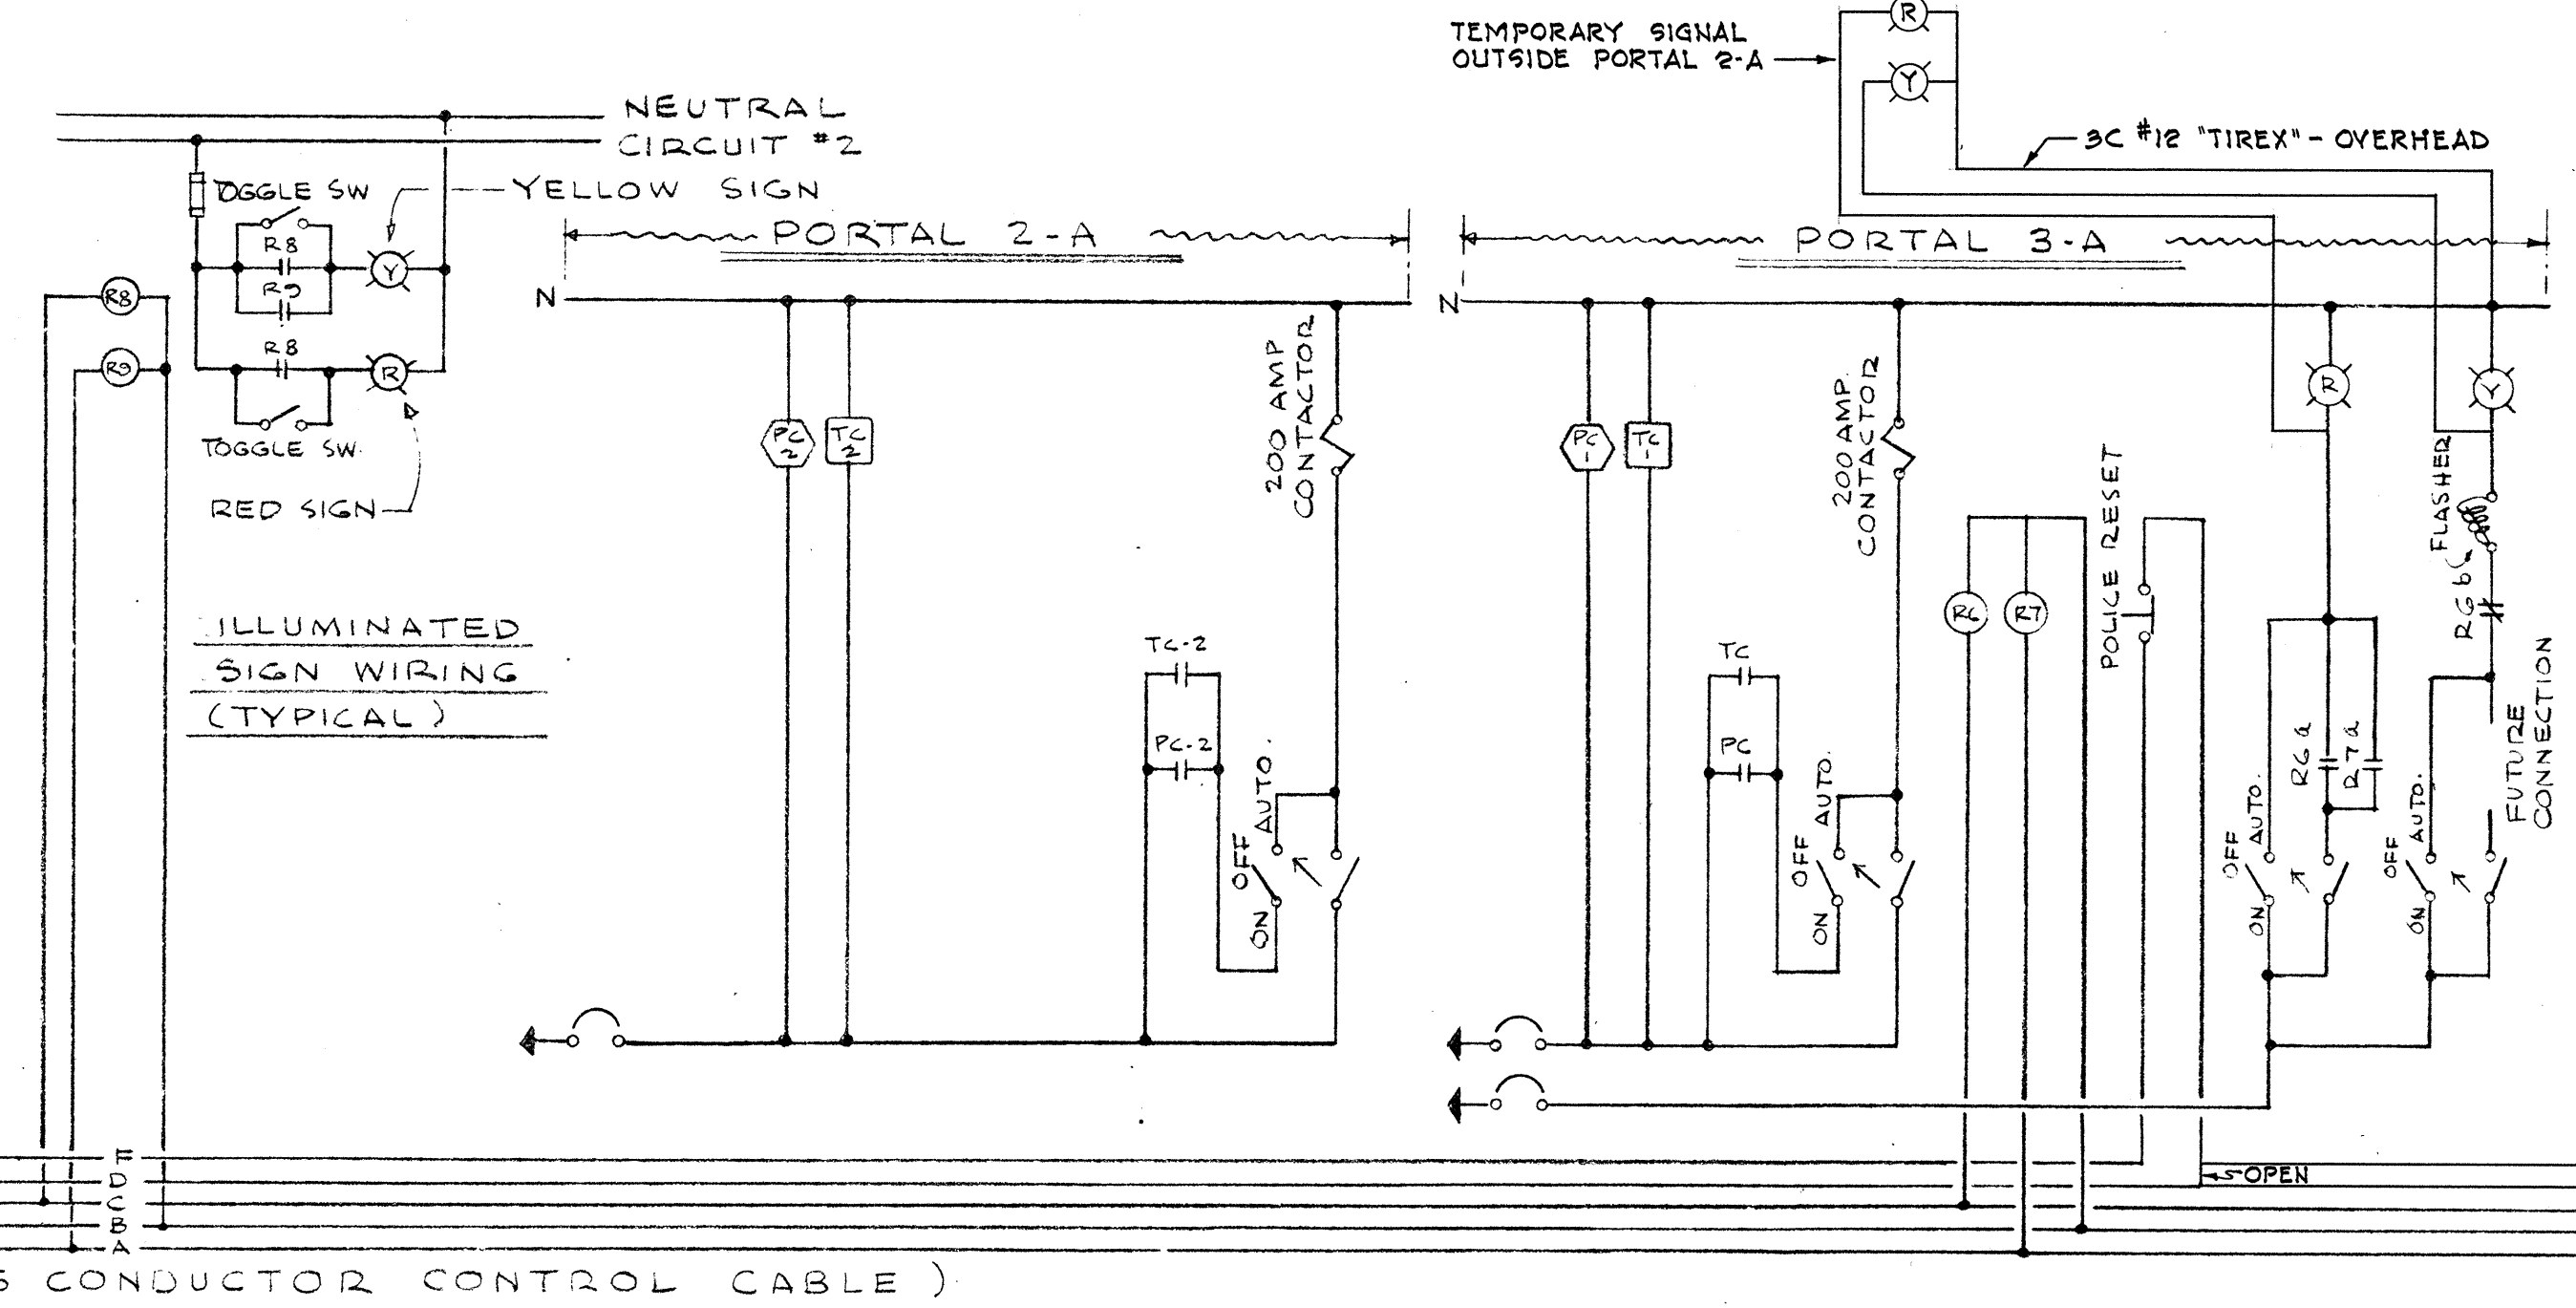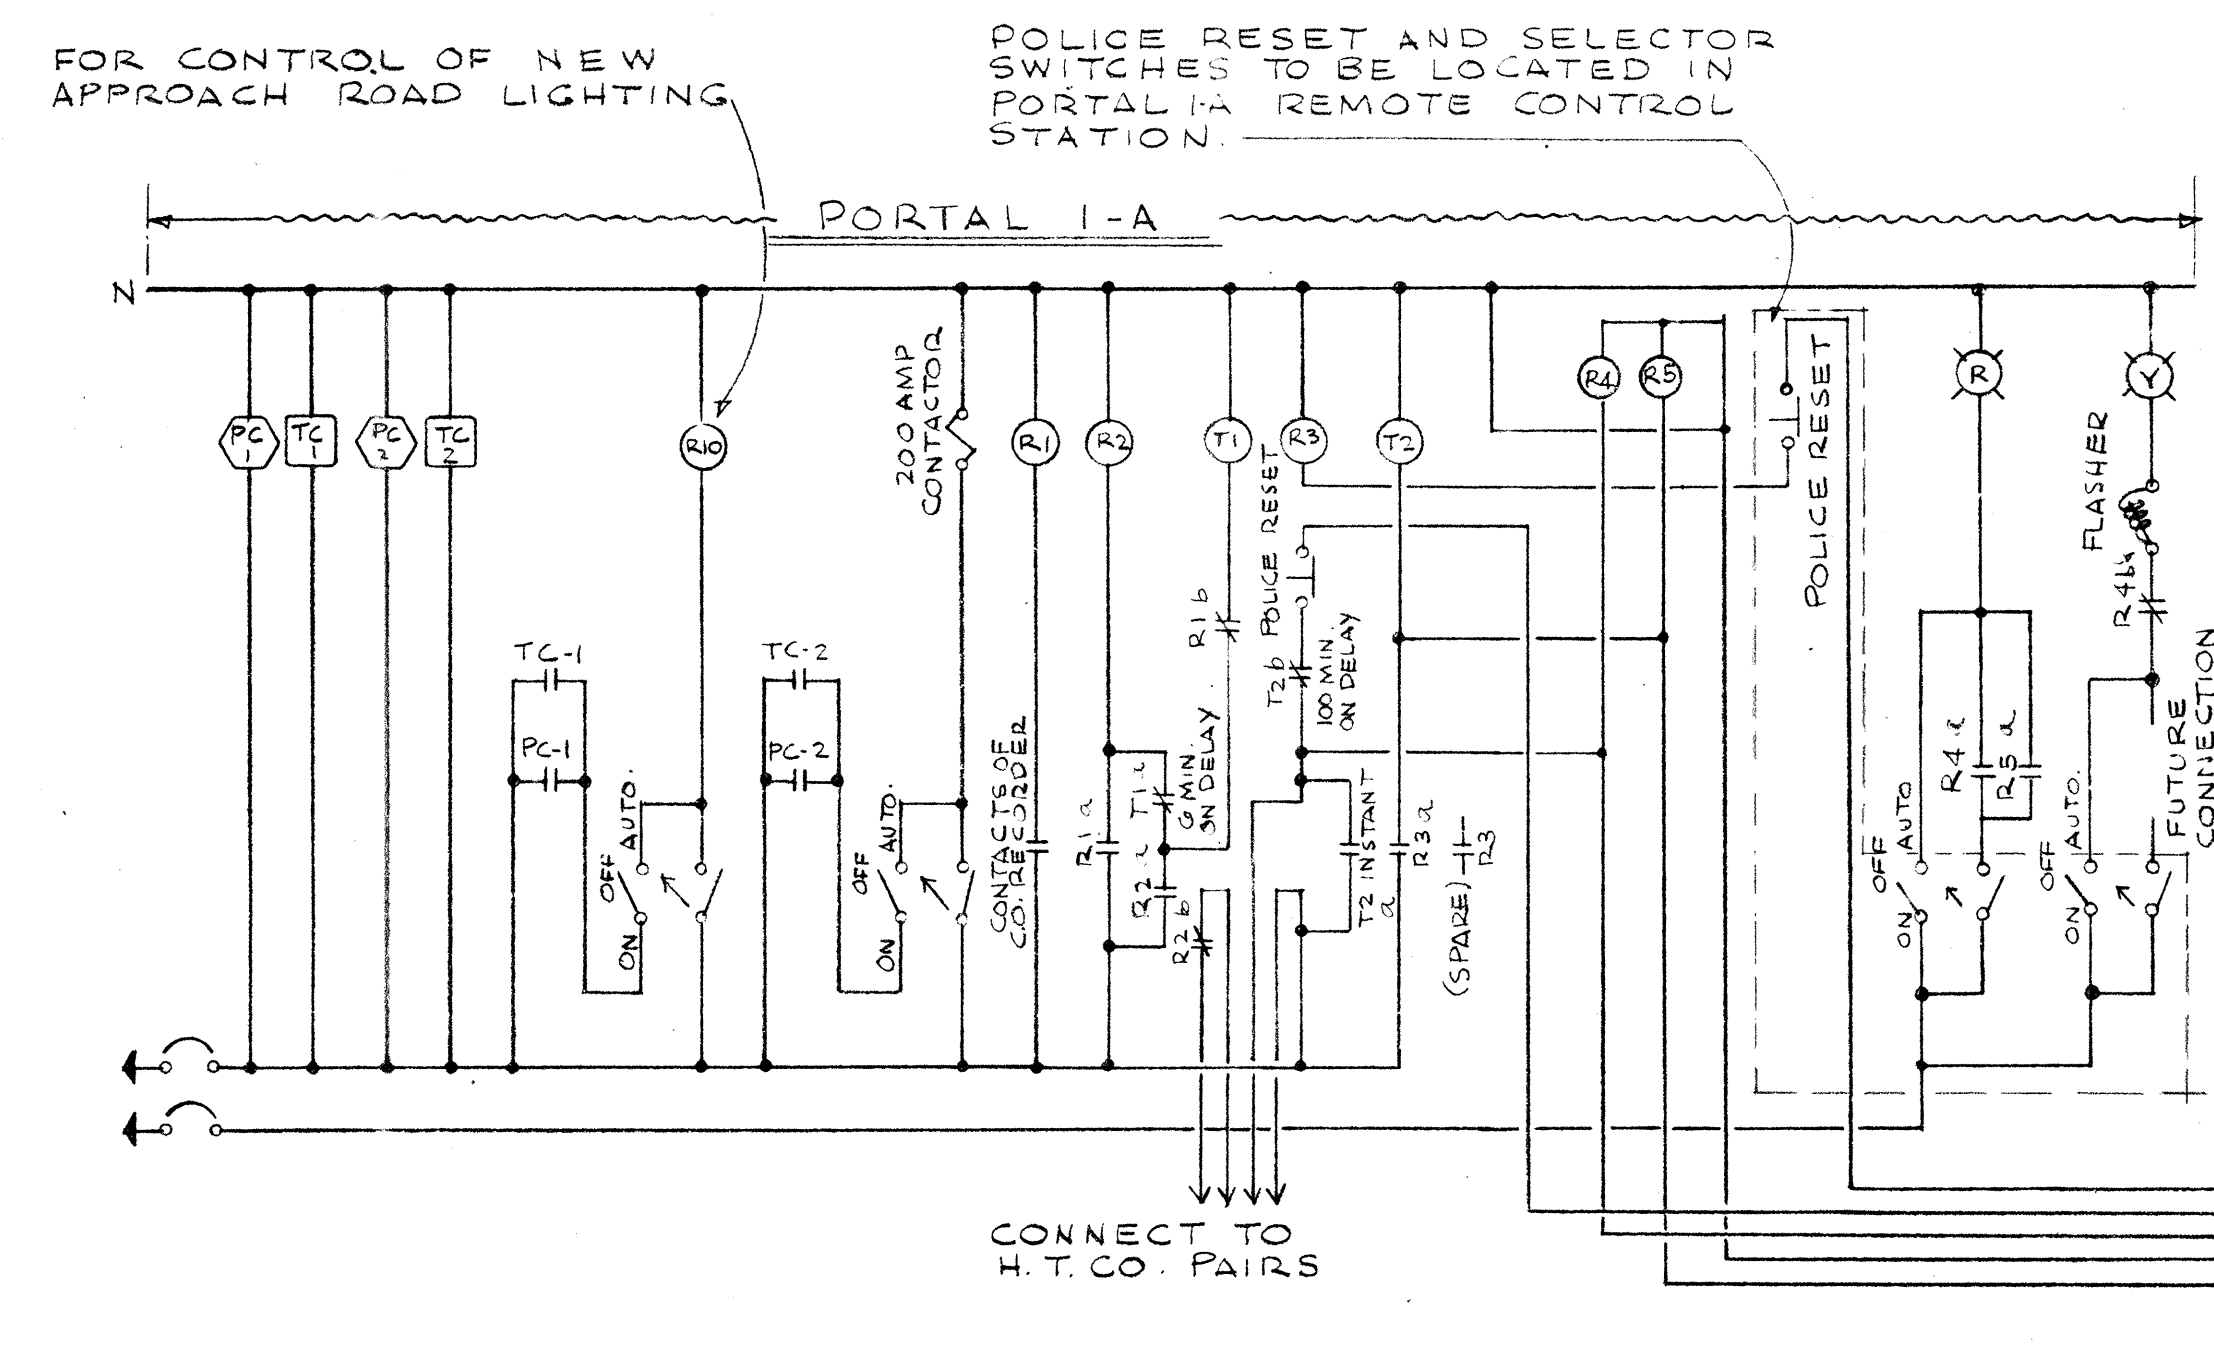

- ### RELAY SCHEDULE
- R1, R2, R4. - 1 SET OF N.O. & 1 SET OF N.C. CONTACTS.
- R6, R11
- R5, R7, R9.
- R10, R12 - 1 SET OF N.O. CONTACTS
- R3, R8 - 2 SET OF N.O. CONTACTS
- T2 - TIMING RELAY, 3 TO 100 MIN. 1 INSTANTANEOUS CONTACT; 1 N.O. & 1 N.C. TIMED CONTACT.
- T1 - TIMING RELAY, 12 SECONDS TO 6 2/3 MINUTES; 1 INSTANTANEOUS CONTACT; 1 N.O. & 1 N.C. TIMED CONTACT.


OUTBOUND TUNNELS

LIGHTING CONTROLS SCHEMATIC DIAGRAM

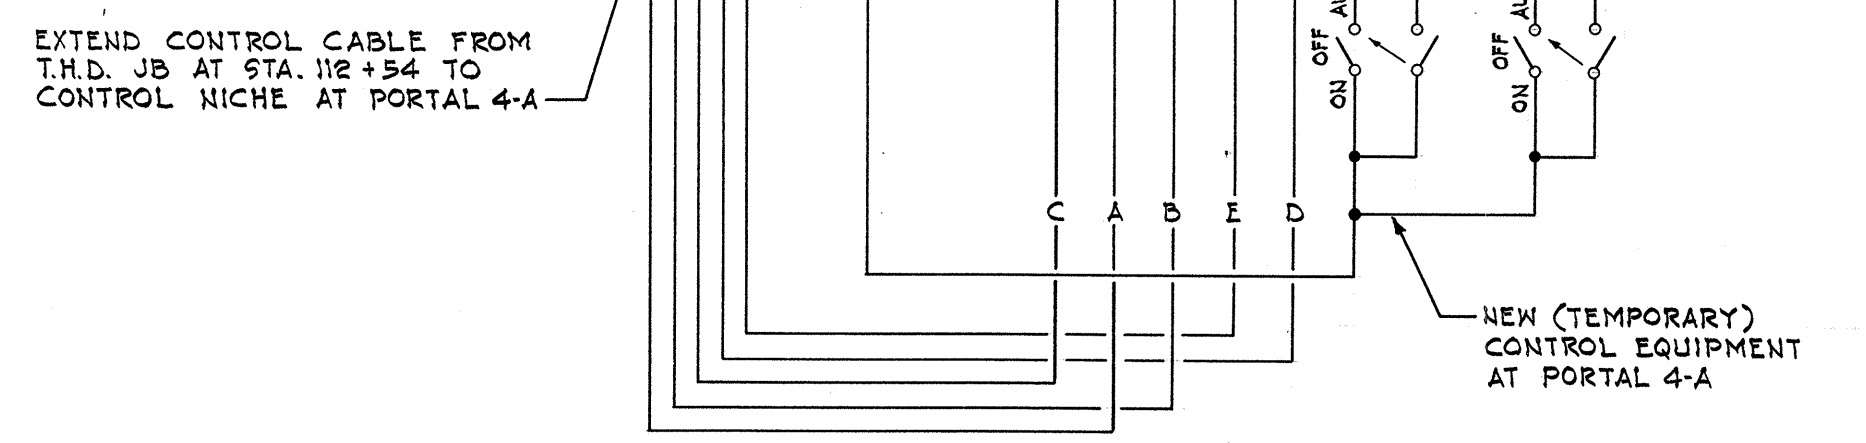


TERRITORIAL HIGHWAY DEPARTMENT
TERRITORY OF HAWAII
ELECTRICAL
LIGHTING CONTROLS SCHEMATIC
WIRING DIAGRAMS
PALI ROAD
OUTBOUND TUNNELS
PROJ. NO. BF-061-1(5)
JAMES J. OBERHAUSEN
ELECTRICAL ENGINEER
SCALE: AS NOTED
DATE: MAY 1957

DATE: _____
SURVEY PLOTTED BY: _____
CHECKED BY: _____
ORIGINAL PLAN: _____
NOTE BOOK: _____
QUANTITIES CHECKED BY: _____
CHECKED BY: _____

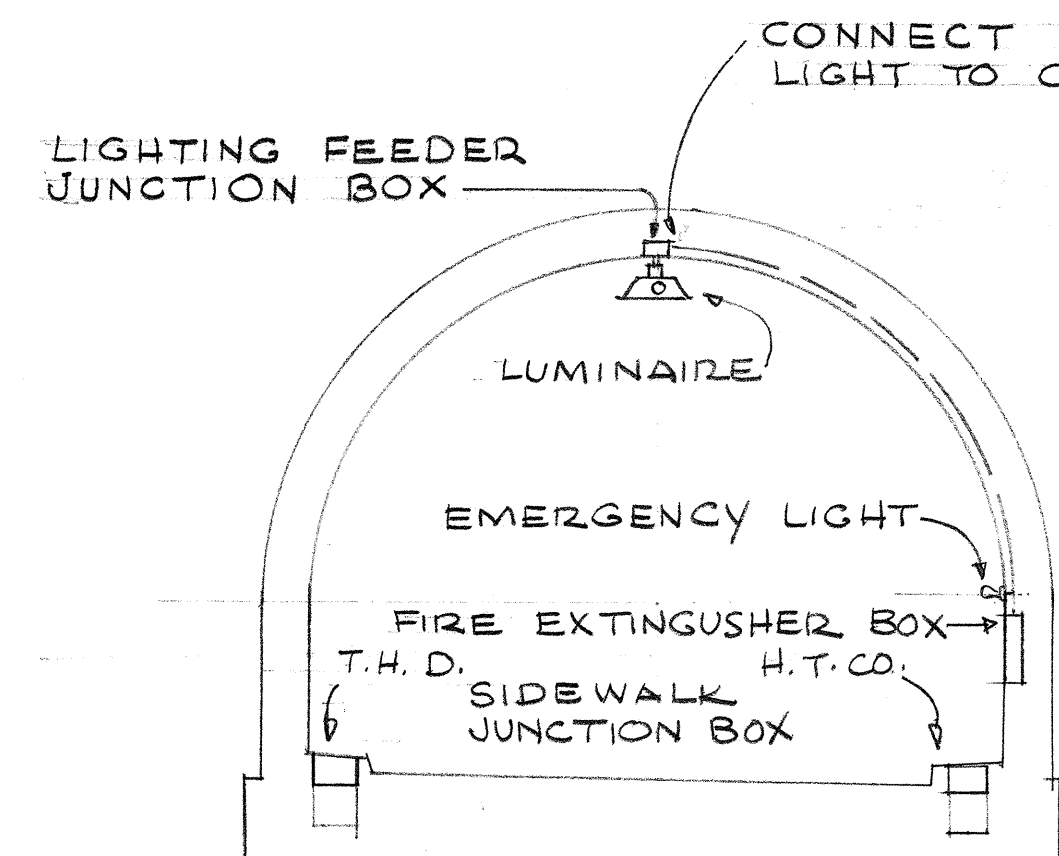

SECTION

SCALE: 1/8" = 1'-0"

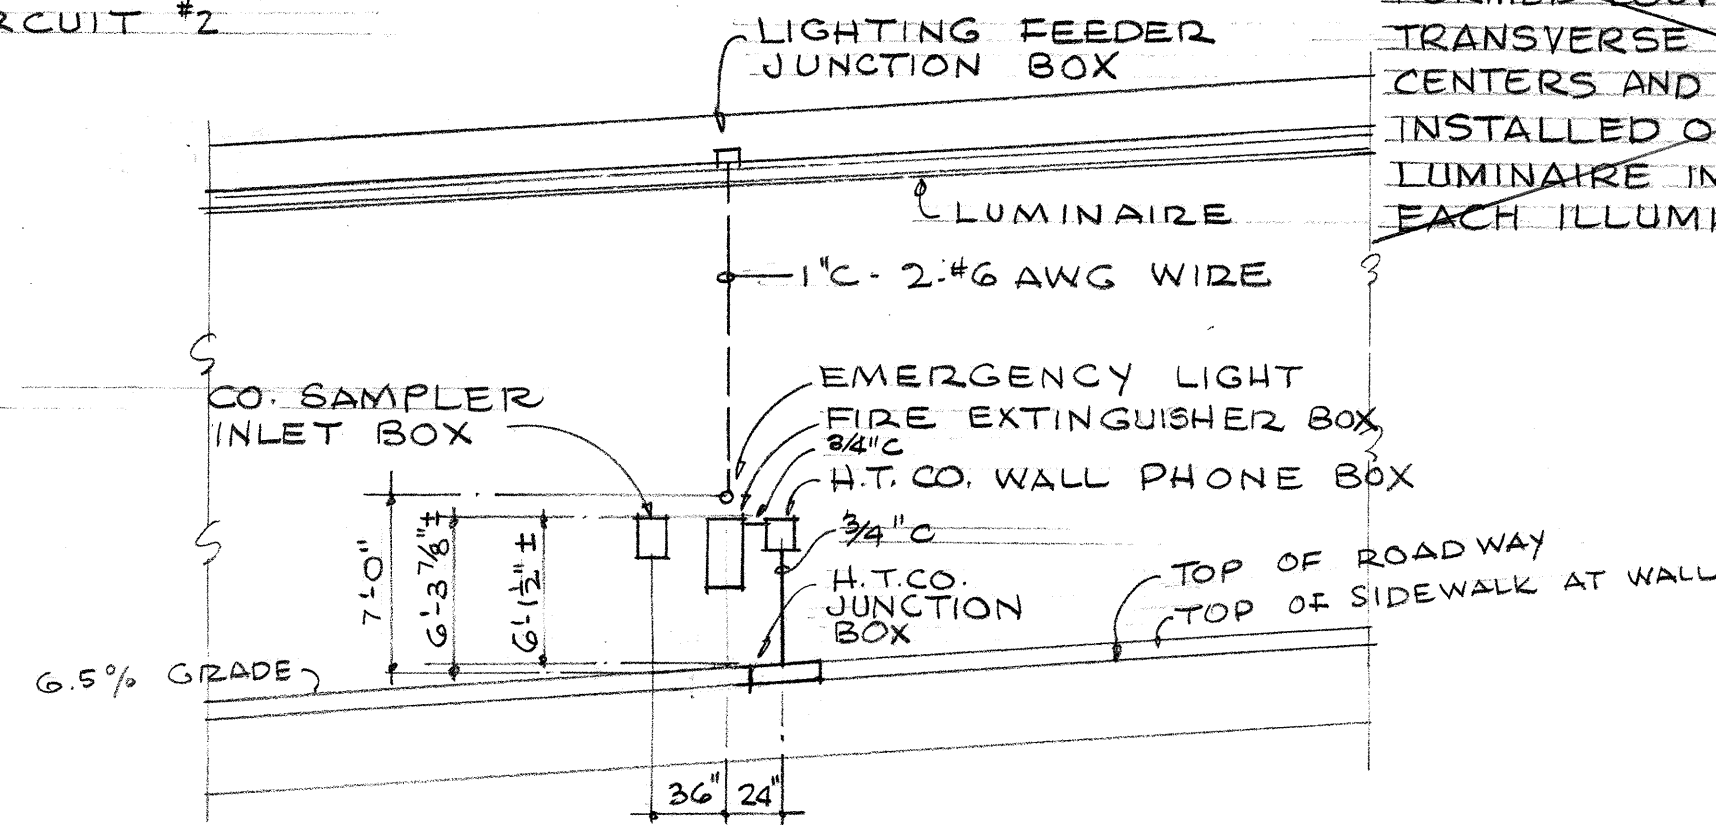

ELEVATION

SCALE: 1/8" = 1'-0"

NOTE: AT PORTALS 1-A AND 2-A EMERGENCY LIGHT IS CONNECTED WITH 2-#12 AWG WIRE FROM NICHE.

3-2" C CONDUIT WHERE SUPER-ELEVATION DOES NOT PERMIT 3-2" C ABOVE EACH OTHER. PLACE IN SIDEWALK AS DIRECTED BY ENGINEER.

DELETE

(See Sheet No. 5896.45A)

NOTE: A 4 FOOT LONG REMOVABLE FORMED LOUVER SECTION 2" WIDE 18" GAUGE TRANSVERSE ALUMINUM STRIPS ON 2" CENTERS AND PAINTED BLACK SHALL BE INSTALLED ON THE TUNNEL LIGHTING LUMINAIRE IMMEDIATELY IN FRONT OF EACH ILLUMINATED SIGN.

CONCRETE INSERTS TO BE SAME AS FOR TUNNEL LIGHTING LUMINAIRE SWIVEL, HANGERS, CANOPY, AND TUNNEL INSERTS TO BE FURNISHED AS REQUIRED FOR SIGNS.

LIQUID TIGHT FLEXIBLE CONDUITS WITH CONTROL AND POWER FOR ILLUMINATED SIGN.

- LIGHTING FEEDER JUNCTION BOX
- 3- PORTAL 1-A
 - 1- ILLUMINATED SIGN AT STA. 93+20
 - 1- EMERGENCY LIGHT AT 101+90 STA.
 - 1- ILLUMINATED SIGN AT STA. 104+00
 - 1- PORTAL 2-A
 - 3- PORTAL 3-A
 - 1- ILLUMINATED SIGN AT STA. 112+58
 - 1- EMERGENCY LIGHT AT PORTAL 4-A

COMPOSITE

TUNNEL SECTION


(LOOKING TOWARD KAILUA)

SCALE: 1/4" = 1'-0"


SYMBOLS

- LAMP ON CONTINUOUS SCHEDULE
- LAMP ON DAY SCHEDULE
- LAMP ON DAY SCHEDULE WITH PROVISION FOR CONNECTING TO CONTINUOUS SCHEDULE
- BALLAST FOR 2 LAMPS ON CONTINUOUS SCHEDULE
- BALLAST FOR 2 LAMPS ON DAY SCHEDULE
- BALLAST FOR 2 LAMPS ON DAY SCHEDULE WITH PROVISION FOR CONNECTING TO CONTINUOUS SCHEDULE AT PORTAL
- FUSE

- CENTER LAMP IN LUMINAIRE NEAREST TO PORTAL 1-A AND 3-A AND THEN IN EVERY OTHER LUMINAIRE THROUGHOUT TUNNEL SHALL BE ON CONTINUOUS SCHEDULE.
- ALL WIRING BETWEEN BALLASTS AND LAMPS SHALL BE #14 AWG. 1000 VOLT. THERMOPLASTIC FIXTURE WIRE WITH UL APPROVED INSULATION FOR 80°C. WIRE SHALL BE CODED AS INDICATED.
- EACH CUTOFF TYPE LAMPHOLDER SHALL BE TOWARD HONOLULU END OF TUNNEL.
- ONE SINGLE LAMP HIGH POWER FACTOR BALLAST SHALL BE INSTALLED ON EACH CIRCUIT HAVING AN UNEVEN NUMBER OF LAMPS.
- FOR WIRE SIZE OF LIGHTING FEEDERS FROM EACH PORTAL, SEE SCHEDULE ON "LIGHTING PLAN."

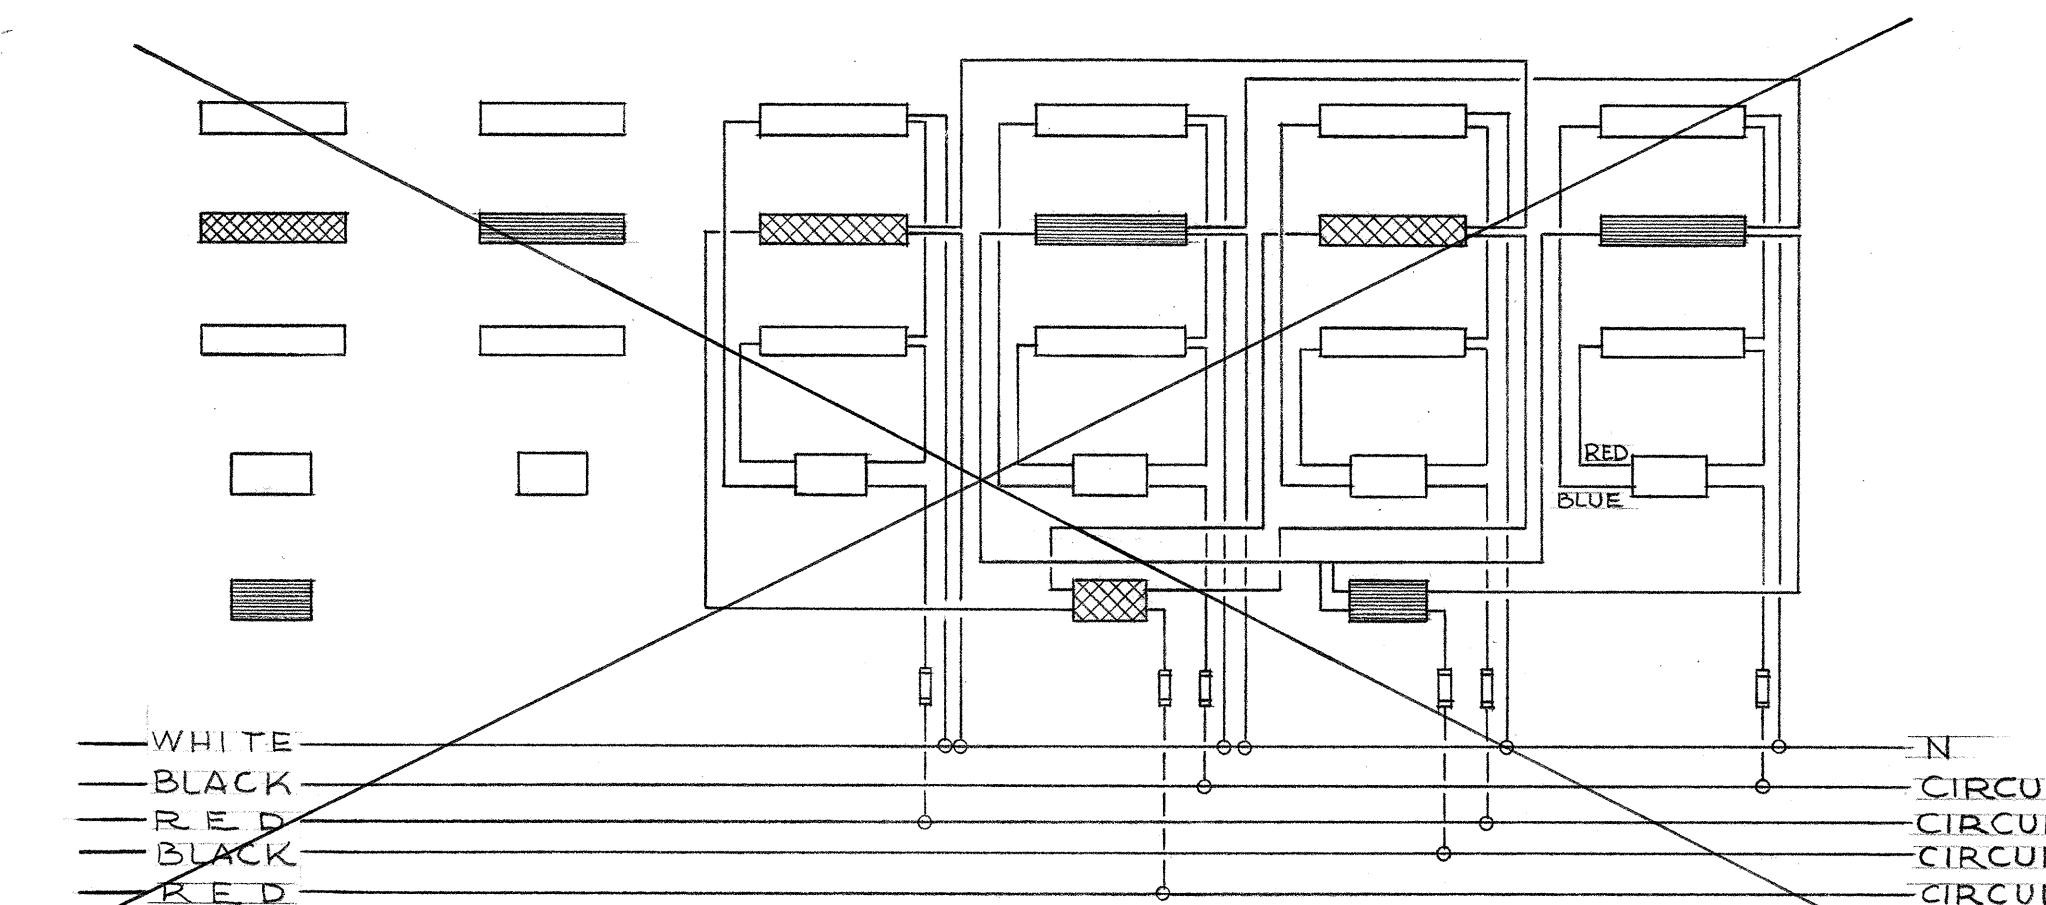

TYPE "C" (# TYPE "A" & "B" CENTER ROW)

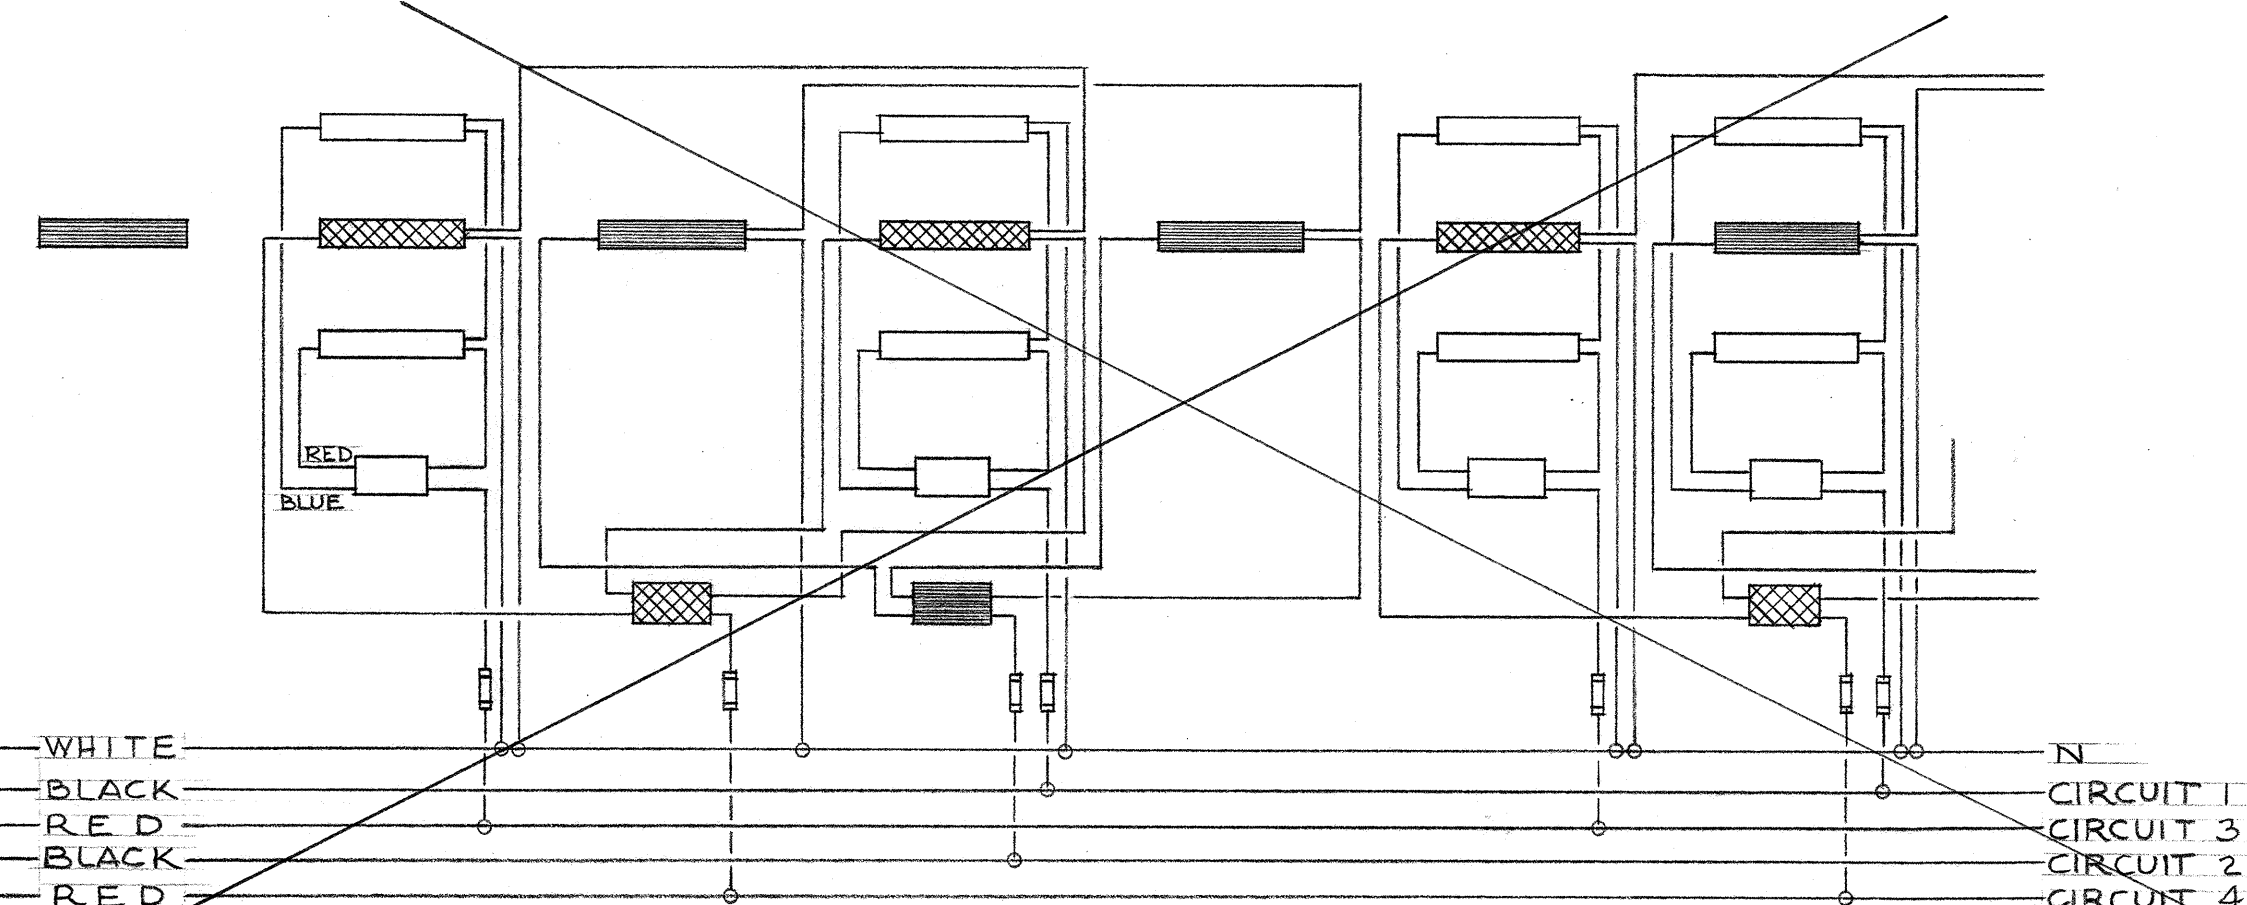

TYPE "D"

TYPICAL LUMINAIRE WIRING

NOTE: [Symbol] INDICATES LOCATION OF FUSES TO BE INSTALLED IN FIRST BORE CIRCUITS. BALLASTS FOR SECOND BORE TO HAVE BUILT-IN THERMAL PROTECTION.

DELETE

(See Sheet No. 5896.45A)

TERRITORIAL HIGHWAY DEPARTMENT
TERRITORY OF HAWAII
ELECTRICAL
TUNNEL SECTIONS &
TYPICAL LUMINAIRE WIRING

PALI ROAD
OUTBOUND TUNNELS

PROJ. NO. BF-061-1(5)


JAMES J. OBERHAUSEN
ELECTRICAL ENGINEER

SCALE: AS NOTED DATE: MAY 1957

SHEET NO. 5 OF 13 SHEETS

5896.47


DESIGNED BY: _____
CHECKED BY: _____
DATE: _____
ORIGINAL PLAN NO. _____
NOTE BOOK NO. _____

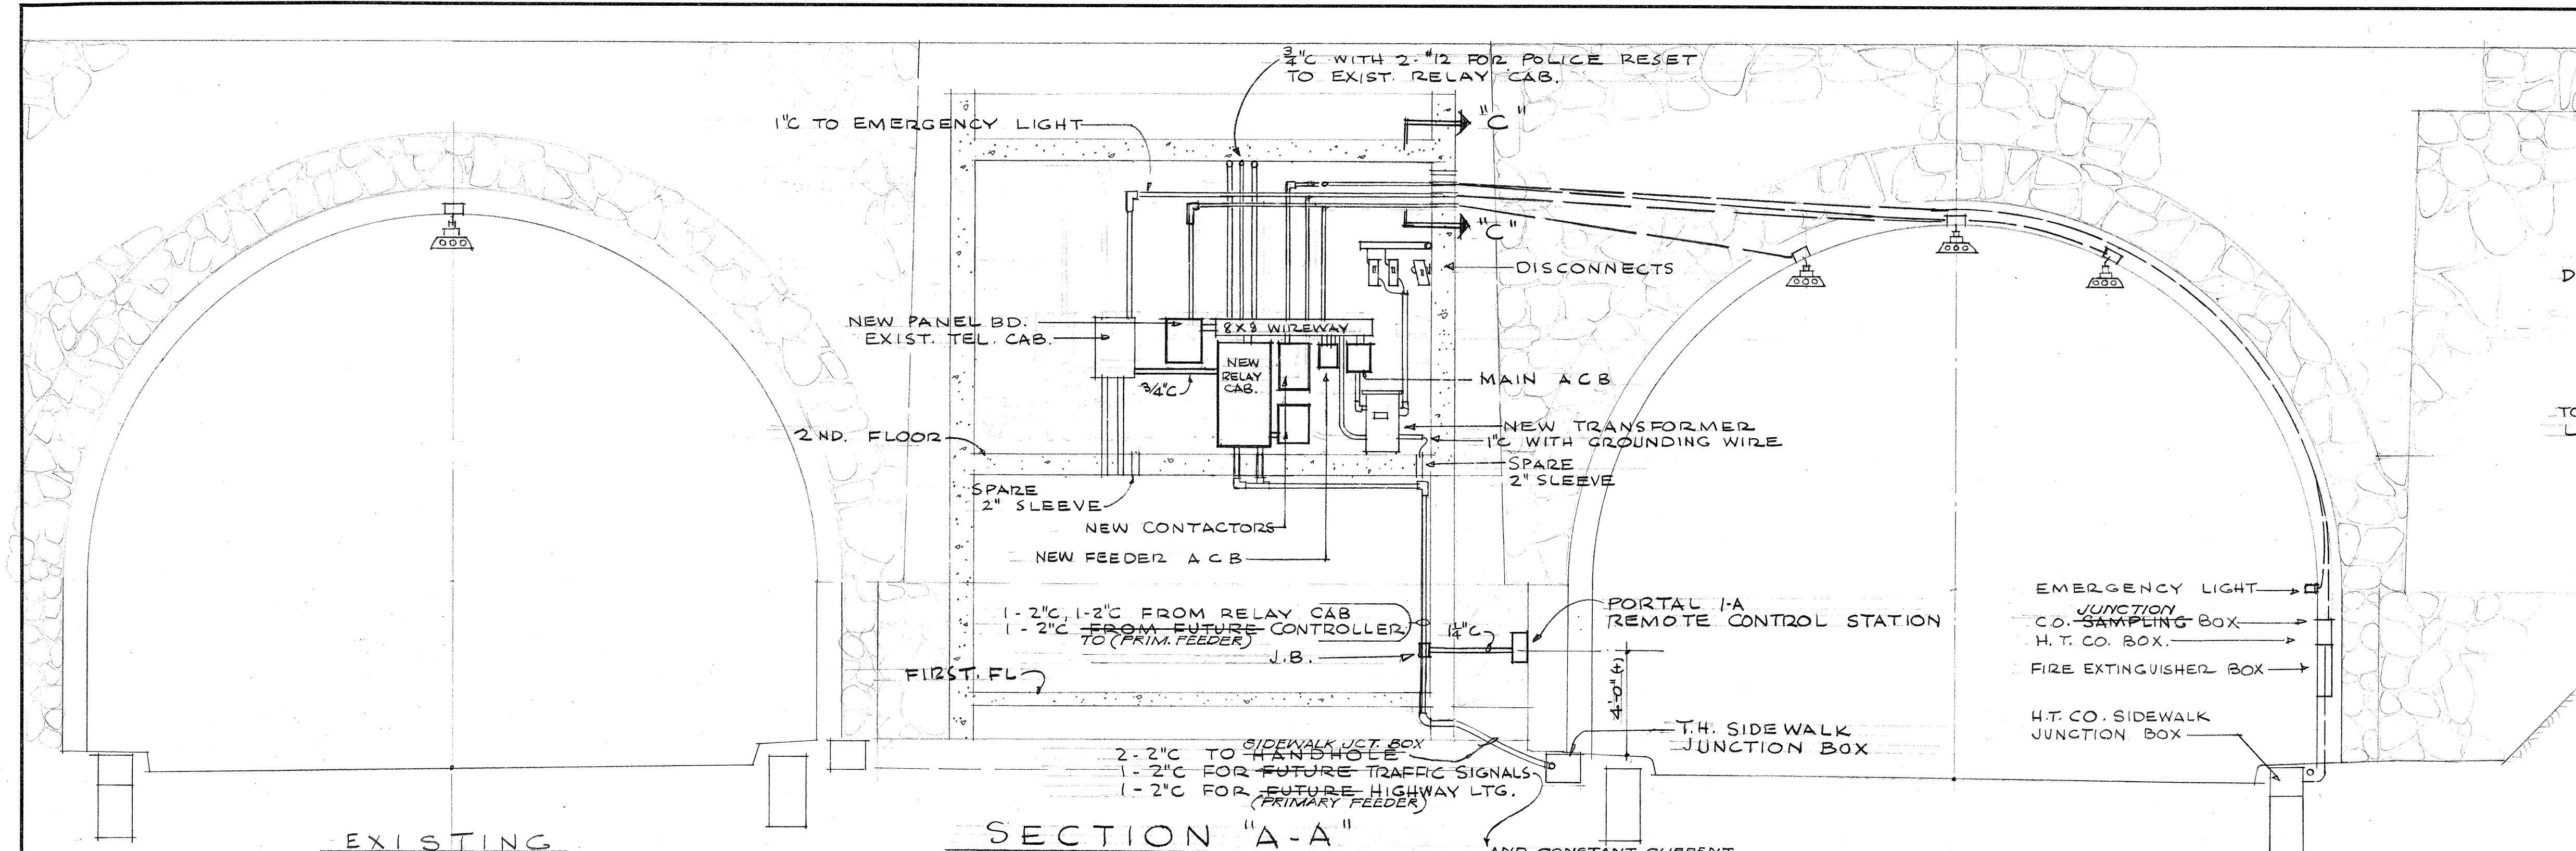


EXISTING
ELEVATION - PORTAL I
SCALE: 1/4" = 1'-0"

SECTION "A-A"

ELEVATION - PORTAL I-A
SCALE: 1/4" = 1'-0"

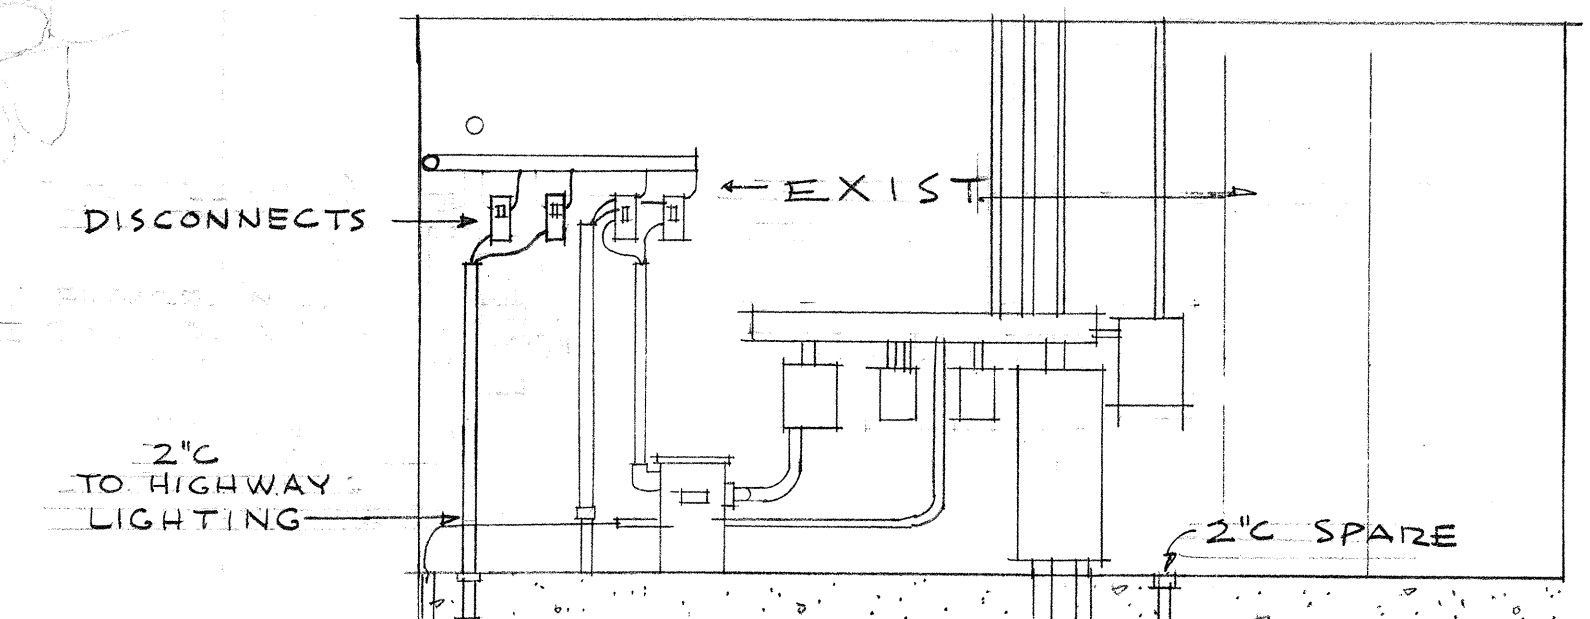

SECOND FLOOR
SECTION "B-B"
SCALE: 1/4" = 1'-0"

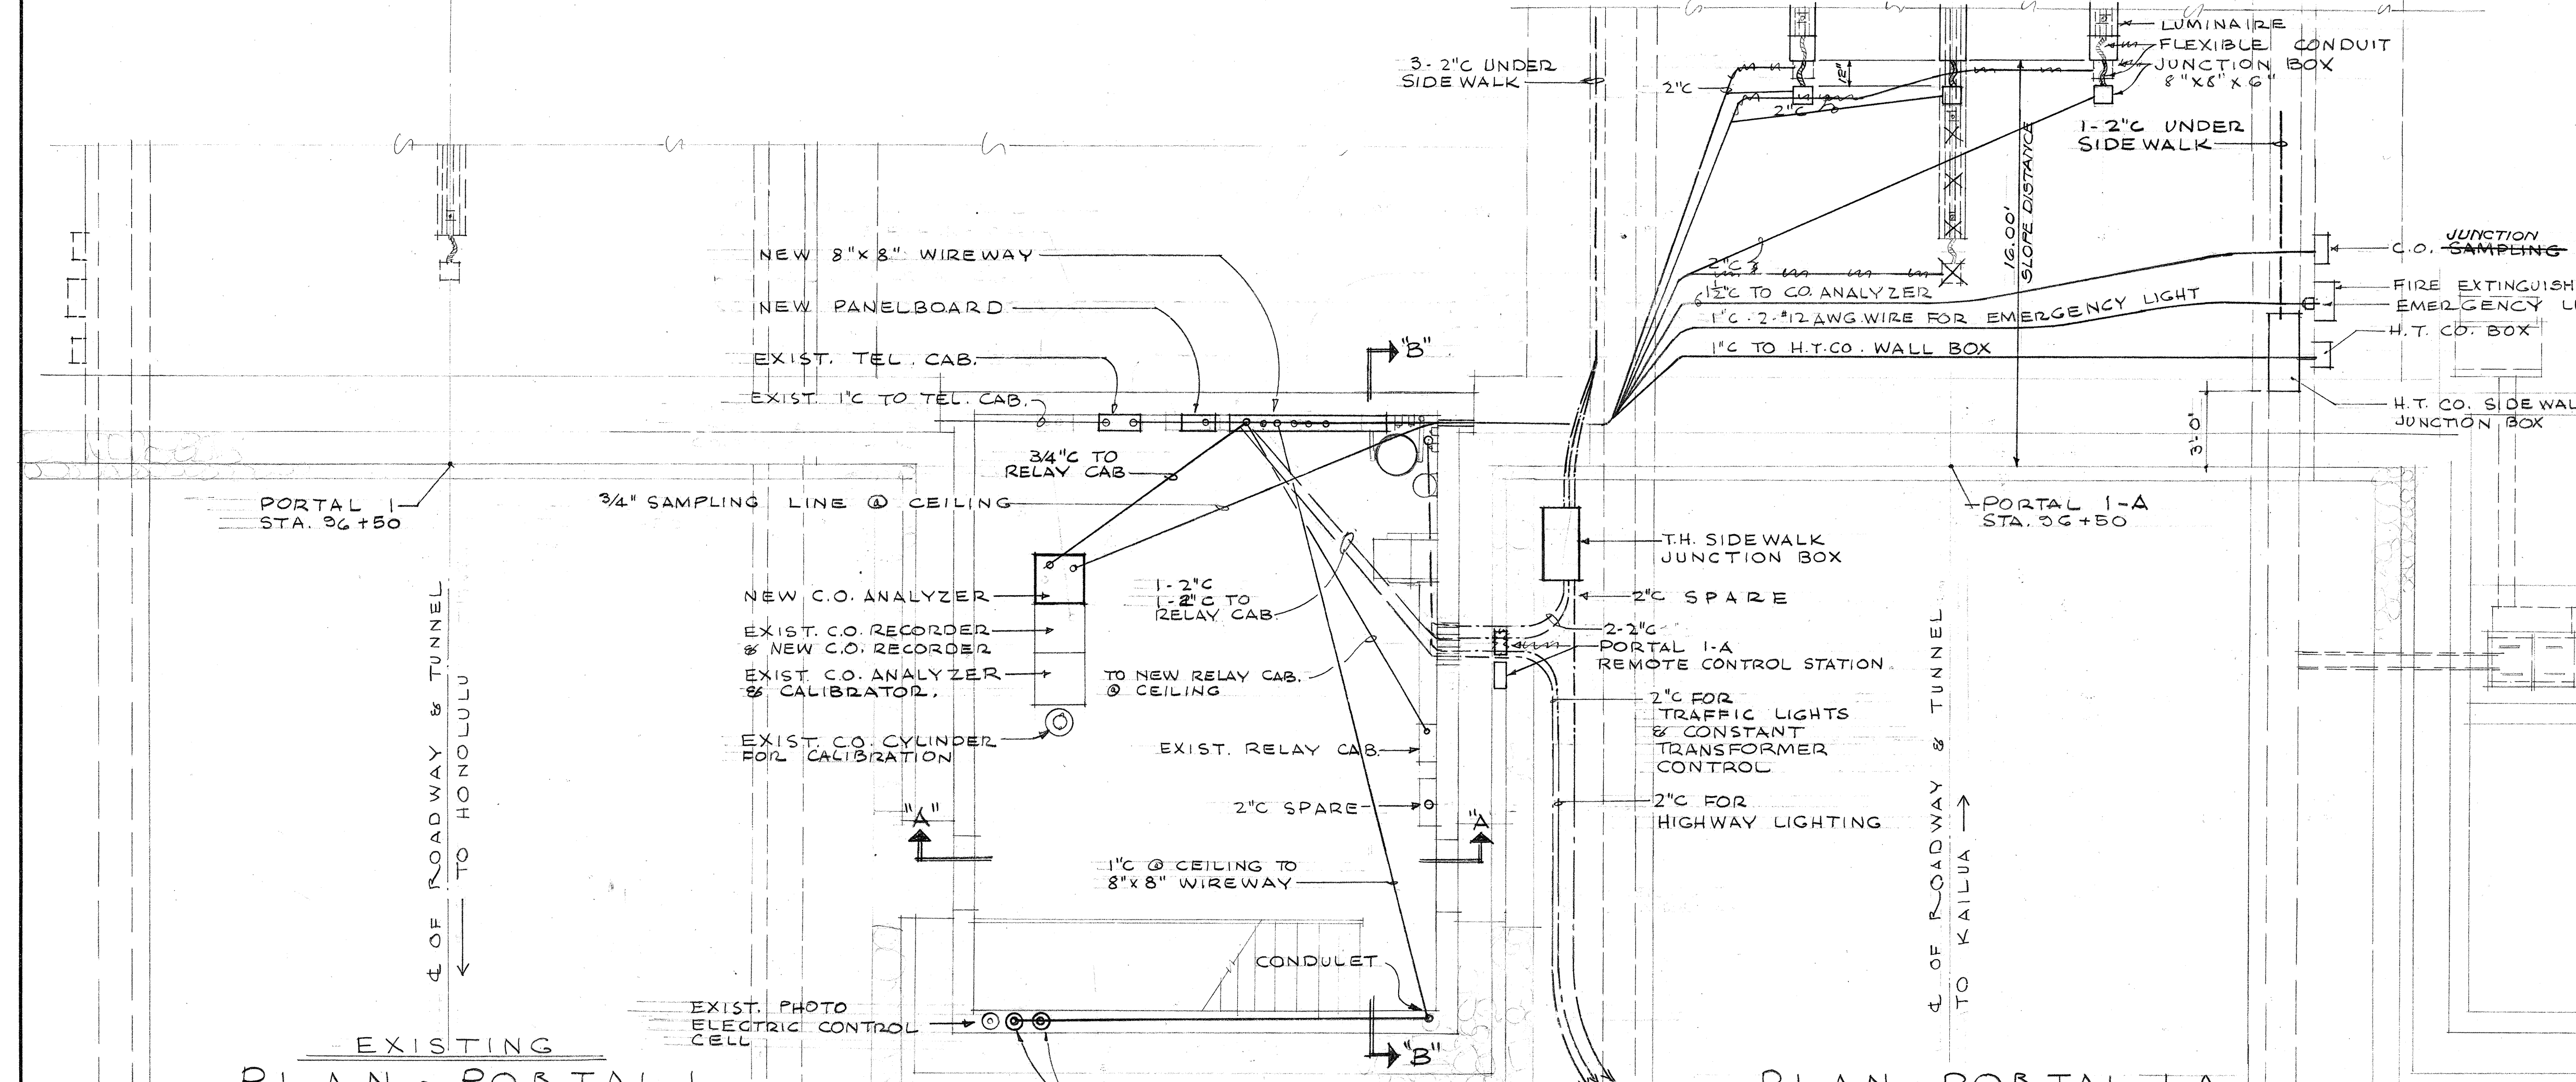

EXISTING
PLAN - PORTAL I
SCALE: 1/4" = 1'-0"

PLAN - PORTAL I-A
SCALE: 1/4" = 1'-0"

- CEILING
- 4" SLEEVE - SPARE
 - 3" SLEEVE - 2" TUNNEL LIGHTING
 - 2" SLEEVE - 1 1/2" TO CO. SAMPLING BOX
 - 3" SLEEVE - 2" TUNNEL LIGHTING
 - 2" SLEEVE - 1" TO H.T. CO. WALL PHONE
 - 3" SLEEVE - 2" TUNNEL LIGHTING
 - 2" SLEEVE - 1" TO EMERGENCY LIGHT

SECTION "C-C"
SHOWING CONDUITS ASSIGNMENTS
IN EXISTING SLEEVES AT WALL
SCALE: 1 1/2" = 1'-0"

NOTES:


ALL NEW CONDUITS WILL RUN THROUGH MASONRY THROUGH EXISTING SLEEVES.

ORIGINAL PLAN	DESIGNED BY	DATE
NO.	TRACED BY	
	QUANTITIES BY	
	CHECKED BY	
	CHECKED BY	


TERRITORIAL HIGHWAY DEPARTMENT
TERRITORY OF HAWAII
ELECTRICAL
PORTAL I-A
PALI ROAD
OUTBOUND TUNNELS
PROJ. NO. BF-OGI-1(5)
SCALE: AS NOTED DATE: MAY 1957

JAMES J. OBERHAUSEN
ELECTRICAL ENGINEER


FED. ROAD DIST. NO.	STATE	FED. AID PROJ. NO.	FISCAL YEAR	SHEET NO.	TOTAL SHEETS
HAWAII	HAW	BF-0611	1957	49	79

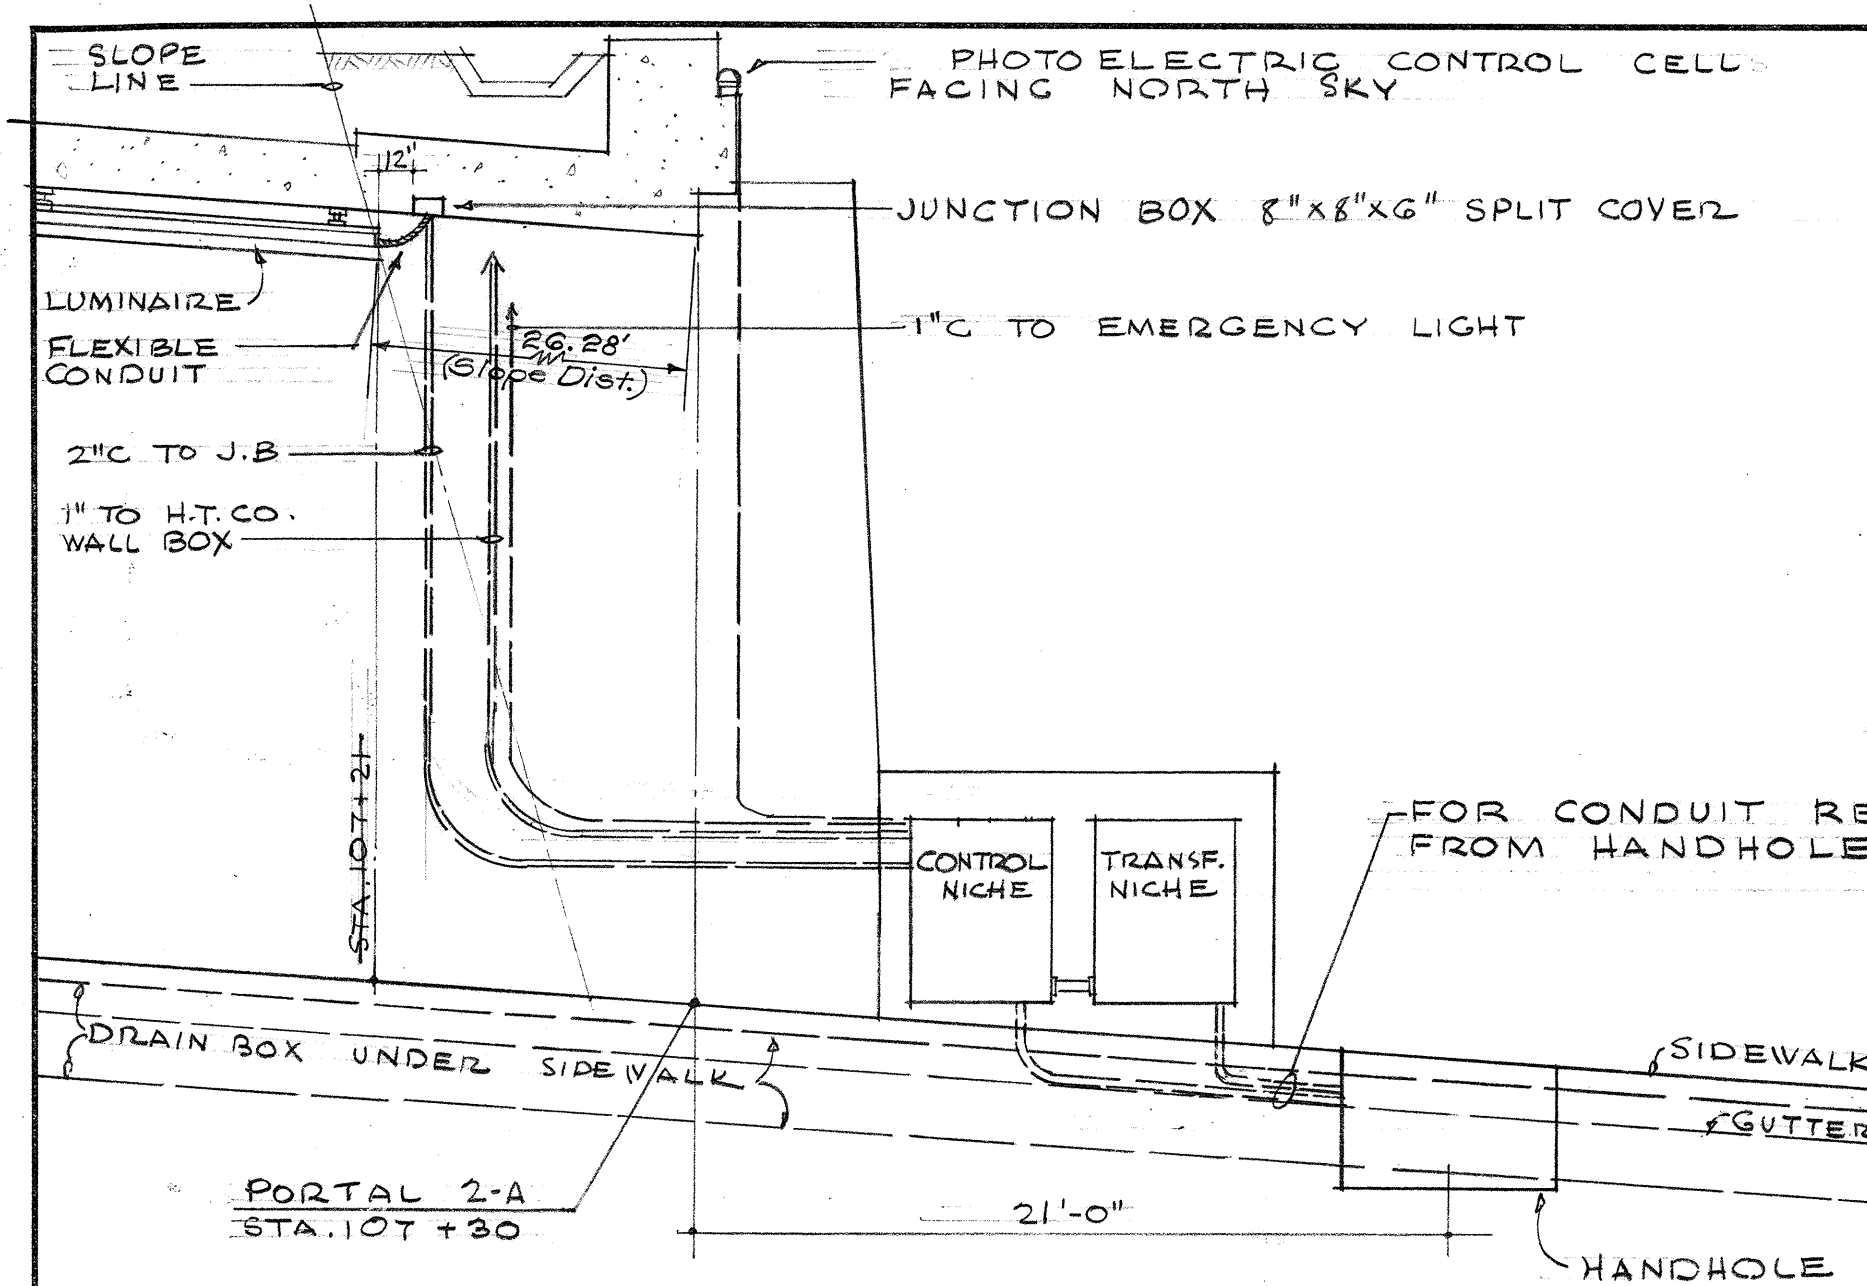



PORTAL 2-A • SECTION "A-A"
SCALE: 3/16" = 1'-0"

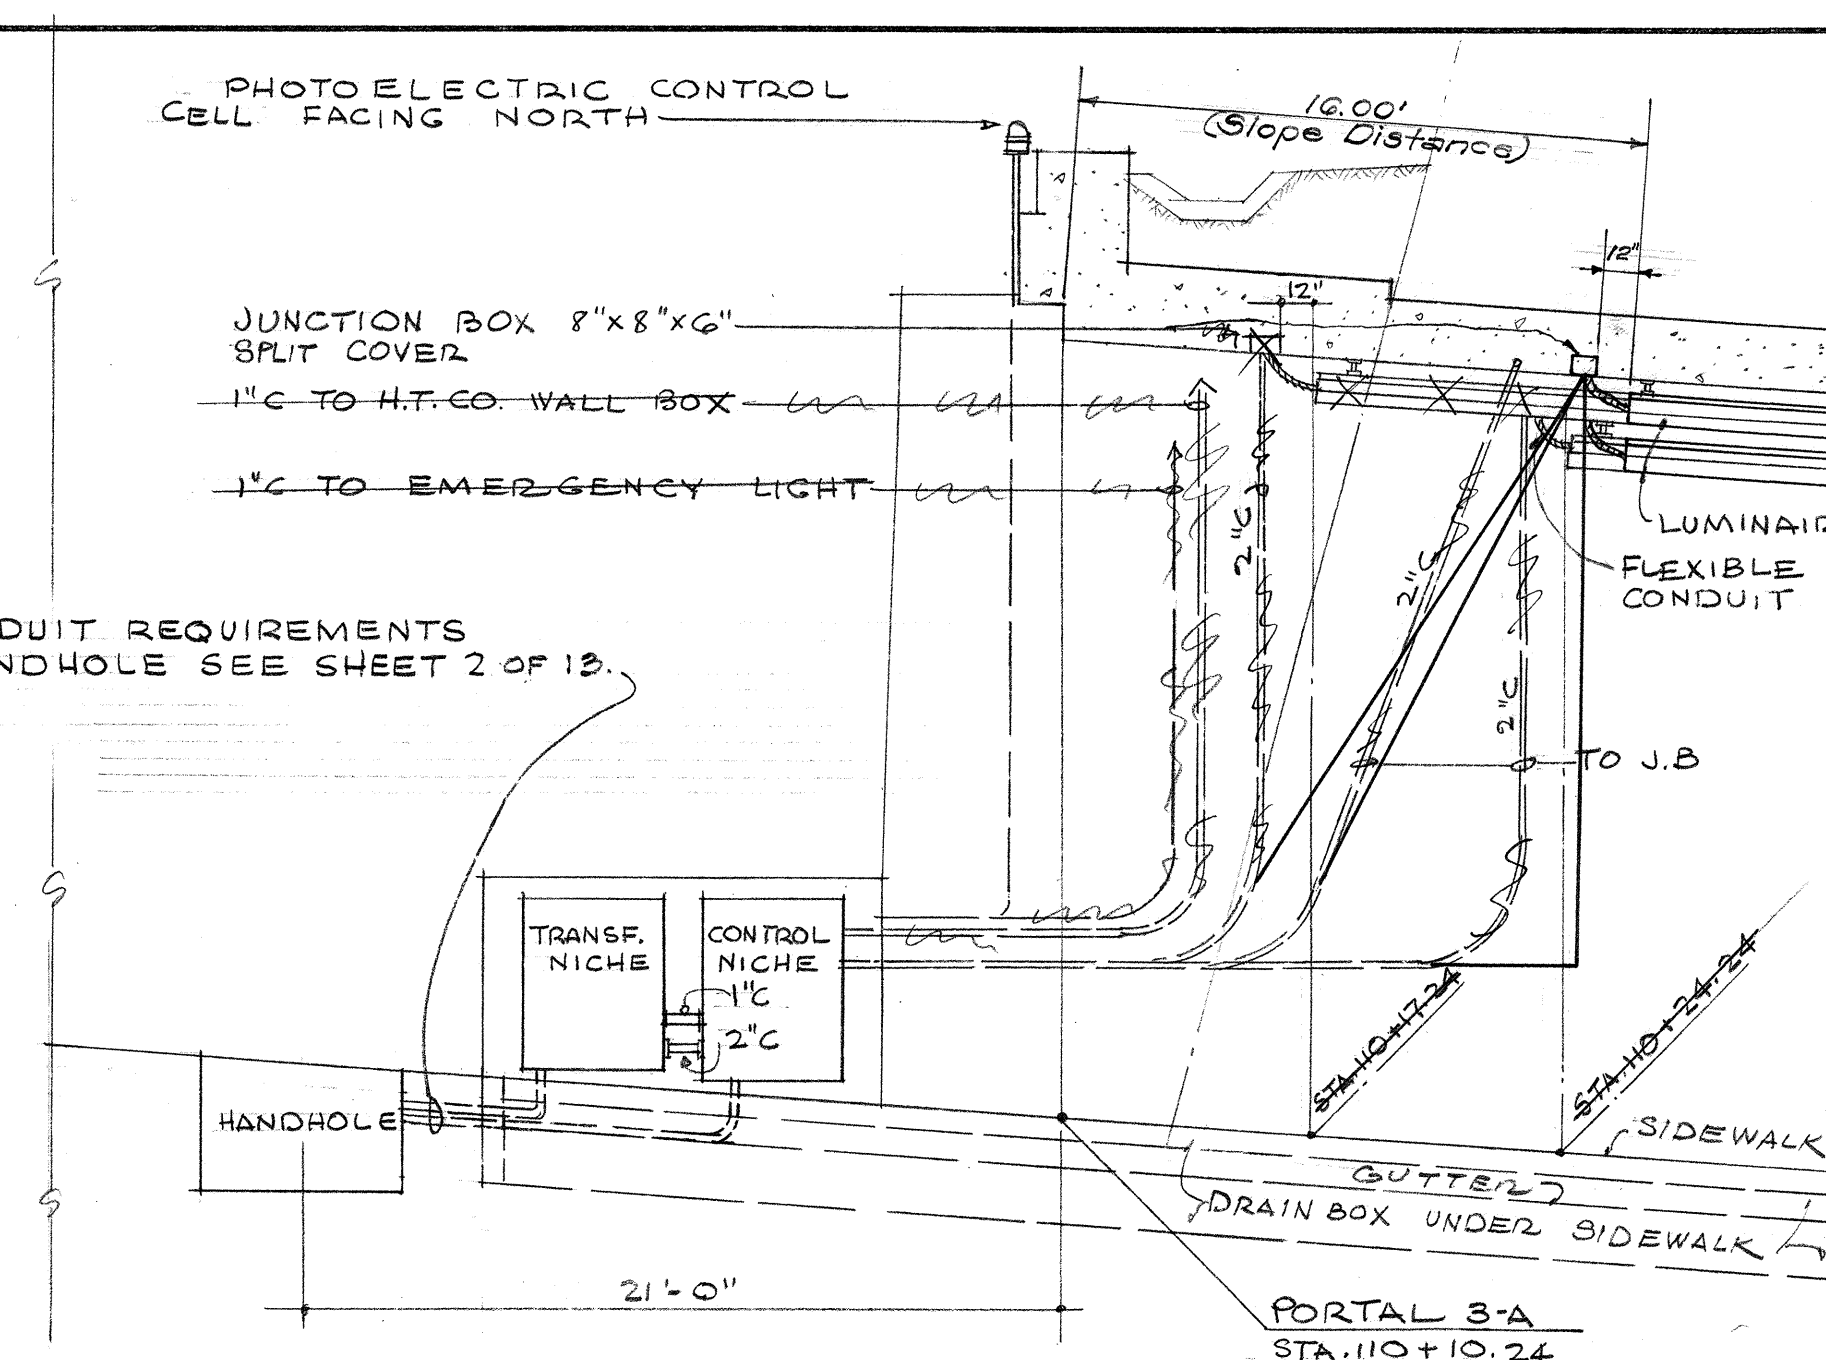


PORTAL 3-A • SECTION "A-A"
SCALE: 3/16" = 1'-0"

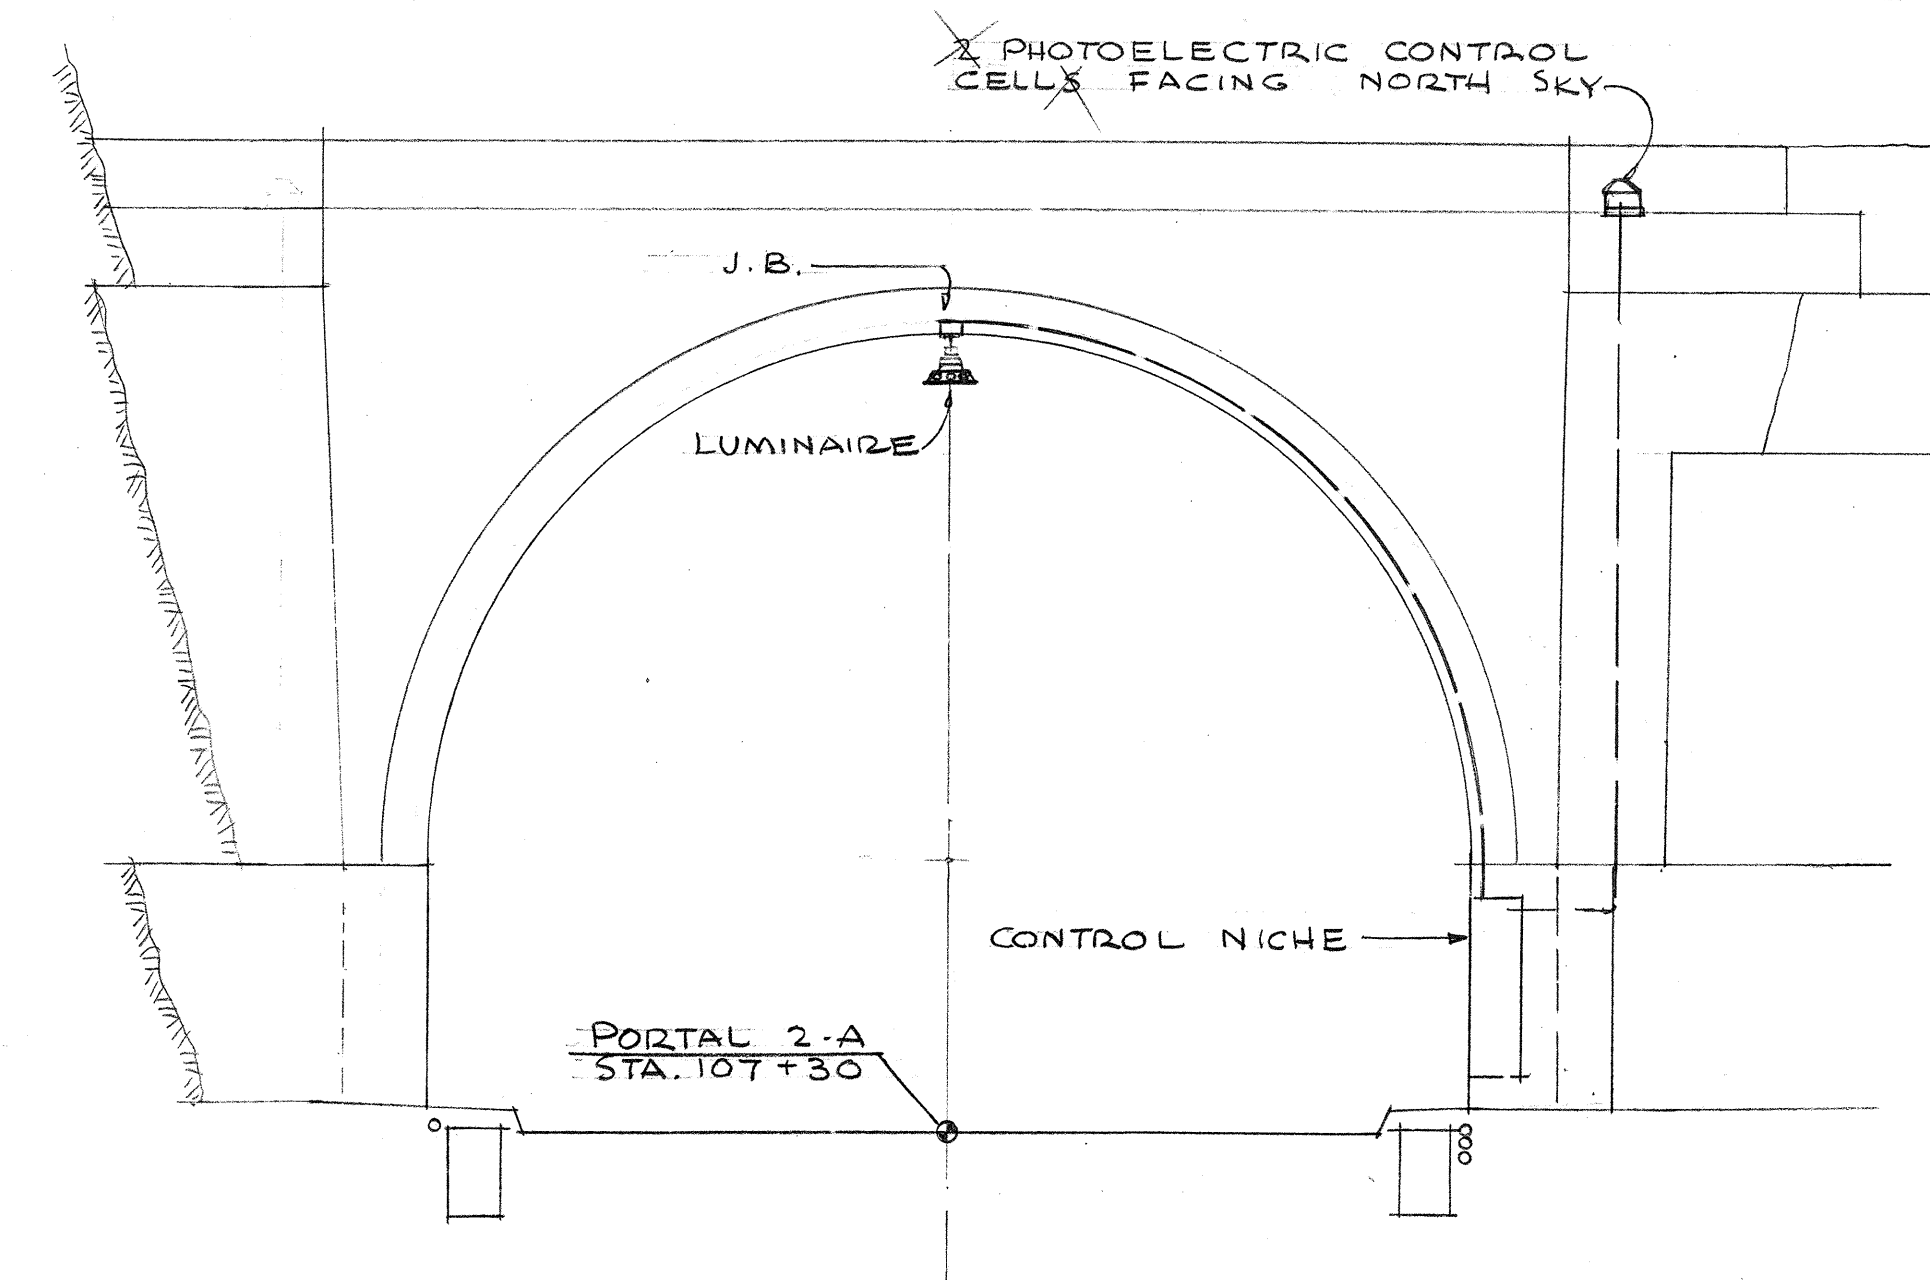

PORTAL 2-A • ELEVATION
SCALE: 3/16" = 1'-0"

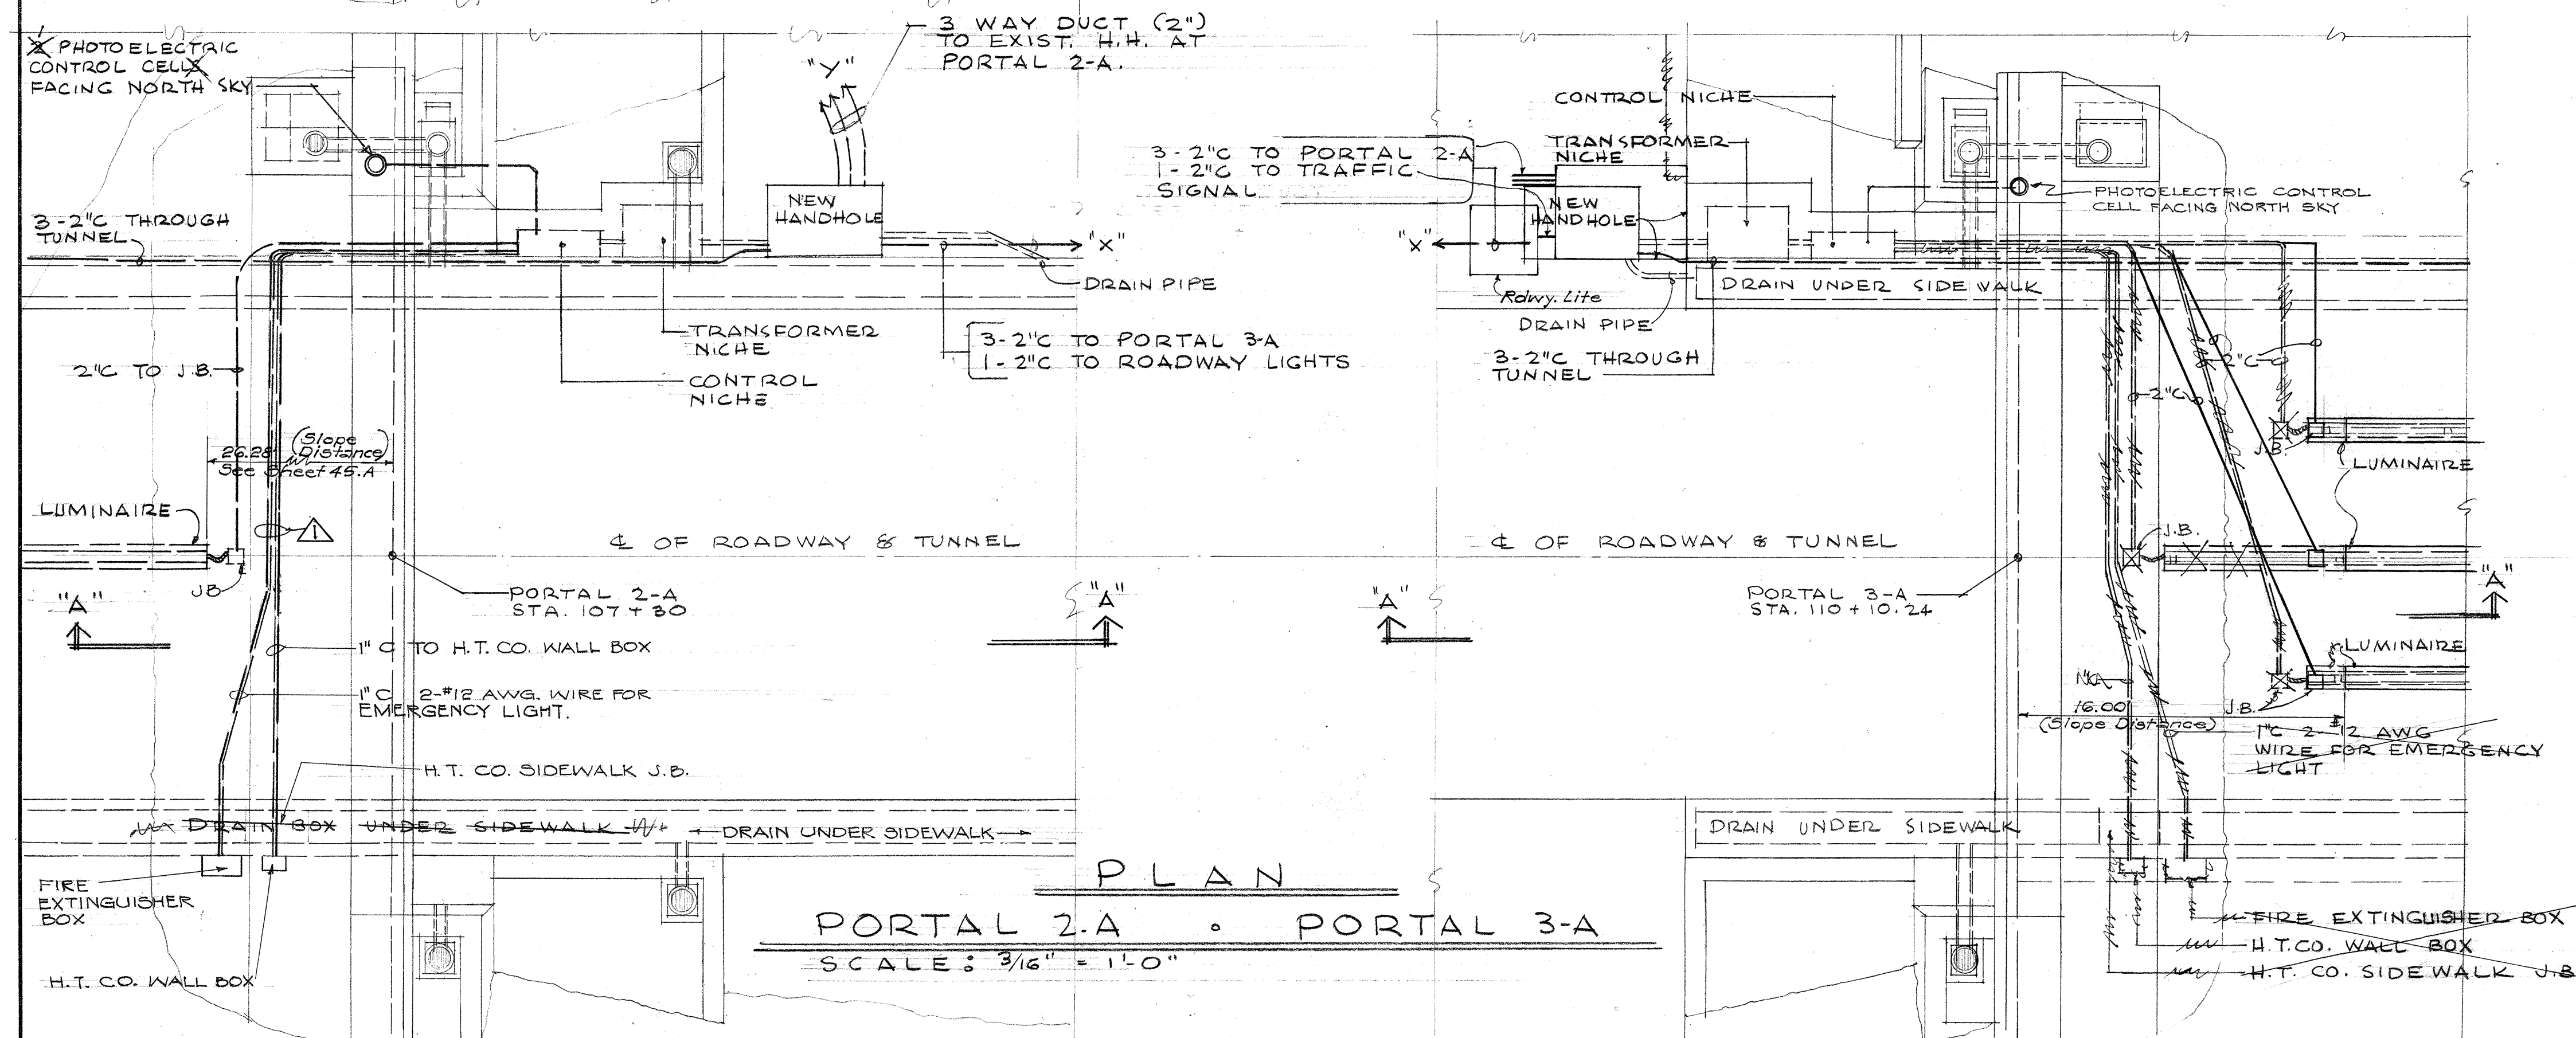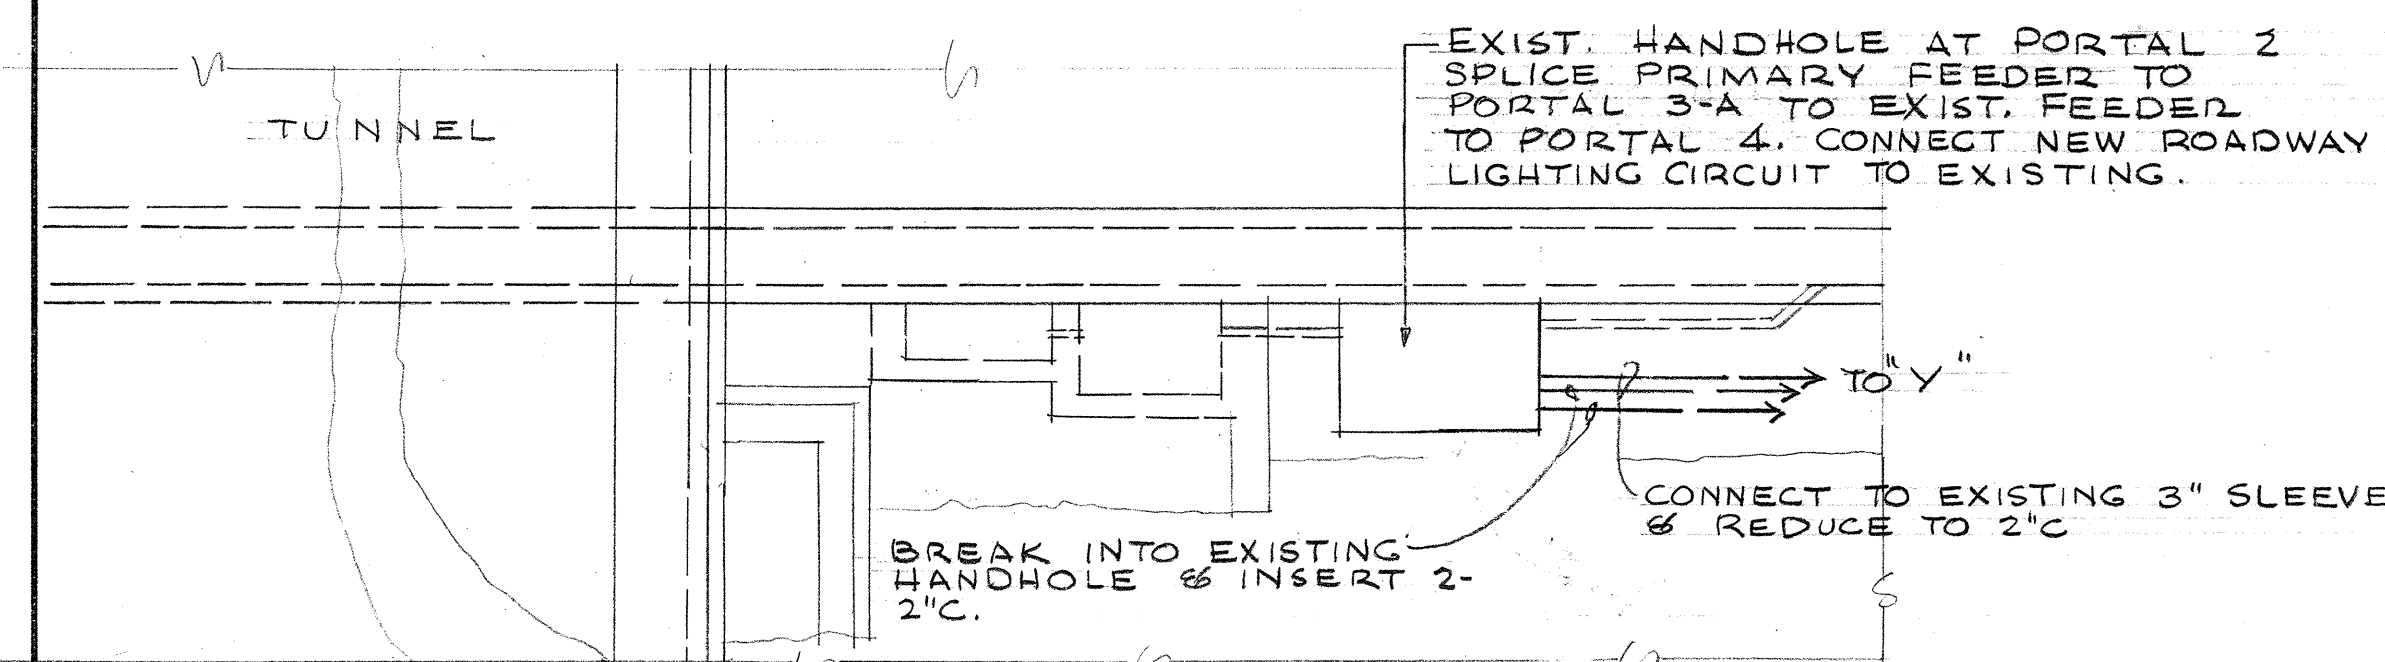

PLAN
PORTAL 2-A • PORTAL 3-A
SCALE: 3/16" = 1'-0"

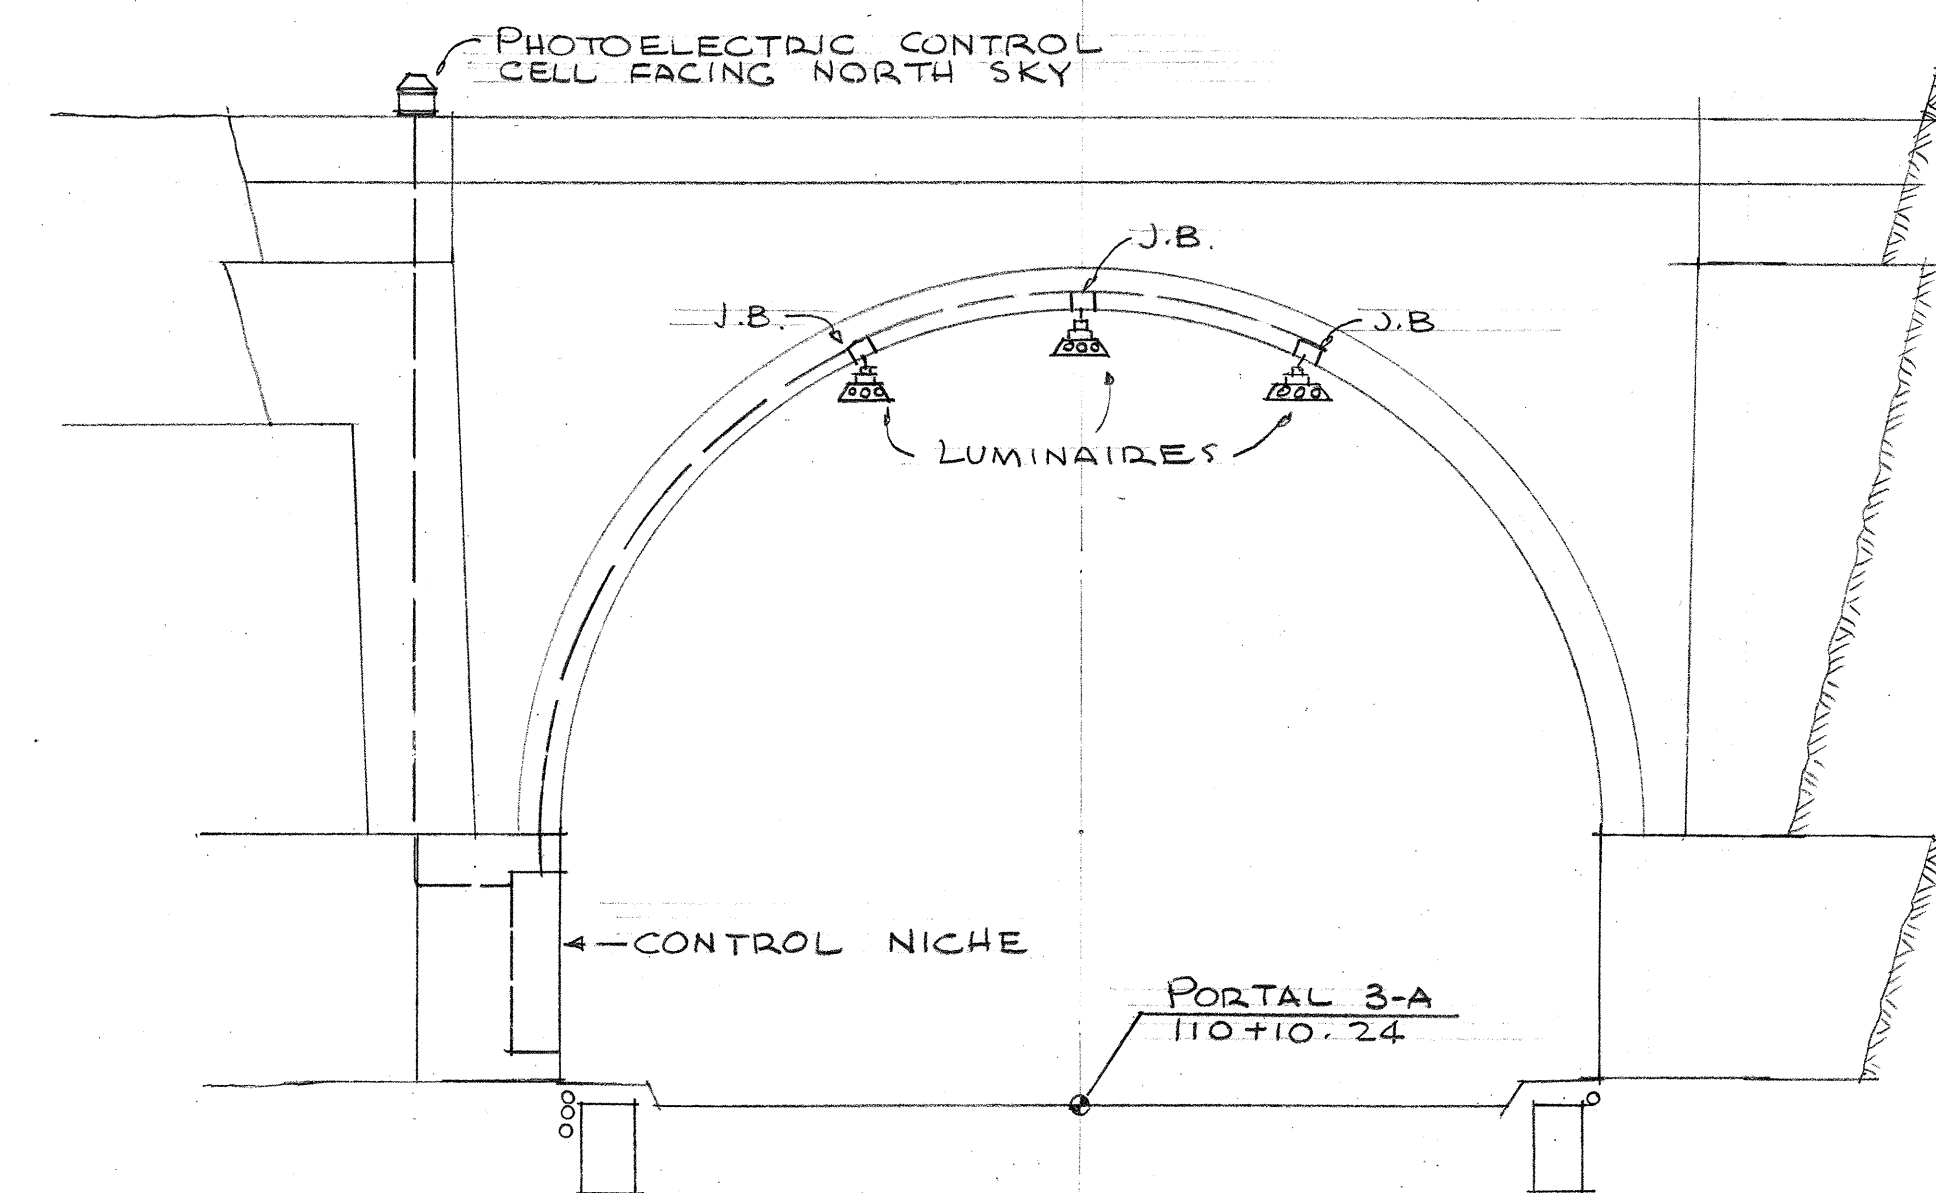


PORTAL 3A • ELEVATION
SCALE: 3/16" = 1'-0"

DATE	DESIGNED BY	TRACED BY	CHECKED BY
.....			
ORIGINAL PLAN	DESIGNED BY	TRACED BY	CHECKED BY
NO.			


REVISION: 12/27/57 Δ CORRECTION
TERRITORIAL HIGHWAY DEPARTMENT
TERRITORY OF HAWAII
ELECTRICAL
PORTAL 2-A
& PORTAL 3-A
PALI ROAD
OUTBOUND TUNNELS
PROJ. NO. BF-0611(5)
JAMES J. OBERHAUSEN
ELECTRICAL ENGINEER
SCALE: AS NOTED
DATE: MAY 1957

SHEET NO. 7 OF 13 SHEETS


5896.49

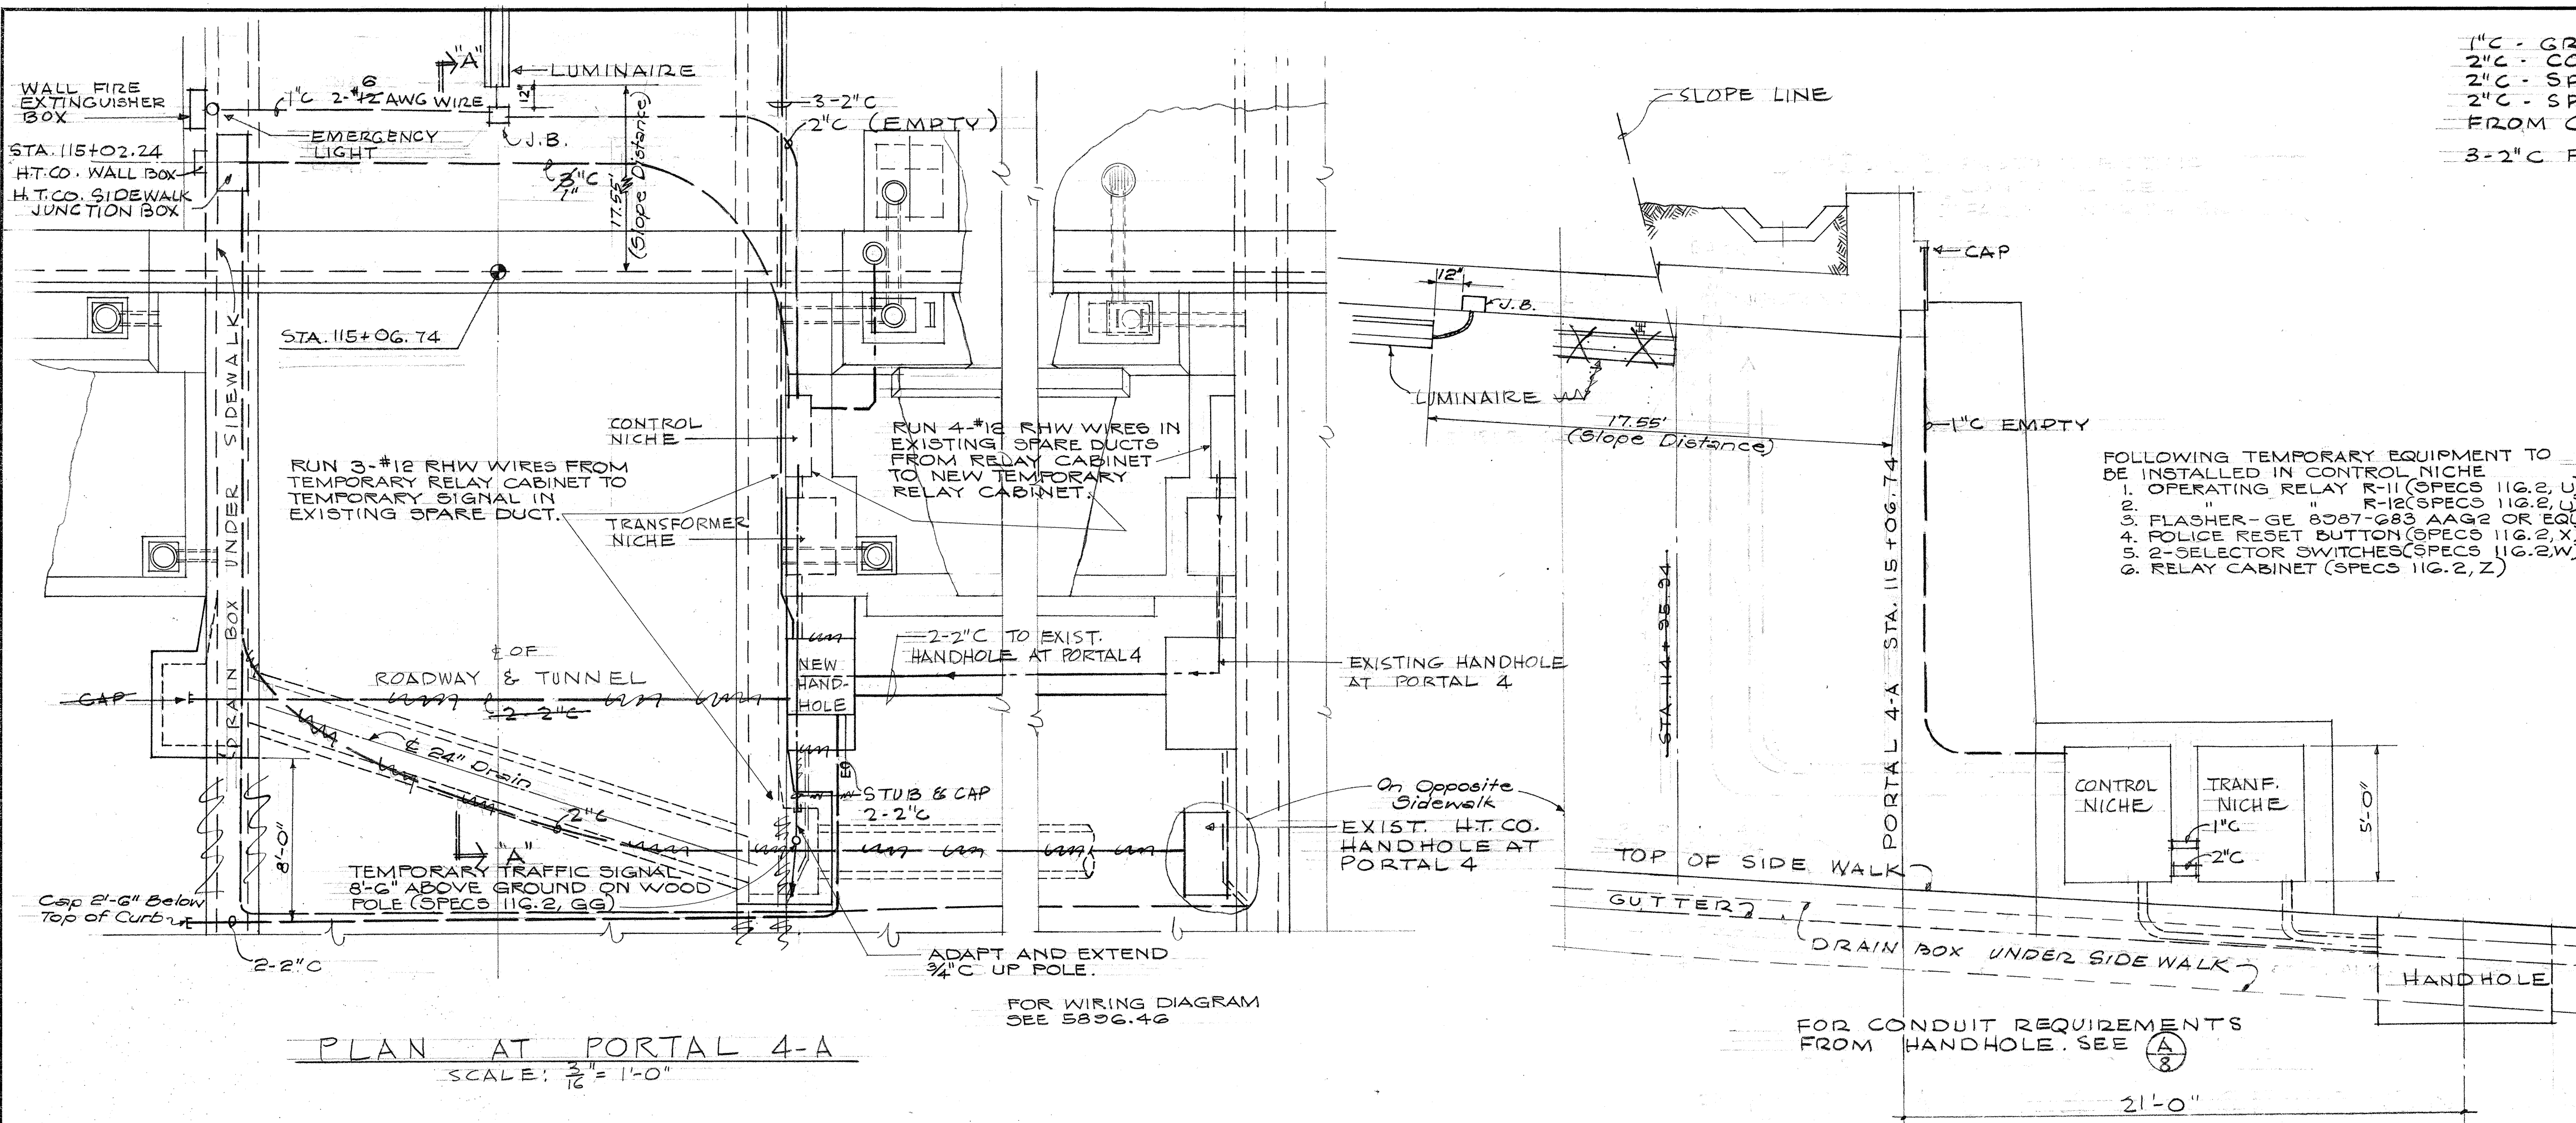

PORTAL 4-A - SECTION "A-A"
 SCALE: 1/4" = 1'-0"
 NO EQUIPMENT SHALL BE INSTALLED IN NICHES AT PORTAL 4-A UNDER THIS CONTRACT, EXCEPT FOR TEMPORARY TRAFFIC SIGNAL CONTROL.

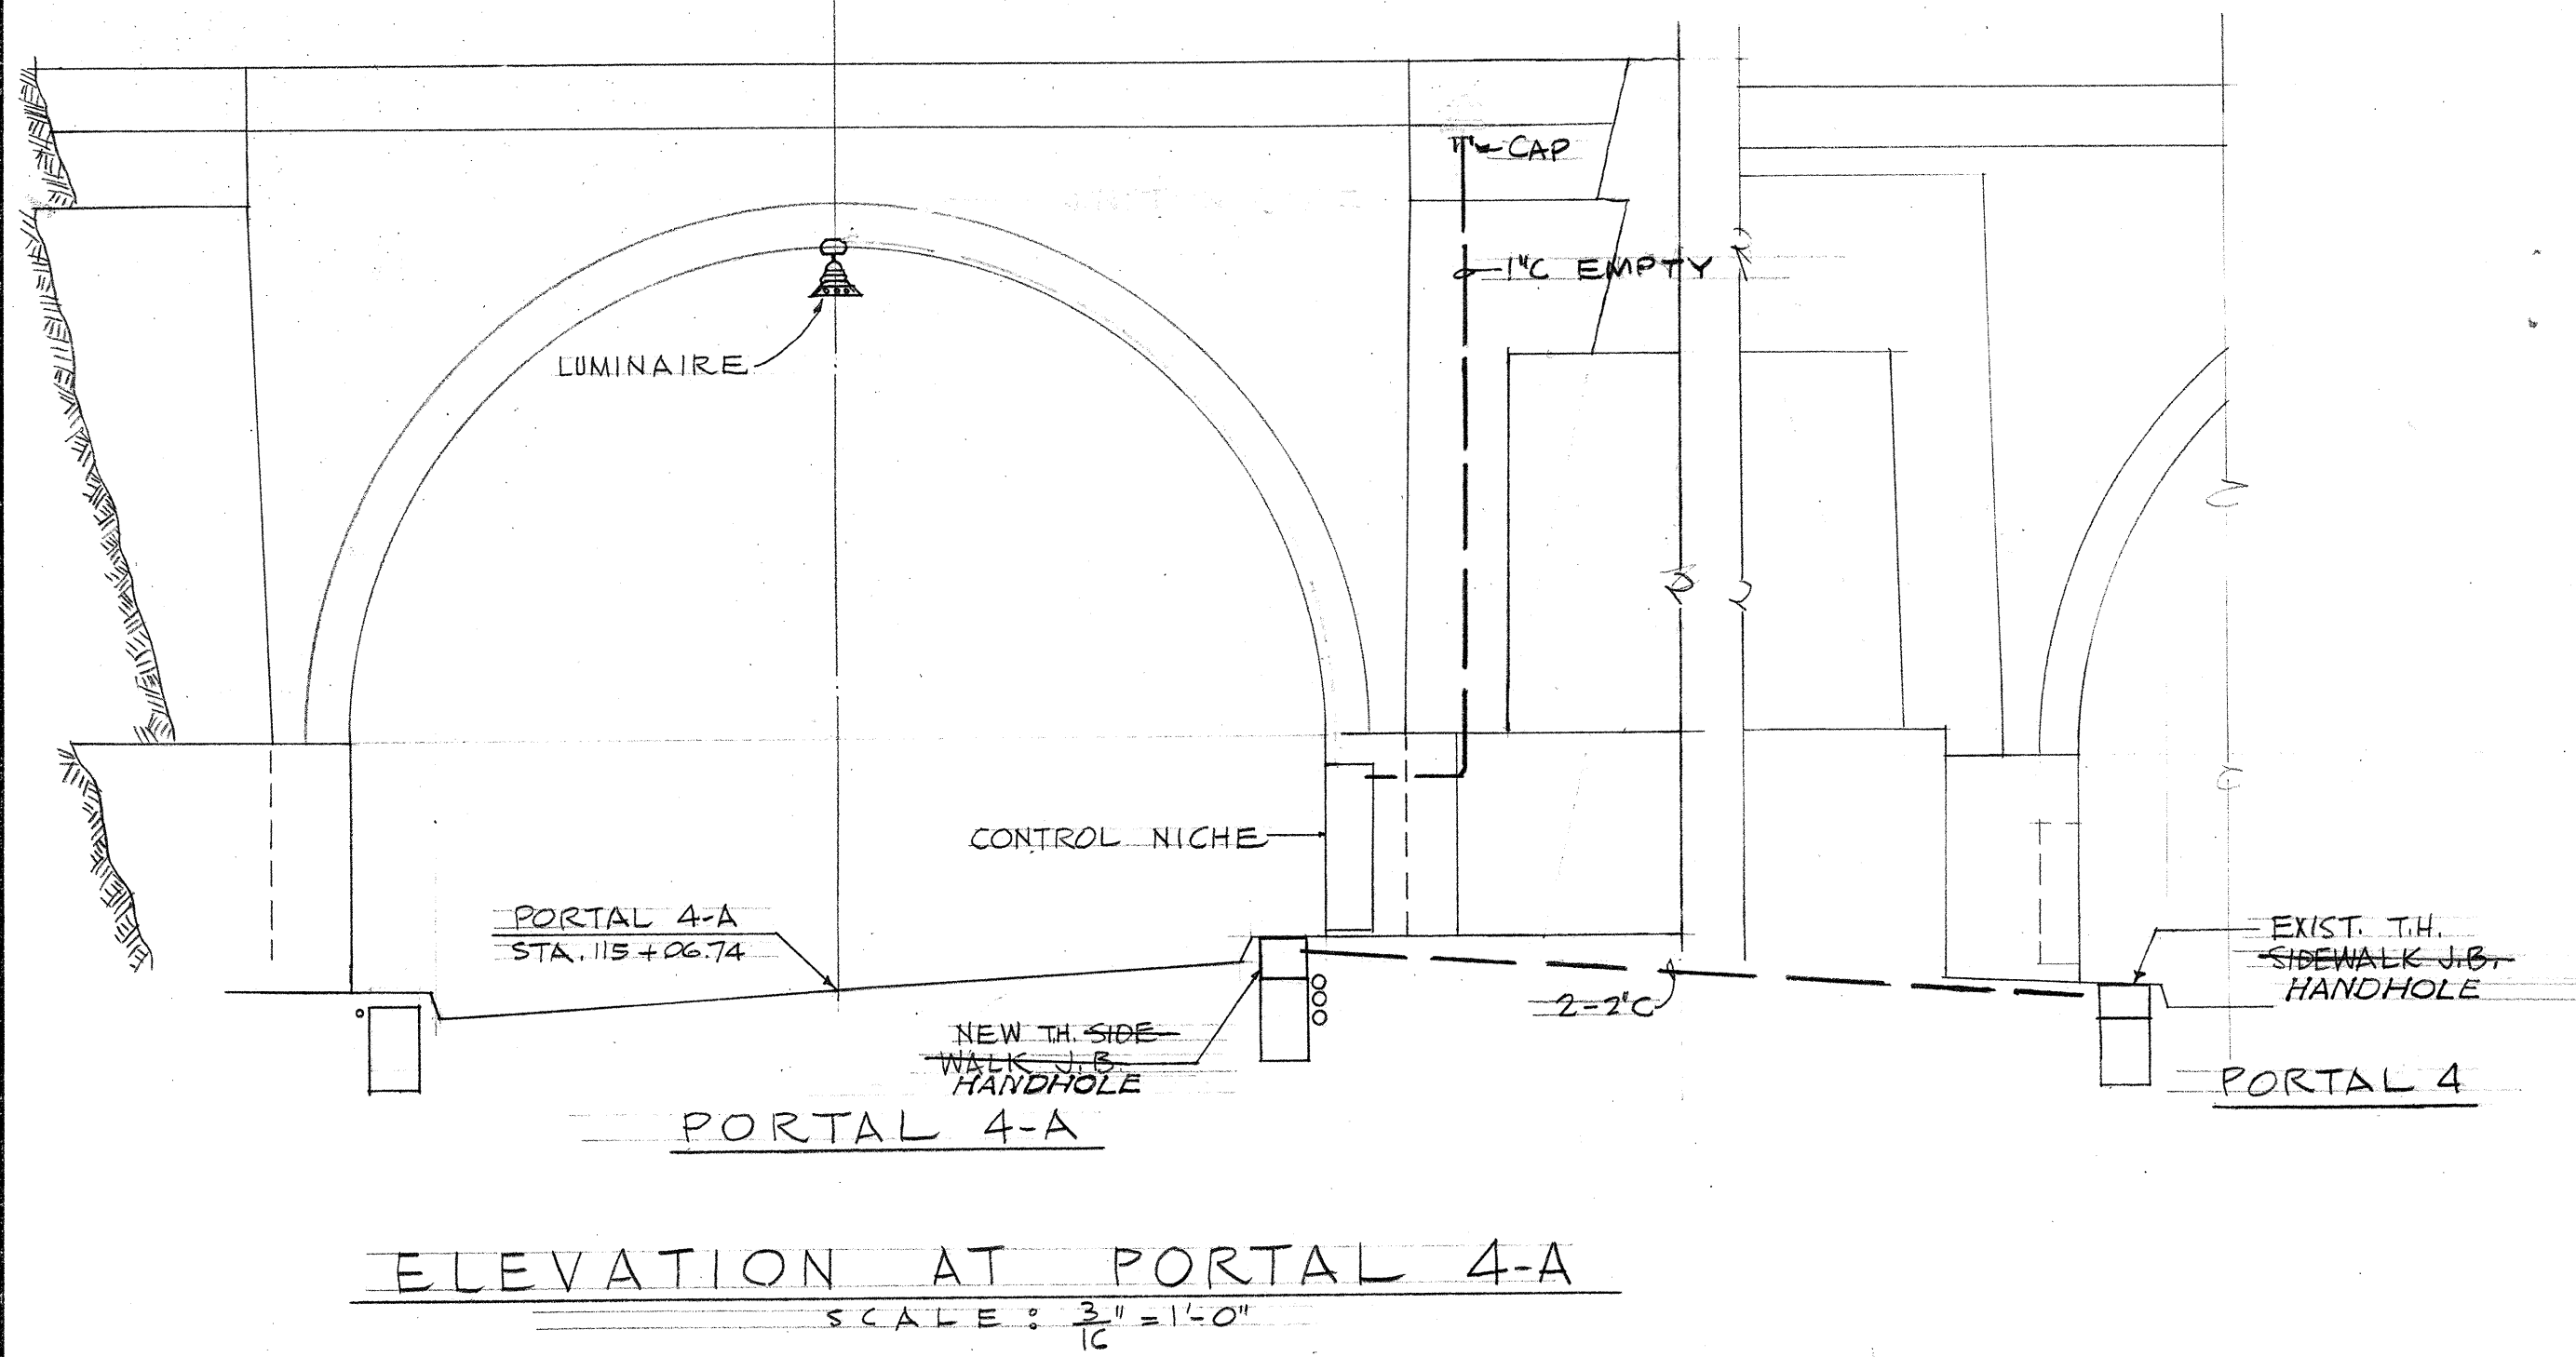


CONDUIT PLANS FOR HANDHOLE A/8
 NOT TO SCALE

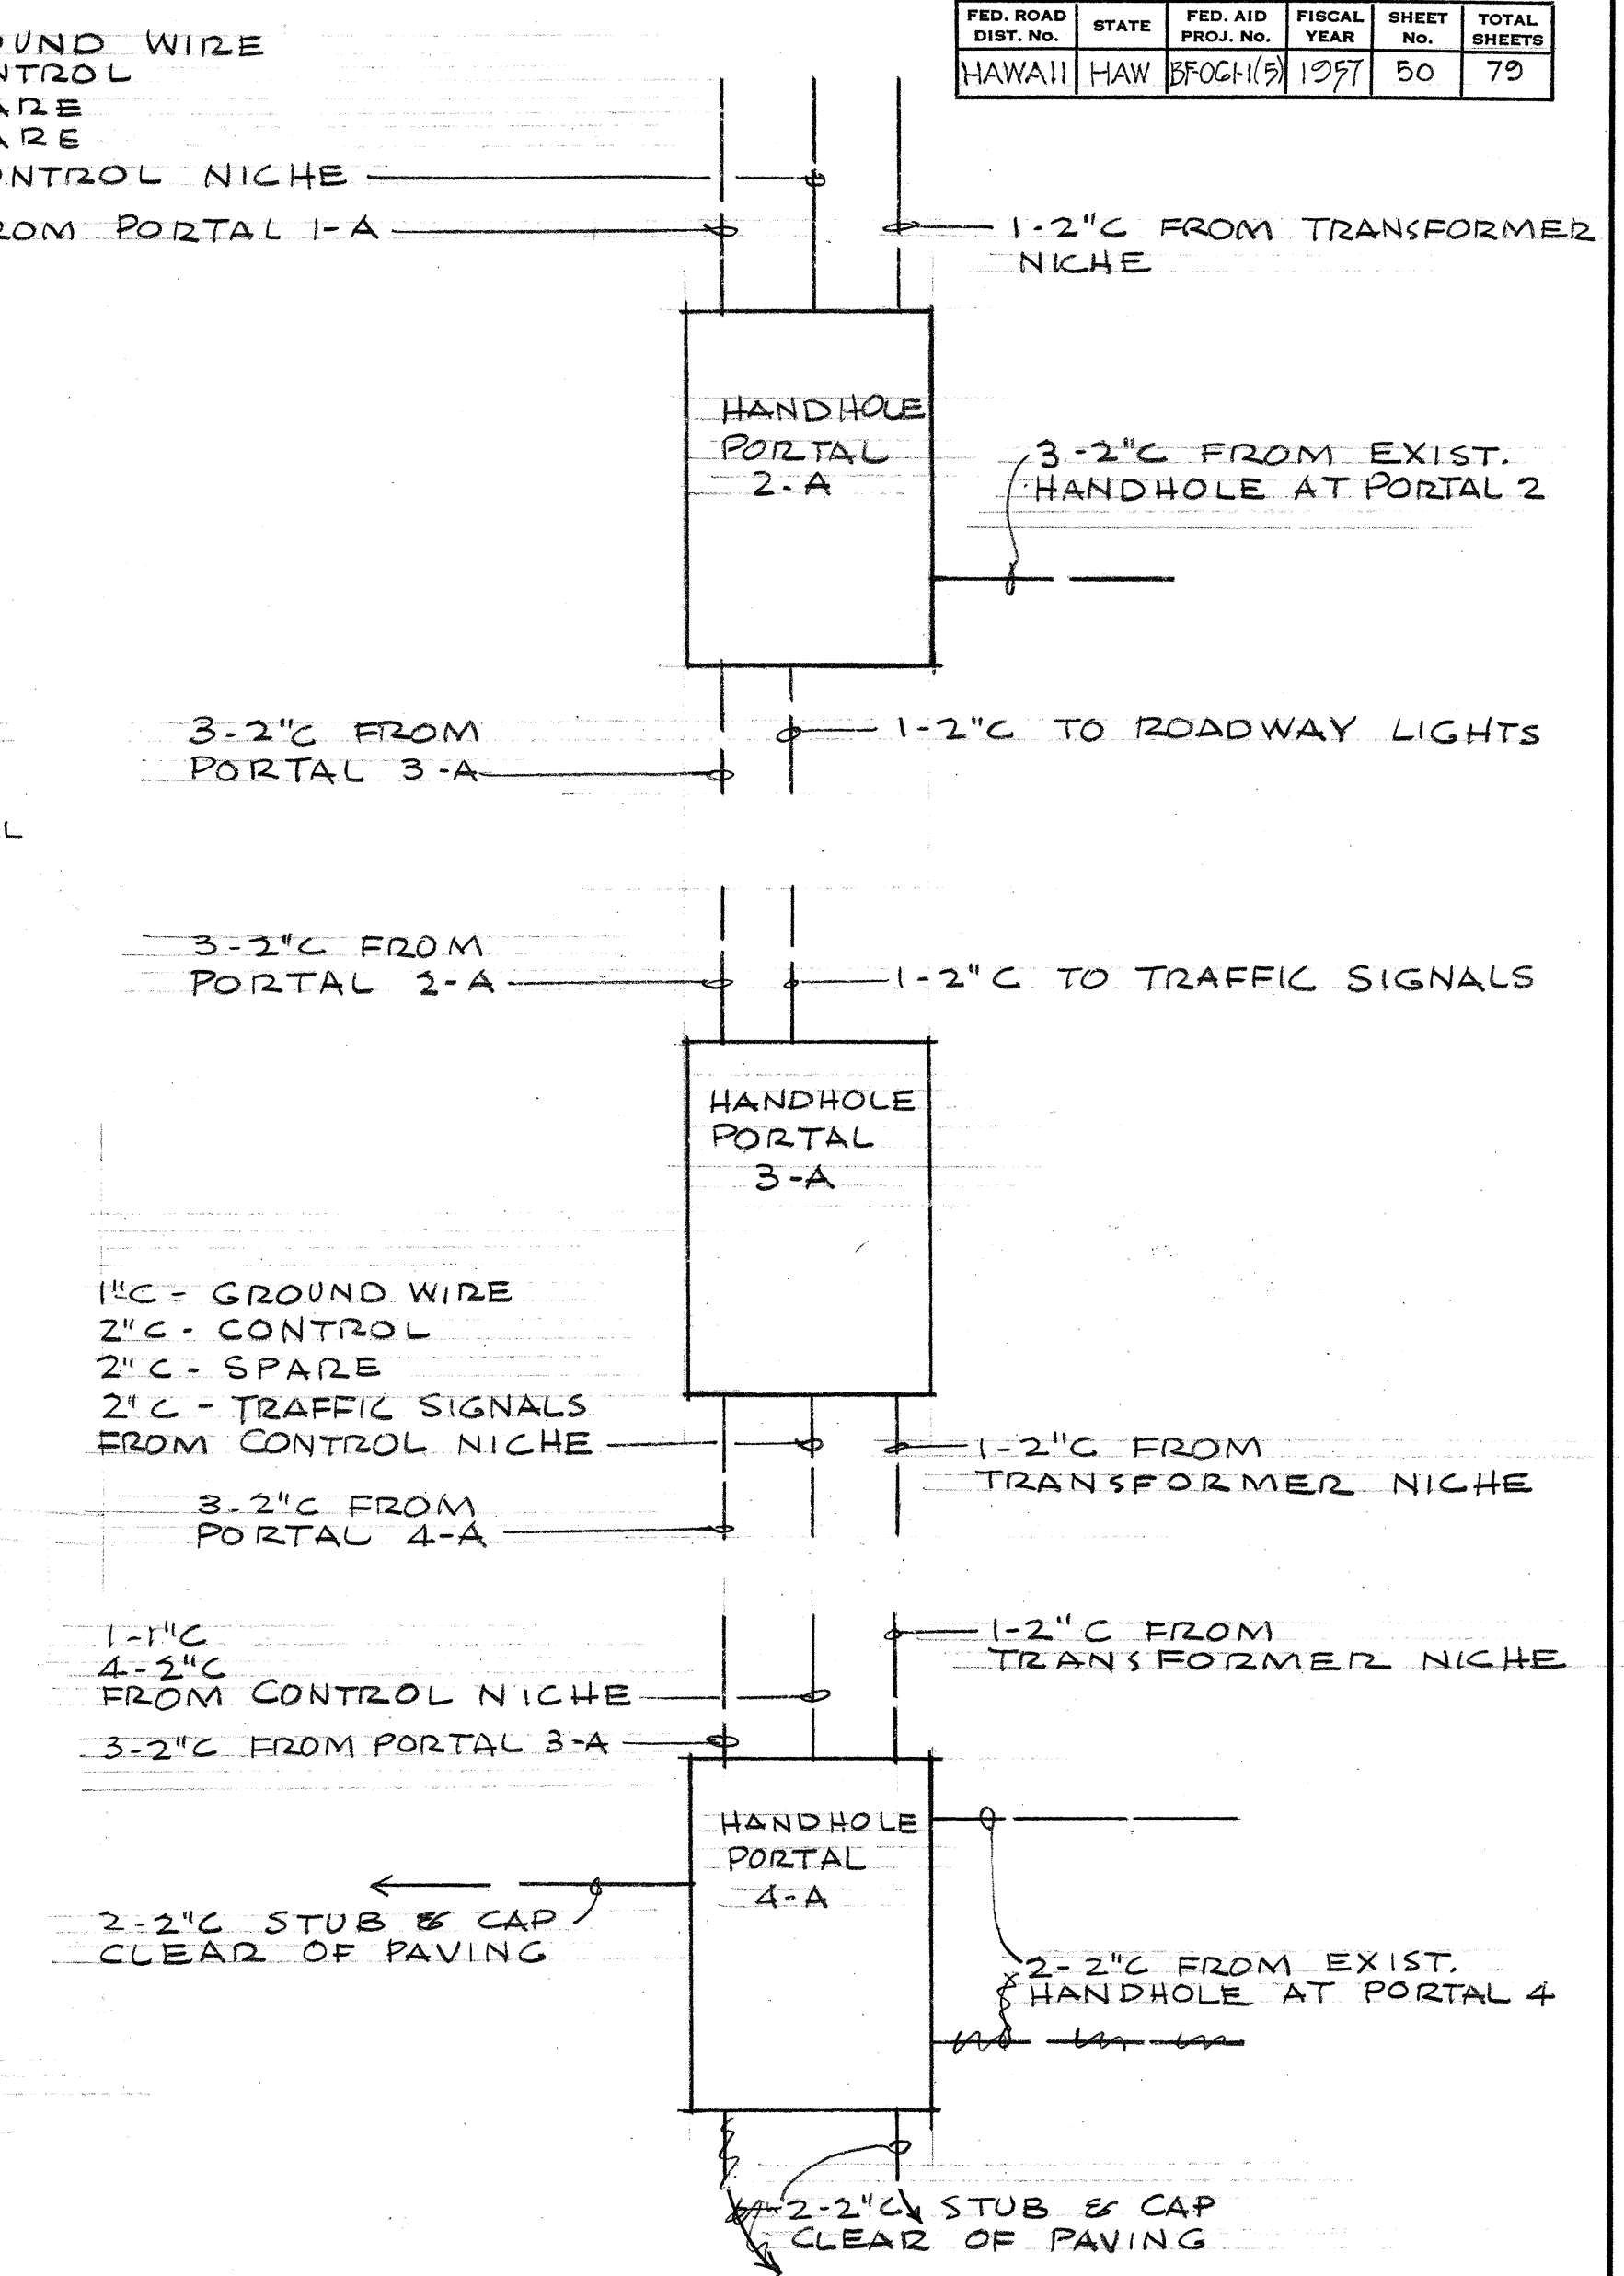


SURVEY PLOTTED BY	DATE
DESIGNED BY	
DRAWN BY	
QUANTITIES CHECKED BY	
NOTE BOOK	
No.	

TERRITORIAL HIGHWAY DEPARTMENT
 TERRITORY OF HAWAII
ELECTRICAL
PORTAL 4-A
PALI ROAD
OUTBOUND TUNNELS
 PROJ. NO. BF061-1(5)
 SCALE: AS SHOWN DATE: MAY 1997


JAMES J. OBERHAUSEN
 ELECTRICAL ENGINEER

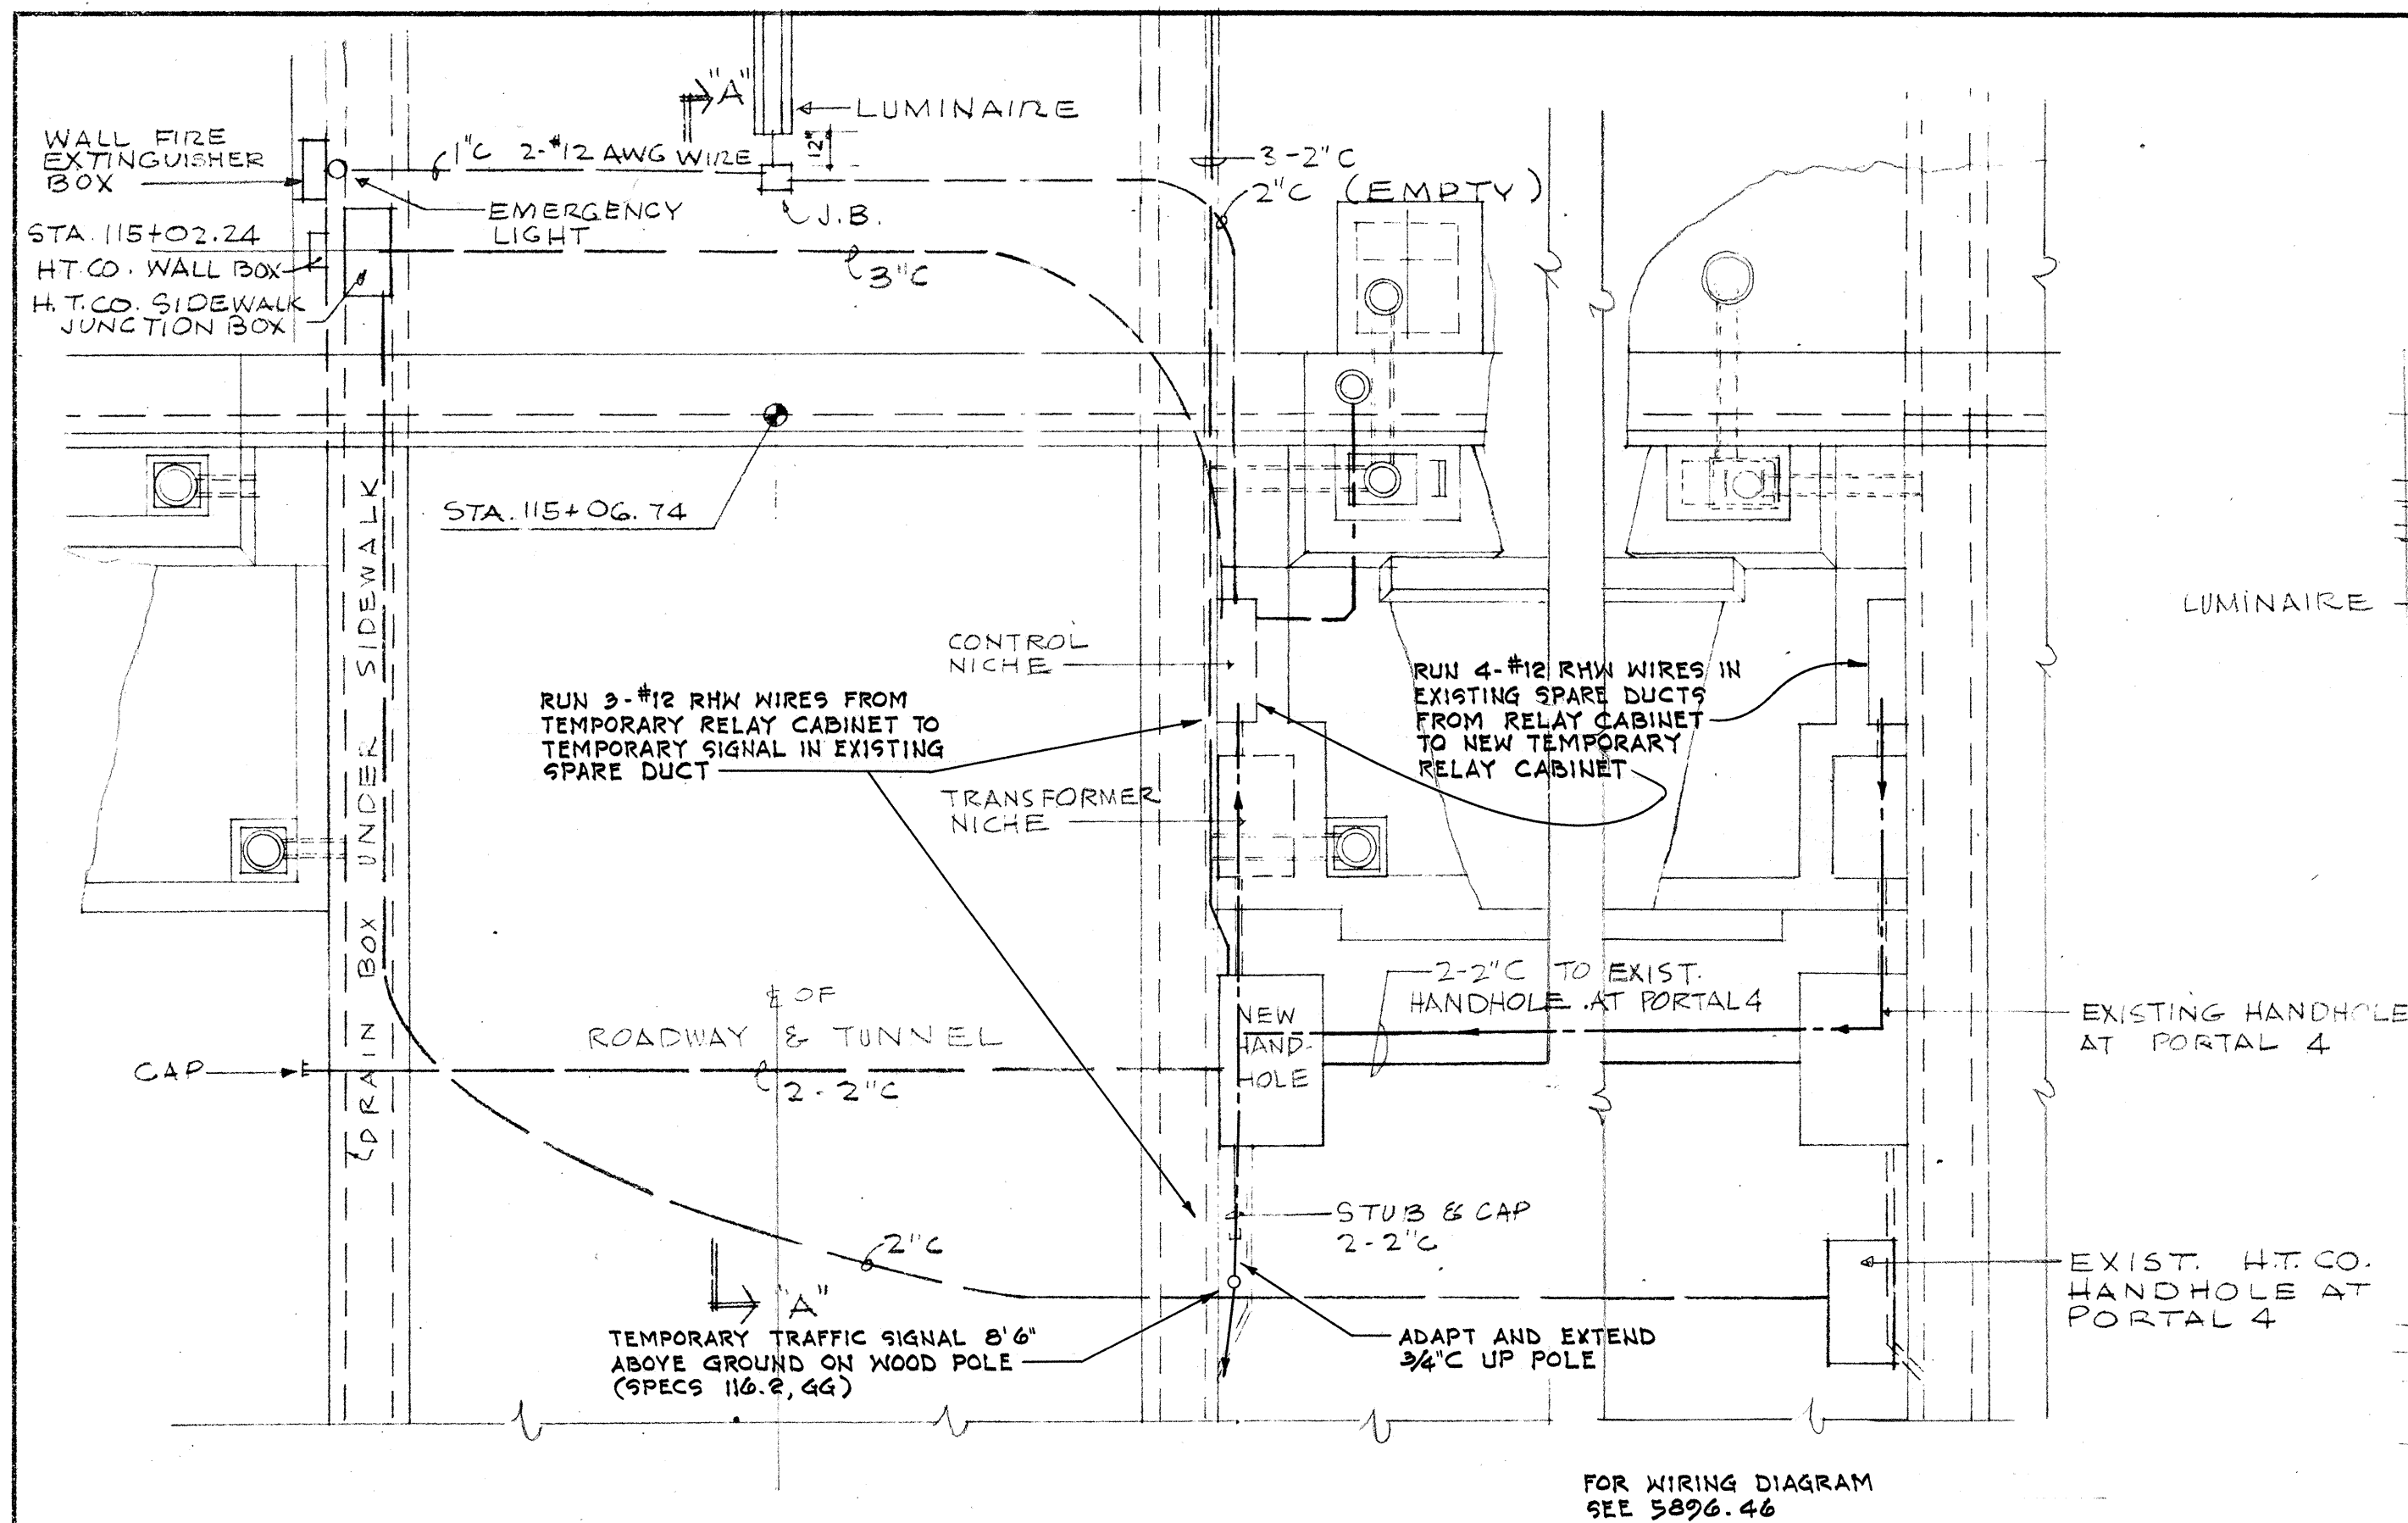

PLAN AT PORTAL 4-A
SCALE: 1/8" = 1'-0"

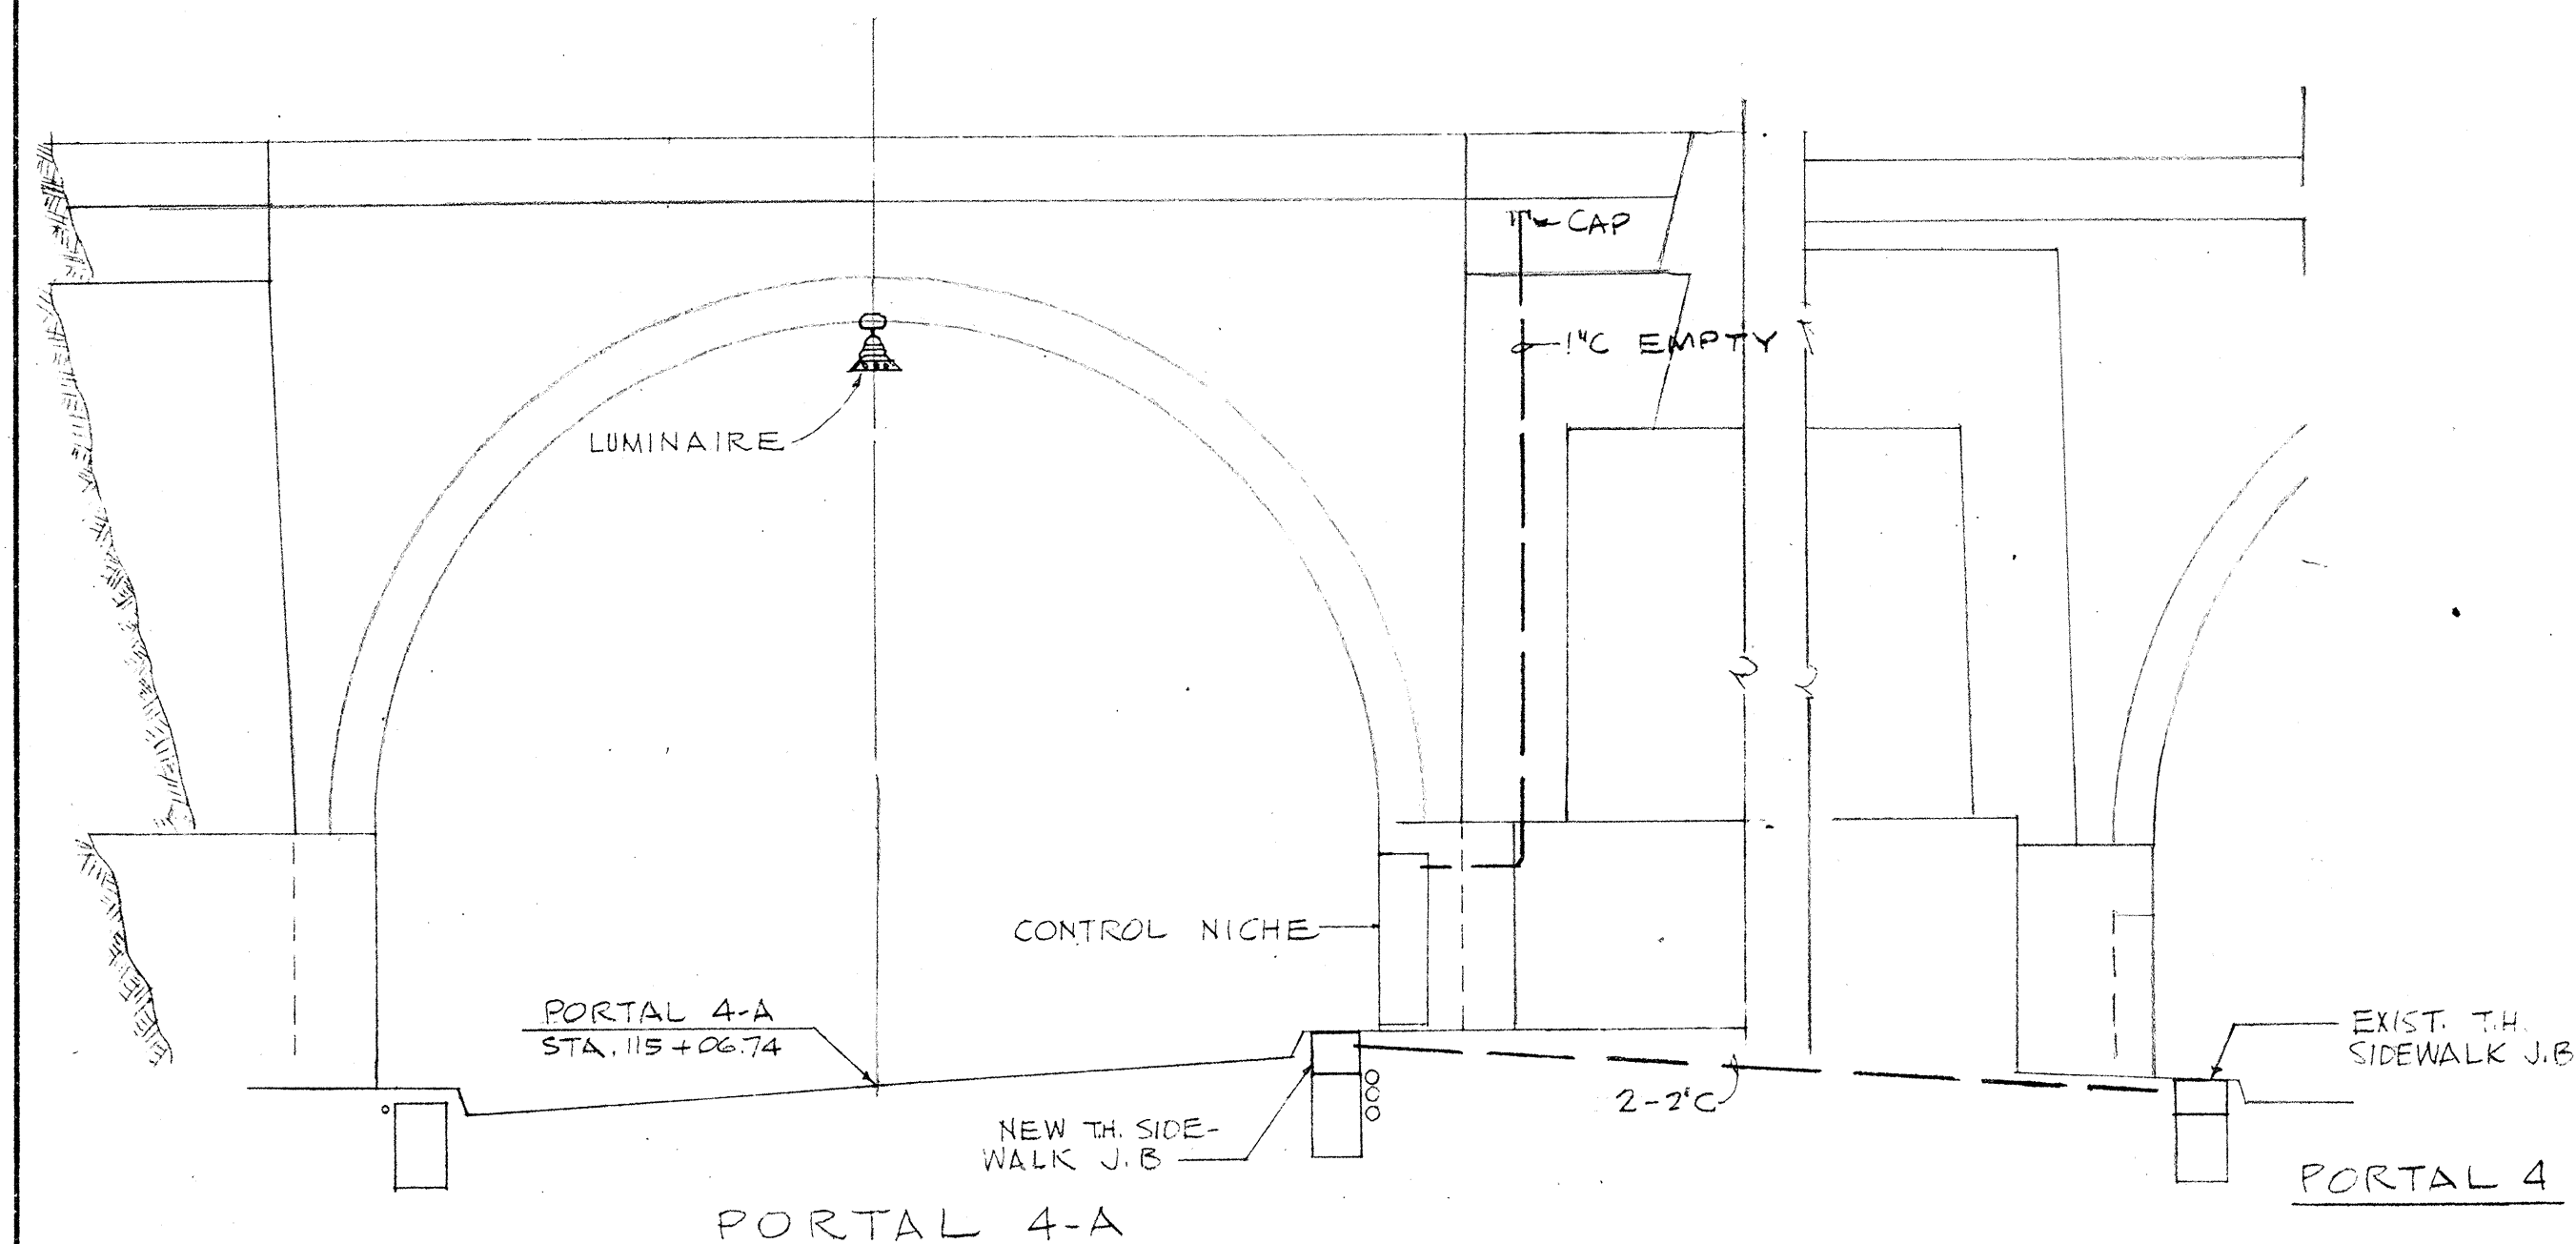

ELEVATION AT PORTAL 4-A
SCALE: 3/16" = 1'-0"

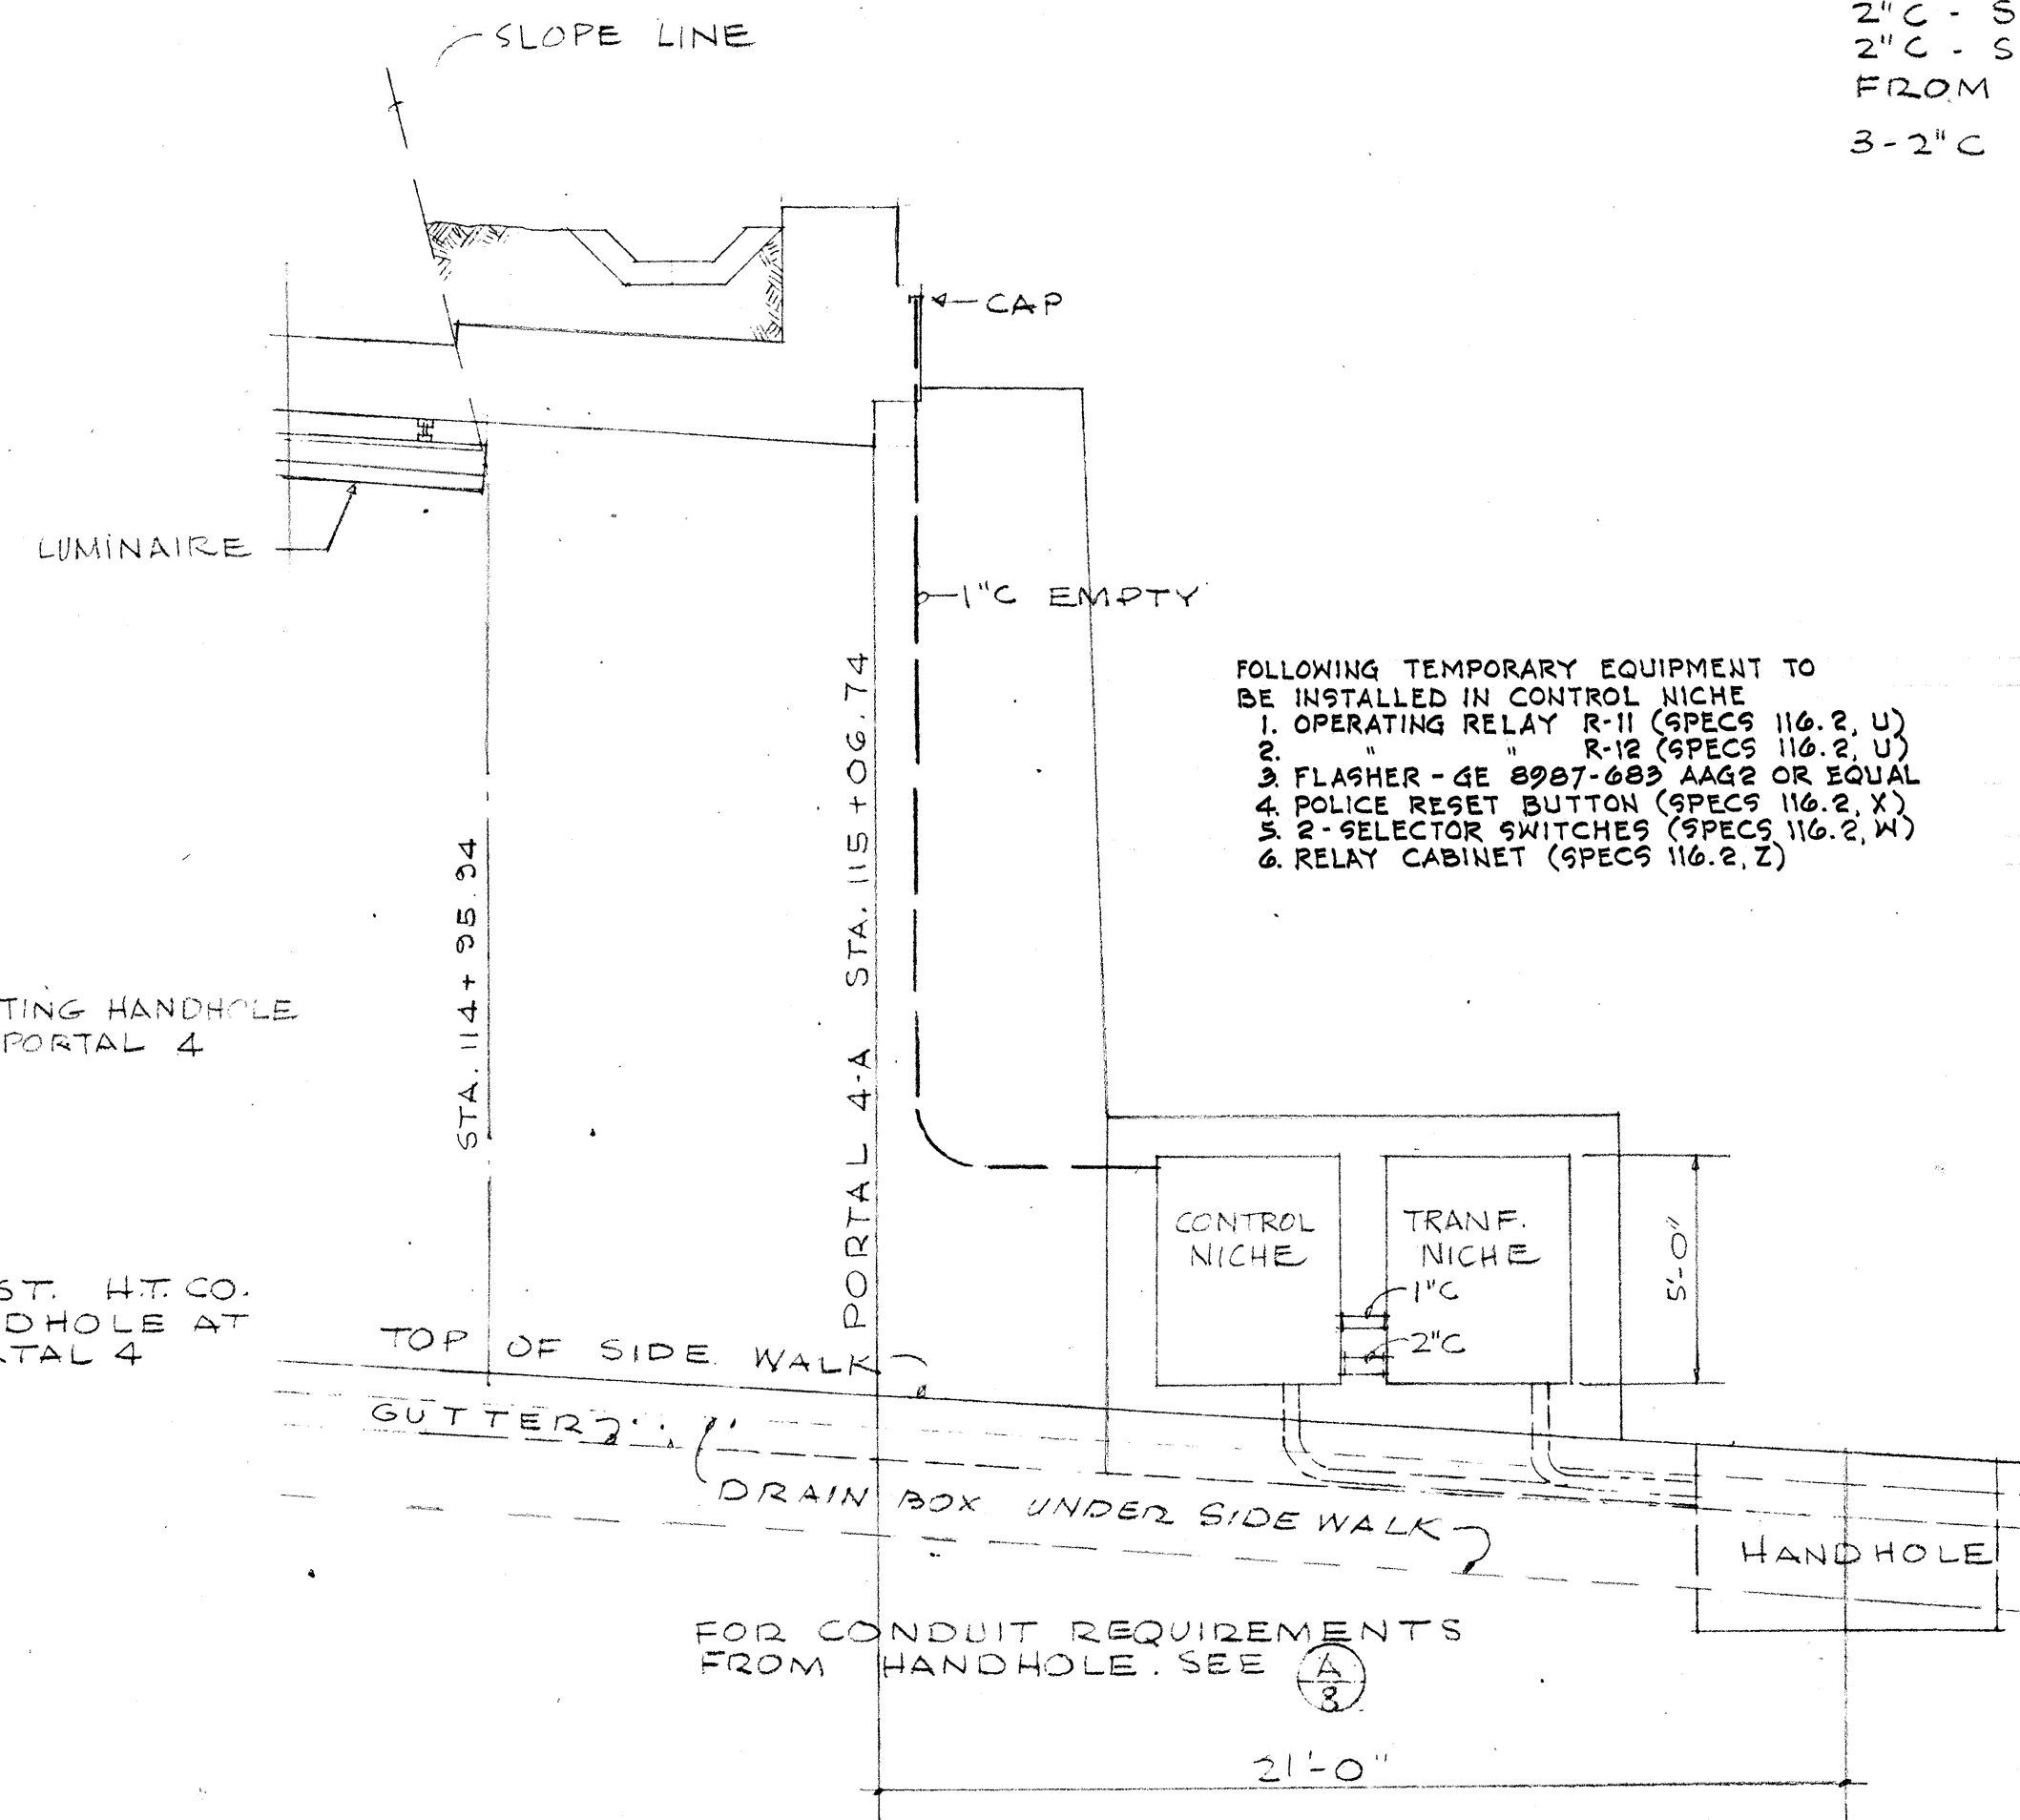

PORTAL 4-A - SECTION "A-A"
SCALE: 1/4" = 1'-0"

NO EQUIPMENT SHALL BE INSTALLED IN NICHES AT PORTAL 4-A UNDER THIS CONTRACT. EXCEPT FOR TEMPORARY TRAFFIC SIGNAL CONTROL.

1" C - GROUND WIRE
2" C - CONTROL
2" C - SPARE
2" C - SPARE
FROM CONTROL NICHE
3-2" C FROM PORTAL 1-A
1-2" C FROM TRANSFORMER NICHE
3-2" C FROM EXIST. HANDHOLE AT PORTAL 2

3-2" C FROM PORTAL 3-A
1-2" C TO ROADWAY LIGHTS
3-2" C FROM PORTAL 2-A
1-2" C TO TRAFFIC SIGNALS

1" C - GROUND WIRE
2" C - CONTROL
2" C - SPARE
2" C - TRAFFIC SIGNALS FROM CONTROL NICHE
3-2" C FROM PORTAL 4-A
1-2" C FROM TRANSFORMER NICHE

1-1" C
4-2" C FROM CONTROL NICHE
3-2" C FROM PORTAL 3-A
1-2" C FROM TRANSFORMER NICHE
2-2" C STUB & CAP CLEAR OF PAVING
2-2" C STUB & CAP CLEAR OF PAVING


CONDUIT PLANS FOR
HANDHOLE (A) 8
NOT TO SCALE

TERRITORIAL HIGHWAY DEPARTMENT
TERRITORY OF HAWAII
ELECTRICAL
PORTAL 4-A
PALI ROAD
OUTBOUND TUNNELS
PROJ. NO. BF061-1(5)
SCALE: AS SHOWN
DATE: MAY 1957

JAMES J. OBERHAUSEN
ELECTRICAL ENGINEER



DATE	
SURVEY PLOTTED BY	
DESIGNED BY	
TRACED BY	
QUANTITIES BY	
CHECKED BY	
NOTE BOOK	
No.	

FED. ROAD DIST. NO.	STATE	FED. AID PROJ. NO.	FISCAL YEAR	SHEET NO.	TOTAL SHEETS
HAWAII	HAW	BF06H1(5)	1957	51	79

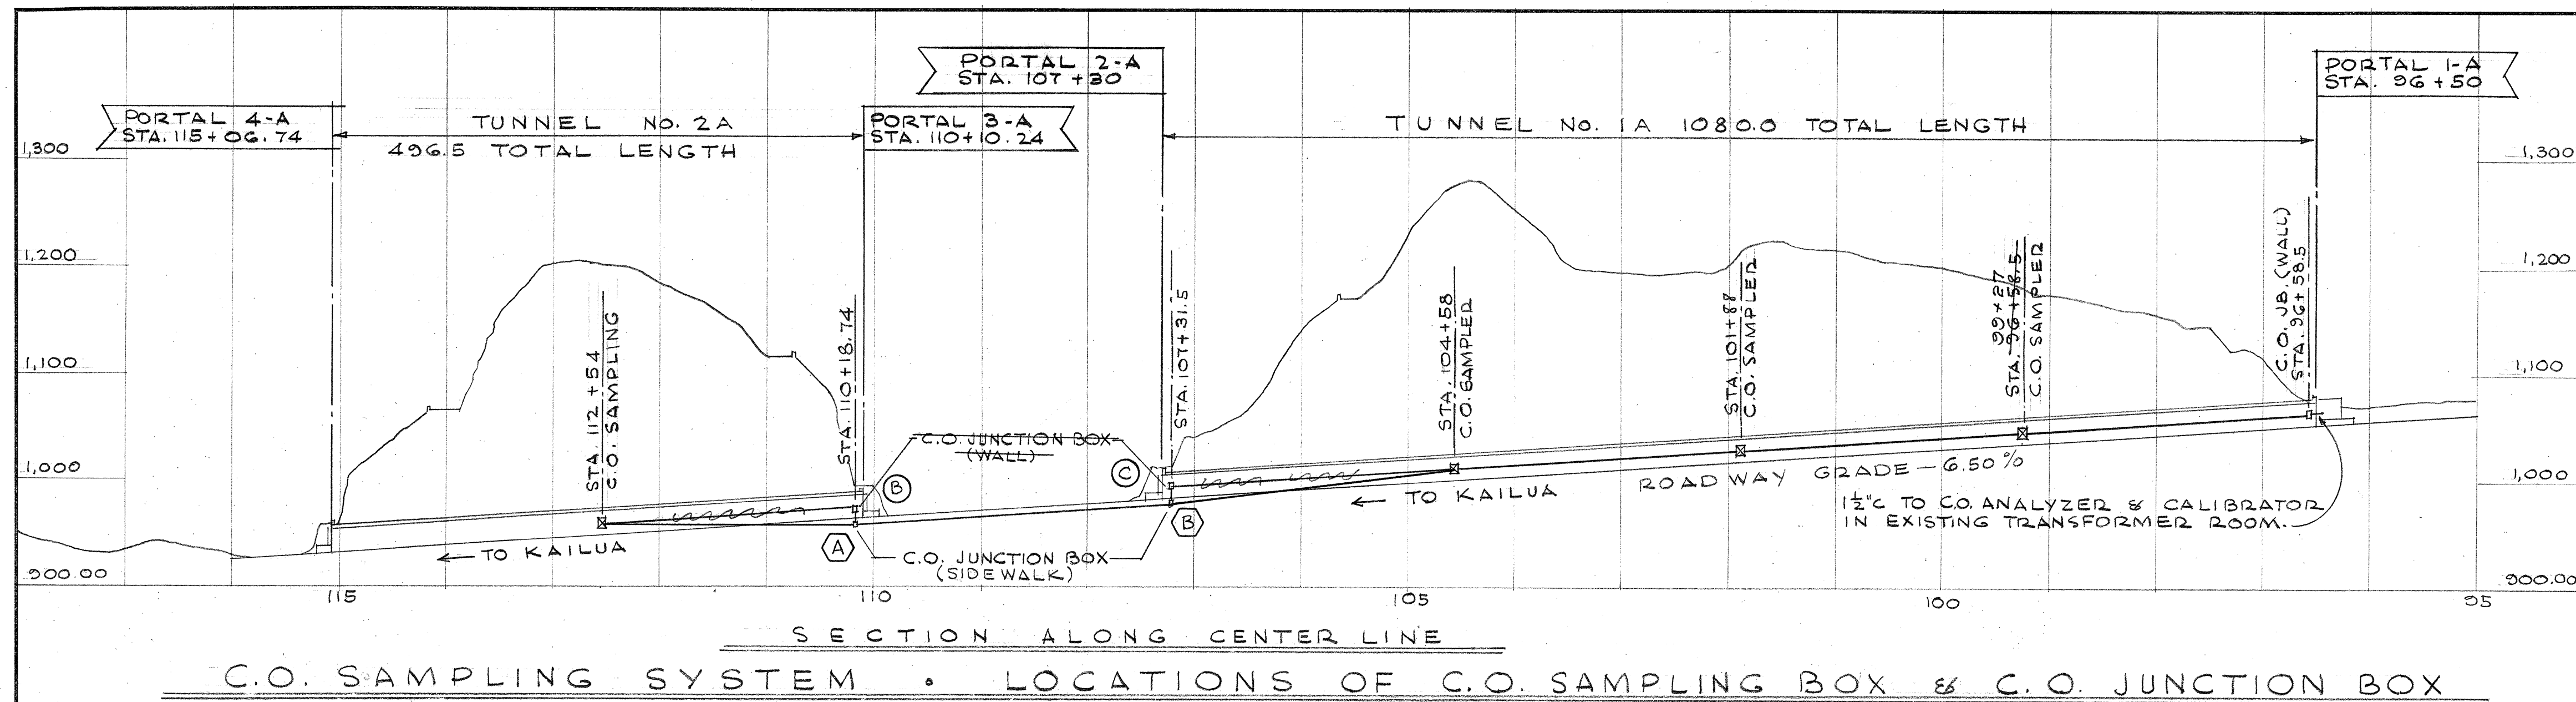

NOTES

1. SEE ELECTRICAL KEY PLAN FOR CO. SAMPLER LOCATIONS - SHEET 1 OF 12.
2. FOR EXISTING & NEW EQUIPMENT LAYOUT OF CO. ANALYZER & CALIBRATOR, SEE SHEET 6 OF 12.

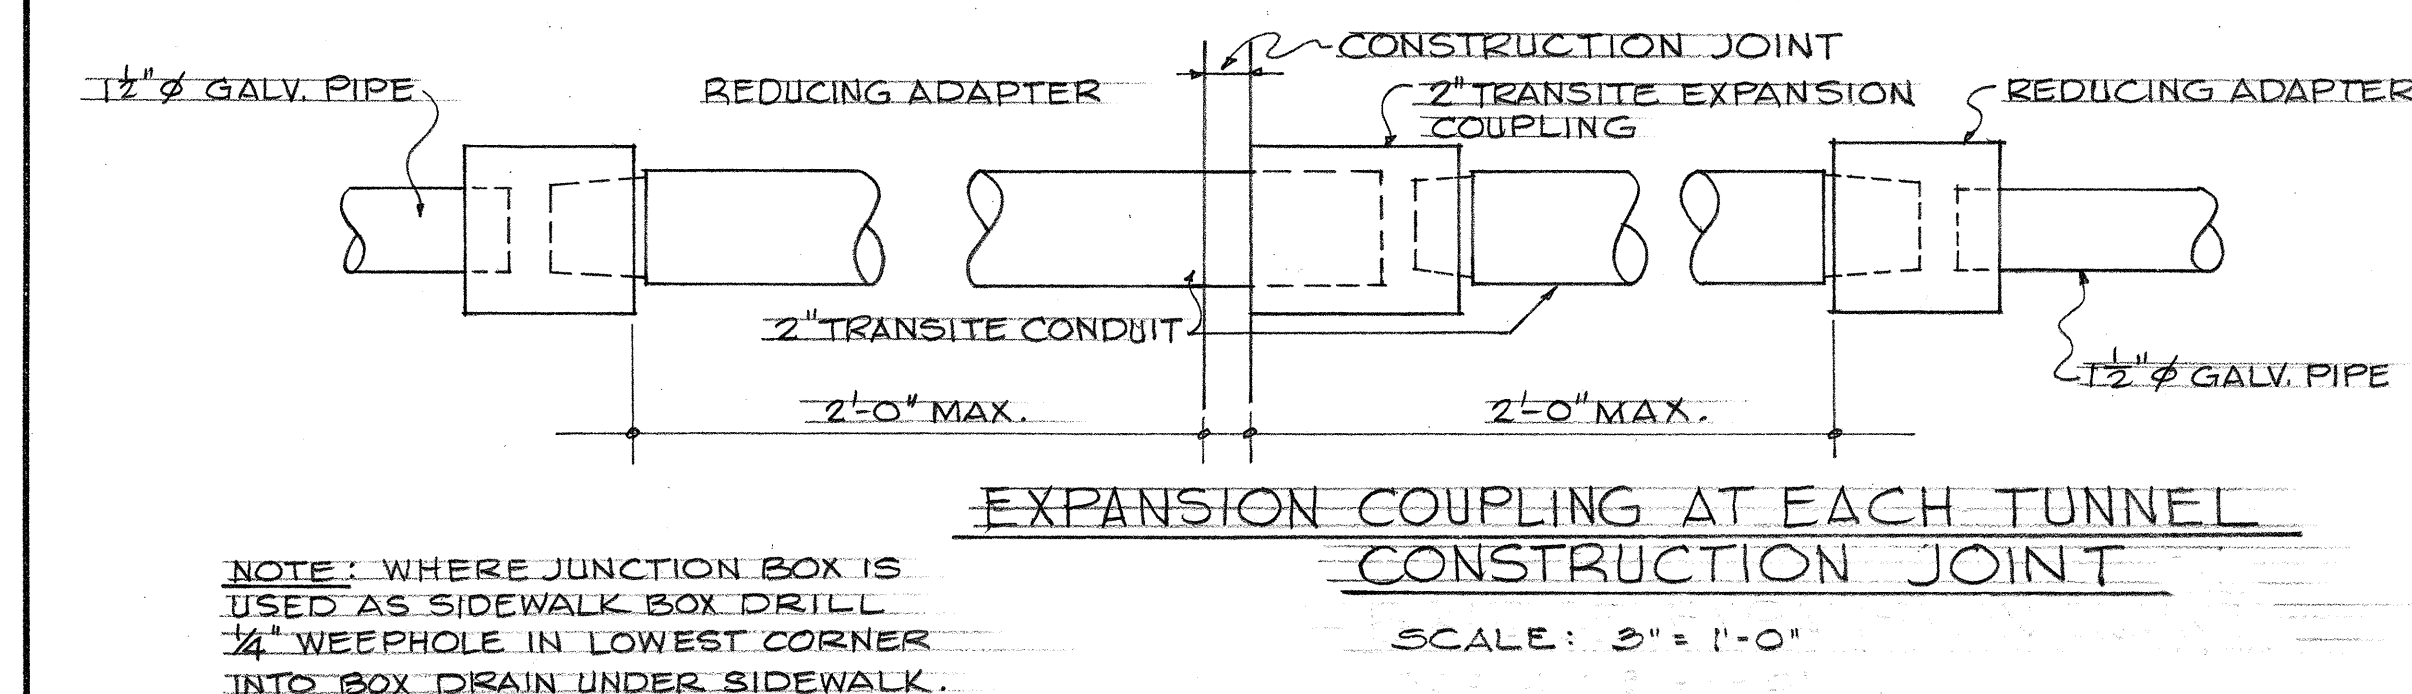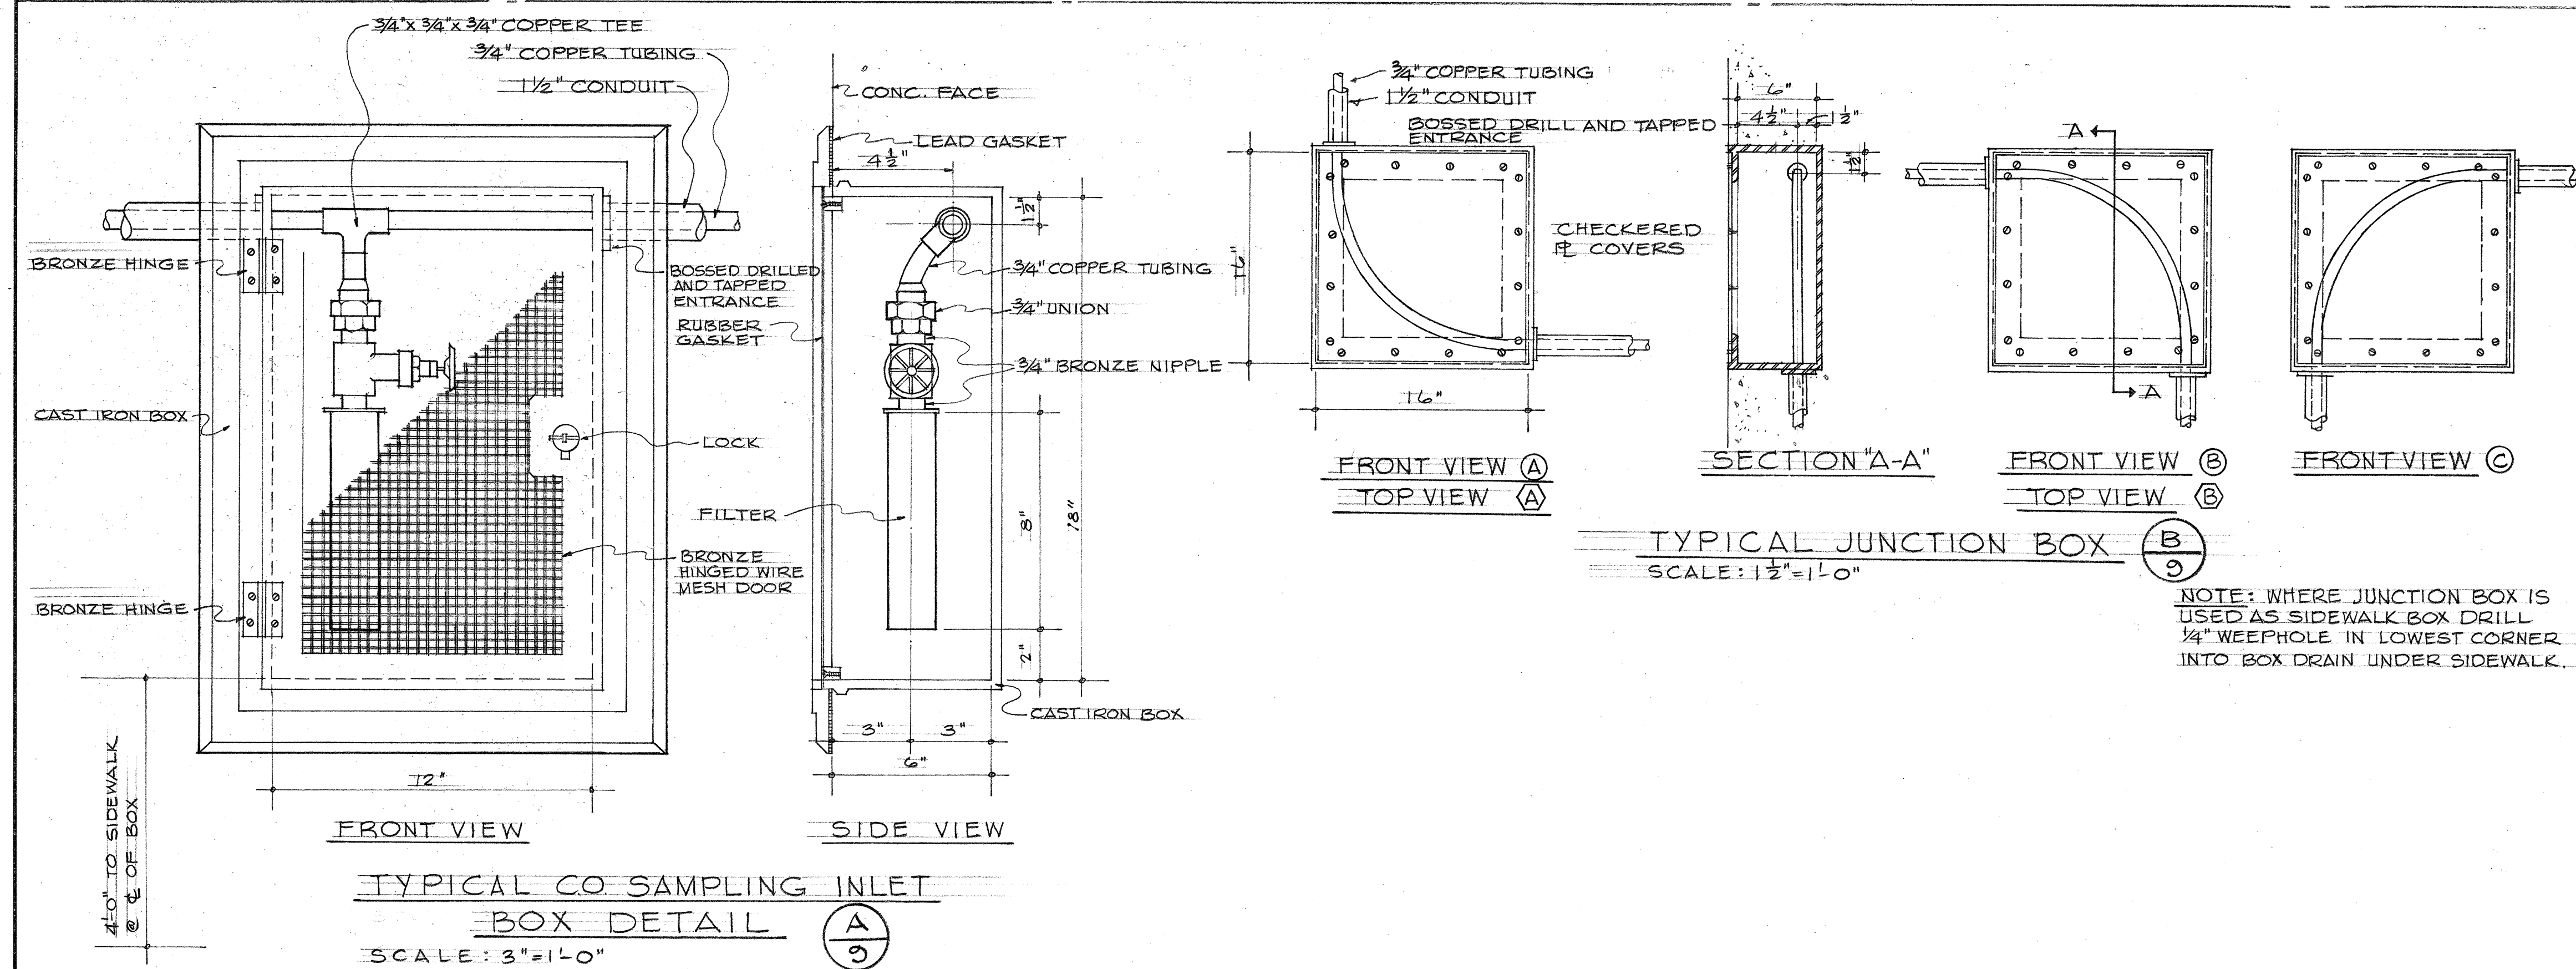









TERRITORIAL HIGHWAY DEPARTMENT
TERRITORY OF HAWAII
**ELECTRICAL
CARBON MONOXIDE
SAMPLING SYSTEM**
PALI ROAD
OUTBOUND TUNNELS
PROJ. NO. BF-OGI-1(5)
SCALE: AS NOTED DATE: MAY 1957


JAMES J. OBERHAUSEN
ELECTRICAL ENGINEER

SHEET NO. 51 OF 13 SHEETS


5896.51

SURVEY PLOTTED BY	DATE
DESIGNED BY	
TRACED BY	
QUANTITIES CHECKED BY	
CHECKED BY	
ORIGINAL PLAN No.	

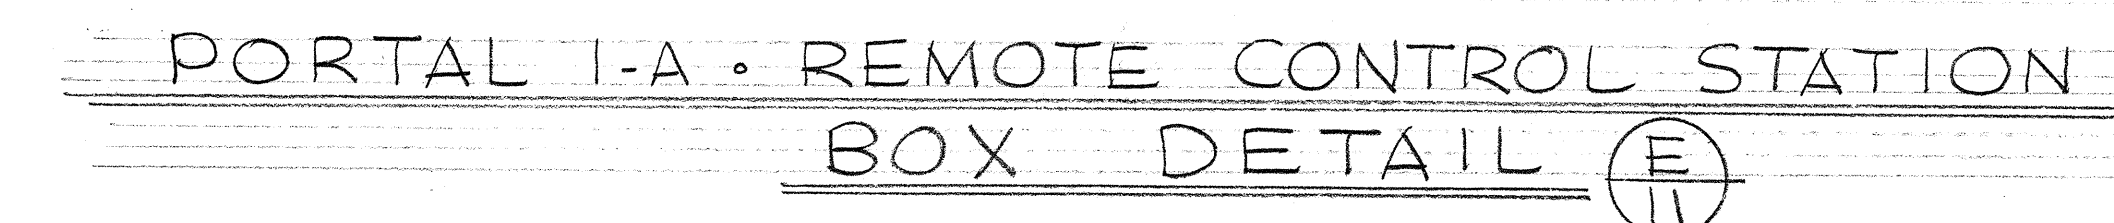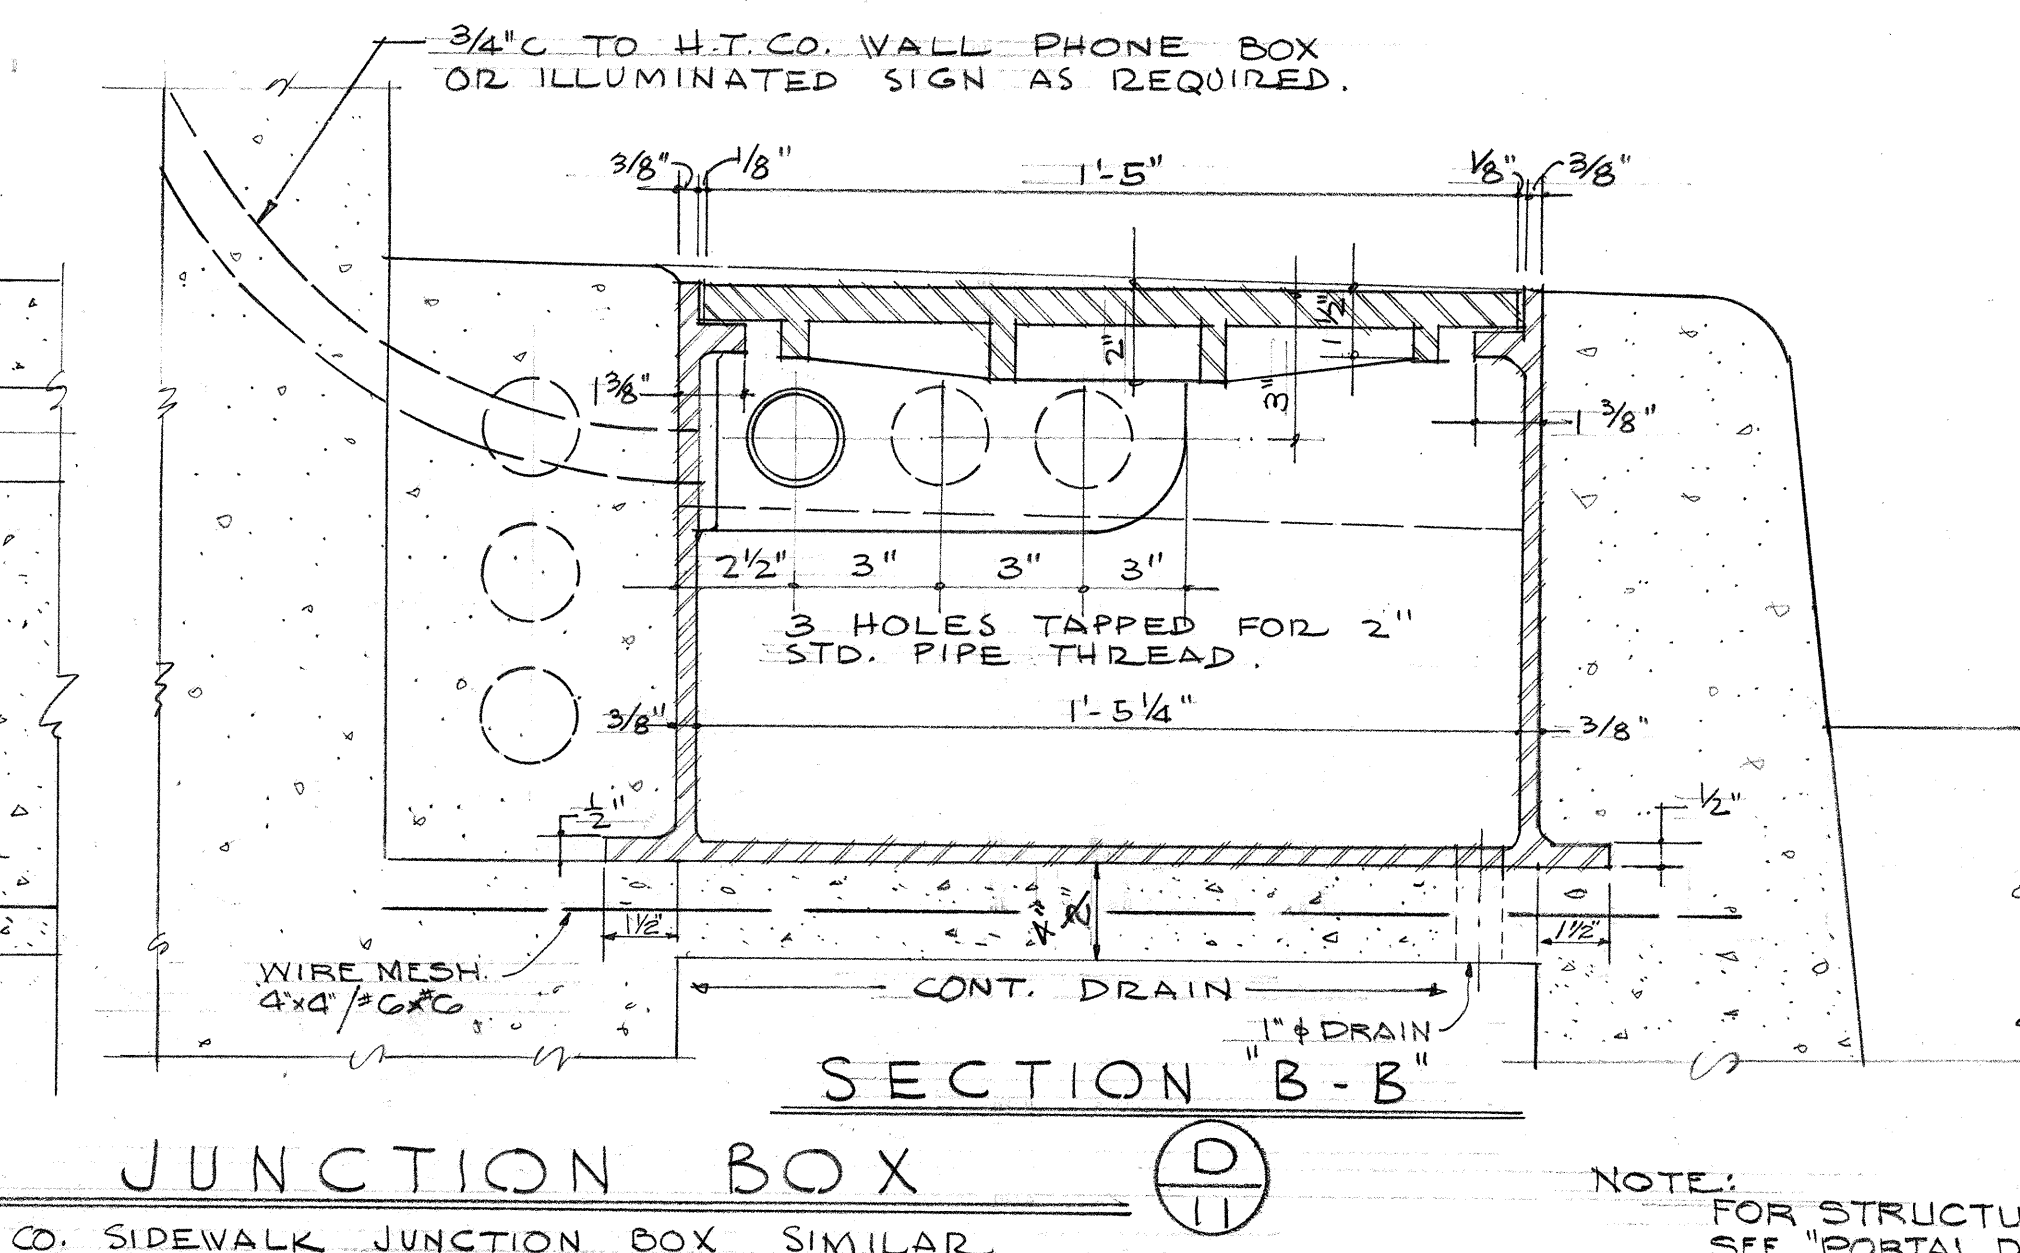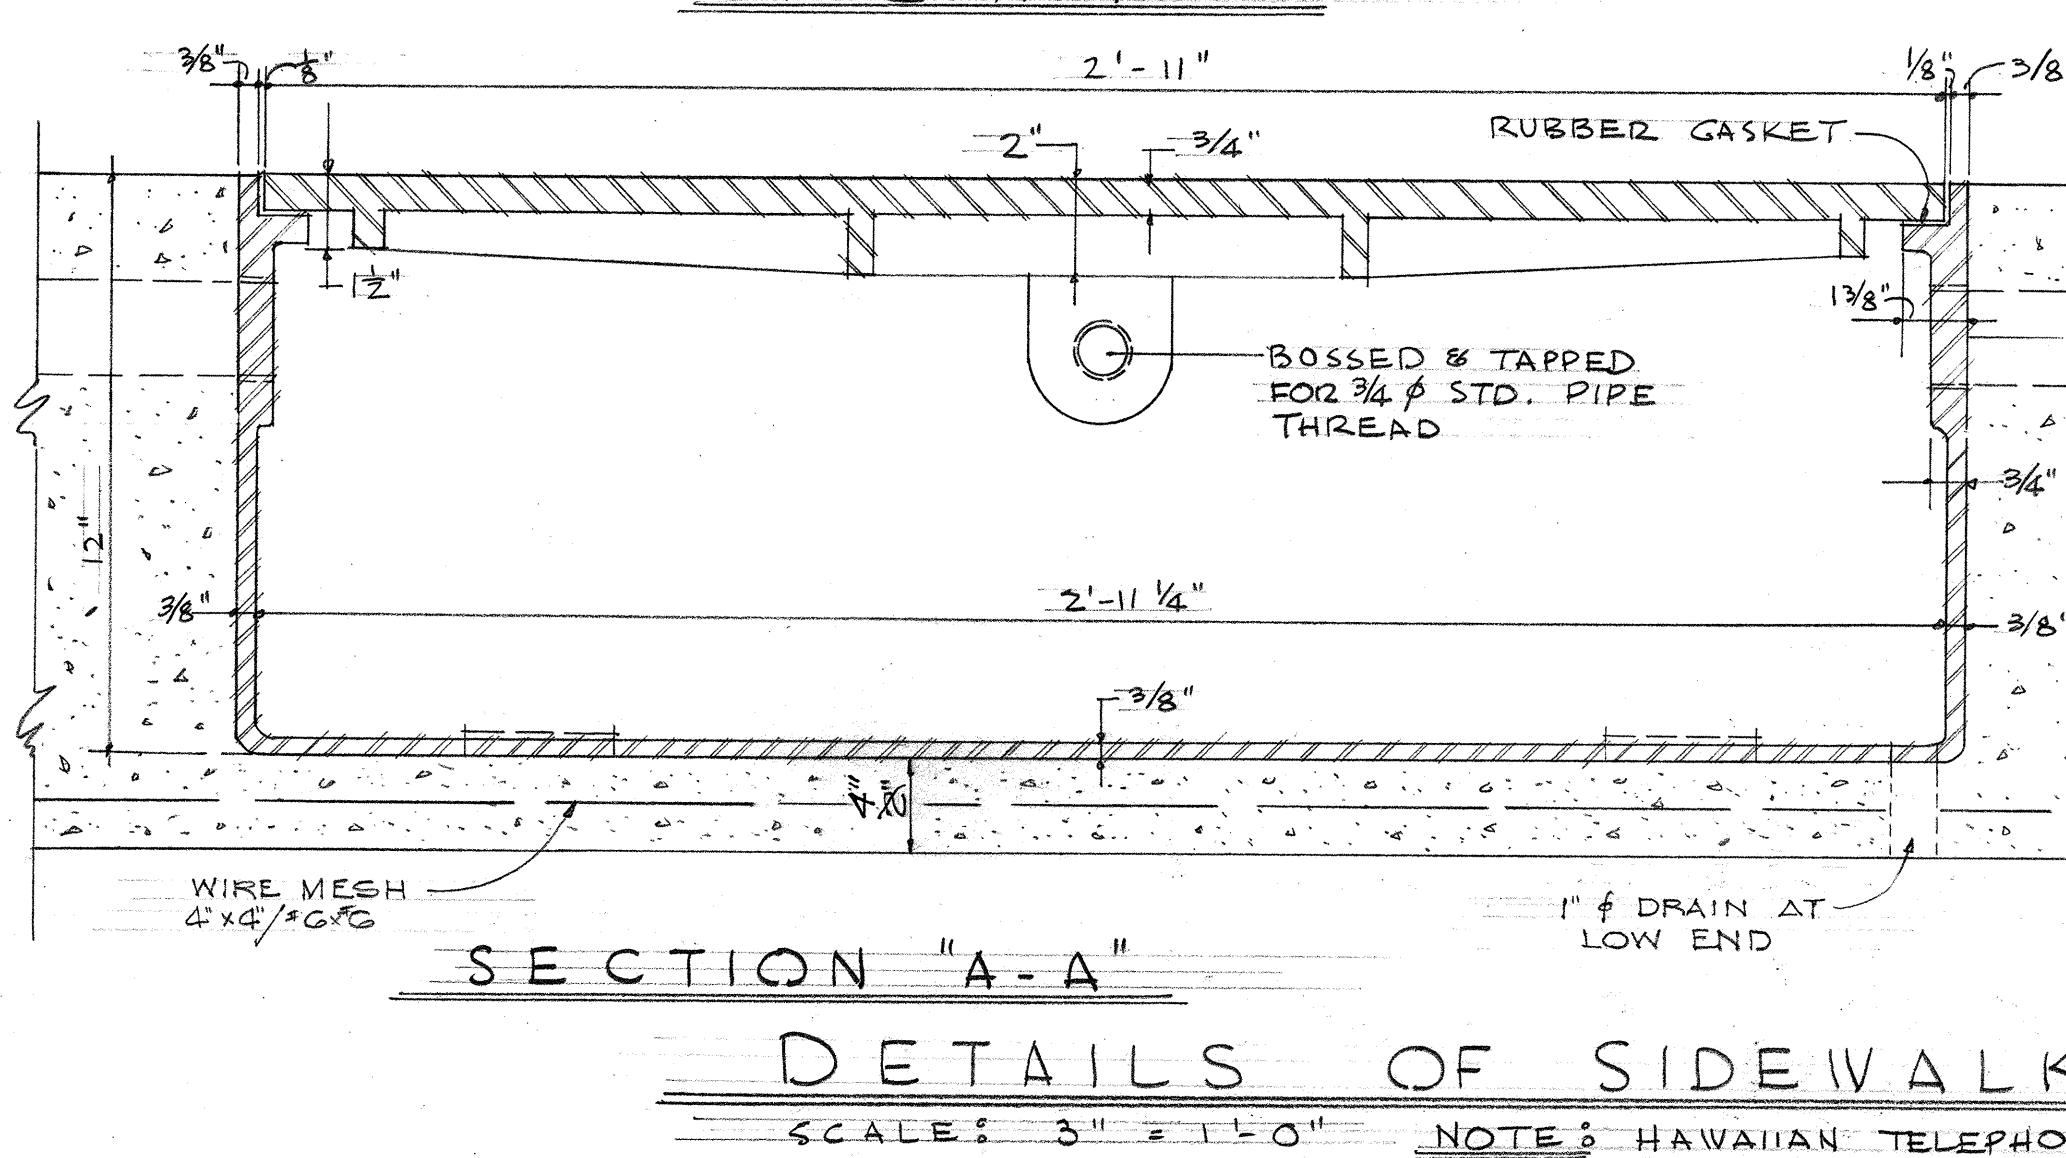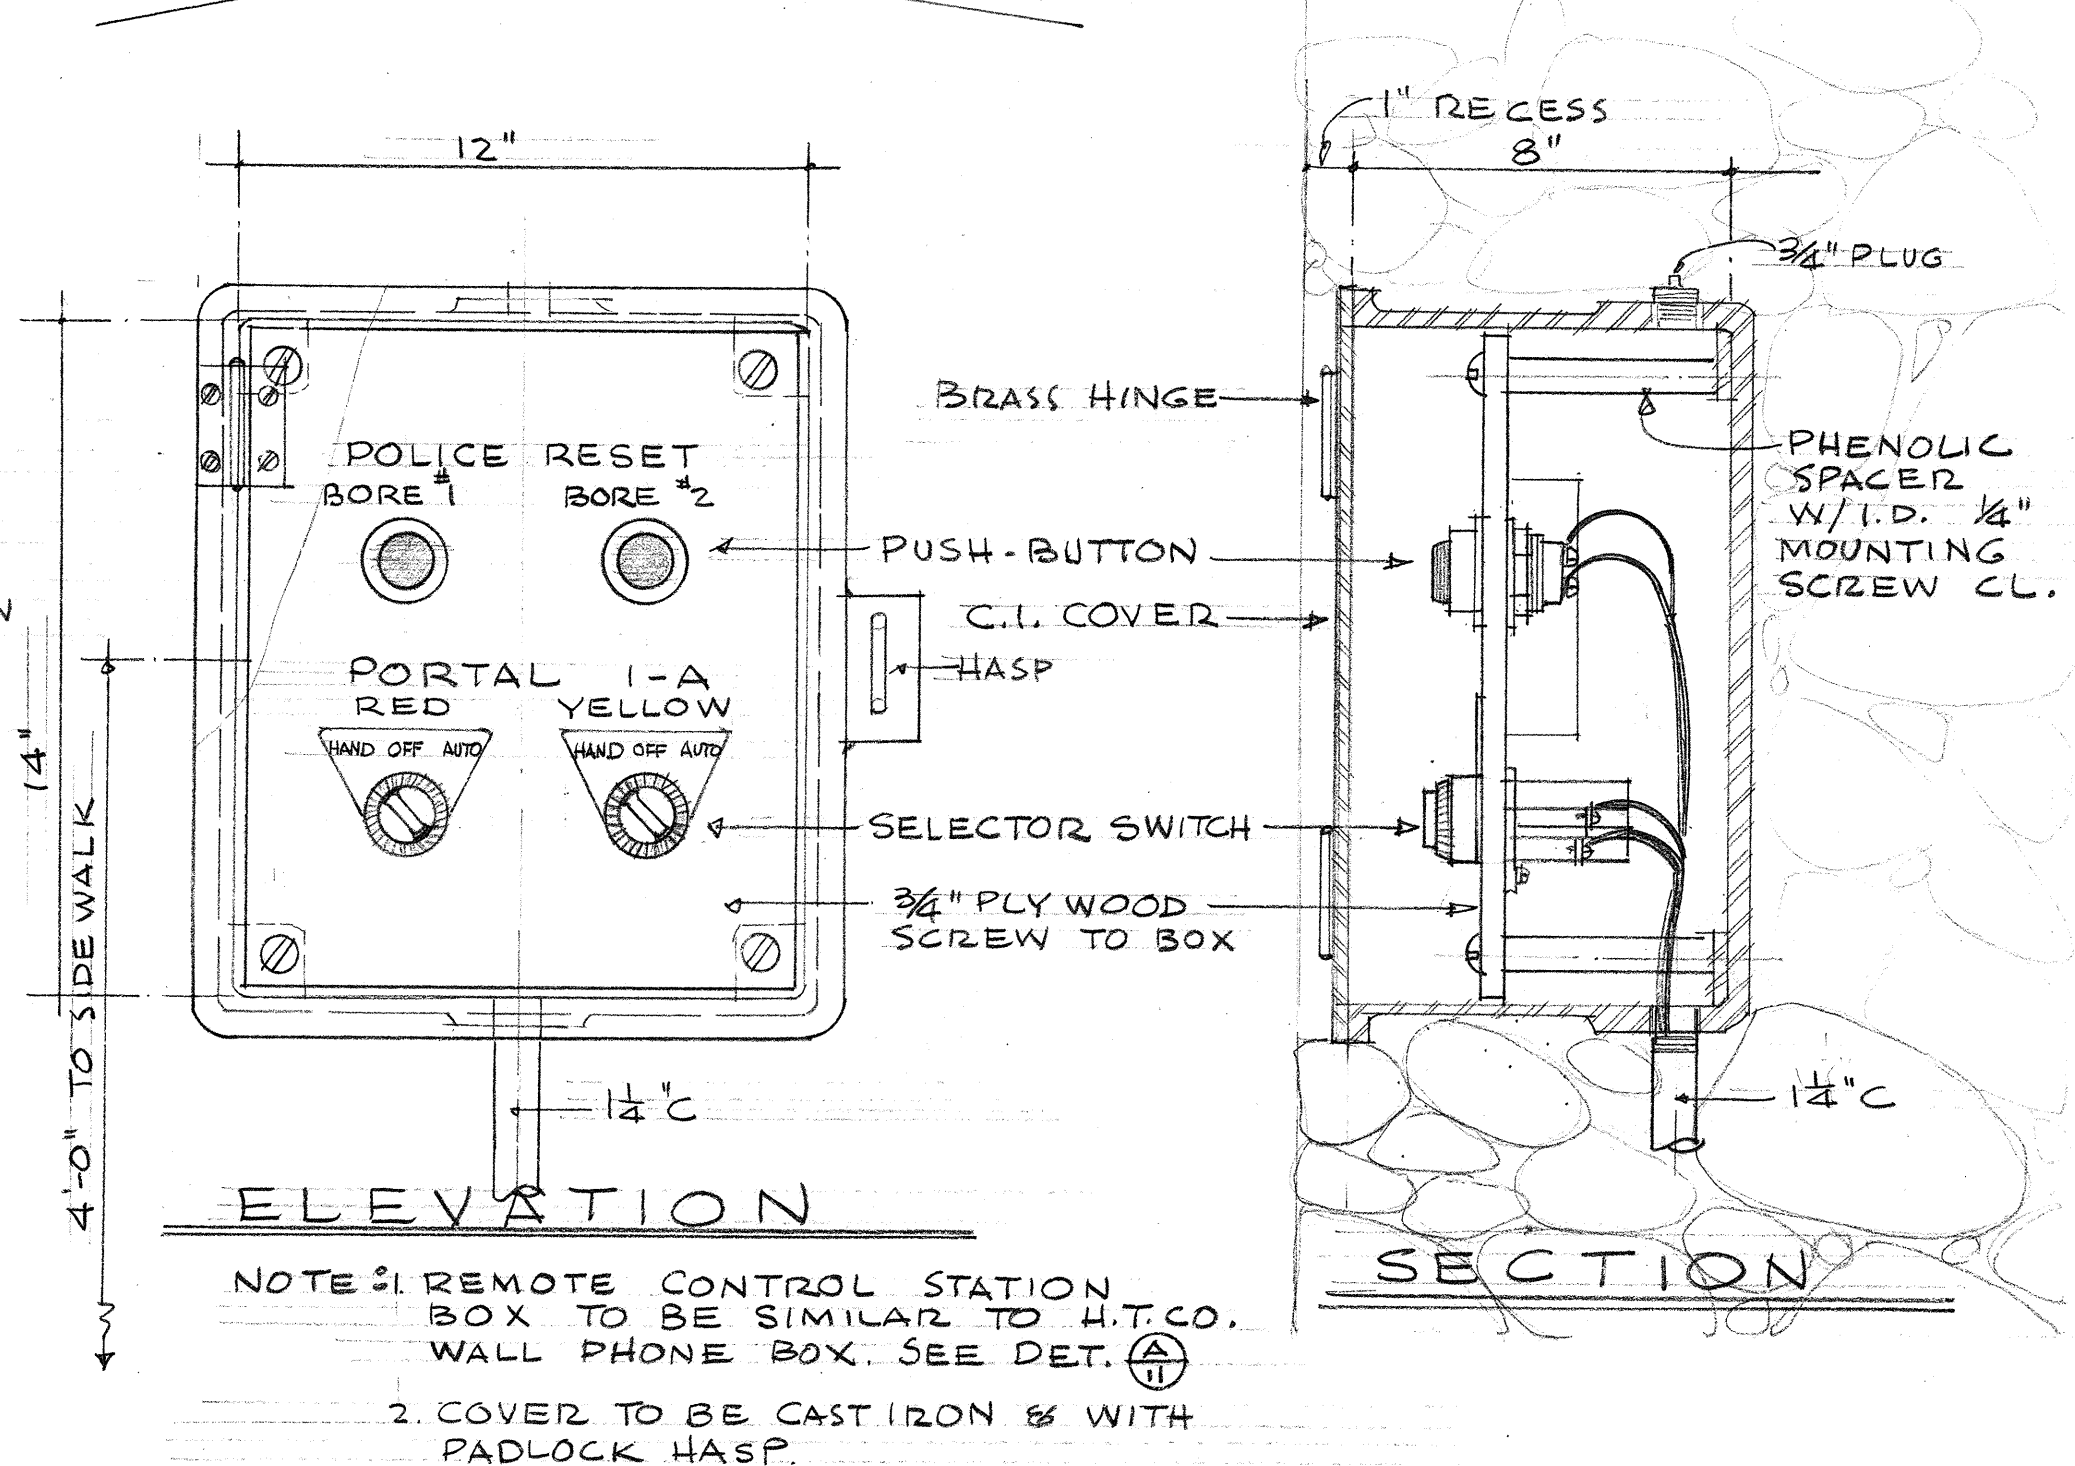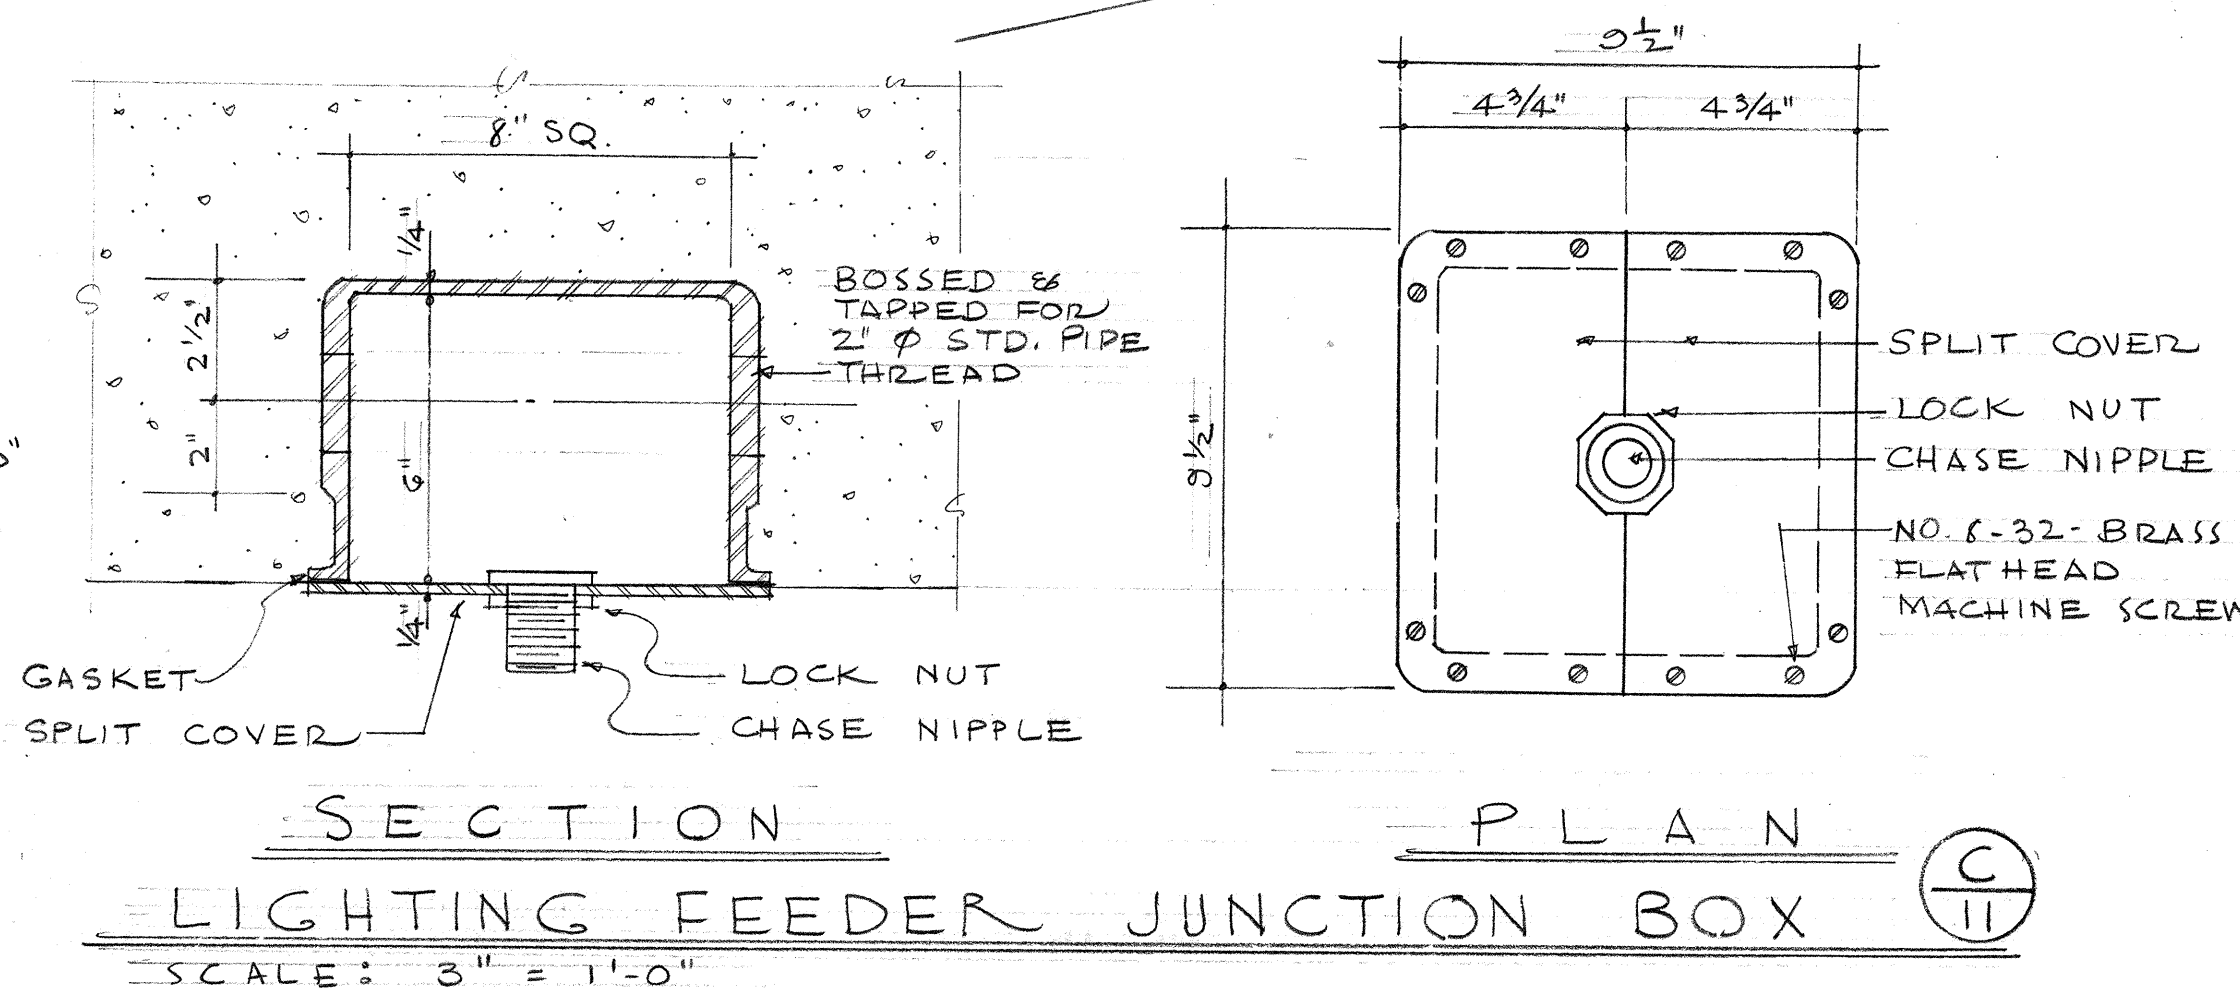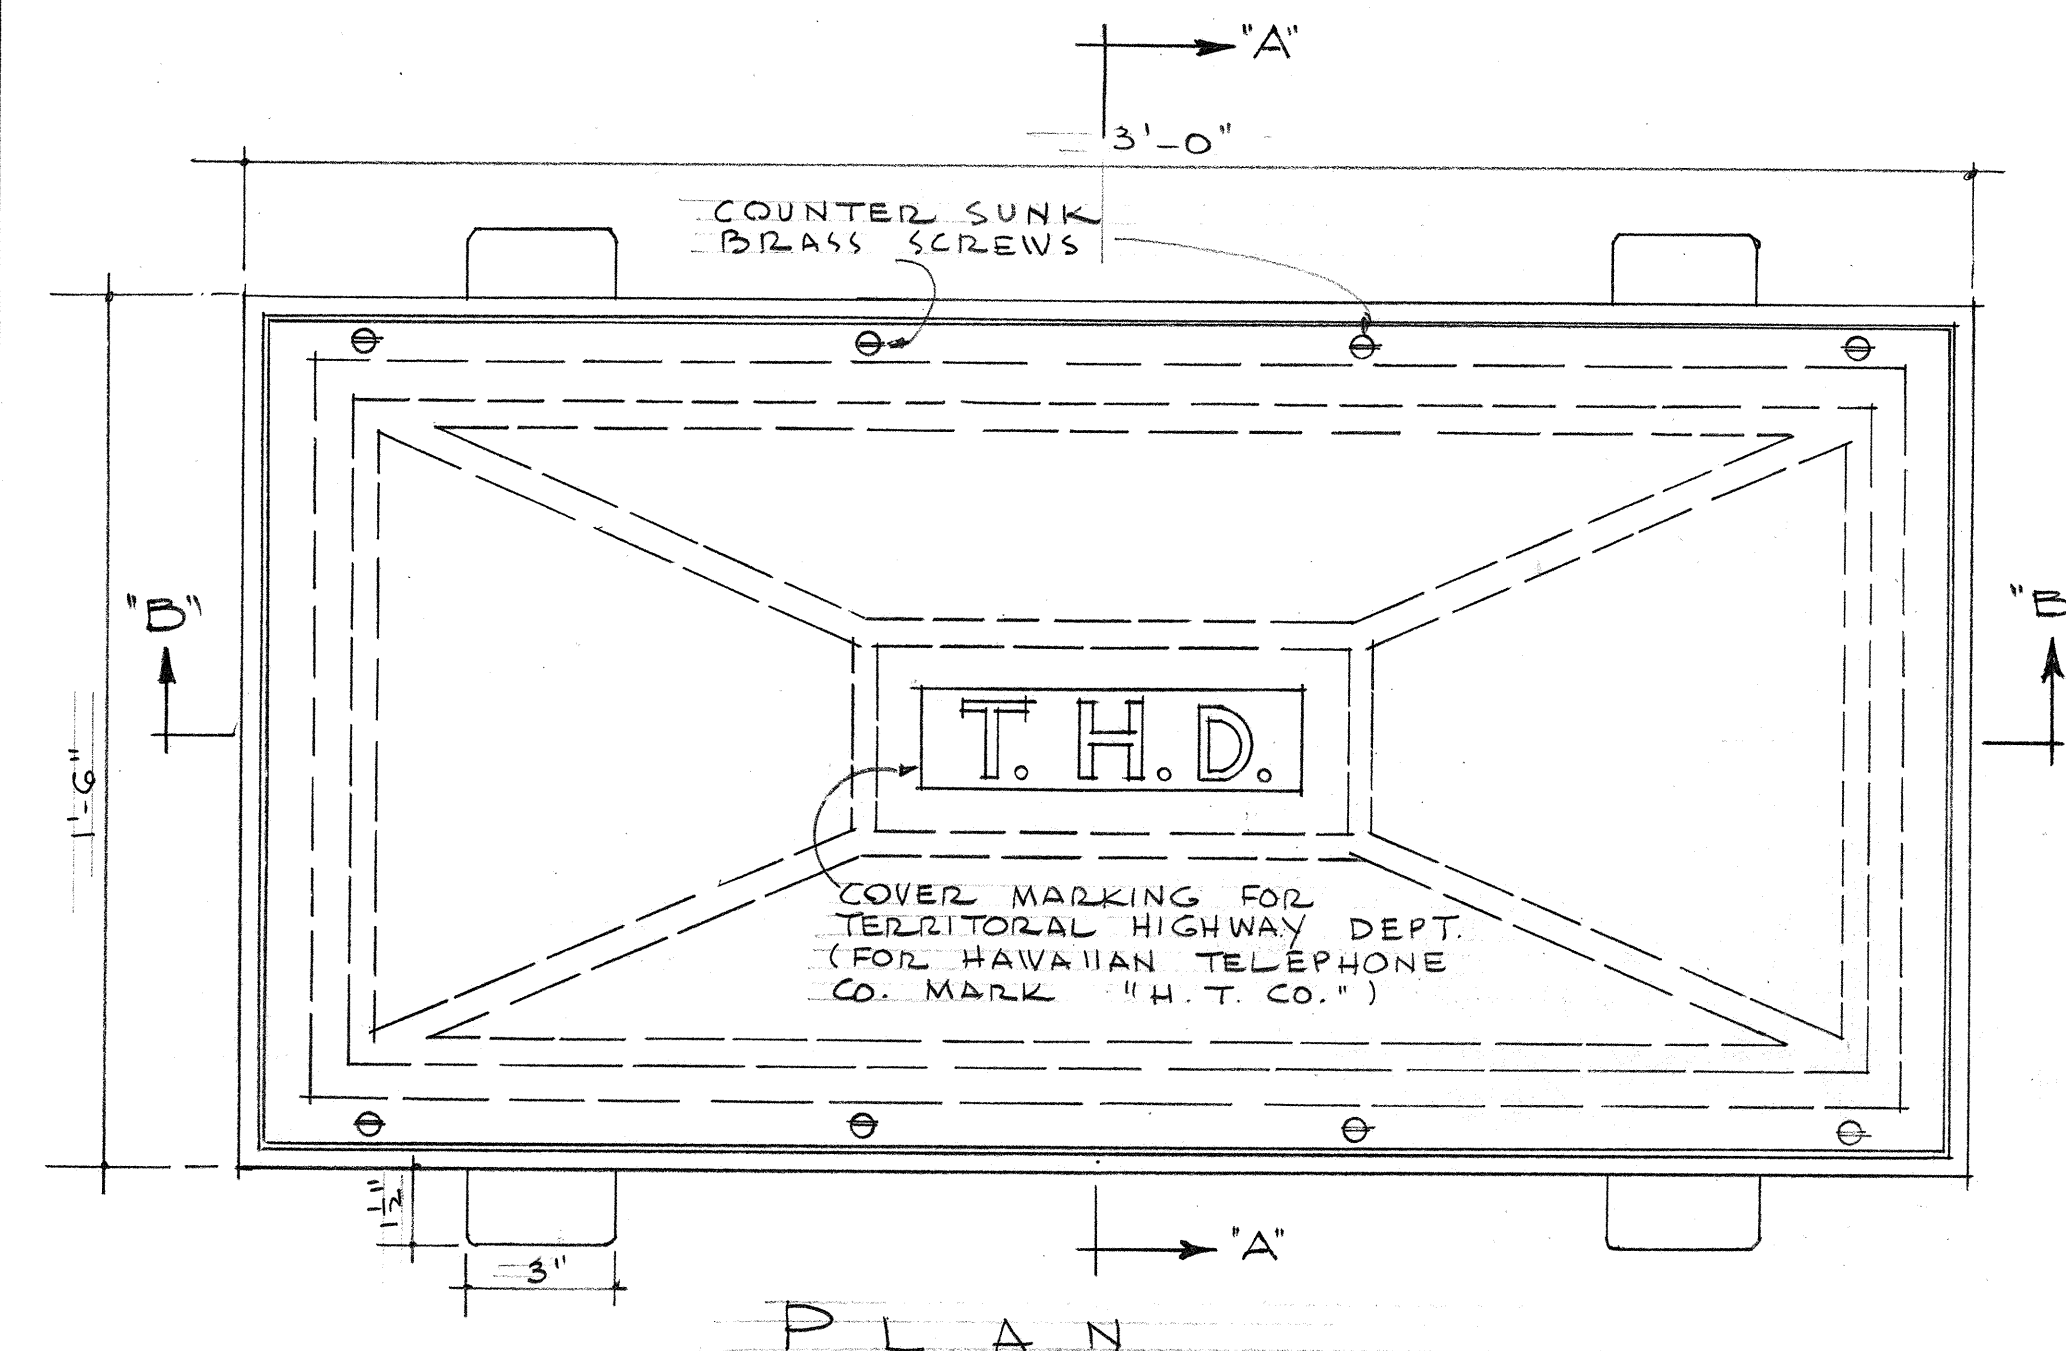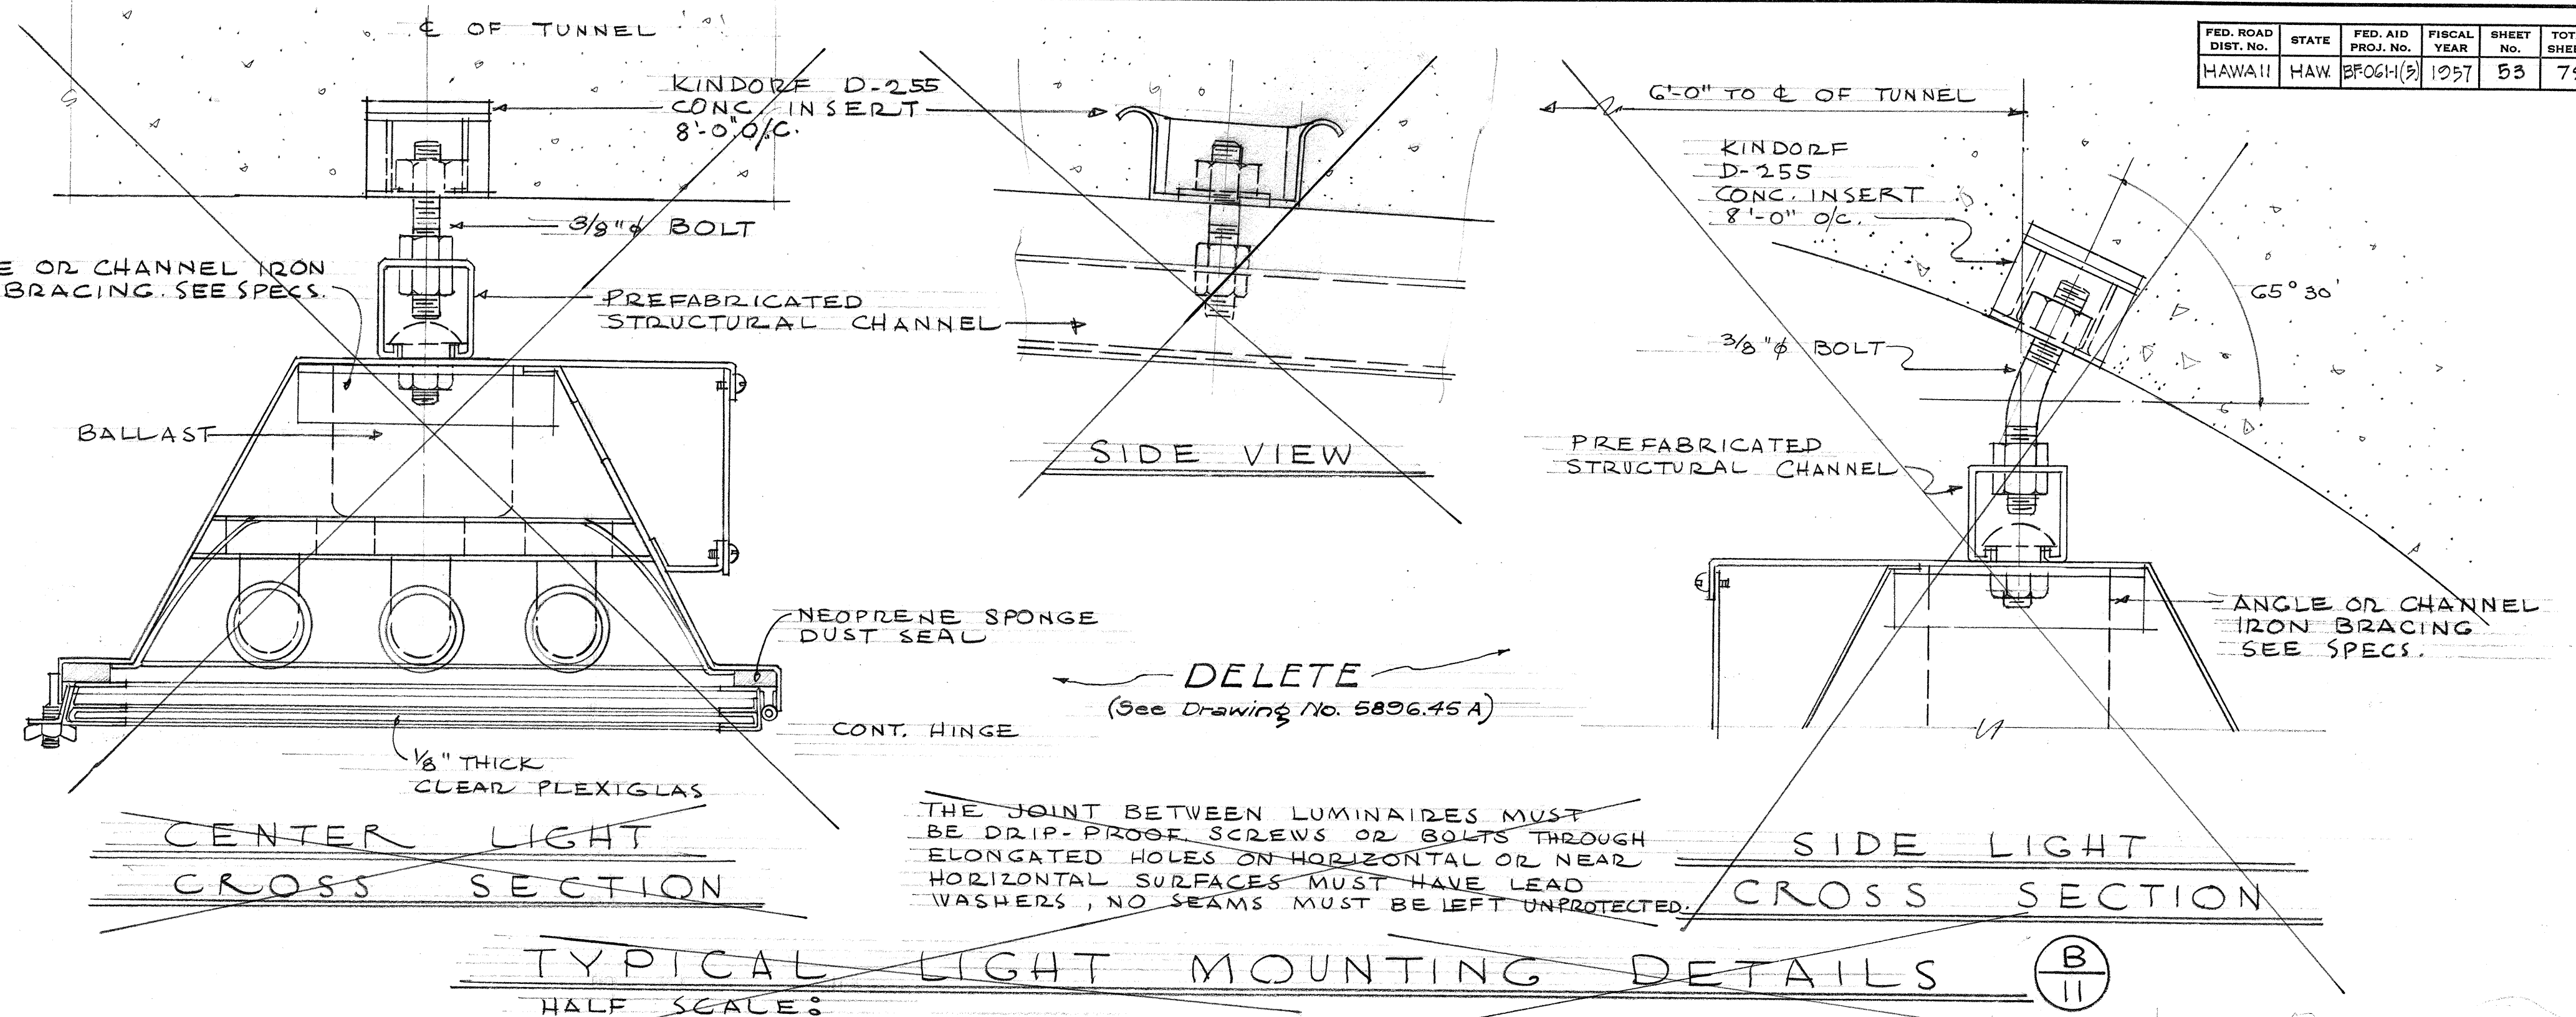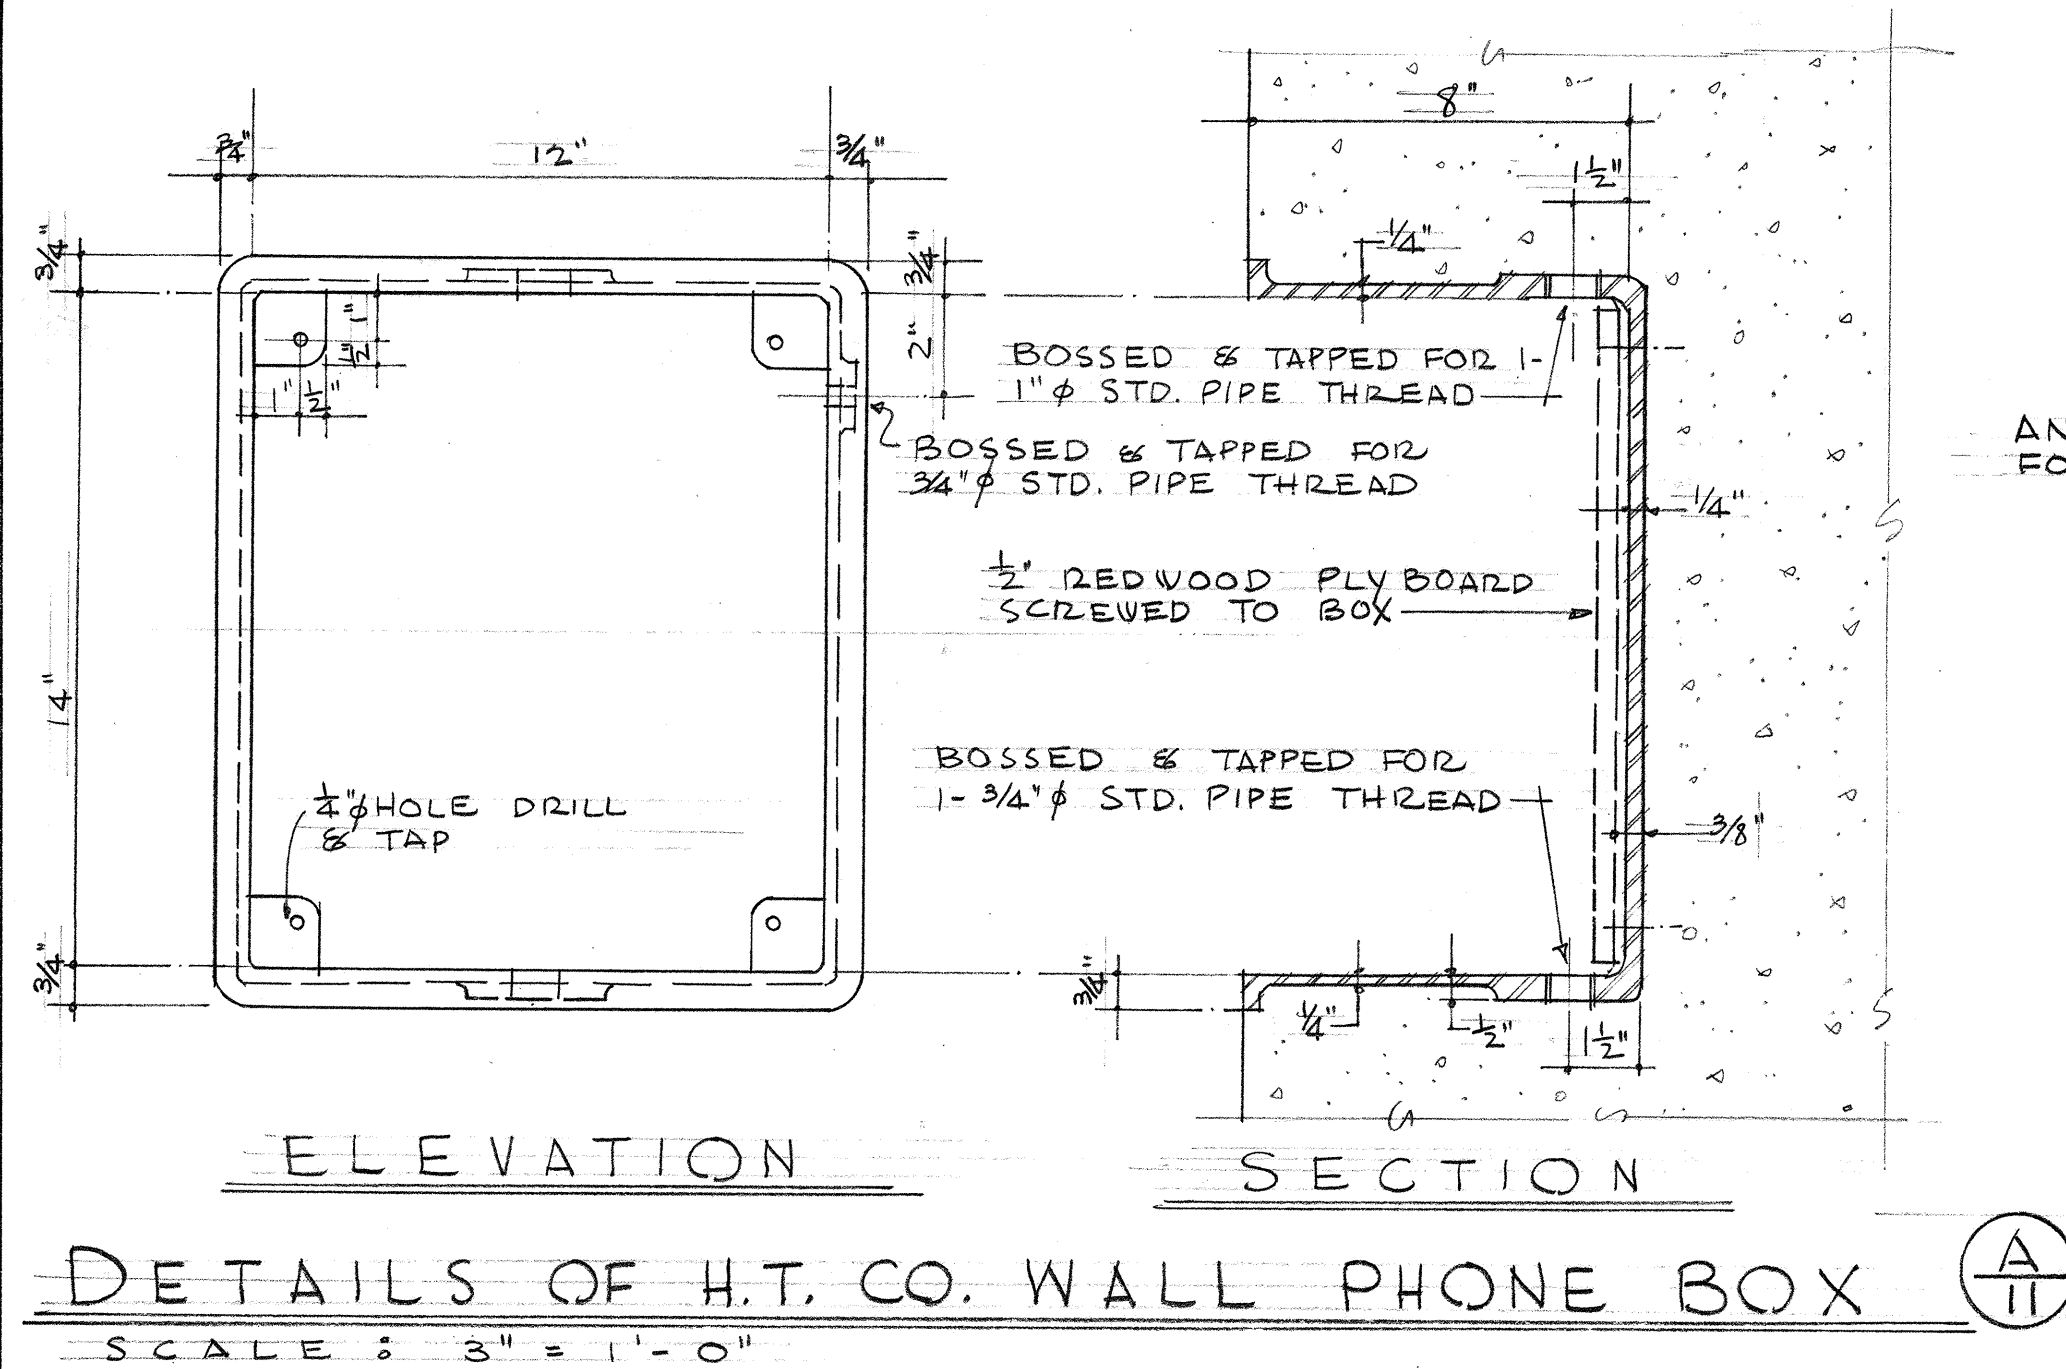


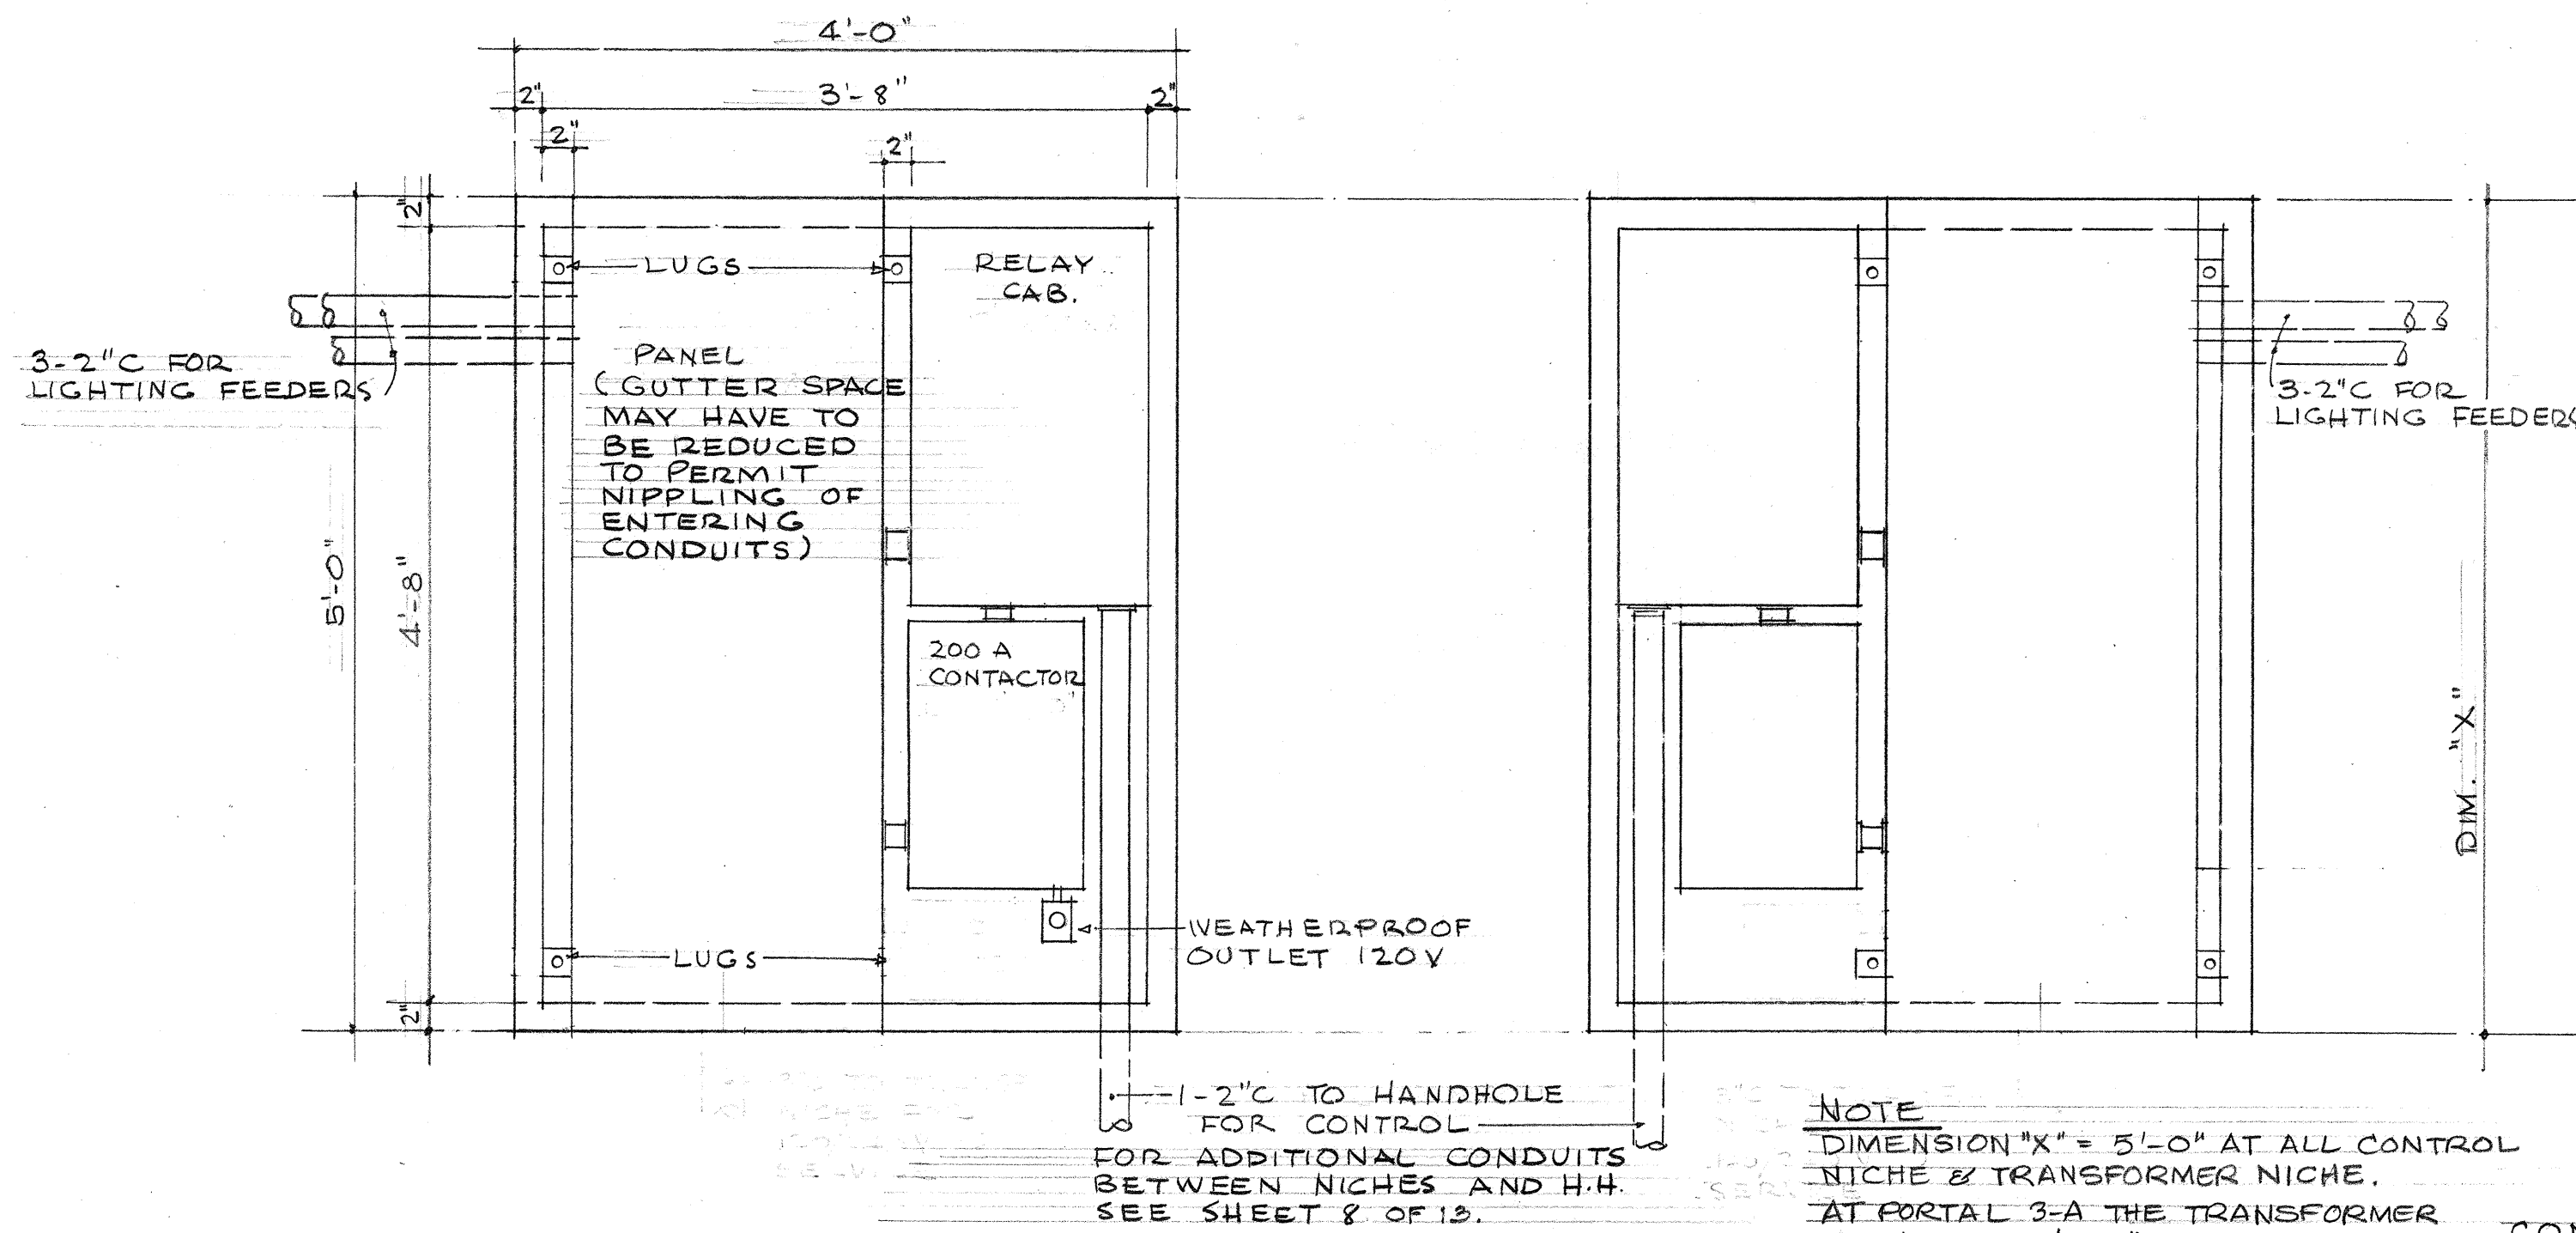


PORTAL 2-A
CONTROL NICHE EQUIPMENT LAYOUT
SCALE: 1" = 1'-0"

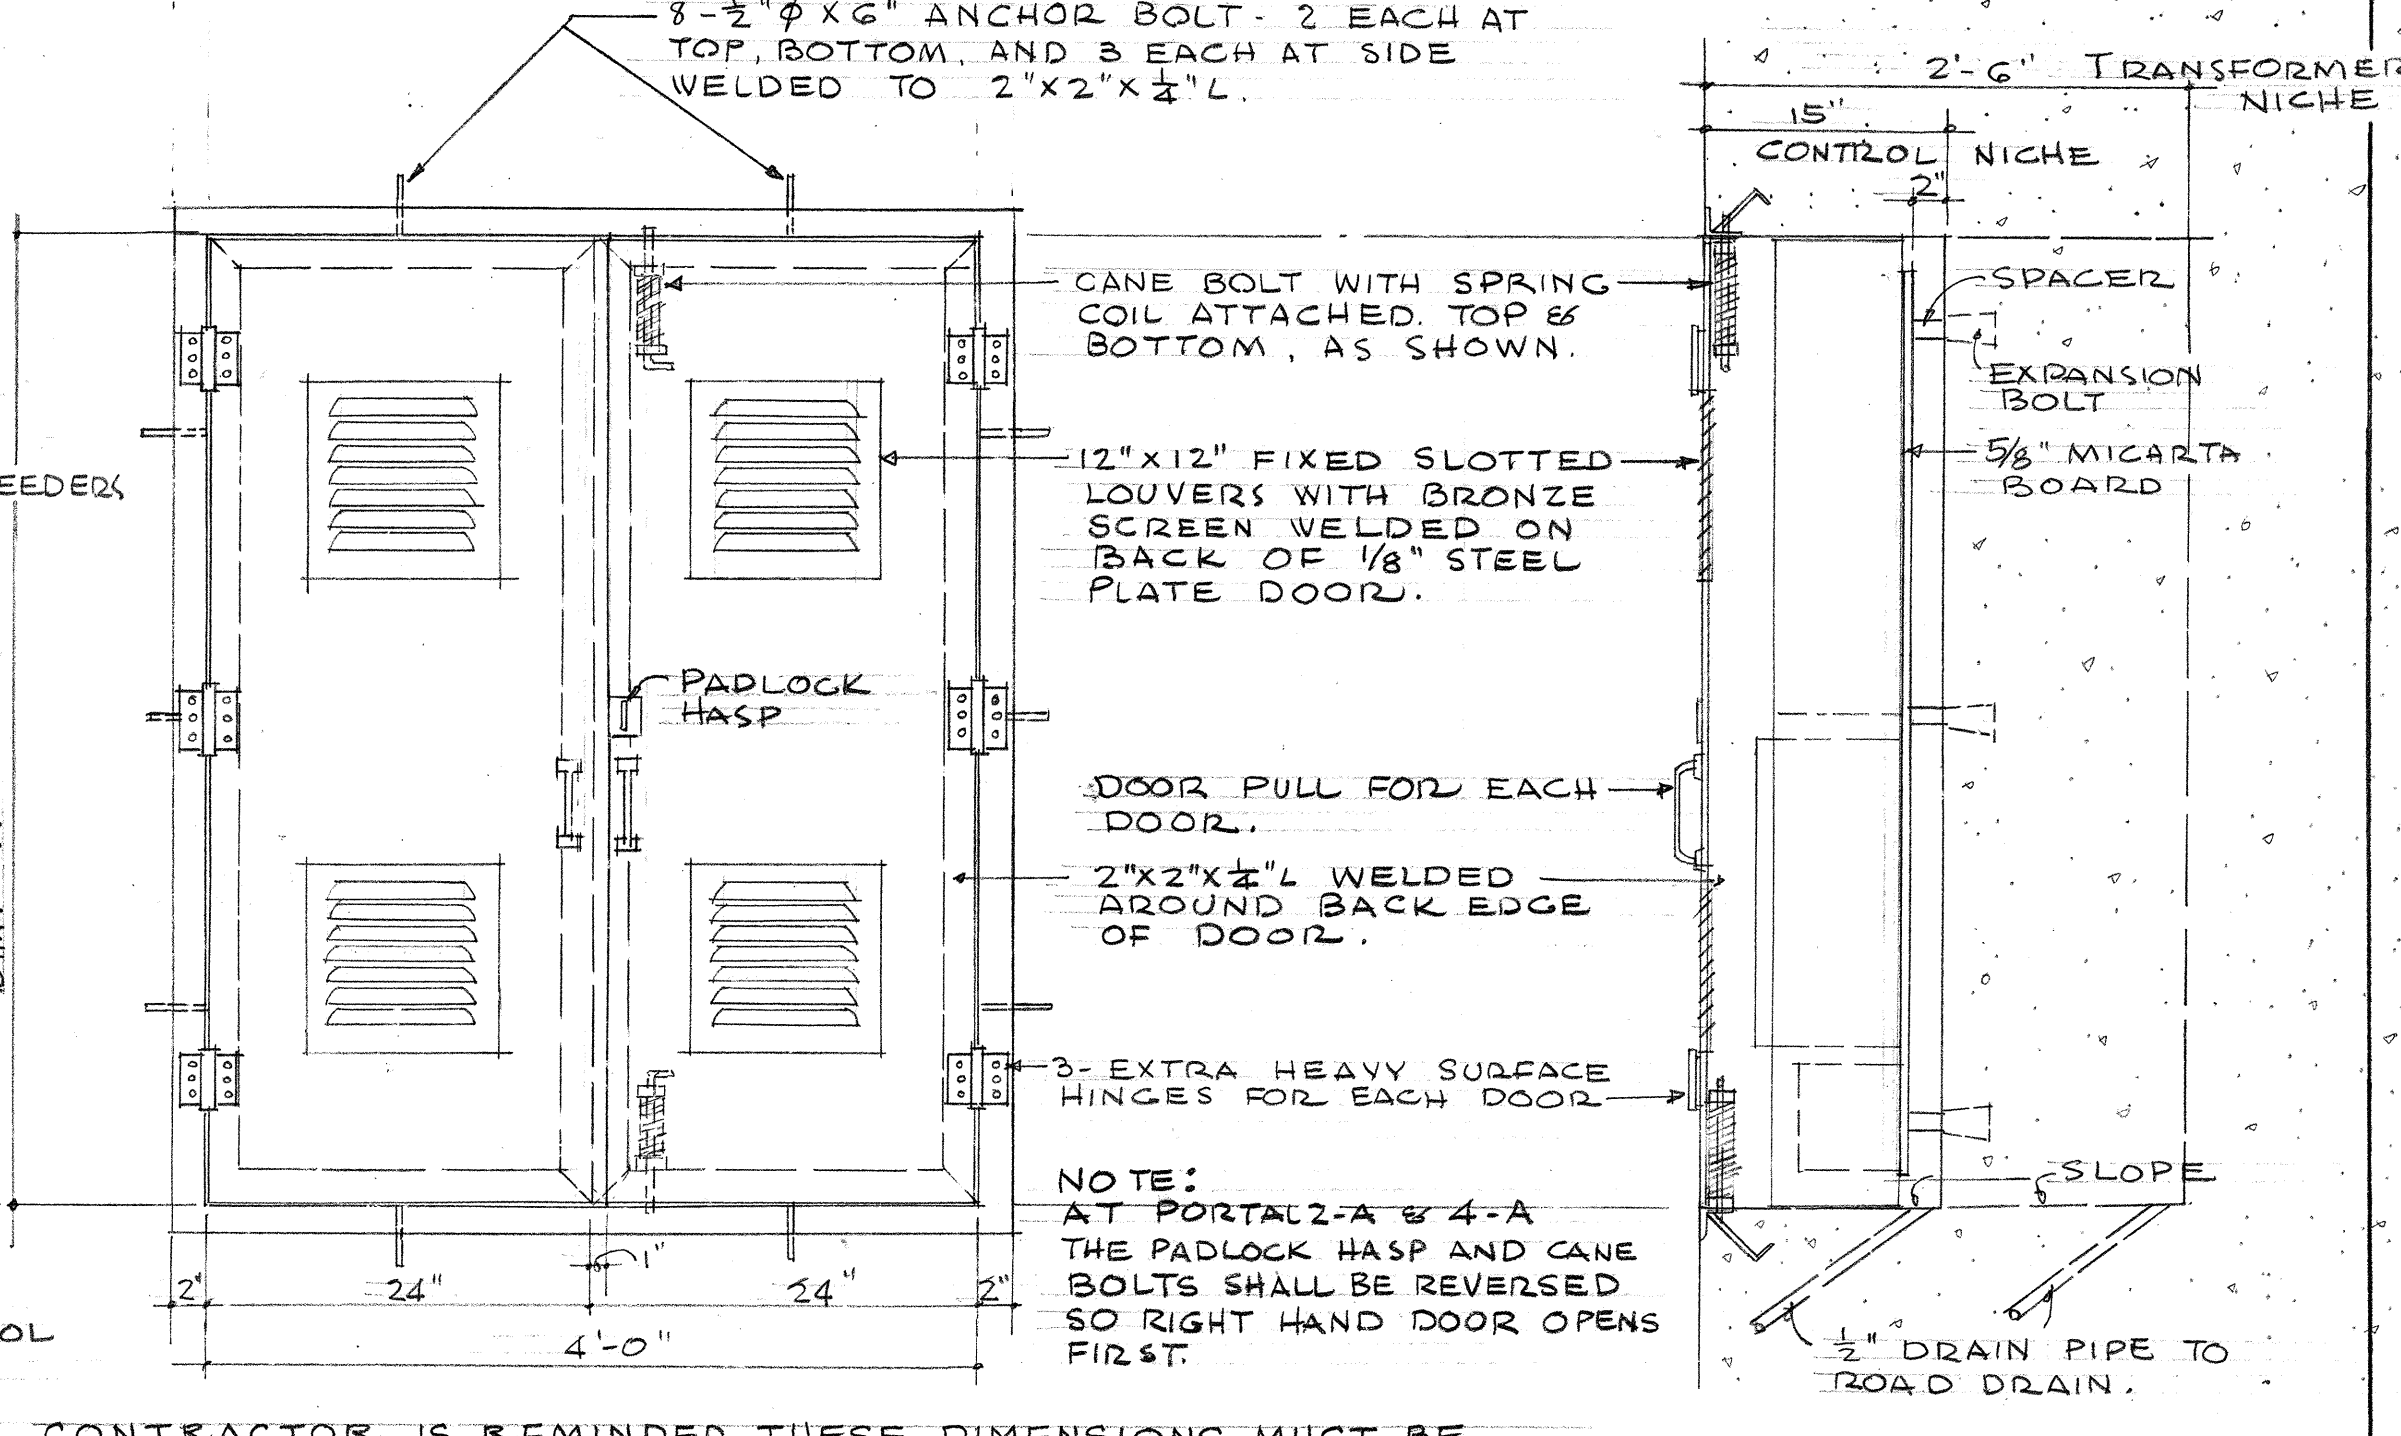

DOOR DETAILS - FRONT VIEW (A/12) SECTION - SIDE VIEW
FOR CONTROL NICHE & TRANSFORMER NICHE
SCALE: 1" = 1'-0"

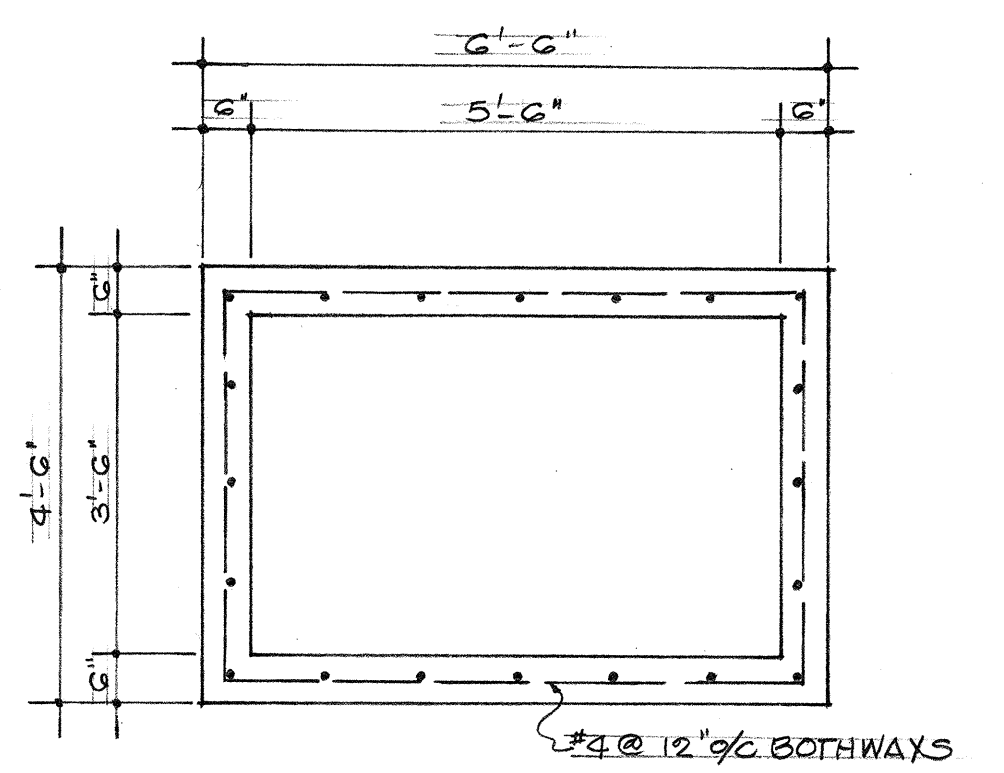


PLAN

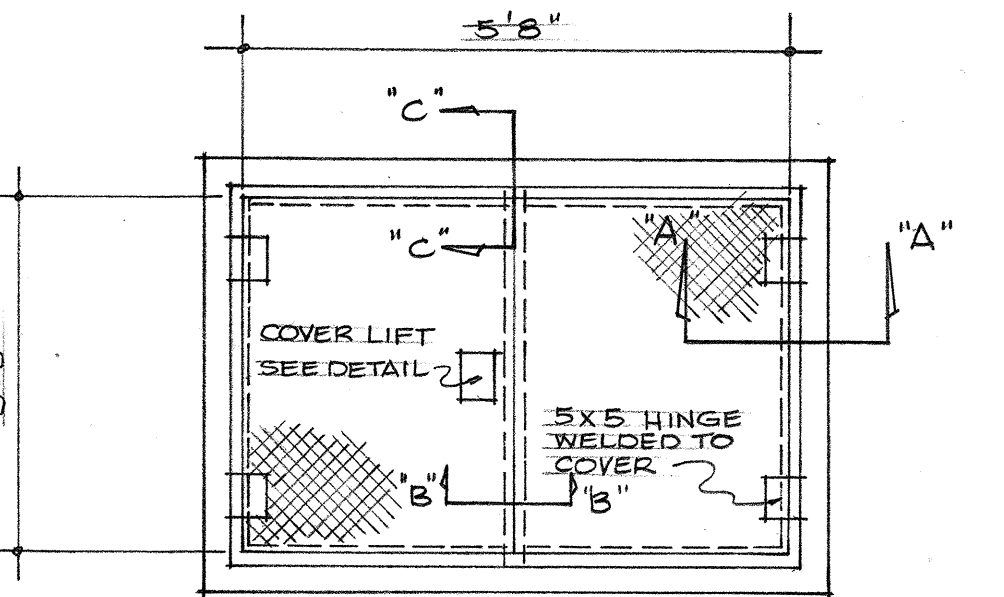

COVER PLAN

SCALE: 1/2" = 1'-0"

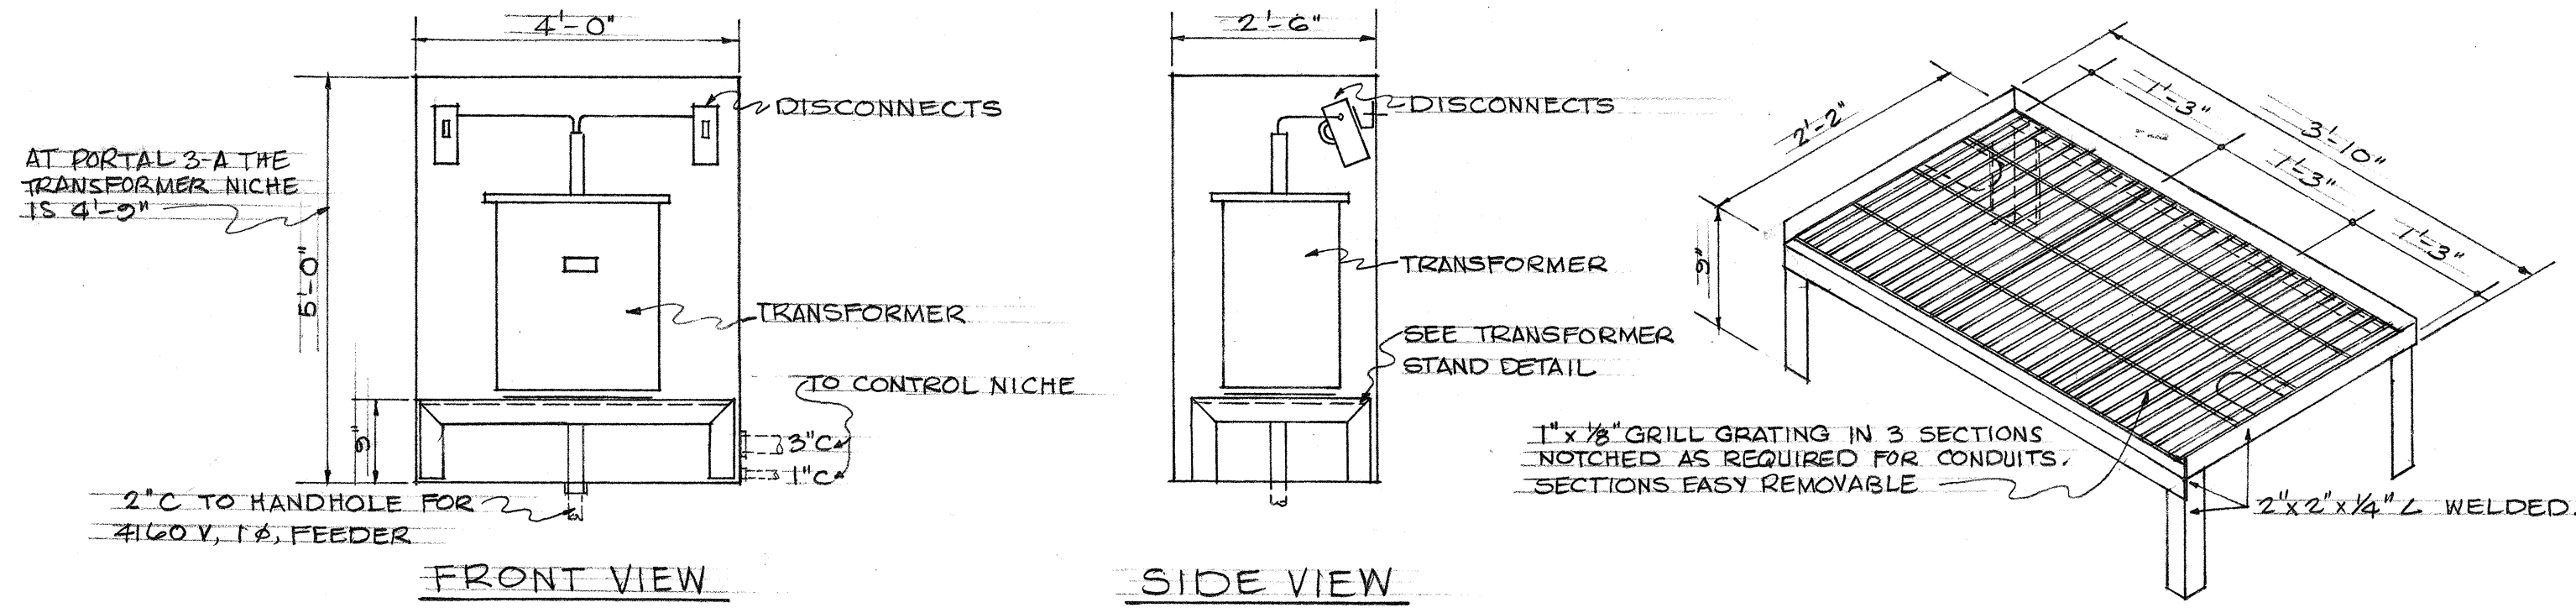


EQUIPMENT LAYOUT
TRANSFORMER NICHE

SCALE: 1/2" = 1'-0"


TRANSFORMER STAND

SCALE: 3/4" = 1'-0"

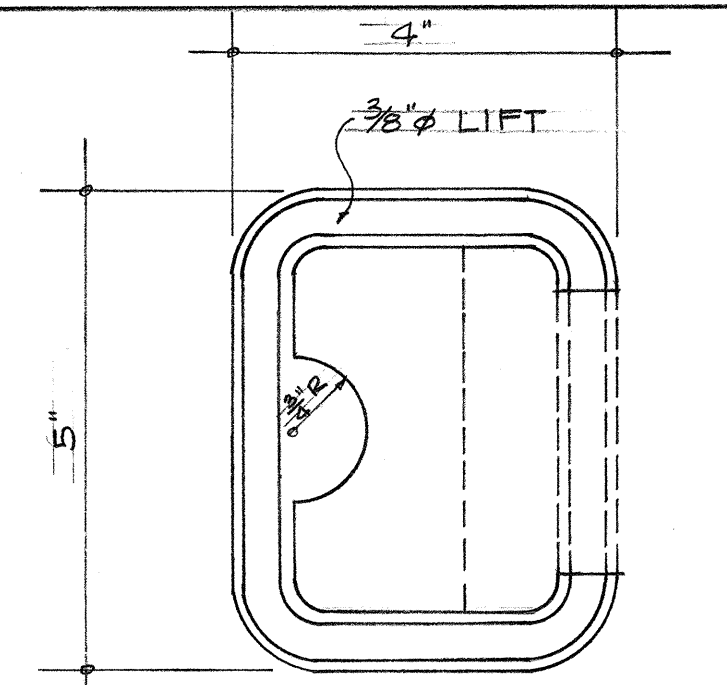

HANDHOLE COVER LIFT PLAN


1/2" F.S.S.

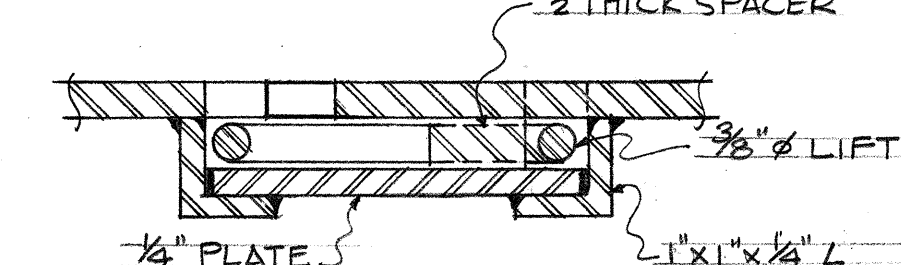

HANDHOLE COVER LIFT SECTION


1/2" F.S.S.

HANDHOLE DETAILS (B/12)

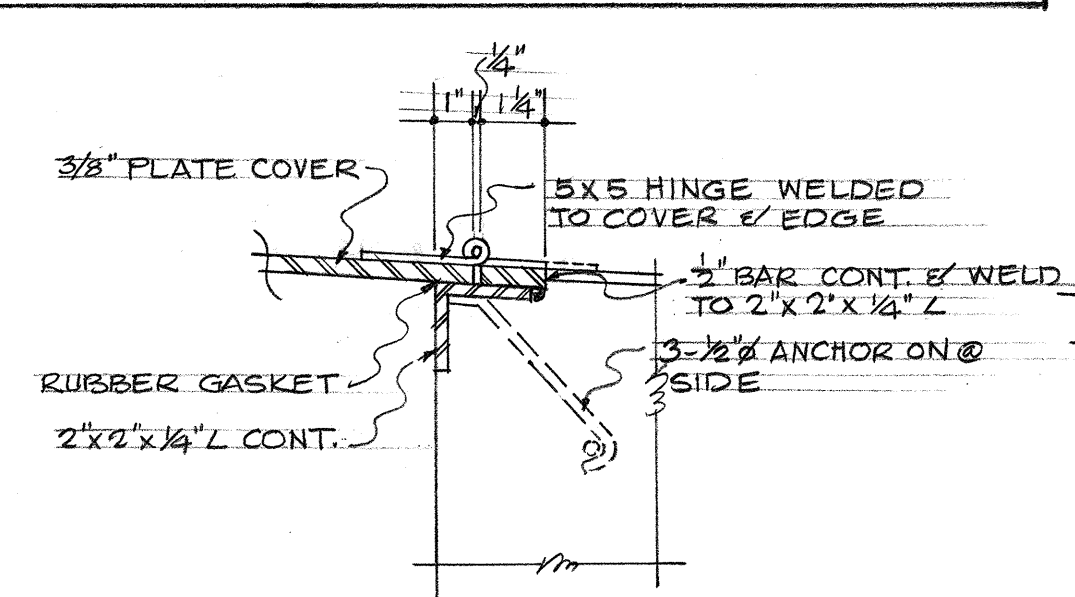


DETAIL "A-A"

SCALE: 3" = 1'-0"

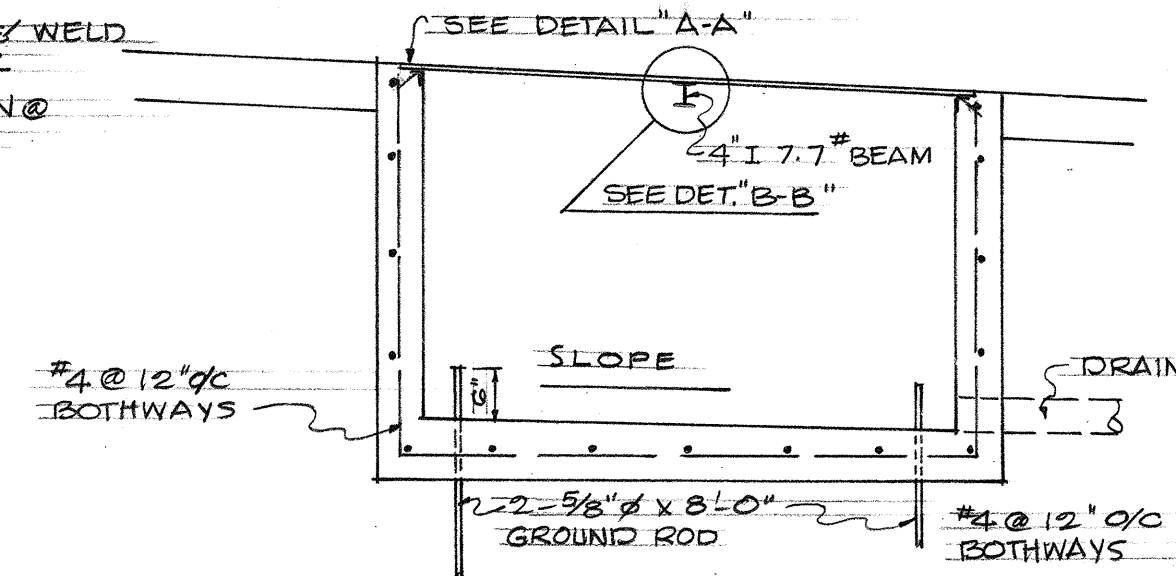

SECTION

SCALE: 1/2" = 1'-0"

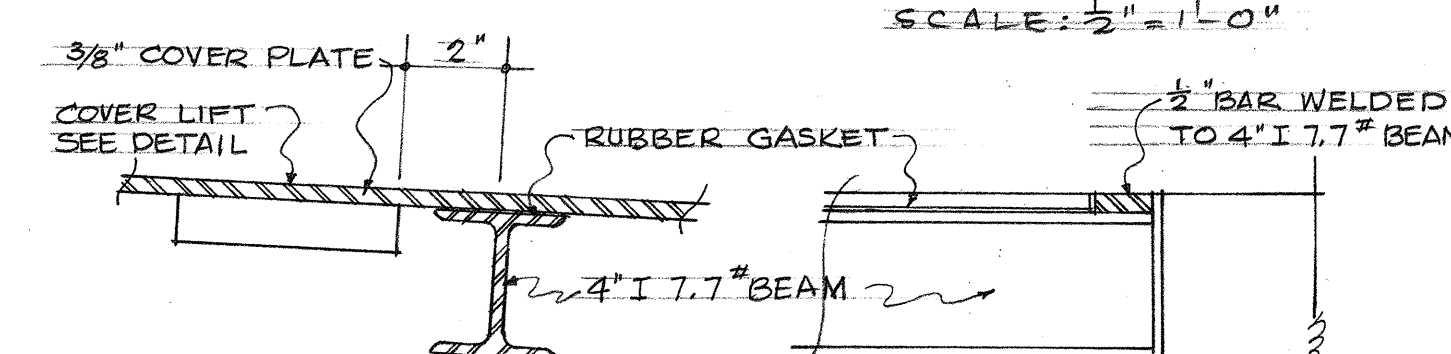

DETAIL "B-B"

SCALE: 3" = 1'-0"

DETAIL "C-C"

SCALE: 3" = 1'-0"

SURVEY PLOTTED BY: DATE: _____

DESIGNED BY: _____

TRACED BY: _____

QUANTITIES CHECKED BY: _____

ORIGINAL PLAN NO. _____

NOTE BOOK NO. _____

TERRITORIAL HIGHWAY DEPARTMENT
TERRITORY OF HAWAII
ELECTRICAL
ELECTRICAL DETAILS

PALI ROAD
OUTBOUND TUNNELS
PROJ. NO. BFOGH(5)



JAMES J. OBERHAUSEN
ELECTRICAL ENGINEER

SCALE: AS NOTED DATE: MAY 1957

SHEET No. 12 OF 13 SHEETS




5896.54

FED. ROAD DIST. No.	STATE	FED. AID PROJ. No.	FISCAL YEAR	SHEET No.	TOTAL SHEETS
HAWAII	HAW.	BF-061-1(5)	1957	55	79

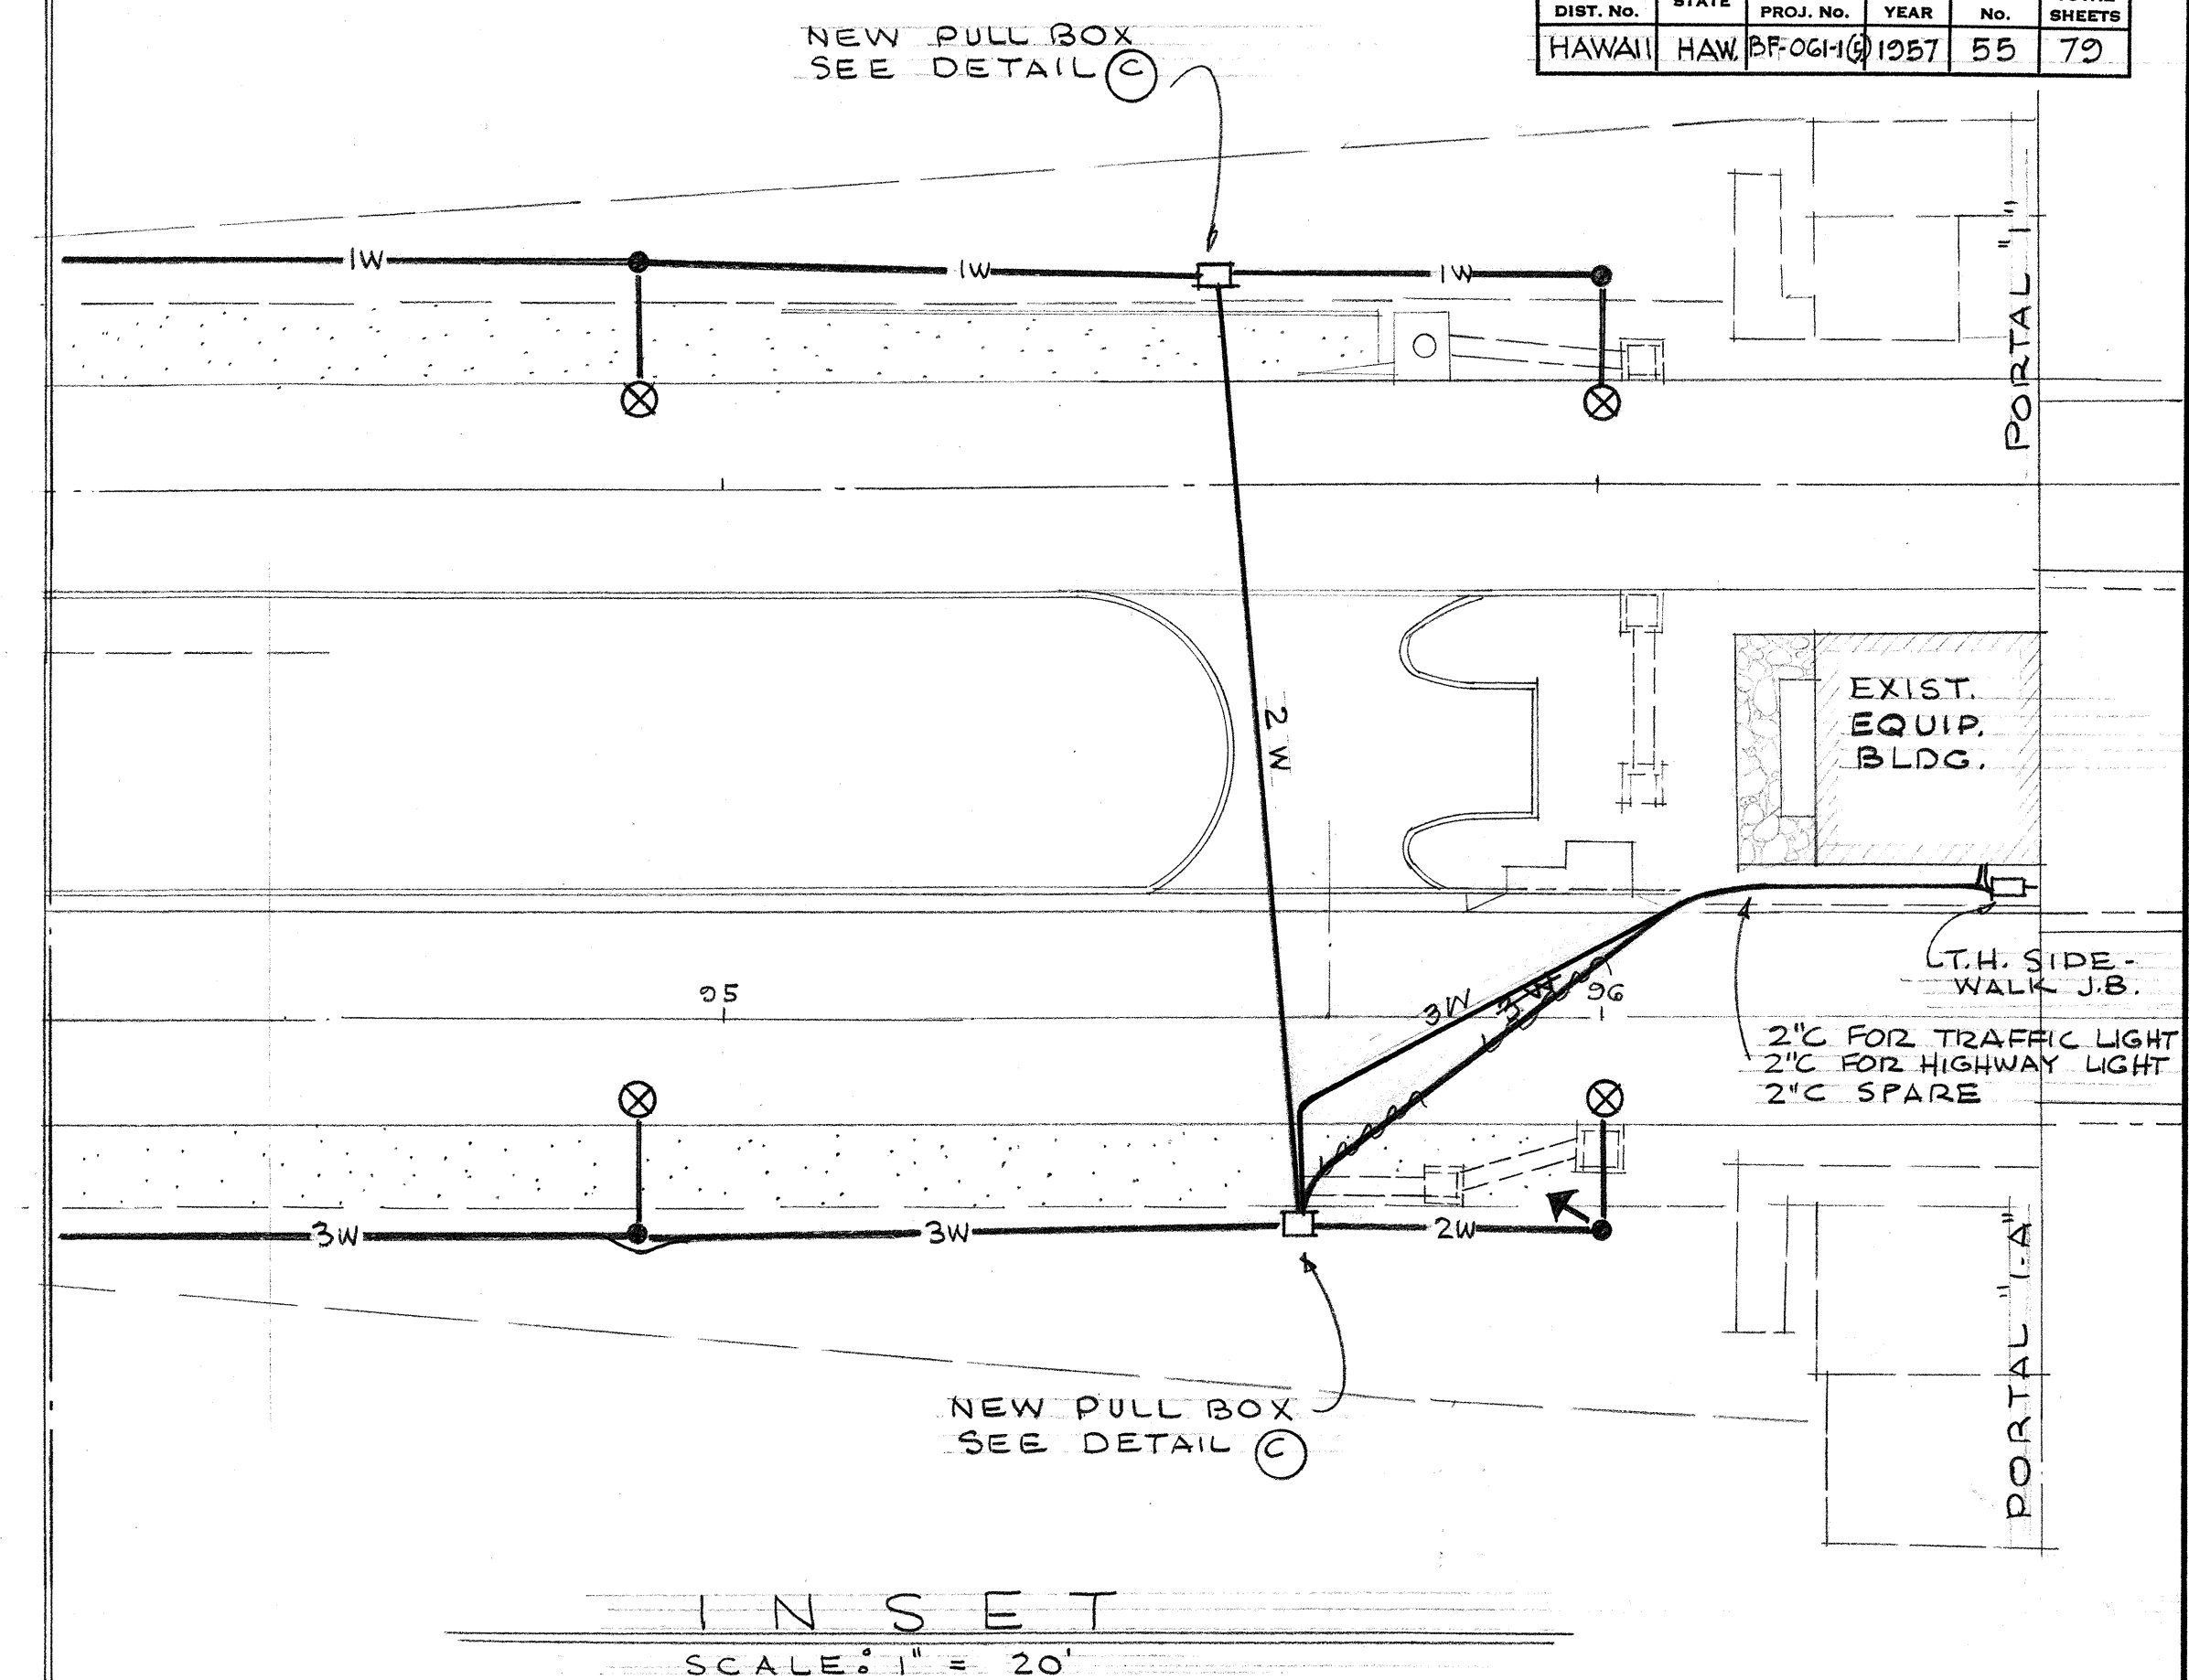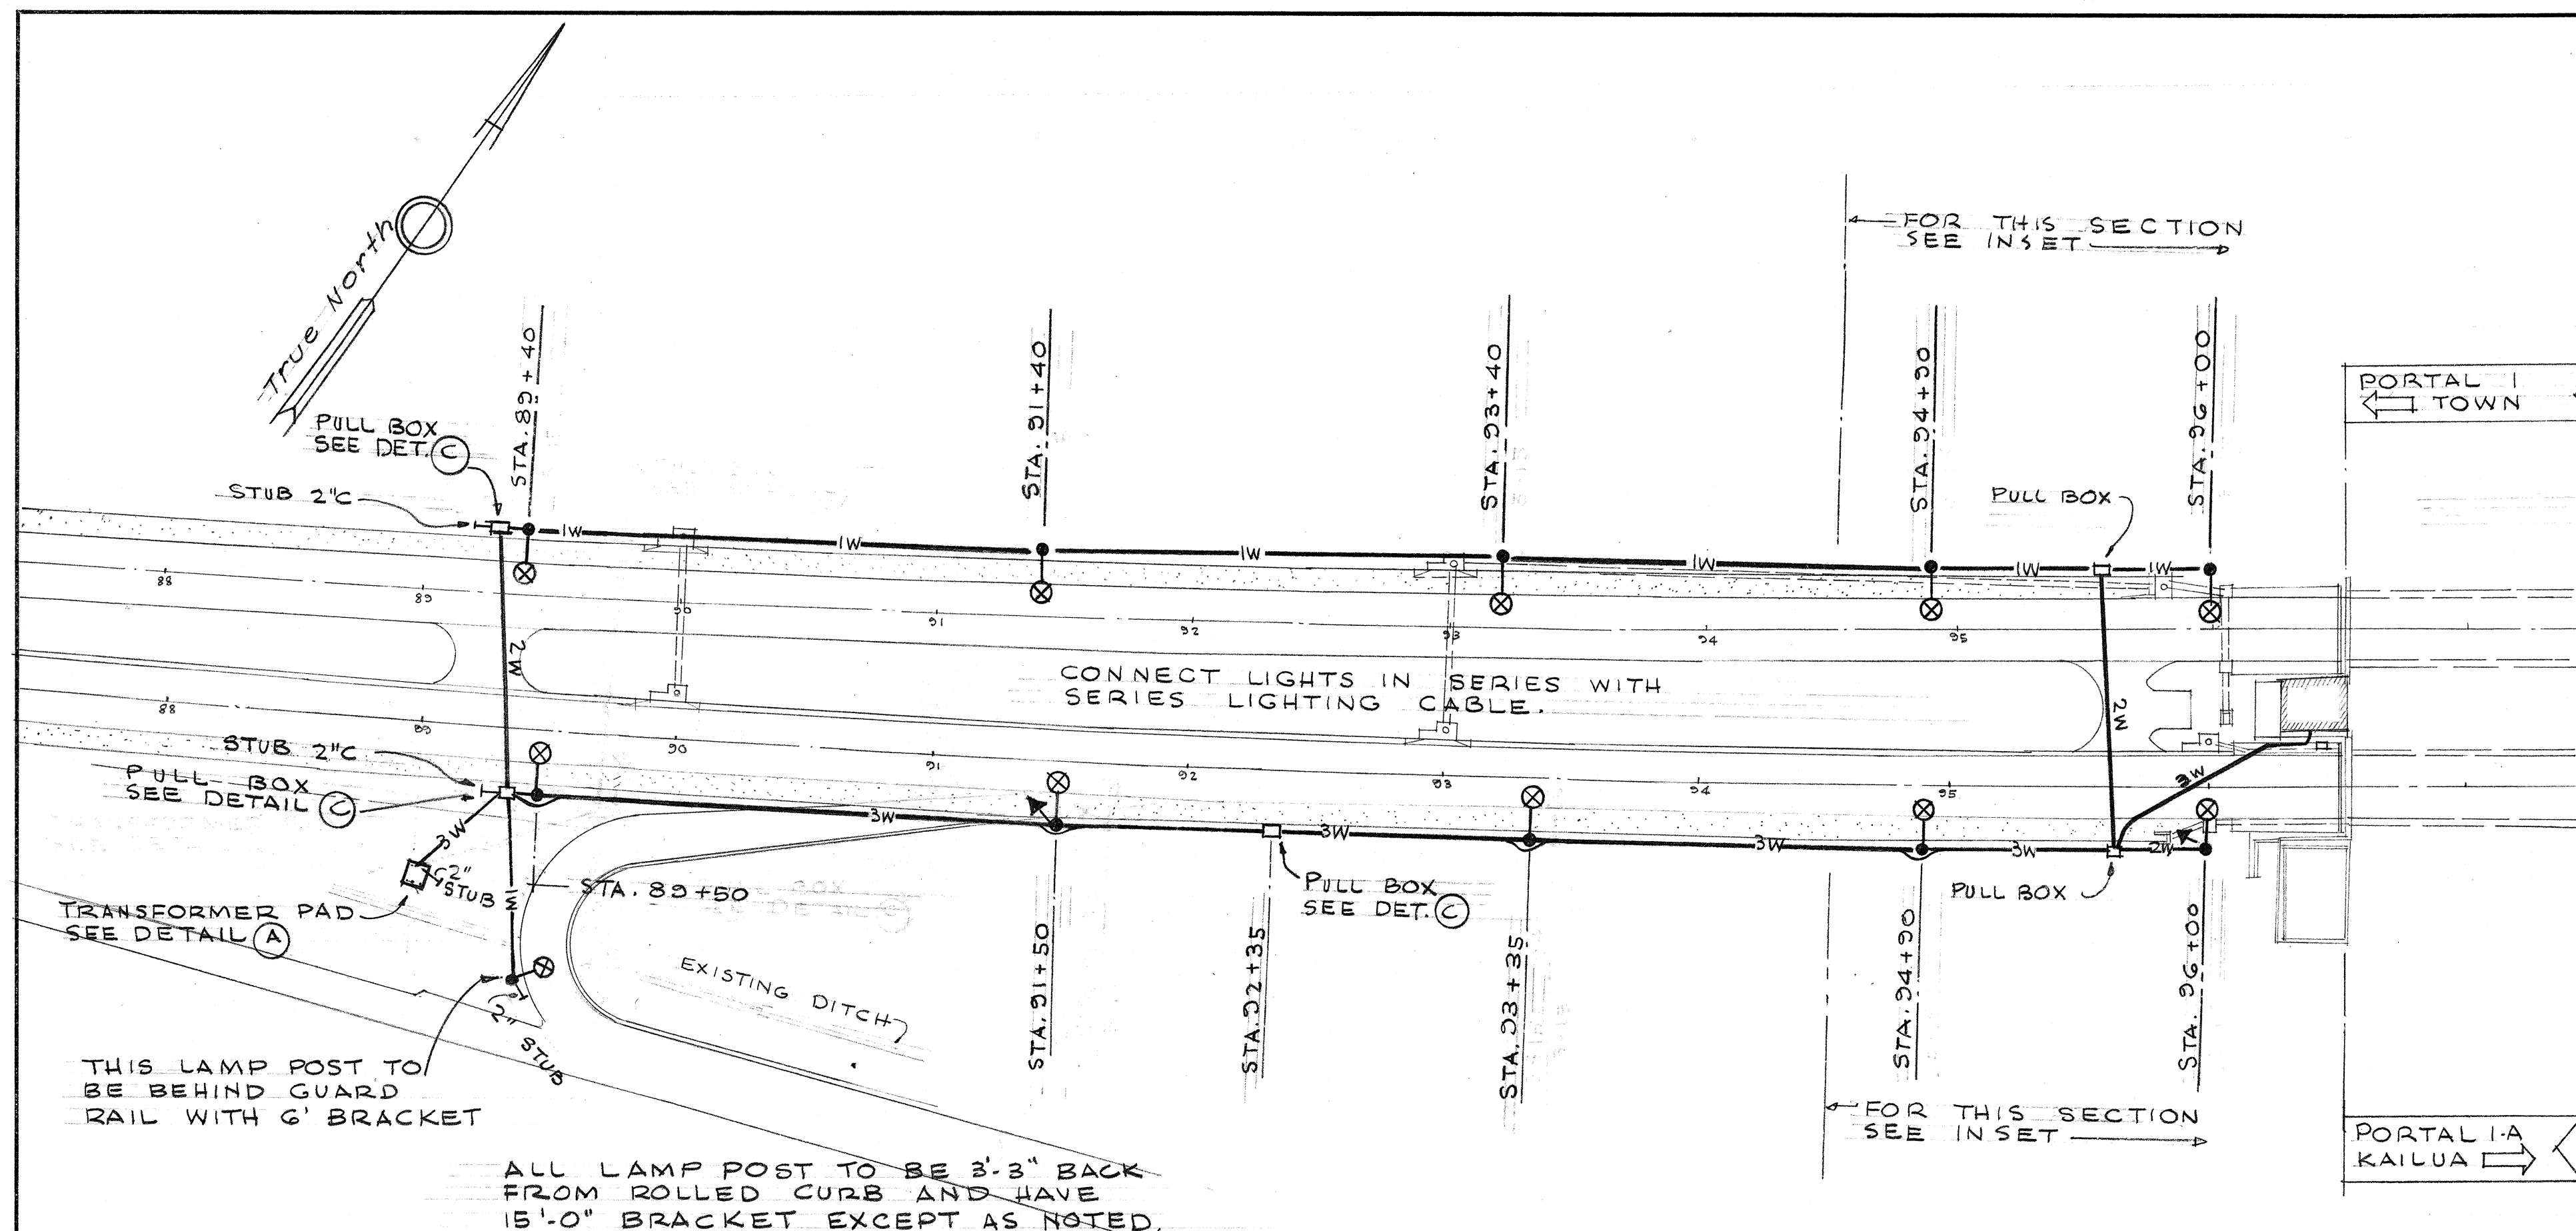

PALI ROAD - APPROACH TO PORTAL "I" & PORTAL "I-A"
HIGHWAY LIGHTING & TRAFFIC LIGHTS PLAN

SCALE : 1" = 50'

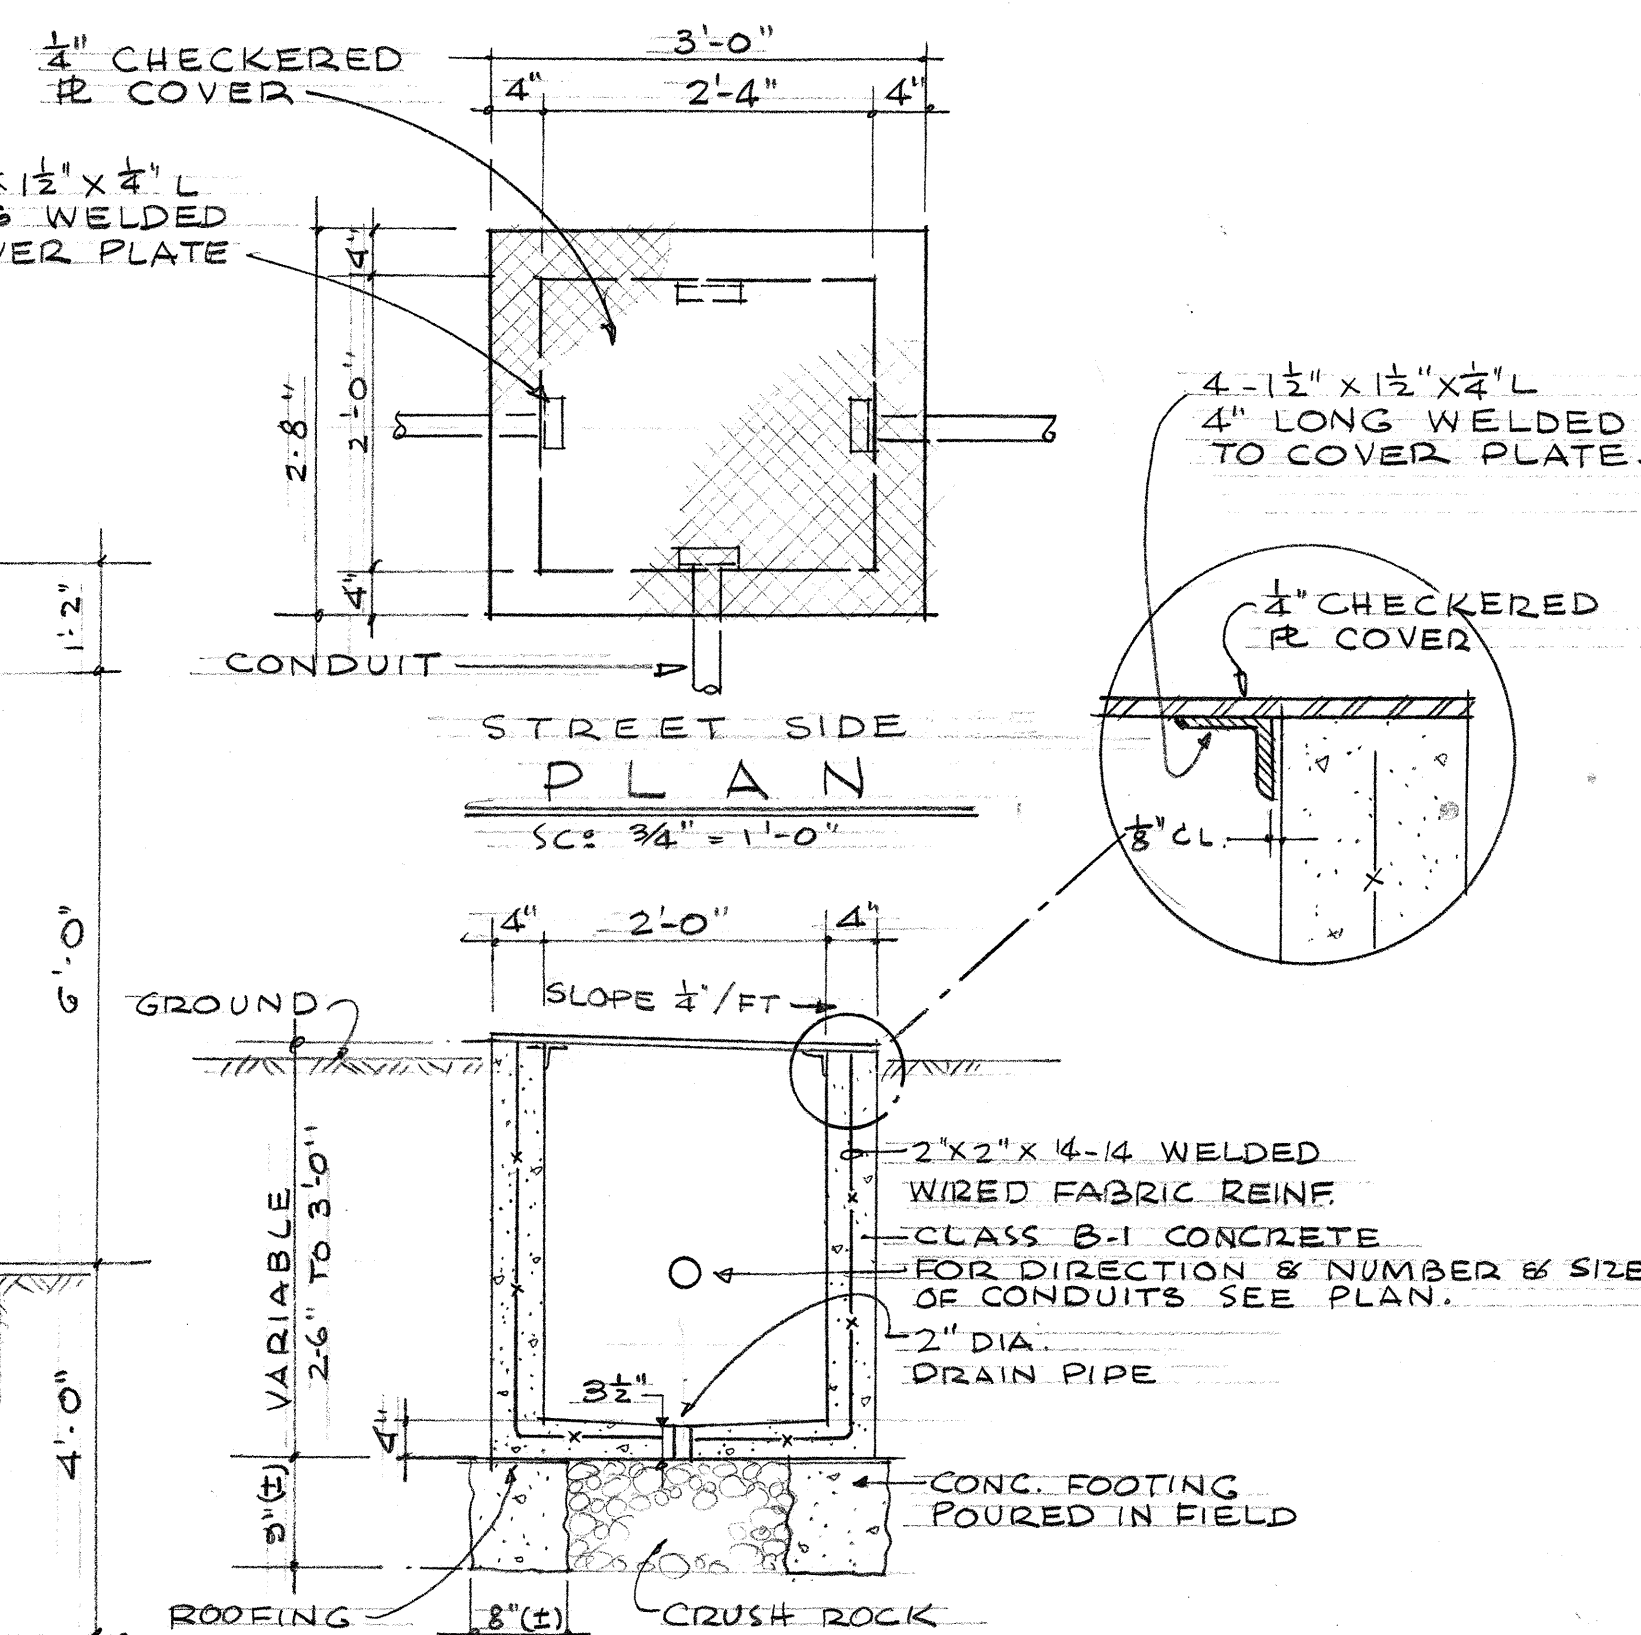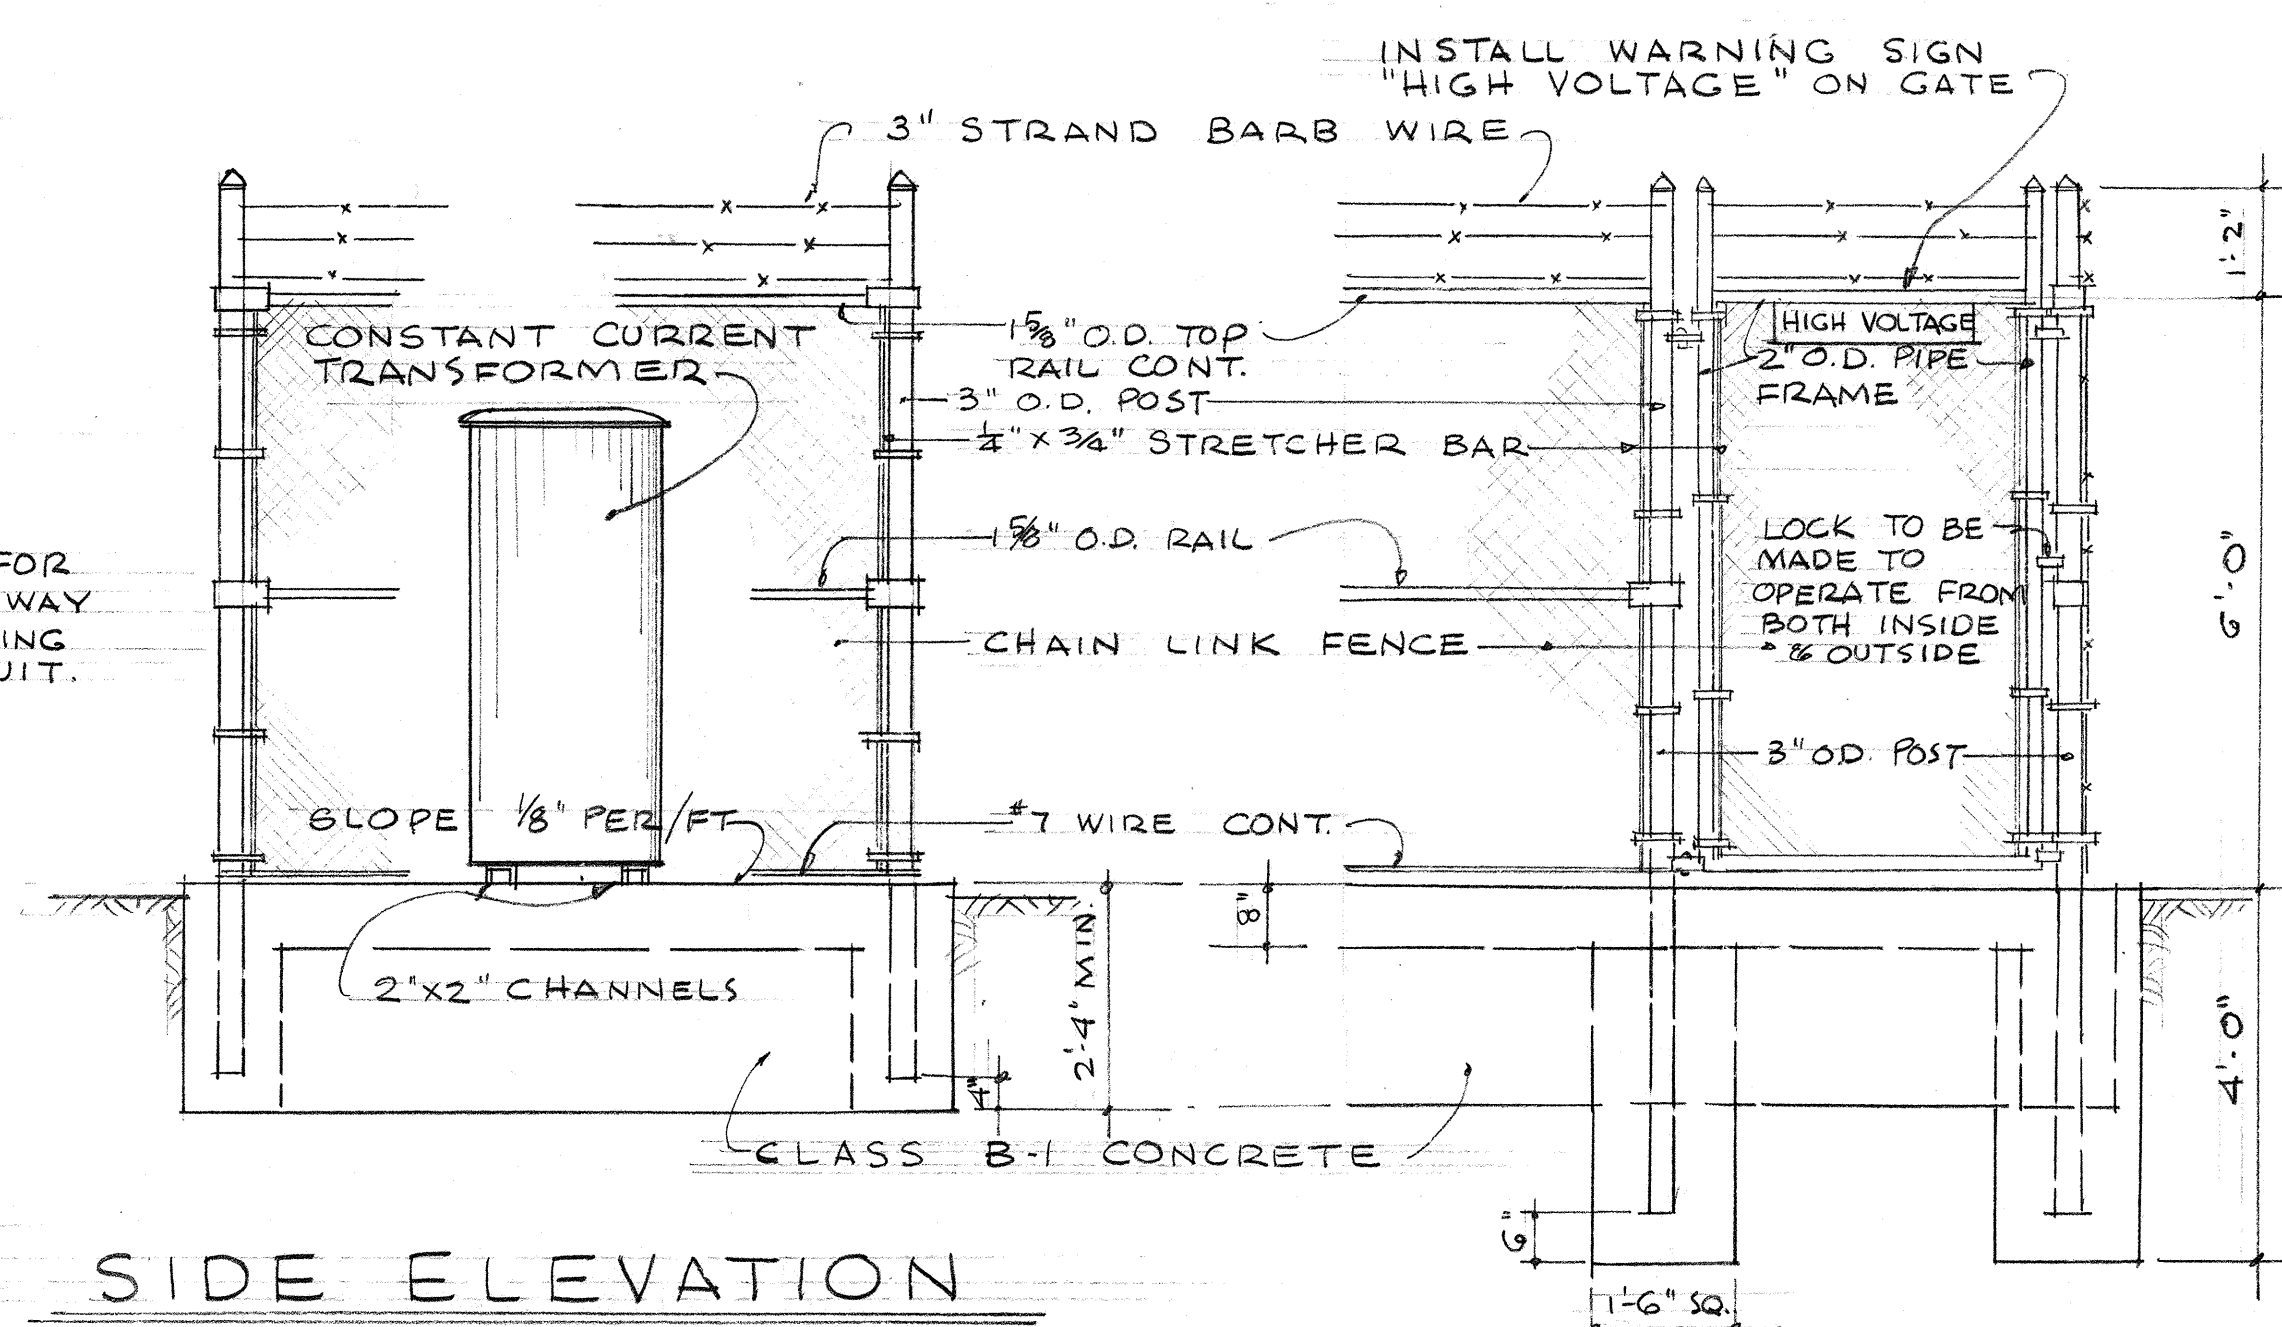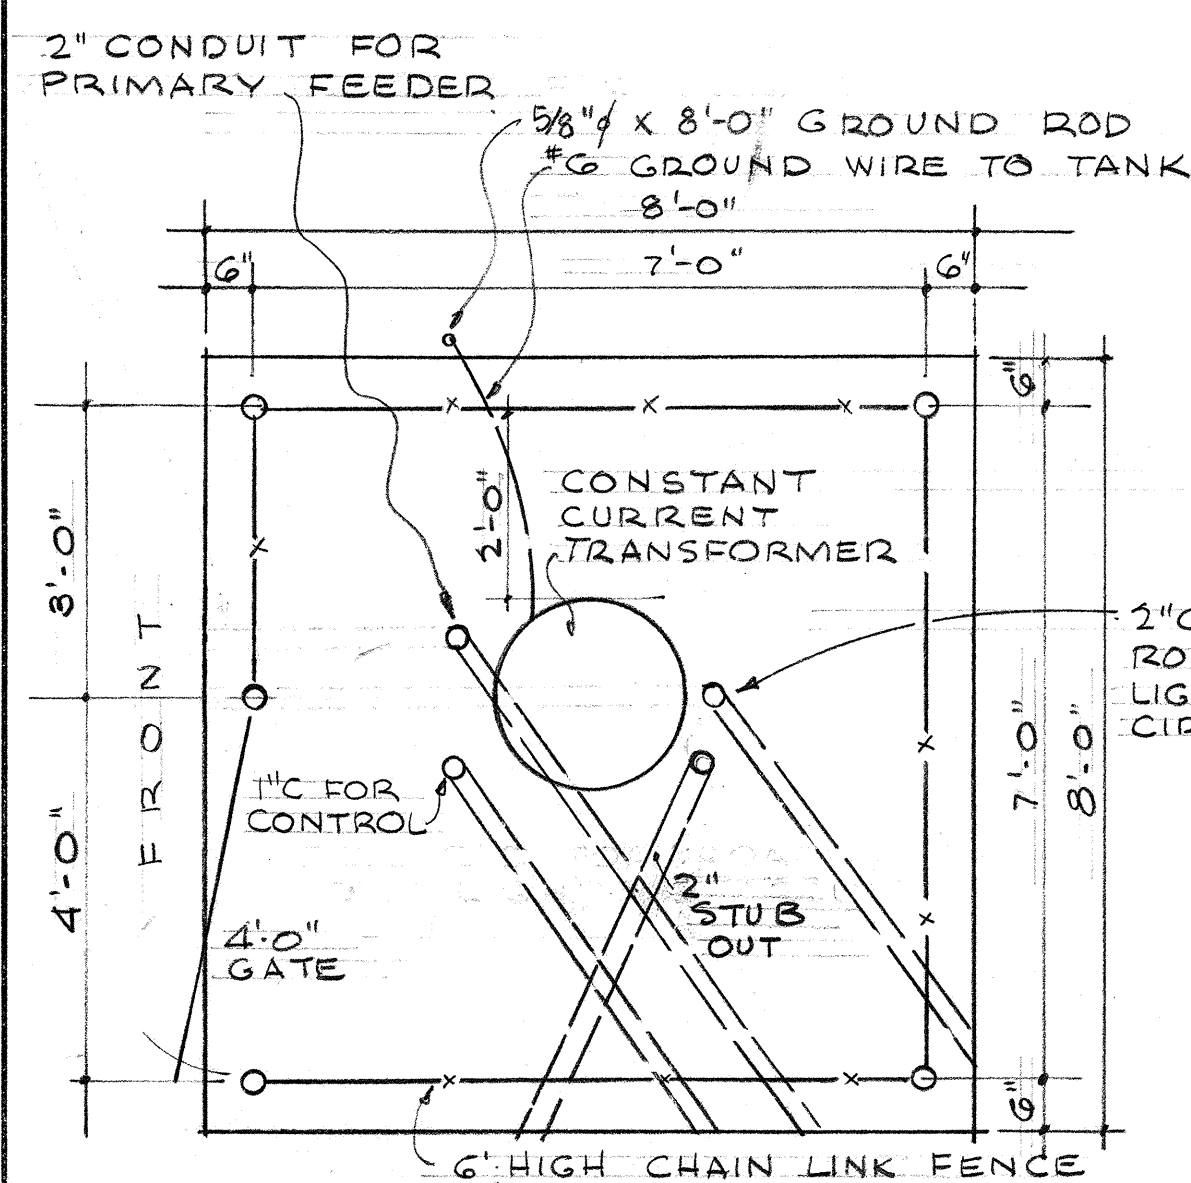

PLAN SIDE ELEVATION

TRANSFORMER PAD DETAIL (A)

SCALE: $\frac{1}{2}" = 1'-0"$

CHAIN LINK FENCE DETAIL (B)

PULL BOX DETAIL (C)

JAMES J. OBERHAUSEN
ELECTRICAL ENGINEER

TERRITORIAL HIGHWAY DEPARTMENT
TERRITORY OF HAWAII
ELECTRICAL
HIGHWAY LIGHTING, TRAFFIC
LIGHTS LAYOUT & DETAILS
PALI ROAD
OUTBOUND TUNNELS
PROJ. NO. BF-OGI-1(B)
SCALE: AS NOTED DATE: MAY 1957

SHEET No. 13 OF 13 SHEETS

5896.55