


FED. ROAD DIST. NO.	STATE	FED. AID PROJ. NO.	FISCAL YEAR	SHEET NO.	TOTAL SHEETS
HAWAII	HAW	U-061-1(4)	1957	27	41

Jan. 27, 1958
Jan. 31, 1958

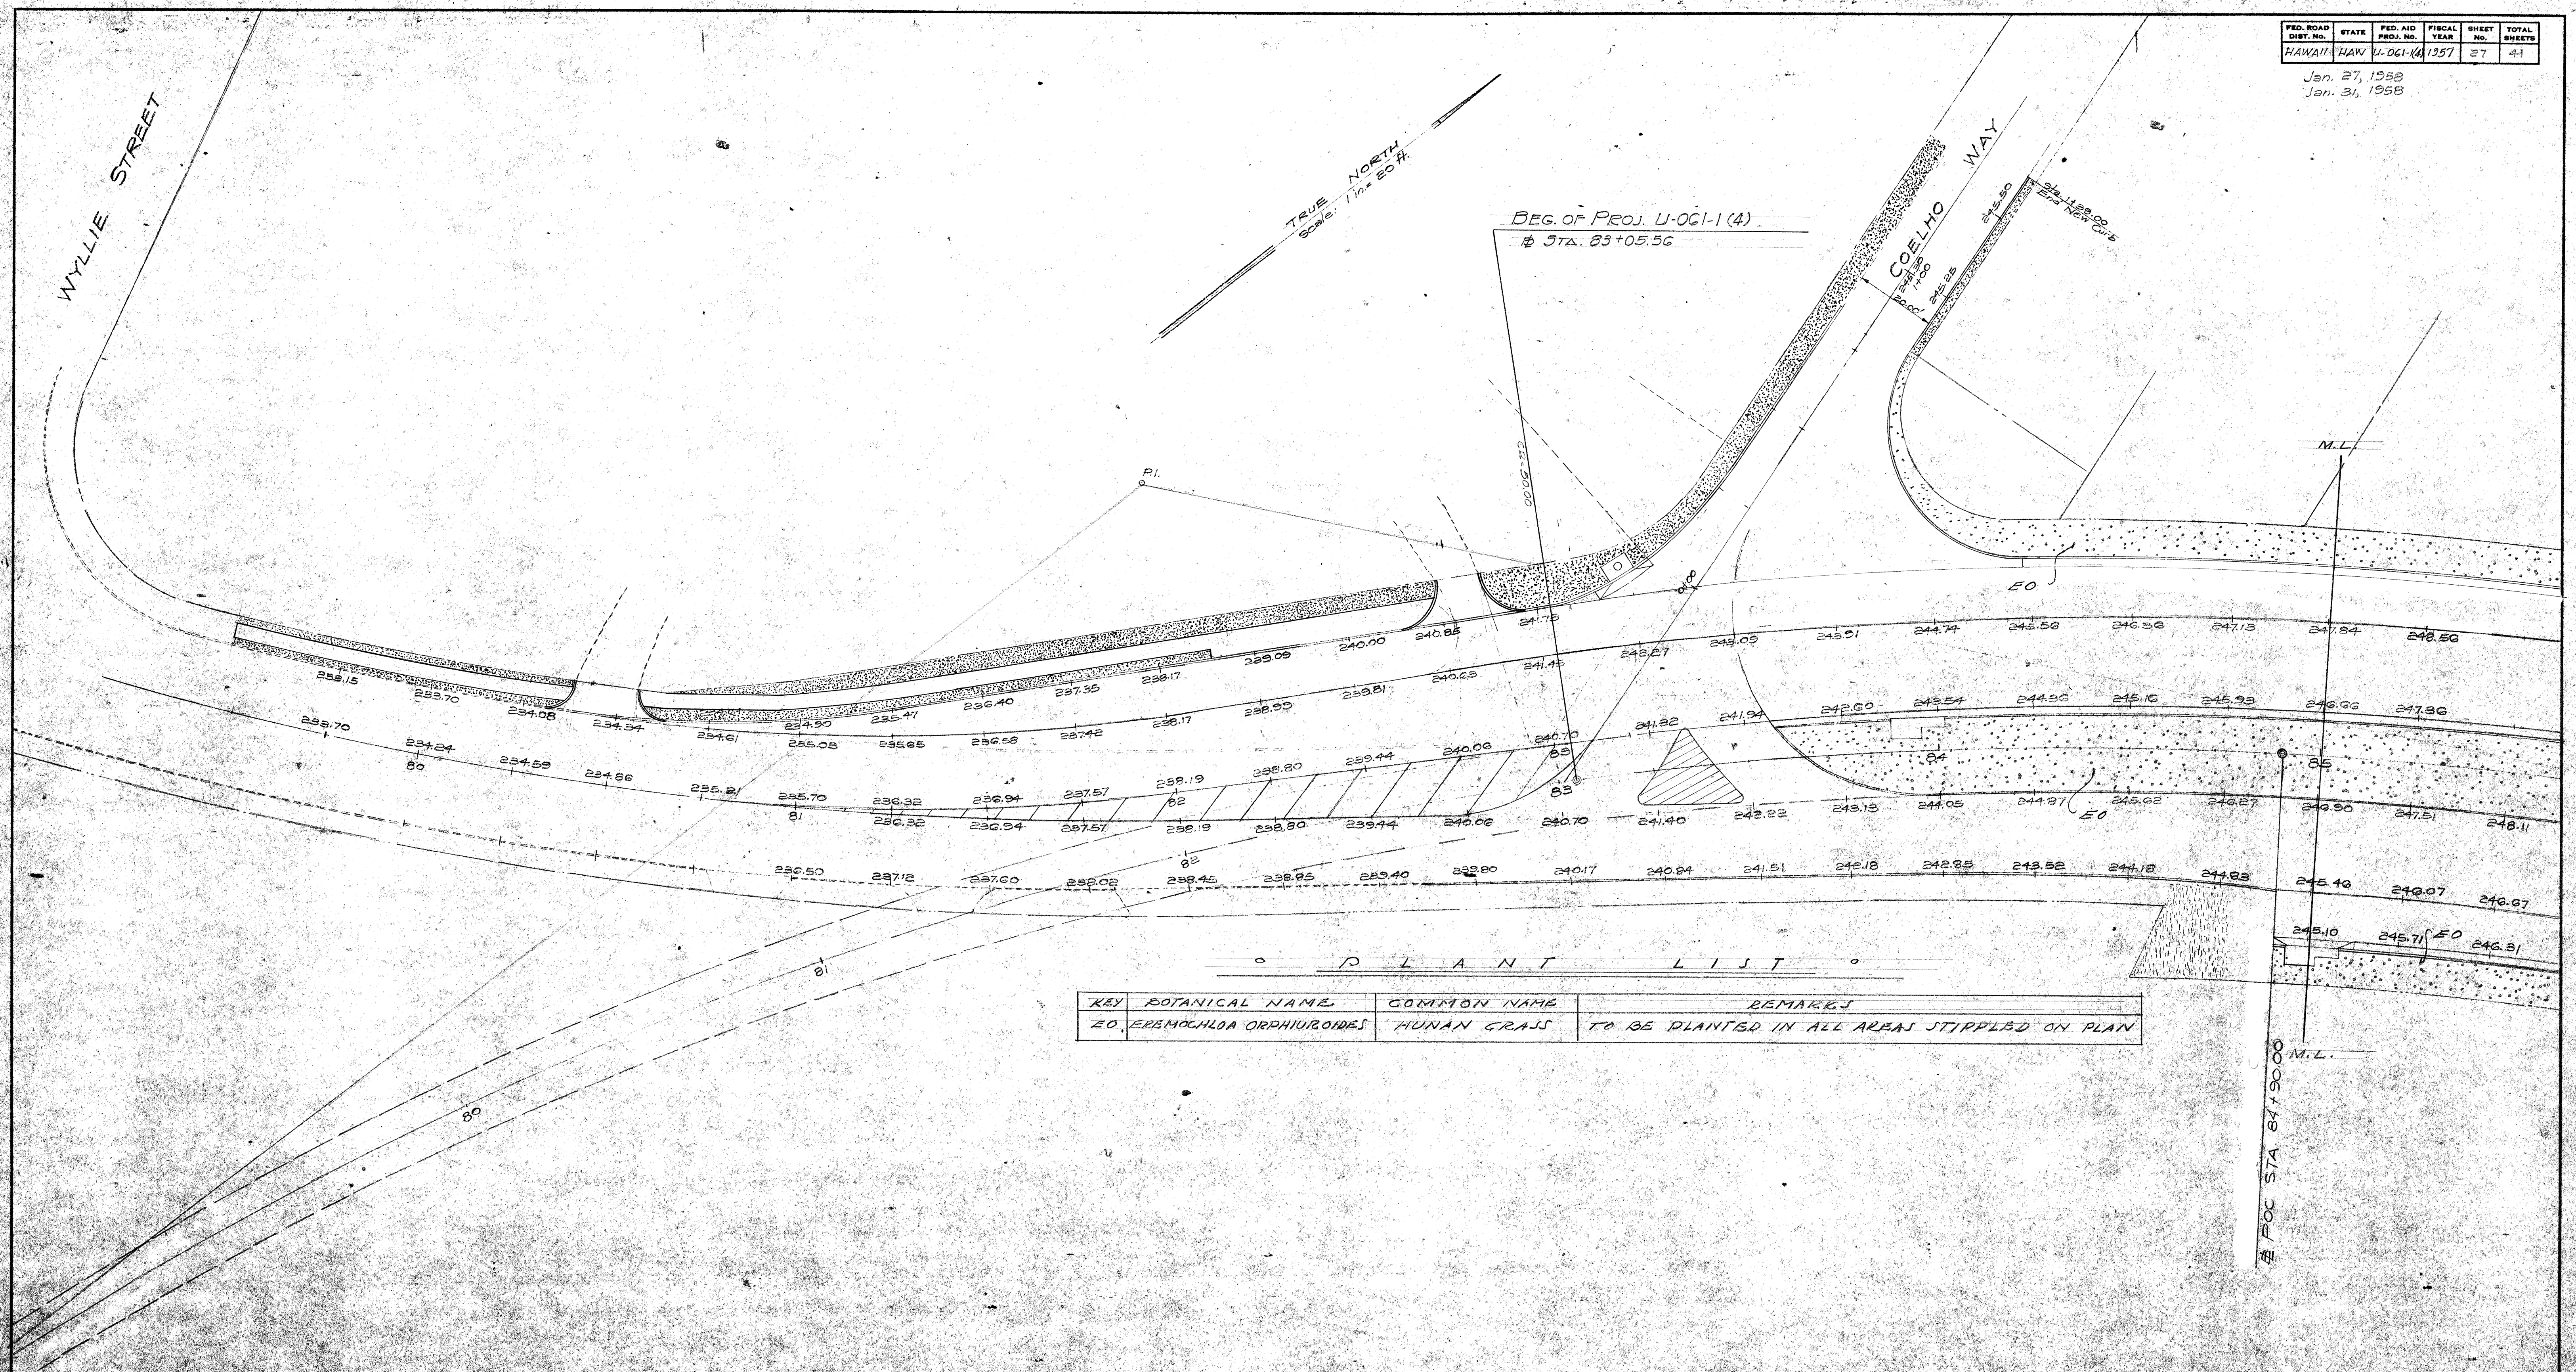

KEY	BOTANICAL NAME	COMMON NAME	REMARKS
EO	EREMOPHLOA ORPHIUROIDES	HUMAN GRASS	TO BE PLANTED IN ALL AREAS STIPPLED ON PLAN

DATE
DESIGNED BY
CHECKED BY
QUANTITIES BY
NOTES CHECKED BY
NO.


MANSFIELD P. CLARKE
LANDSCAPE ARCH. A.S.L.A.
HONOLULU

TERRITORIAL HIGHWAY DEPARTMENT
TERRITORY OF HAWAII
LANDSCAPE PLAN
NUUANU AVENUE
PROJ. NO. U-061-1(4)
SCALE: 1 IN. = 20 FT.

FED. ROAD DIST. NO.	STATE	FED. AID PROJ. NO.	FISCAL YEAR	SHEET NO.	TOTAL SHEETS
HAW.	HAWAII	U-061-1(4)	1957	28	41

Jan. 27, 1958
Jan. 31, 1958

NOTE: For Access Streets Grades See Sheet

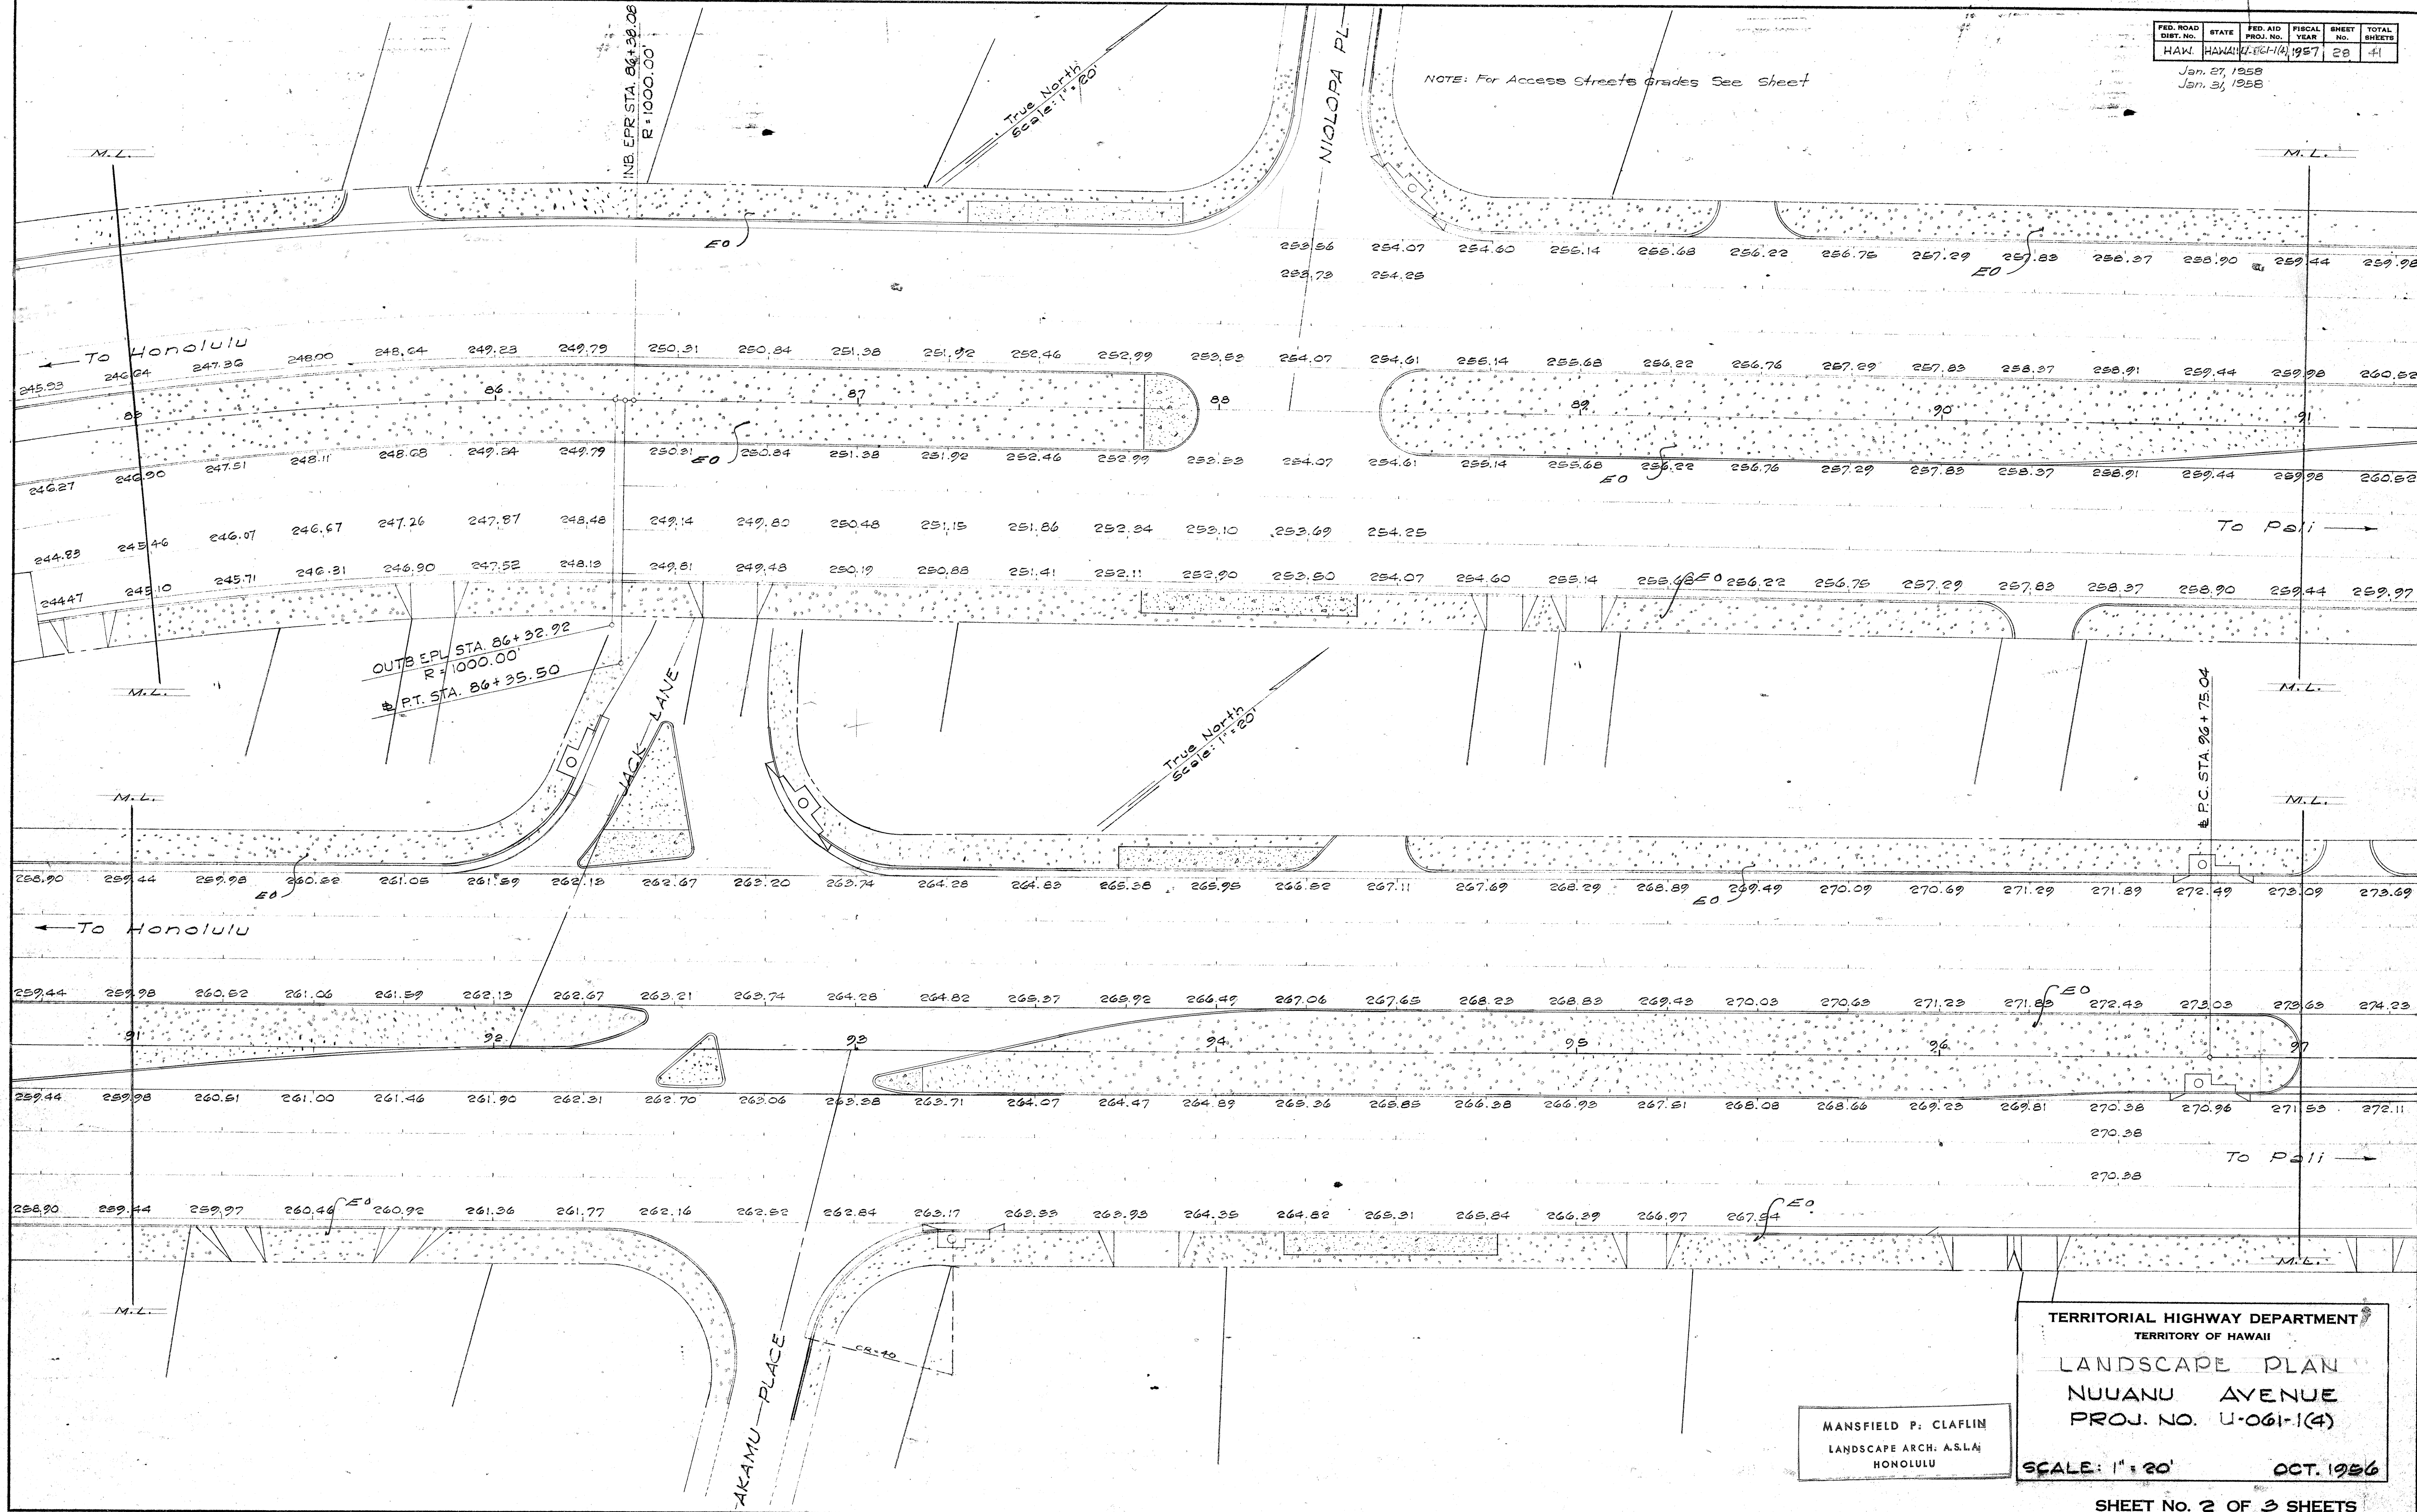

SURVEY PLOTTED BY	DATE
DRAWN BY	
TRACED BY	
QUANTITIES BY	
CHECKED BY	
ORIGINAL PLAN	
NOTE BOOK	
No.	

MANSFIELD P. CLAFLIN
LANDSCAPE ARCH. A.S.L.A.
HONOLULU

TERRITORIAL HIGHWAY DEPARTMENT
TERRITORY OF HAWAII
LANDSCAPE PLAN
NUUANU AVENUE
PROJ. NO. U-061-1(4)


SCALE: 1" = 20' OCT. 1956




SHEET No. 2 OF 3 SHEETS

5891.28

Jan. 27, 1958
Jan. 31, 1958

FED. ROAD DIST. NO.	STATE	FED. AID PROJ. NO.	FISCAL YEAR	SHEET NO.	TOTAL SHEETS
HAW.	HAWAII	U-061(4)	1957	23	41

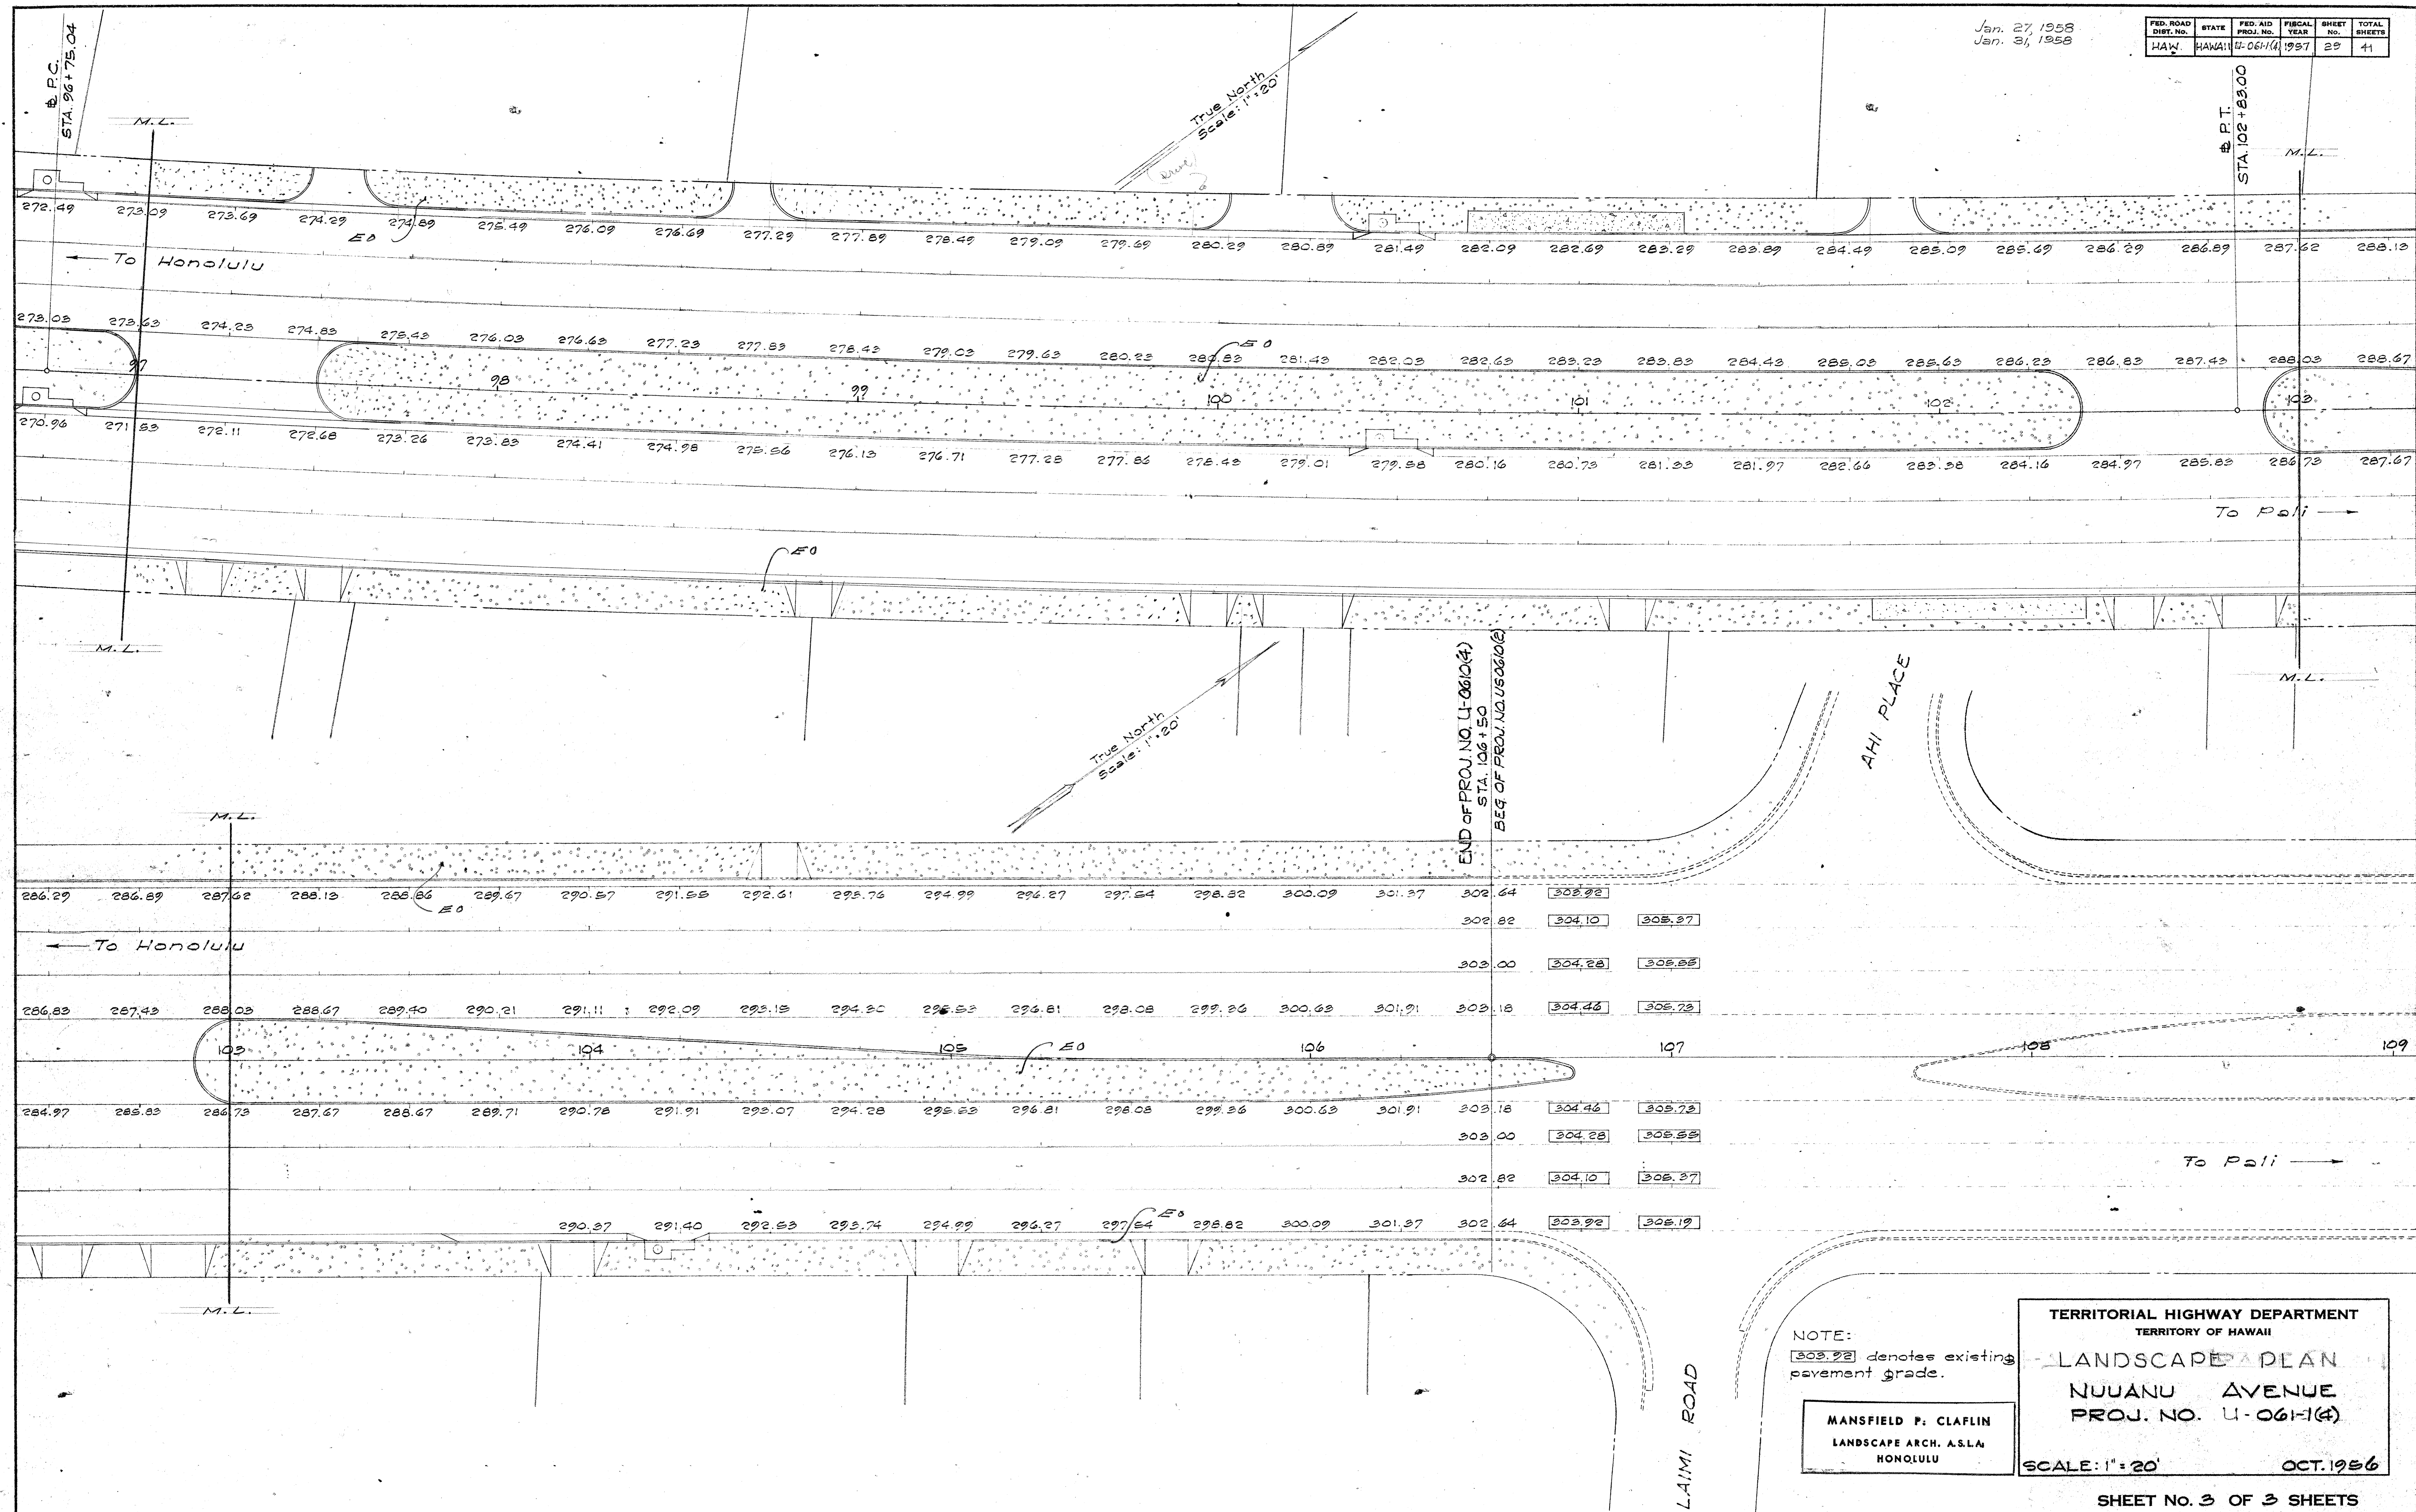

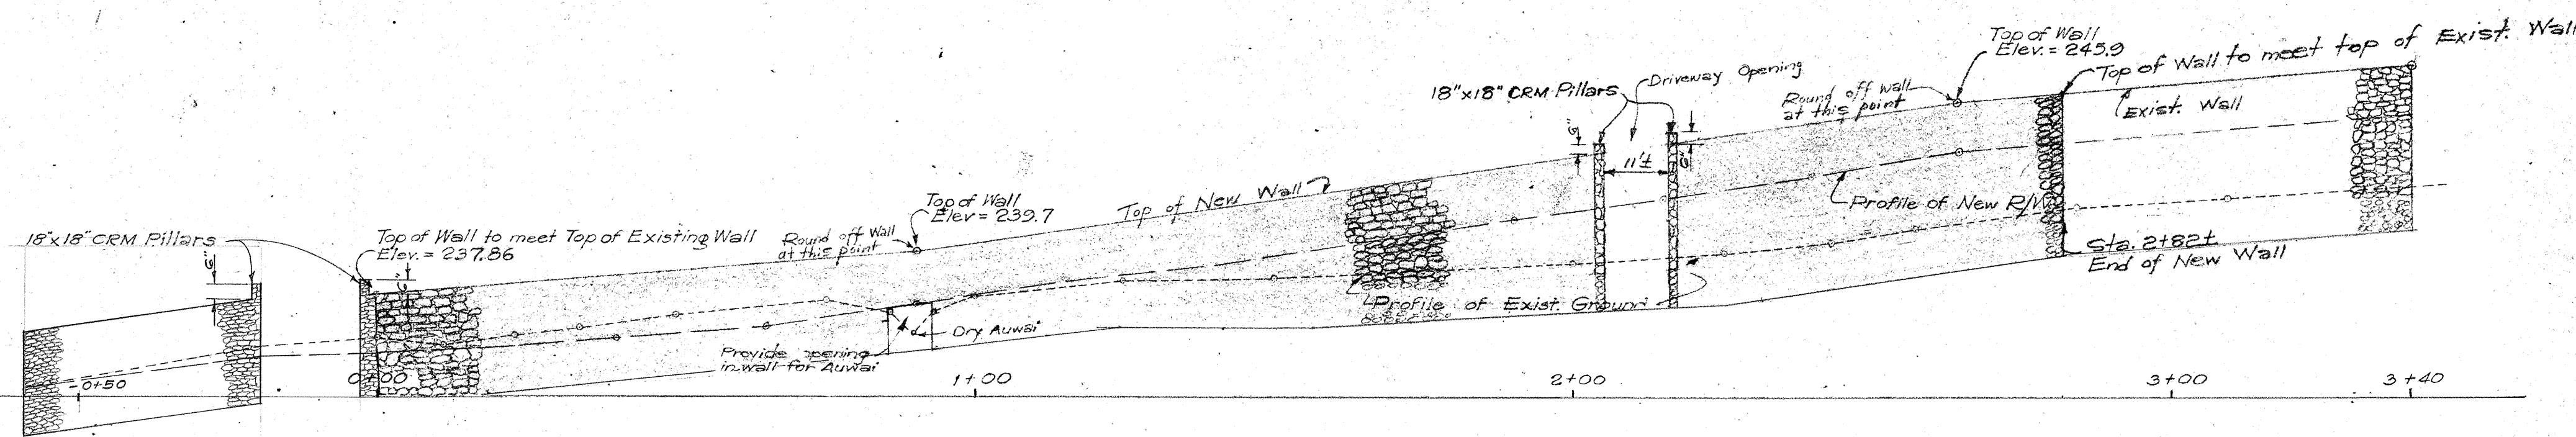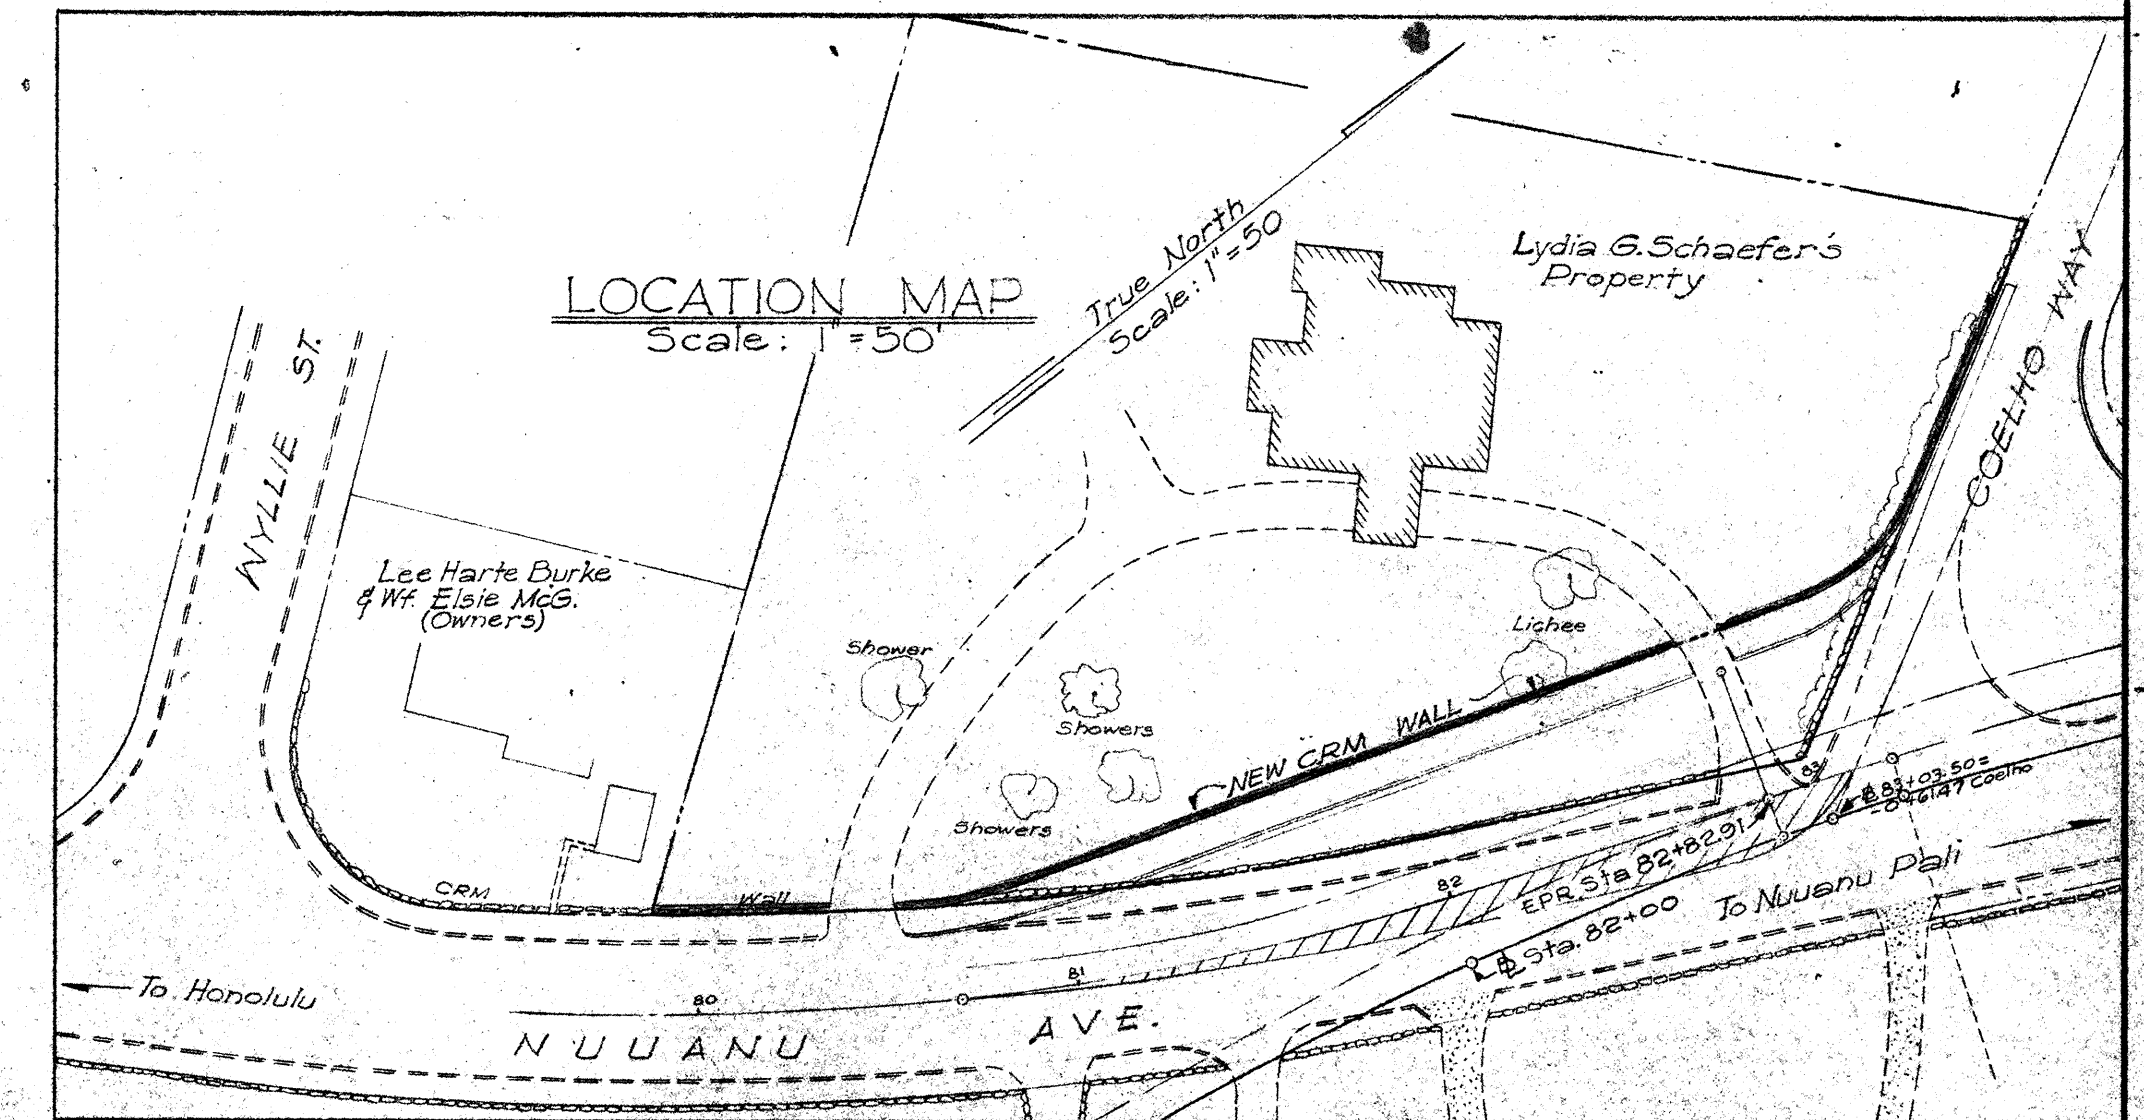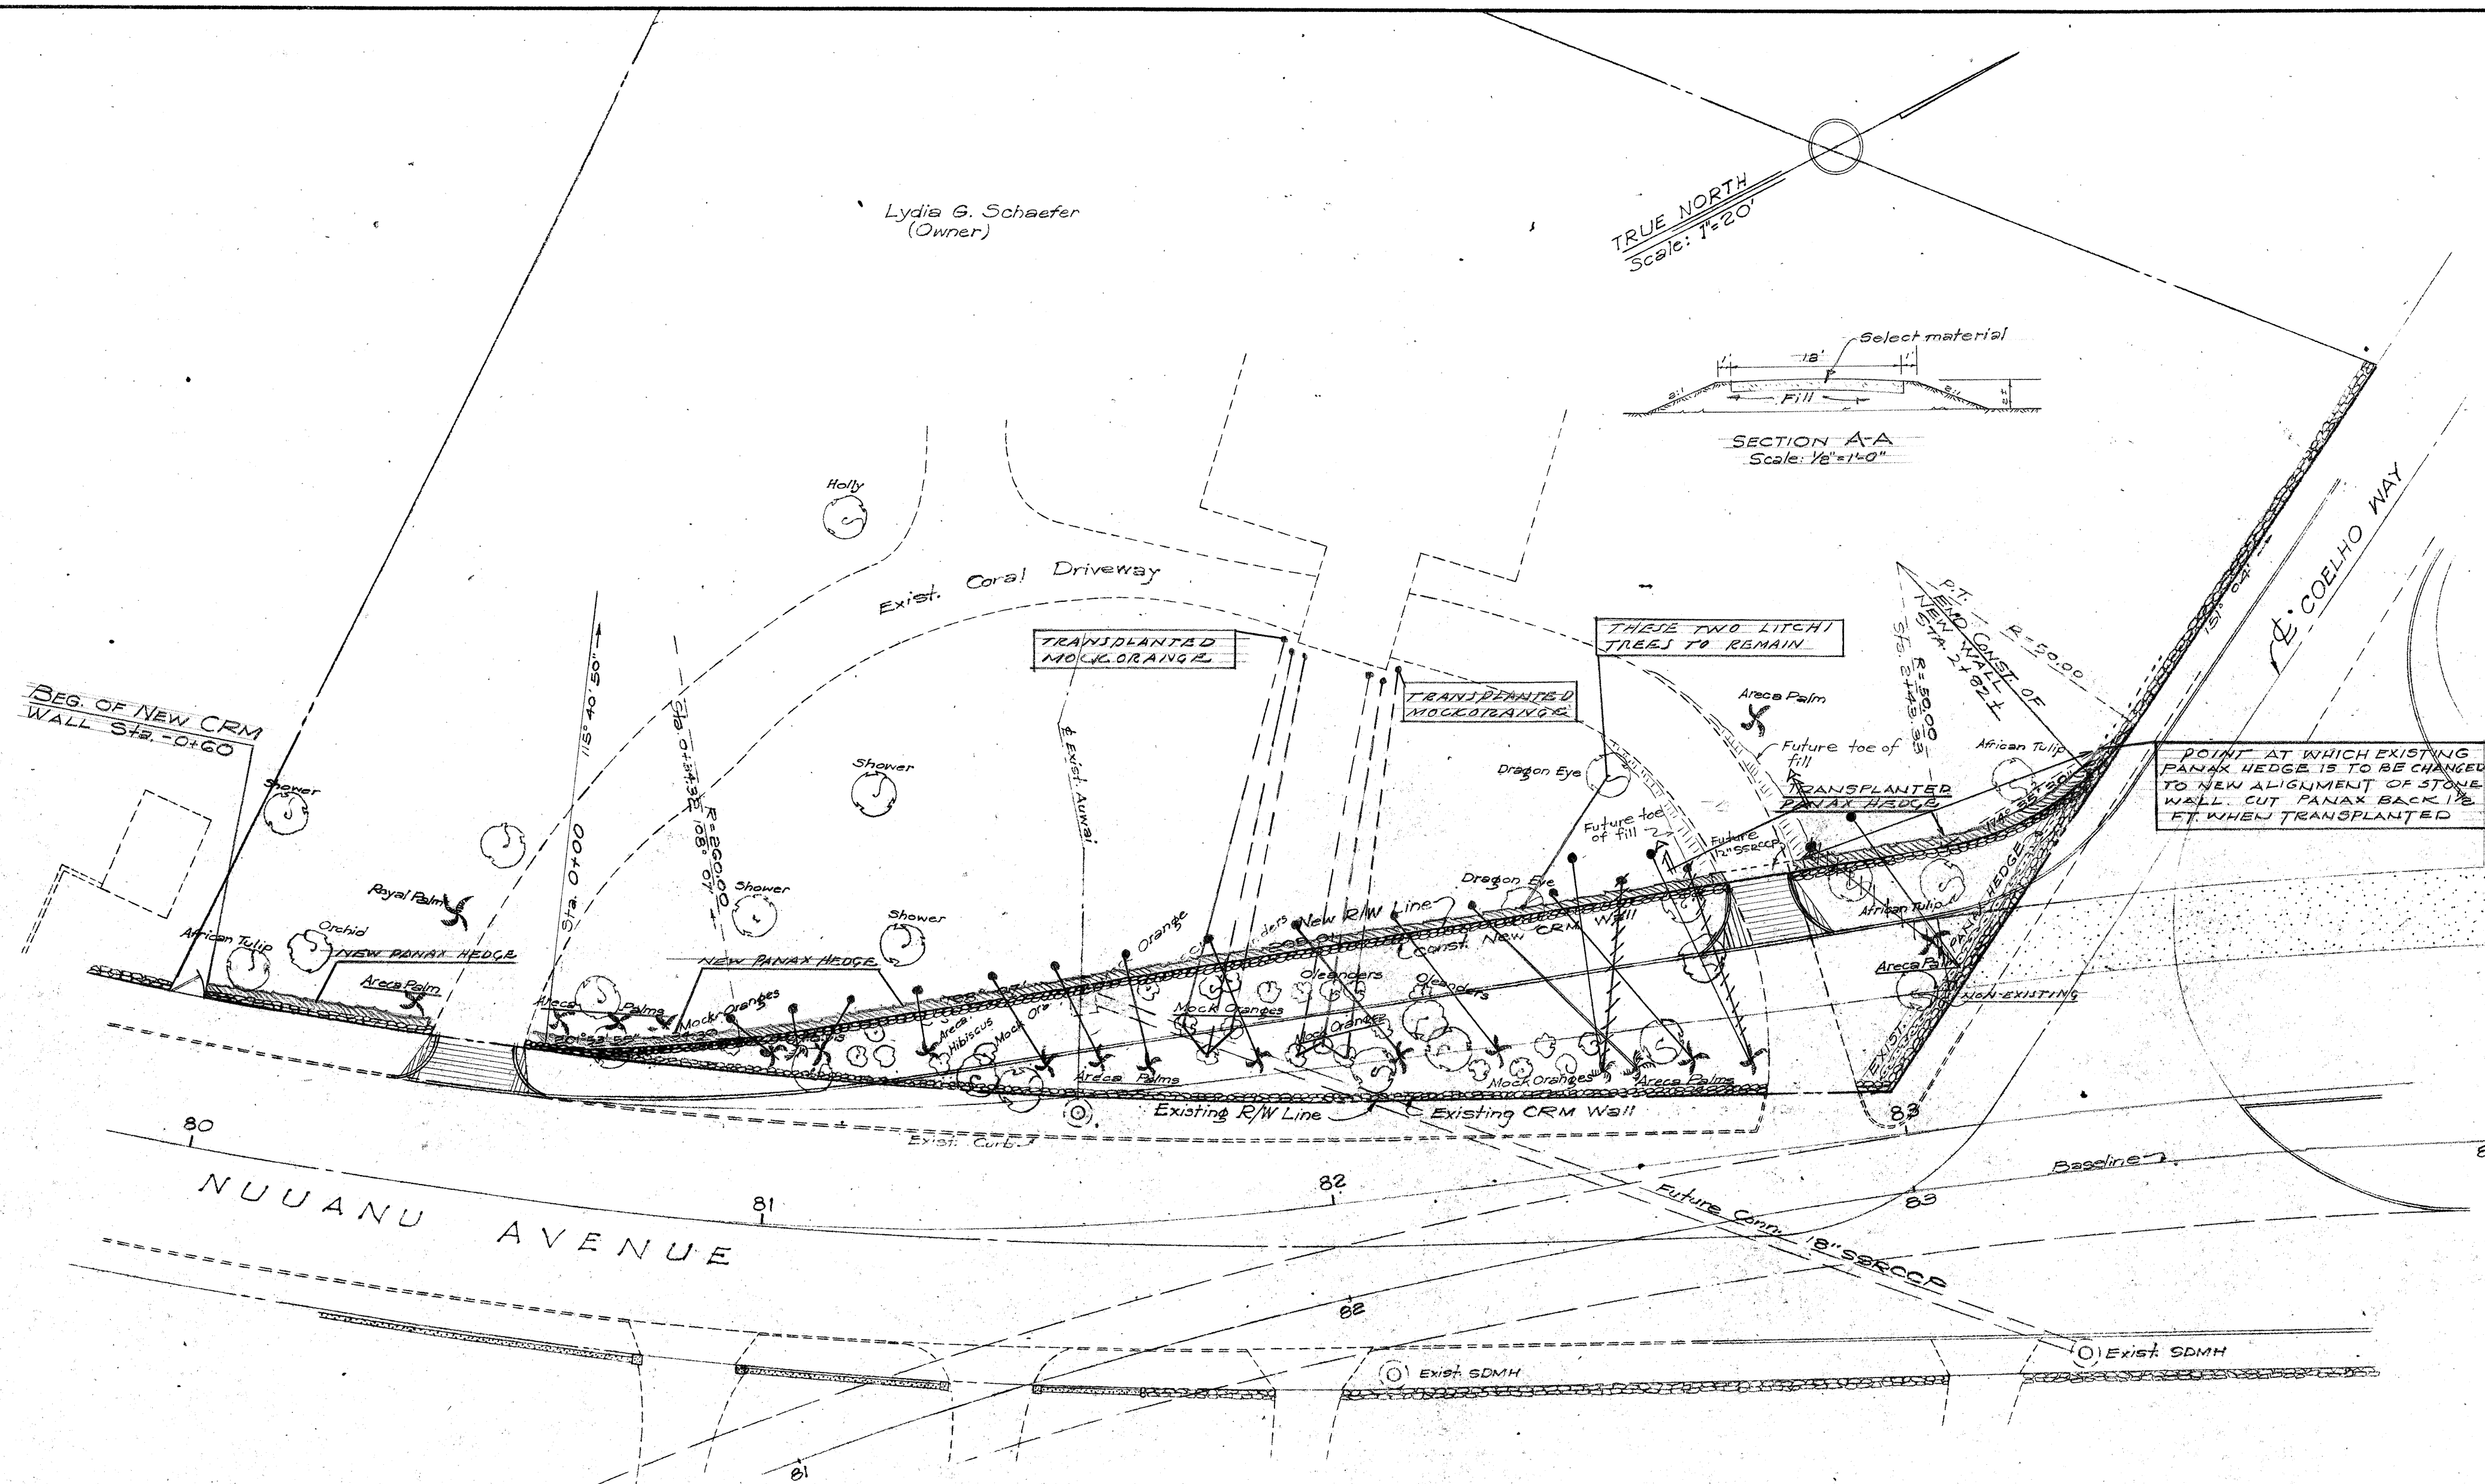

PROFILE OF NEW CRM WALL

Horiz. = 1"=20'
Vert. = 1"=5'

SCHEDULE FOR LANDSCAPE PLANTING

1. THE 15 ARECA PALMS (*CHRYSLIDOCARPUS LUTETENSIS*) TO BE TRANSPLANTED TO NEW LOCATIONS AS INDICATED ON PLAN. BALL AROUND EACH PLANT TO EXTEND 1 FT. OUT ALL AROUND FROM CLUSTER OF PLANT TRUNKS. DEPTH OF BALL TO BE 30 IN. BACK-FILL NEW HOLES WITH A MIXTURE OF 1 PART COW MANURE (WELL ROTTED) & 4 PARTS TOP SOIL.
2. THE 6 MOKORANGE PLANTS (*MURRAYA EXOTICA*) TO BE TRANSPLANTED TO THE NEW LOCATIONS INDICATED ON PLAN. BALL IN EACH CASE TO BE 2 FT. IN DIAMETER & 2 FT. DEEP. BACK-FILL NEW HOLES WITH MIXTURE OF 1 PART COW MANURE (WELL ROTTED) & 4 PARTS TOP SOIL.
3. AFTER NEW CRM WALL HAS BEEN CONSTRUCTED, A PANAX HEDGE (*NOTHOPANAX GUIL*) IS TO BE PLANTED. THREE FT. CUTTINGS PLANTED 1 FT. APART - IN DOUBLE ROW - WITH PLANTS STAGGERED - APPROX. 500 CUTTINGS. THE PANAX HEDGE ALONG THE OLD WALL SHALL BE TRANSPLANTED TO THE NEW LOCATION TO MATCH THE EXISTING HEDGE.
4. THE ARECA PALMS TO BE PLANTED 6 FT. INSIDE OF NEW CRM WALL.

LANDSCAPE PLAN

TERRITORIAL HIGHWAY DEPARTMENT
TERRITORY OF HAWAII

ADJUSTMENT OF IMPROVEMENT

LYDIA G. SCHAEFER'S PROPERTY

PROJ. U-06-1(4)

Tax Map Key: 1-8-06-10

Scale: 1"=20'

LANDSCAPE PLANTING PLAN

MANSFIELD P. CLAFLIN

LANDSCAPE ARCH. A.S.L.A.
HONOLULU

SHEET No. 1 OF 1 SHEETS

5891.29A

DATE
DRAWN BY
CHECKED BY
NOTE BOOK
No.