
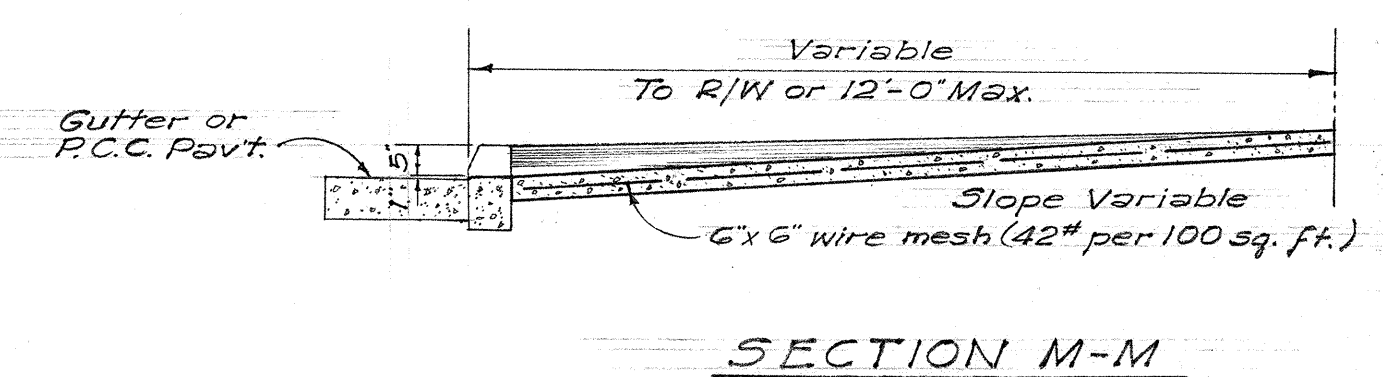
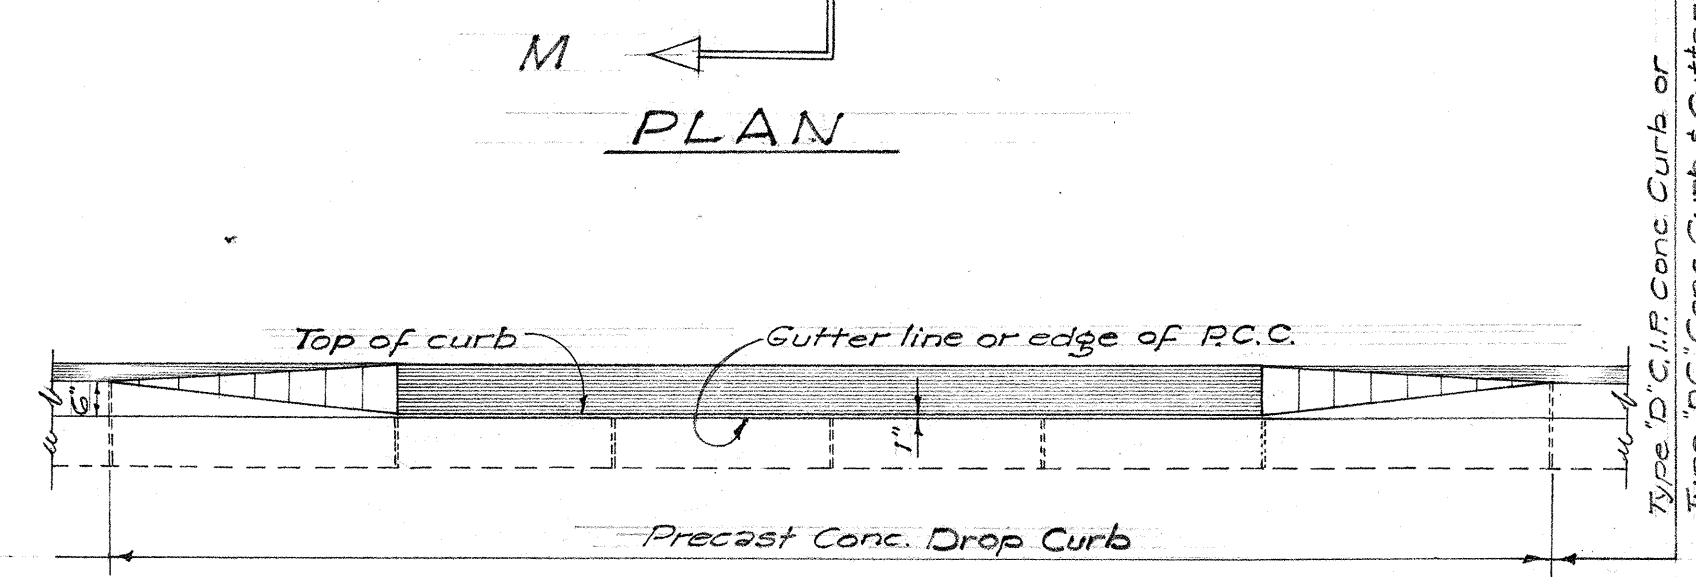






Revised 5/13/58

FED. ROAD DIST. NO.	STATE	FED. AID PROJ. NO.	FISCAL YEAR	SHEET NO.	TOTAL SHEETS
HAWAII	HAW.	U-061-1(4)	1957	8	41

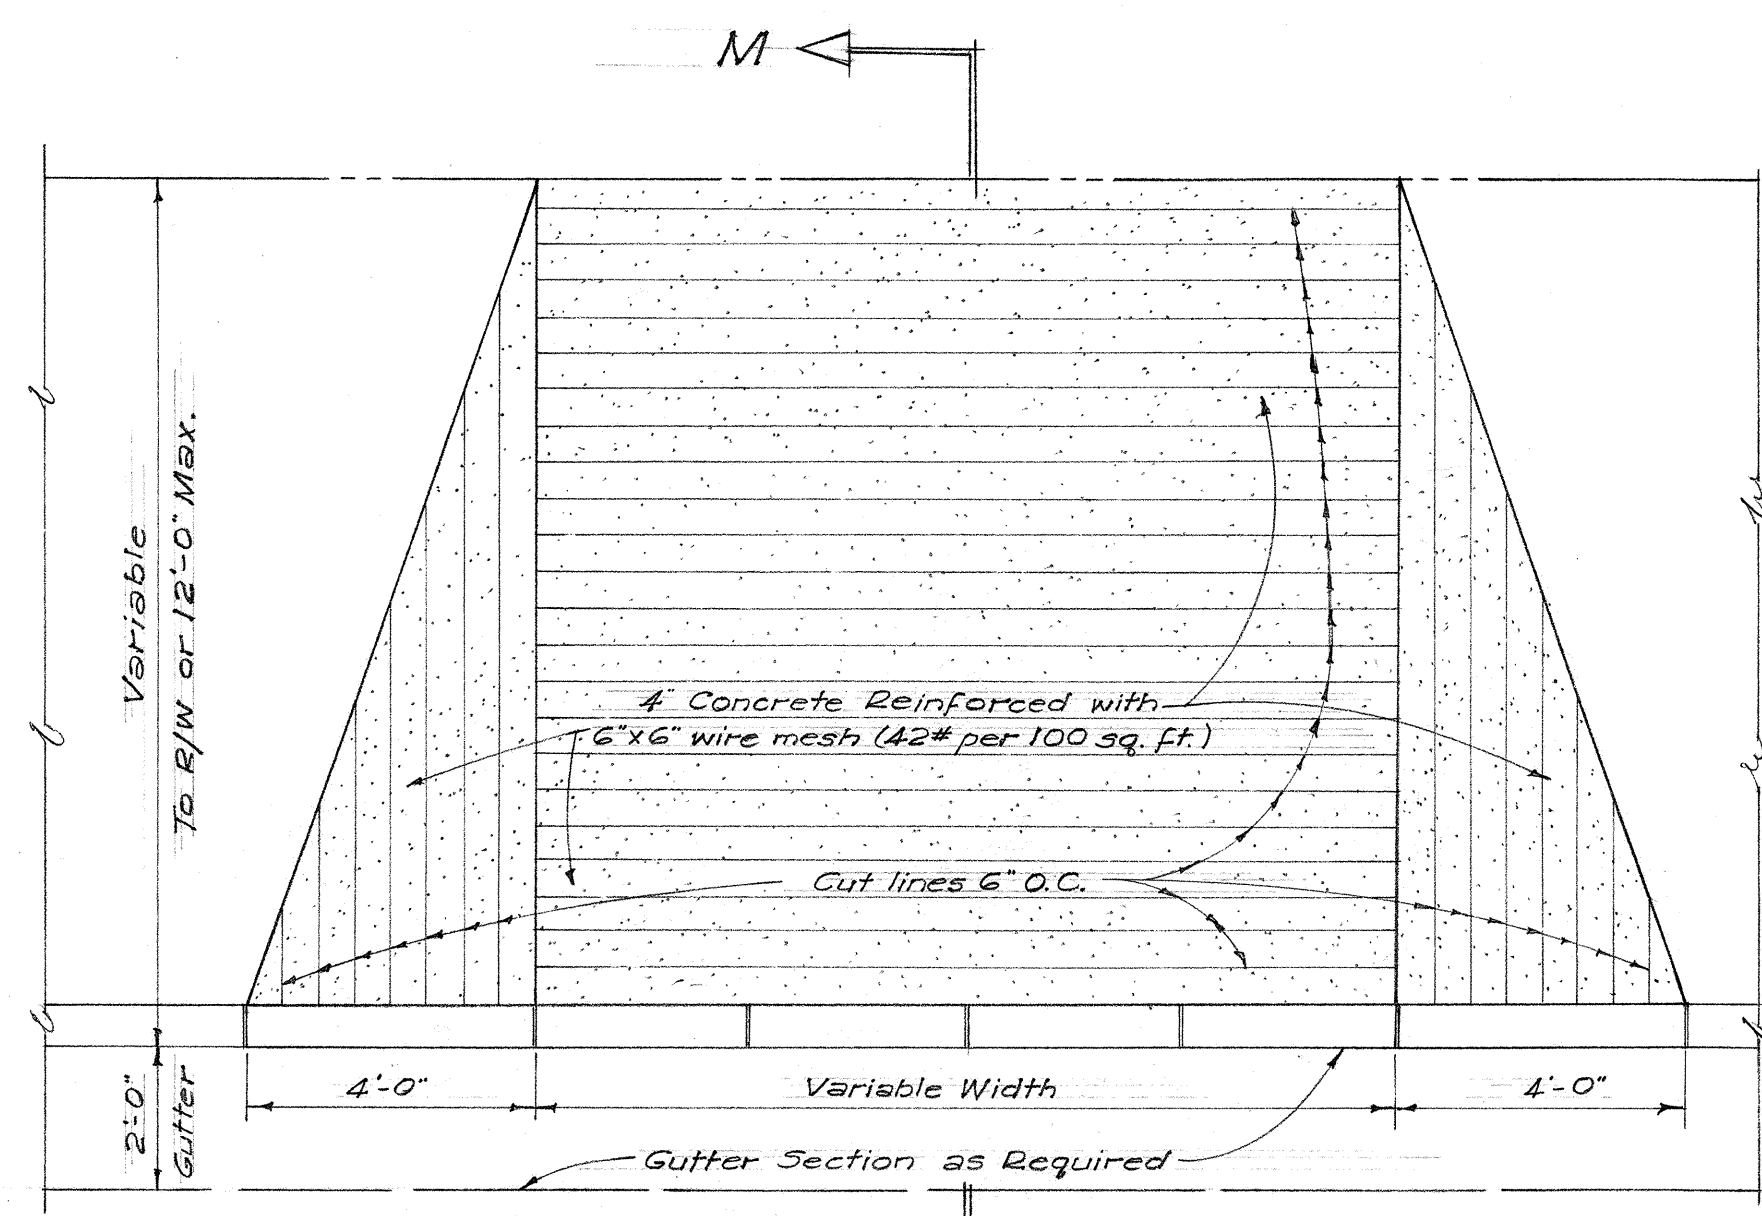




DETAIL OF REINF. CONCRETE DRIVEWAYS
Scale: 3/8" = 1'-0"

NOTE: Precast conc. curb and gutter through drop driveways shall be paid as Type "D" cast-in place conc. curb or Type "DG" cast-in place conc. curb and gutter.

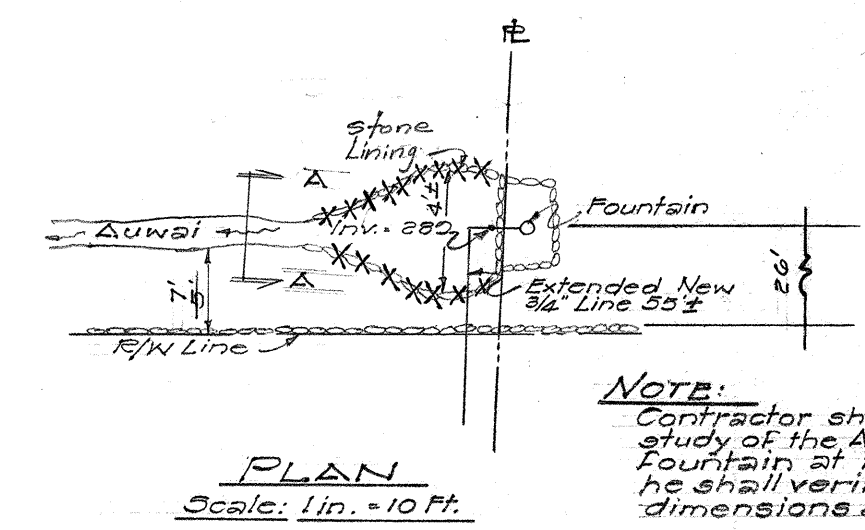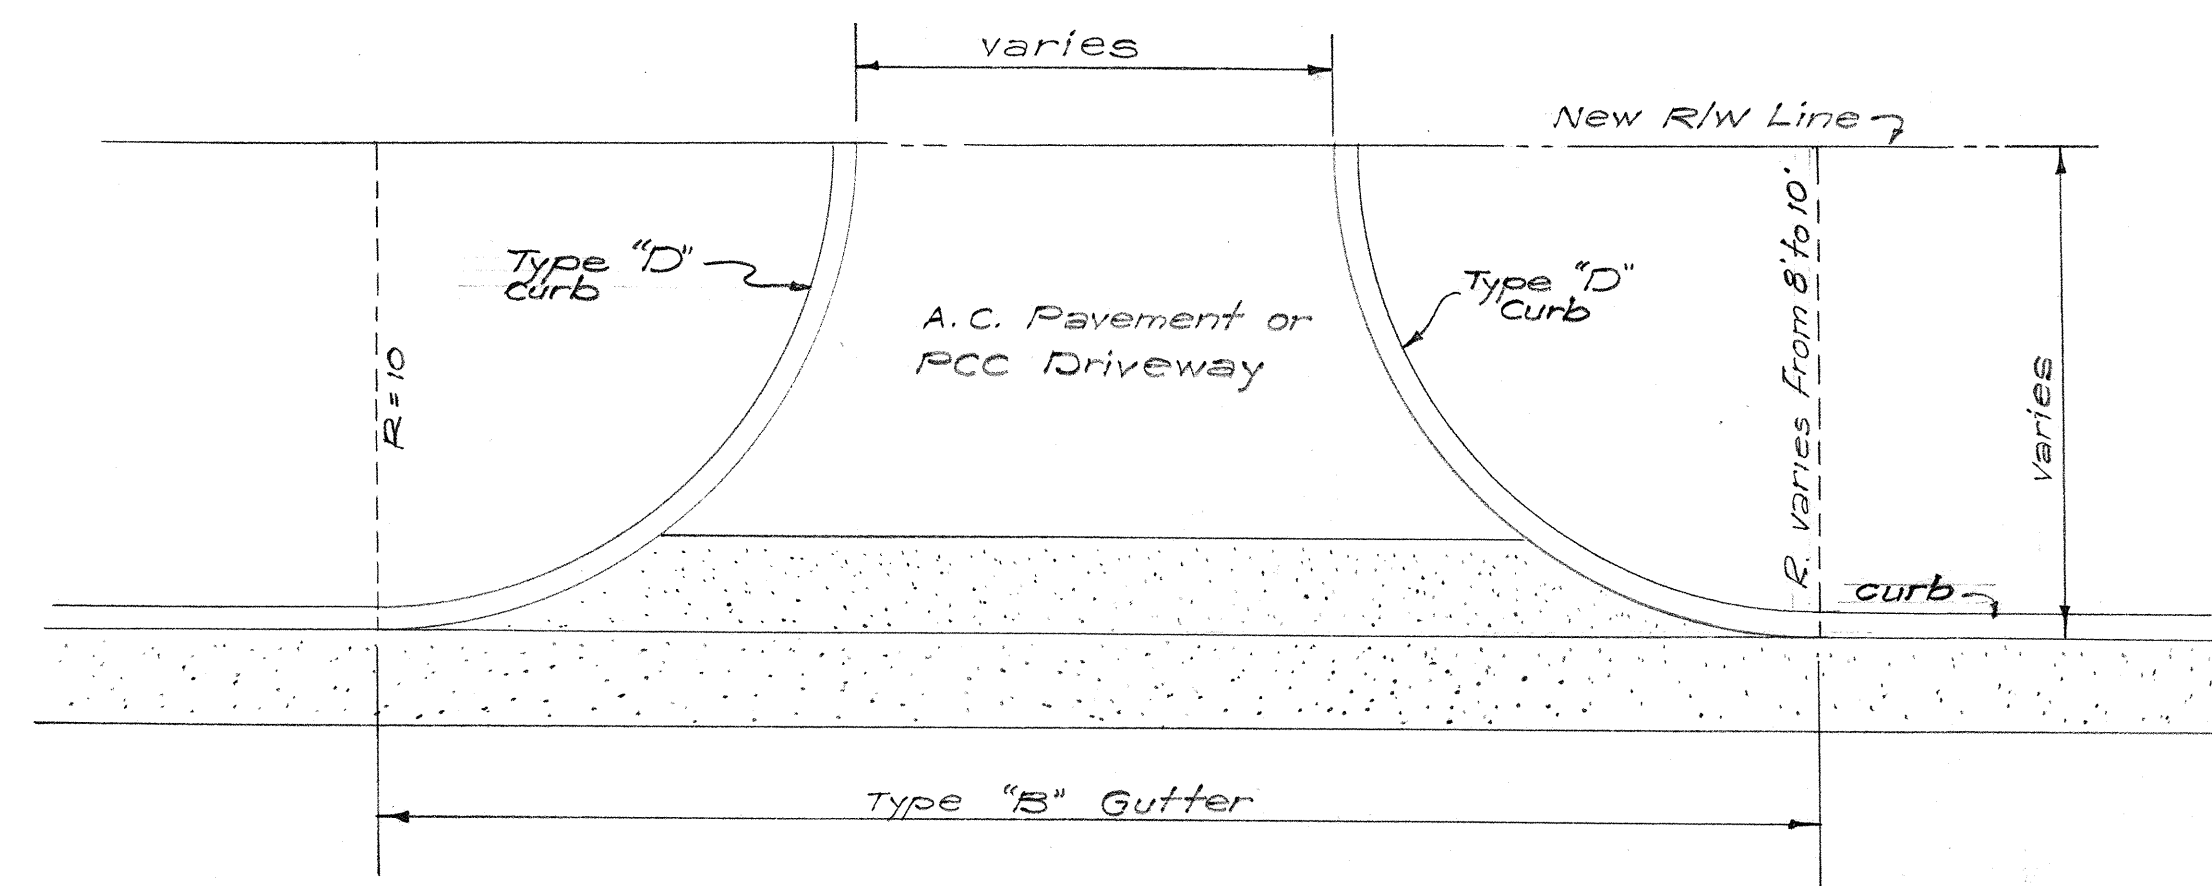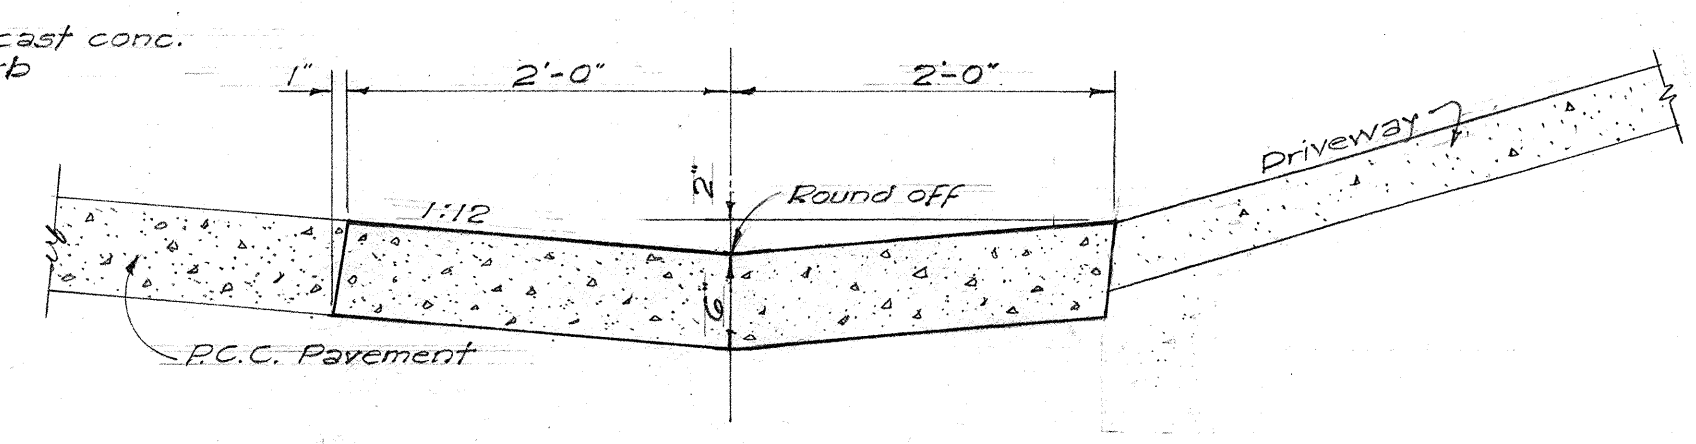
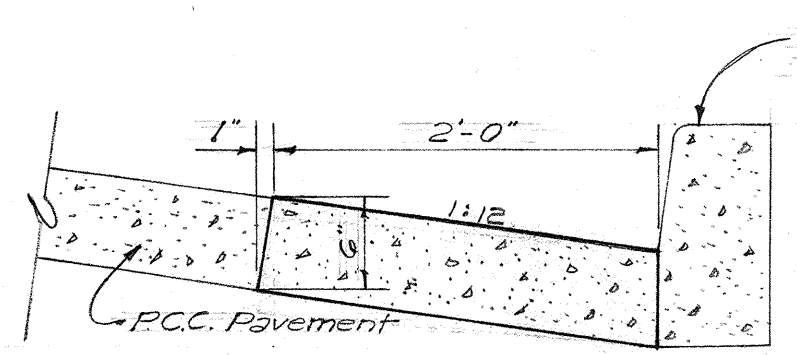


SECTION A-A
Scale: 3/8" = 1'-0"

DETAIL OF AUWAI AND FOUNTAIN
Scale: As Shown

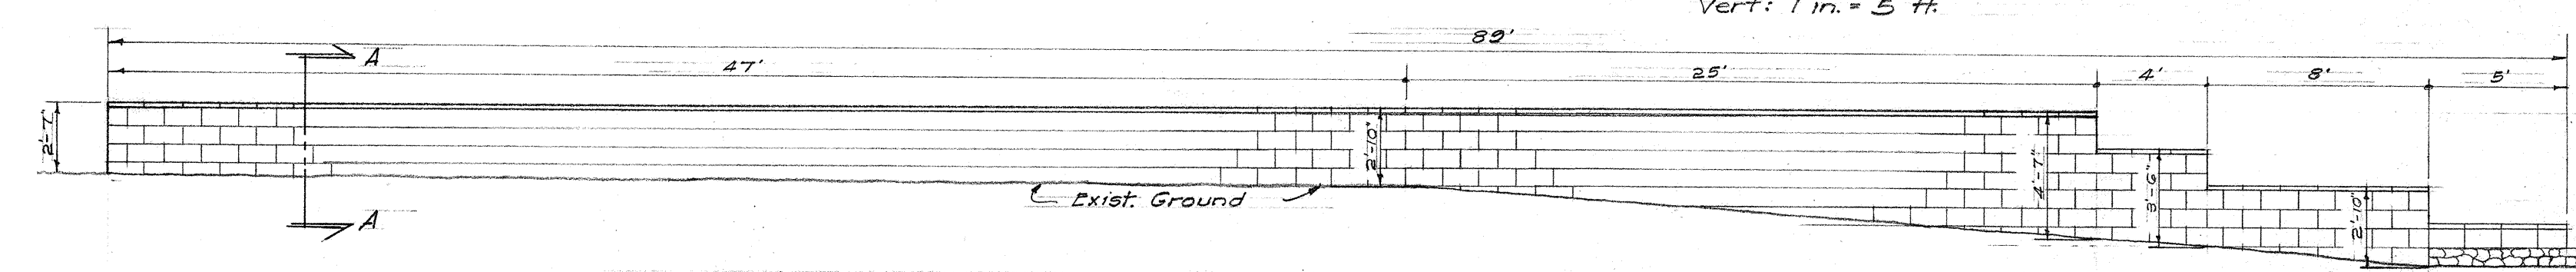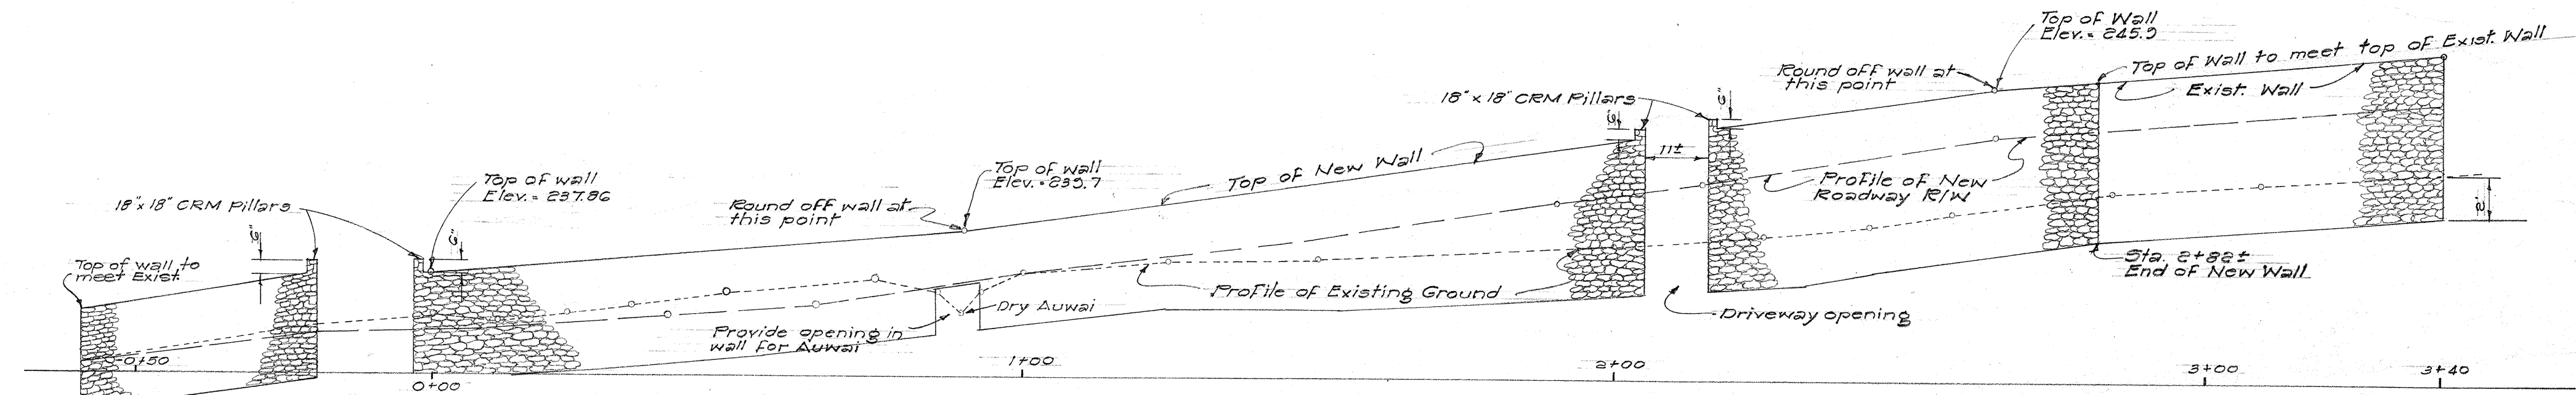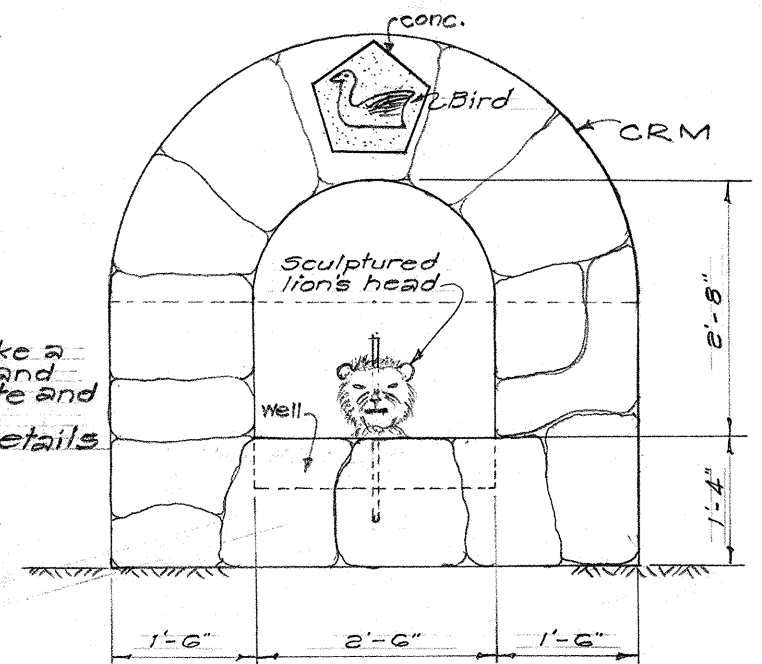

DETAIL OF HOLLOW TILE WALL
AT AKAMU PLACE
Scale: As Shown

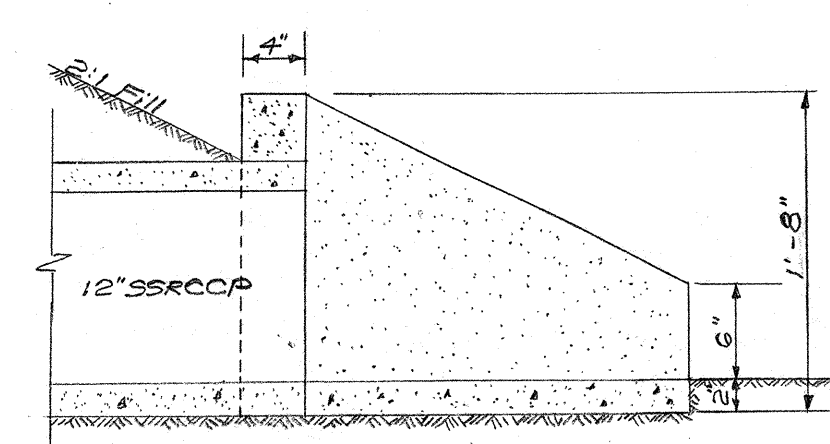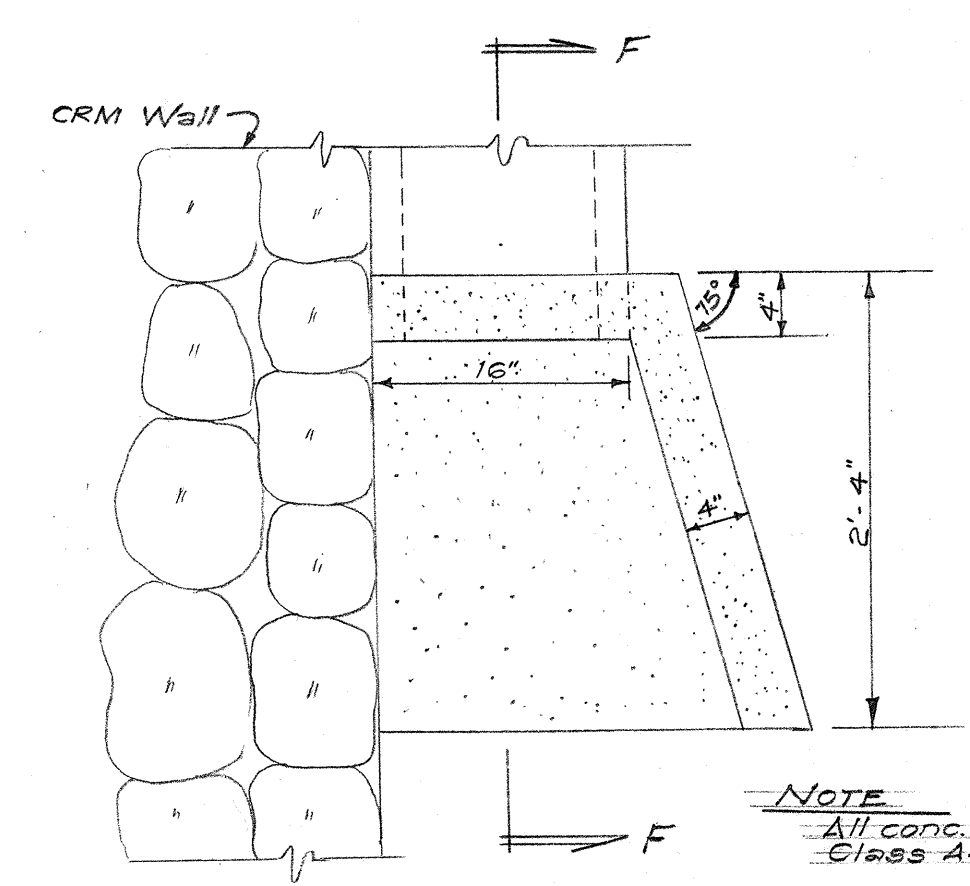

NOTE: All conc. shall be Class A-1

DETAIL OF HEADWALL AT SHAEFER'S PROP
Scale: 1" = 1'-0"

TERRITORIAL HIGHWAY DEPARTMENT
TERRITORY OF HAWAII
MISCELLANEOUS DETAILS
NUUANU AVENUE
PROJECT NO: U-061-1(4)
Scale: As noted