


FED. ROAD DIST. NO.	STATE	FED. AID PROJ. NO.	FISCAL YEAR	SHEET NO.	TOTAL SHEETS
HAWAII	HAWAII	U-061-1(4)	1957	9	41

Jan. 27, 1958
Jan. 31, 1958

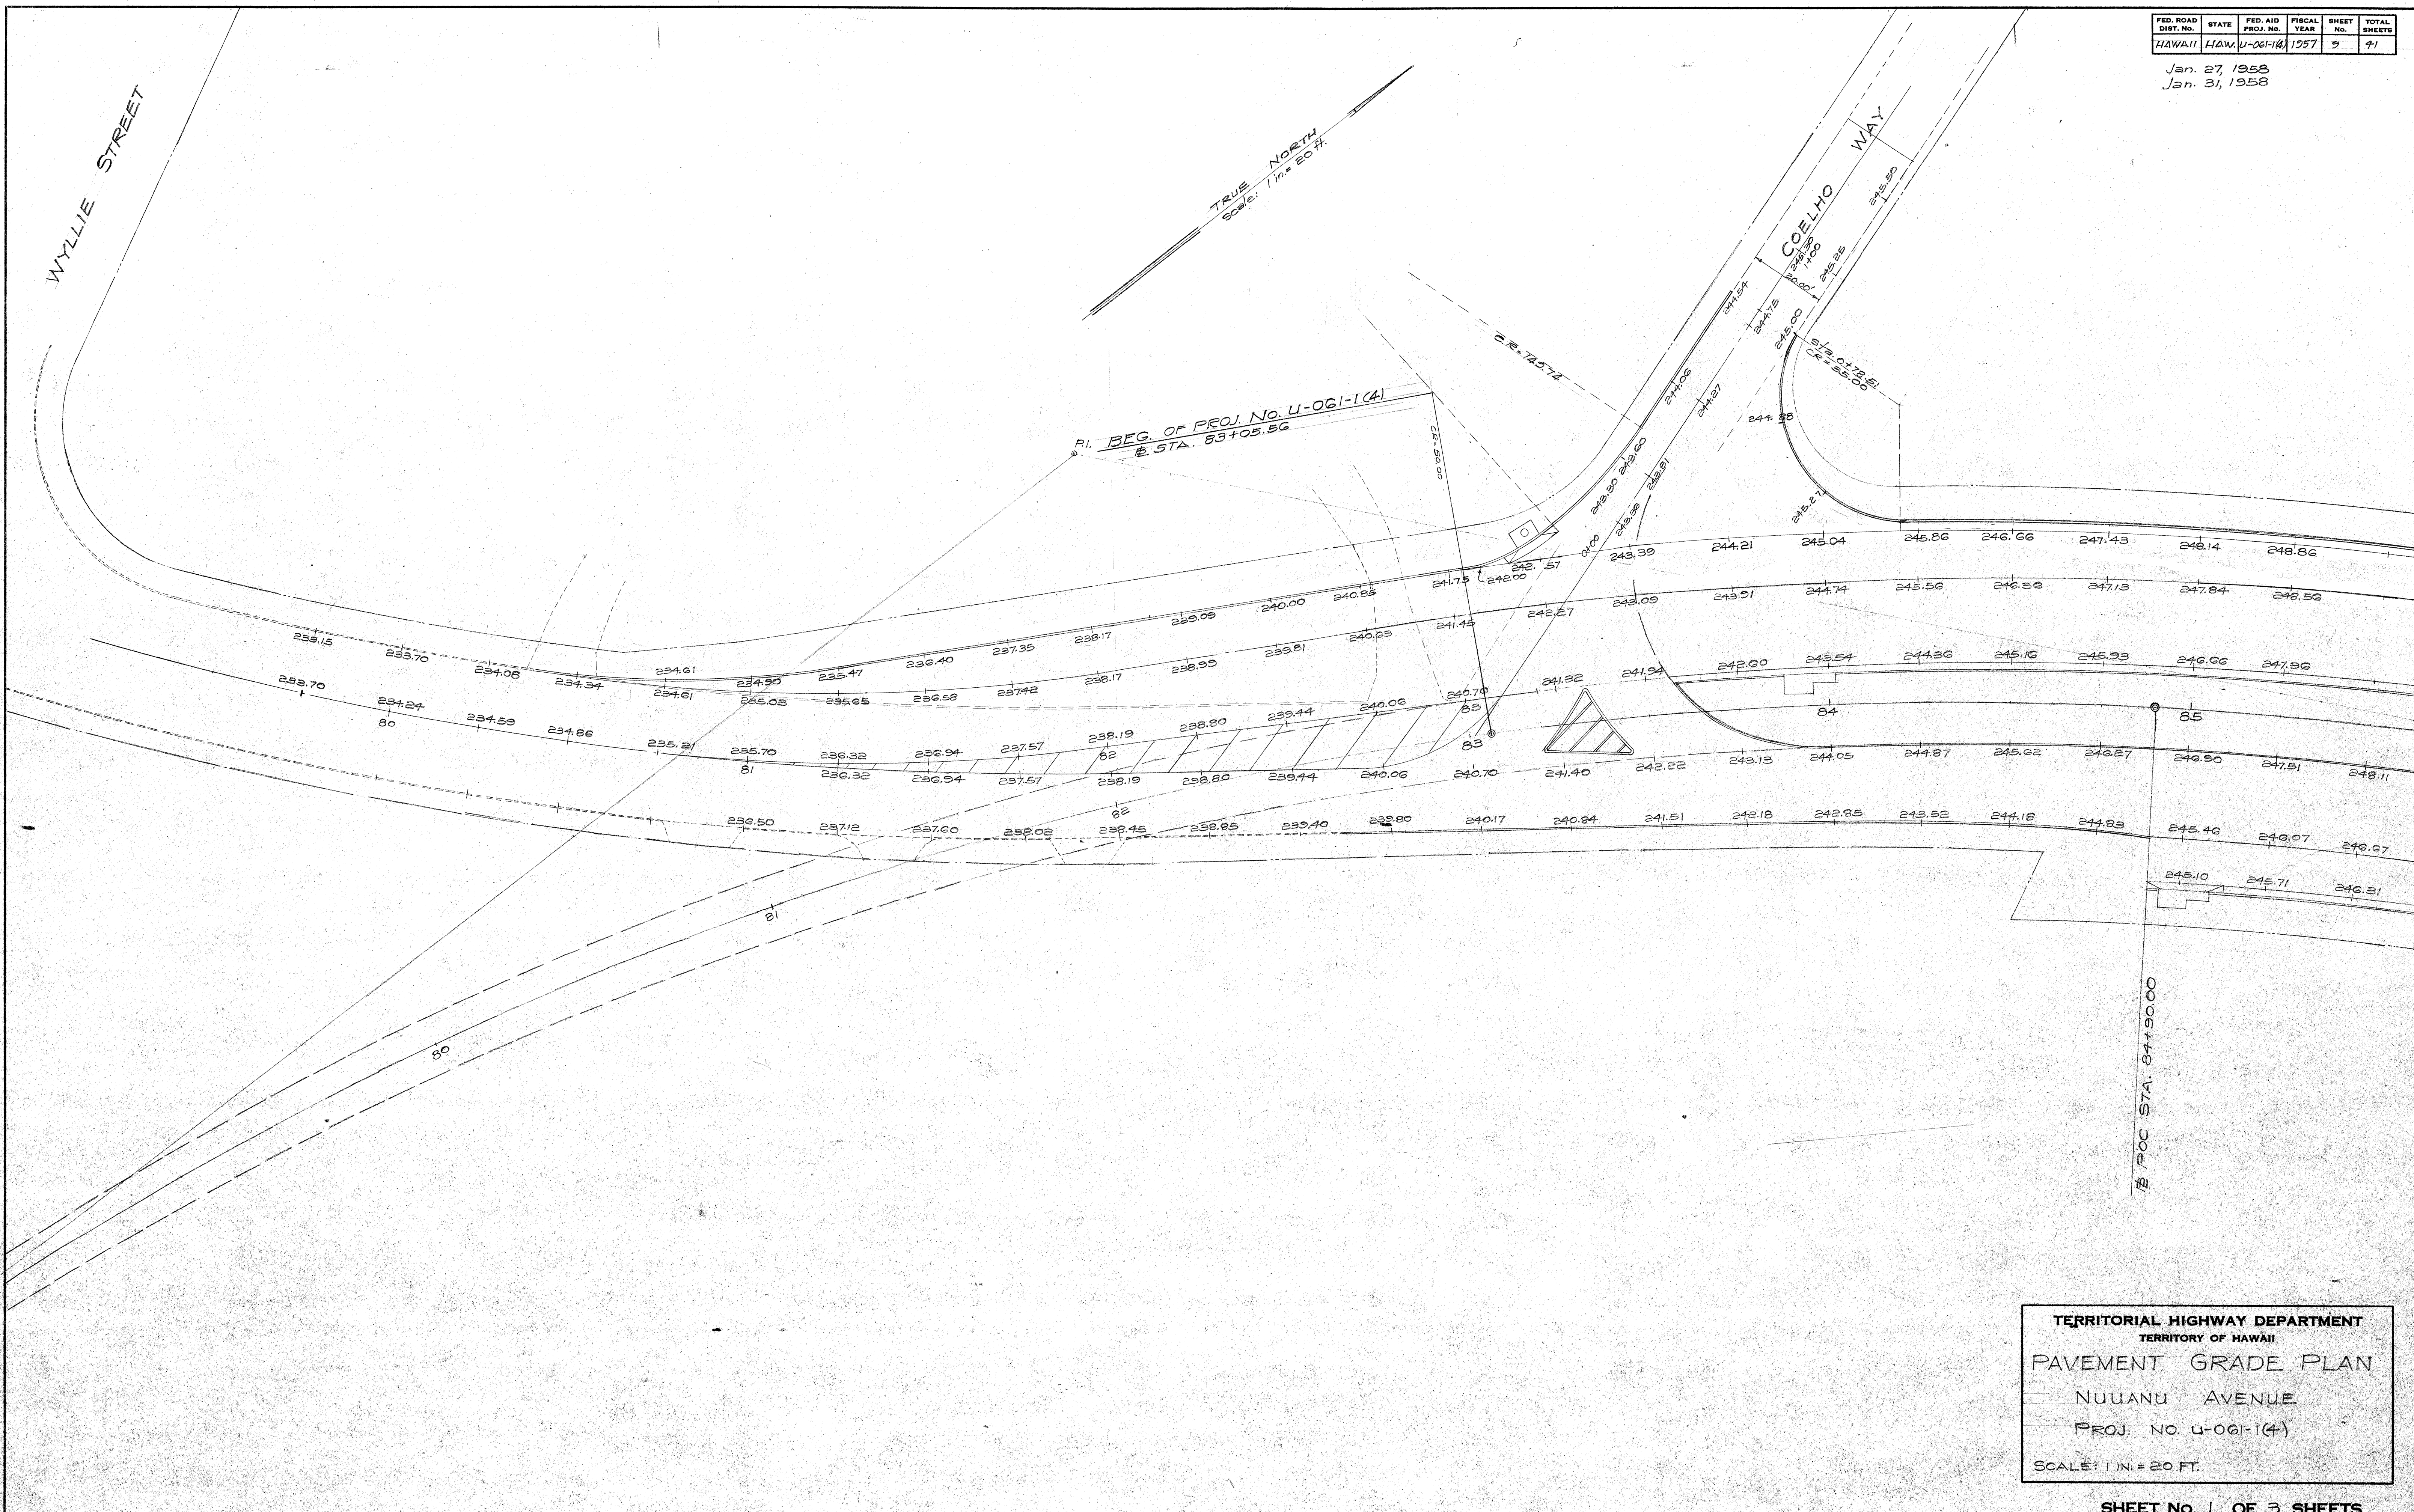

ORIGINAL PLAN	DATE
SURVEY PLOTTED BY	
DRAWN BY	
TRACED BY	
CHECKED BY	
NOTE BOOK NO.	

TERRITORIAL HIGHWAY DEPARTMENT
TERRITORY OF HAWAII
PAVEMENT GRADE PLAN
NUUANU AVENUE
PROJ. NO. U-061-1(4)
SCALE: 1 IN. = 20 FT.

Jan. 27, 1958
Jan. 31, 1958


FED. ROAD DIST. NO.	STATE	FED. AID PROJ. NO.	FISCAL YEAR	SHEET NO.	TOTAL SHEETS
HAW.	HAWAII	U-061-1(4)	1957	10	41

NOTE: For Access Streets Grades See Sheet 5891.12

True North
Scale: 1" = 20'

NIOLOPA PL

INB. EPL STA. 86+38.08
R = 1000.00

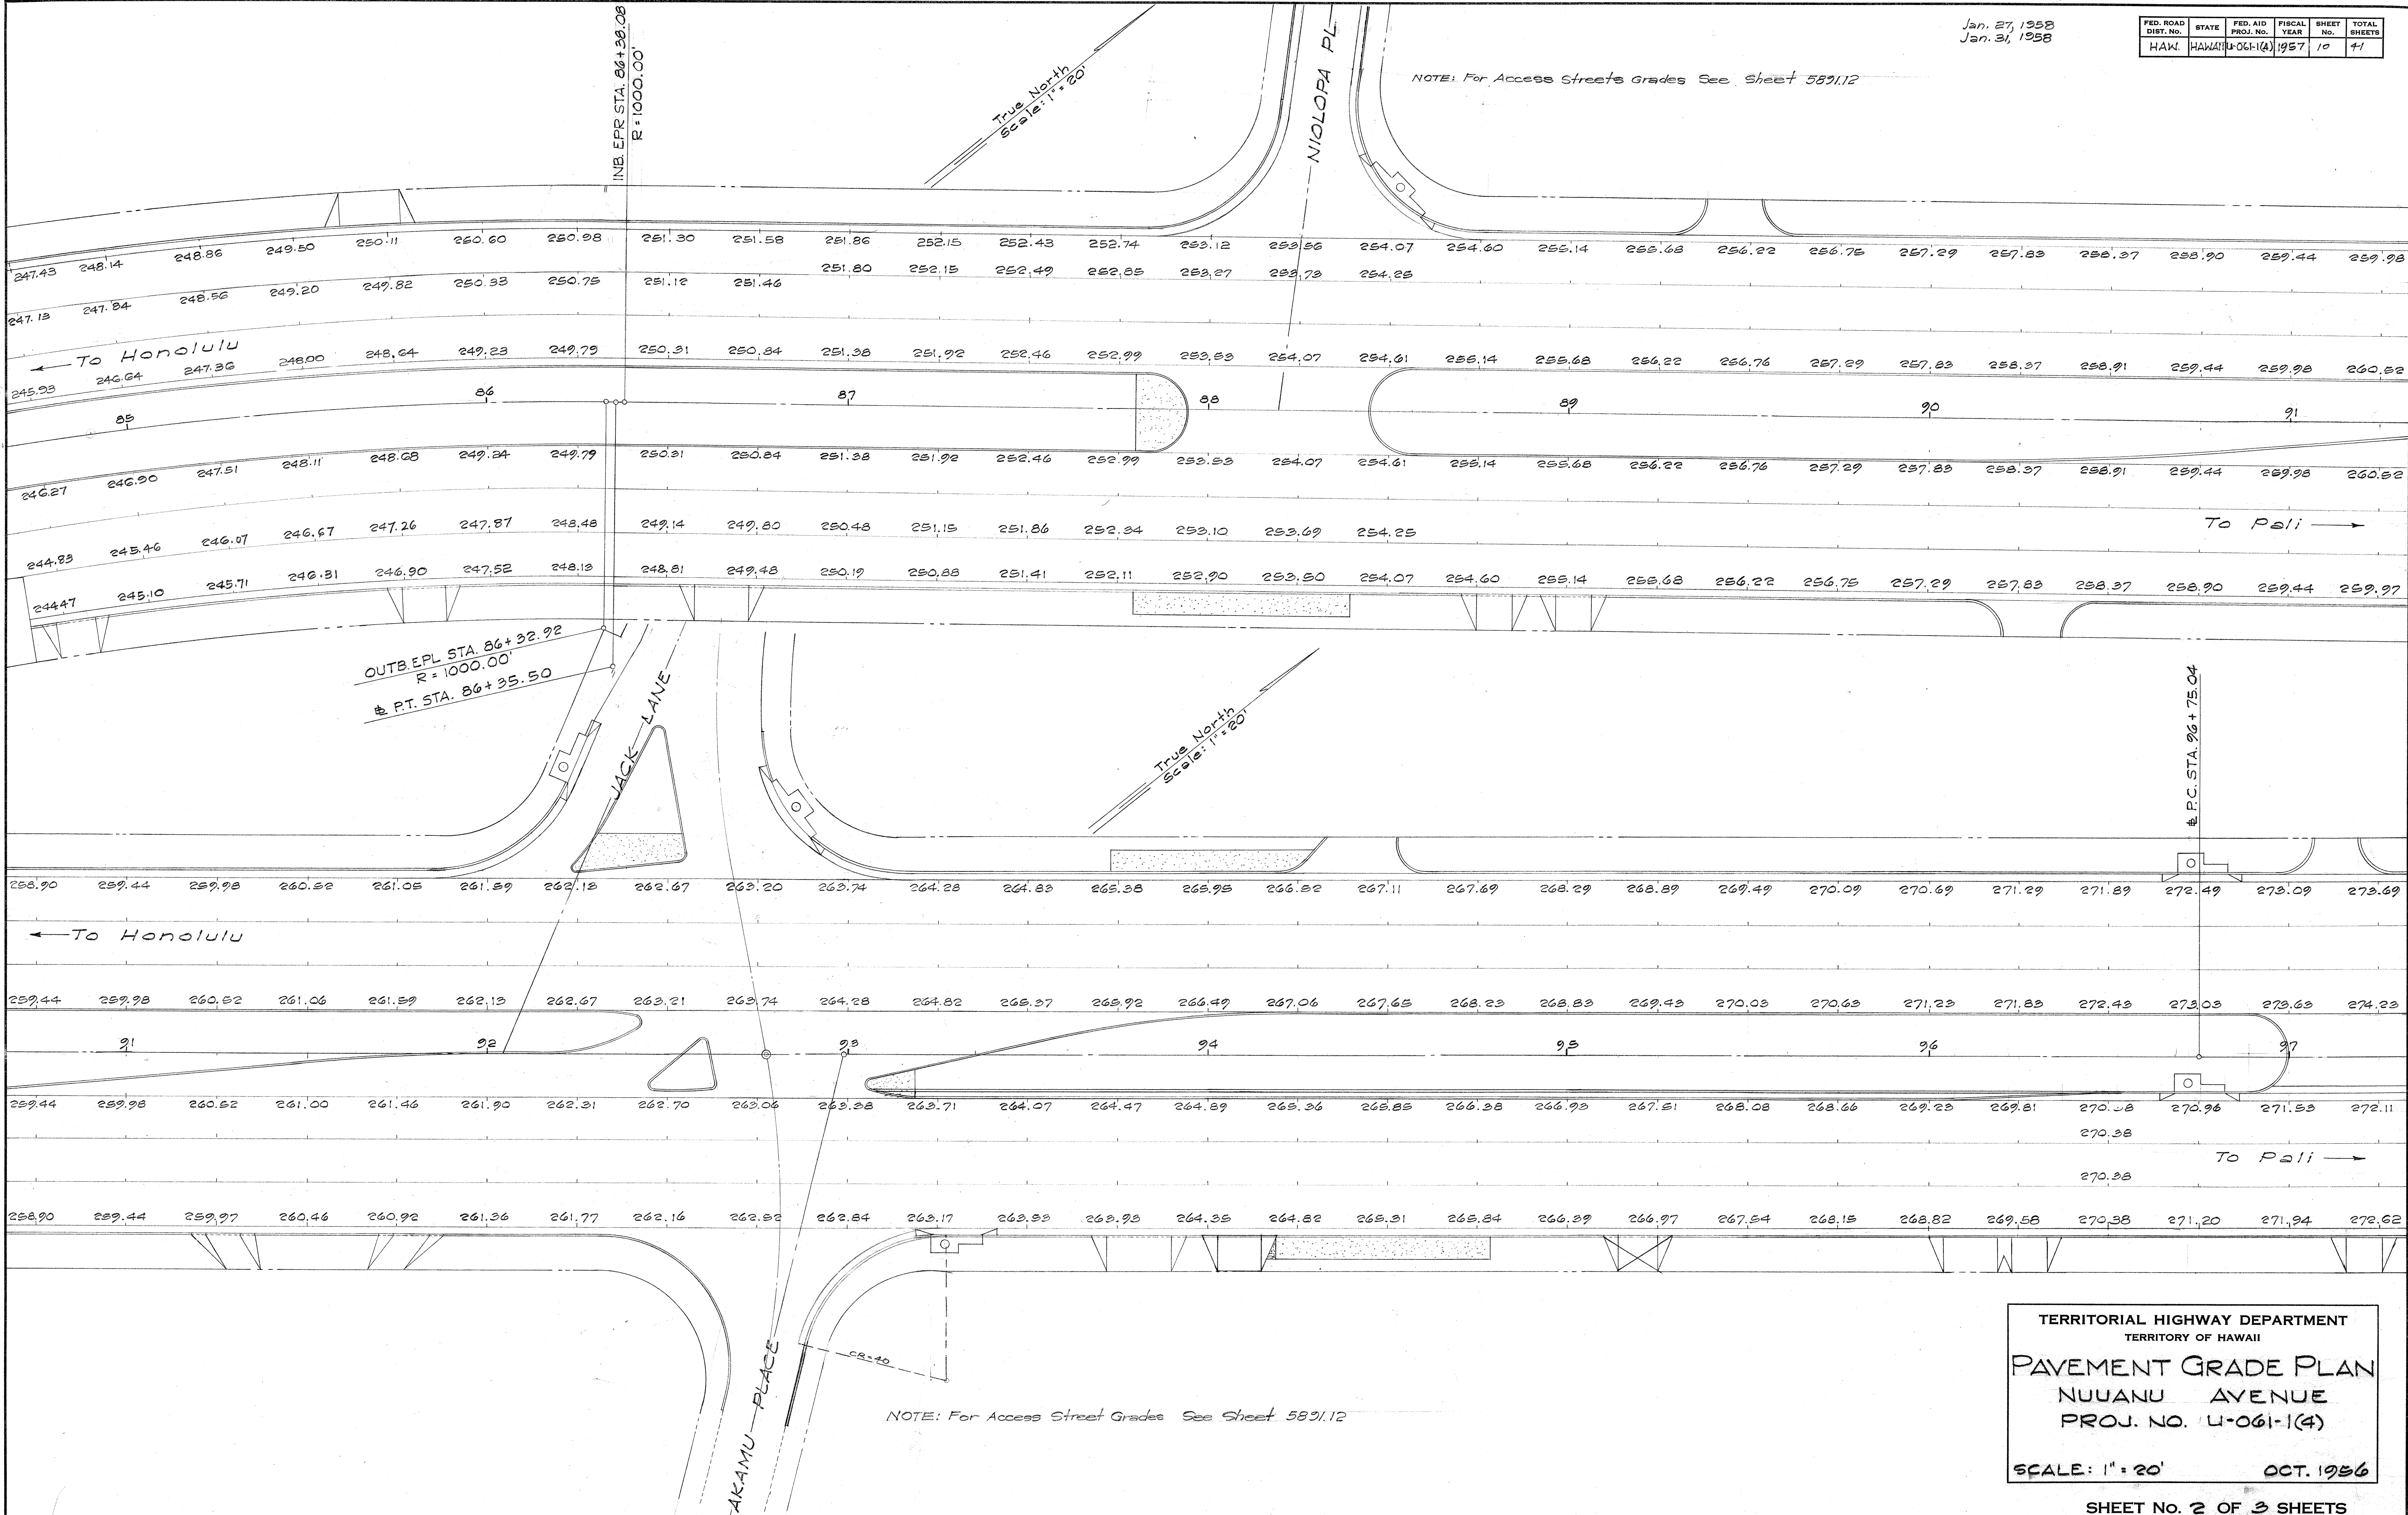

OUTB. EPL STA. 86+32.92
R = 1000.00
P.T. STA. 86+35.50

True North
Scale: 1" = 20'

P.C. STA. 96+75.04

NOTE: For Access Street Grades See Sheet 5891.12

ORIGINAL PLAN	DATE
DESIGNED BY	
DRAWN BY	
CHECKED BY	
NOTES BY	
QUANTITIES BY	
CHECKED BY	
NO.	


TERRITORIAL HIGHWAY DEPARTMENT
TERRITORY OF HAWAII
PAVEMENT GRADE PLAN
NUUANU AVENUE
PROJ. NO. U-061-1(4)
SCALE: 1" = 20' OCT. 1956

SHEET No. 2 OF 3 SHEETS

5891.10

Jan. 27, 1958
Jan. 31, 1958



FED. ROAD DIST. NO.	STATE	FED. AID PROJ. NO.	FISCAL YEAR	SHEET NO.	TOTAL SHEETS
HAW.	HAWAII	U-061-1(4)	1957	11	41

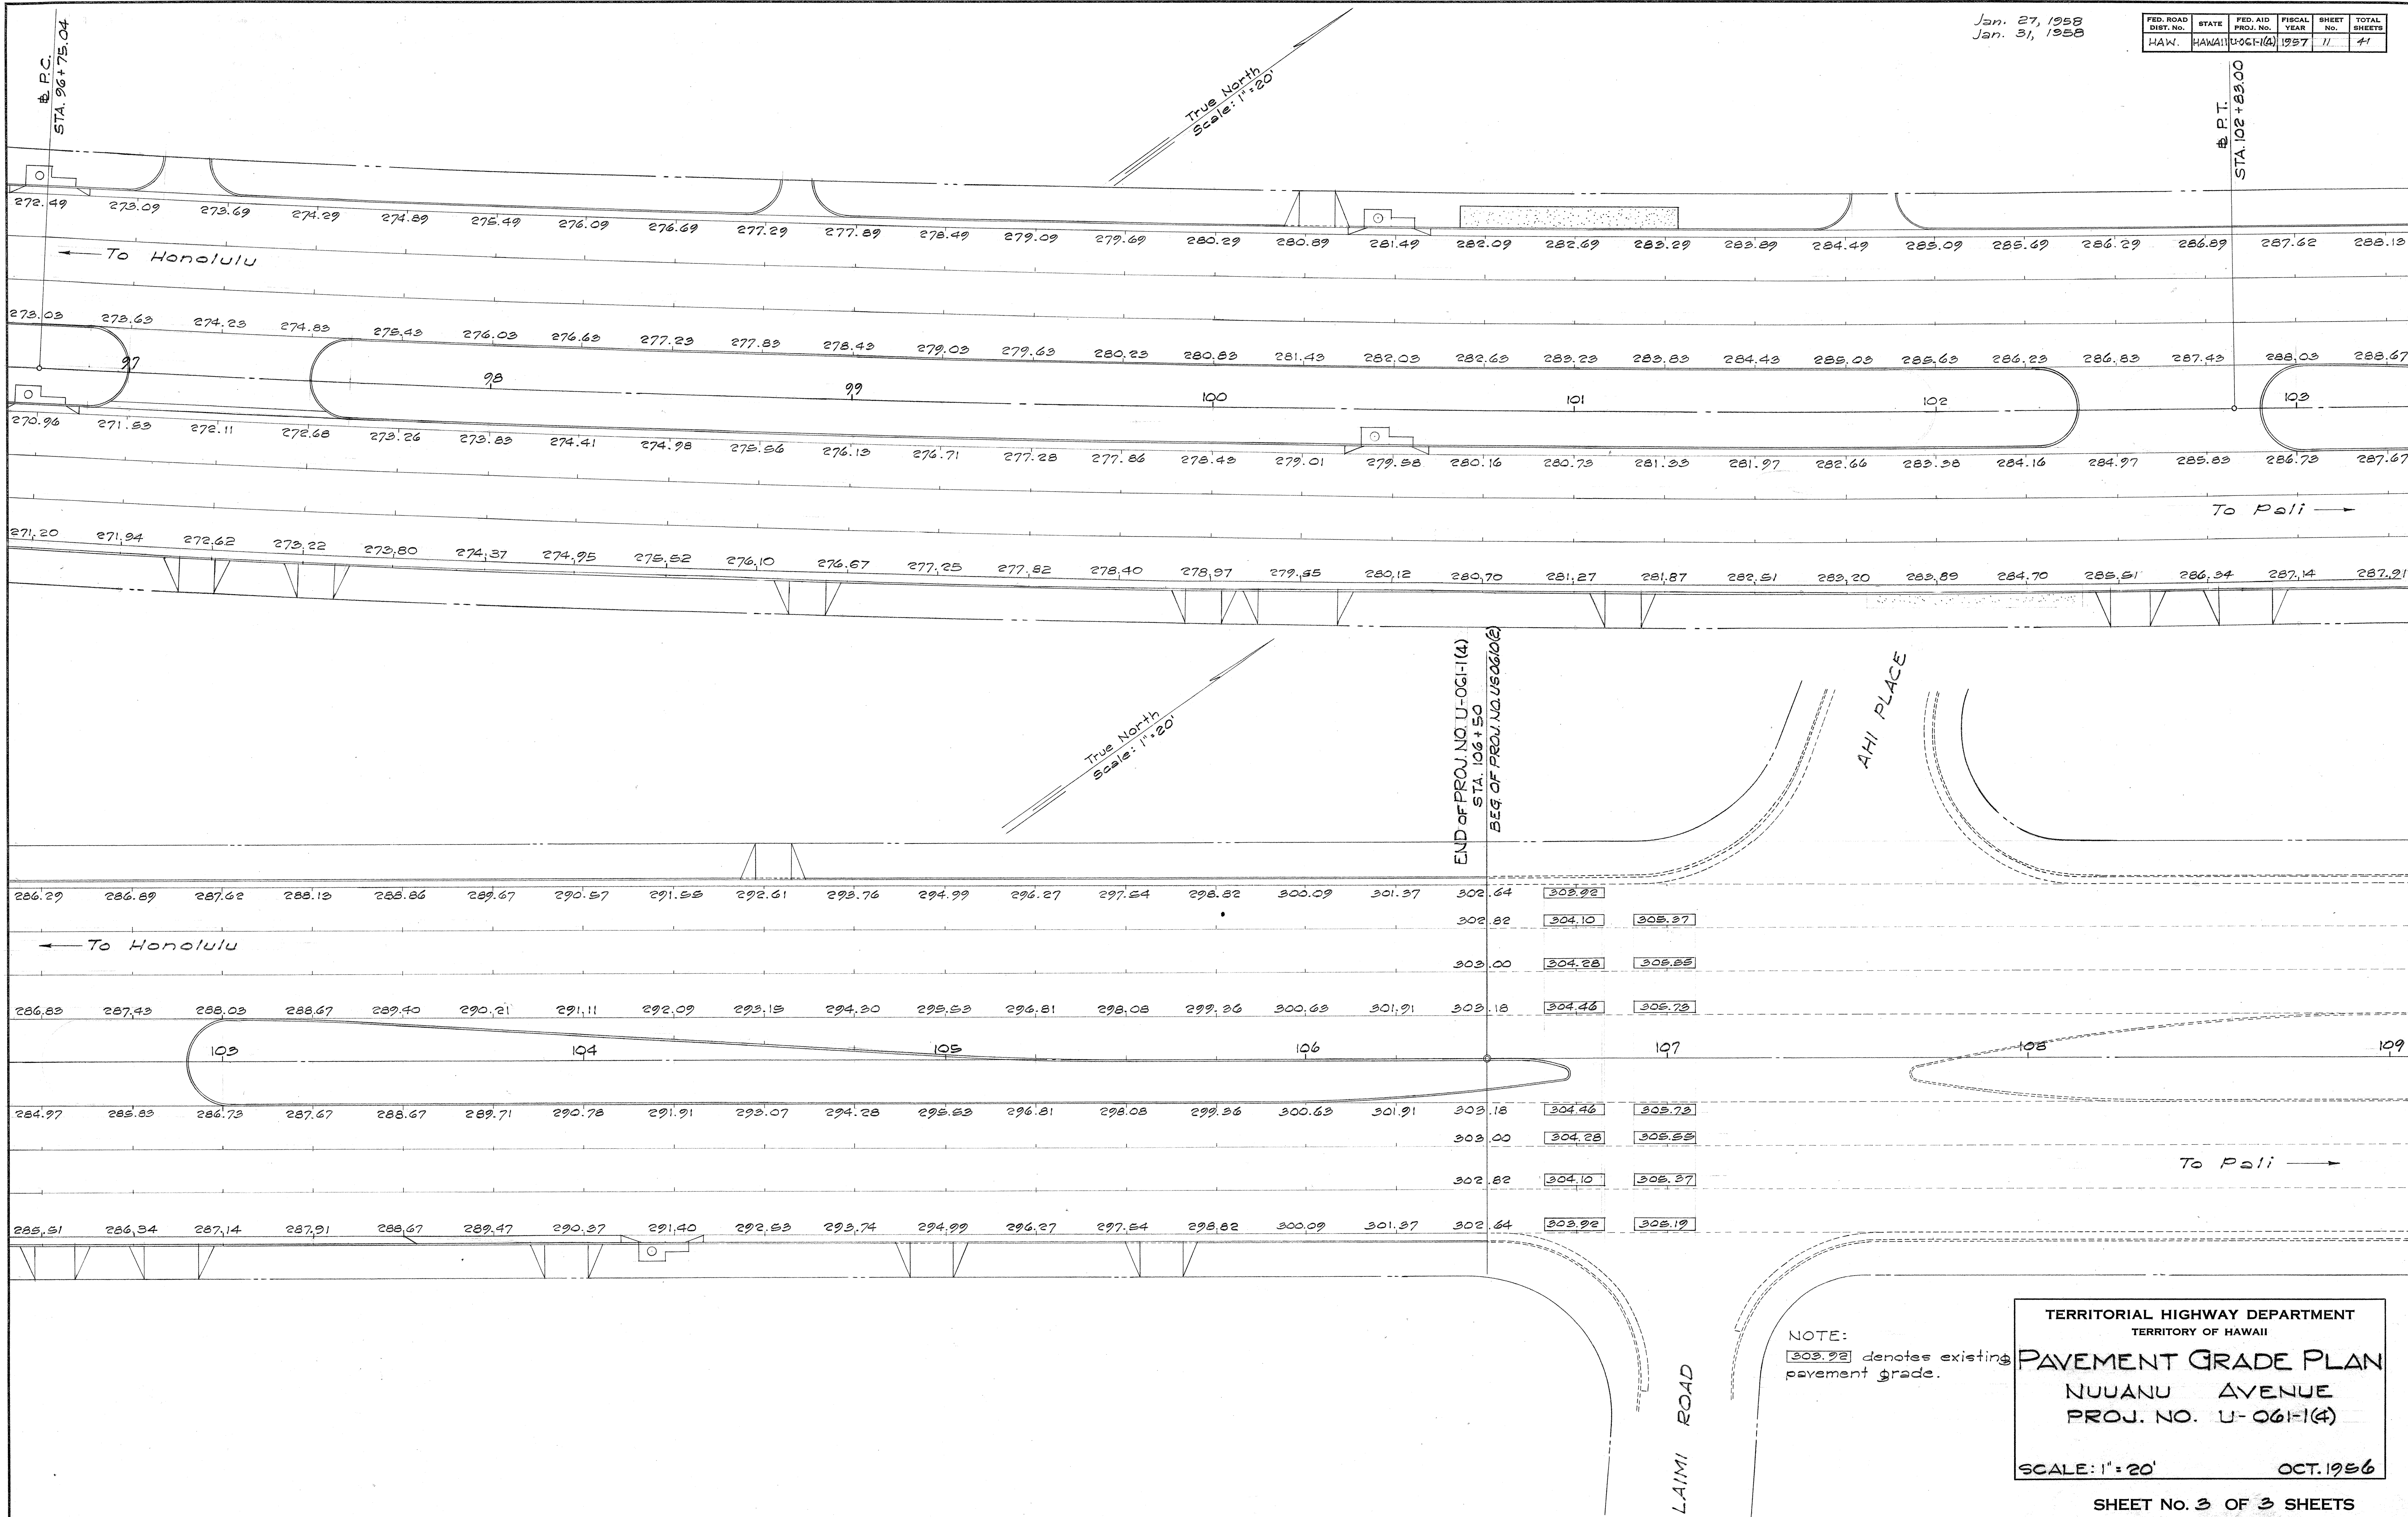

SURVEY PLOTTED BY	DATE
ORIGINAL PLAN	NO.
TRACED BY	
QUANTITIES CHECKED BY	
CHECKED BY	

Jan. 27, 1958
Jan. 31, 1958

FED. ROAD DIST. NO.	STATE	FED. AID PROJ. NO.	FISCAL YEAR	SHEET NO.	TOTAL SHEETS
HAWAII	HAW.	4-061-1(4)	1957	12	41

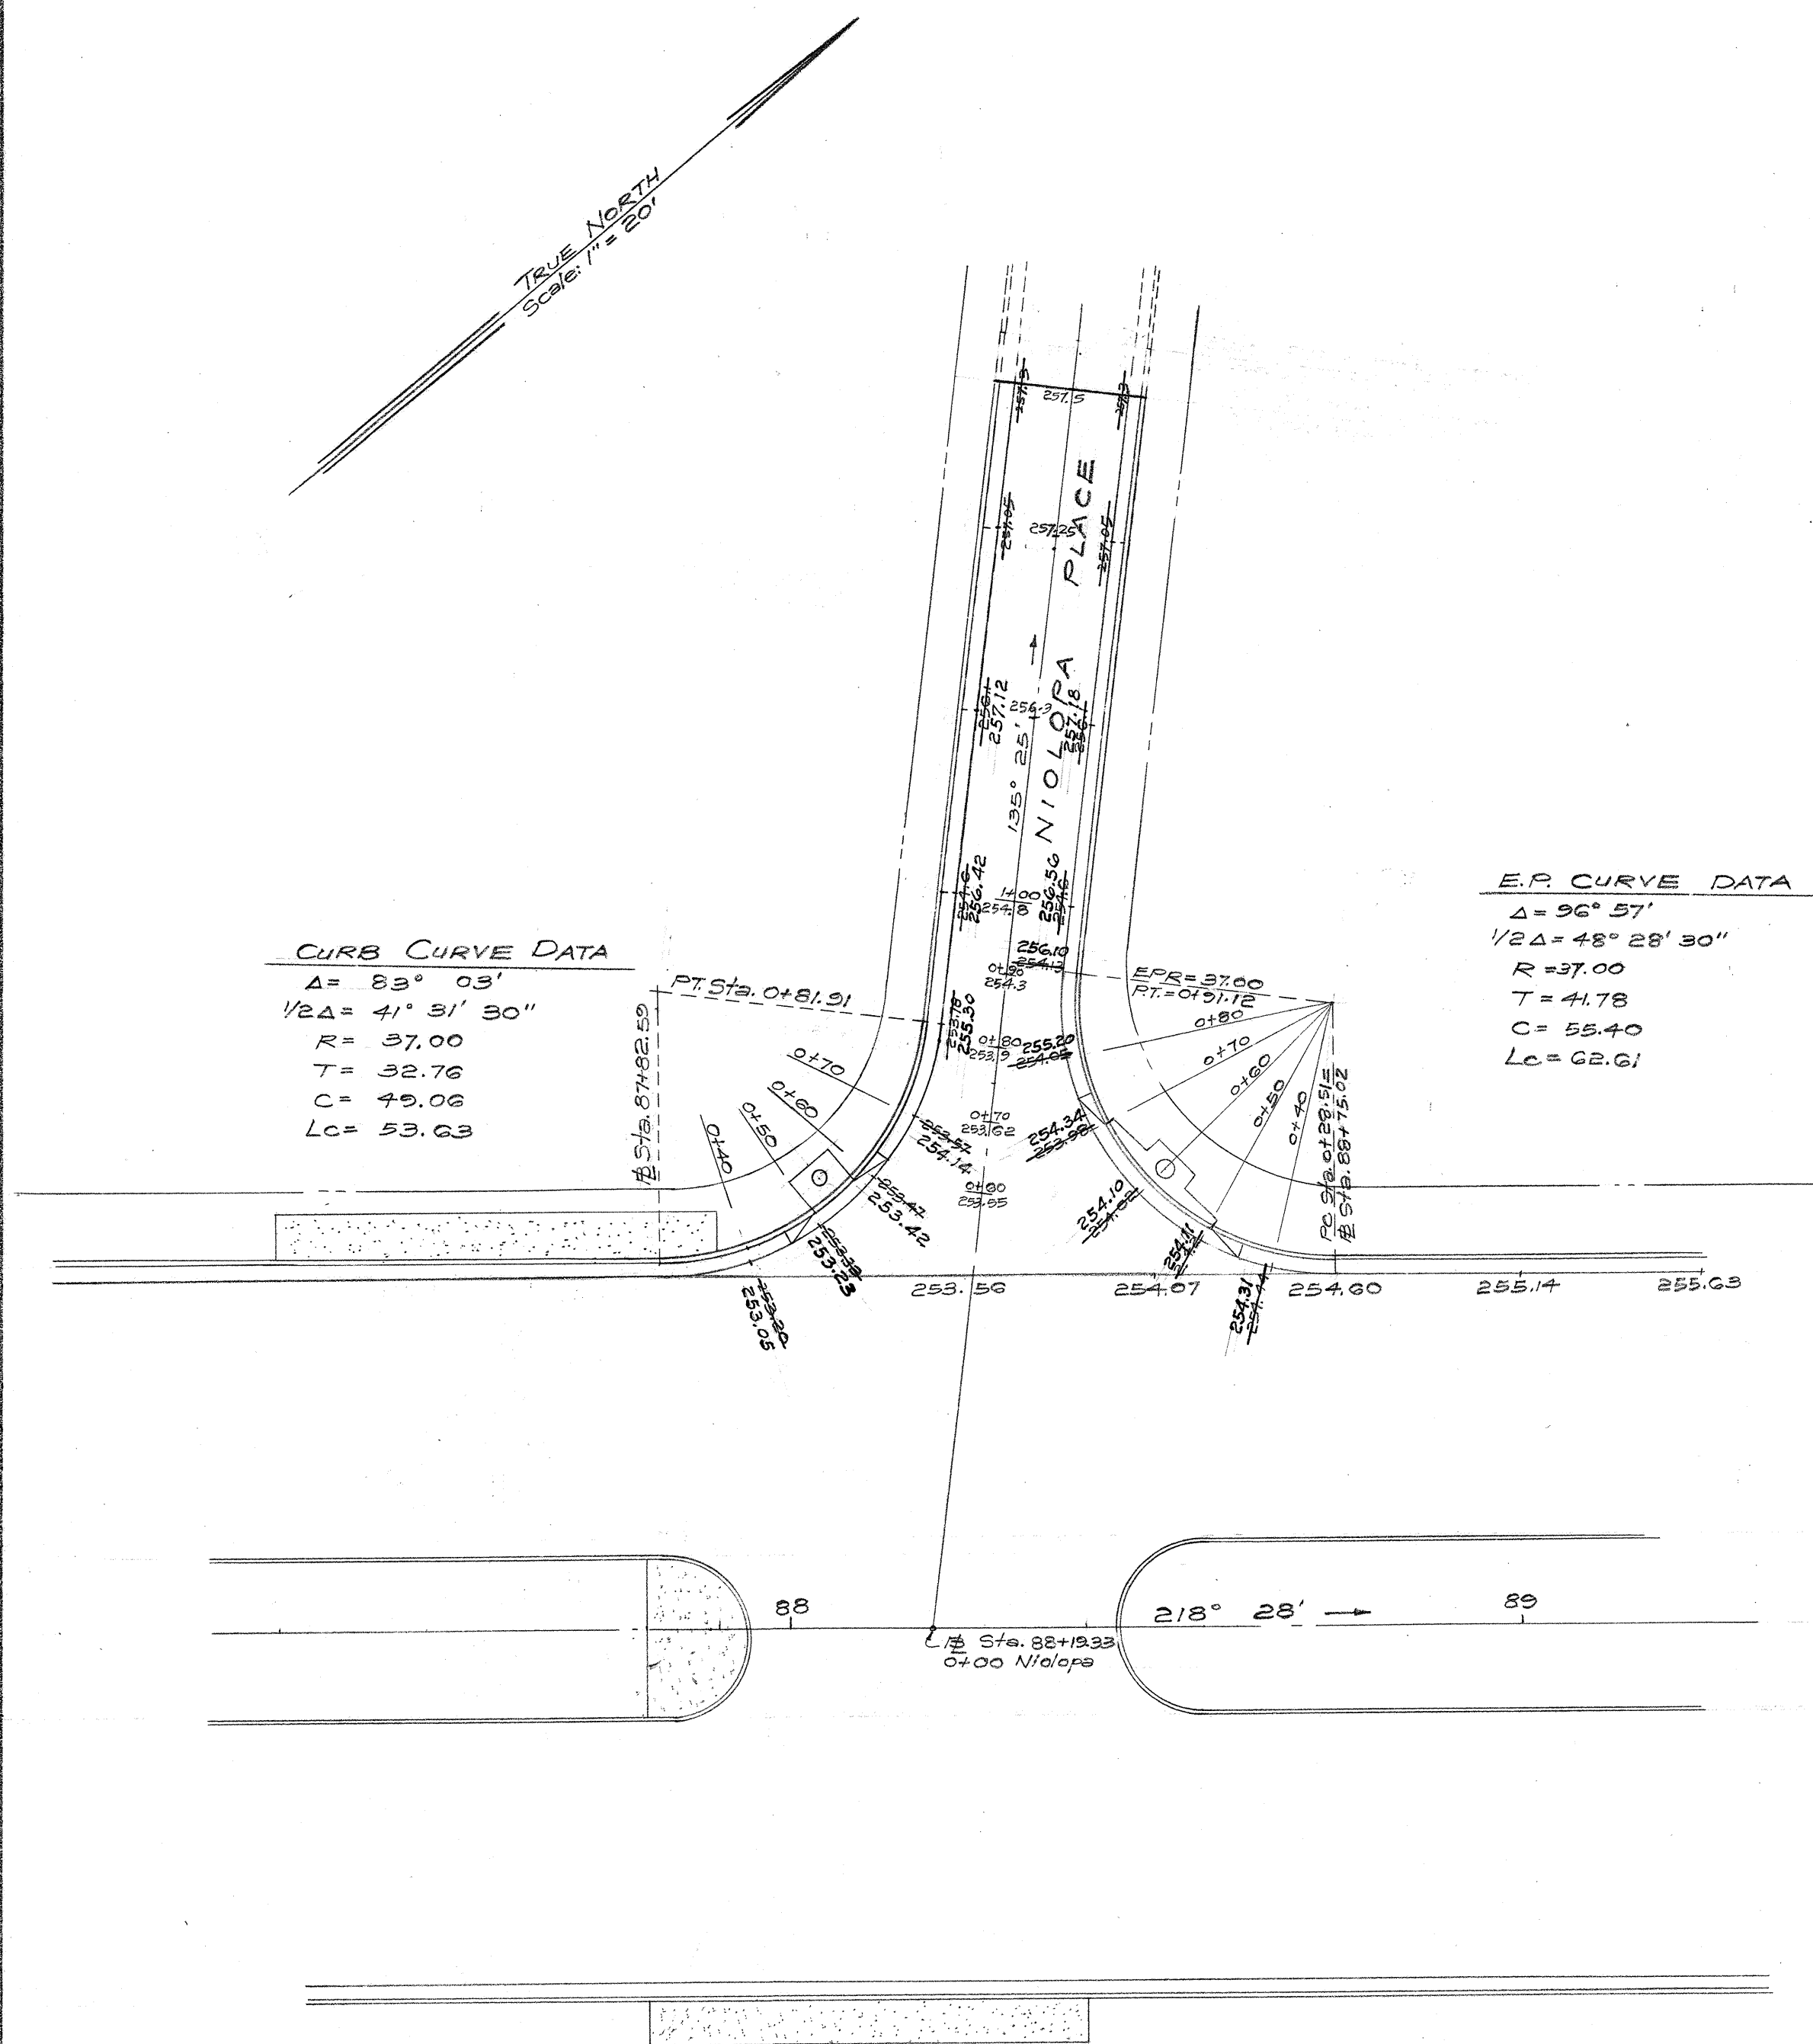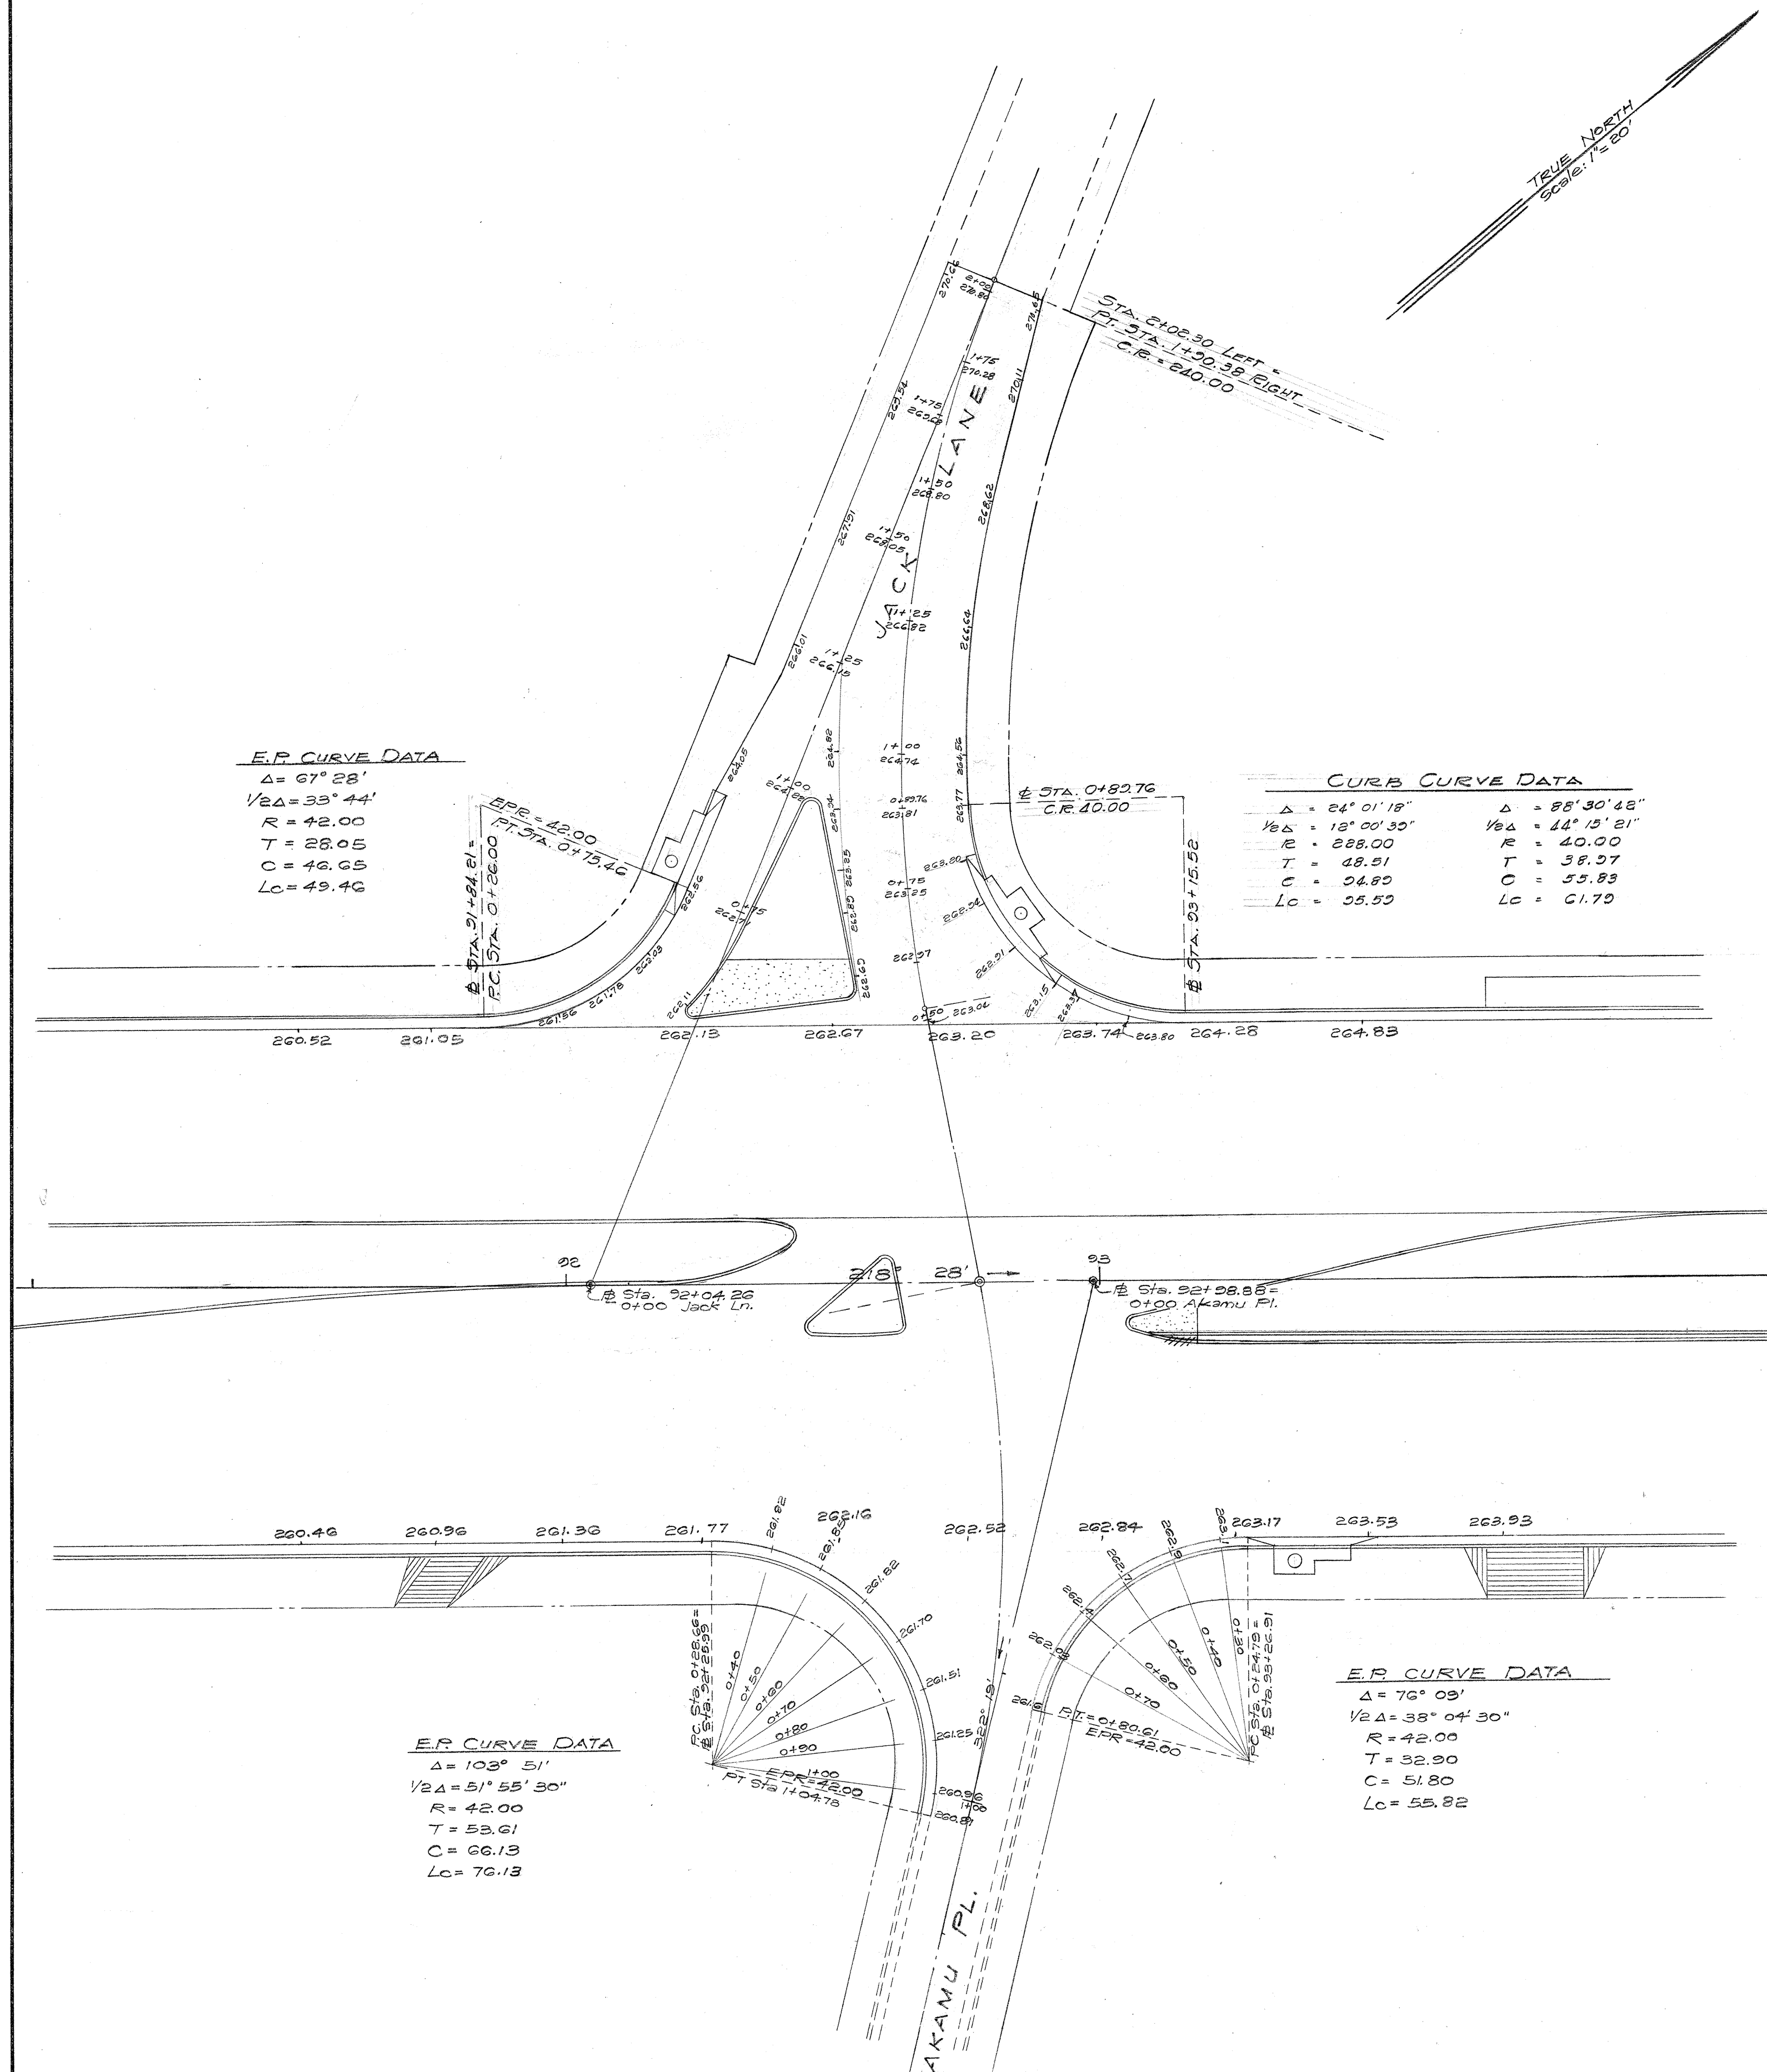

SURVEY PLOTTED BY	DATE
ORIGINAL PLAN	NO.
TRACED BY	QUANTITIES CHECKED BY
NOTE BOOK	CHECKED BY

TERRITORIAL HIGHWAY DEPARTMENT
TERRITORY OF HAWAII
ACCESS ROAD AND
CURB RETURN GRADE PLAN
PROJ. No. 4-061-1(4)

SHEET No. / OF / SHEETS

5891.12