


FED. ROAD DIST. NO.	STATE	FED. AID PROJ. NO.	FISCAL YEAR	SHEET NO.	TOTAL SHEETS
HAW.	HAWAII	U-061-1(4)	1957	24	41

Jan. 27, 1958
Jan. 31, 1958

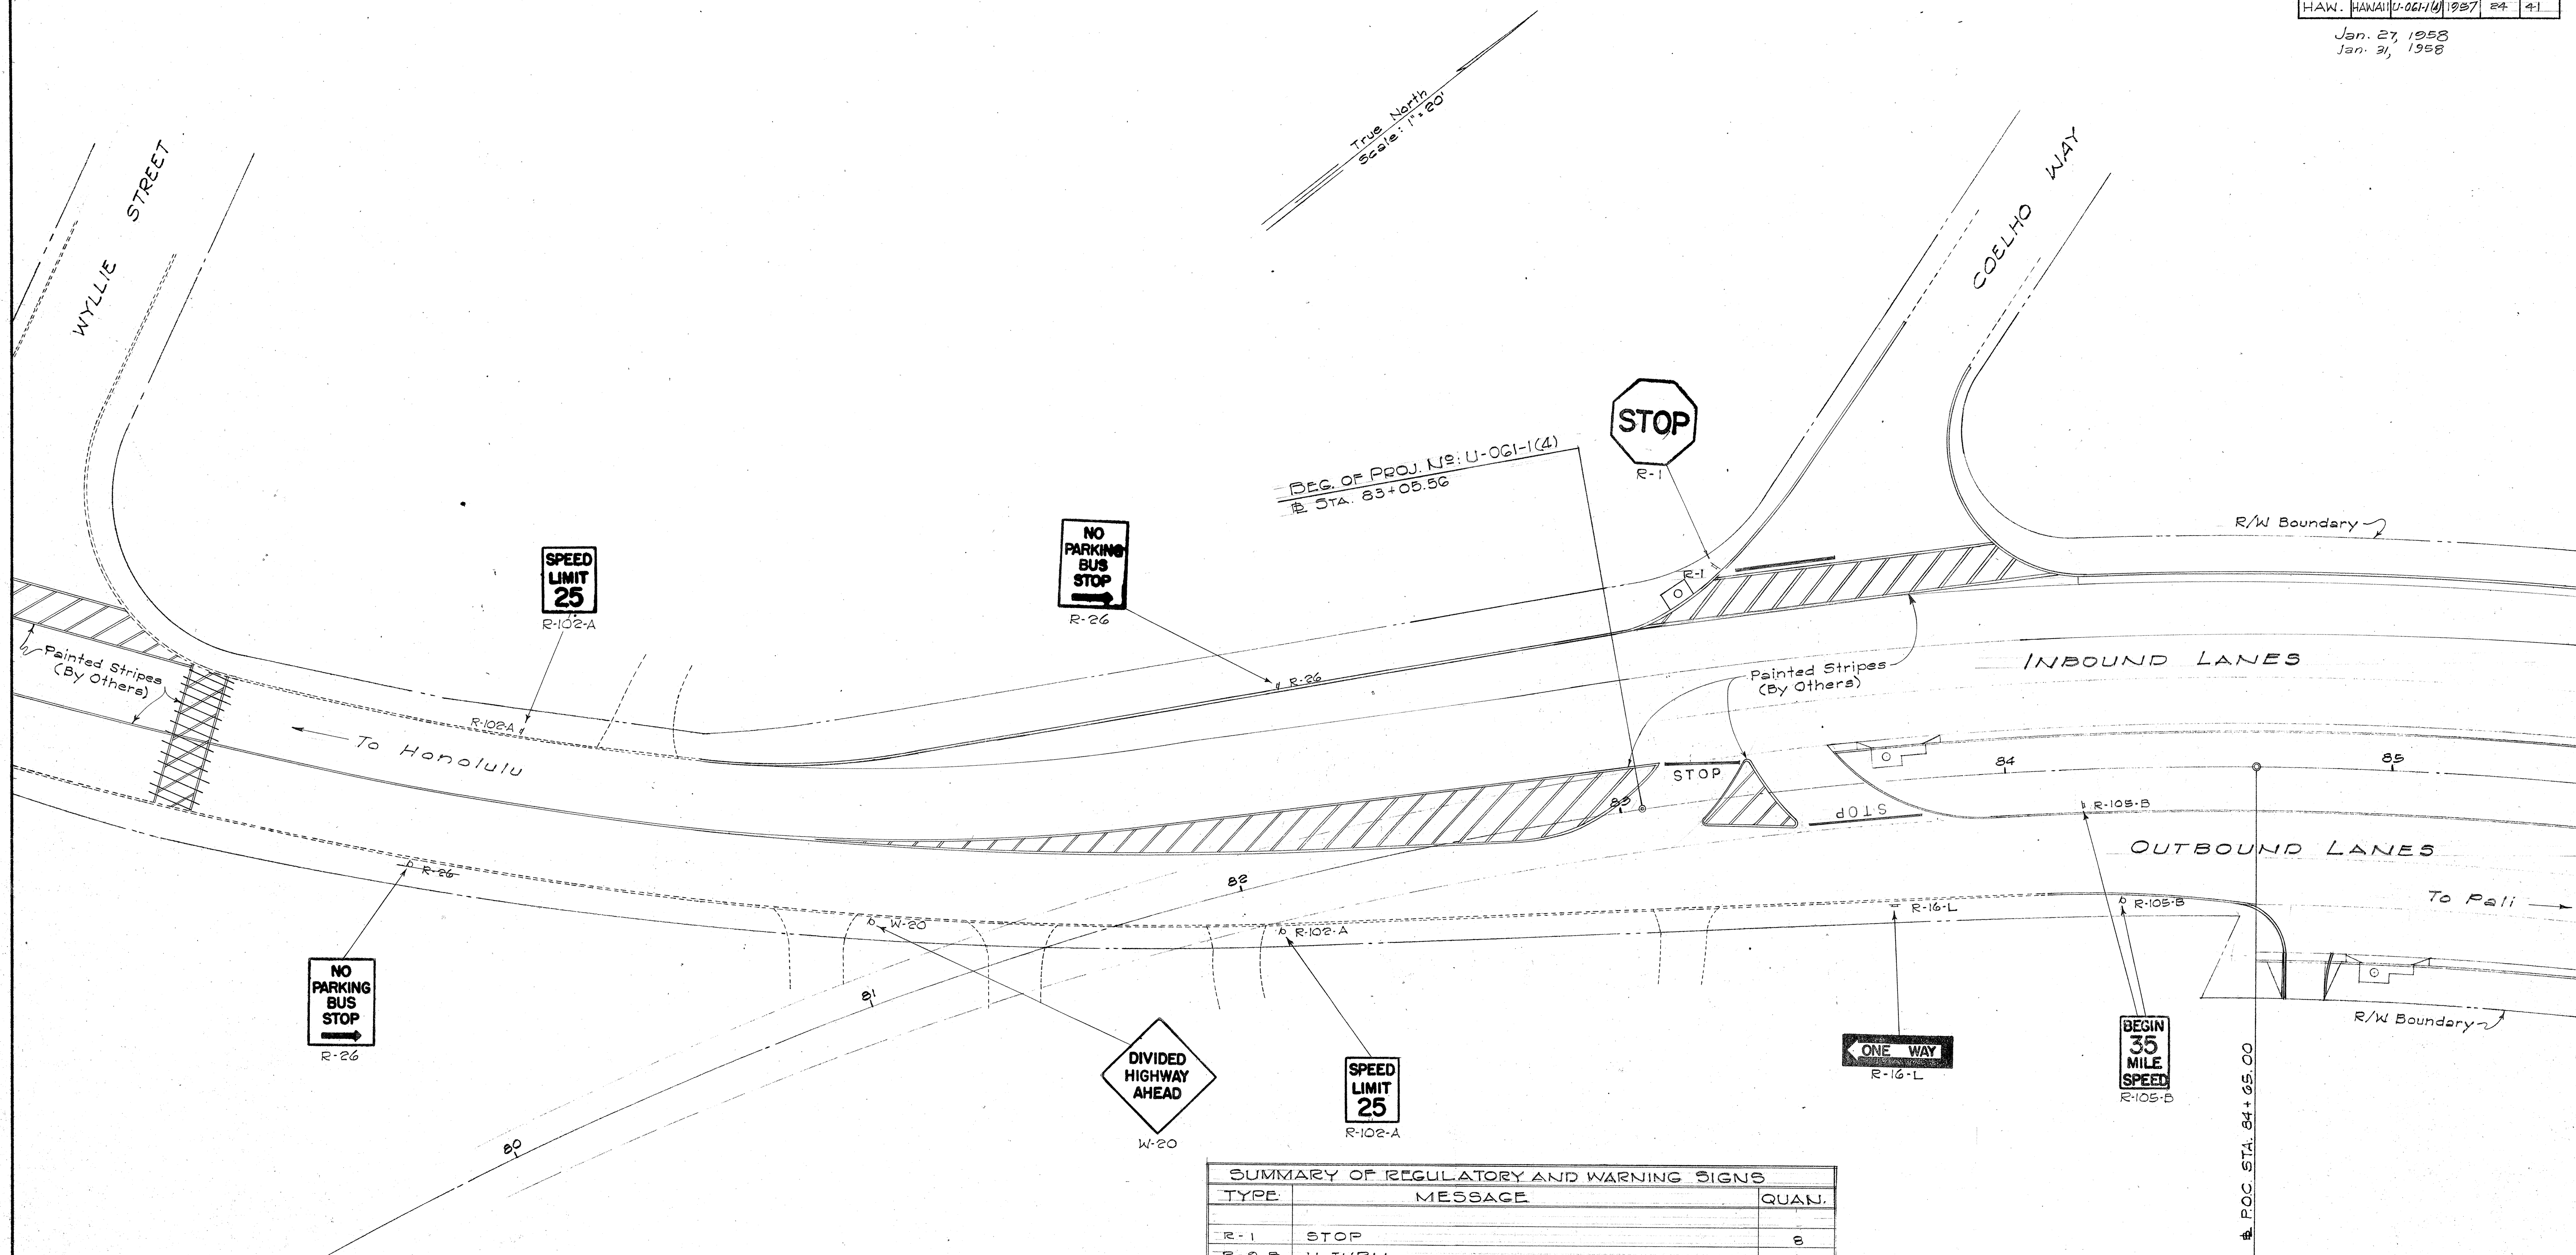

SUMMARY OF REGULATORY AND WARNING SIGNS		
TYPE	MESSAGE	QUAN.
R-1	STOP	8
R-9-B	U TURN	6
R-16-L	ONE WAY	6
R-18	NO PARKING (ANY TIME)	10
R-26	NO PARKING (BUS STOP)	8-7
R-102-A	SPEED LIMIT 25	2
R-102-B	SPEED LIMIT 35	6
R-104-A	REDUCED SPEED OF 25 AHEAD	2
R-105-A	BEGIN 25 MILE SPEED	2
R-105-B	BEGIN 35 MILE SPEED	2
W-20	DIVIDED HIGHWAY AHEAD	1
W-21	DIVIDED HIGHWAY ENDS	1
W-41	REFLECTOR	1
TOTAL :		55-54

TERRITORIAL HIGHWAY DEPARTMENT
TERRITORY OF HAWAII
LAYOUT OF
REGULATORY & WARNING SIGNS
PAYEMENT MARKINGS
NUUANU AVENUE
PROJECT NO. U-061-1(4)
SCALE: 1" = 20' OCT. 1956


SHEET No. 1 OF 3 SHEETS

5891.24

ORIGINAL PLAN	DATE
DESIGNED BY	
TRACED BY	
QUANTITIES BY	
CHECKED BY	
NOTE BOOK No.	

FED. ROAD DIST. NO.	STATE	FED. AID PROJ. NO.	FISCAL YEAR	SHEET NO.	TOTAL SHEETS
HAW.	HAWAII	4-061-1(4)	1957	25	41

Jan. 27, 1958
Jan. 31, 1958

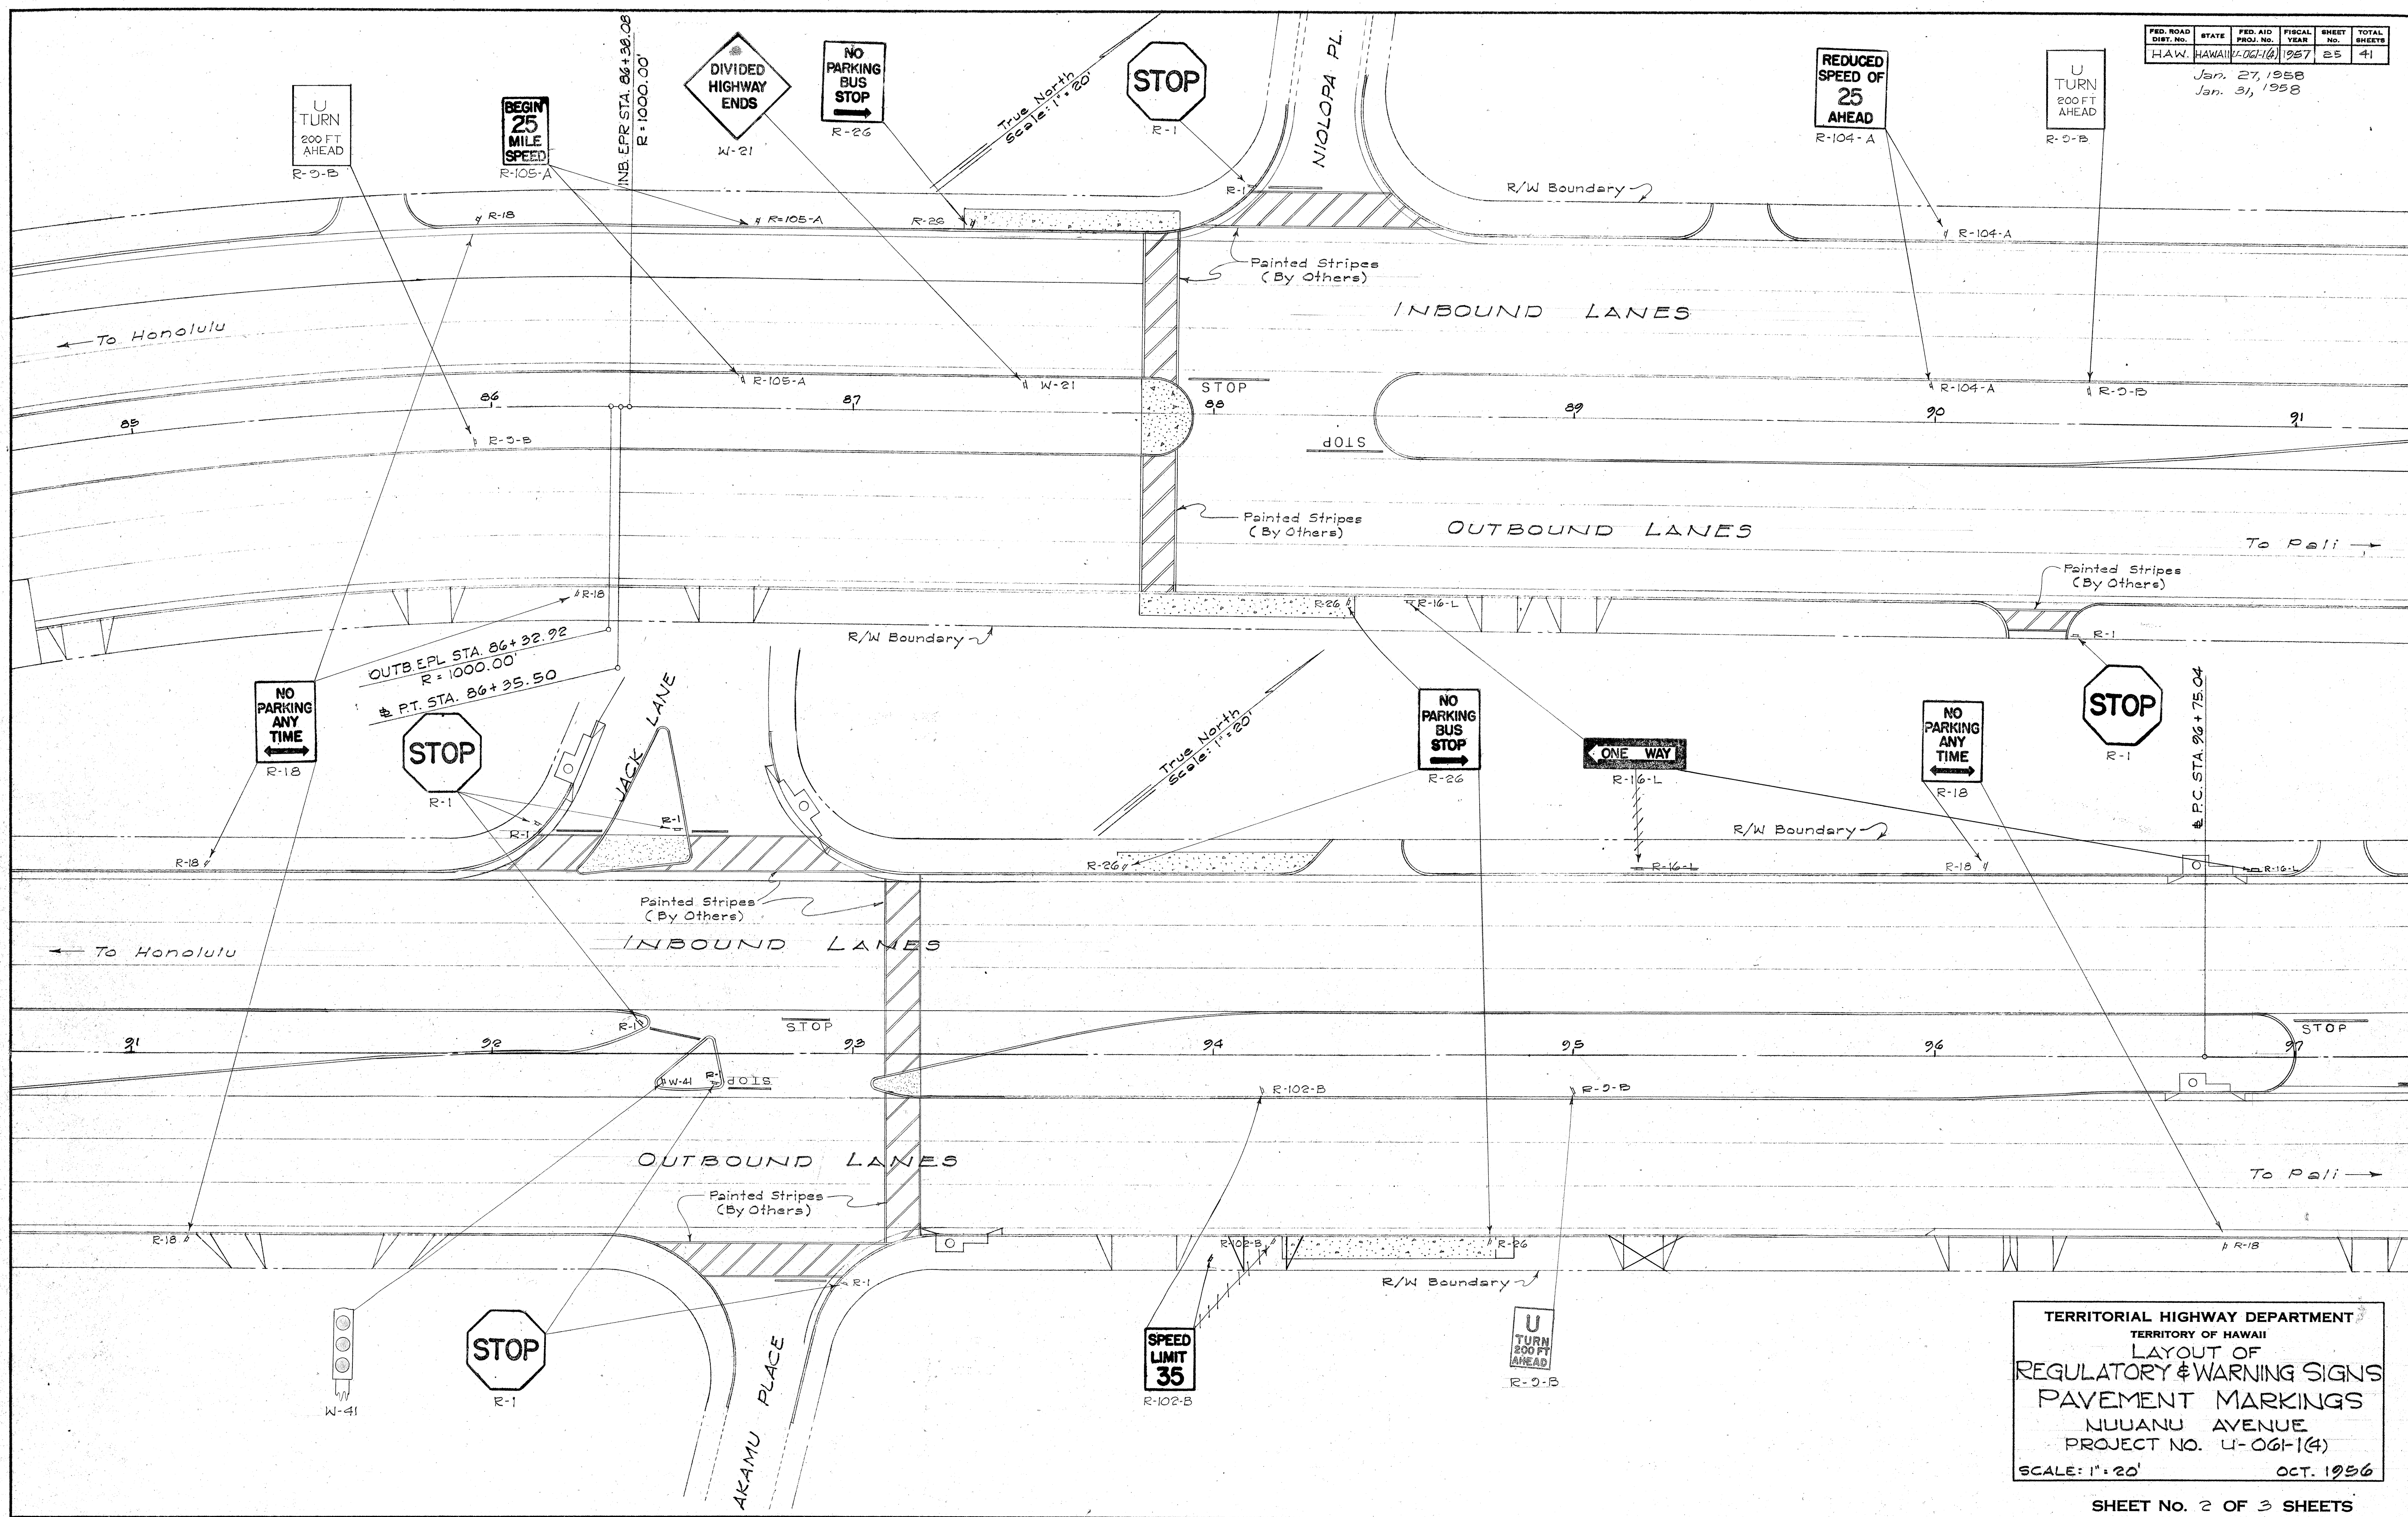


TERRITORIAL HIGHWAY DEPARTMENT
TERRITORY OF HAWAII
LAYOUT OF
REGULATORY & WARNING SIGNS
PAVEMENT MARKINGS
NUUANU AVENUE
PROJECT NO. 4-061-1(4)
SCALE: 1" = 20' OCT. 1956

SHEET No. 2 OF 3 SHEETS

5891.25

SURVEY PLOTTED BY	DATE
DESIGNED BY	
TRACED BY	
QUANTITIES BY	
CHECKED BY	
NOTE BOOK No.	

FED. ROAD DIST. No.	STATE	FED. AID PROJ. No.	FISCAL YEAR	SHEET No.	TOTAL SHEETS
HAW.	HAWAII	U-061-14	1957	26	41

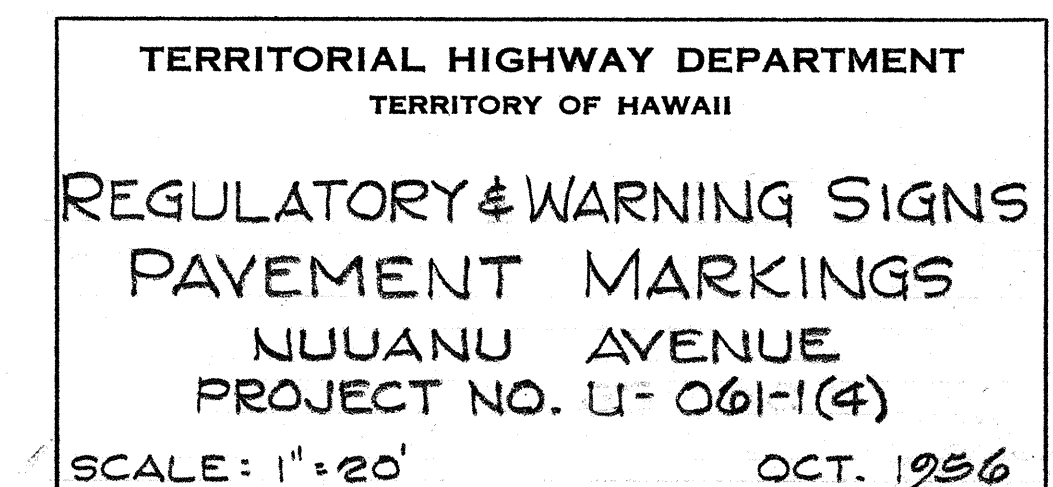

5891.26

ORIGINAL	SURVEY PLOTTED BY _____	DATE _____
PLAN	DESIGNED BY _____	_____
	DRAWN BY _____	_____
	TRACED BY _____	_____
NOTE BOOK	QUANTITIES BY _____	_____
	QUANTITIES CHECKED BY _____	_____
No. _____	CHECKED BY _____	_____