

INDEX TO DRAWINGS	
SHEET NO.	DESCRIPTION
1	TITLE SHEET
2	TYPICAL SECTIONS
3 - 4	PLAN & PROFILE
5	STORM DRAIN OUTLET
6 - 7	INTERSECTION DETAILS
8	MISCELLANEOUS DETAILS
9 - 12	PAVEMENT GRADES
13 - 19	UTILITIES-HIGHWAY LIGHTING
20 - 23	WATER
24 - 26	REGULATORY & WARNING SIGNS
27 - 29	LANDSCAPING
30 - 35	ADJ. OF IMPROVEMENTS
36 - 41	CROSS SECTIONS

CONVENTIONAL SIGNS	
Centerline	125
Boundary Lines	or
Fences (Named)	
Existing Roadways	
Circular Culvert	
Box Culvert	
Bridge	
Telephone Pole	T.P.
Electric Power Pole	E.P.
Water Main	W ₂ (W ₄ , 8, 12, Etc.)
Storm Drain	SD ₁₂ (SD ₁₈ , 24, Etc.)
Concrete Drop Intake	C.D.I.
Standard Catch Basin	S.C.B.
Standard Manhole	M.H.S.
Sewer Manhole	S.S. S ₁₂ S ₁₈ S ₂₄
Telephone Manhole	T.M.H.
Fire Hydrant	F.H.
Tree (Large, named)	Tree
Railroad	
Hawaiian Telephone Underground Cable	HTC
Water Meter	WM

TERRITORY OF HAWAII
TERRITORIAL HIGHWAY DEPARTMENT
HONOLULU, OAHU, T. H.
"AS BUILT"
PLANS OF


NUUANU AVENUE

FEDERAL AID URBAN PROJECT NO. U-061-I(4)

DISTRICT OF HONOLULU

ISLAND OF OAHU

SCALES	
PLAN	1 INCH = 50 FT.
PROFILE	HOR. 1 INCH = 50 FT.
	VER. 1 INCH = 10 FT.
CROSS SECTION	HOR. 1 INCH = 10 FT.
	VER. 1 INCH = 5 FT.

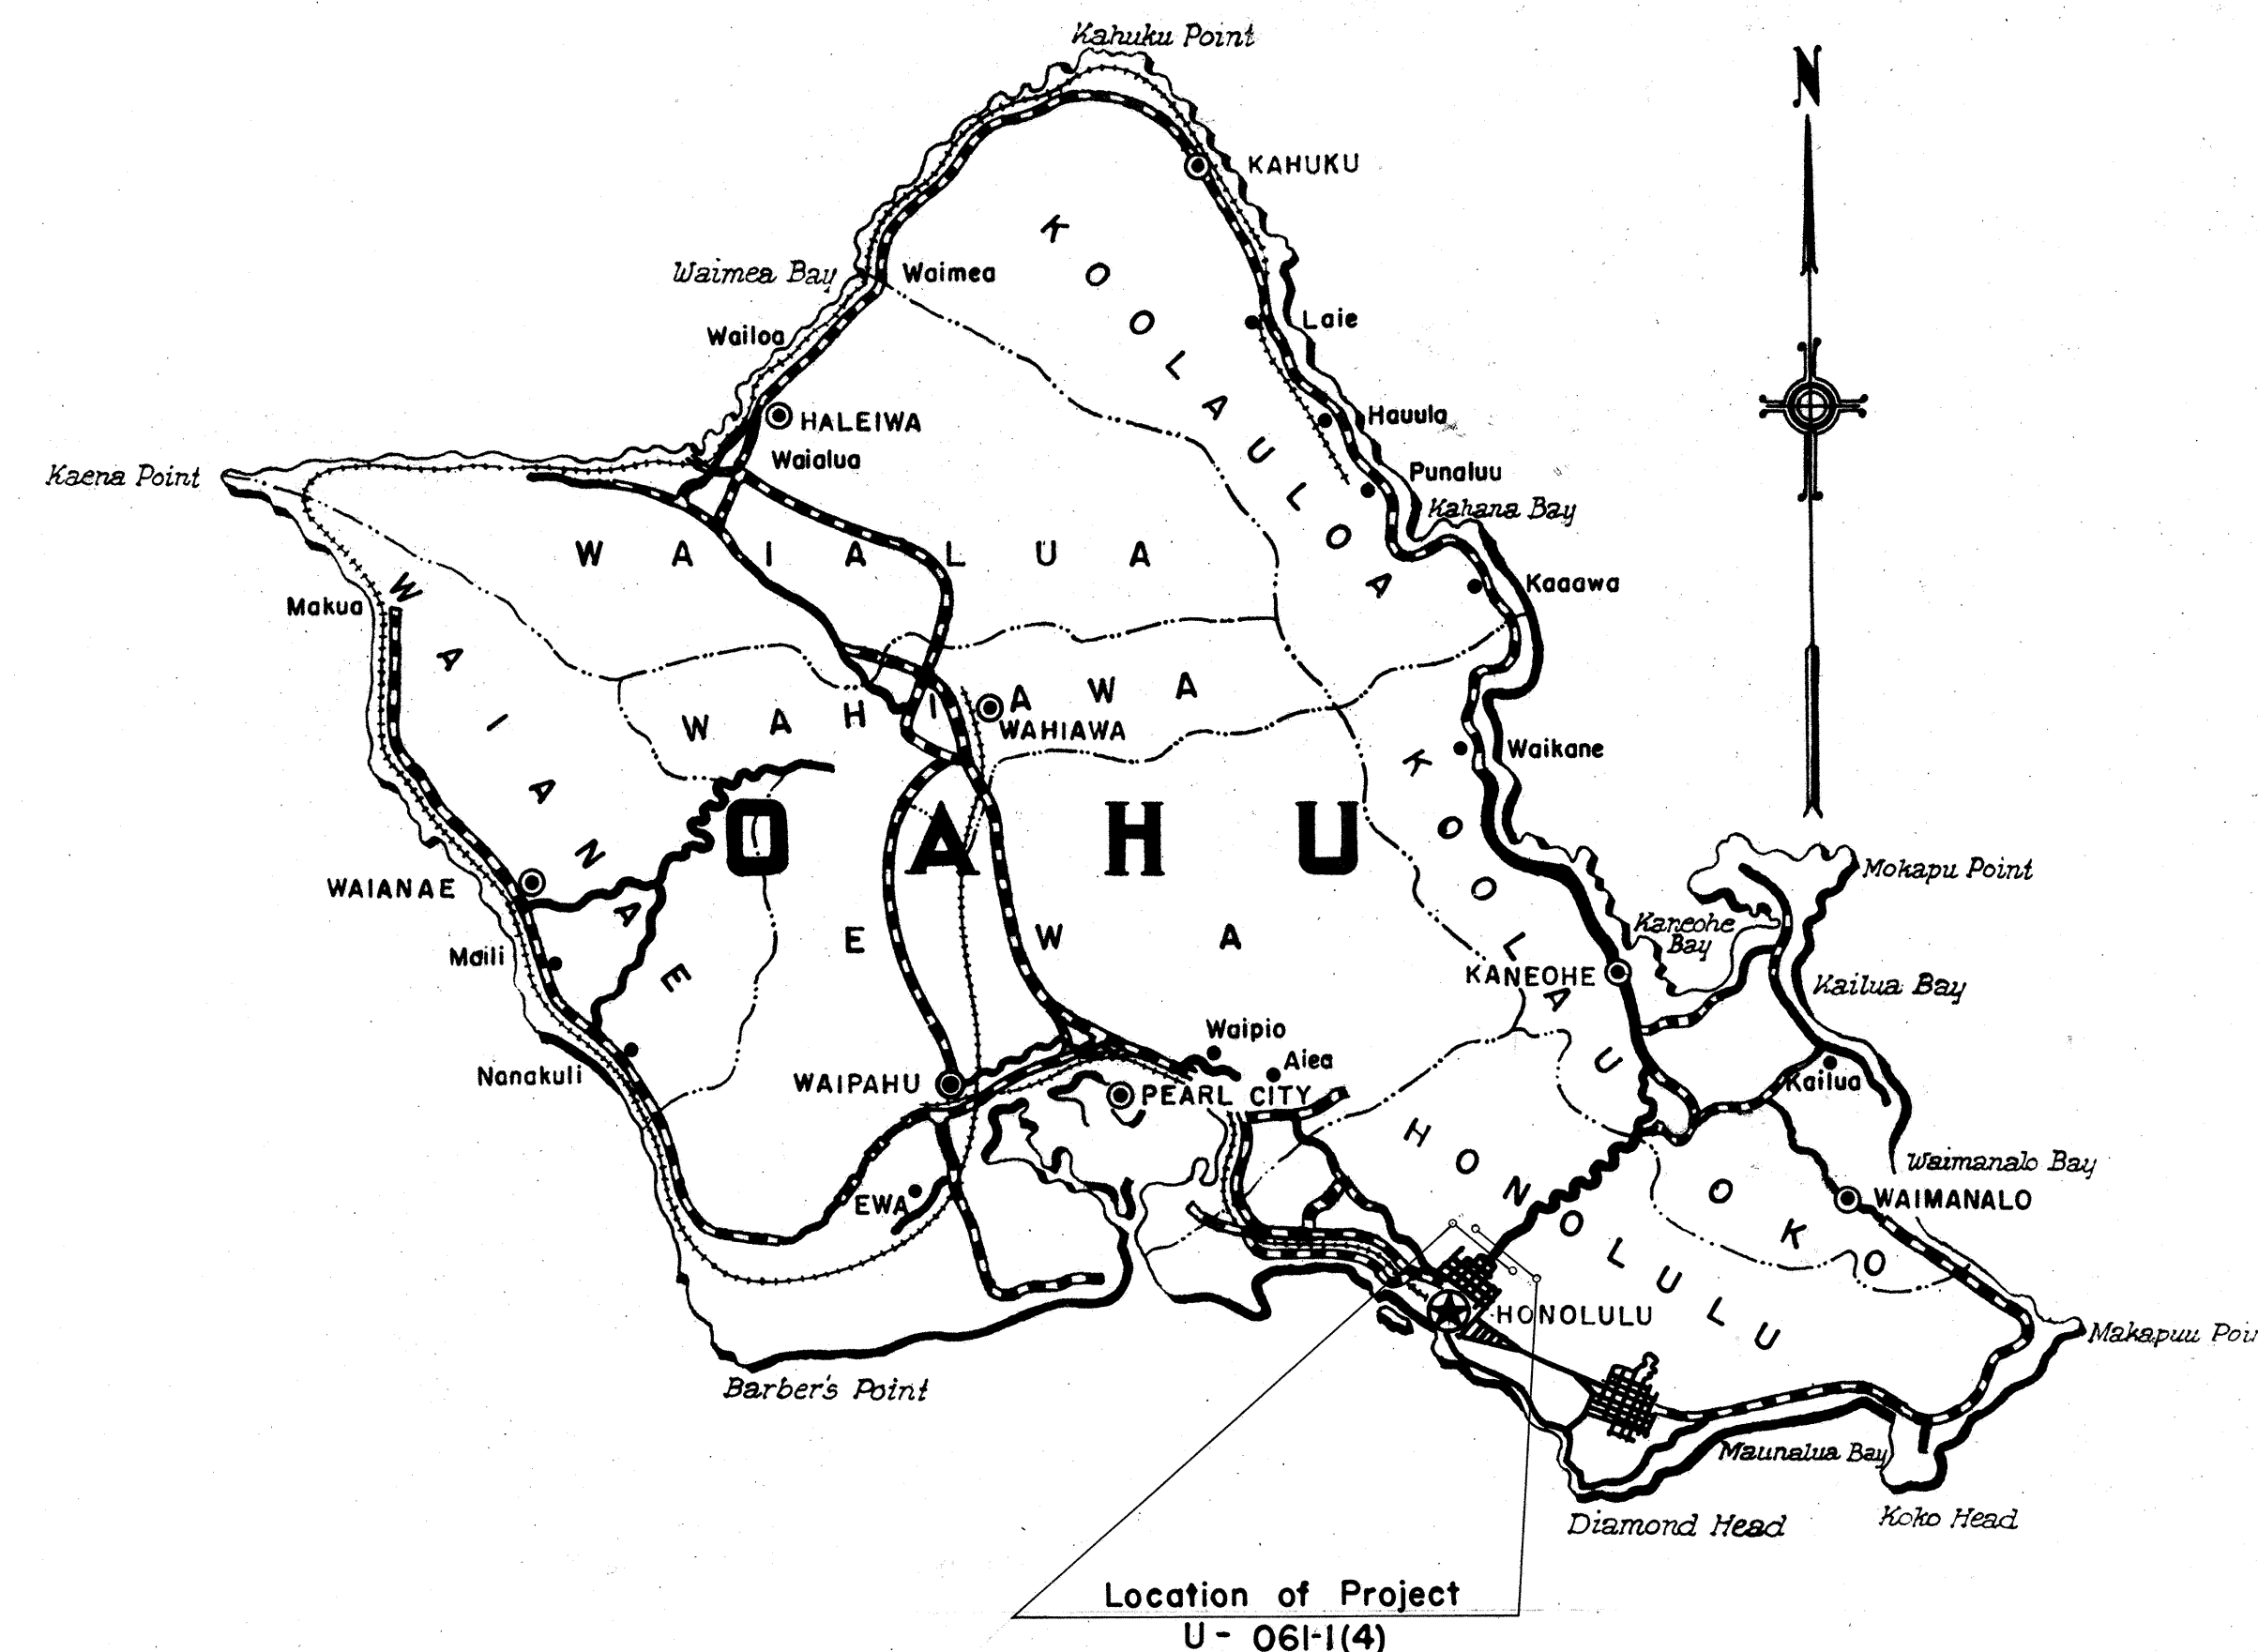

Federal Aid Projects Previously Constructed Or Under Construction

NOTE:
PLAN SHEETS IN THIS SET WHICH HAVE BEEN CHANGED INCLUDE NO.'S 5891.2A, 2B, 2C, 2D, 2E, 3-8 (Incl.), 10, 12, 17, 18, 20, 20A, 21, 24, 25, 27, 29A, 30, 30A, 31-34 (Incl.), 36-41 (Incl.).


NOTE : ALL CHANGES MADE DURING CONSTRUCTION ARE SHOWN IN RED ON THESE TRACINGS AND ARE CHECKED BY

C. J. Patton
for DISTRICT ENGINEER
Jan. 4, 1961
DATE

DEPARTMENT OF COMMERCE BUREAU OF PUBLIC ROADS	
APPROVED	
DIVISION ENGINEER	DATE

APPROVED	DATE 8-6-57
<i>Harold W. Butcher</i> TERRITORIAL HIGHWAY ENGINEER	

SURVEY PLOTTED BY	DATE
DESIGNED BY	
TRACED BY	
NOTED BY	
CHECKED BY	
ORIGINAL PLAN	
NOTED BY	
CHECKED BY	
No.	

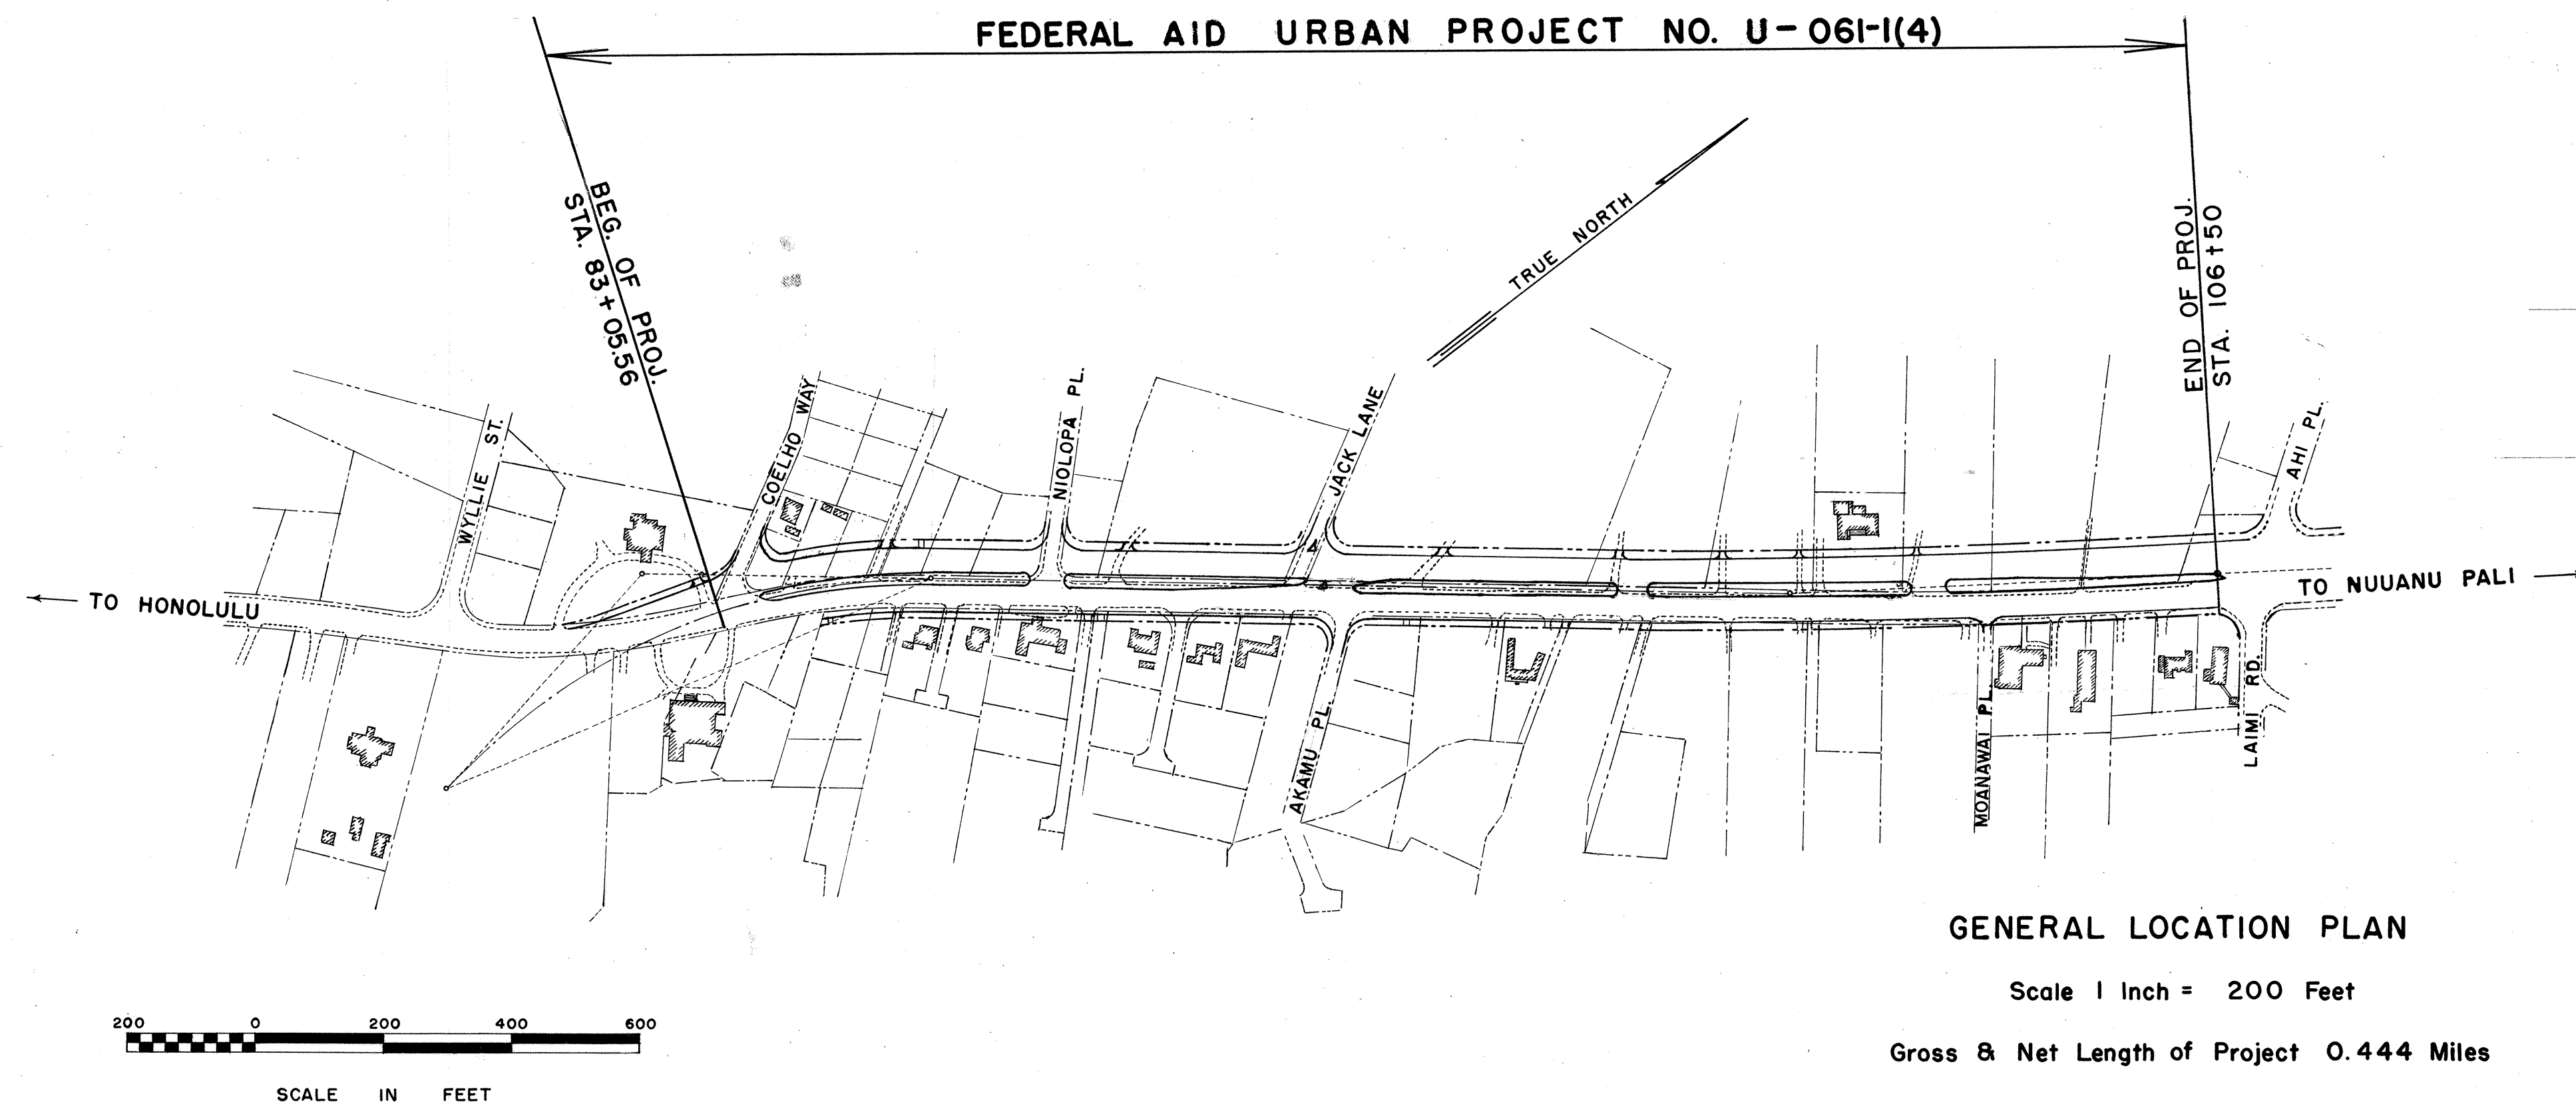

GENERAL LOCATION PLAN

Scale 1 Inch = 200 Feet

Gross & Net Length of Project 0.444 Miles