

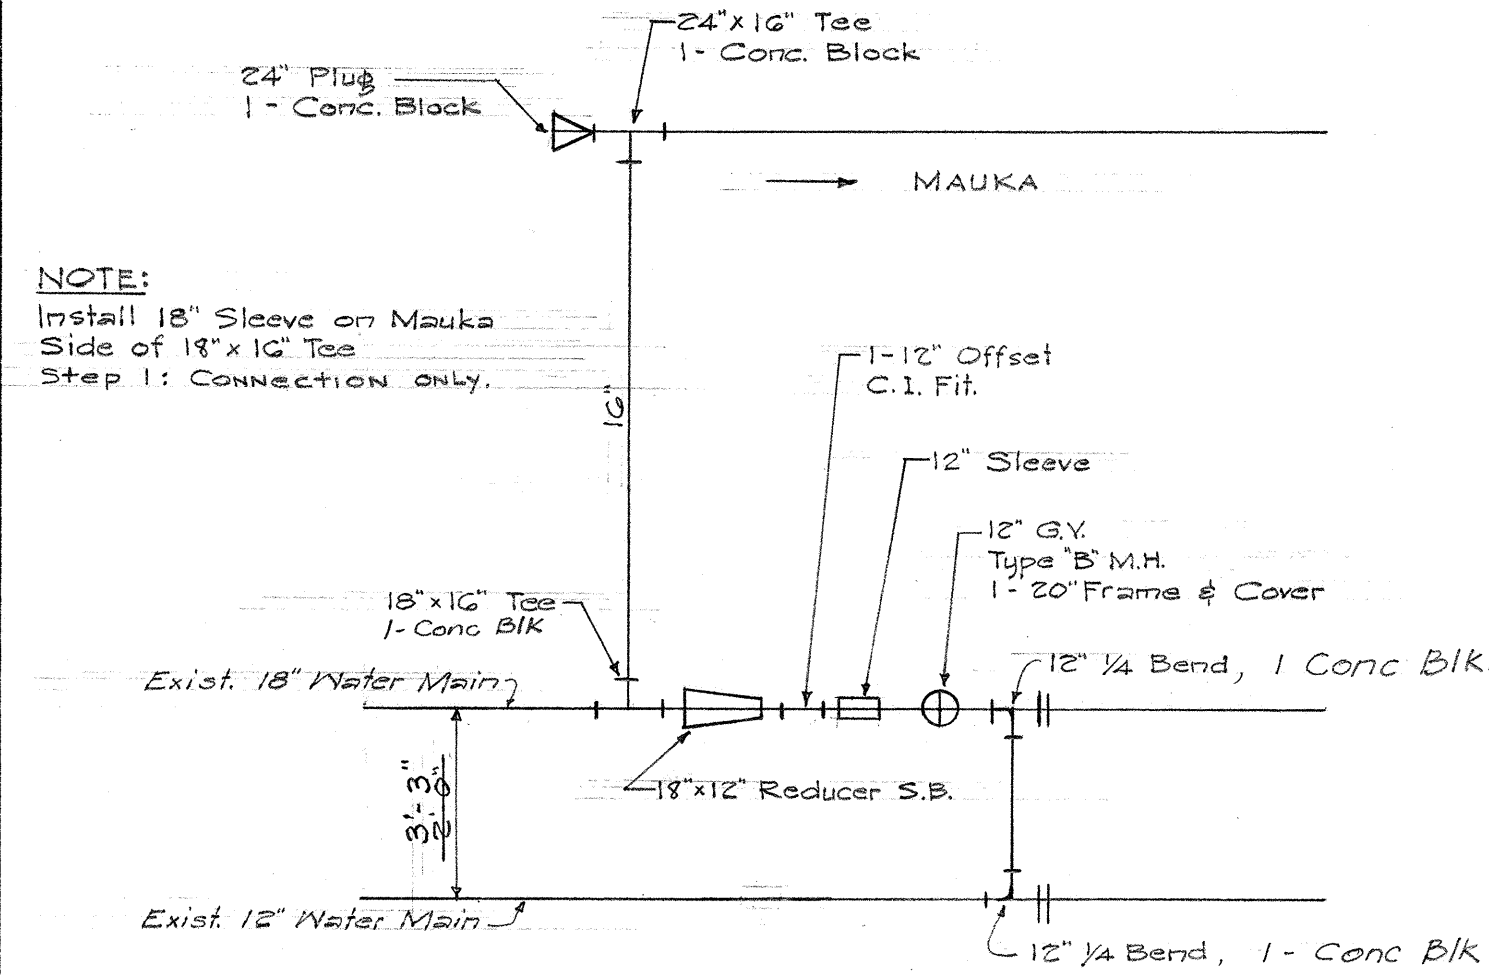


FED. ROAD DIST. No.	STATE	FED. AID PROJ. No.	FISCAL YEAR	SHEET No.	TOTAL SHEETS
HAWAII	HAW.	U-061-14	1958	20A	41

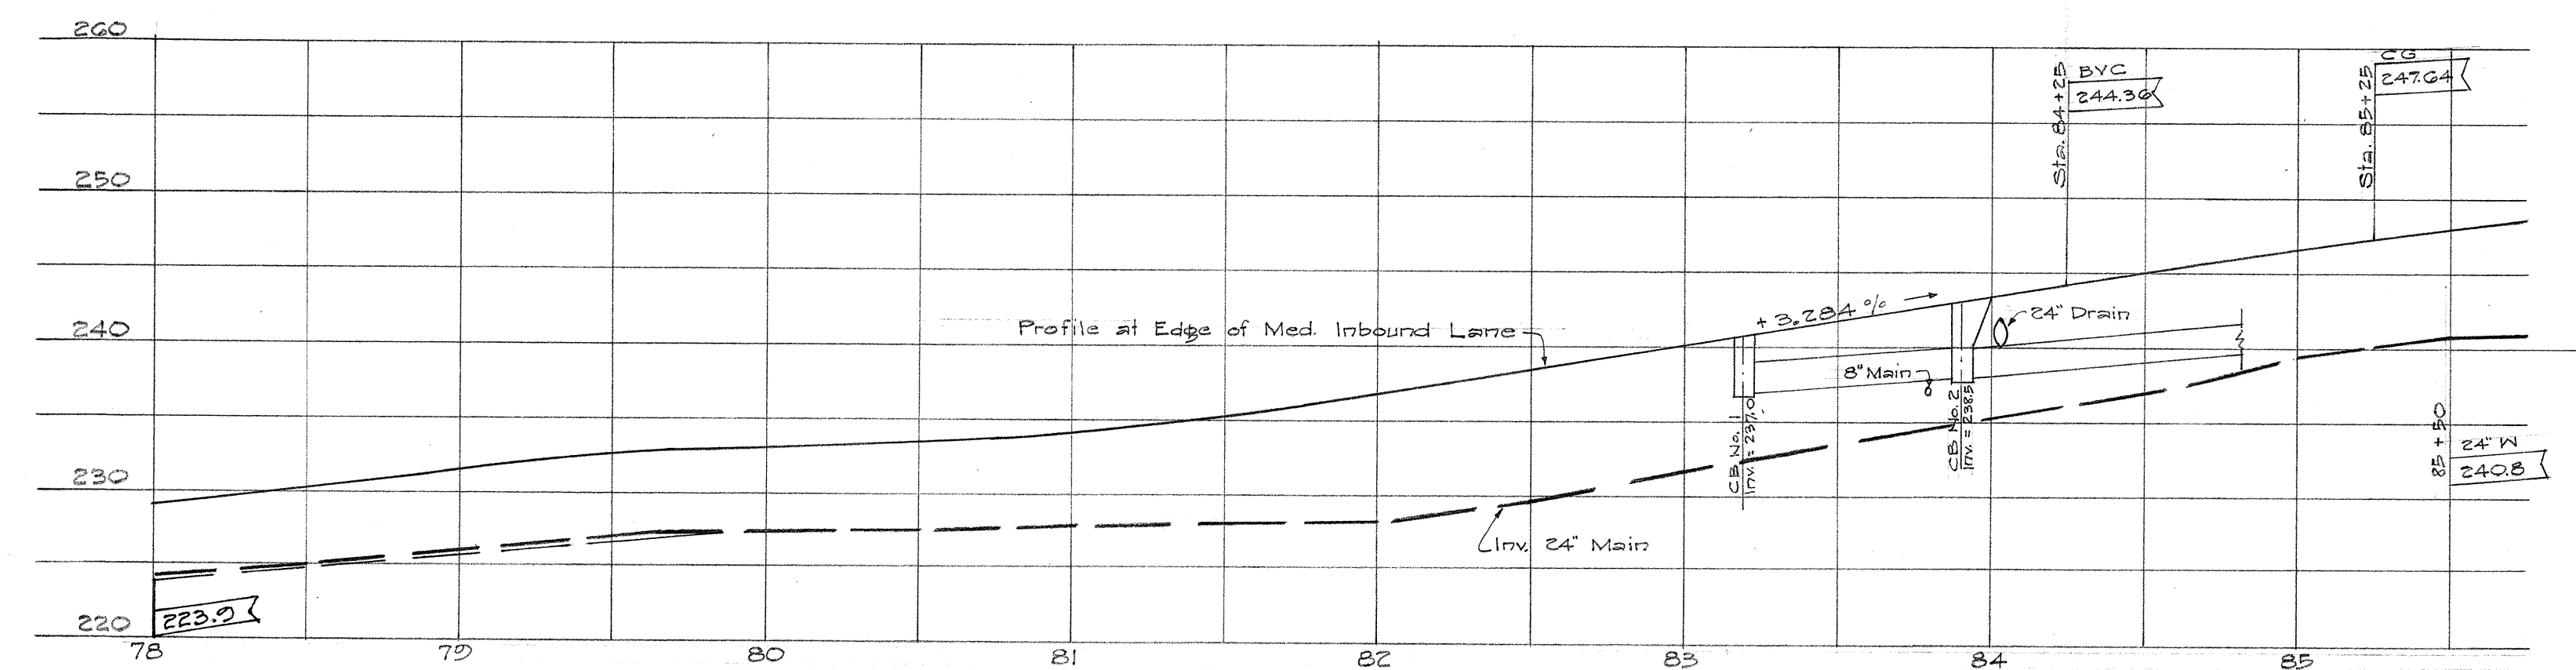

CONNECTION TO EXIST. 12" & 18" MAINS

INSET
Not to Scale

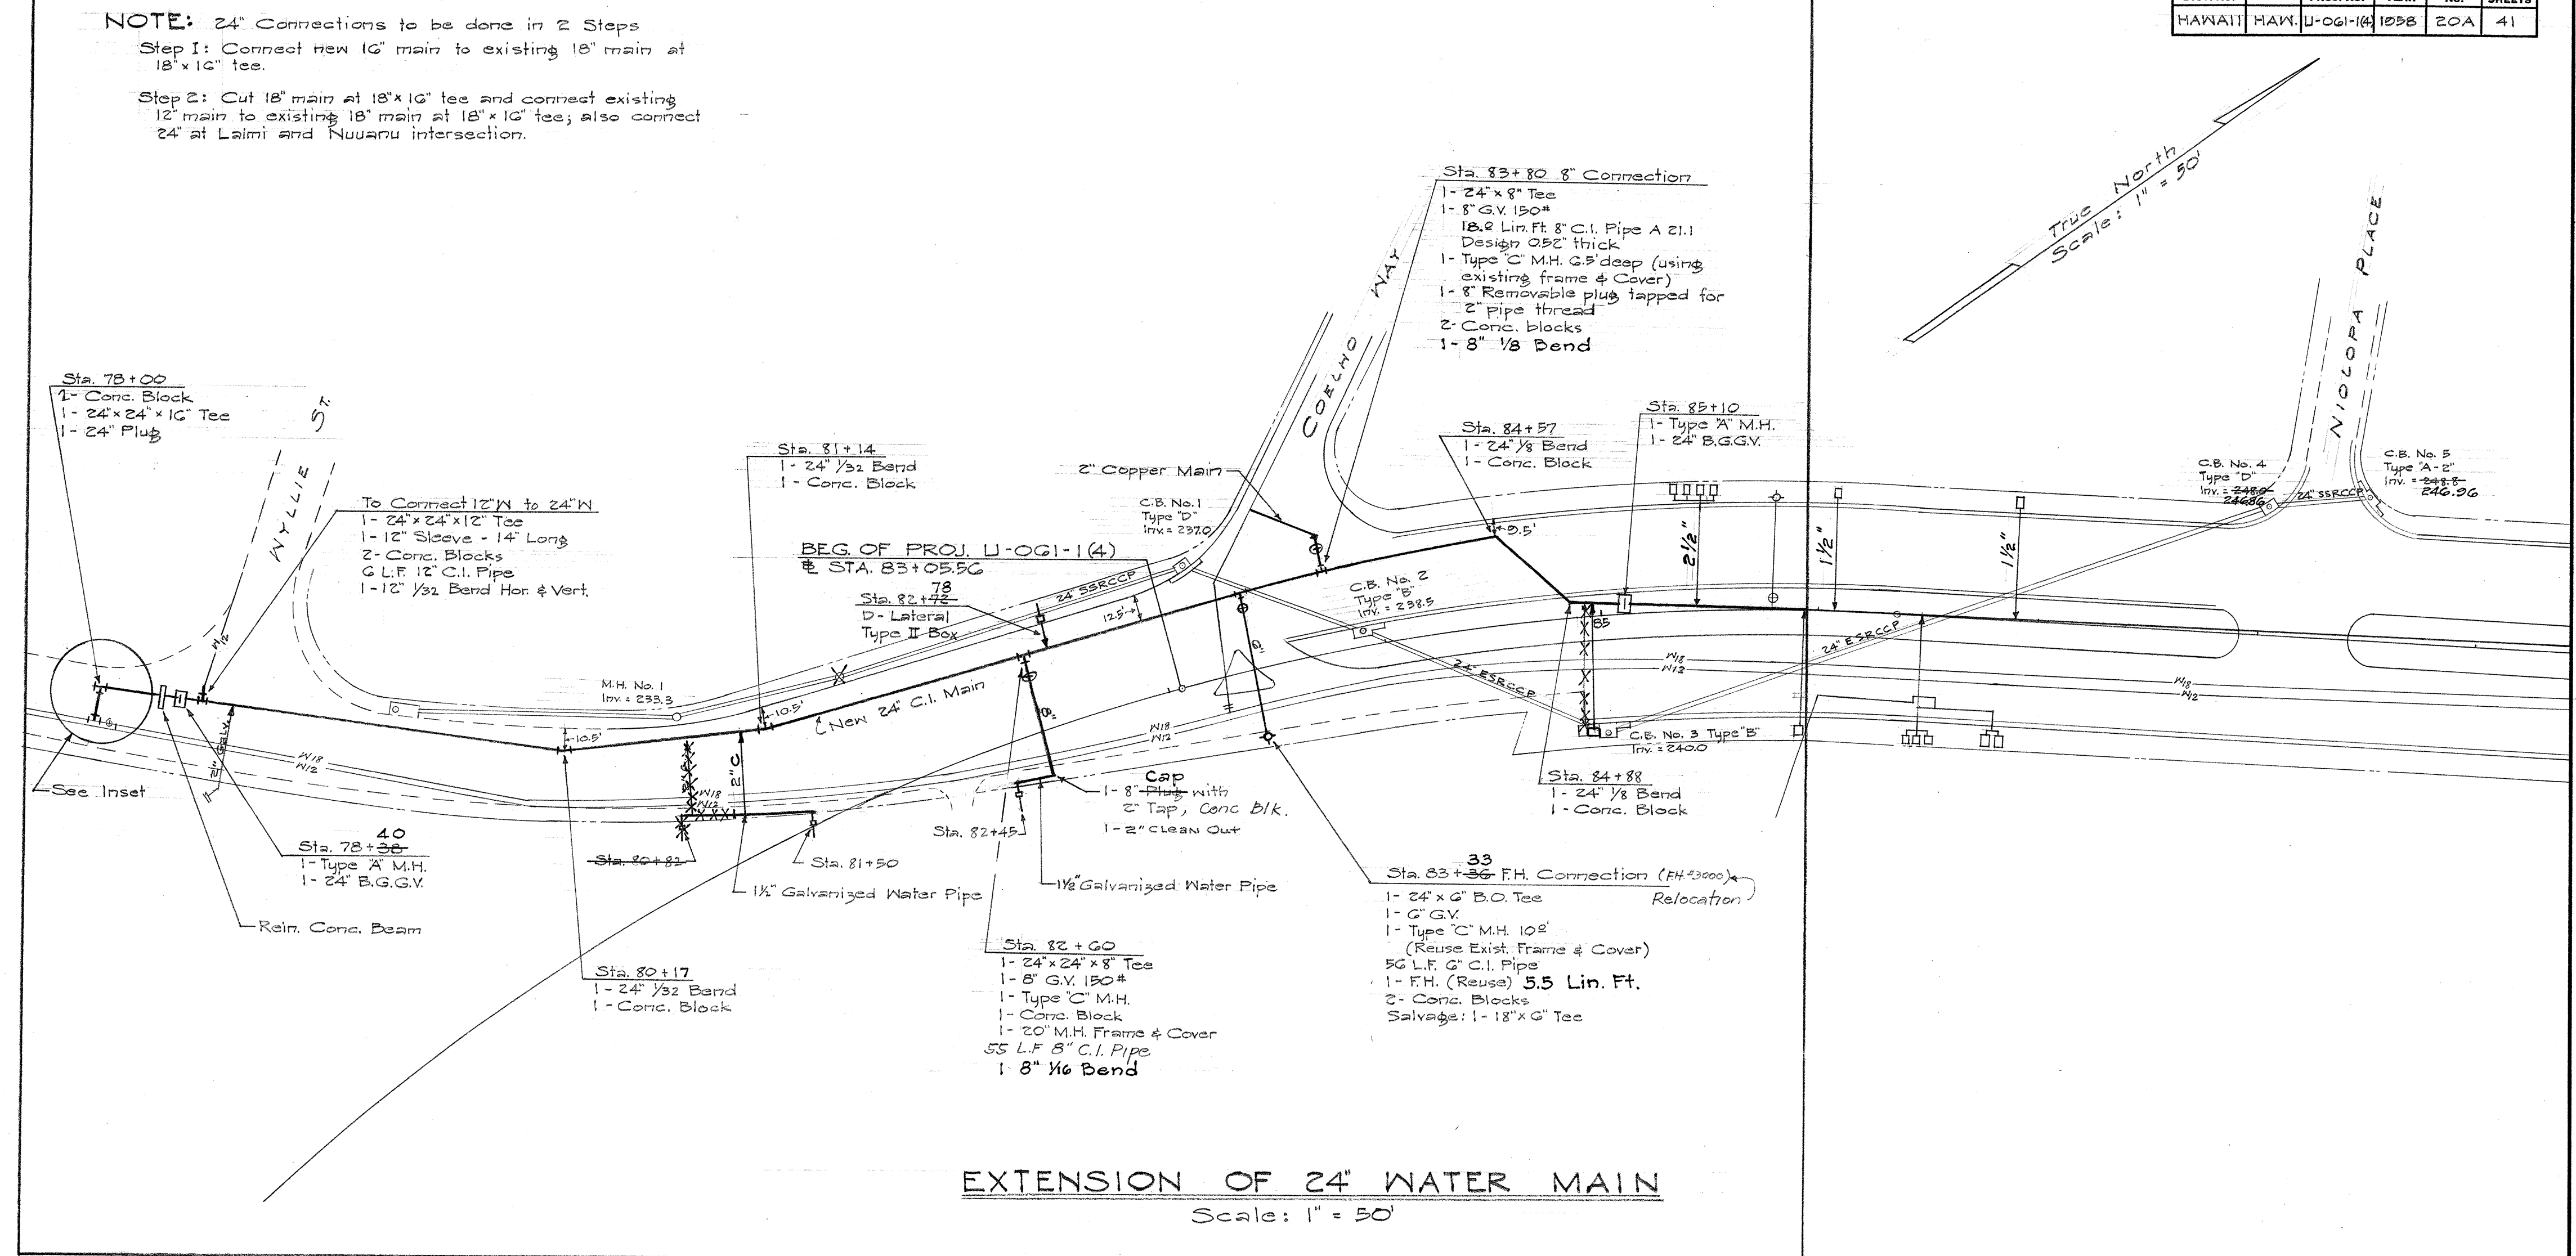

PROFILE ~ 24" WATER MAIN

Scale: Vert. : 1" = 10'
Horiz.: 1" = 50'

APPROVED:

Smorgan
MANAGER AND CHIEF ENGINEER
BOARD OF WATER SUPPLY
M. D. Frenick 8/17/58
DIVISION ENGINEER

TERRITORIAL HIGHWAY DEPARTMENT

WATER SYSTEM

NUUANU AVENUE

LAIMI ROAD TO COELHO WAY



PROJ. No. U-OGI-1(4)


Scale: As Noted August 1958

SHEET No. OF SHEETS


5 § 91.20A

remove, clean
and return to
B.W.S. Kaliki
Yard.


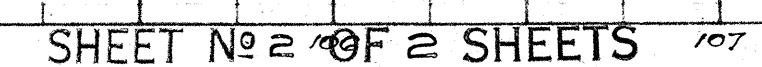
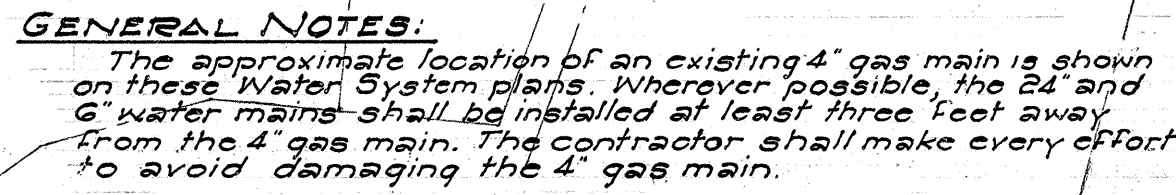


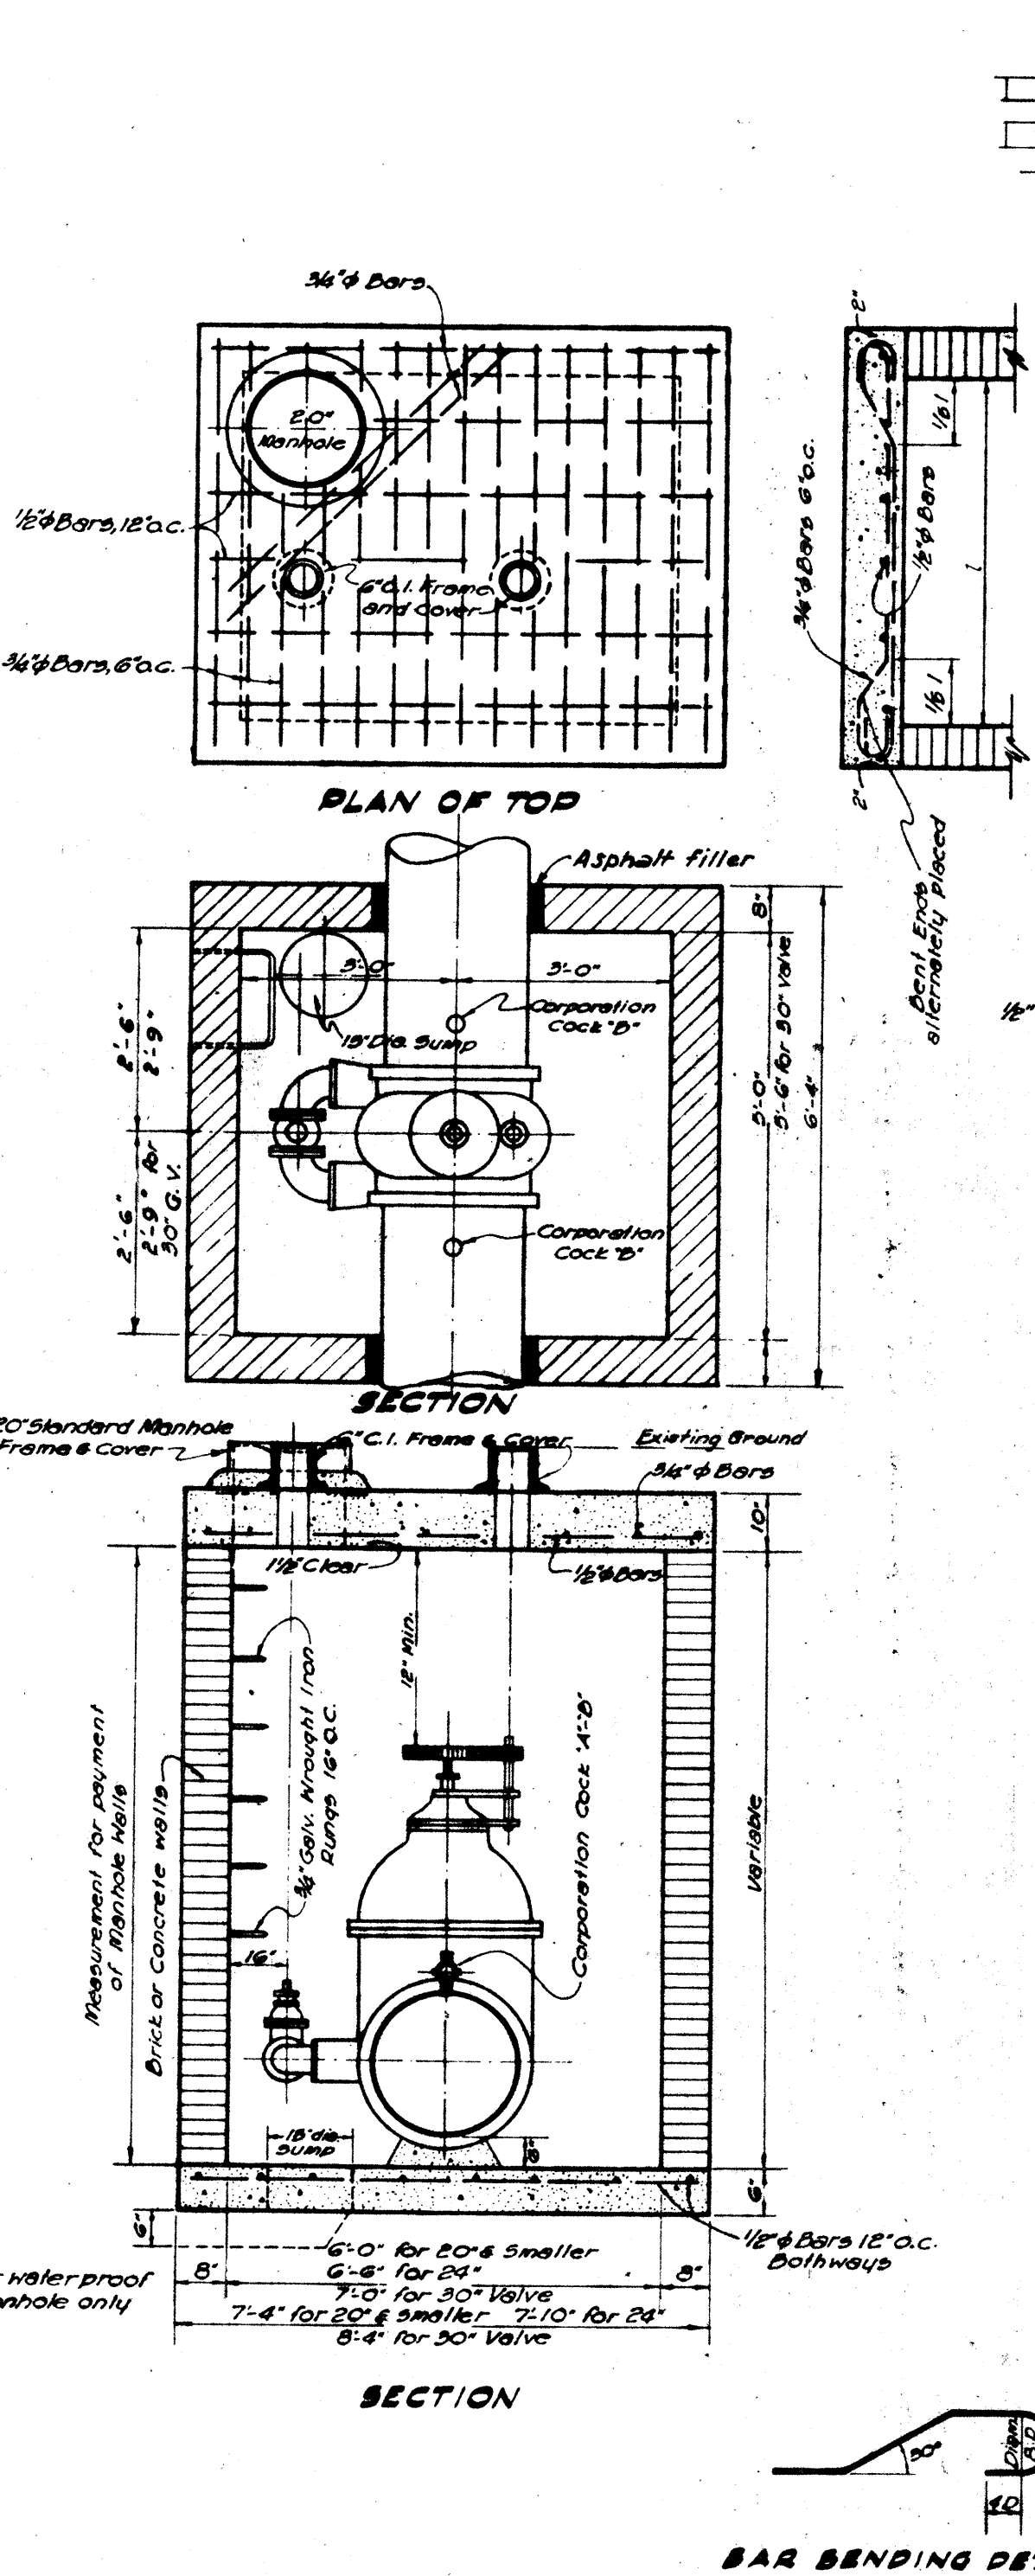




**TYPE "A" MANHOLE
FOR SPUR-GEARED GATE VALVES**

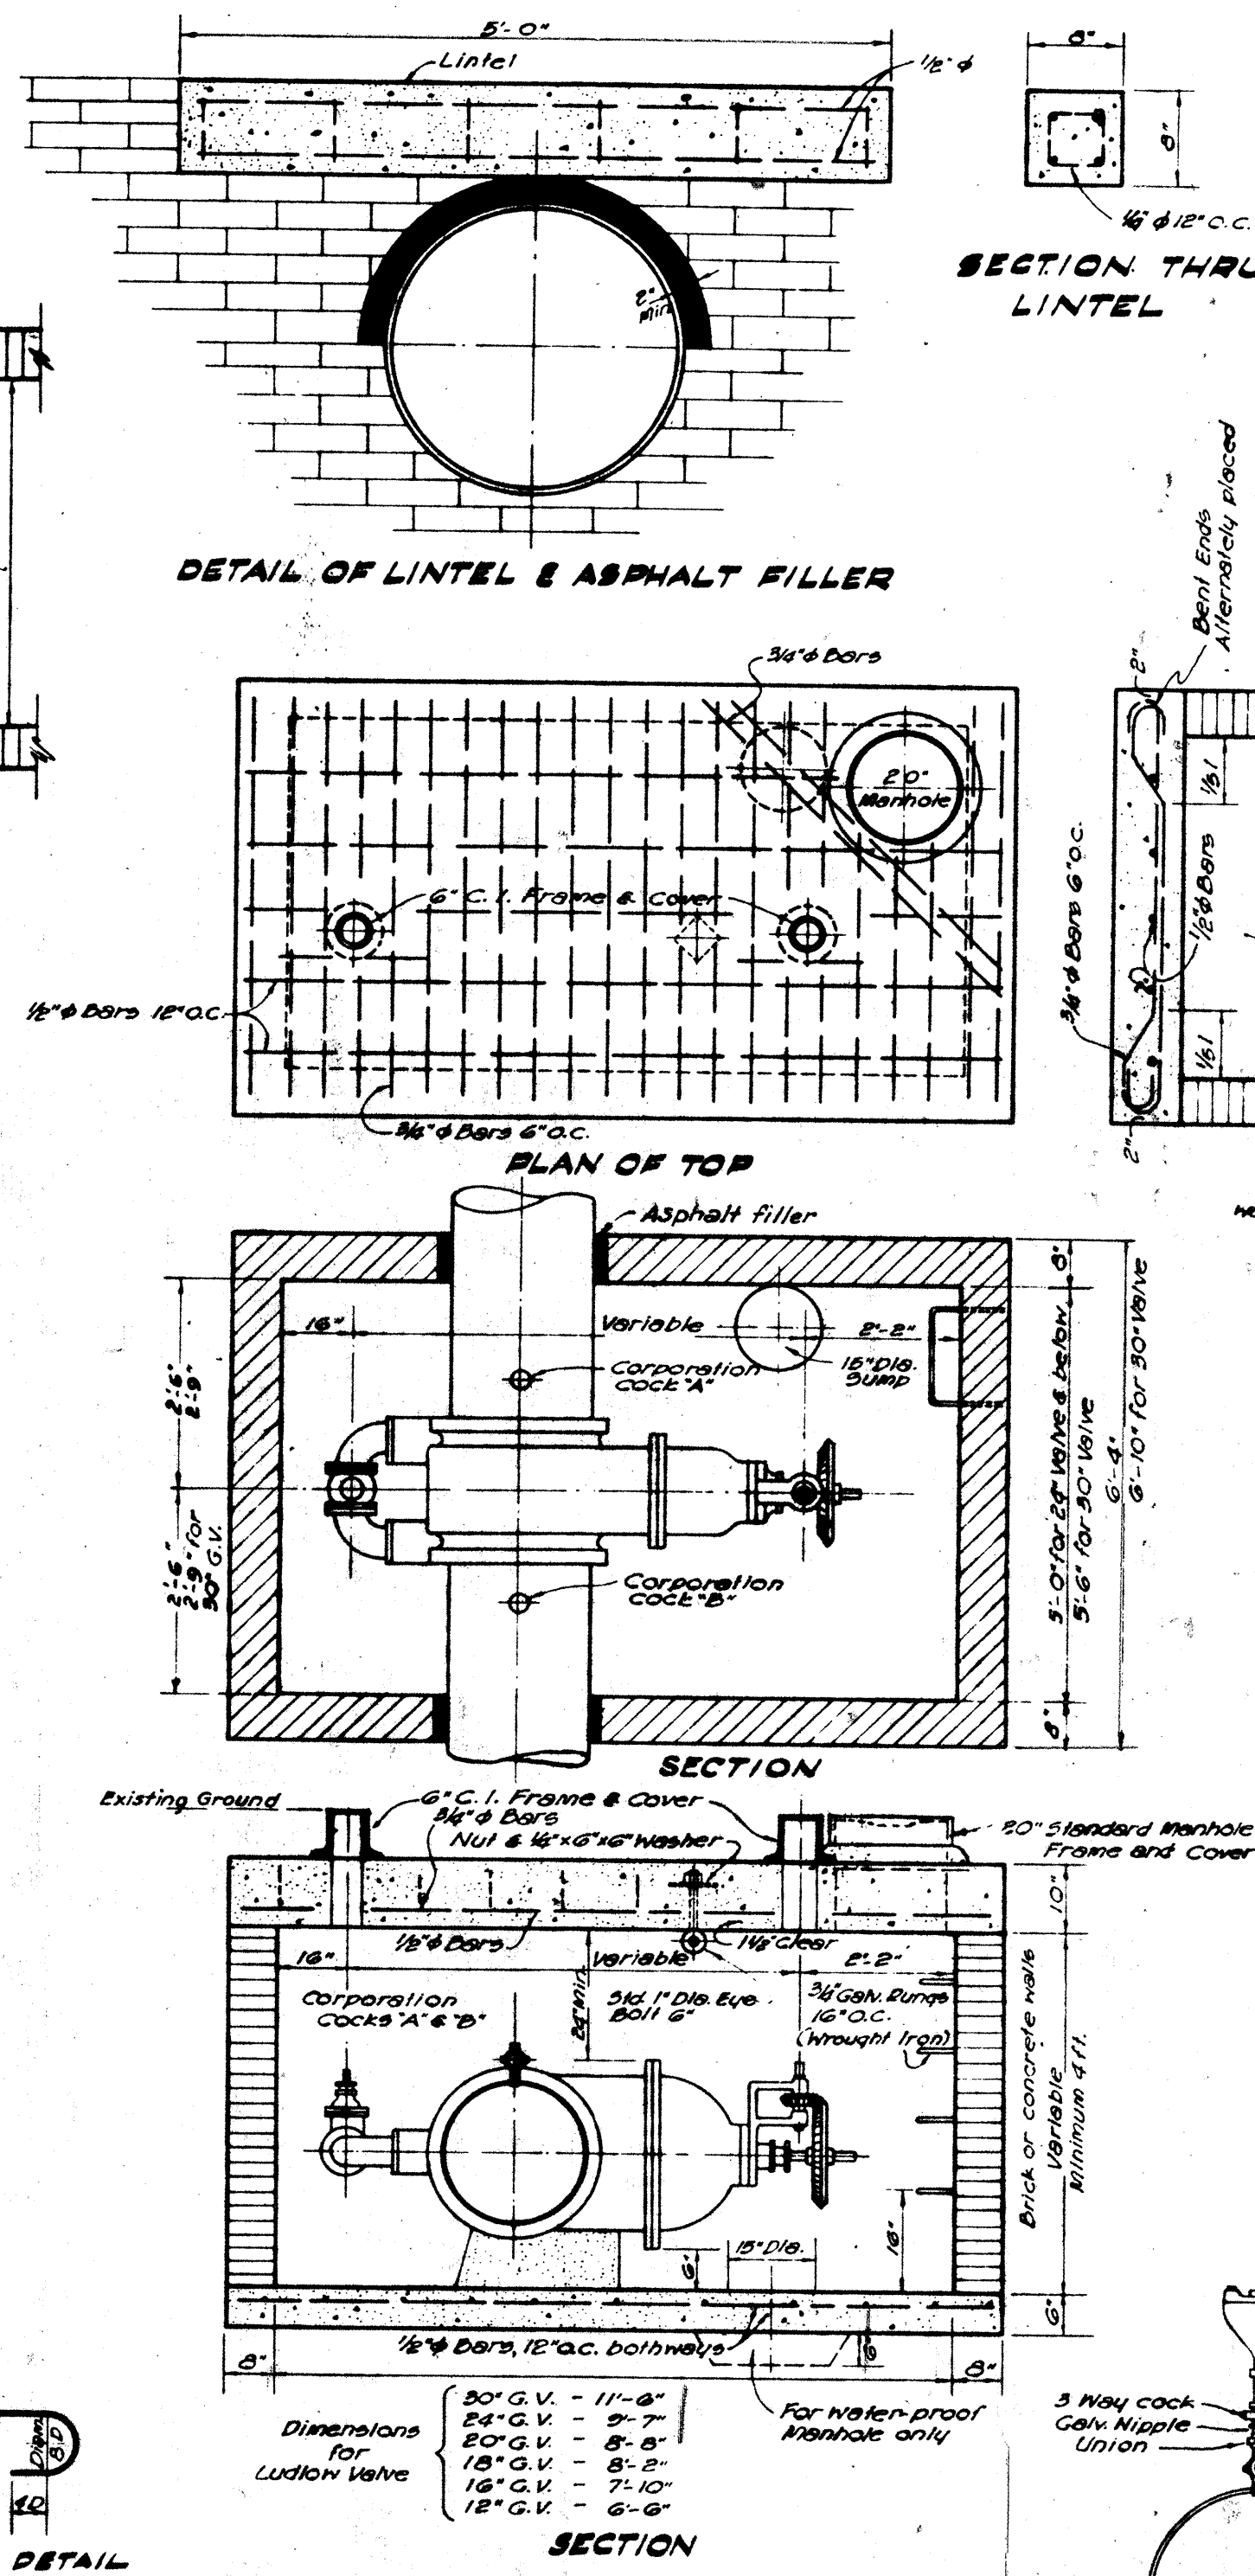


**TYPE "A" MANHOLE
FOR BEVEL GEARED GATE VALVES**

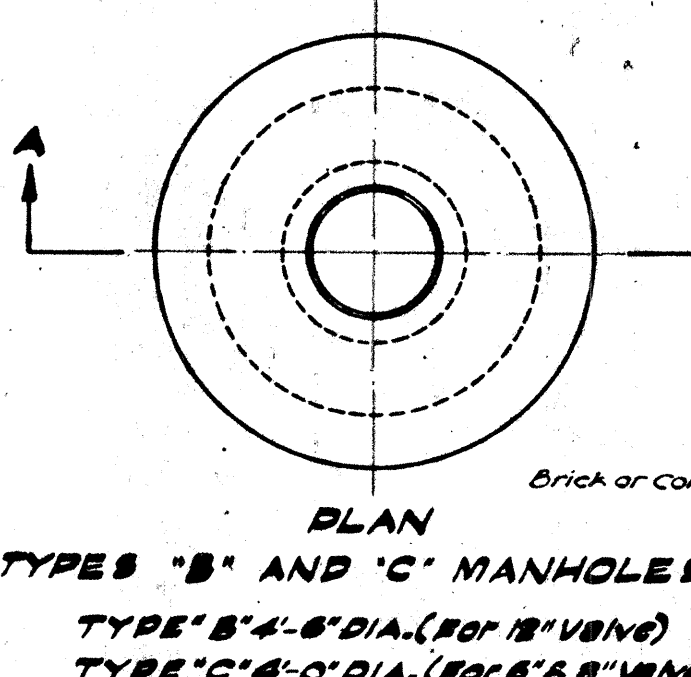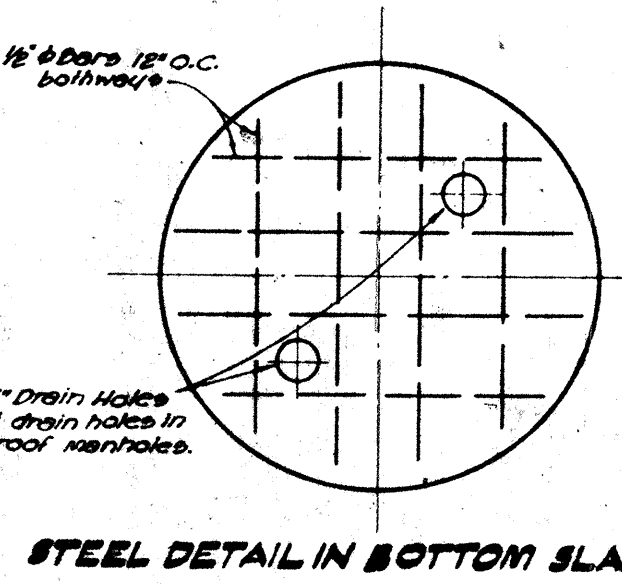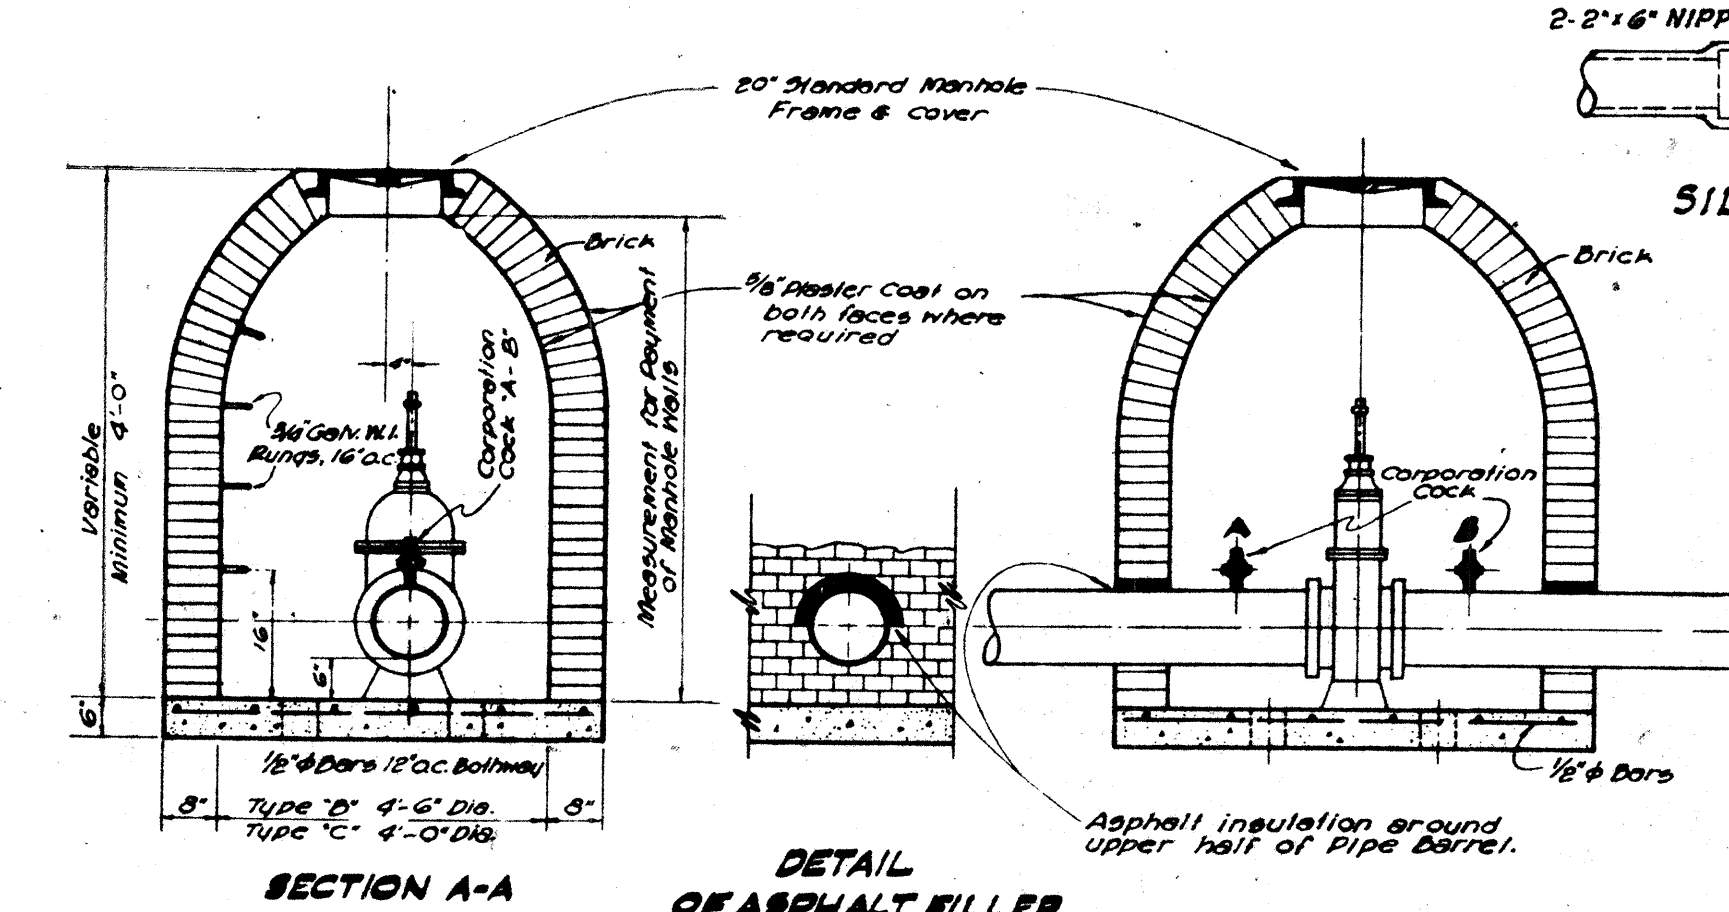

DETAIL OF RUNG

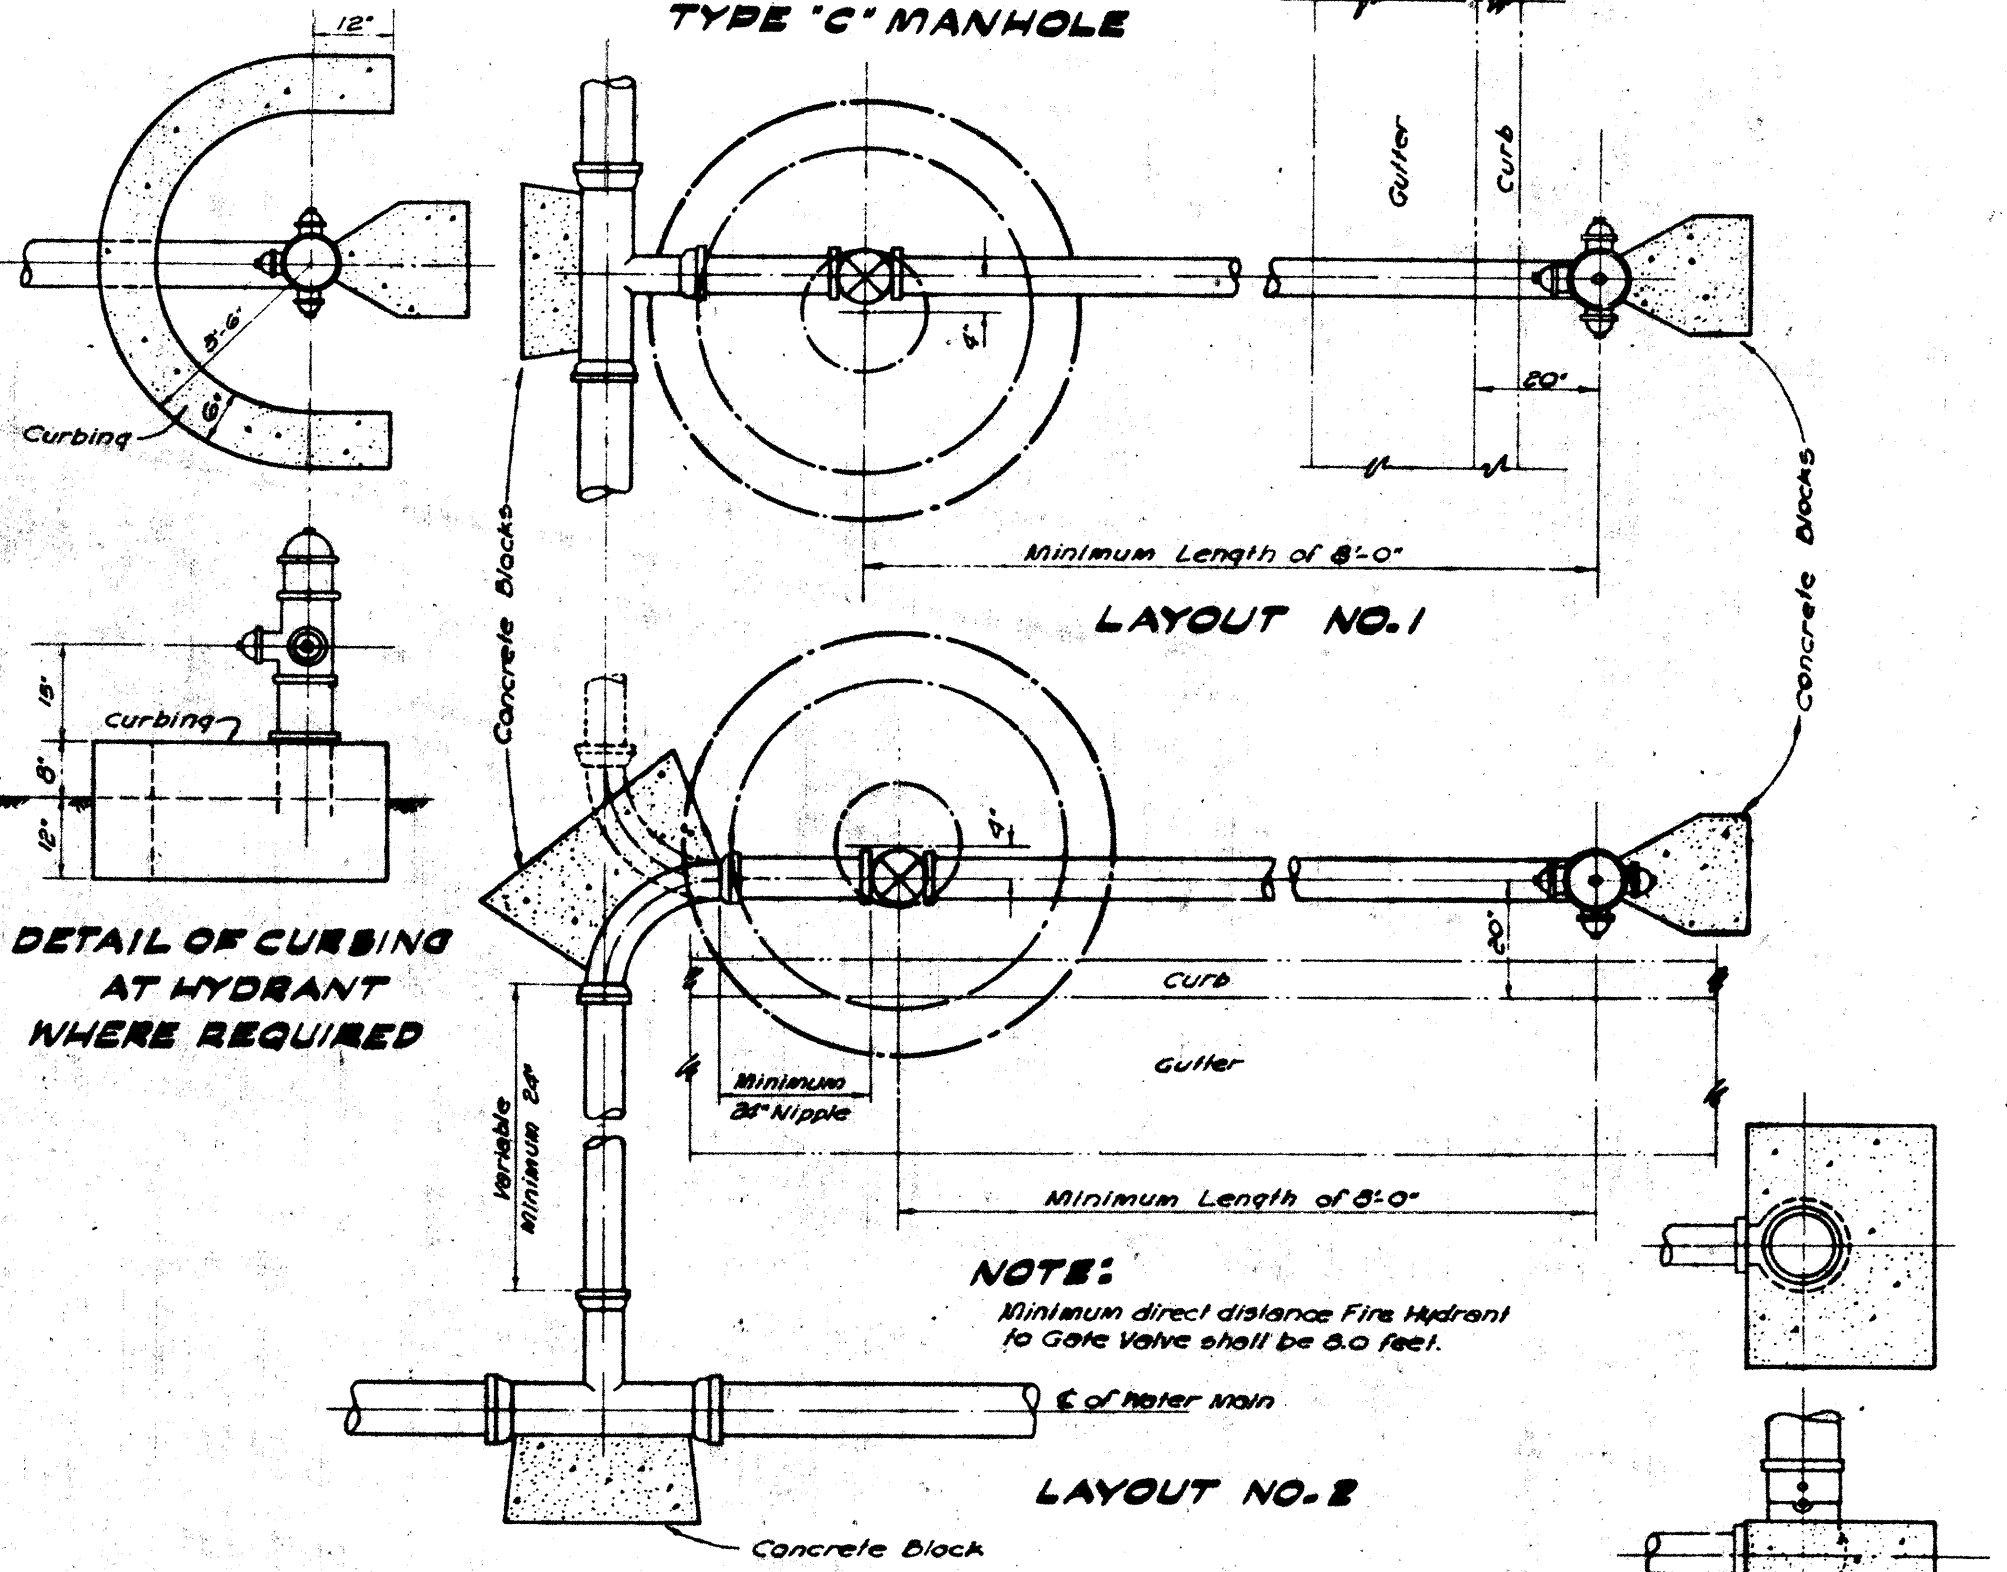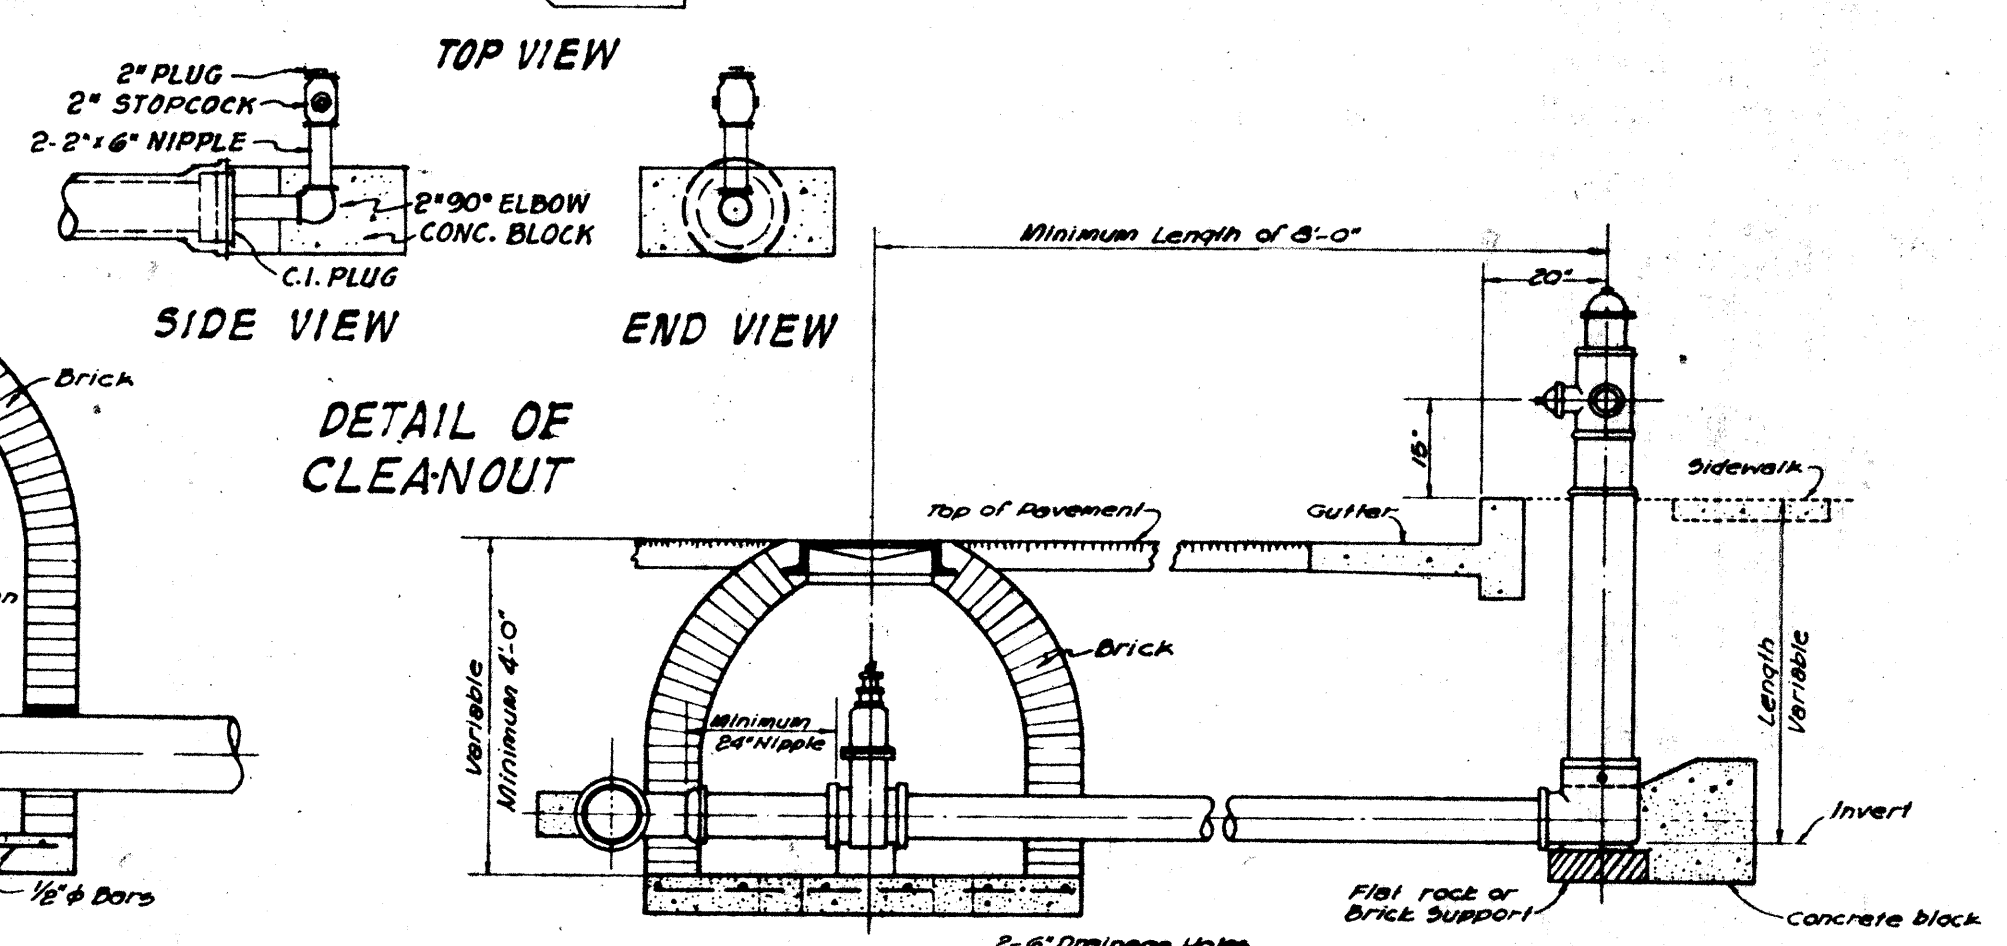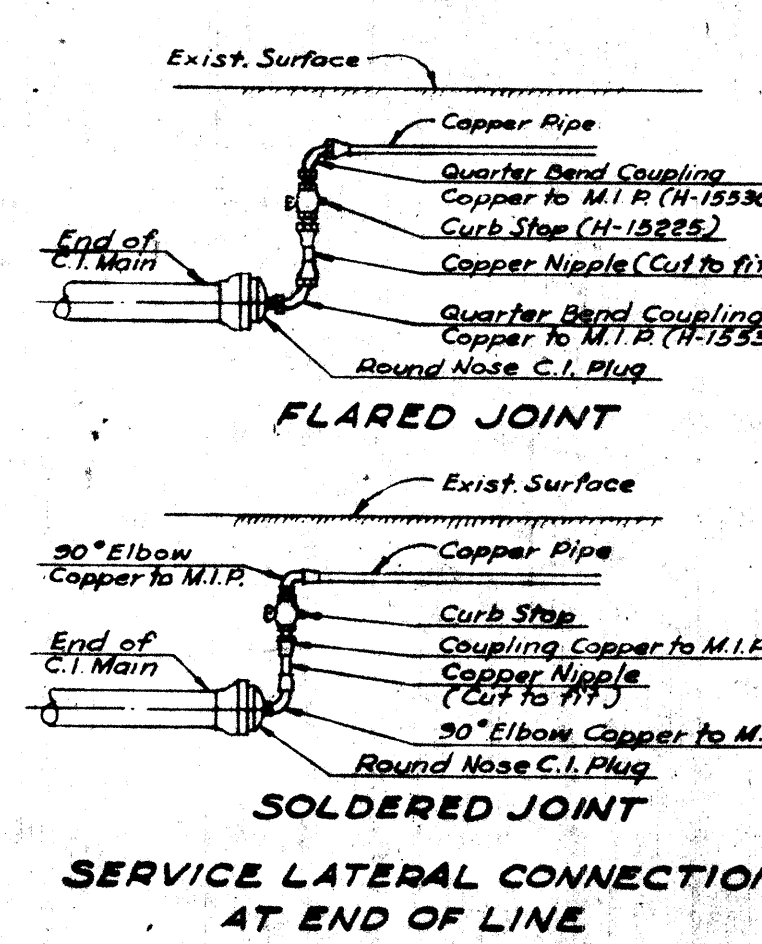

**CONCRETE BLOCK
FOR
MATHENS HYDRANT ONLY**

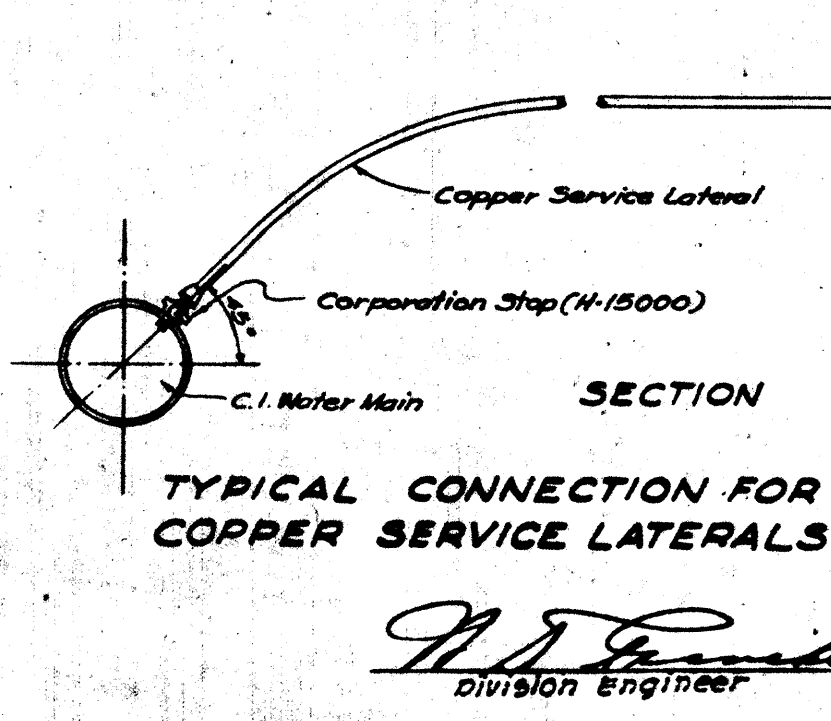

STANDARD DETAILS		DESIGN BY: D.A.
APPROVED: [Signature]		TRACED BY: P.H.
SCALE: 1/8" = 1'-0"		CHECKED BY: S.L.
DATE: Oct. 31, 1952		ENGINEER: W.S.F.
DRAWING NO. 1267		
BOARD OF WATER SUPPLY HONOLULU, T.H.		
TERRITORIAL HIGHWAY DEPARTMENT TERRITORY OF HAWAII		
NUUANU AVENUE PROJ. NO. U-061-1(4)		
Dec. 2, 1957		

