




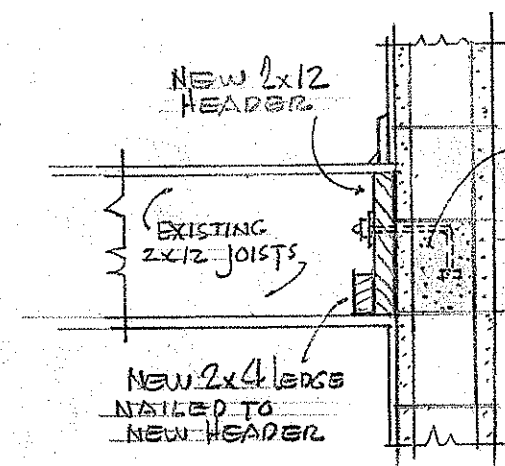

⑥

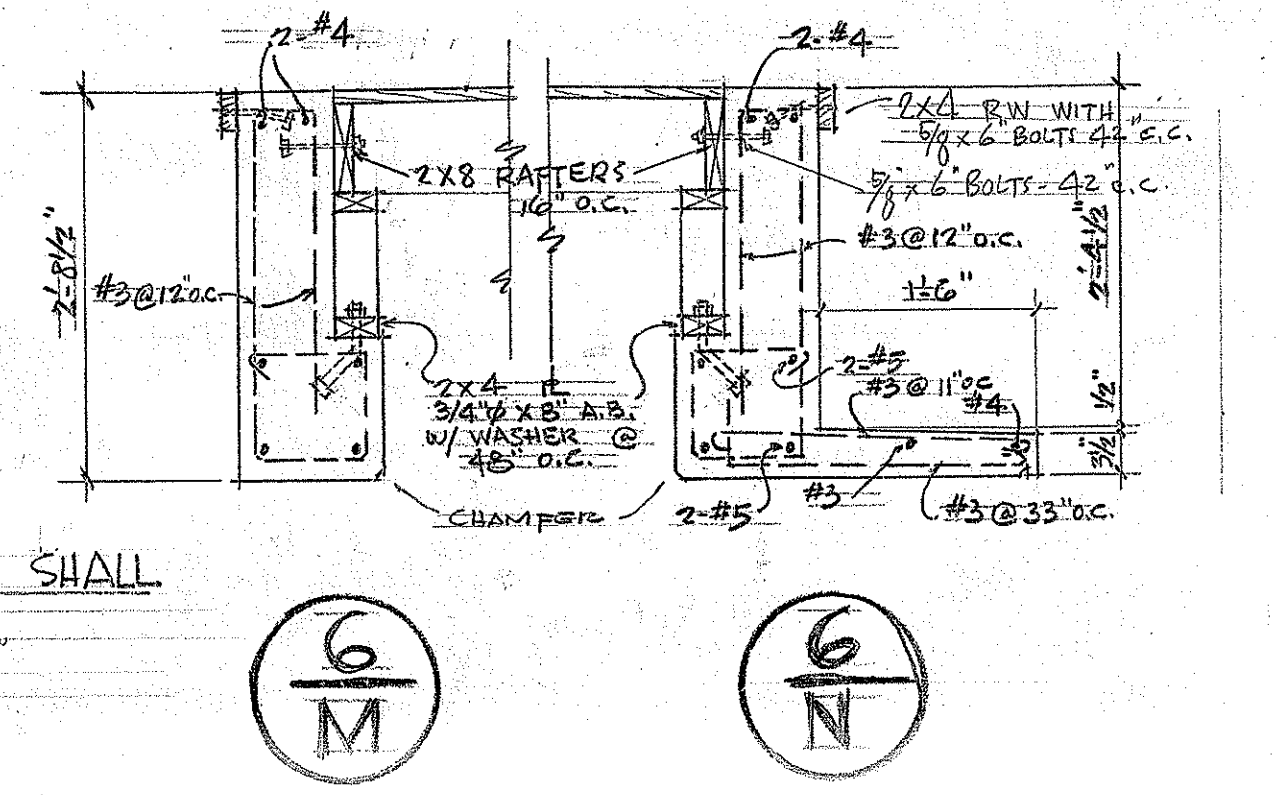

TRUSS DETAIL SCALE: 1/2" = 1'-0"

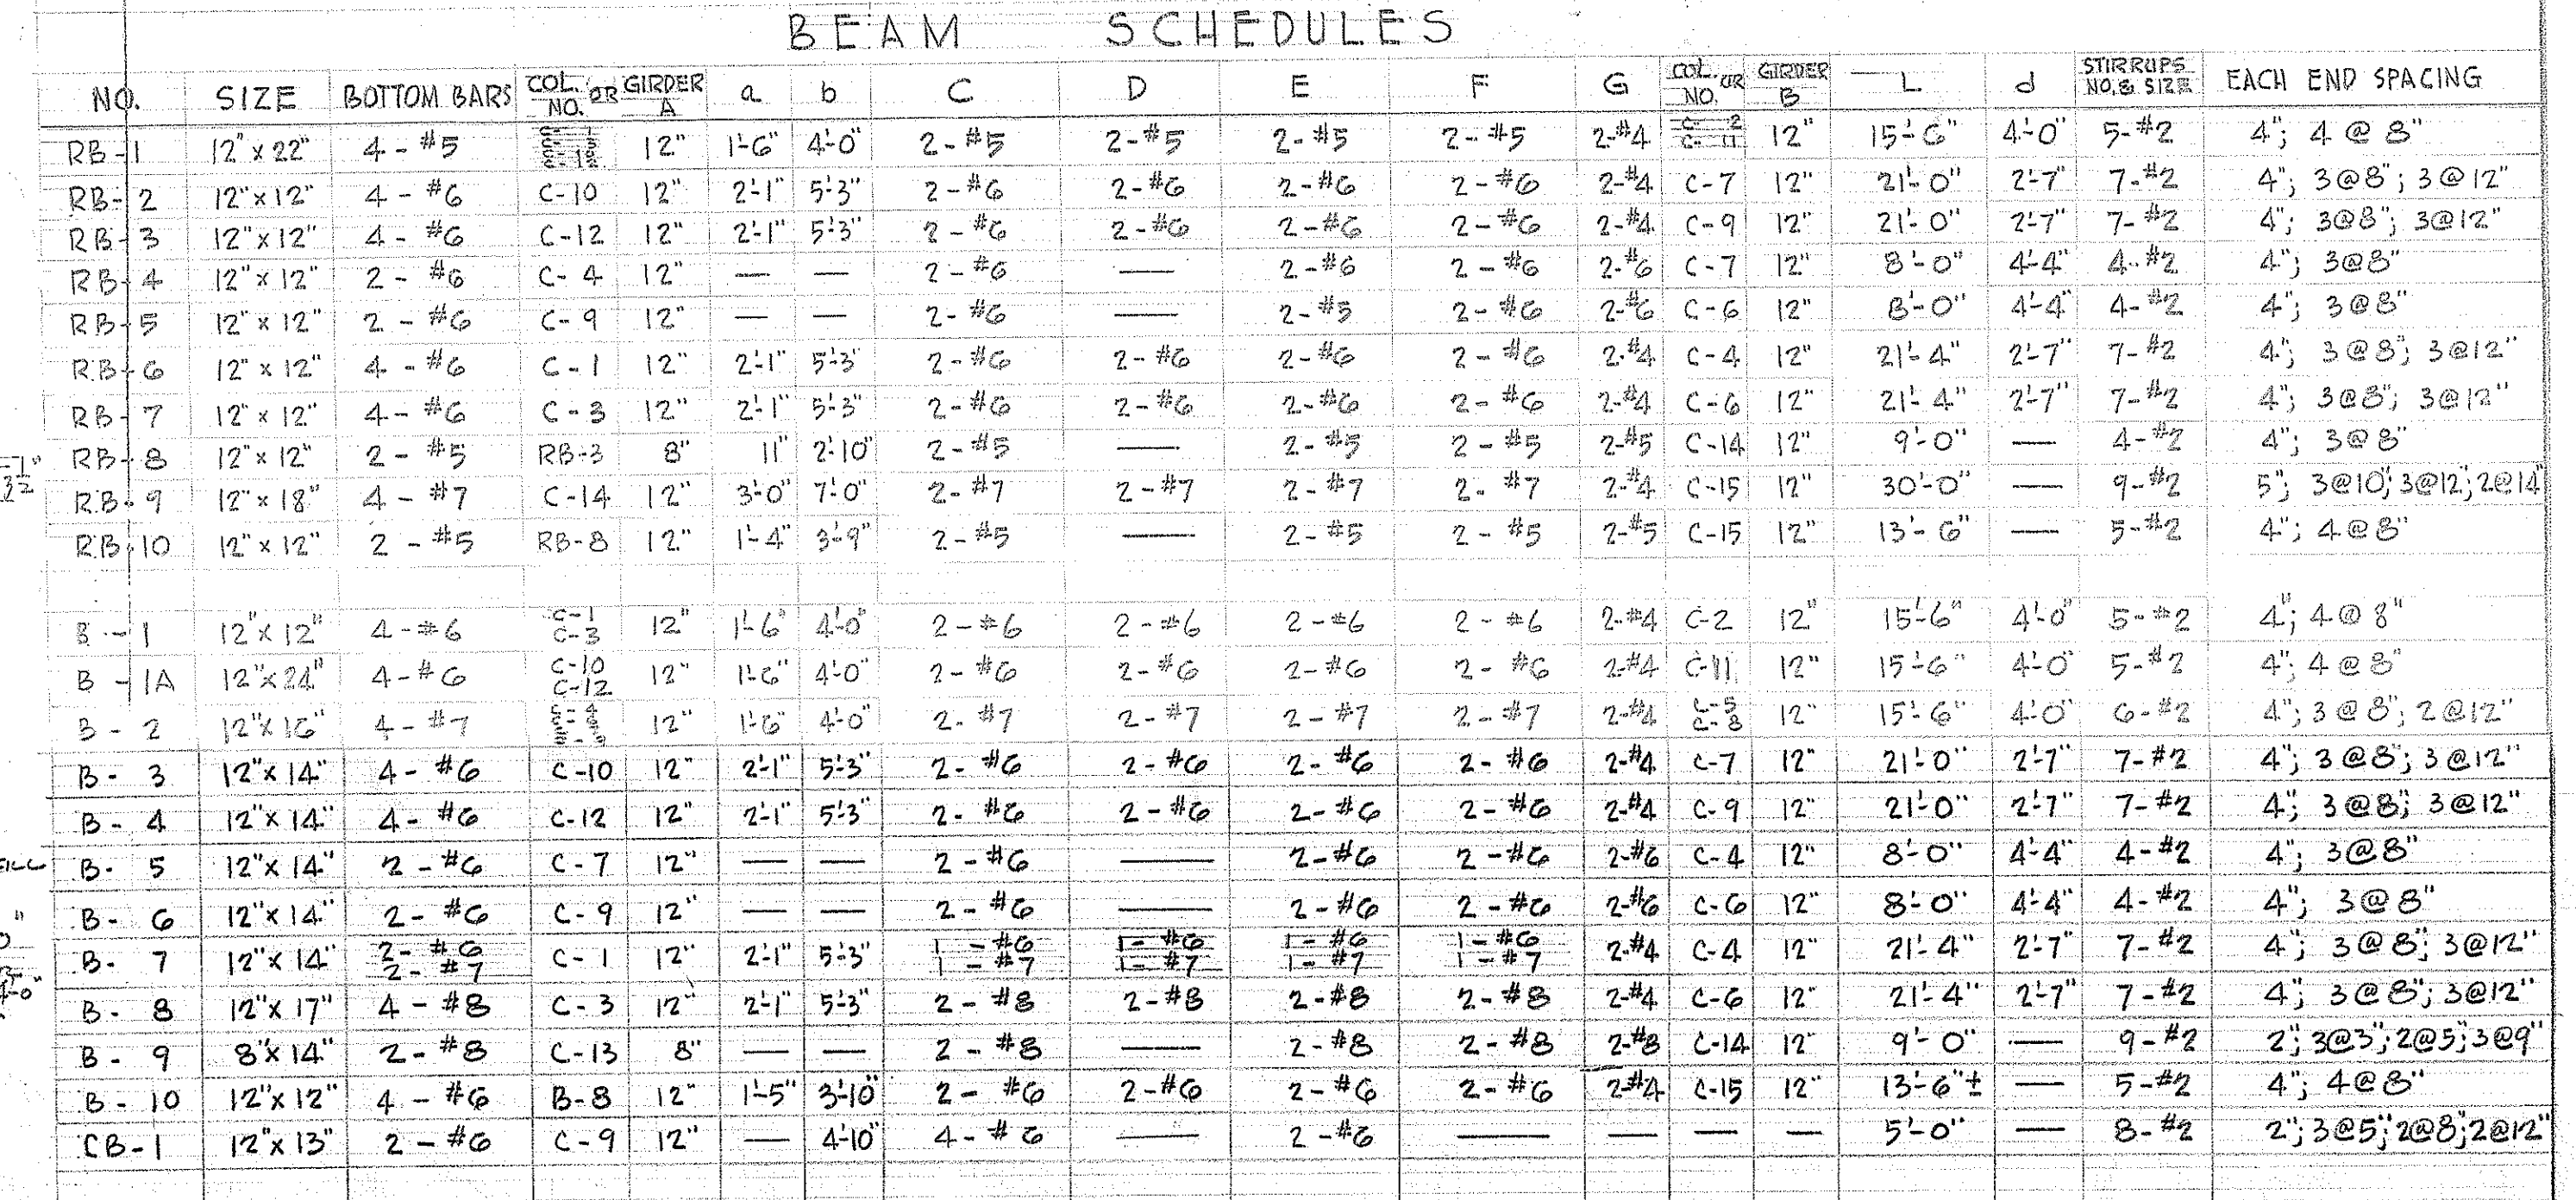

TERRITORIAL HIGHWAY DEPARTMENT		
TERRITORY OF HAWAII		
REHABILITATION OF CERTAIN EXISTG. IMPROVEMENTS ON SCHOOL PREMISES OF HONPA HONGWANJI MISSION OF HAWAII		
FORT ST. HONOLULU, T.H.		
IN CONNECTION WITH NUBUANU HIGHWAY PROJECT NO BU - OG 1 - 1 (6)		
DATE JULY 1958	ROBERT T. KATSYUOSHI - ARCHITECT BEGO FUCHINO - ENGINEER 218 N. QUEEN ST HONOLULU 17, TH	SHEET 6 OF 18 SHTS