



FED. ROAD DIST. NO.	STATE	FED. AID PROJ. NO.	FISCAL YEAR	SHEET NO.	TOTAL SHEETS
HAWAII	HAW.	BU-061-1(6)	1958	22	148


REVISION
No. 2 - 14 July 59 - Location & corresponding details of stairway on retaining wall no. 16 changed.

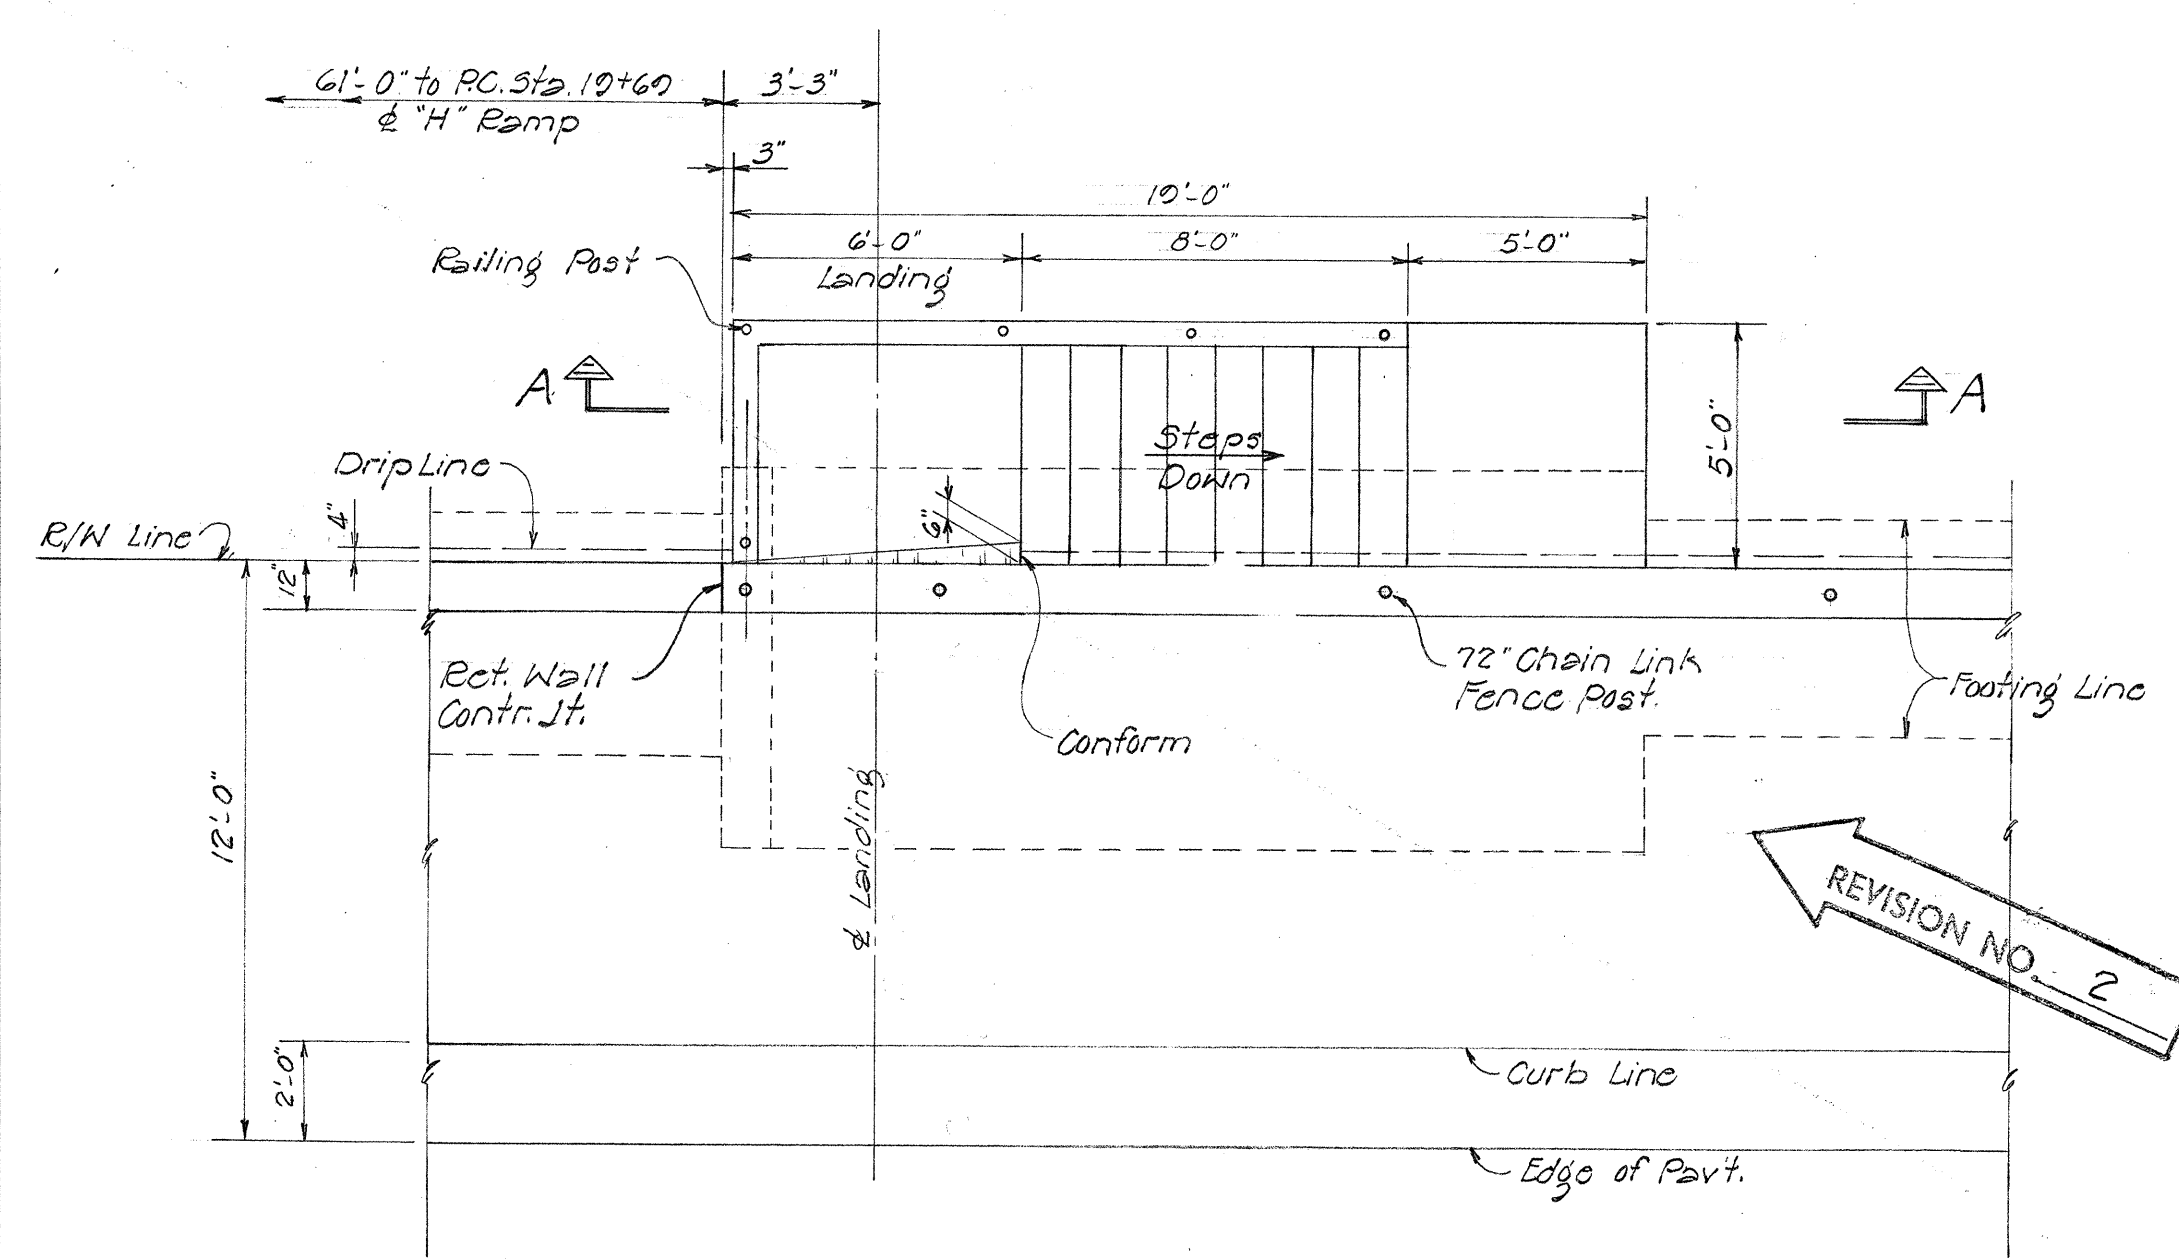

LAYOUT PLAN
Scale - 1/4" = 1'-0"

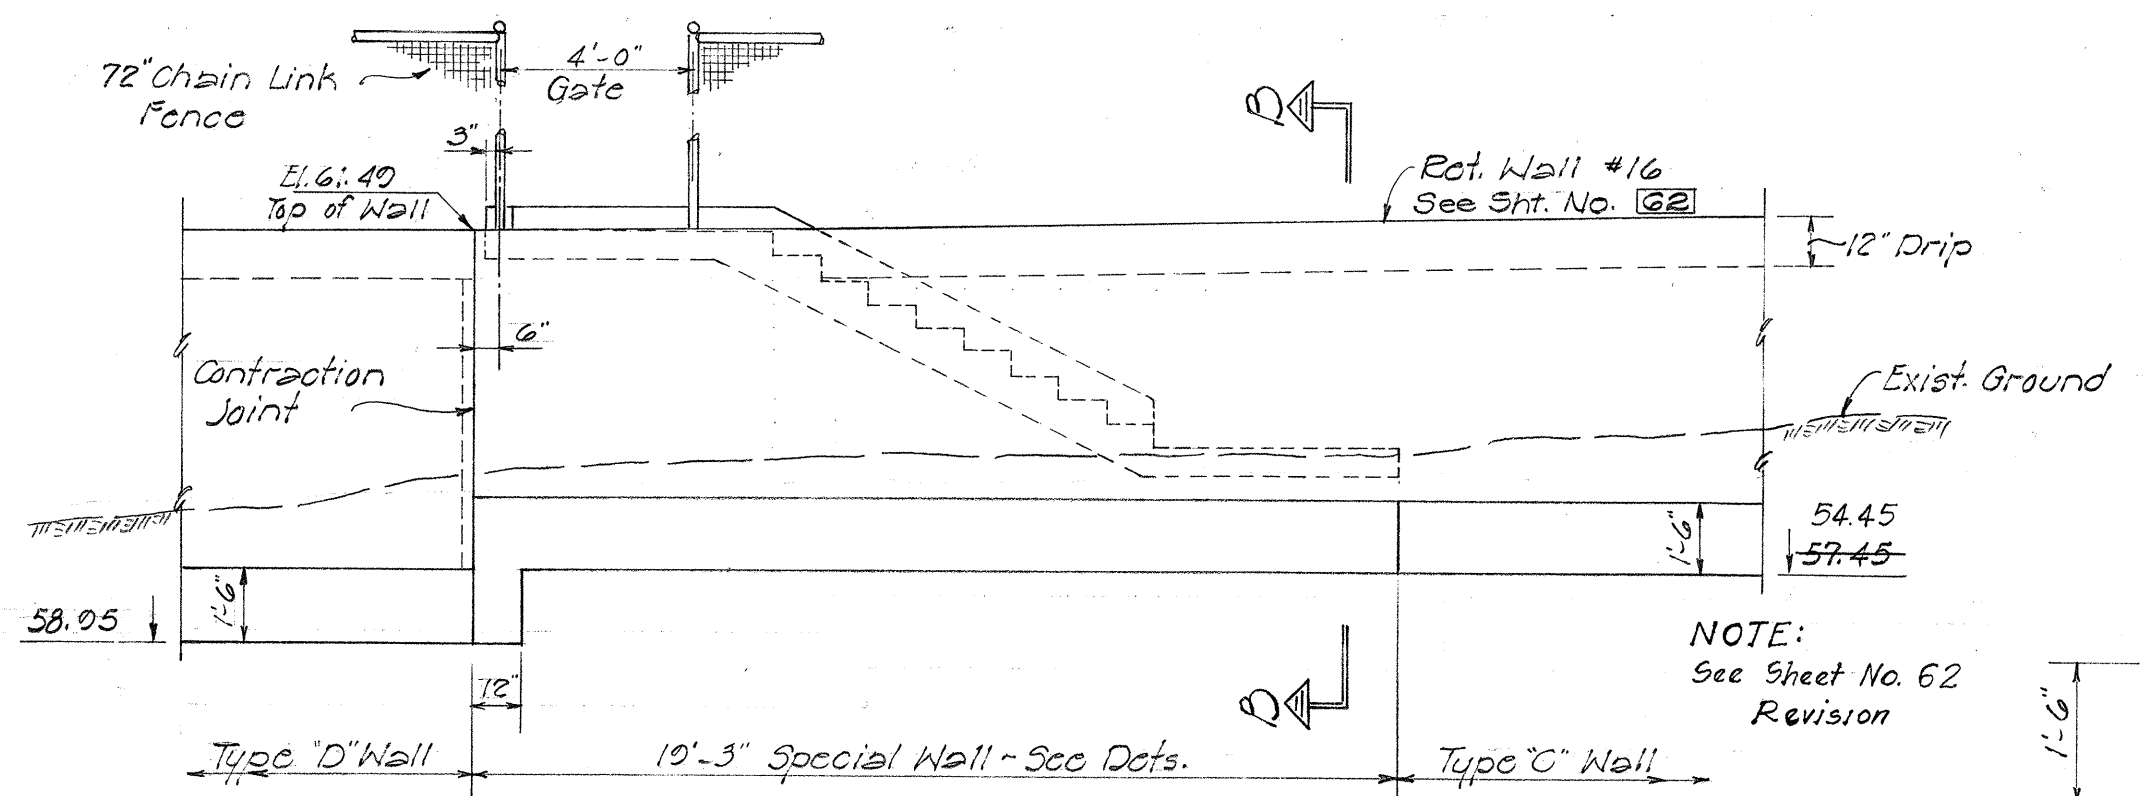

ELEVATION
Scale - 1/4" = 1'-0"

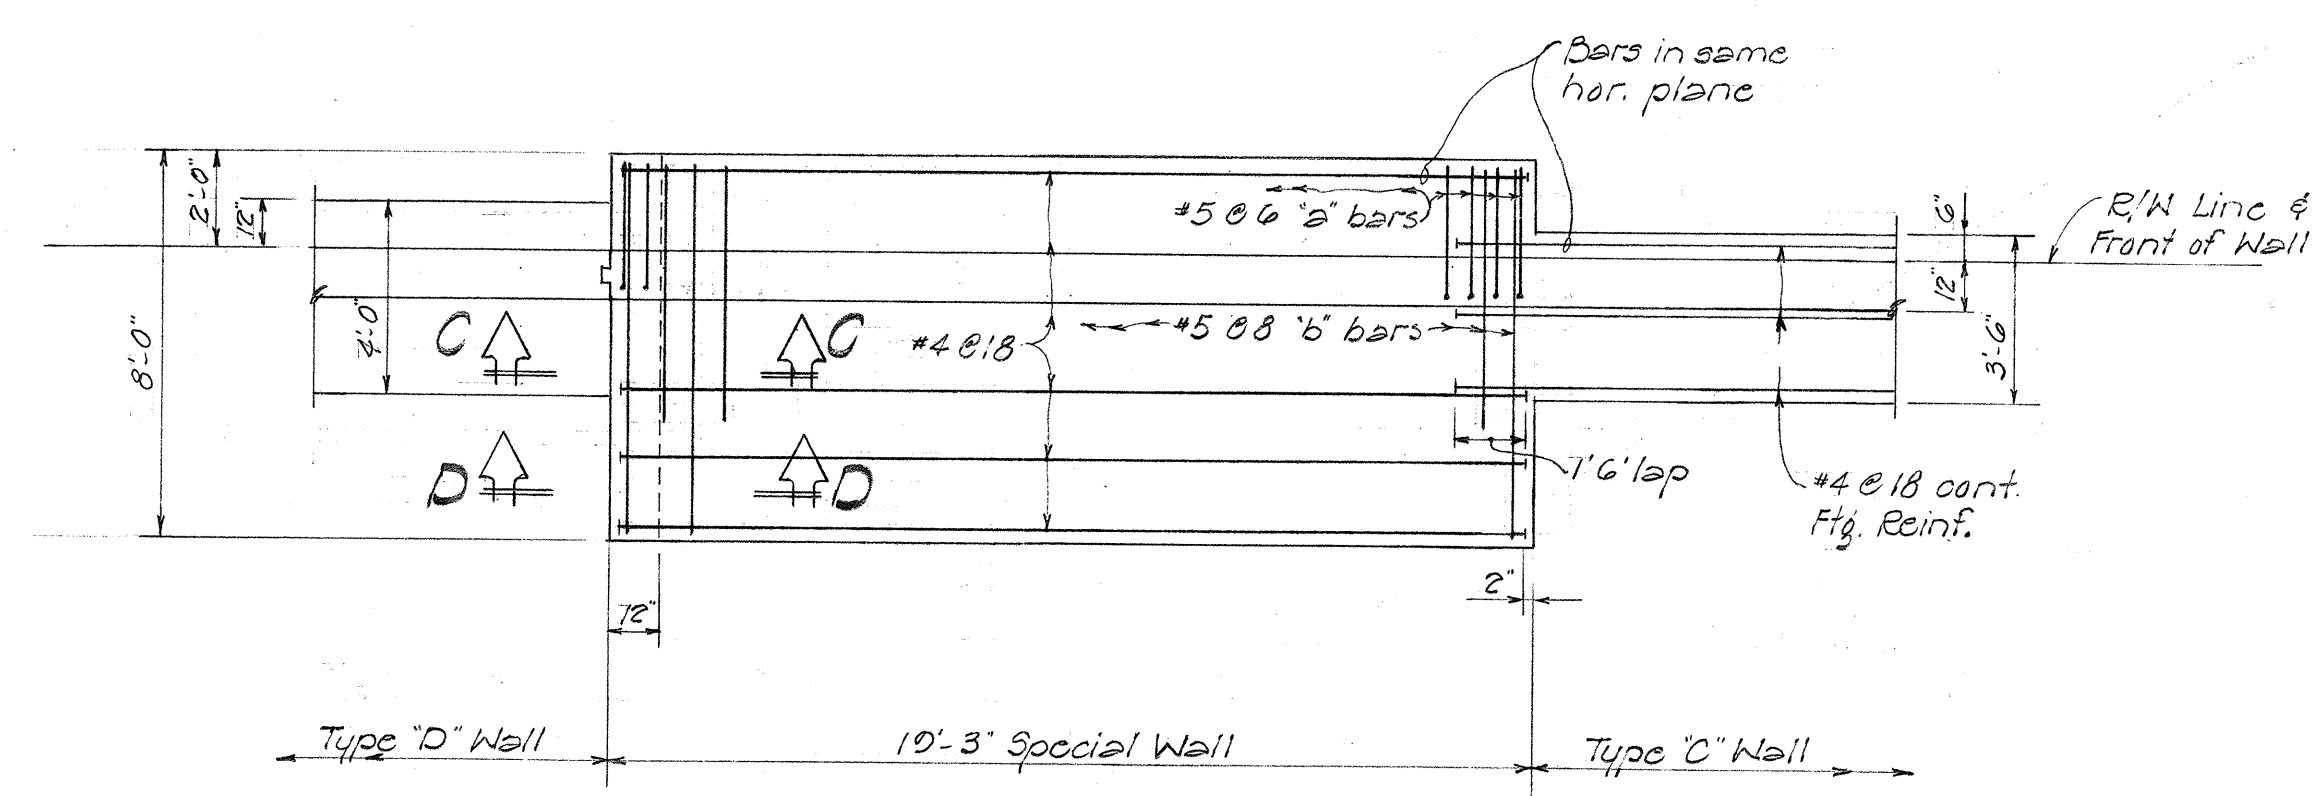


FOOTING REINF. PLAN
Scale - 1/4" = 1'-0"


ESTIMATED QUANTITIES

Class A-1 Conc.	=	3.0	C.Y.
Reinf. Steel	=	430	Lbs.
Pipe Railing	=	20	Lin. Ft.


Note: Quantities for Special Wall included with Ret. Wall #16.

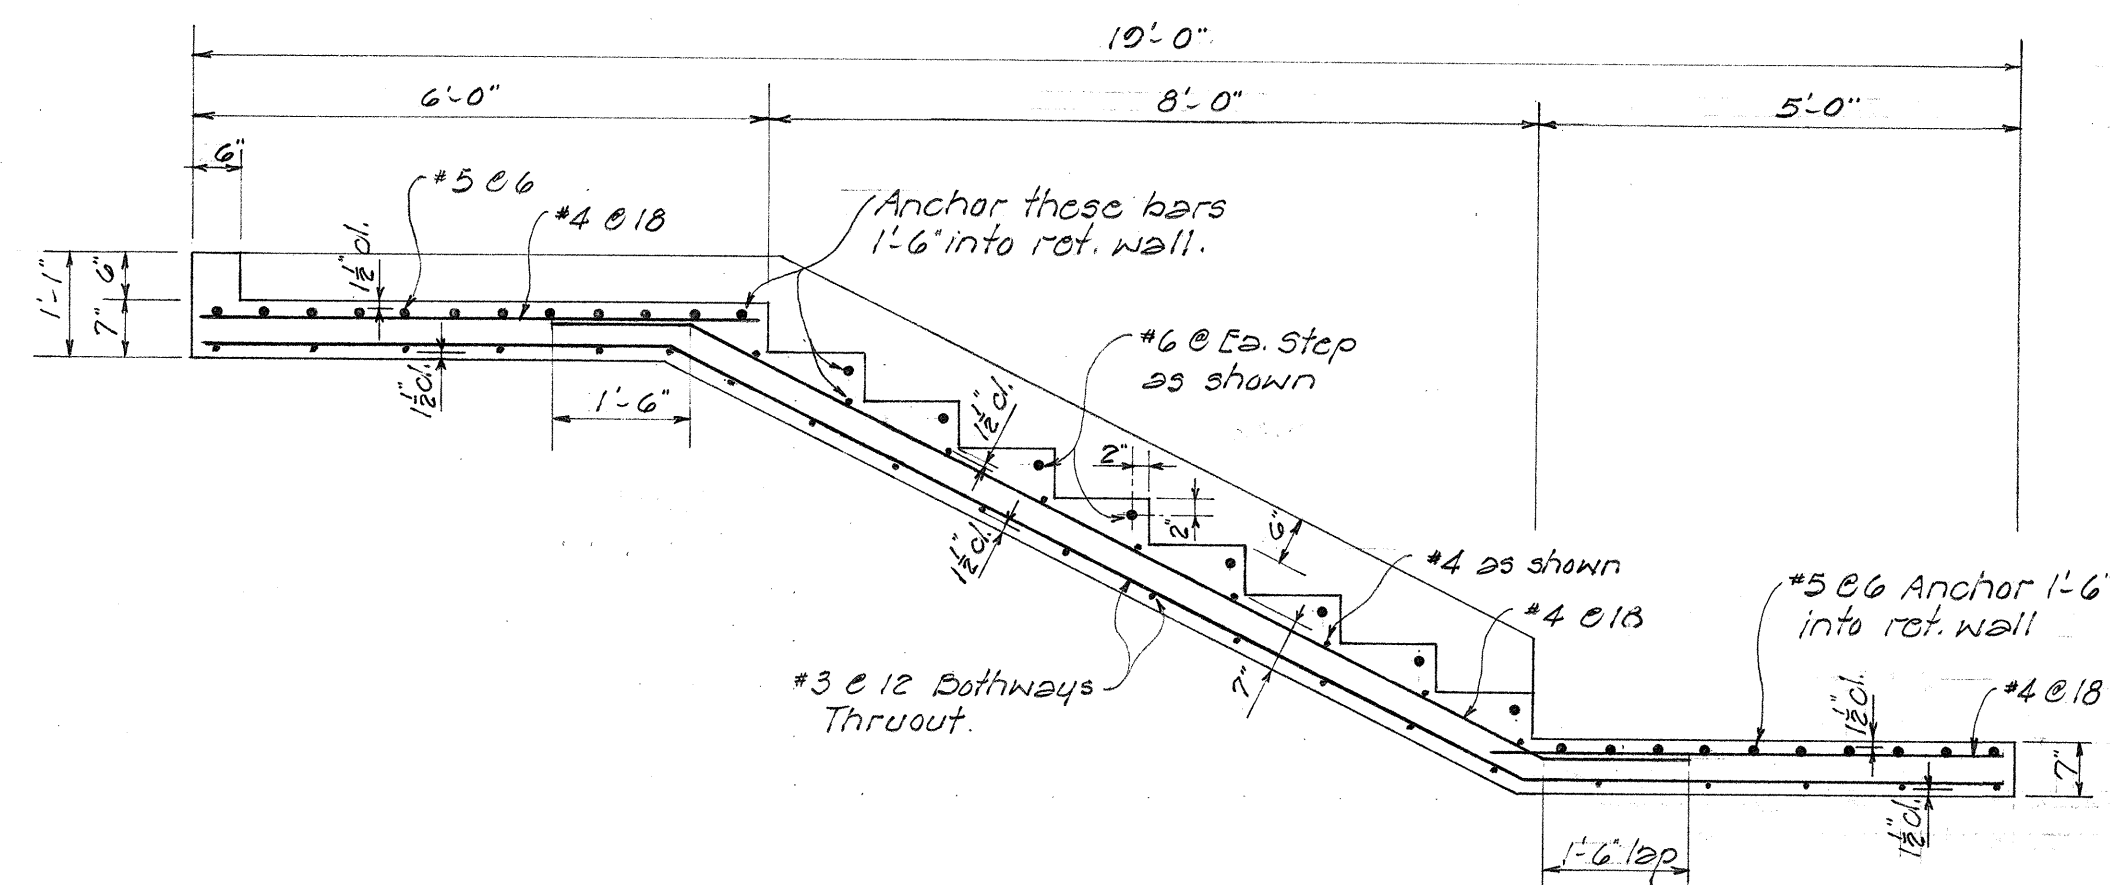


SECTION A-A
Scale - 1/2" = 1'-0"

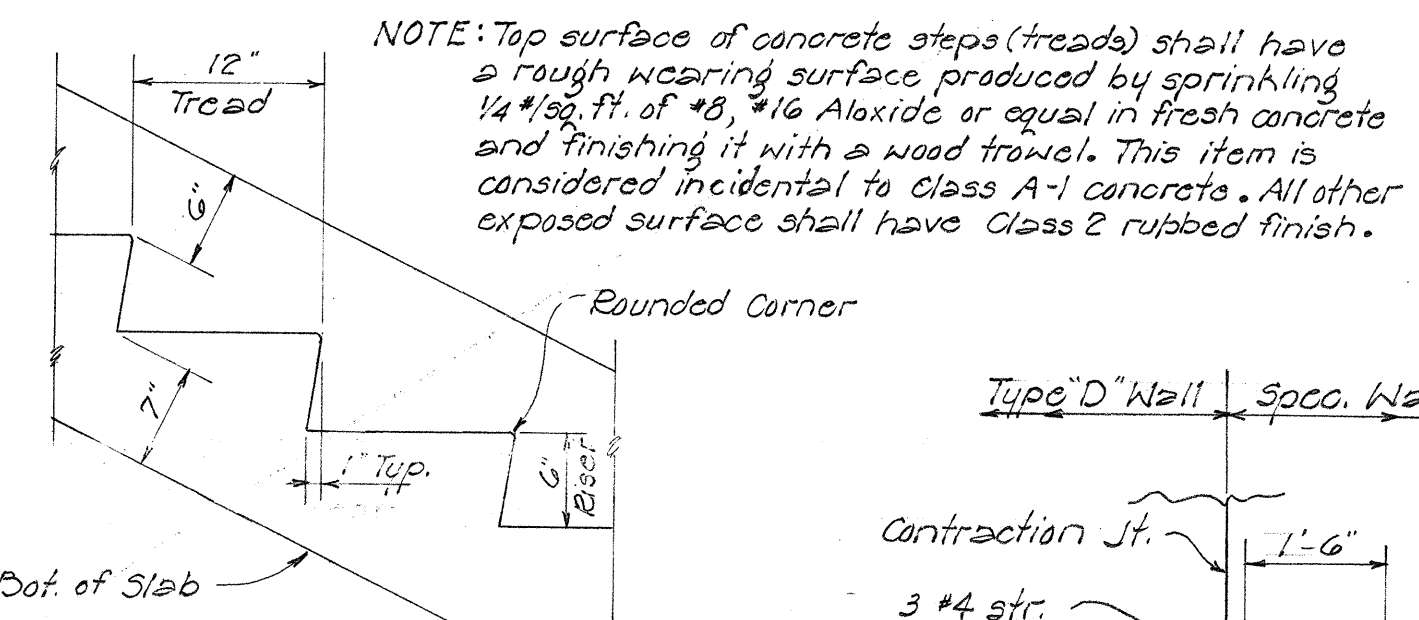


TYP. STEP DET.
Scale - 1" = 1'-0"

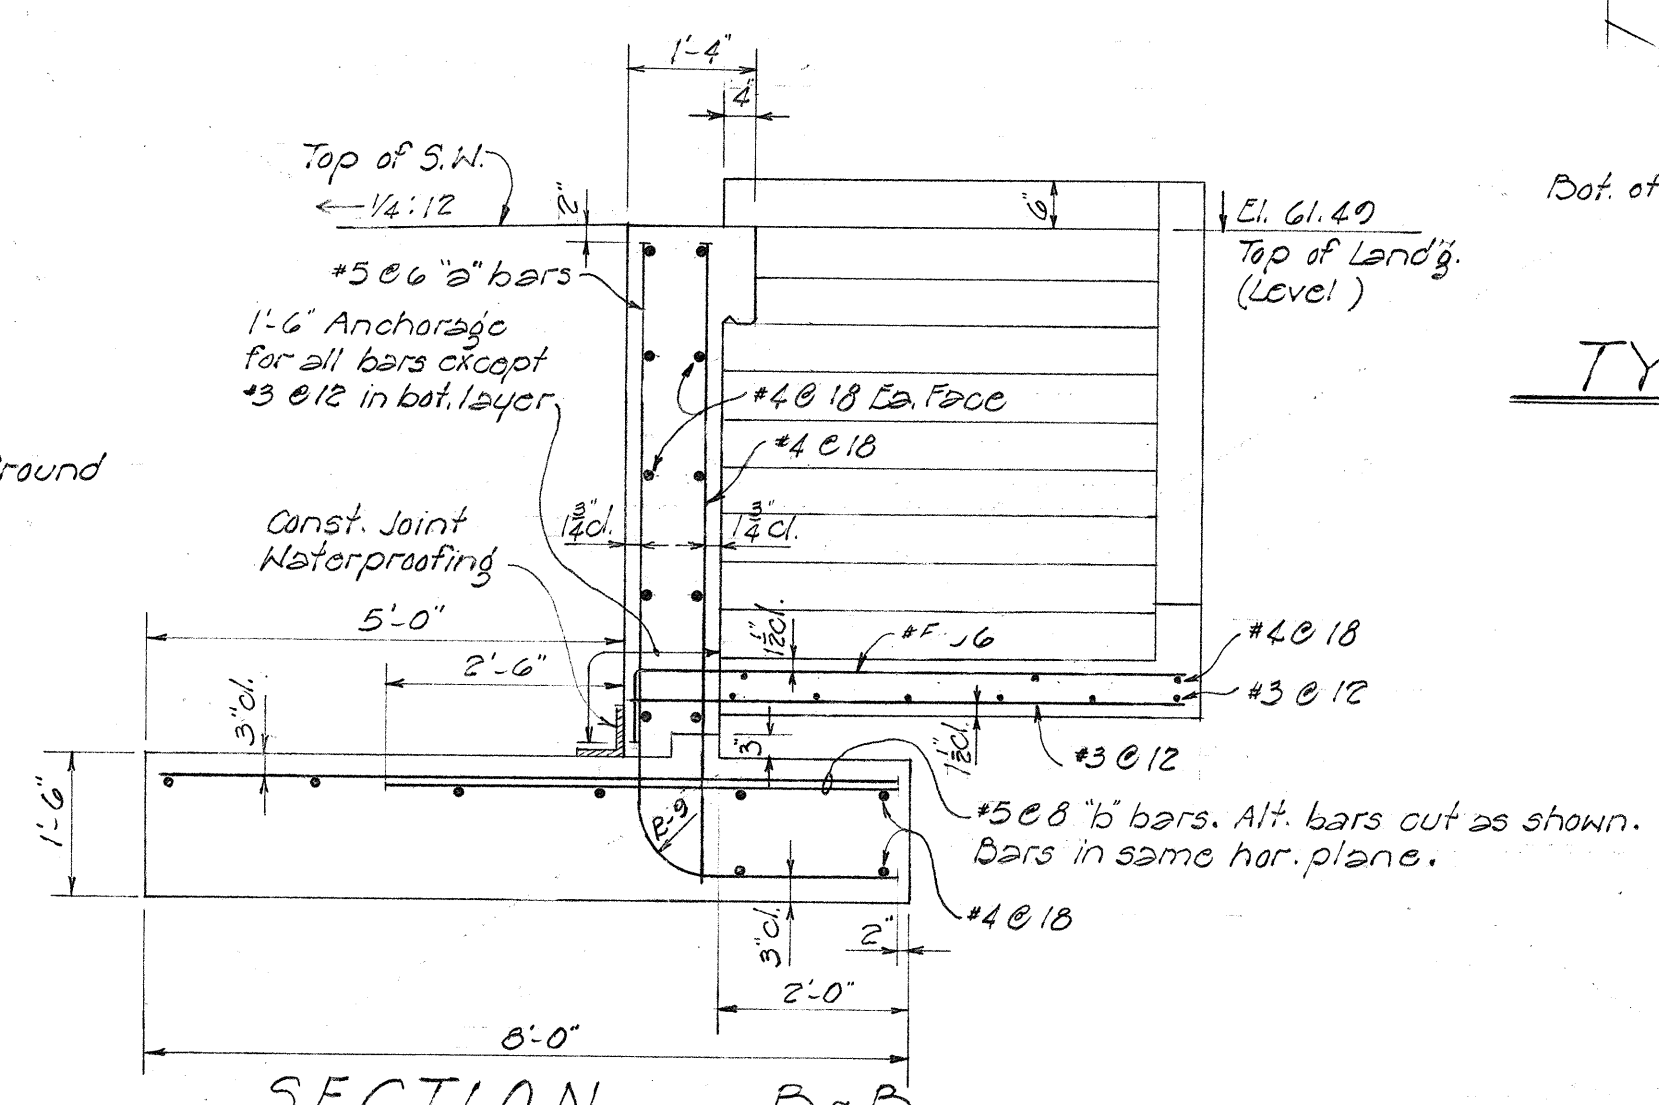


SECTION B-B
TYP. SECTION - SPEC. WALL
Scale - 1/2" = 1'-0"

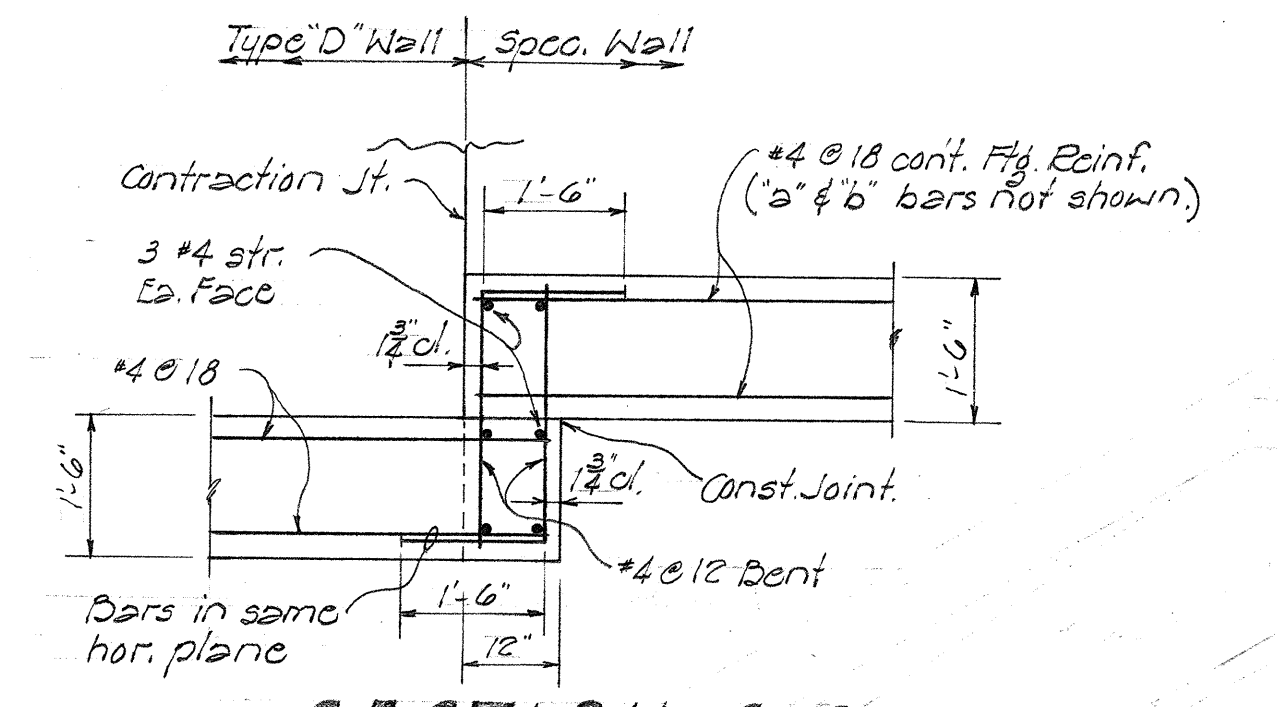

SECTION C-C
Scale - 1/2" = 1'-0"

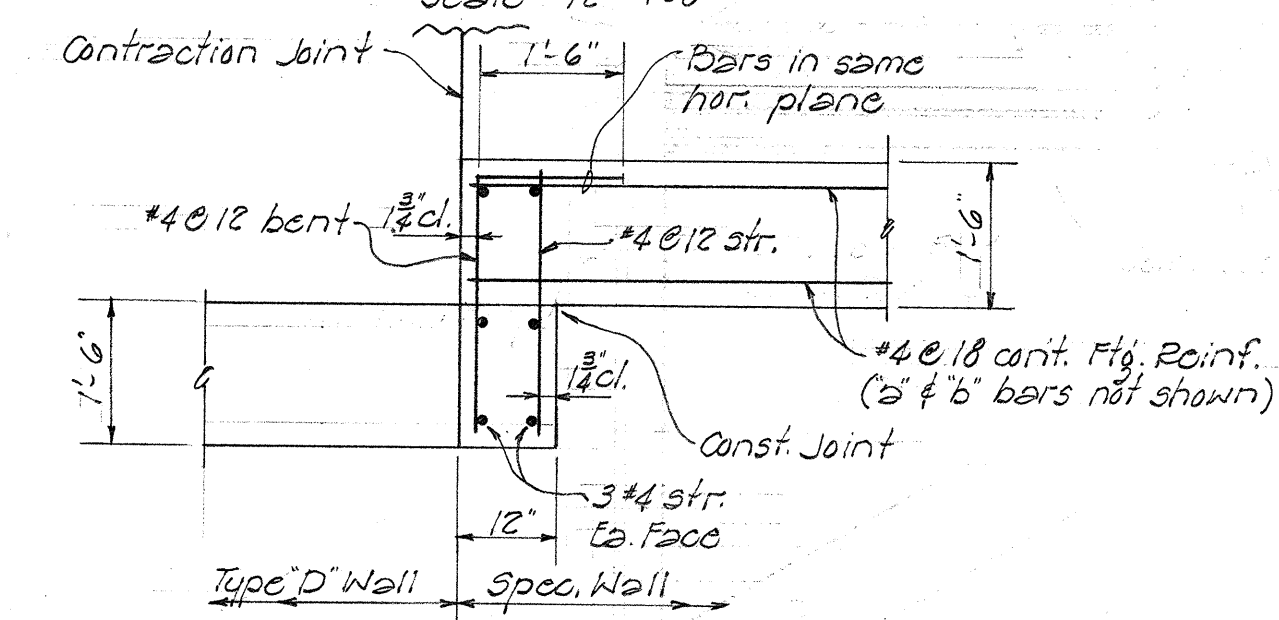

SECTION D-D
Scale - 1/2" = 1'-0"

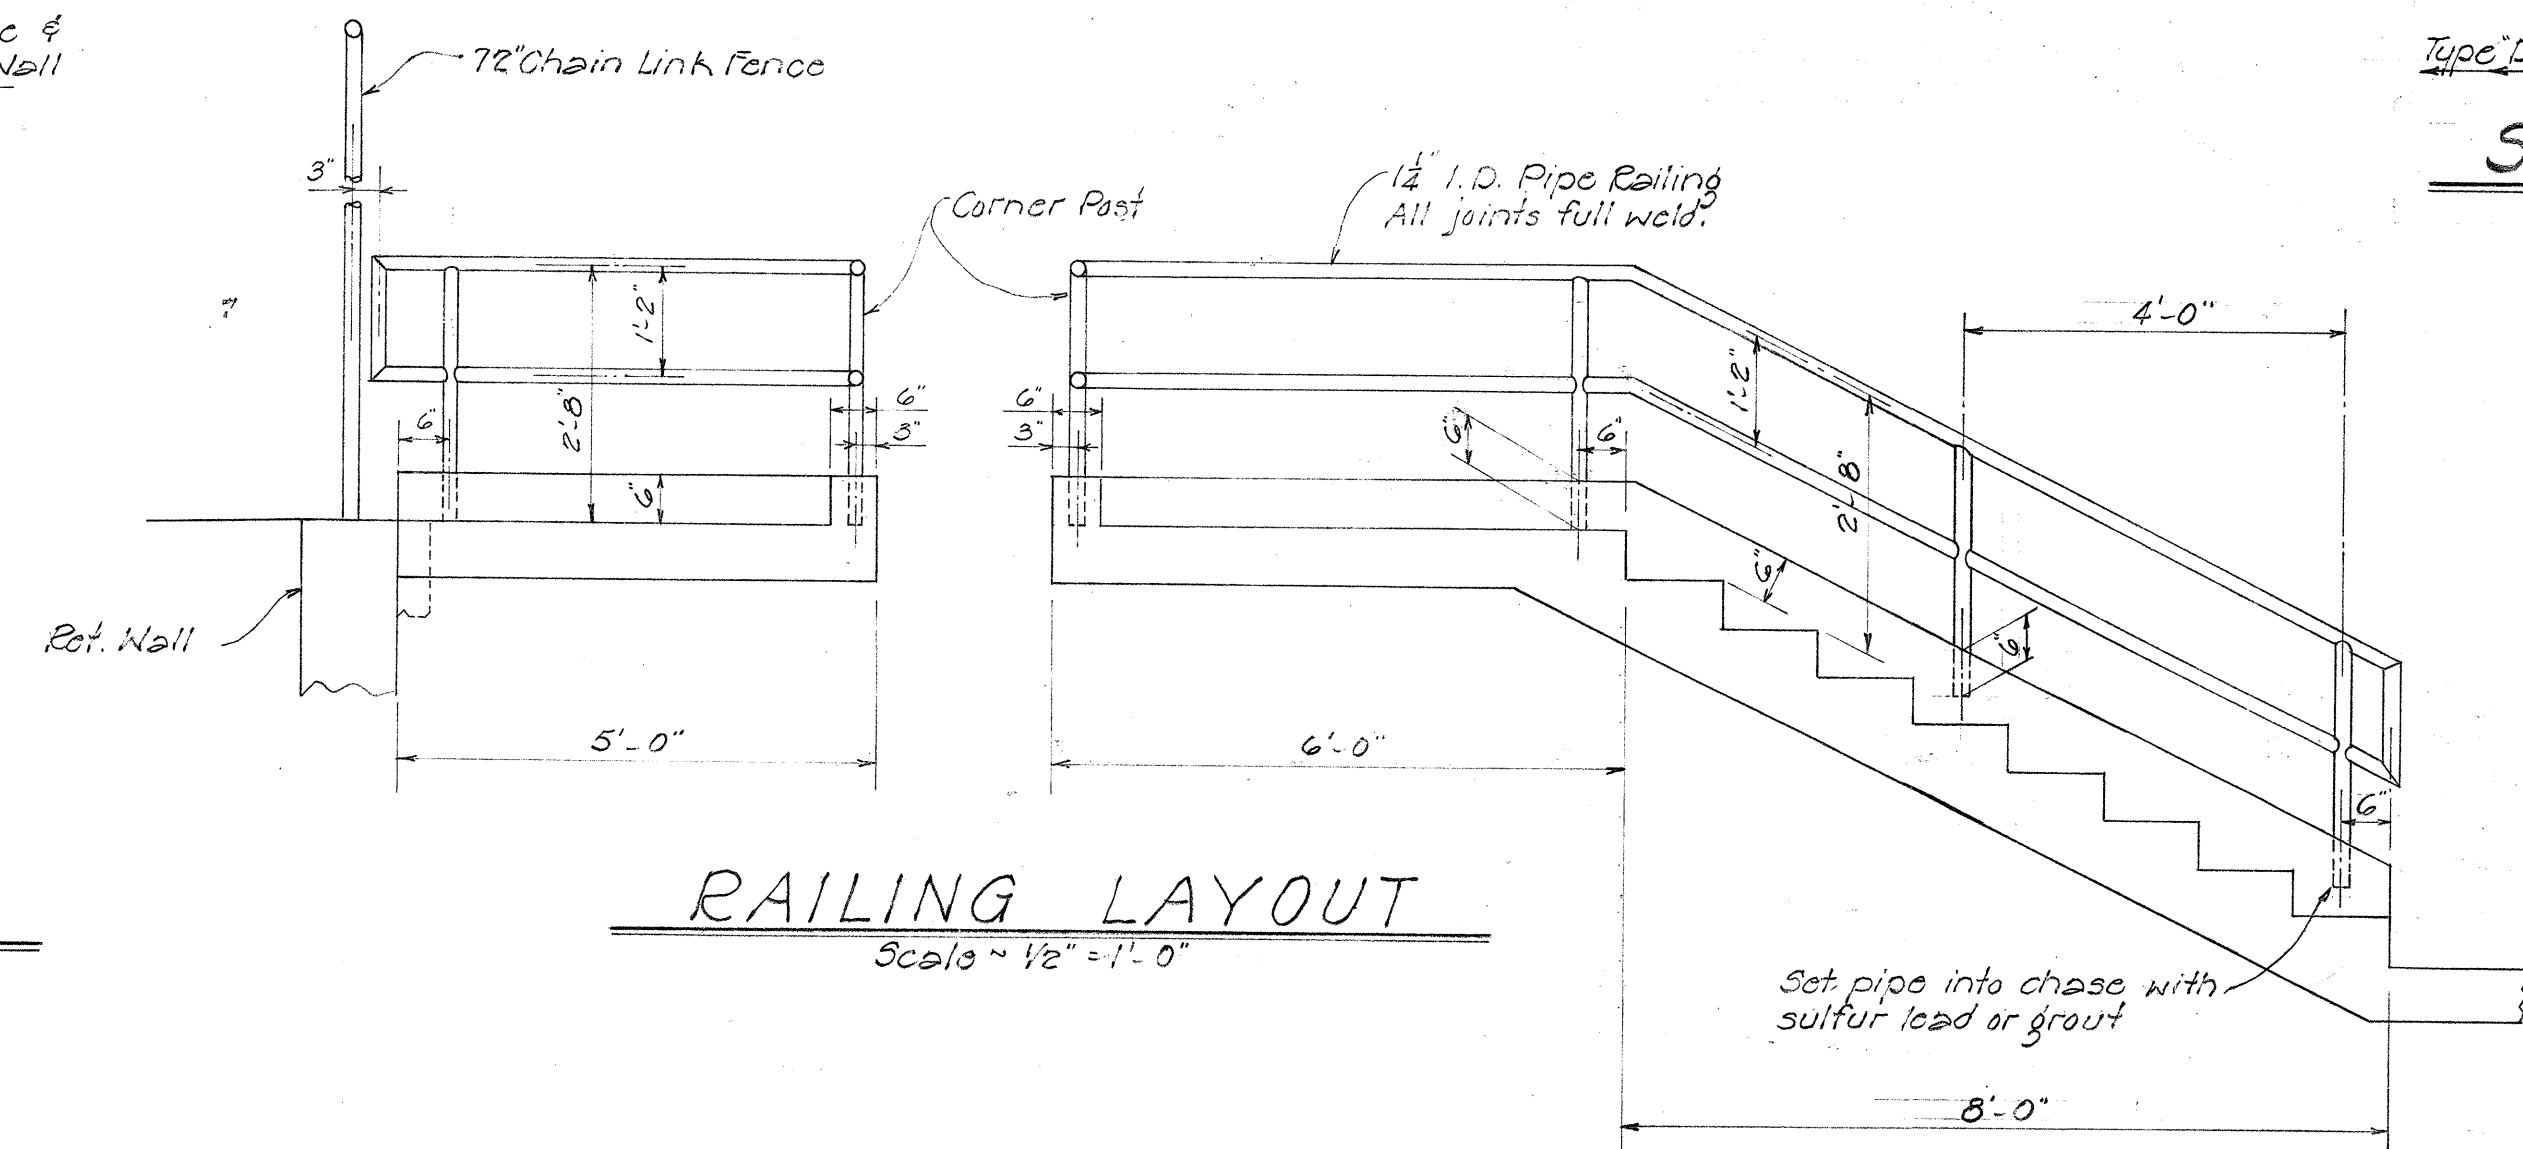

RAILING LAYOUT
Scale - 1/2" = 1'-0"

TERRITORIAL HIGHWAY DEPARTMENT
TERRITORY OF HAWAII
HONGWANJI MISSION
STAIRWAY
Ramp "H" Station 12 + 66
NUUANU HWY. Proj. No. BU-061-1(6)
Oct. 1, 1958 UNIT 1

SURVEY PLOTTED BY	DATE
DRAWN BY	
CHECKED BY	
NOTED BY	
ORIGINAL PLAN	
NO. BOOK	
QUANTITIES CHECKED BY	
NO.	

