


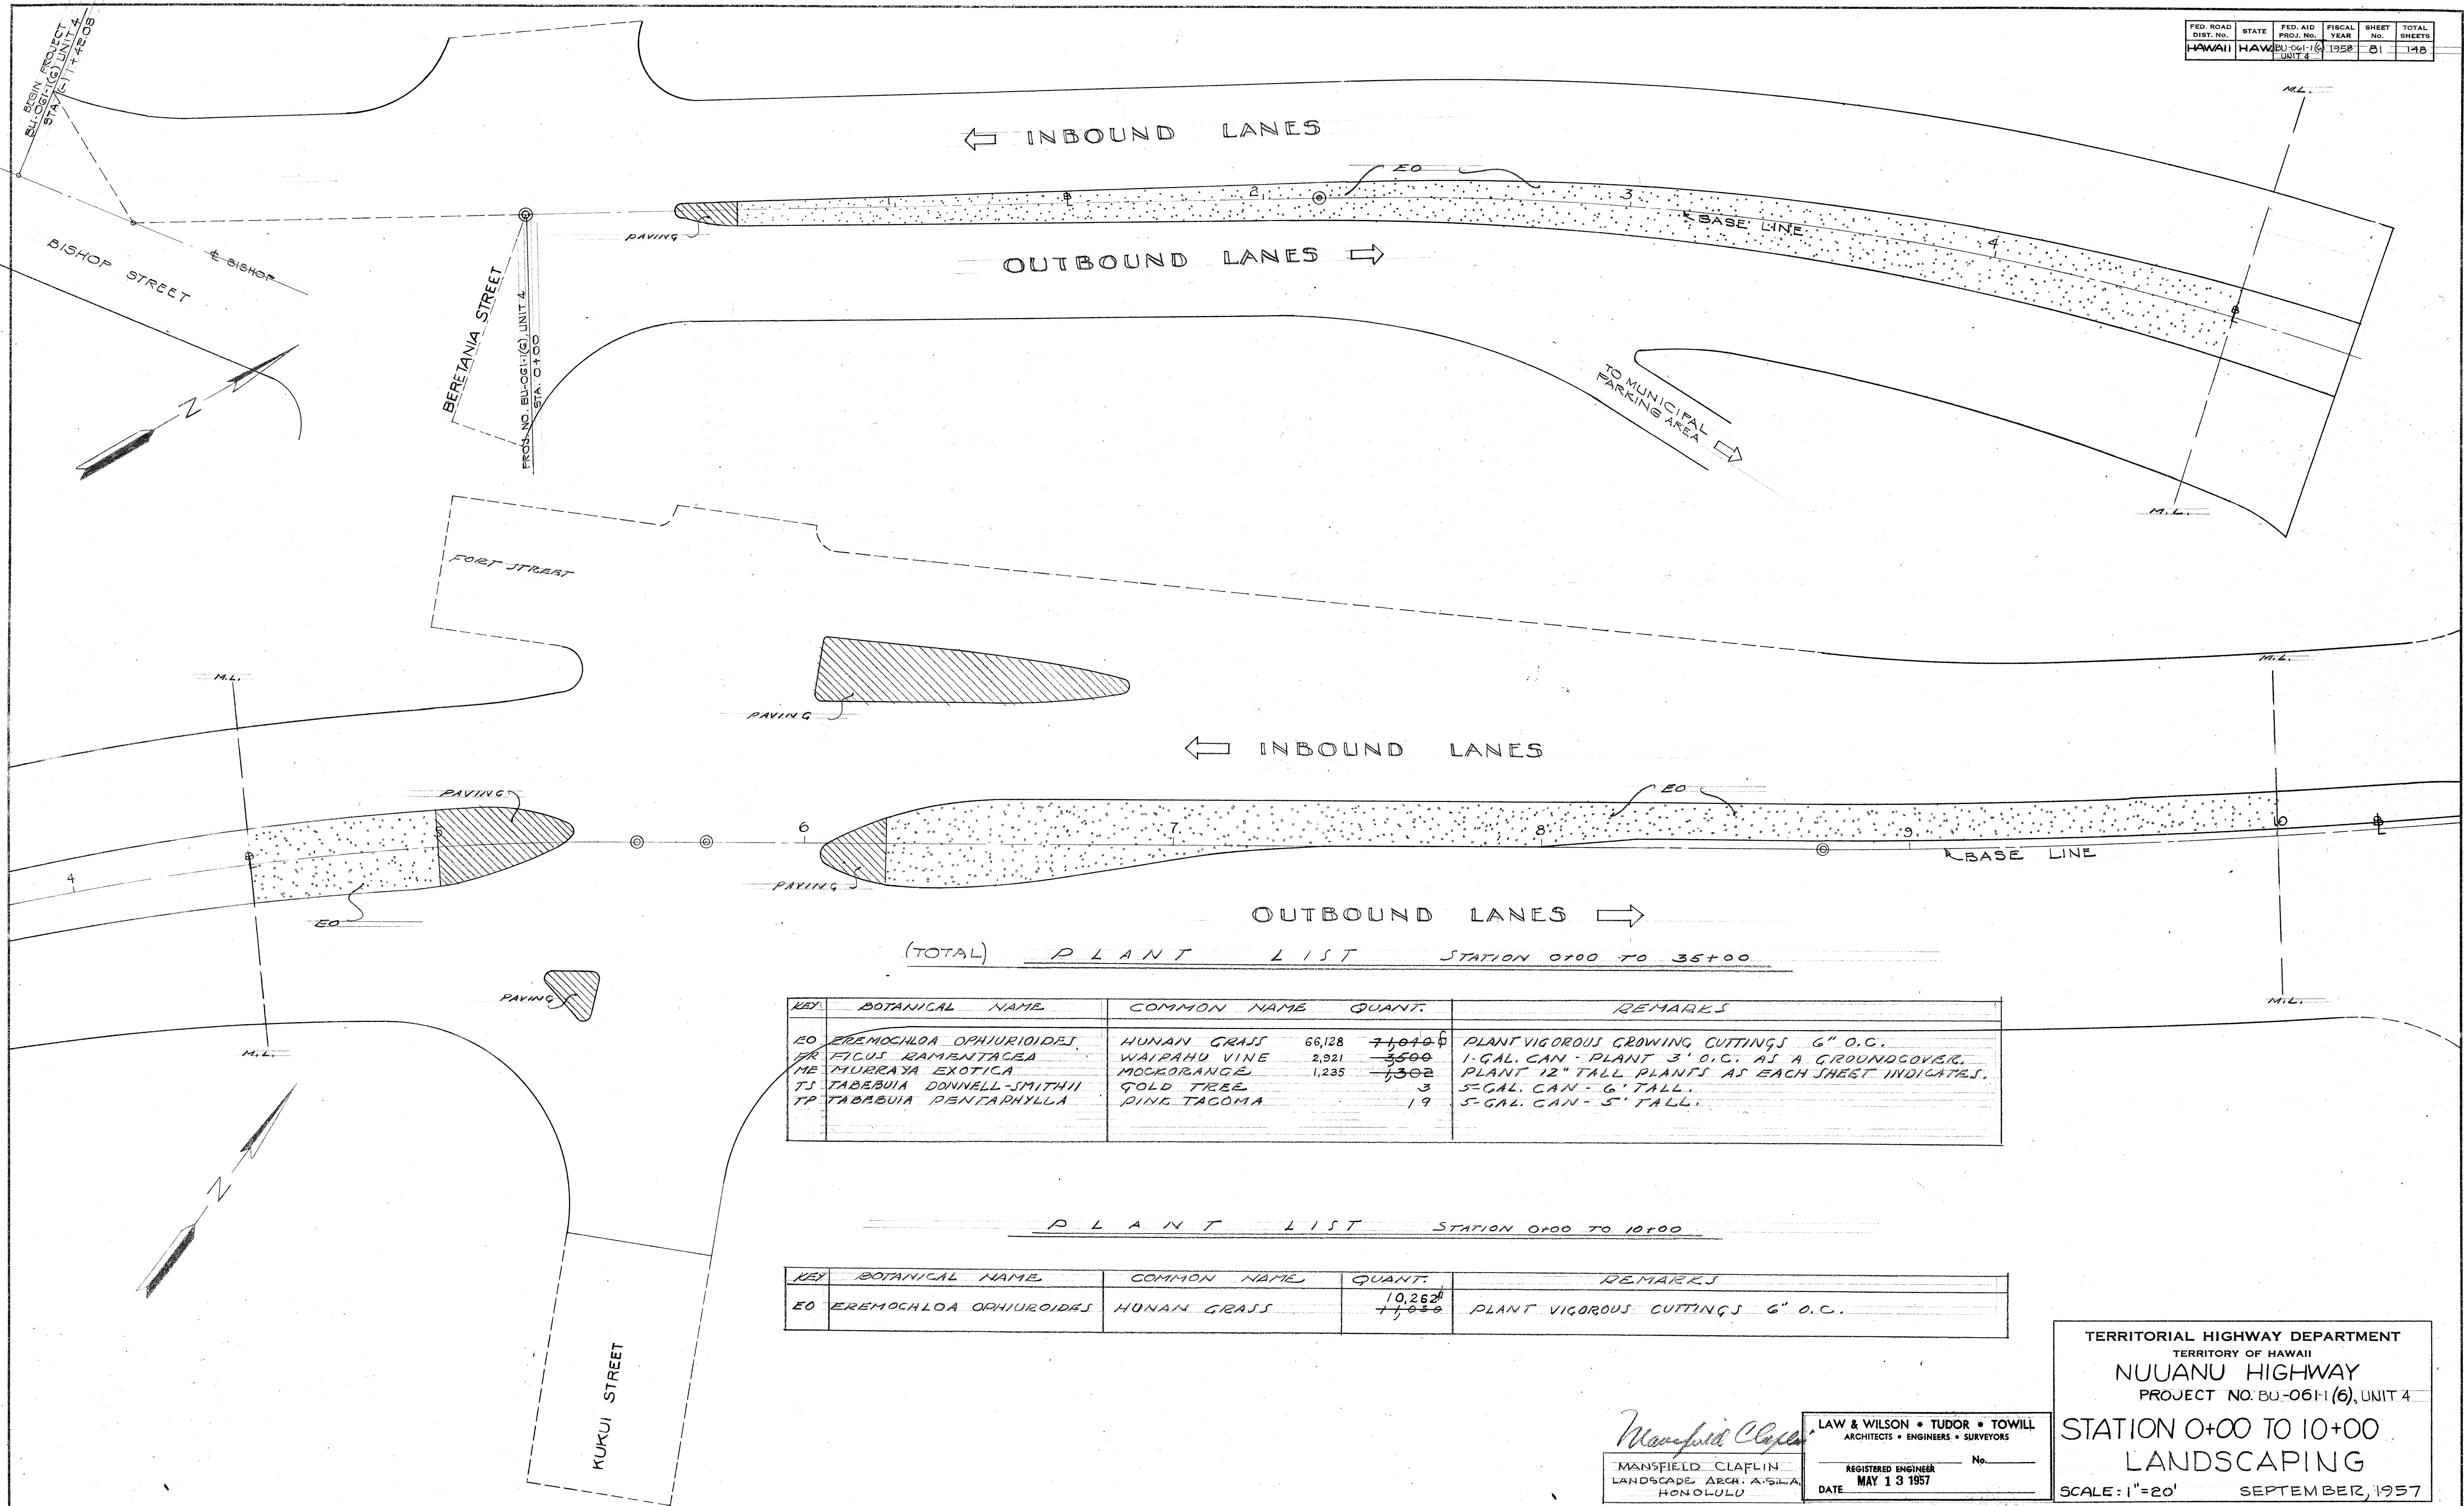

(TOTAL) PLANT LIST STATION 0+00 TO 35+00

KEY	BOTANICAL NAME	COMMON NAME	QUANT.	REMARKS
EO	EREMOCHLOA OPHIUROIDES	HUNAN GRASS	66,128	PLANT VIGOROUS GROWING CUTTINGS 6" O.C.
FR	FICUS RAMENTACEA	WAIPAHU VINE	2,921	1-GAL. CAN - PLANT 3' O.C. AS A GROUND COVER.
ME	MURRAYA EXOTICA	MOORORANGE	1,235	PLANT 12" TALL PLANTS AS EACH SHEET INDICATES.
TS	TABERBUA DONNELL-SMITHII	GOLD TREE	3	5-GAL. CAN - 6' TALL.
TP	TABERBUA PENTAPHYLLA	PINK TAGOMA	19	5-GAL. CAN - 5' TALL.

PLANT LIST STATION 0+00 TO 10+00


KEY	BOTANICAL NAME	COMMON NAME	QUANT.	REMARKS
EO	EREMOCHLOA OPHIUROIDES	HUNAN GRASS	10,262	PLANT VIGOROUS CUTTINGS 6" O.C.

Mansfield Claplin
LANDSCAPE ARCH. A.S.W.A.
HONOLULU

LAW & WILSON • TUDOR • TOWILL
ARCHITECTS • ENGINEERS • SURVEYORS
REGISTERED ENGINEER
DATE MAY 13 1957

TERRITORIAL HIGHWAY DEPARTMENT
TERRITORY OF HAWAII
NUUANU HIGHWAY
PROJECT NO. BU-06-1(6), UNIT 4
STATION 0+00 TO 10+00
LANDSCAPING
SCALE: 1"=20' SEPTEMBER, 1957

FED. ROAD DIST. NO.	STATE	FED. AID PROJ. NO.	FISCAL YEAR	SHEET NO.	TOTAL SHEETS
HAWAII	HAW.	BU-061-1(6)	1958	20	148

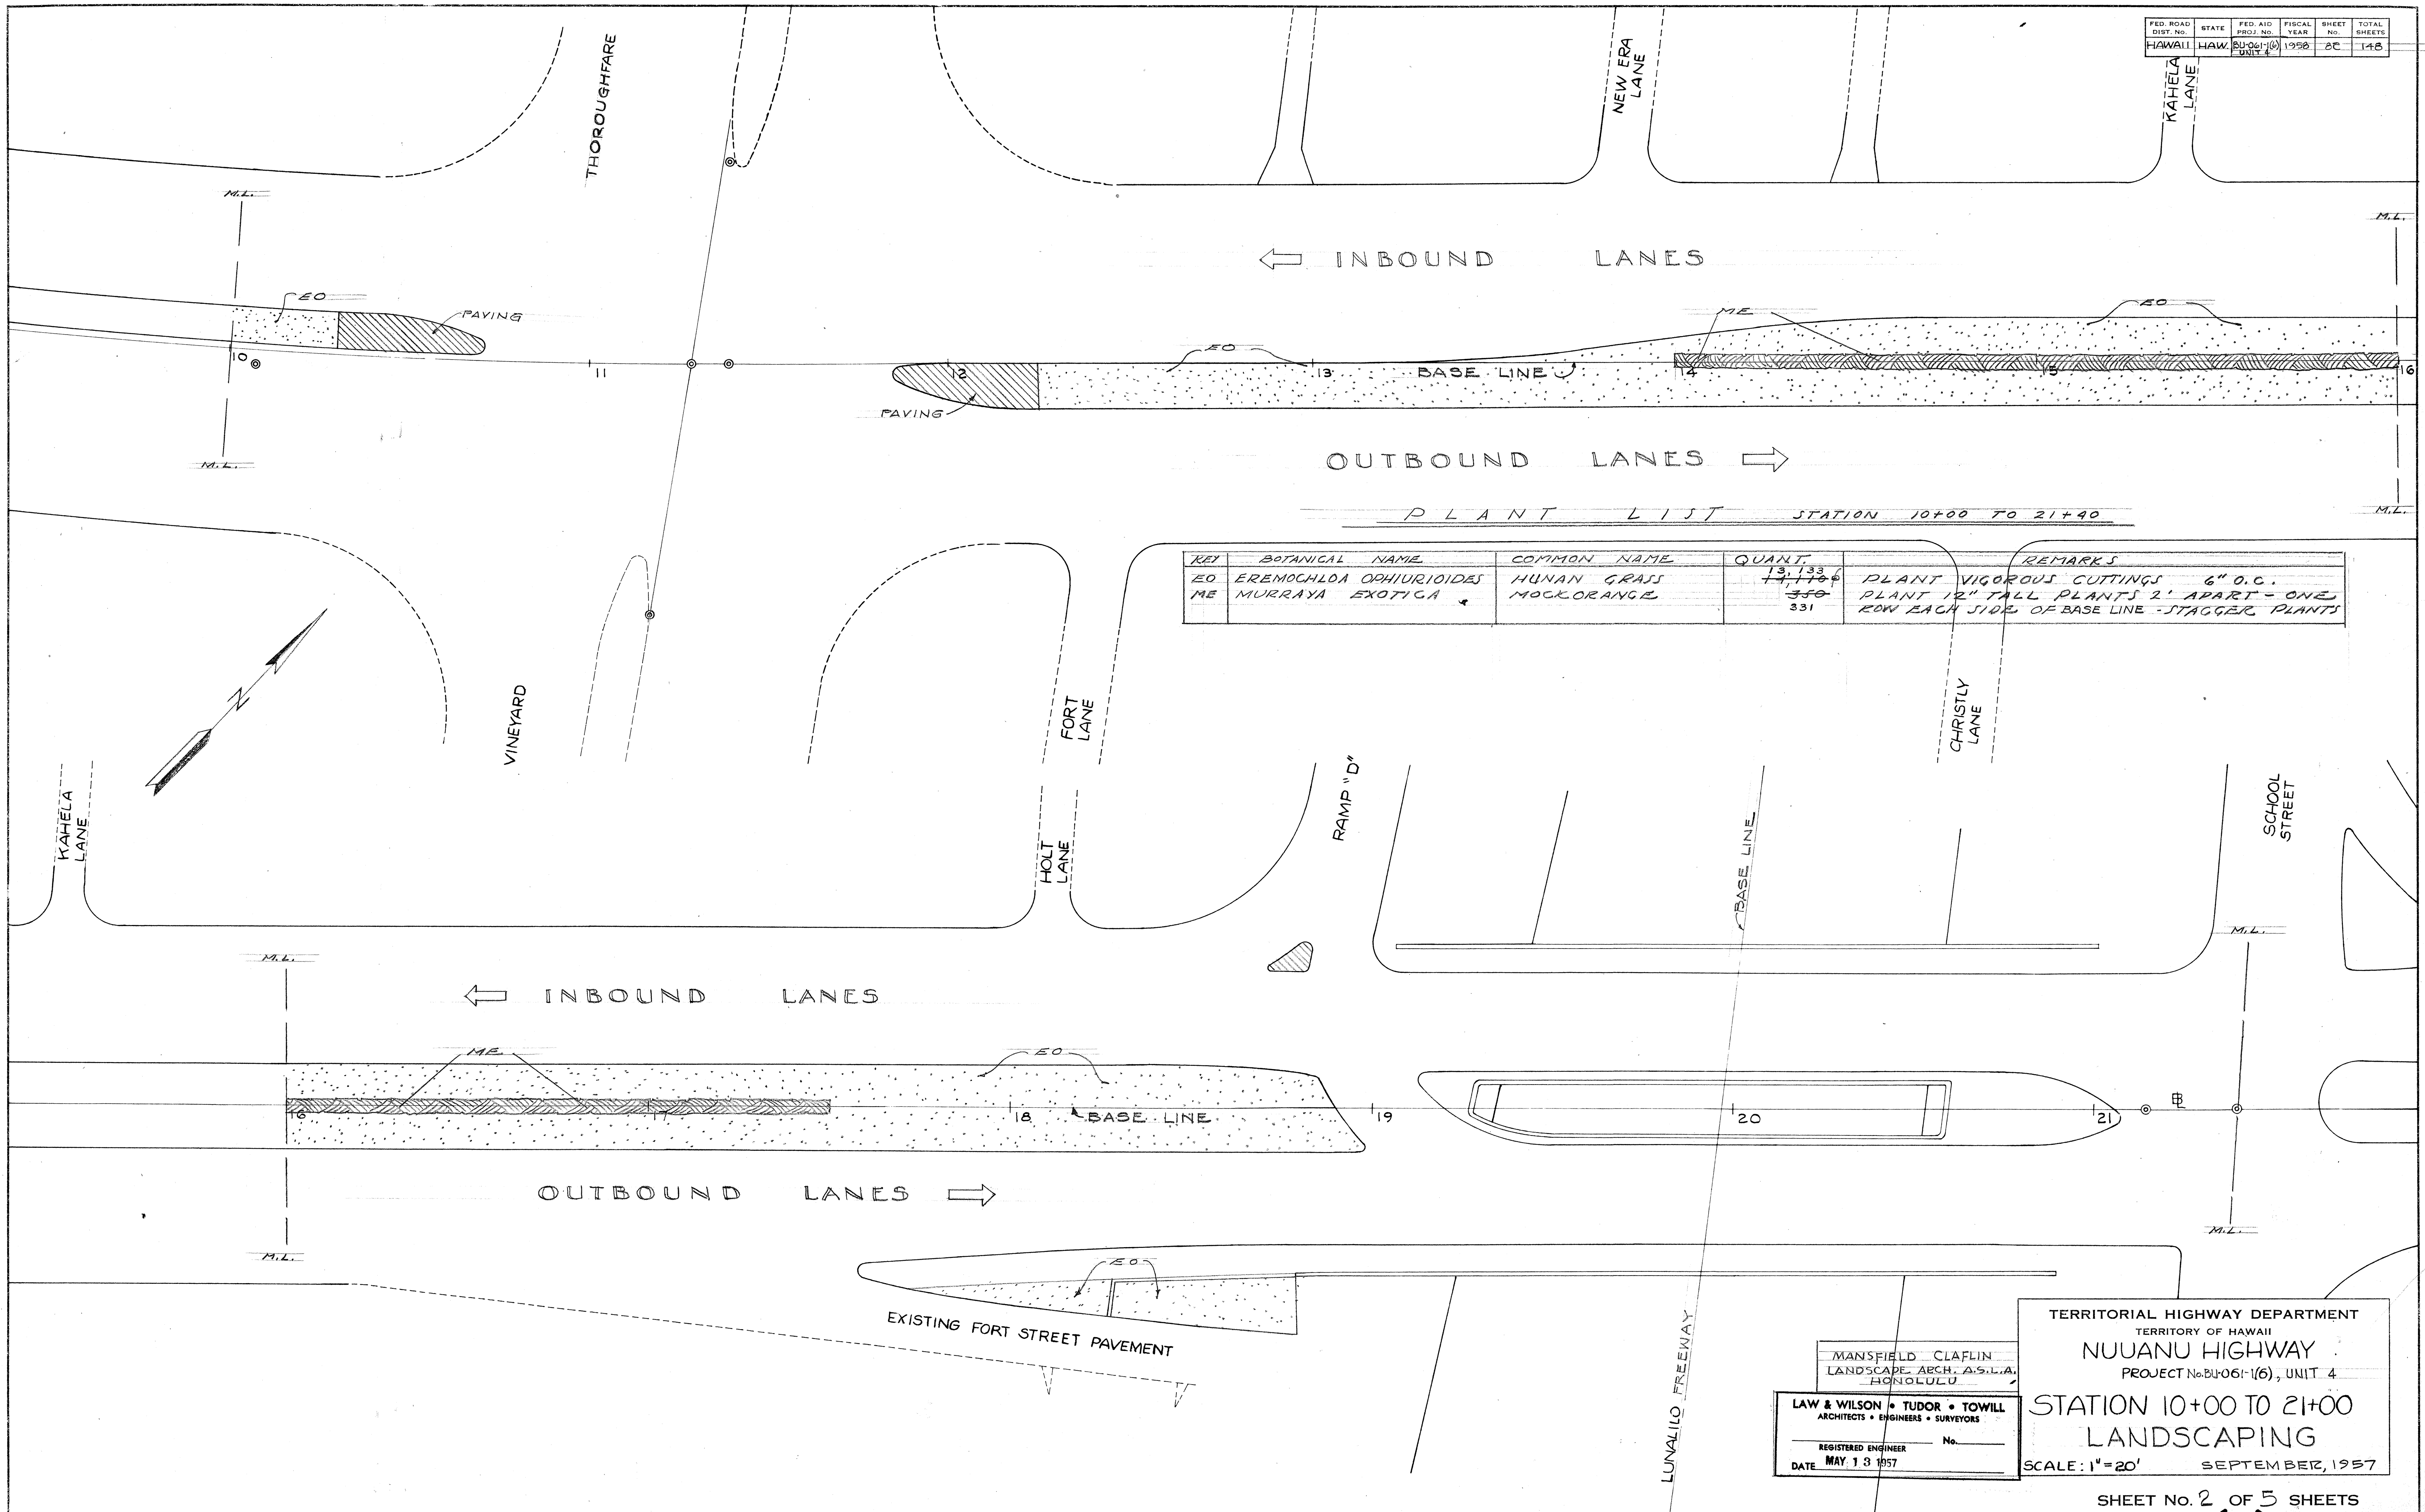

DESIGNED BY	DATE
DRAWN BY	4-30-57
CHECKED BY	
NOTE BOOK	
NO.	

MANSFIELD CLAFLIN
LANDSCAPE ARCH. A.S.L.A.
HONOLULU


LAW & WILSON • TUDOR • TOWILL
ARCHITECTS • ENGINEERS • SURVEYORS


REGISTERED ENGINEER No. _____
DATE MAY 13 1957

TERRITORIAL HIGHWAY DEPARTMENT
TERRITORY OF HAWAII
NUUANU HIGHWAY
PROJECT No. BU-061-1(6), UNIT 4
STATION 10+00 TO 21+00
LANDSCAPING
SCALE: 1"=20' SEPTEMBER 12, 1957

SHEET No. 2 OF 5 SHEETS

.8146 (2).82 162

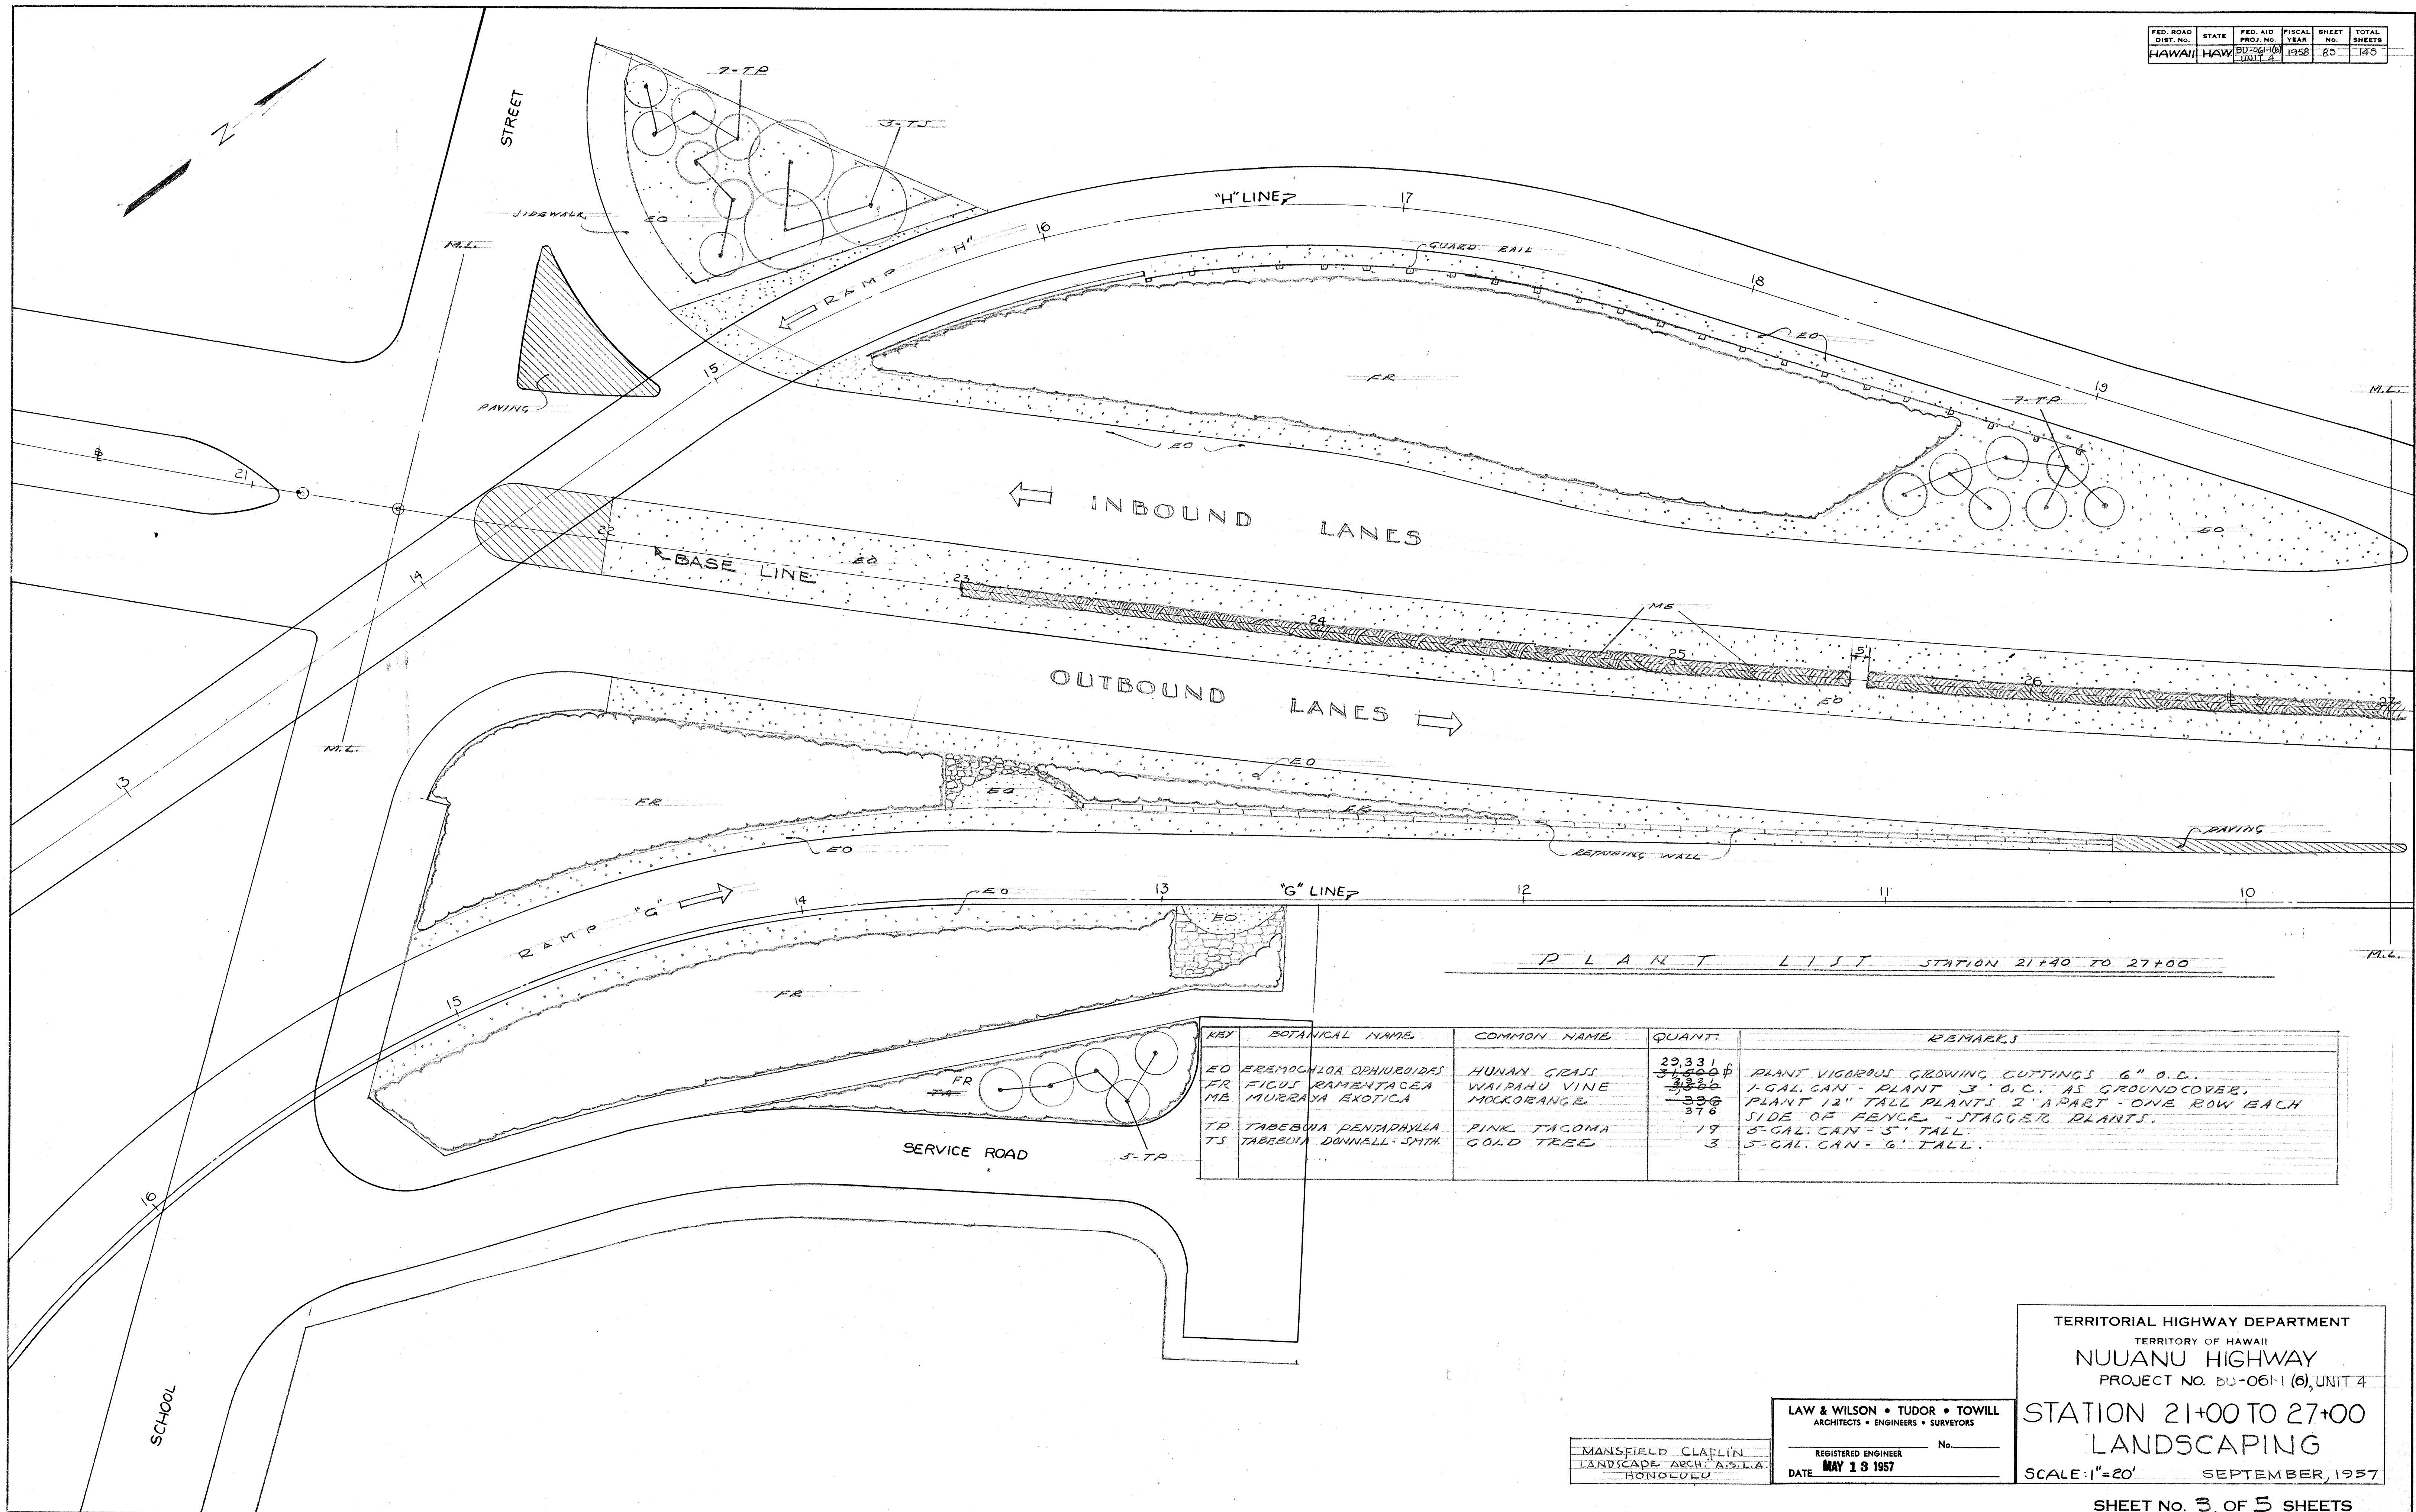

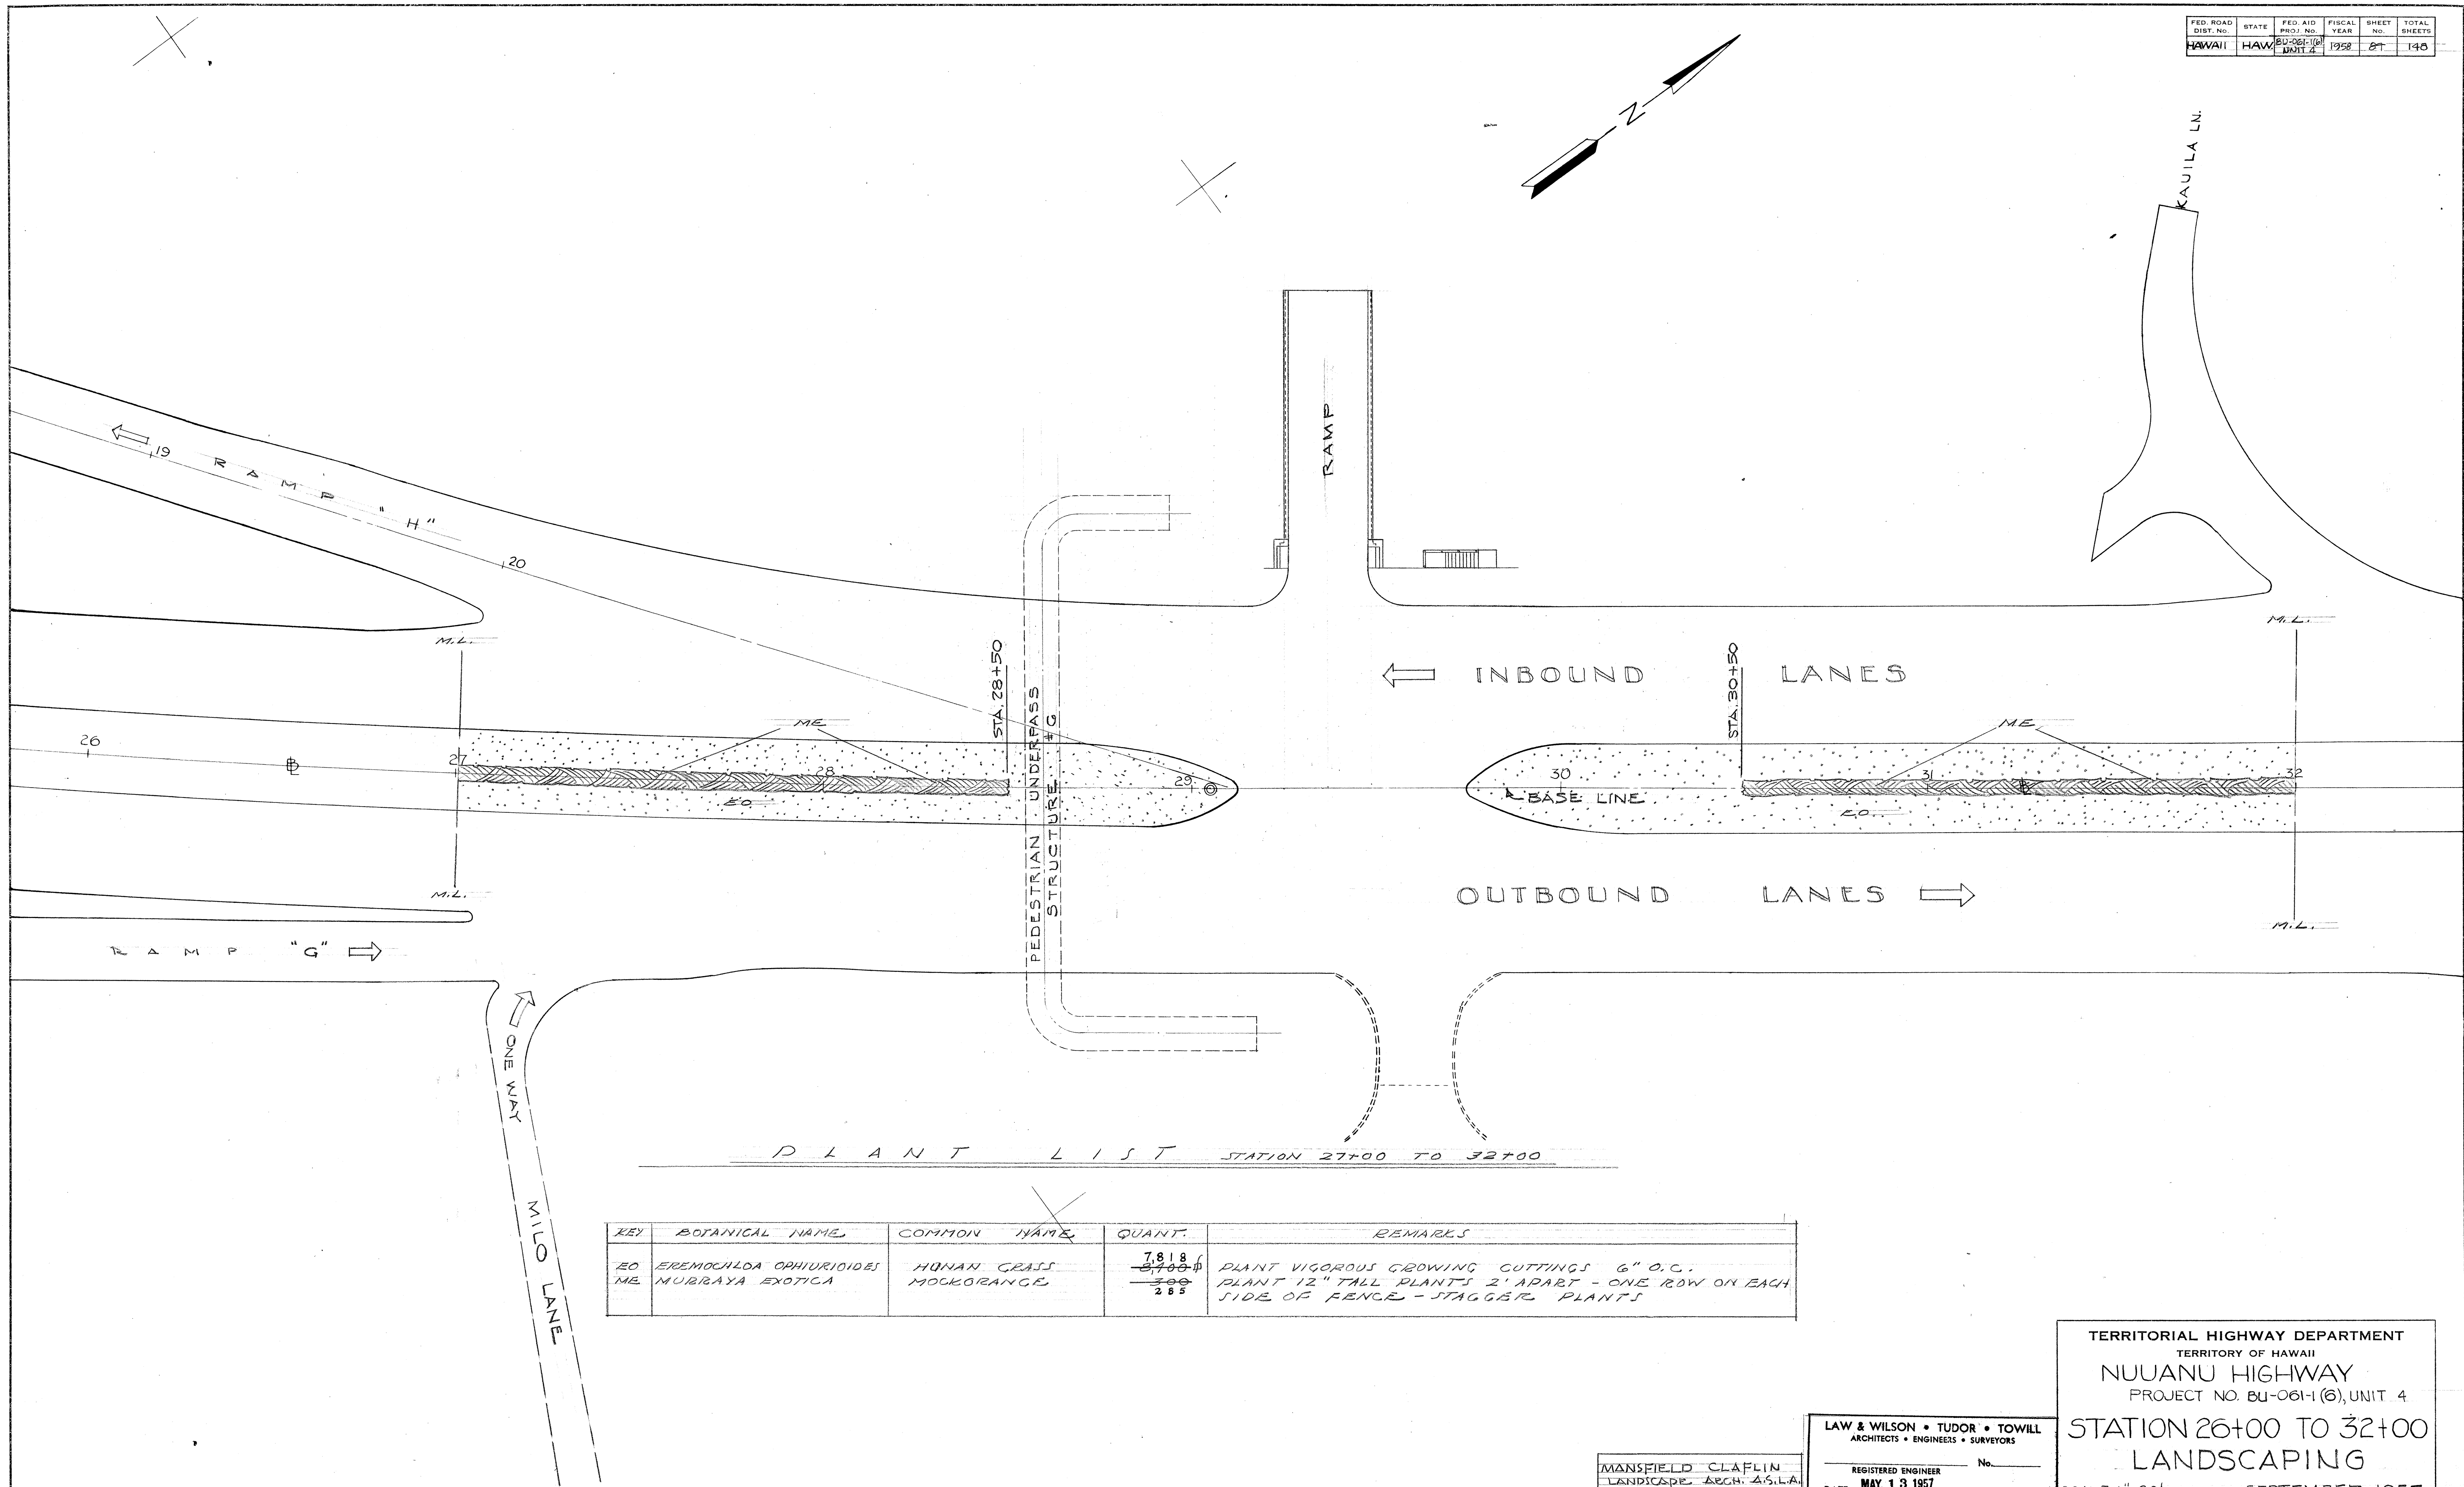


ORIGINAL PLAN
DESIGNED BY
DATE
4-29-57
QUANTITIES BY
CHECKED BY
C.S.

MANSFIELD CLAFIN
LANDSCAPE ARCH. & S.L.A.
HONOLULU

LAW & WILSON • TUDOR • TOWILL
ARCHITECTS • ENGINEERS • SURVEYORS
REGISTERED ENGINEER
DATE MAY 13 1957

TERRITORIAL HIGHWAY DEPARTMENT
TERRITORY OF HAWAII
NUUANU HIGHWAY
PROJECT NO. BU-061-1(6), UNIT 4
STATION 26+00 TO 32+00
LANDSCAPING
SCALE: 1"=20'
SEPTEMBER 12, 1957

SHEET NO. 4 OF 5 SHEETS

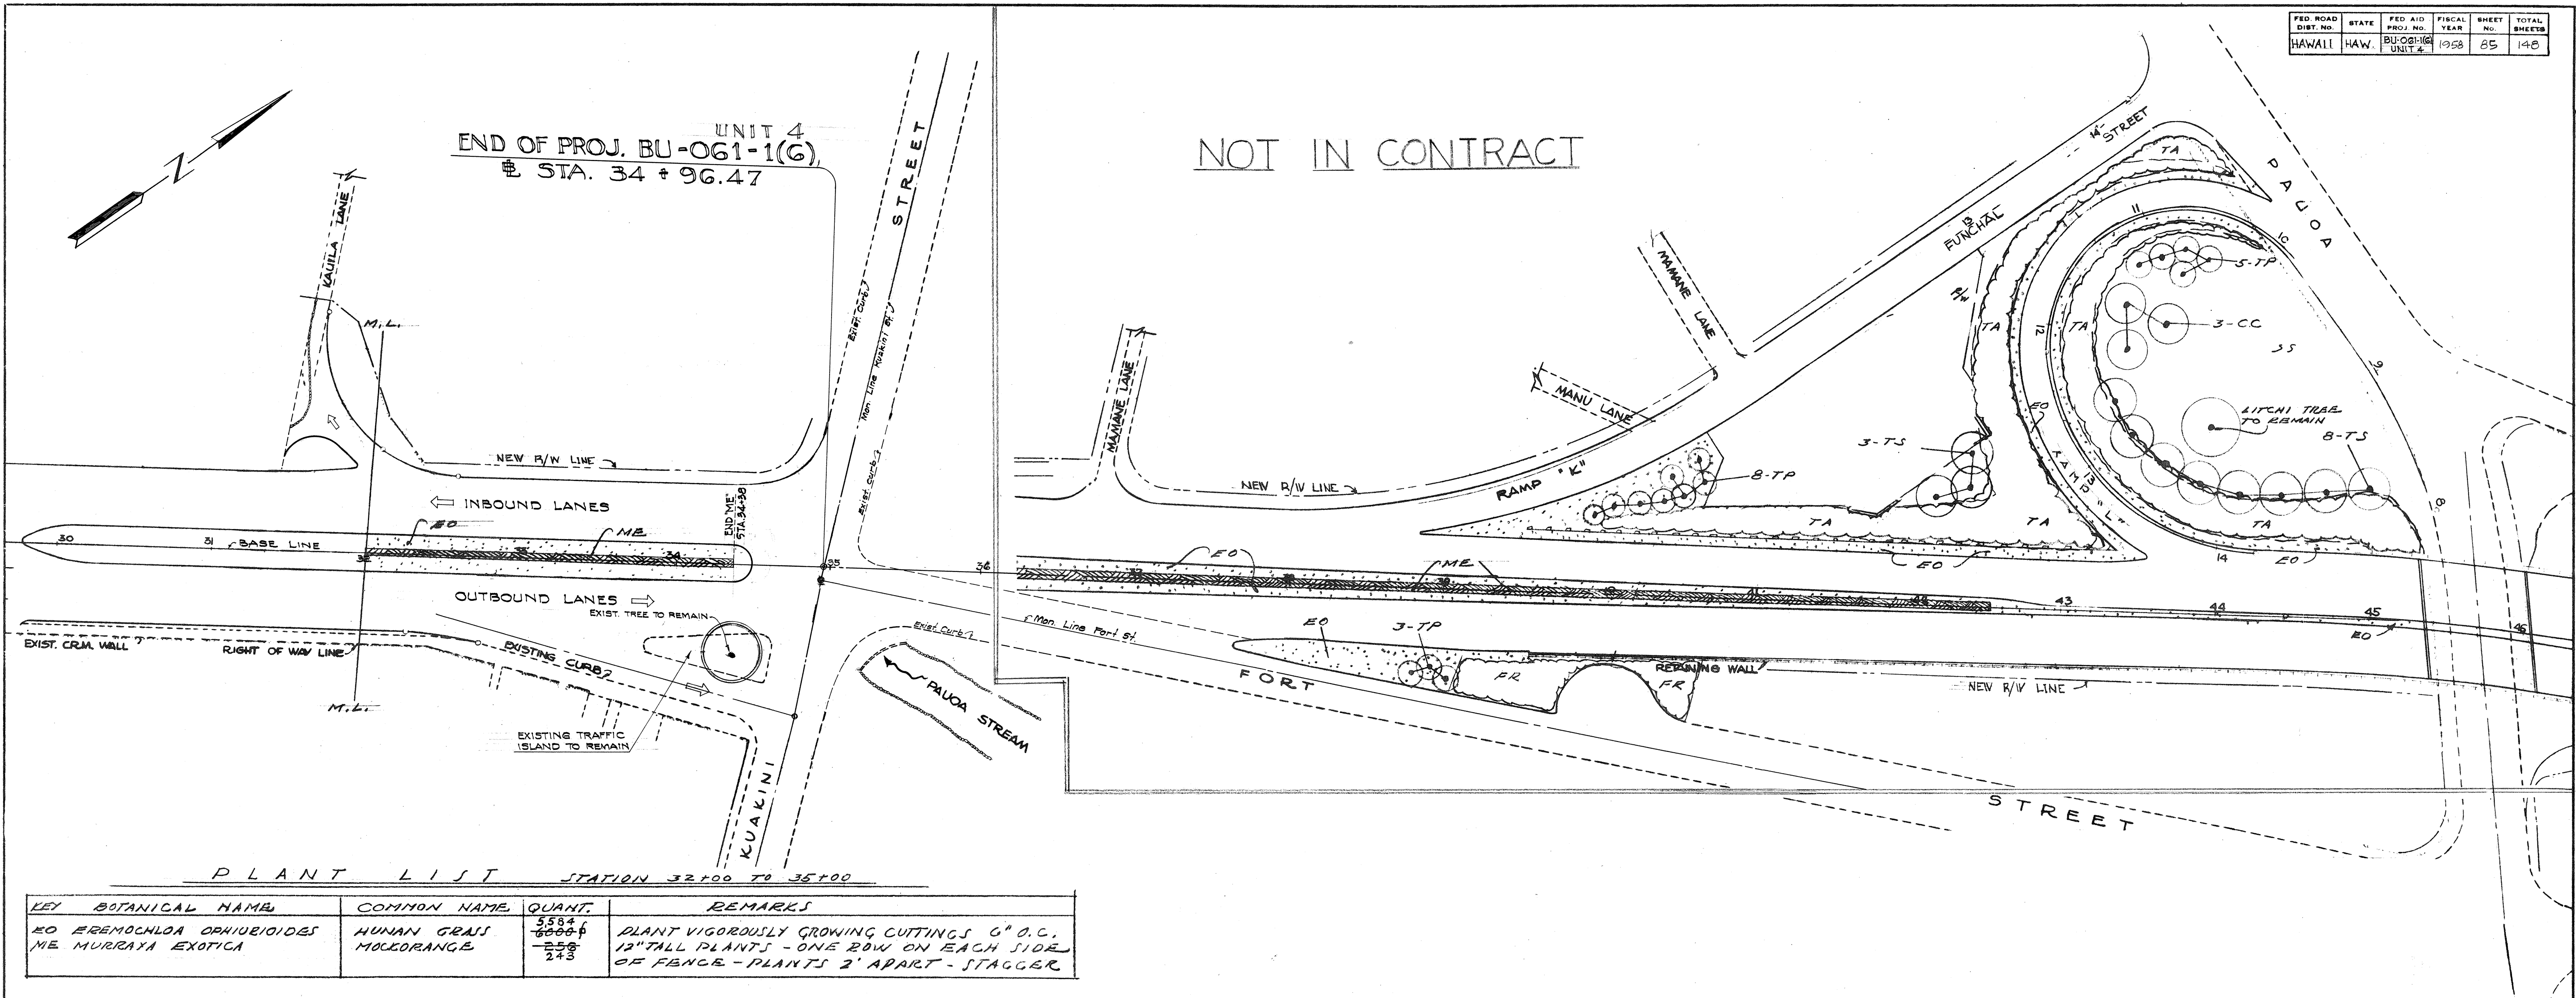

DATE
DRAWN BY
CHECKED BY
NOTE BOOK
No.

MANSFIELD P. CLAFLIN
LANDSCAPE ARCH. A.S.L.A.
HONOLULU

LAW & WILSON • TUDOR • TOWILL
ARCHITECTS • ENGINEERS • SURVEYORS
REGISTERED ENGINEER
DATE

TERRITORIAL HIGHWAY DEPARTMENT
TERRITORY OF HAWAII
NUUANU HIGHWAY
PROJECT NO. BU-061(6), UNIT 4
STATION 30+00 TO 46+00
LANDSCAPING
SCALE: 1"=50' SEPTEMBER, 1957

SHEET No. 5 OF 5 SHEETS