


Revised: April 25, 1960

FED. ROAD DIST. NO.	STATE	FED. AID PROJ. NO.	FISCAL YEAR	SHEET NO.	TOTAL SHEETS
HAWAII	HAW.	BF-061-1(8)	1960	12	61

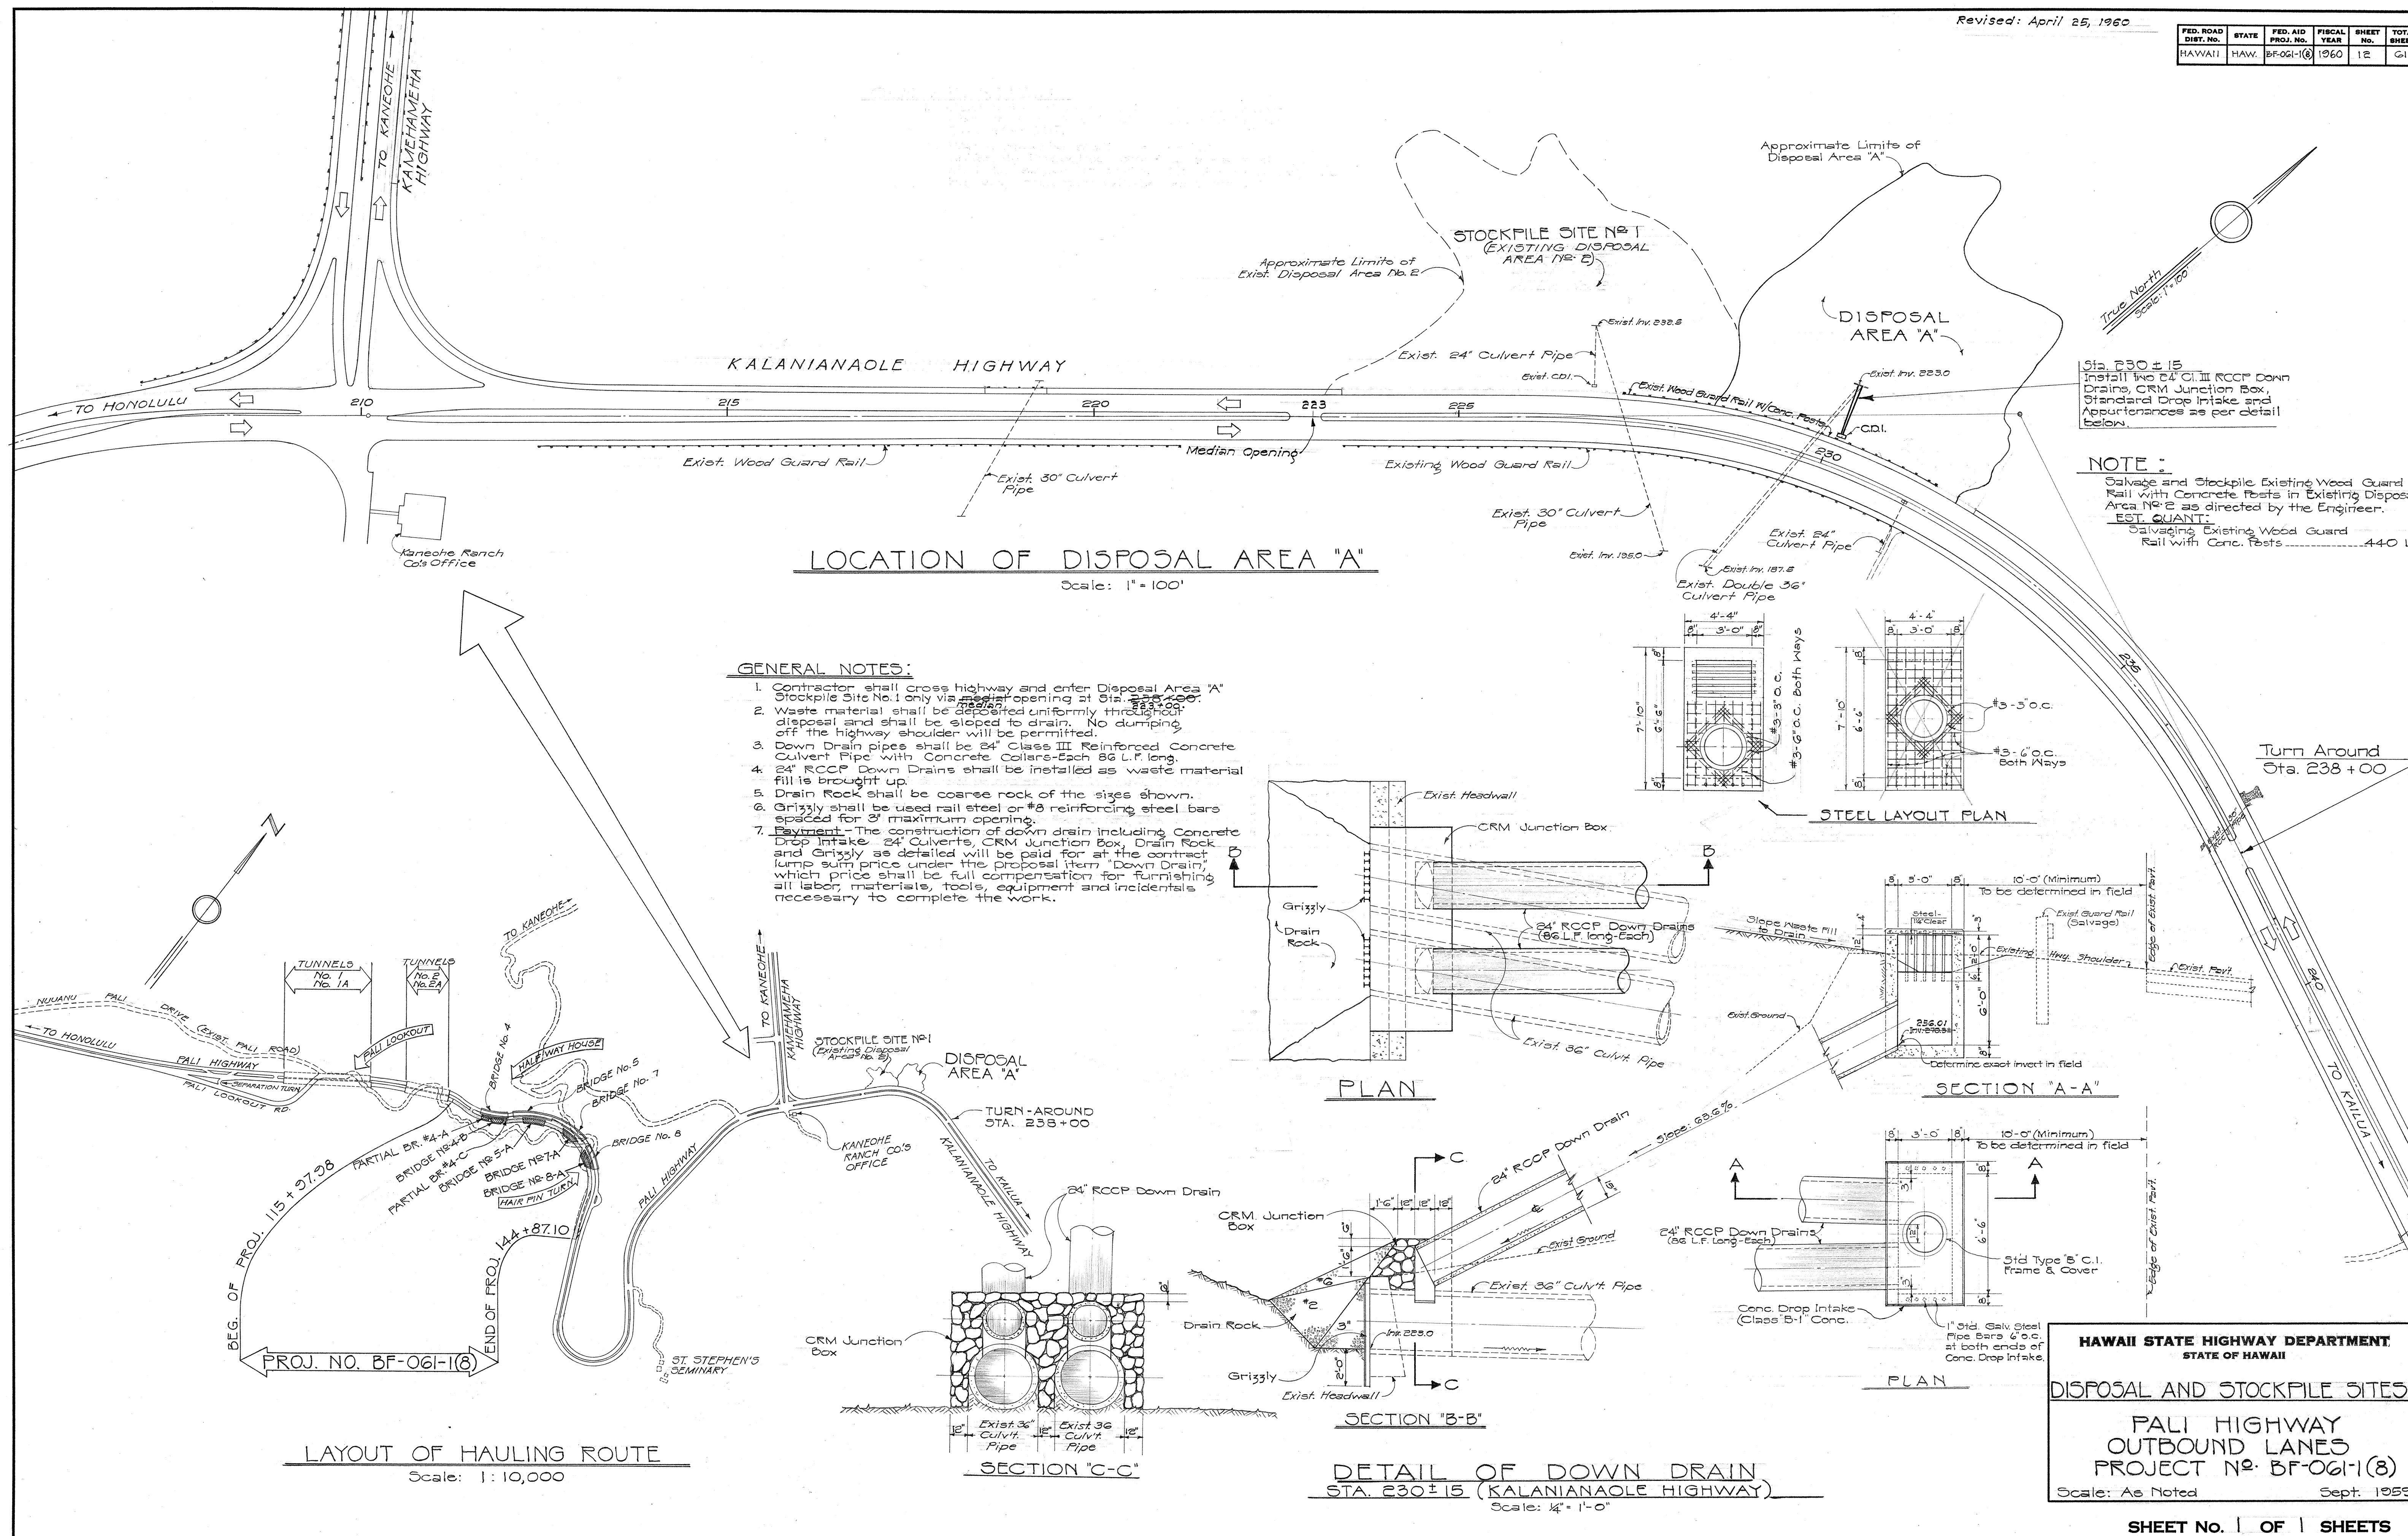

.8148.12