




FED. ROAD DIST. No.	STATE	FED. AID PROJ. No.	FISCAL YEAR	SHEET No.	TOTAL SHEETS
HAWAII	HAW.	BF-061-1(8)	1960	7	61

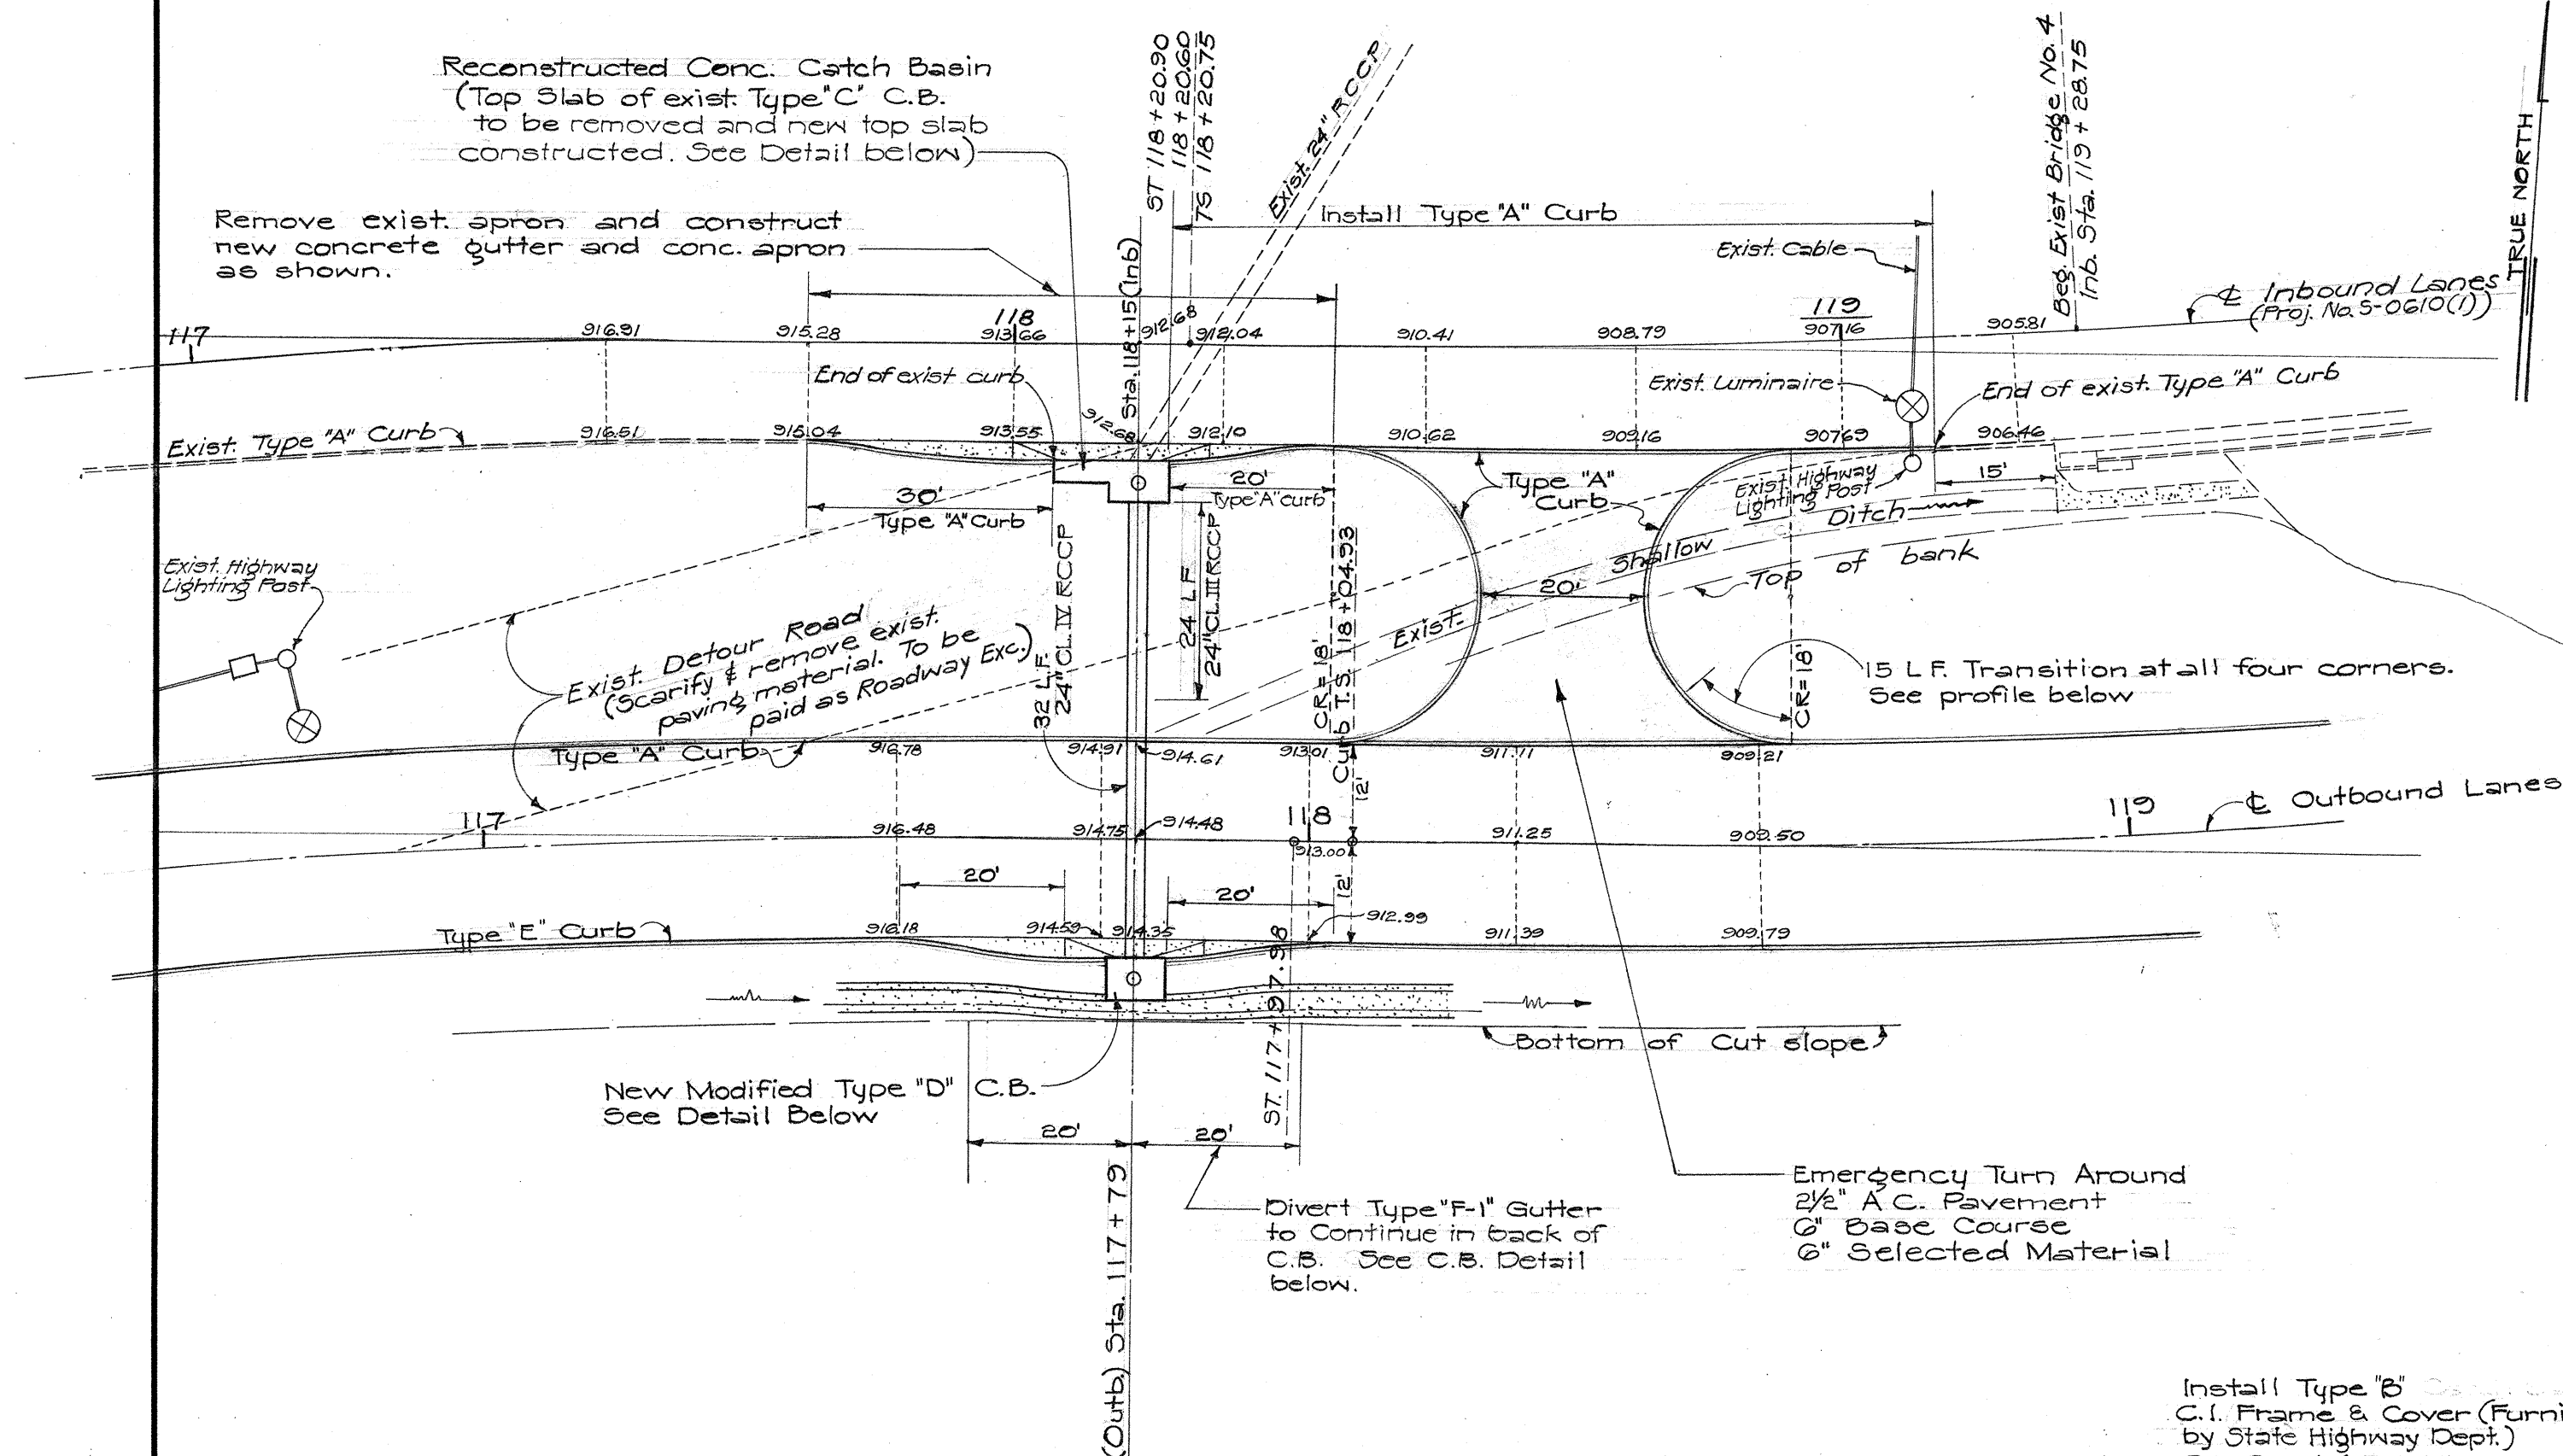


EMERGENCY TURN AROUND & CATCH BASINS

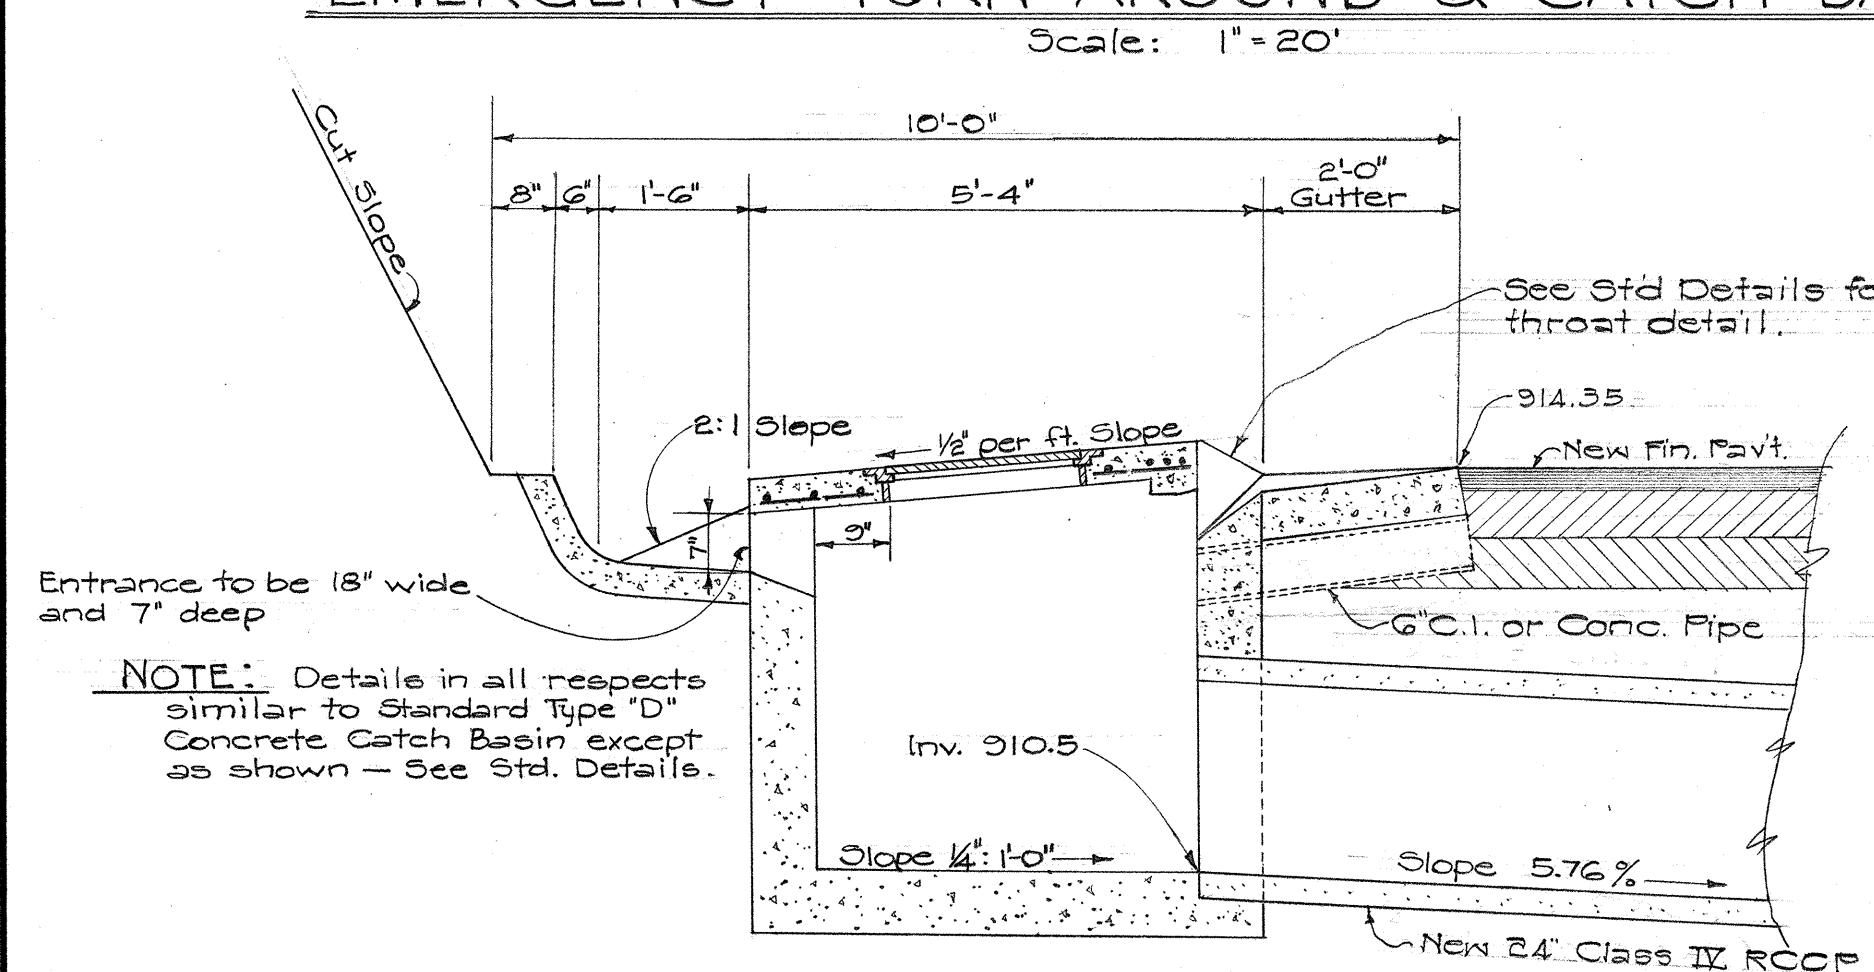


DETAIL OF NEW MODIFIED TYPE "D" C.B. AT OUTB'D. STA. 117+79

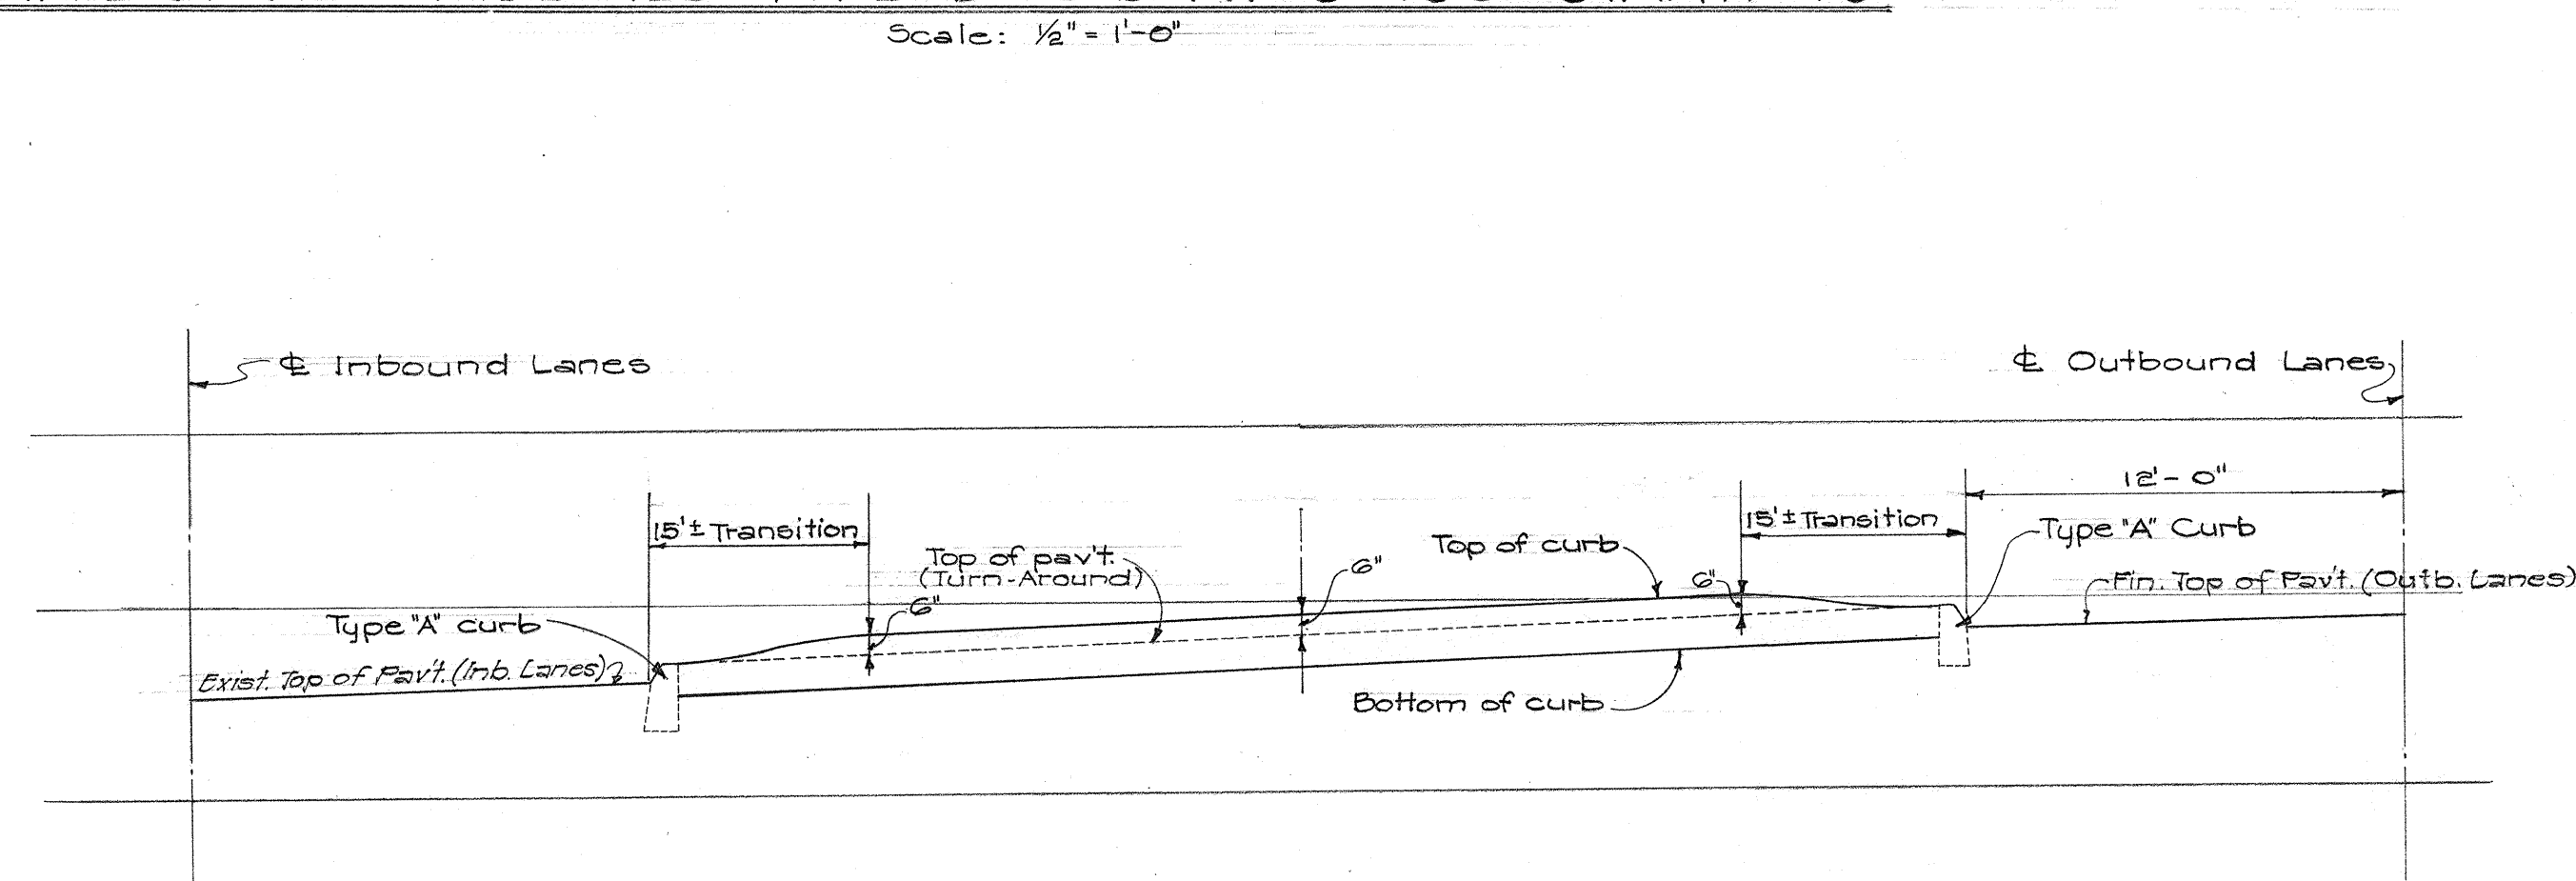


TYPICAL PROFILE OF TYPE "A" CURB AT EMERGENCY TURN AROUND

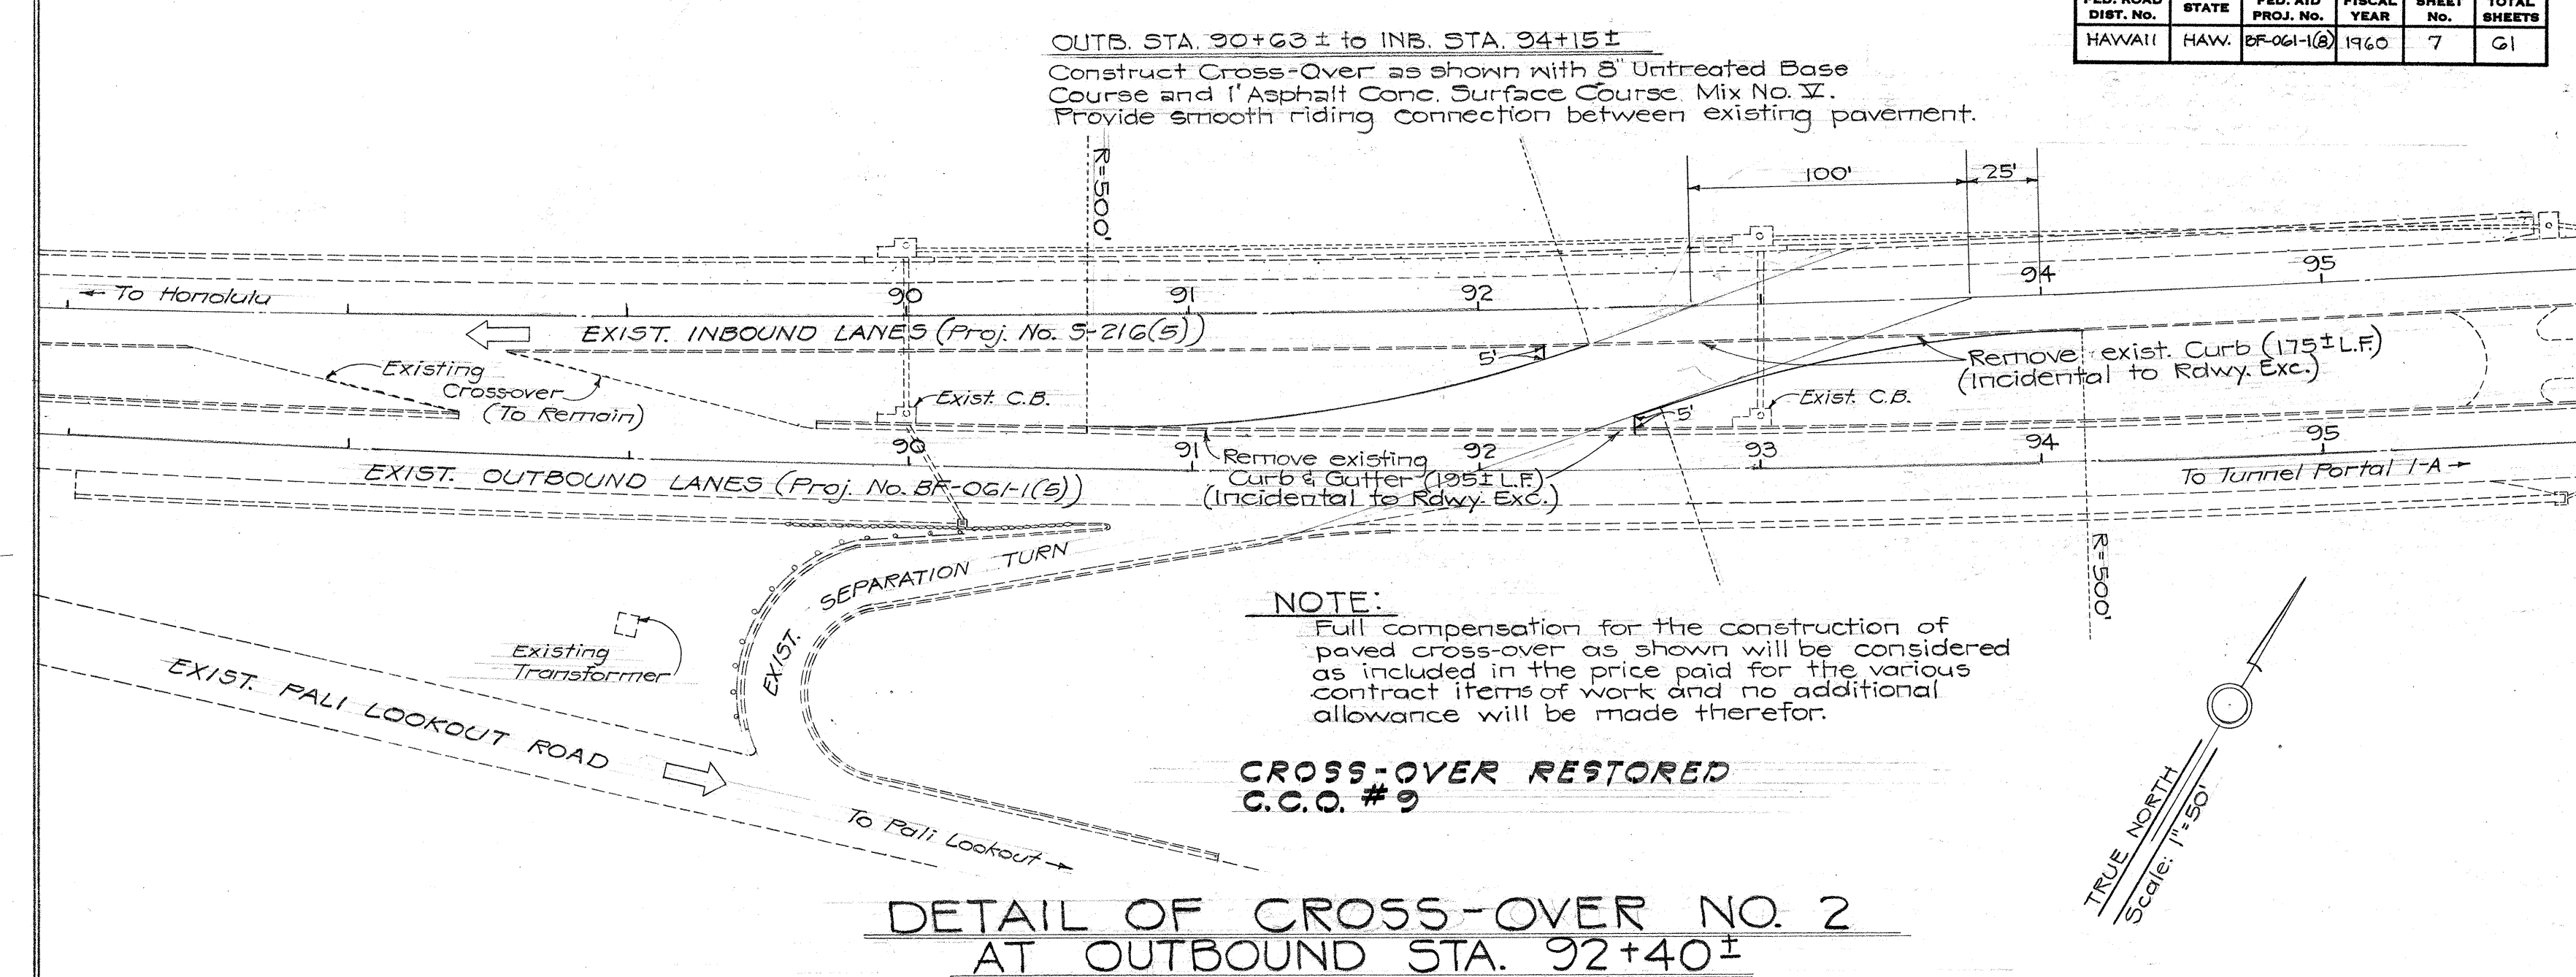

DETAIL OF CROSS-OVER NO. 2
AT OUTBOUND STA. 92+40±

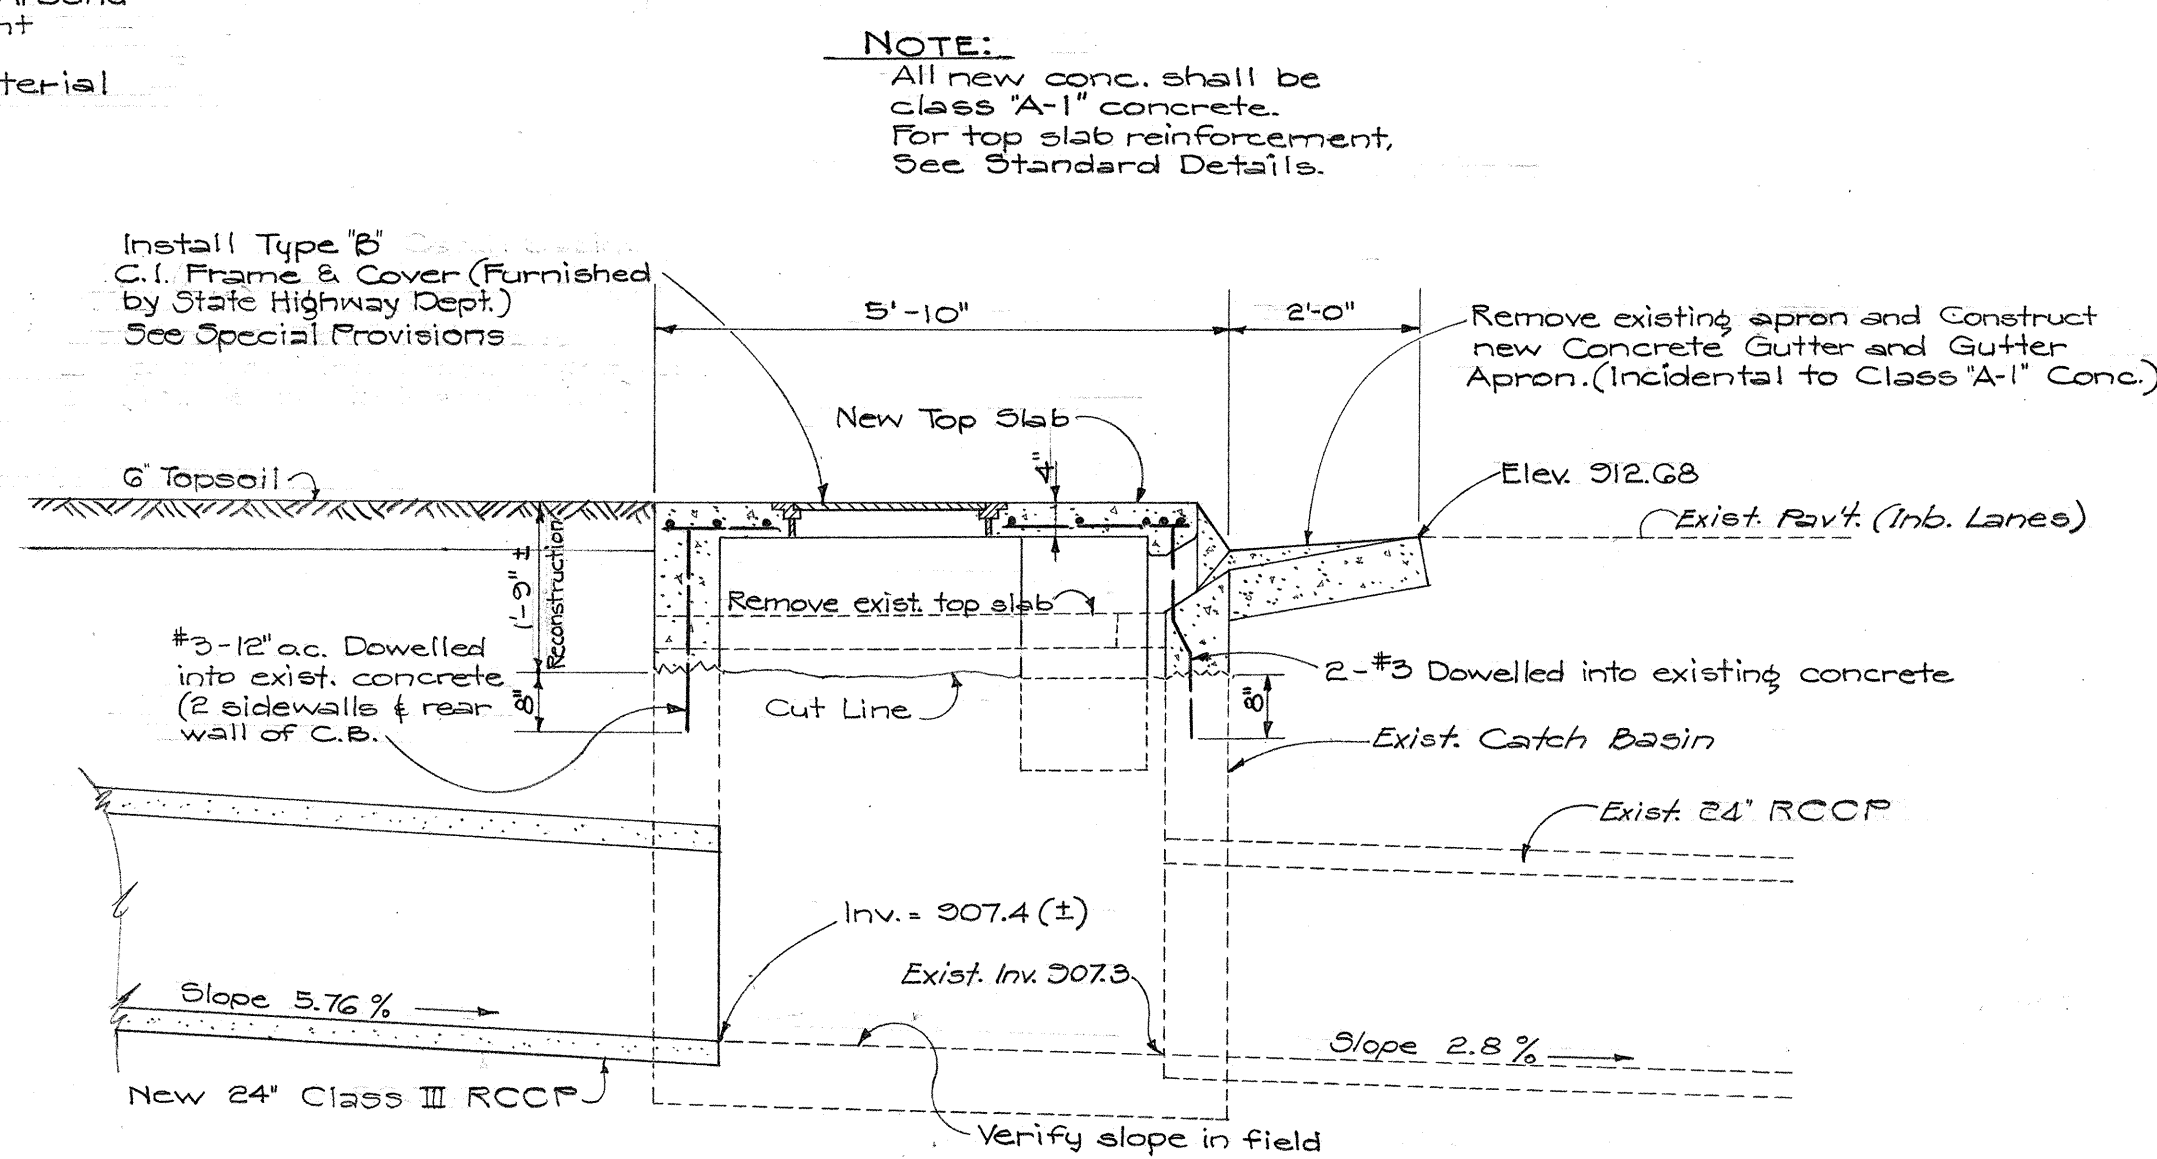


DETAIL OF RECONSTRUCTED TYPE "C" C.B. AT INB'D. STA. 118+15

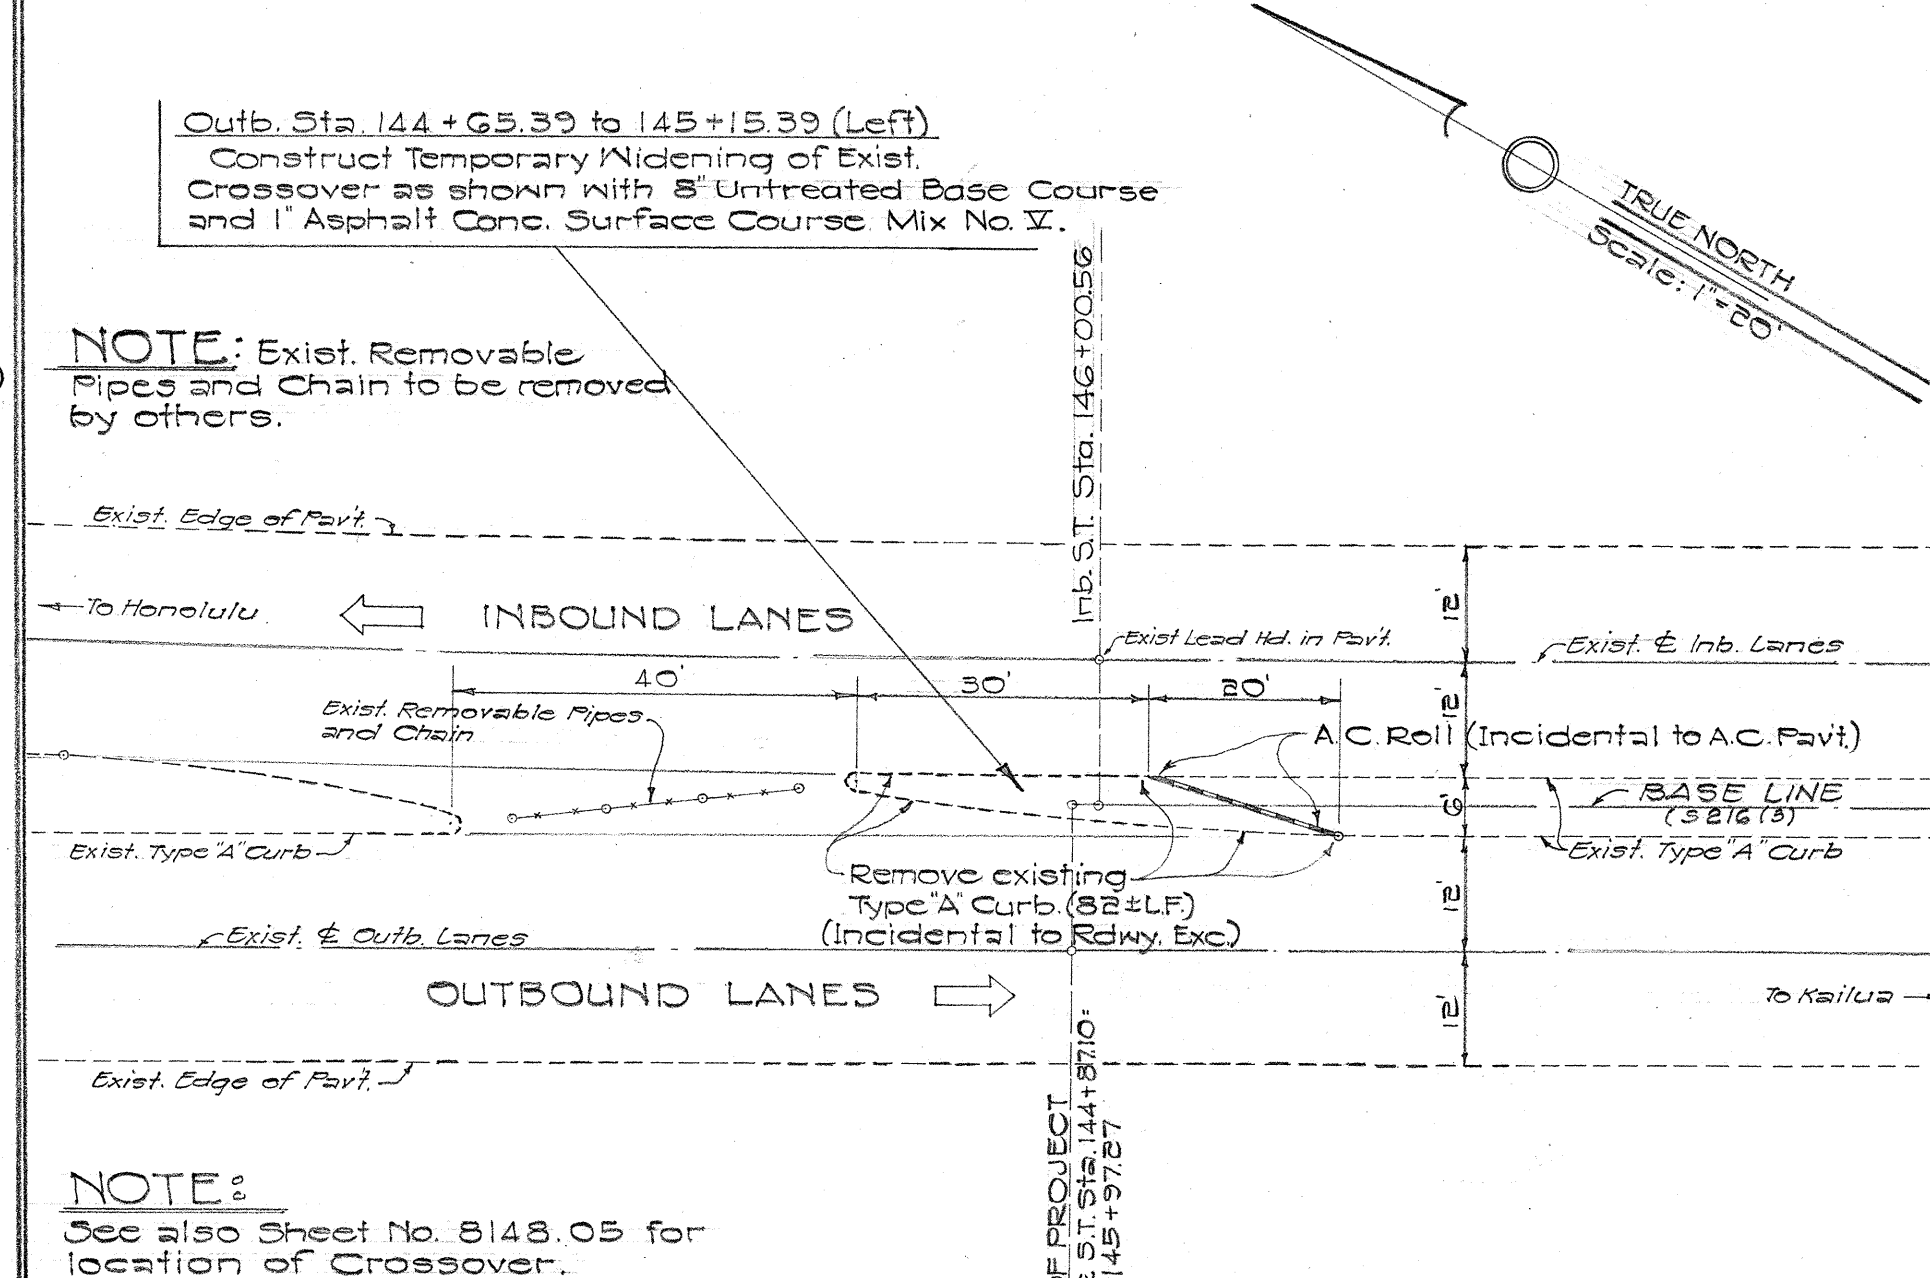

CROSS-OVER NO. 3

DETAIL OF TEMPORARY WIDENING OF EXISTING CROSS-OVER
ON PALI HIGHWAY
Scale: 1"=20'

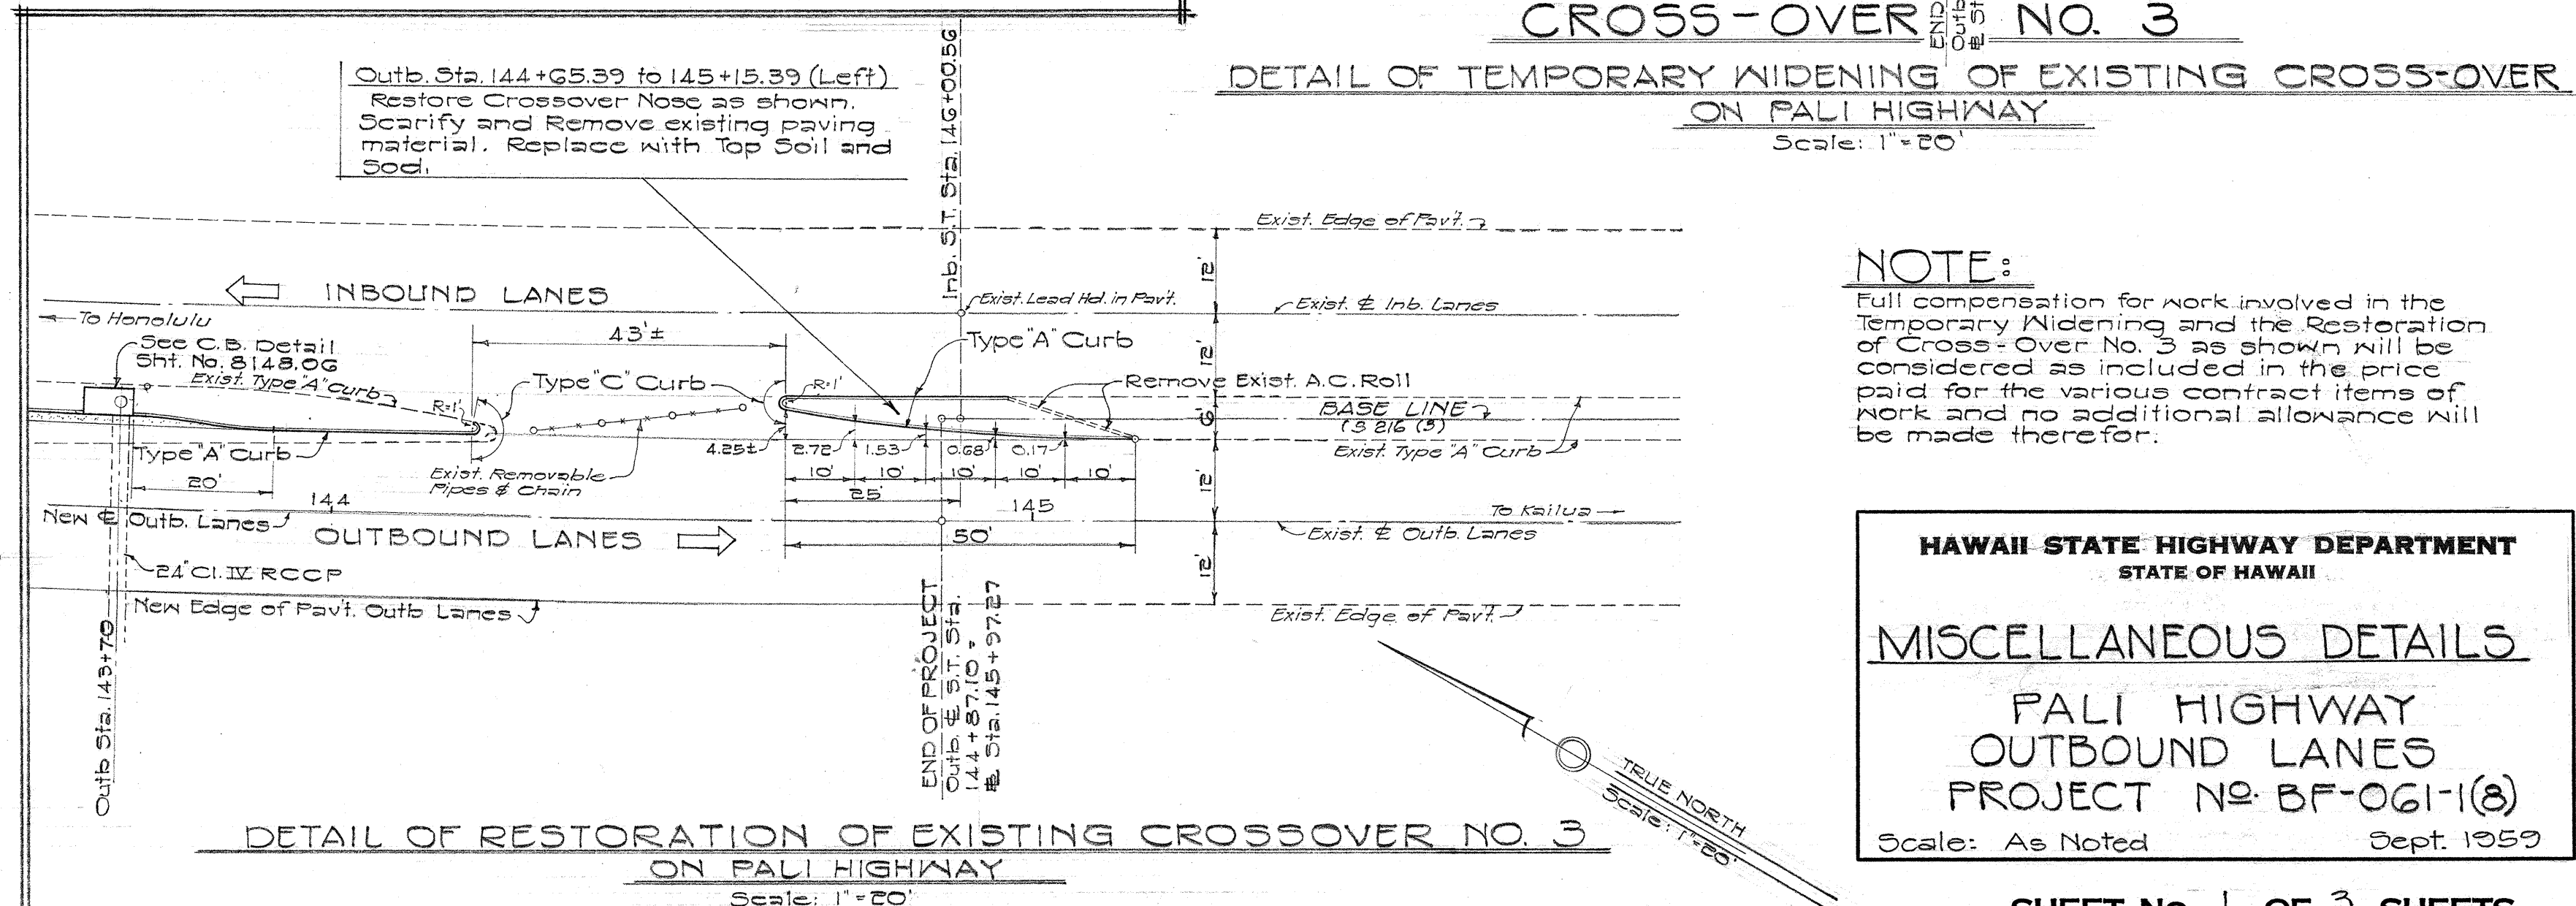

DETAIL OF RESTORATION OF EXISTING CROSSOVER NO. 3
ON PALI HIGHWAY
Scale: 1"=80'

HAWAII STATE HIGHWAY DEPARTMENT
STATE OF HAWAII

MISCELLANEOUS DETAILS






PALI HIGHWAY
OUTBOUND LANES
PROJECT NO. BF-061-1(8)

Scale: As Noted Sept. 1954

SHEET No. 1 OF 3 SHEETS




.8148.05

FED. ROAD DIST. No.	STATE	FED. AID PROJ. No.	FISCAL YEAR	SHEET No.	TOTAL SHEETS
HAWAII	HAW.	BF-06-1(8)	1960	9	61

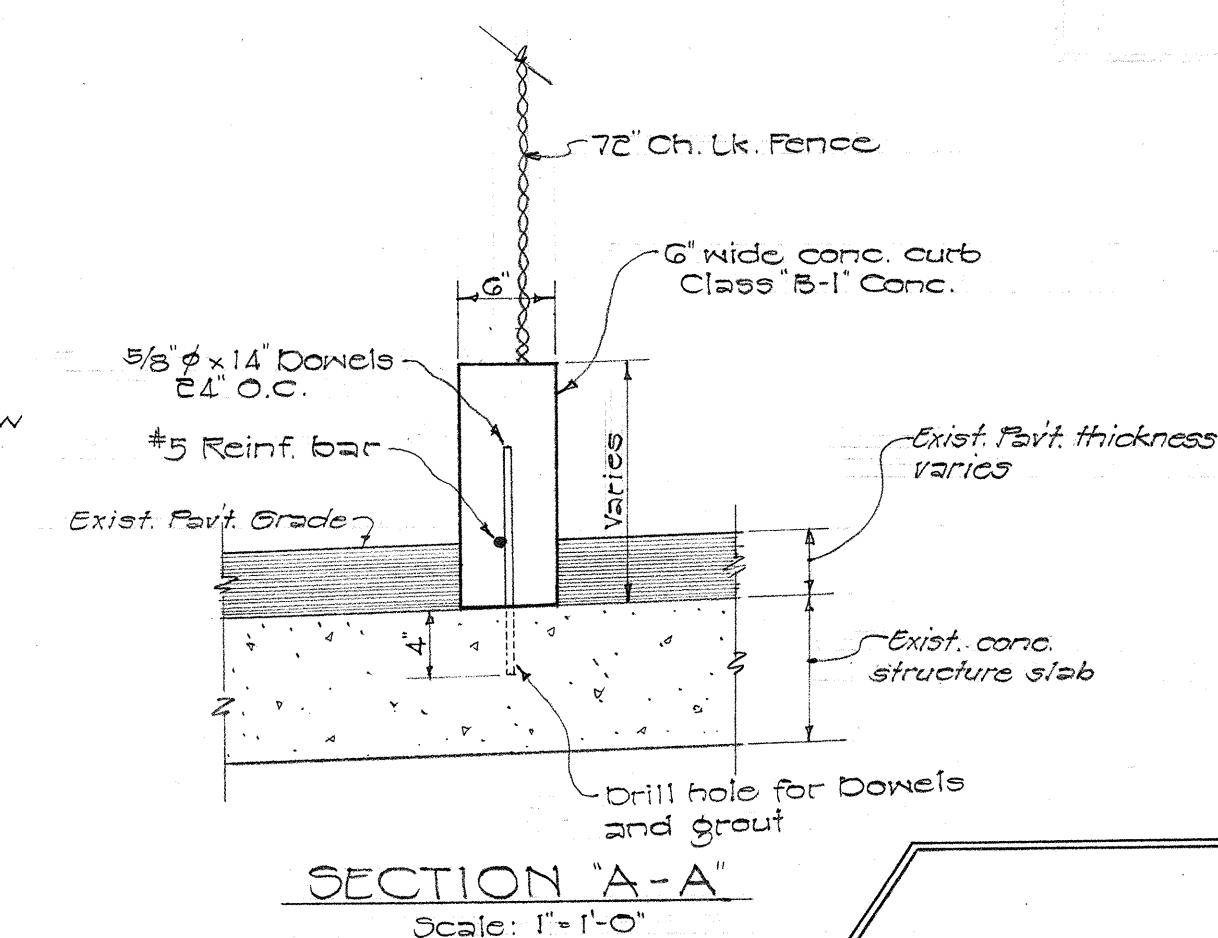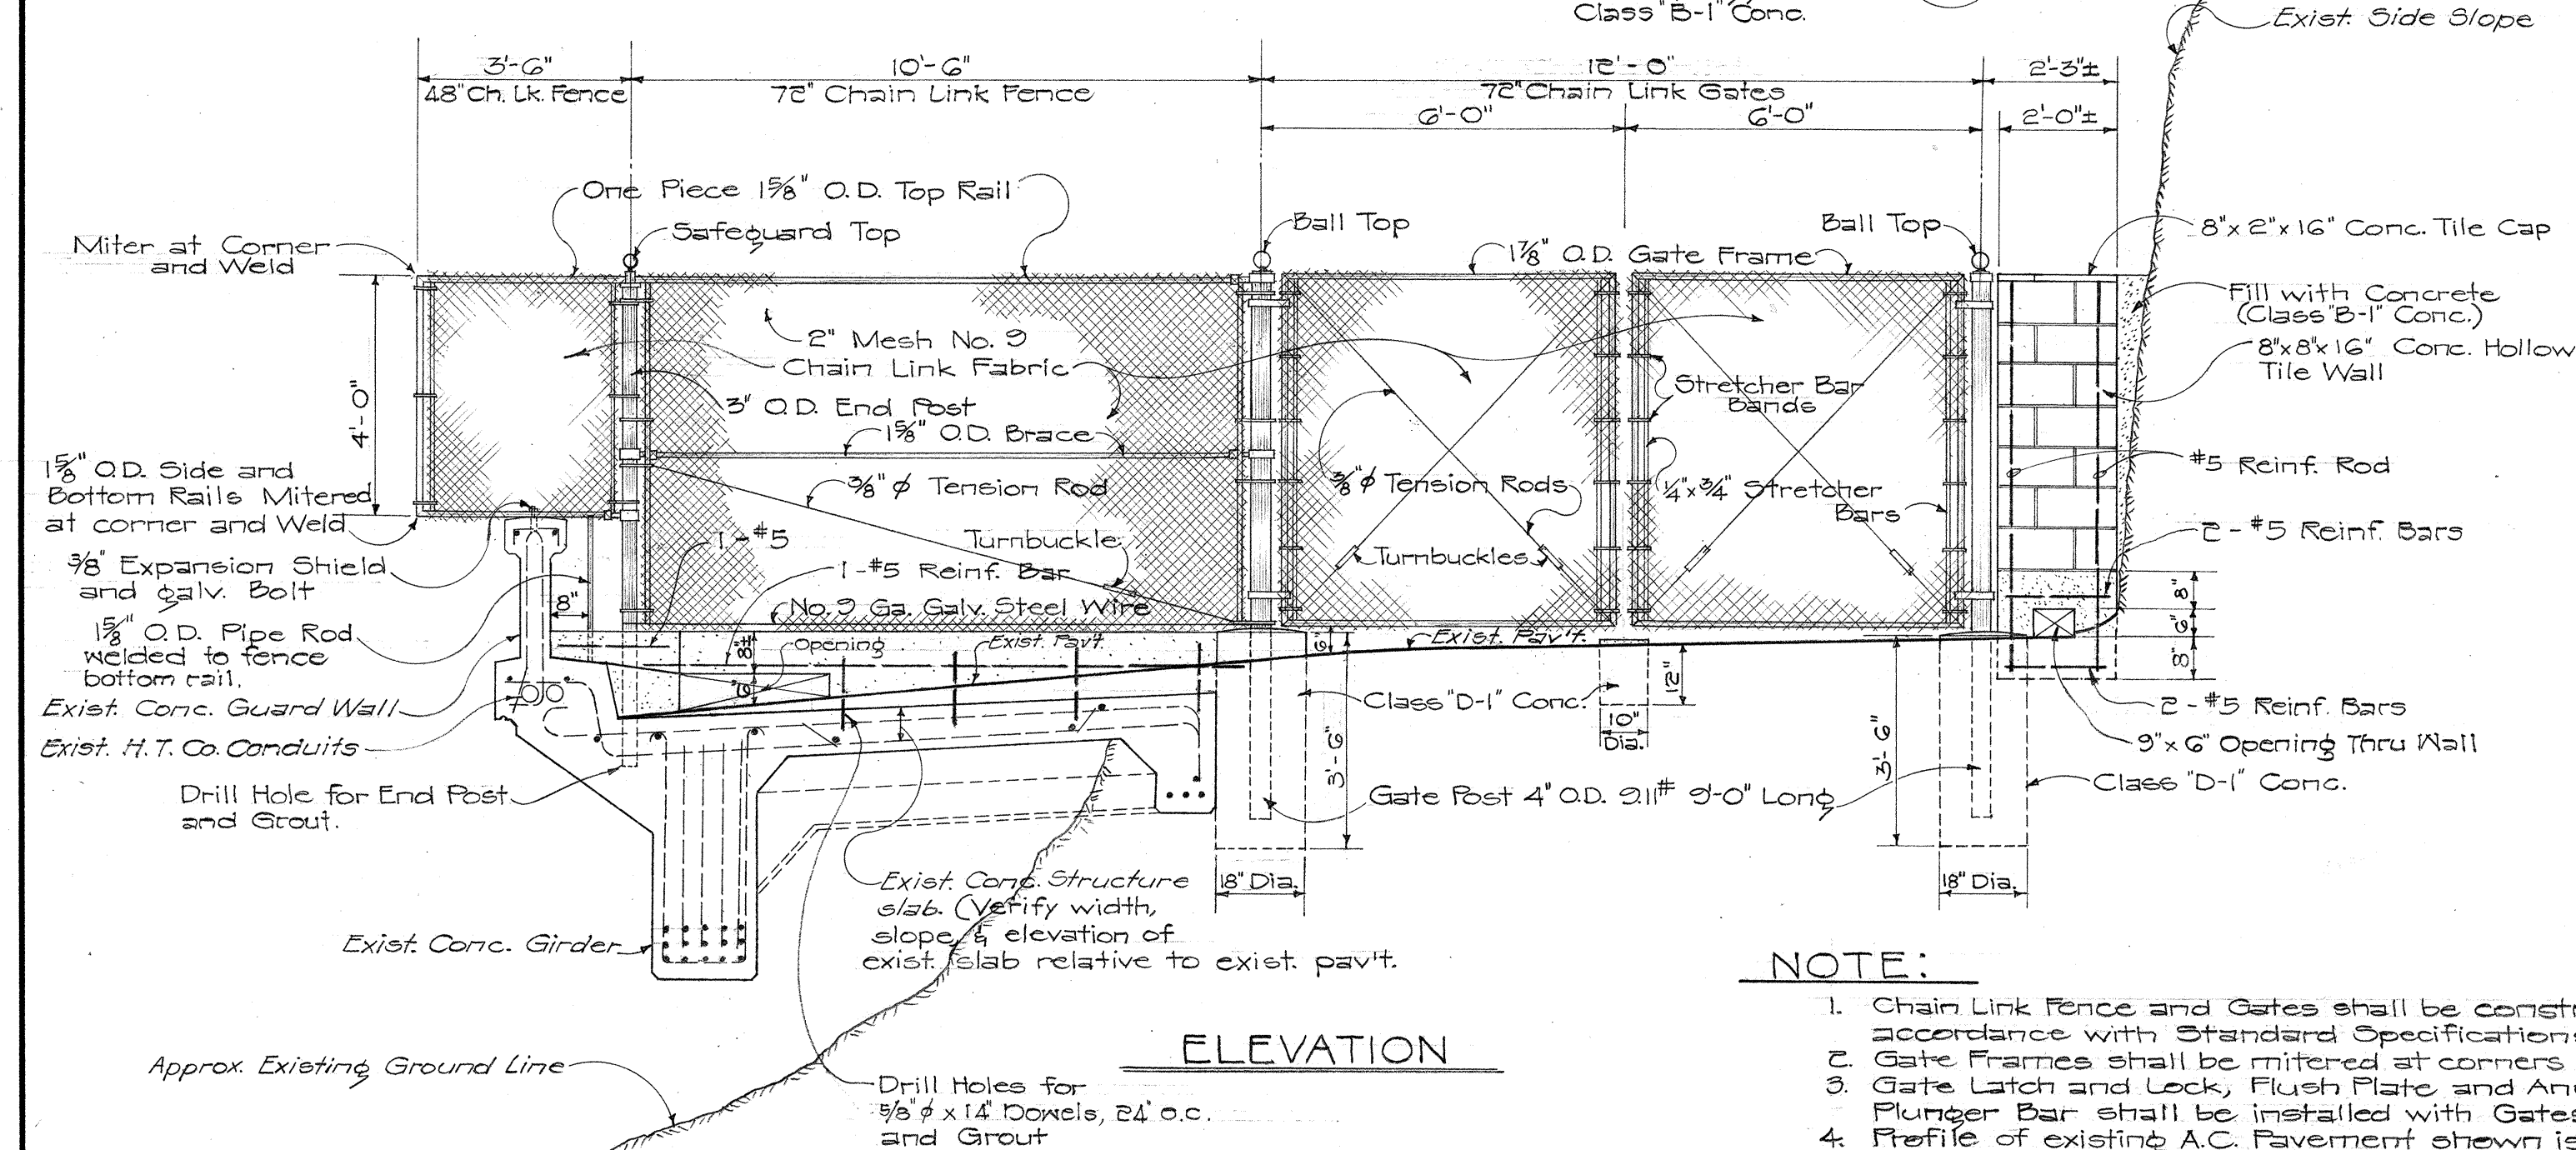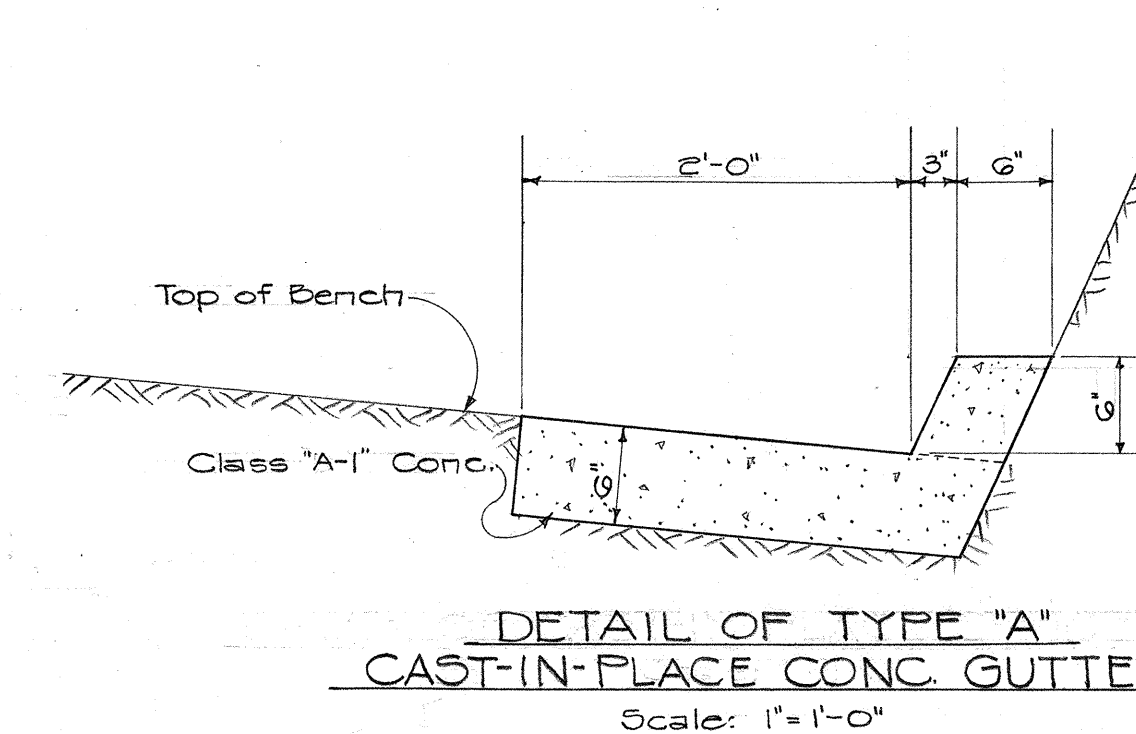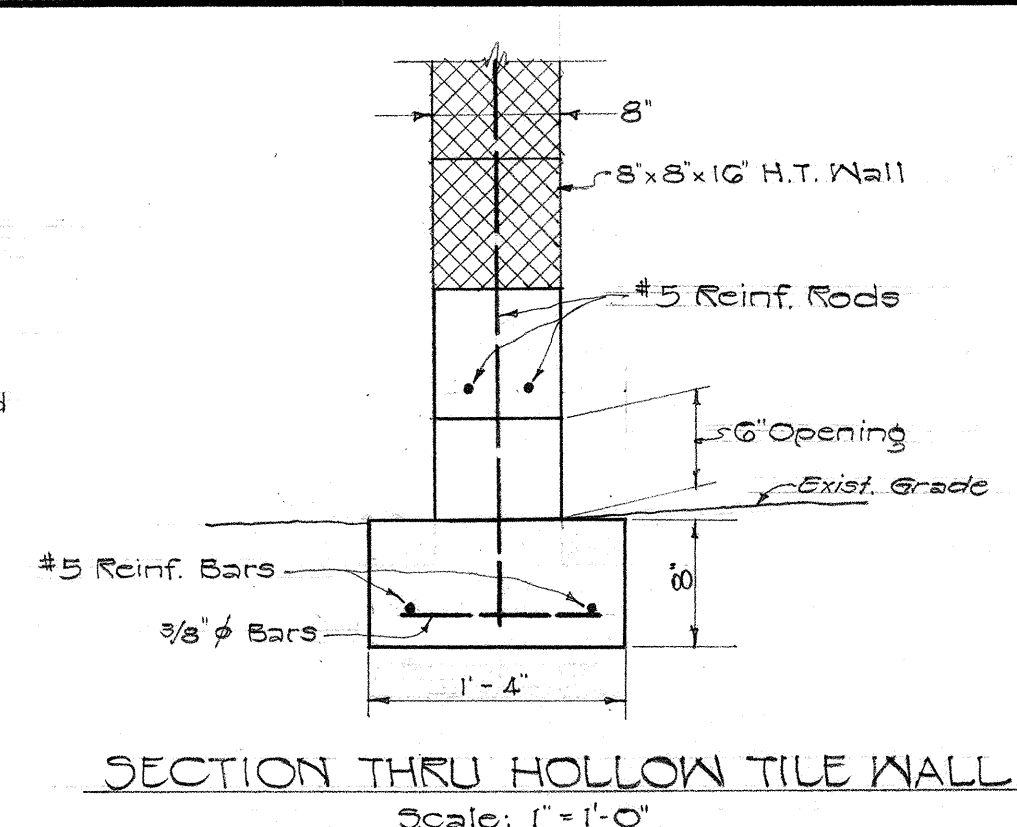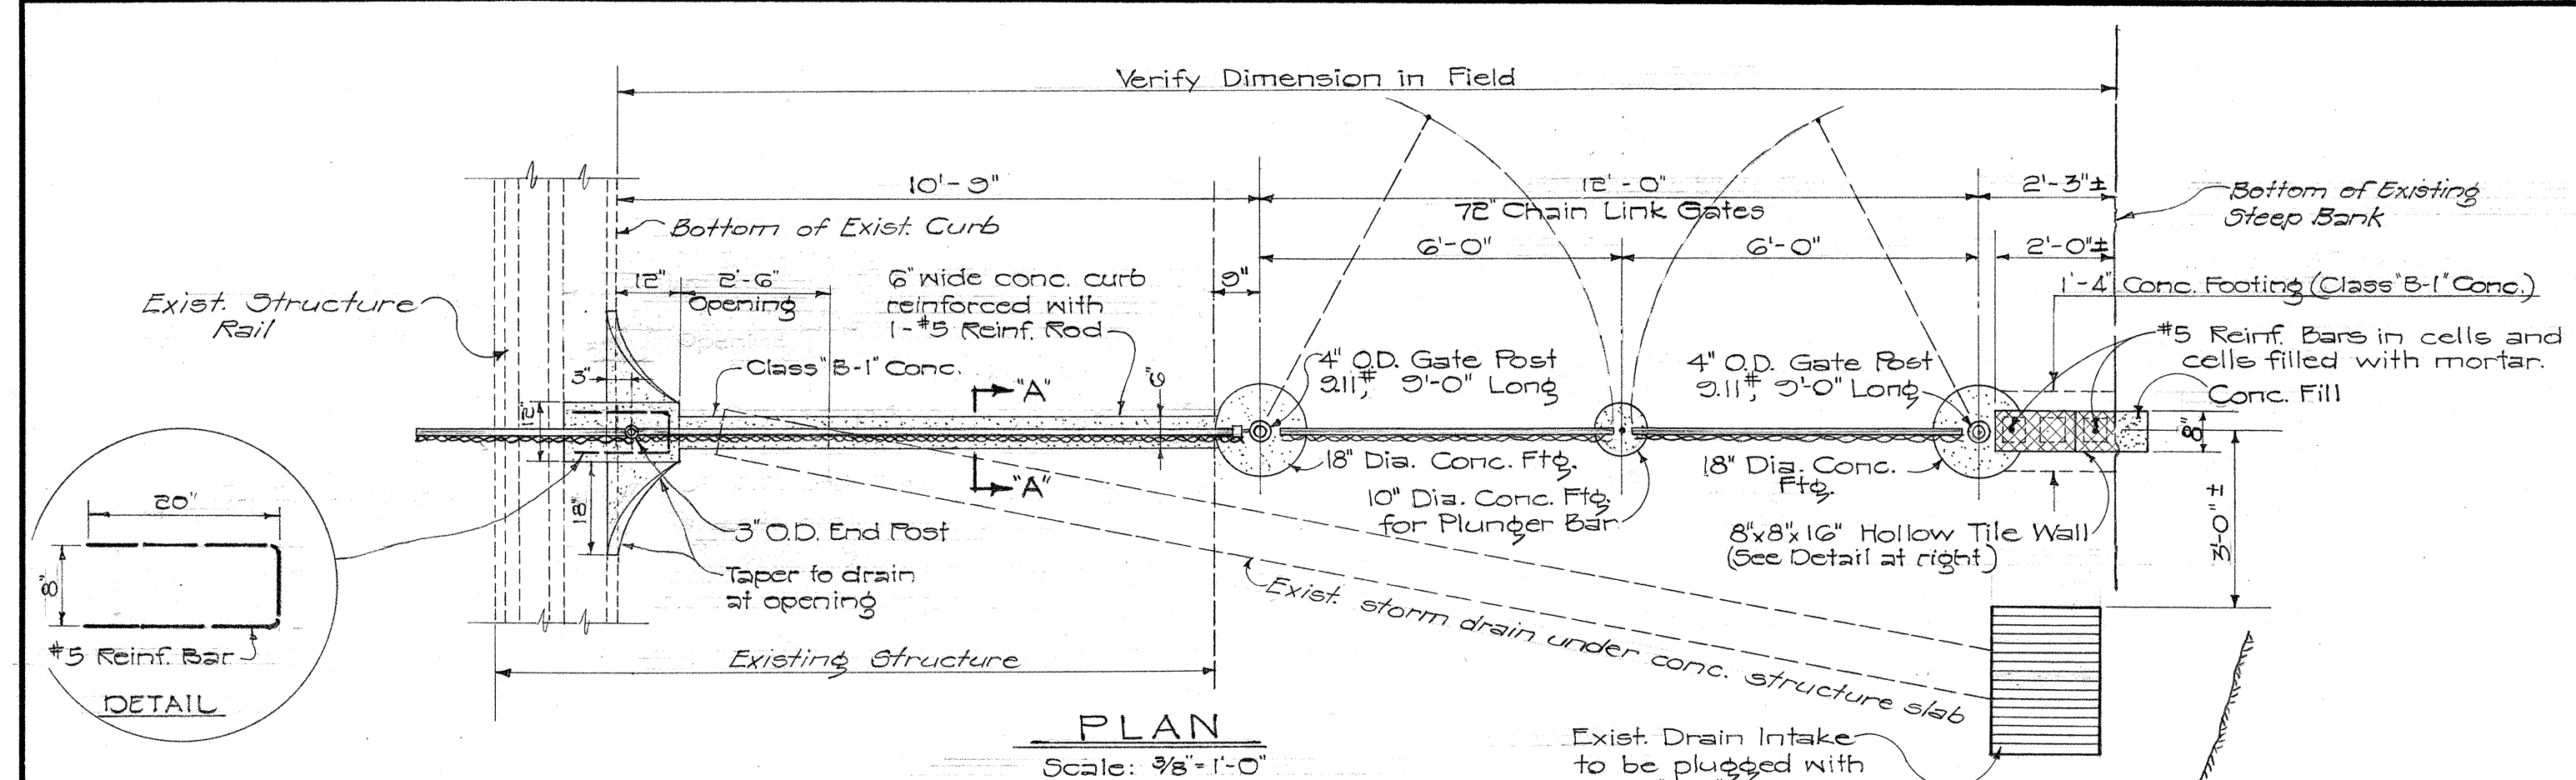

- NOTE:
1. Chain Link Fence and Gates shall be constructed in accordance with Standard Specifications.
 2. Gate Frames shall be mitered at corners and welded.
 3. Gate Latch and Lock, Flush Plate and Anchor Hinges, and Plunger Bar shall be installed with Gates.
 4. Profile of existing A.C. Pavement shown is approximate. Contractor shall verify same and adjust his work accordingly.
- See Section 88A of Special Provisions.

- ## NOTE:
1. Exact location of the Separation Turn and Cross-Over to be determined in the field by the Engineer.
 2. Separation Turn and Cross-Over shall be constructed so as to provide smooth riding connection to existing pavt.
 3. Full compensation for the construction of the paved Separation Turn and Cross-Over as shown will be considered as included in the price paid for the various contract items of and no additional allowance will be made therefor.

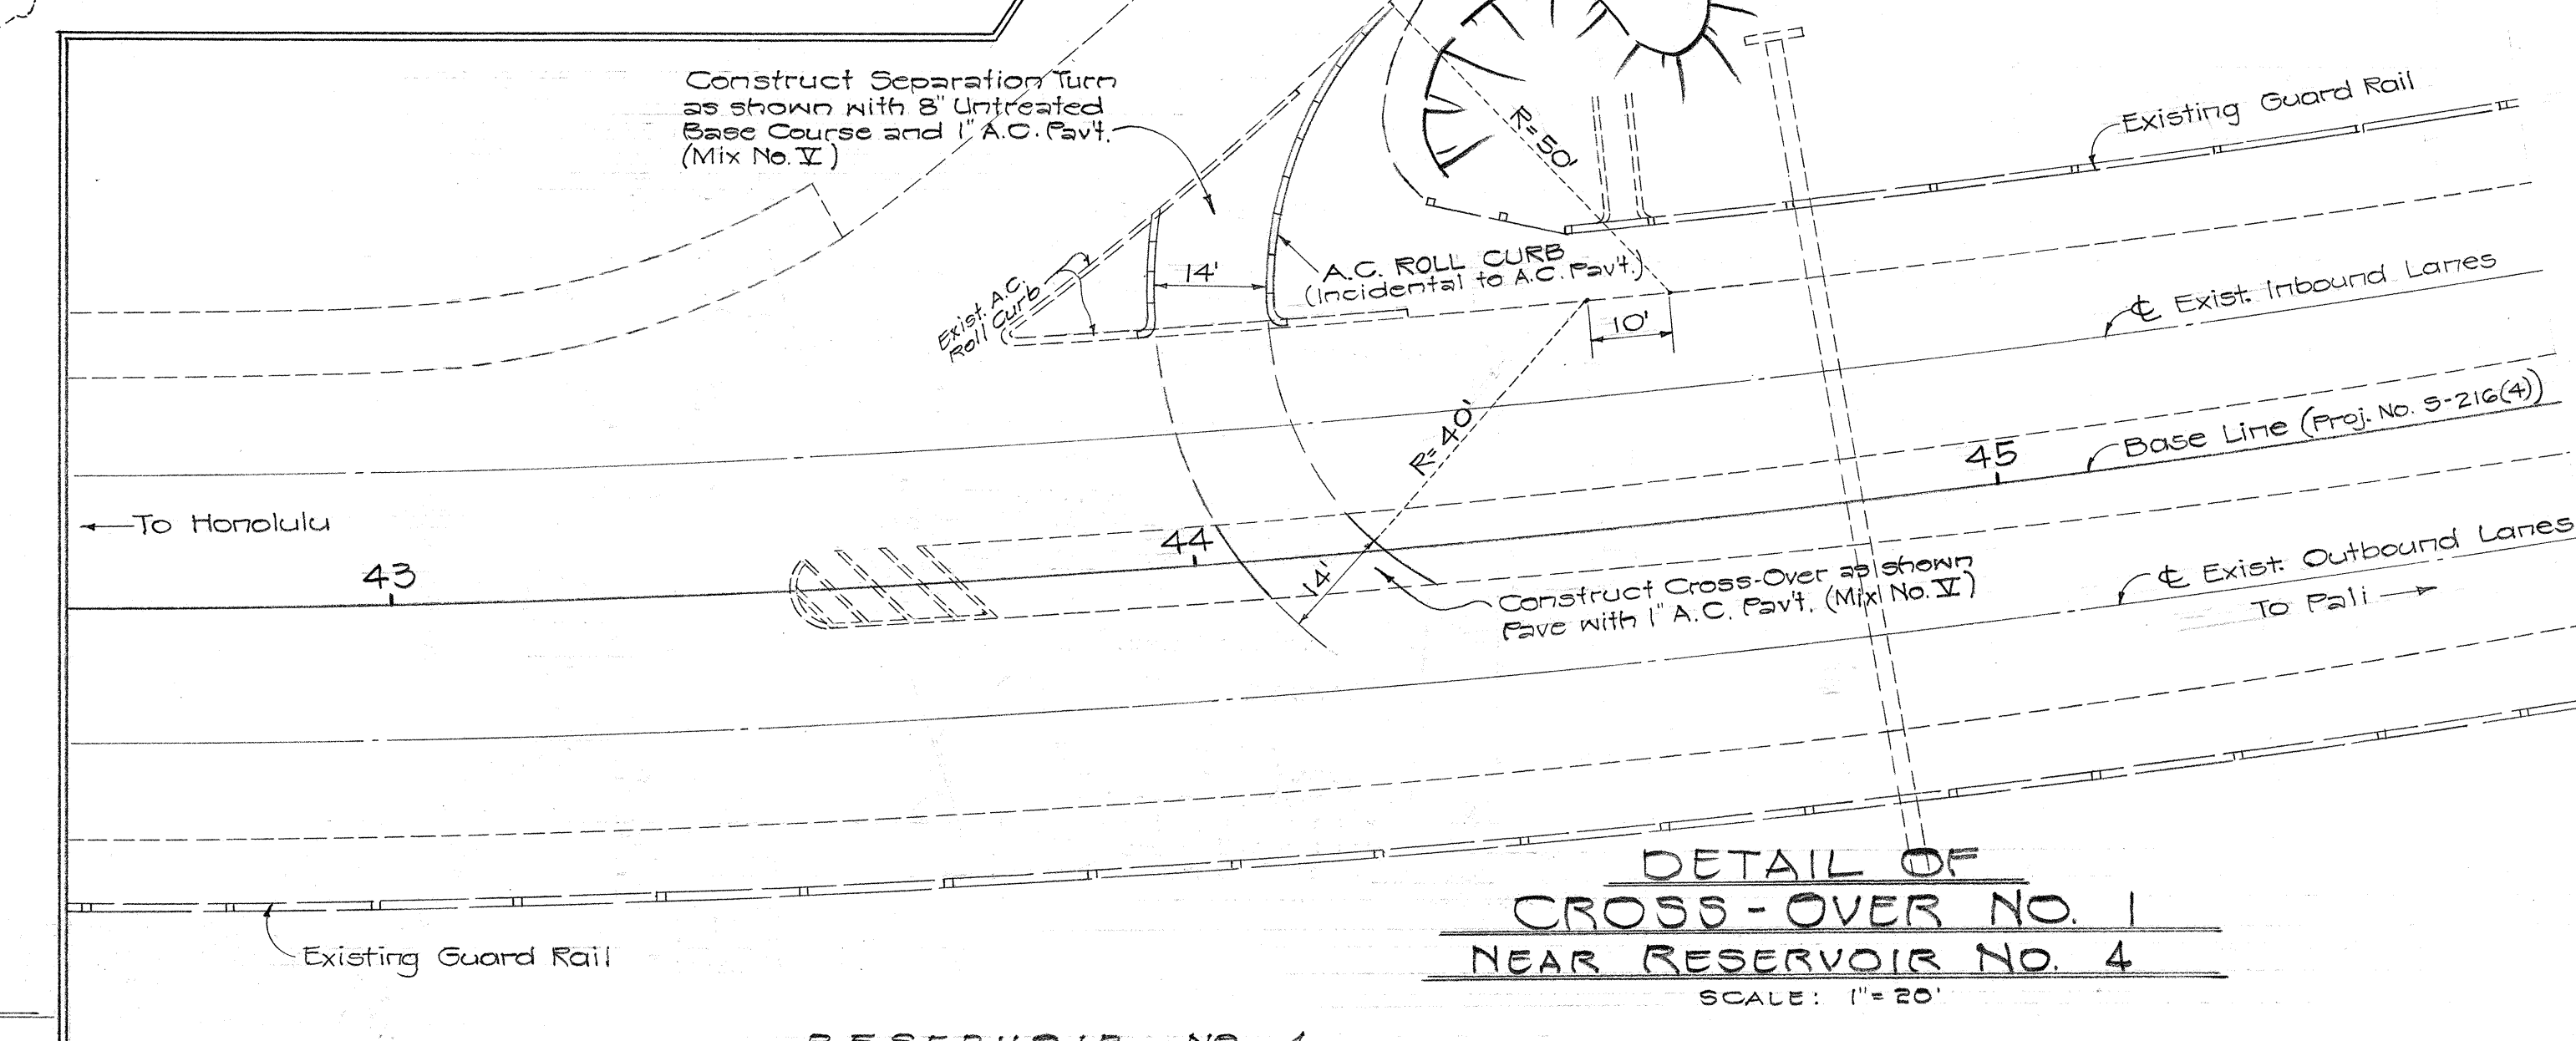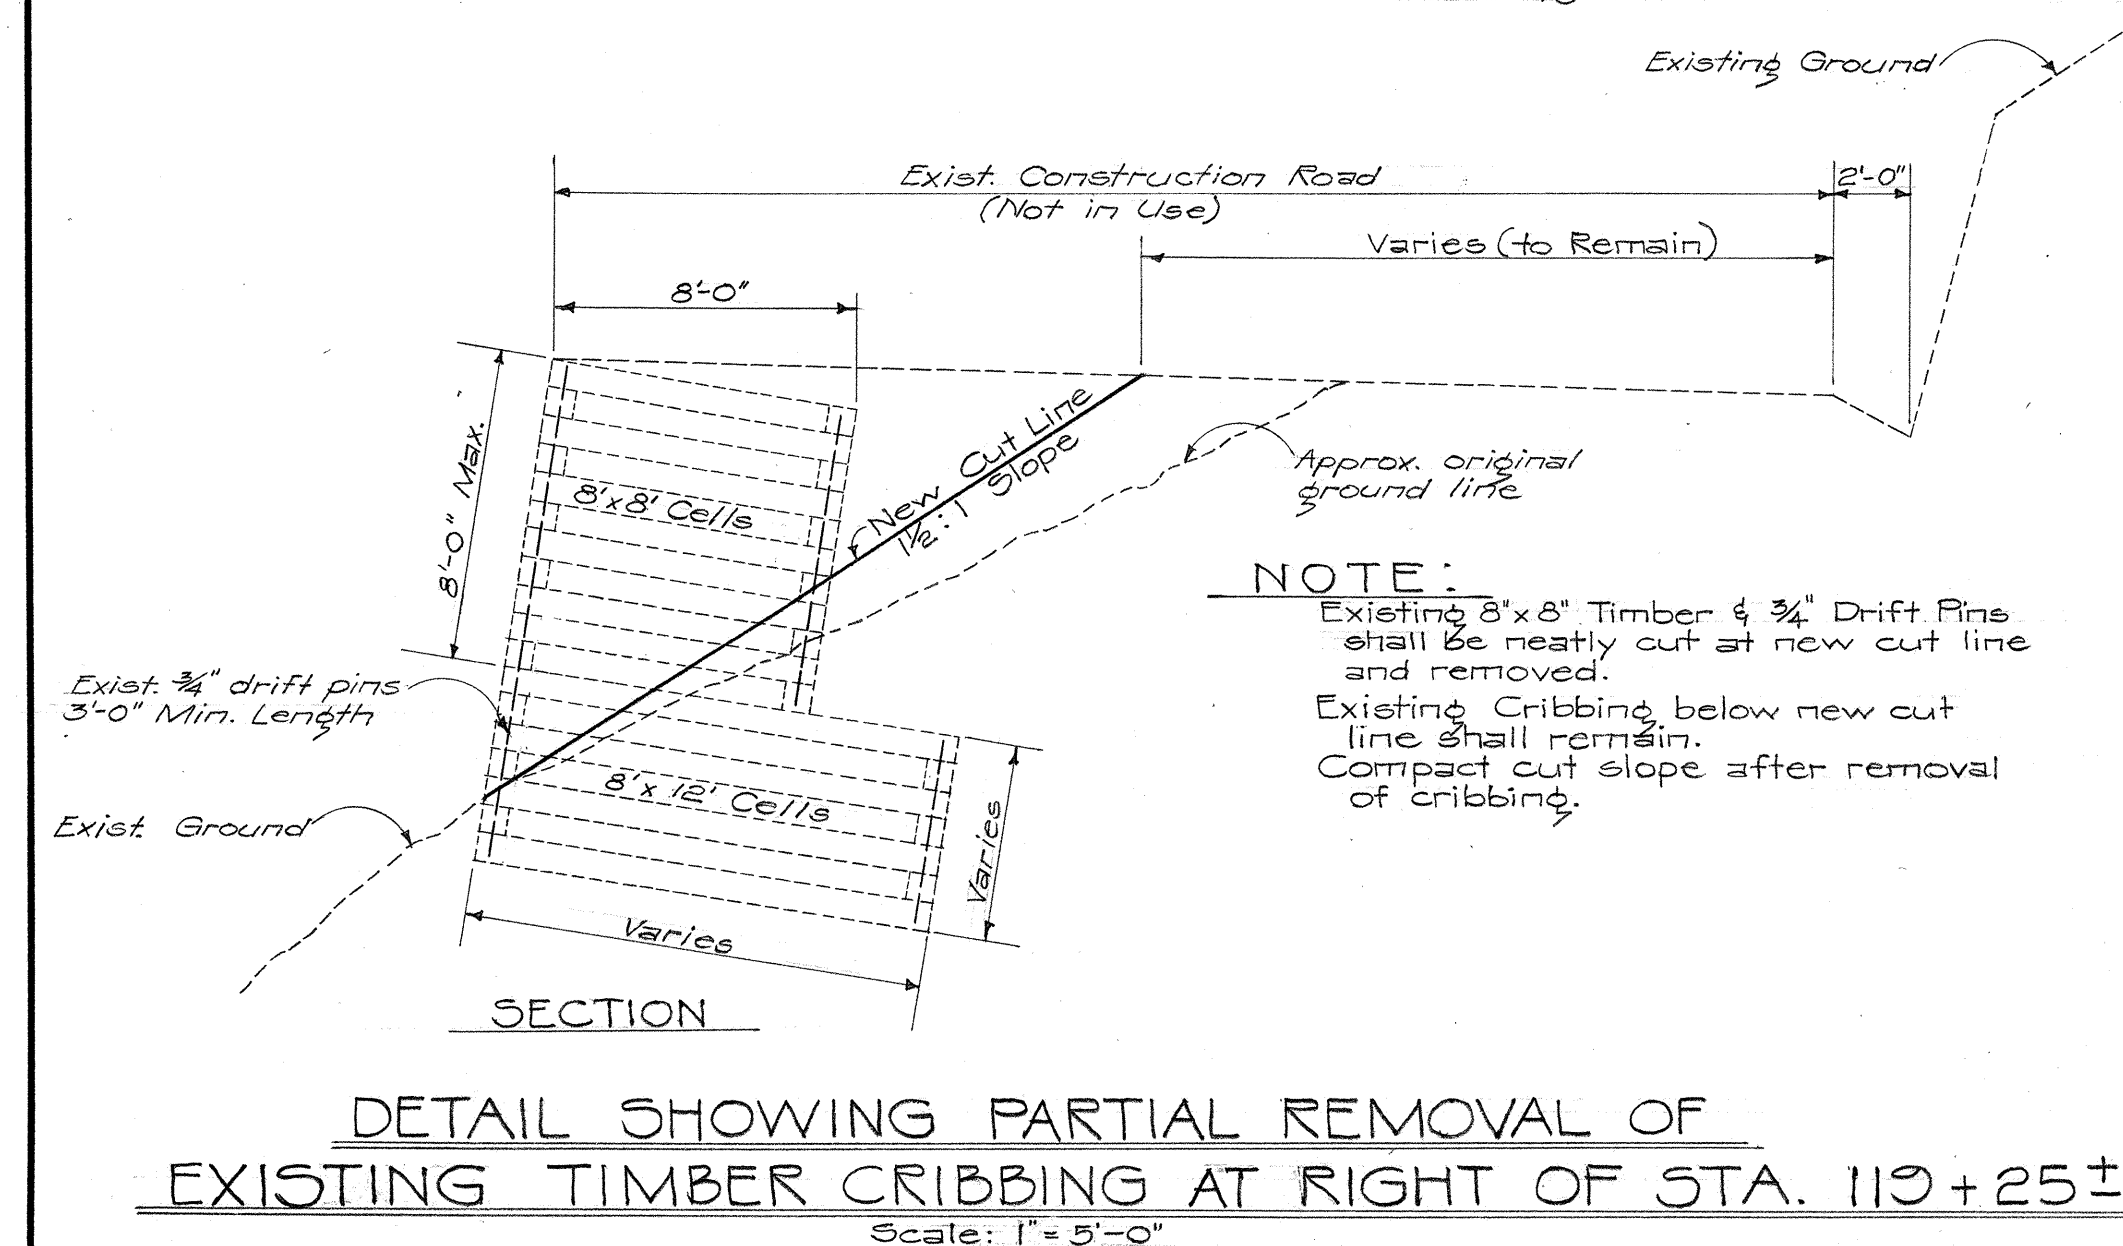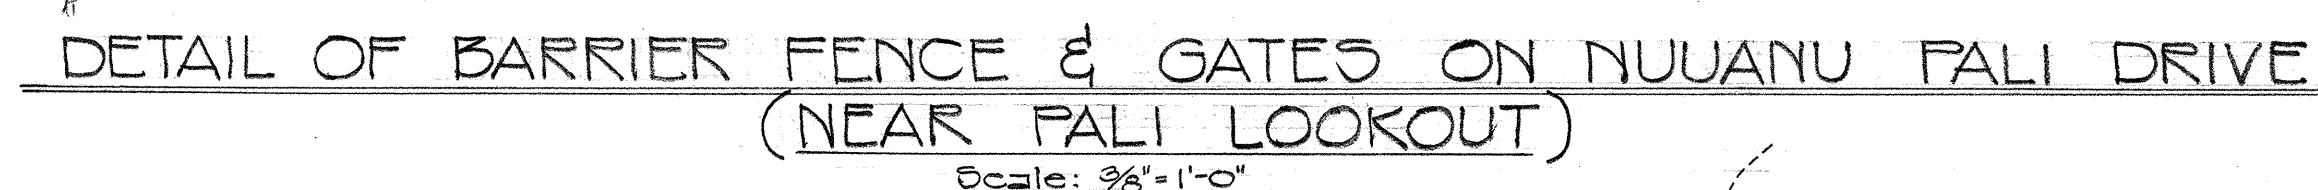

ORIGINAL PLAN	SURVEY PLOTTED BY _____ DATE _____
NOTE BOOK No. _____	DESIGNED BY _____
	DRAWN BY _____
	TRACED BY _____
	QUANTITIES BY _____
	QUANTITIES CHECKED BY _____
	CHECKED BY _____

HAWAII STATE HIGHWAY DEPARTMENT
STATE OF HAWAII
MISCELLANEOUS DETAILS
PALI HIGHWAY
OUTBOUND LANES
PROJECT NO. BF-061-1(8)
Scale: As Noted Sept. 1959

SHEET No. 3 OF 3 SHEETS

.8148.09