

| PLAN | SURVEYED | DATE |
|------|----------|------|
| NO.  | NO.      | NO.  |

| PROFILE | SURVEYED | DATE |
|---------|----------|------|
| NO.     | NO.      | NO.  |


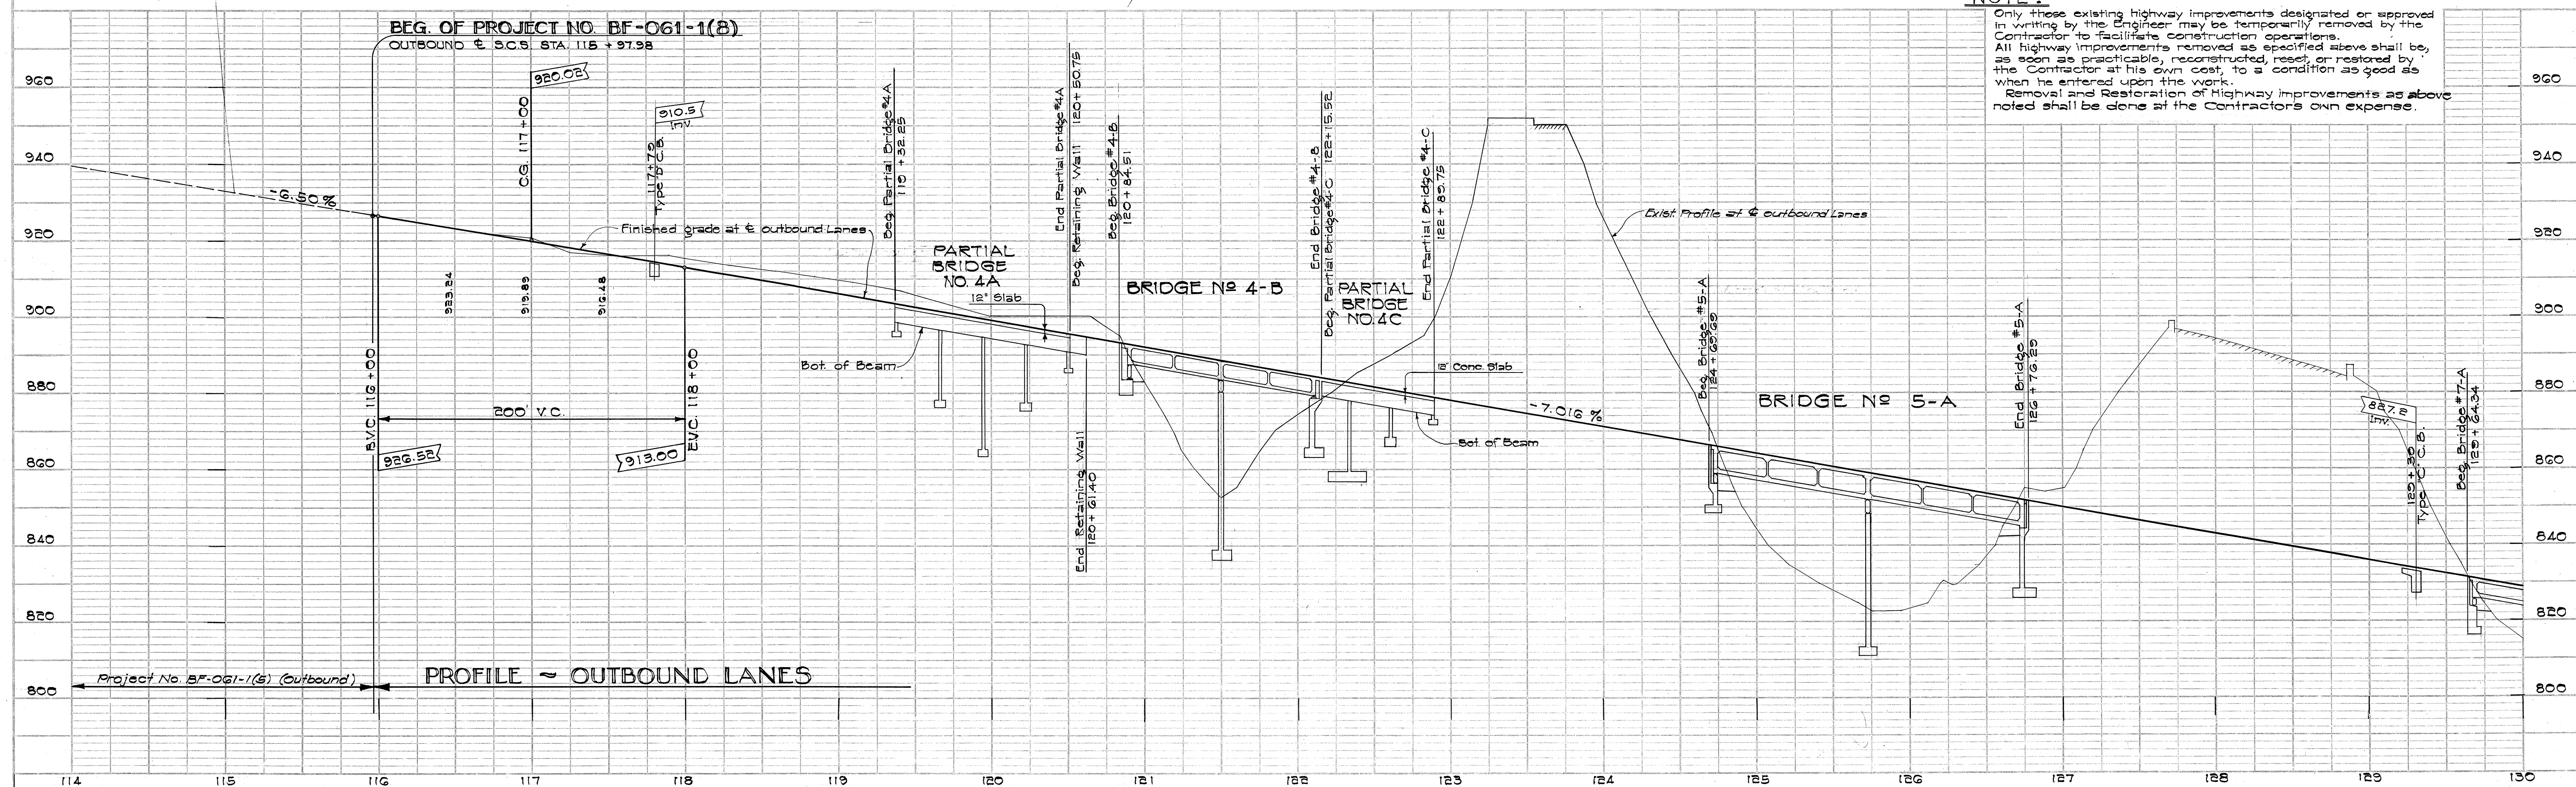


PLATE 1 - PLAN-PROFILE C. P. R. & E. STANDARD  
 REUPPEL & EBER CO., NEW YORK

8148.04

00-4-9

SHT #1 OF 2

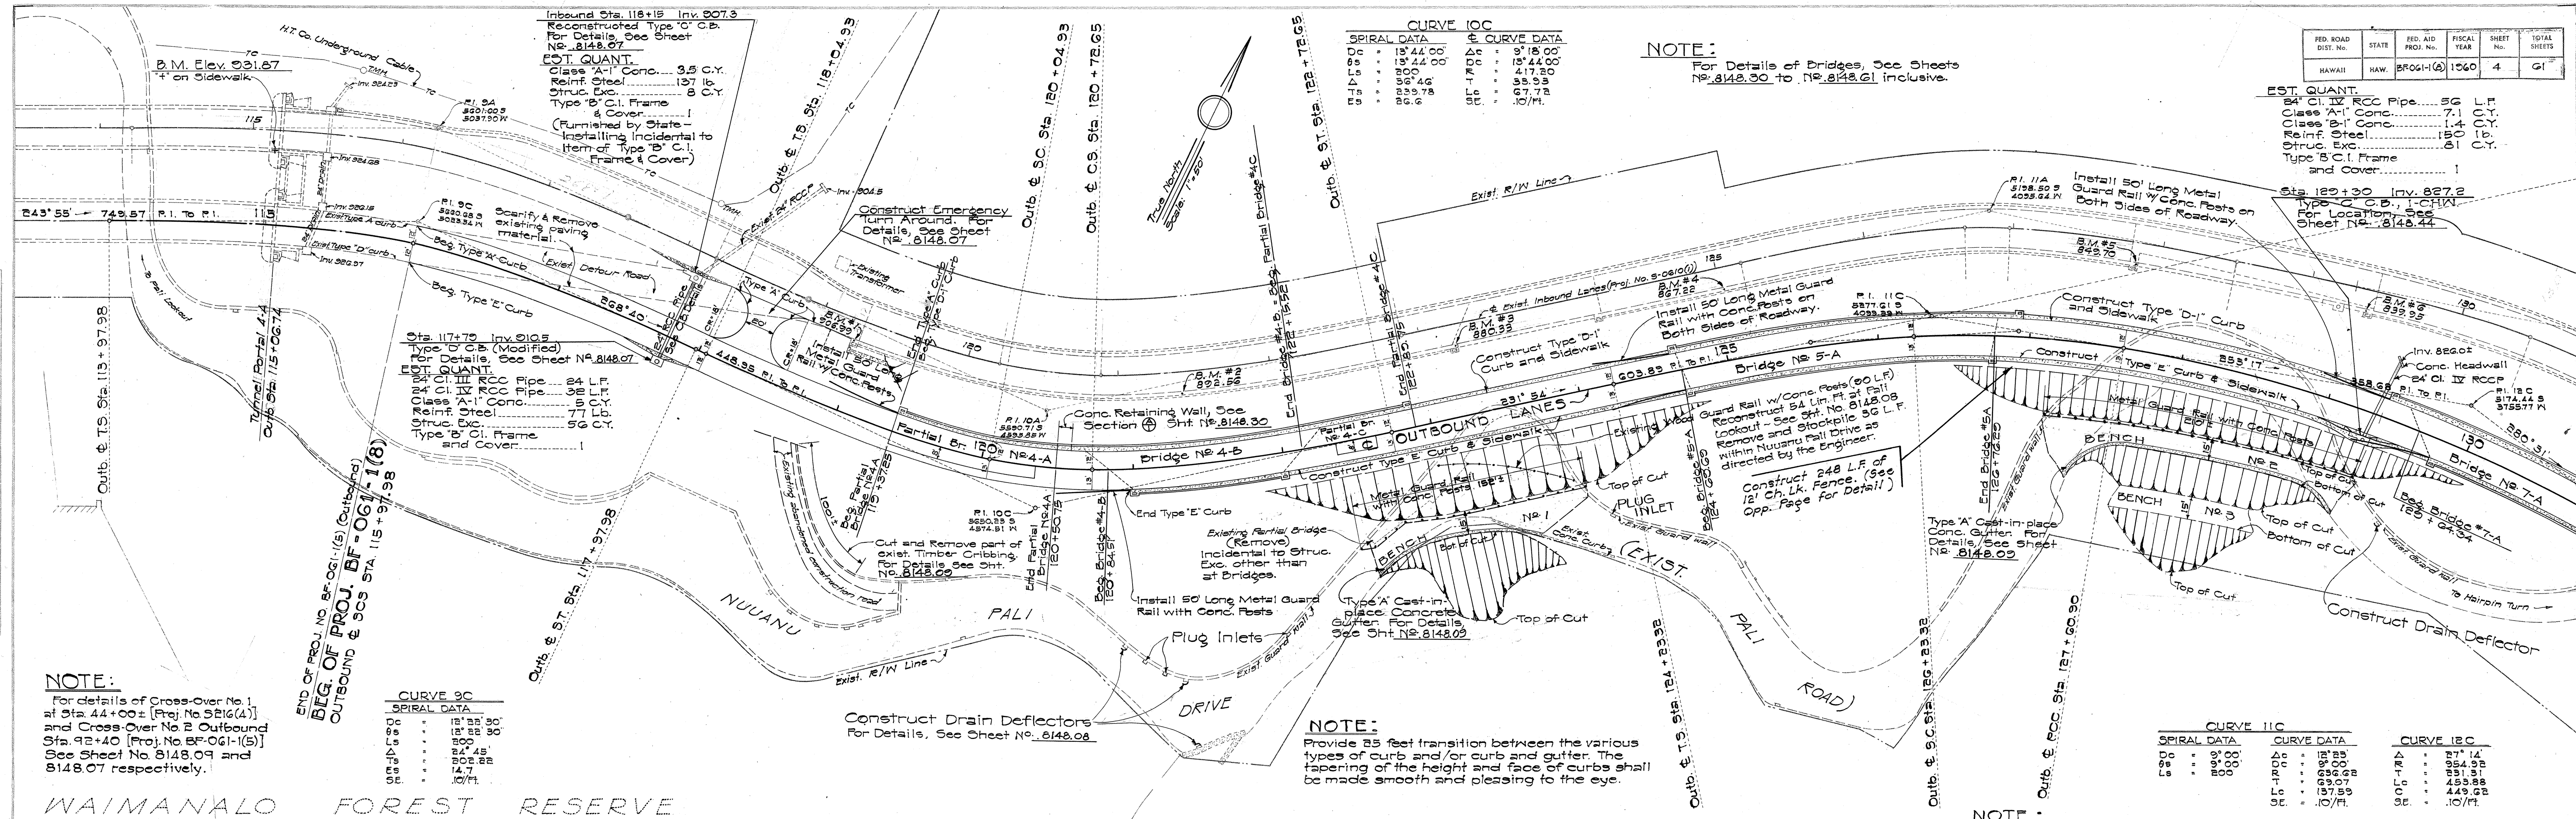