


FED. ROAD DIST. NO.	STATE	FED. AID PROJ. NO.	FISCAL YEAR	SHEET NO.	TOTAL SHEETS
HAWAII	HAW.	BF-061-1(8)	1960	5A	61

NOTE:

For sign panels and sign installation details, see Sheets No. 8148.5C and 8148.5D.
"B" signs are special blinker warning signs.
"S" signs are supplementary warning signs.
"D" signs are special directional signs.

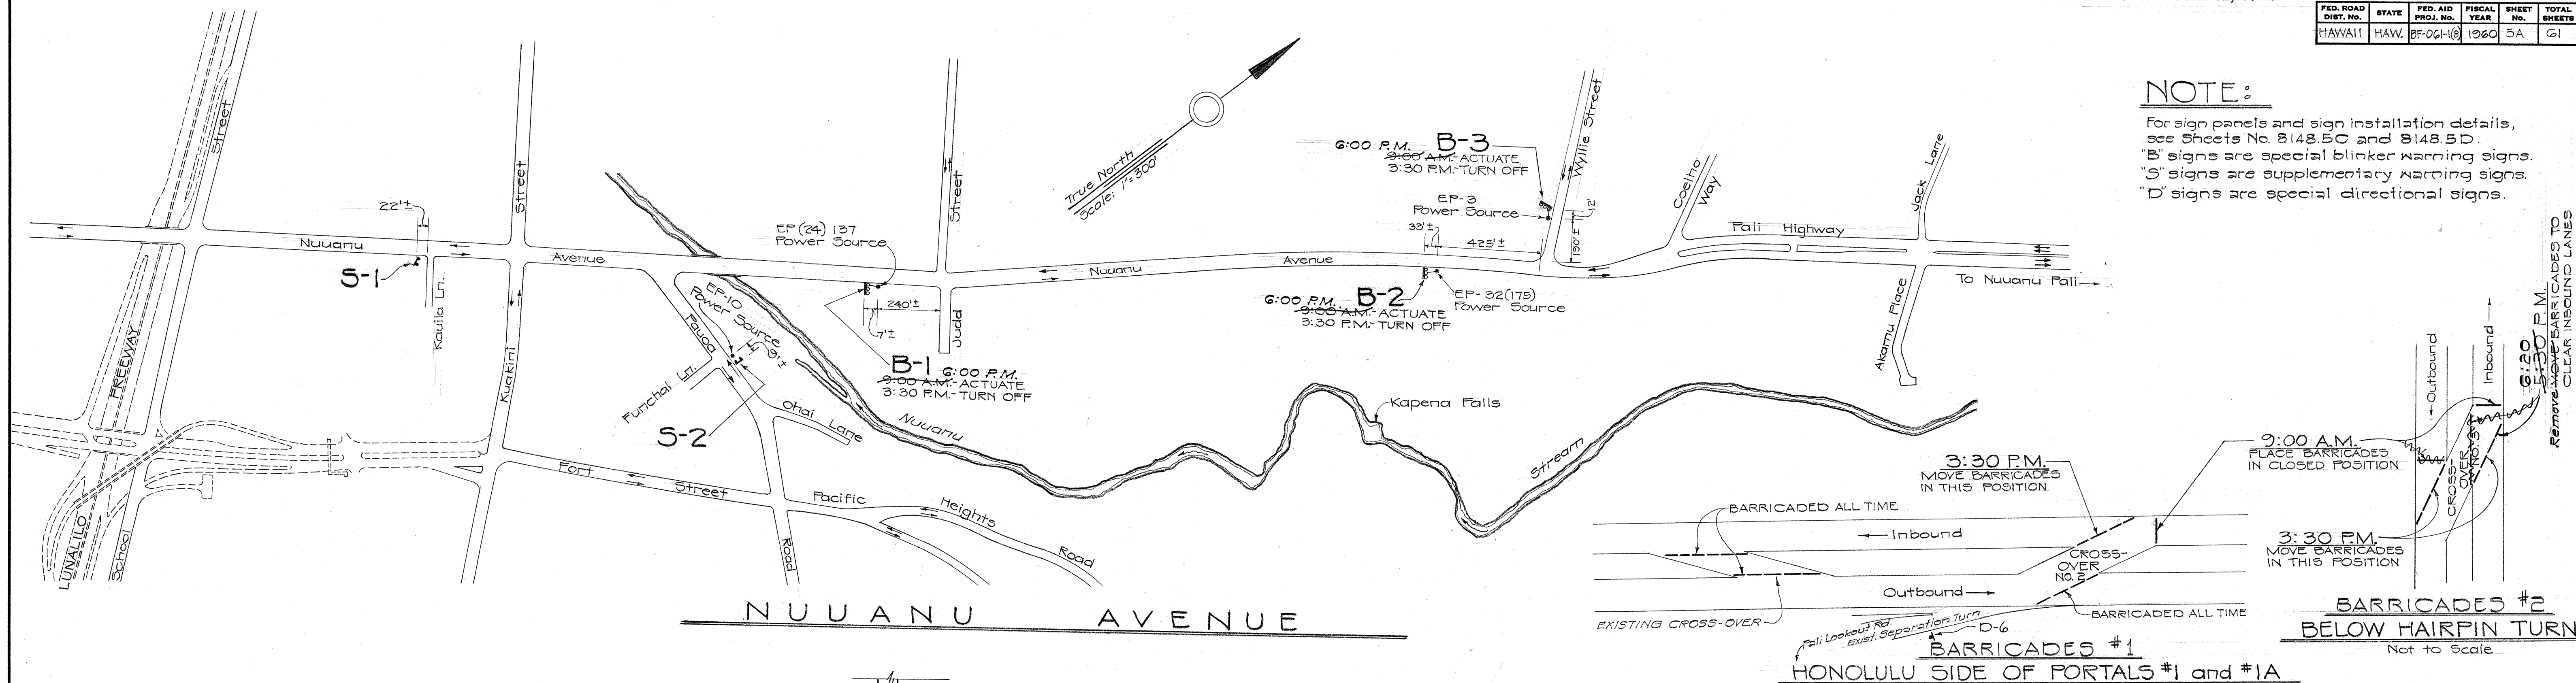


NUUANU AVENUE

HONOLULU SIDE OF PORTALS #1 and #1A


BARRICADES #2 BELOW HAIRPIN TURN

NOTE:

For details of Cross-Overs No. 2 and No. 3, see Sheet No. 8148.07.

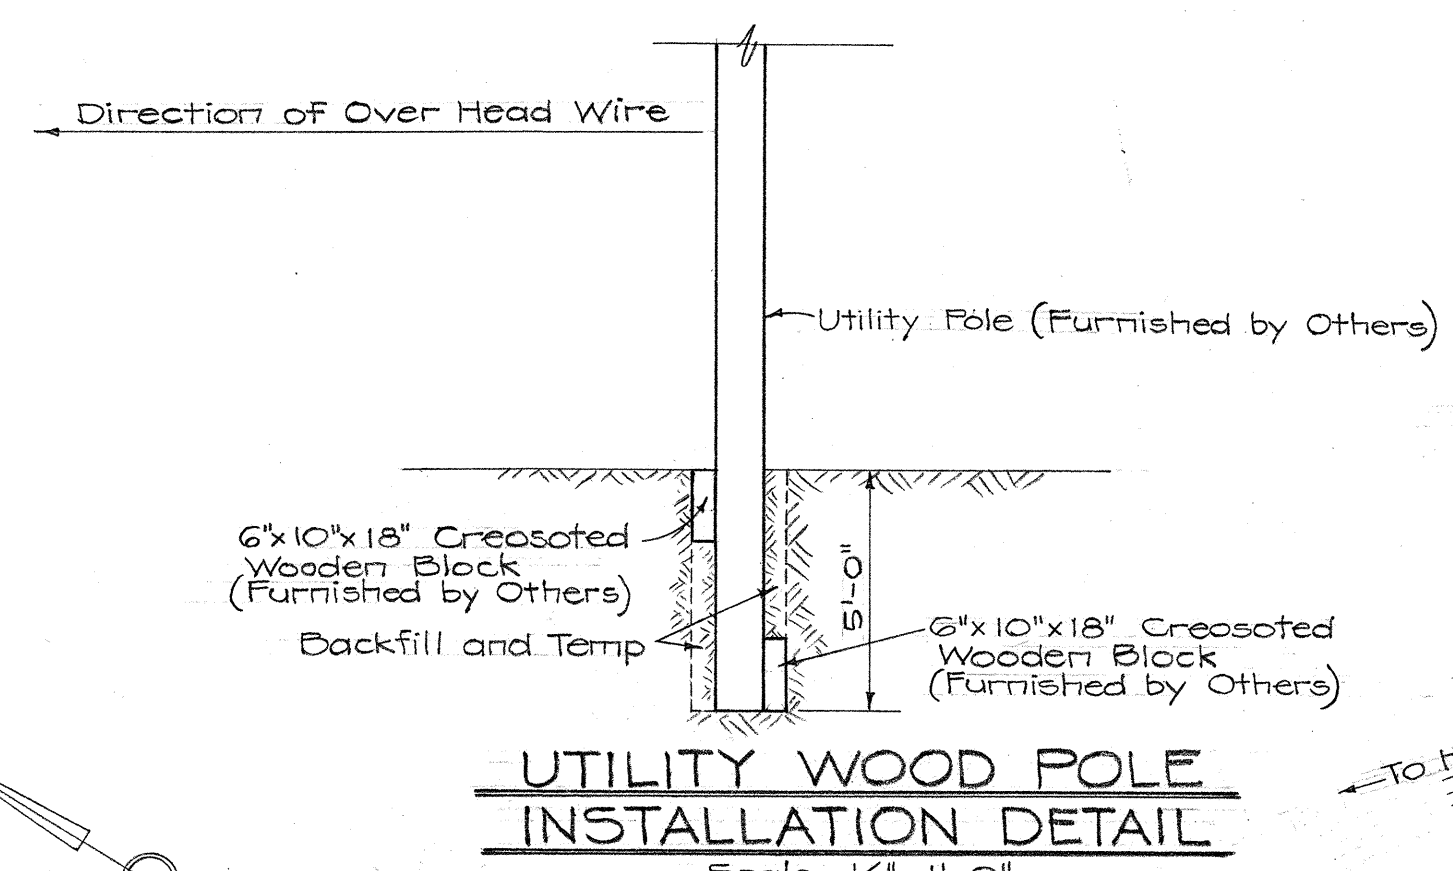

UTILITY WOOD POLE INSTALLATION DETAIL

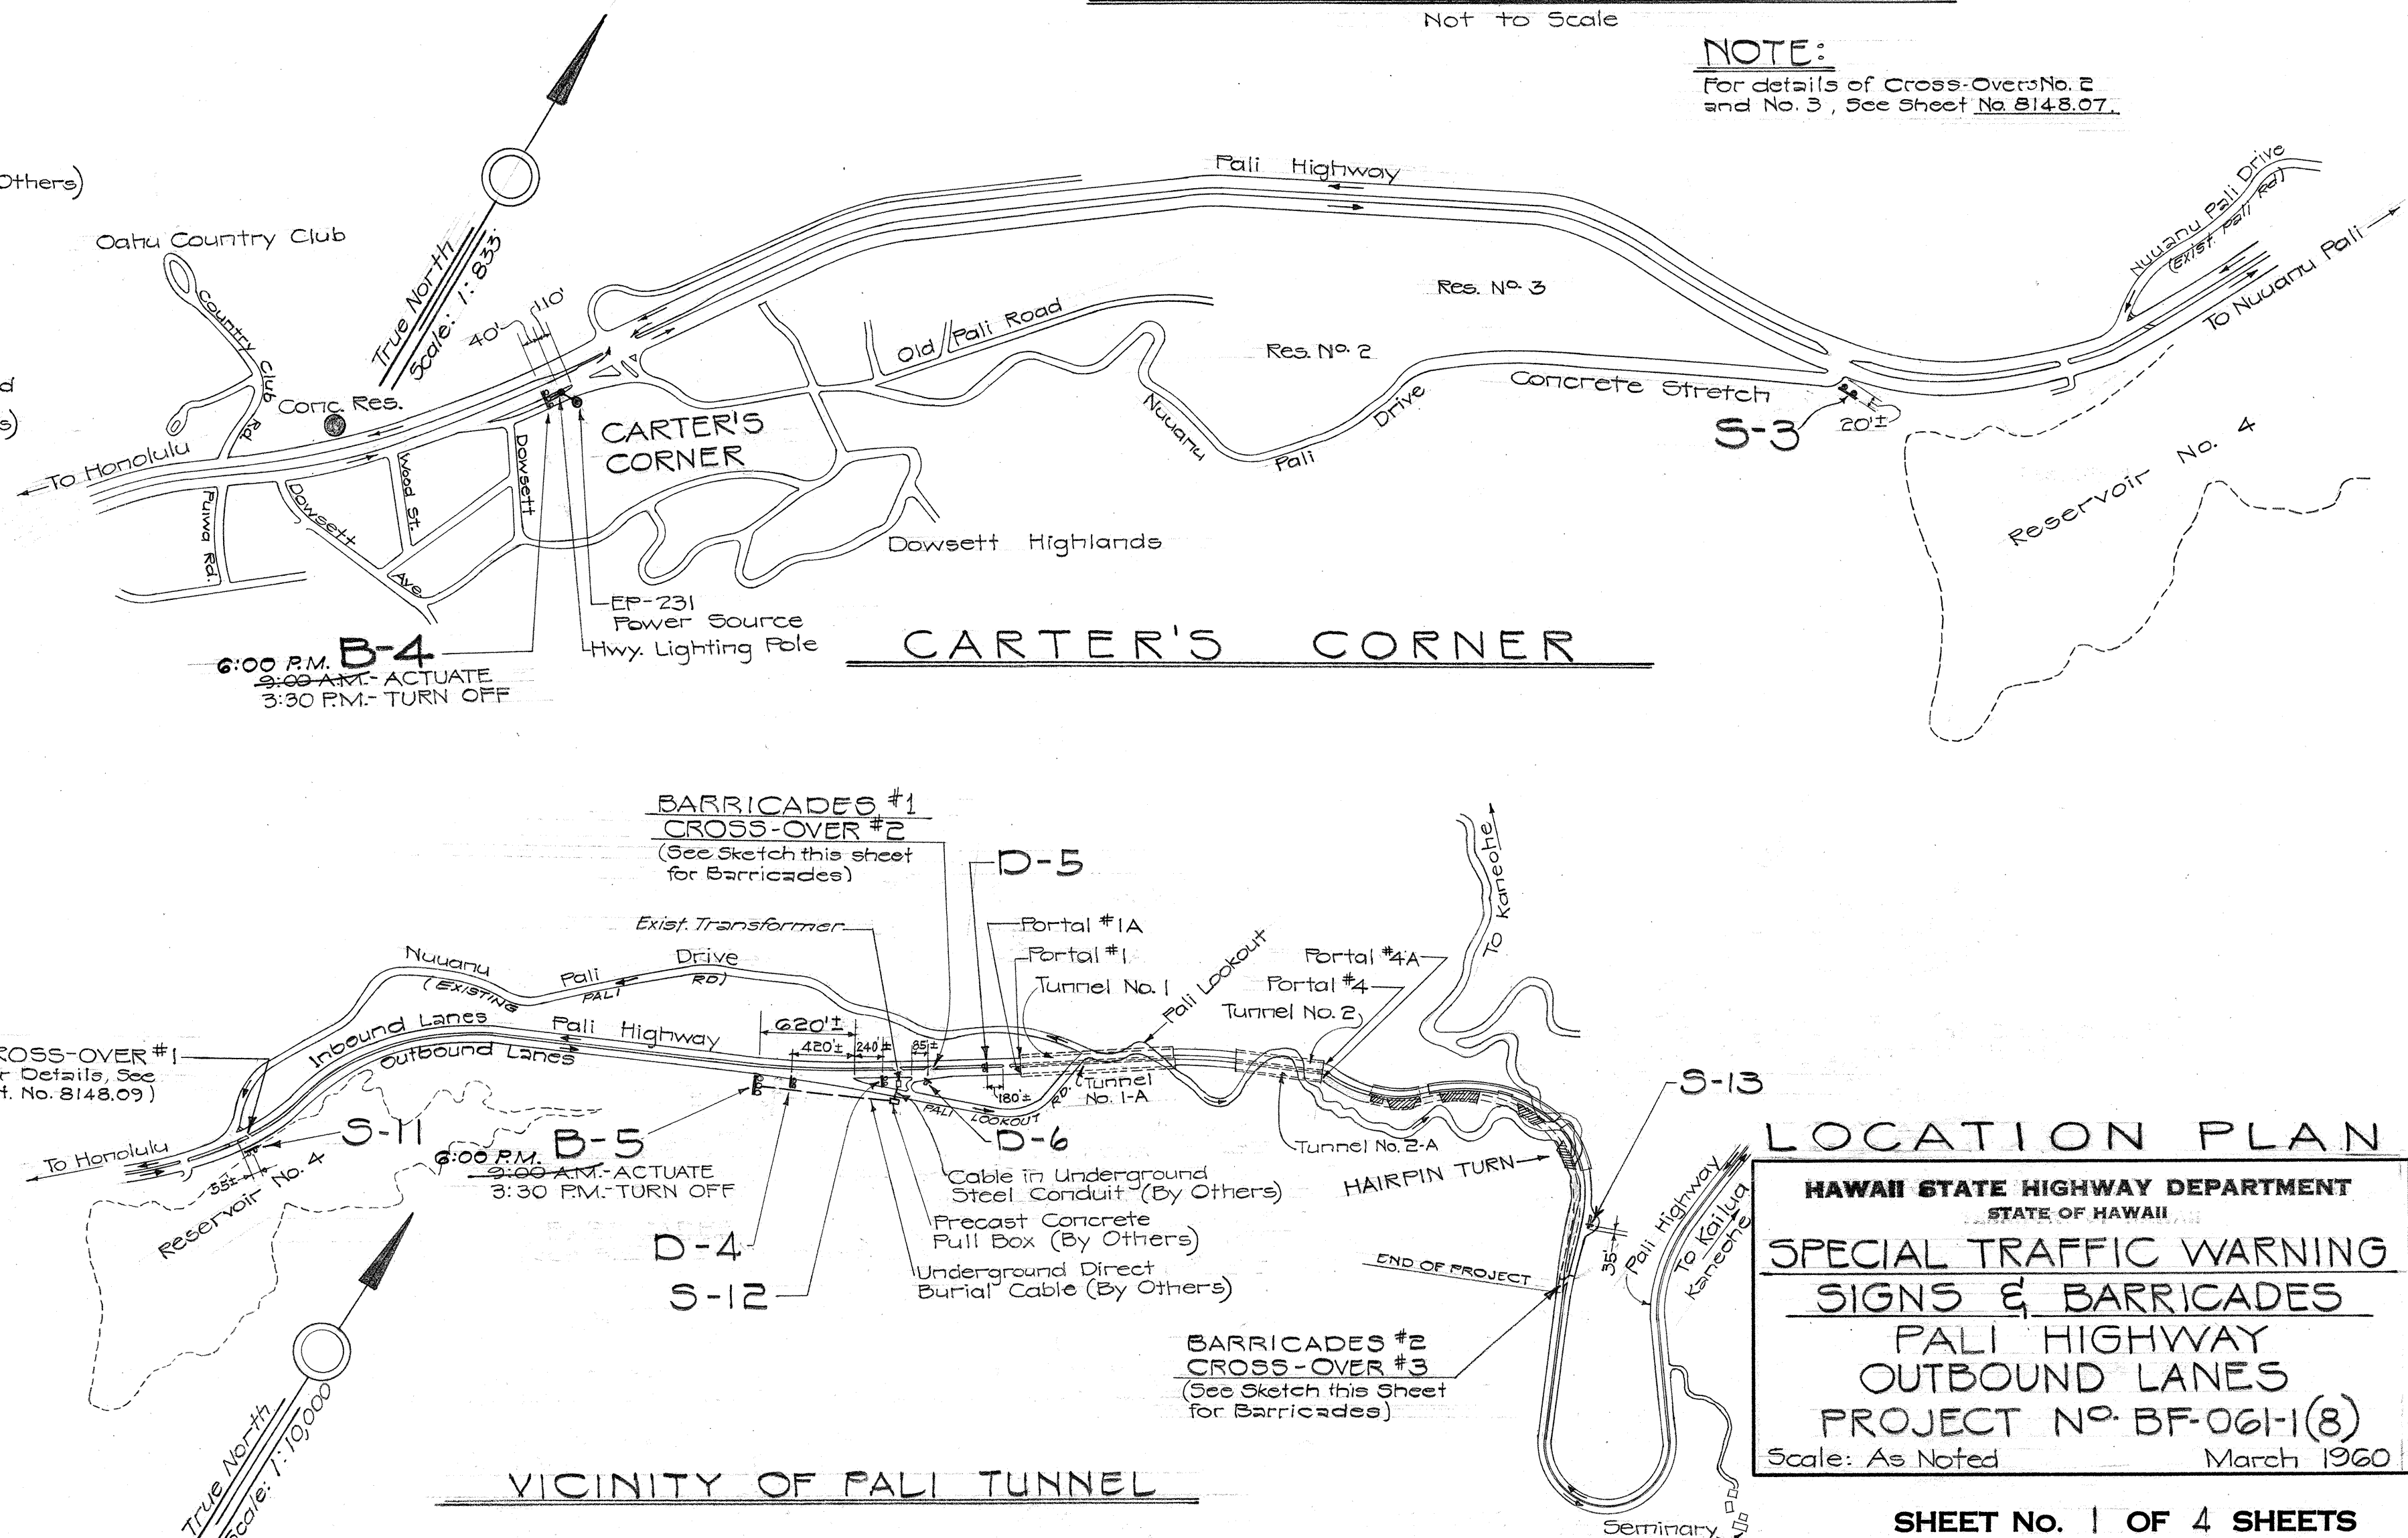

CARTER'S CORNER

VICINITY OF PALI TUNNEL


LOCATION PLAN

HAWAII STATE HIGHWAY DEPARTMENT
STATE OF HAWAII
SPECIAL TRAFFIC WARNING
SIGNS & BARRICADES
PALI HIGHWAY
OUTBOUND LANES
PROJECT NO. BF-061-1(8)
Scale: As Noted March 1960

SHEET NO. 1 OF 4 SHEETS

SURVEY PLOTTED BY	DATE
DRIVEN BY	
TRACED BY	
NOTED BY	
CHECKED BY	

FED. ROAD DIST. NO.	STATE	FED. AID PROJ. NO.	FISCAL YEAR	SHEET NO.	TOTAL SHEETS
HAWAII	HAW	BF-061(8)	1960	5B	61

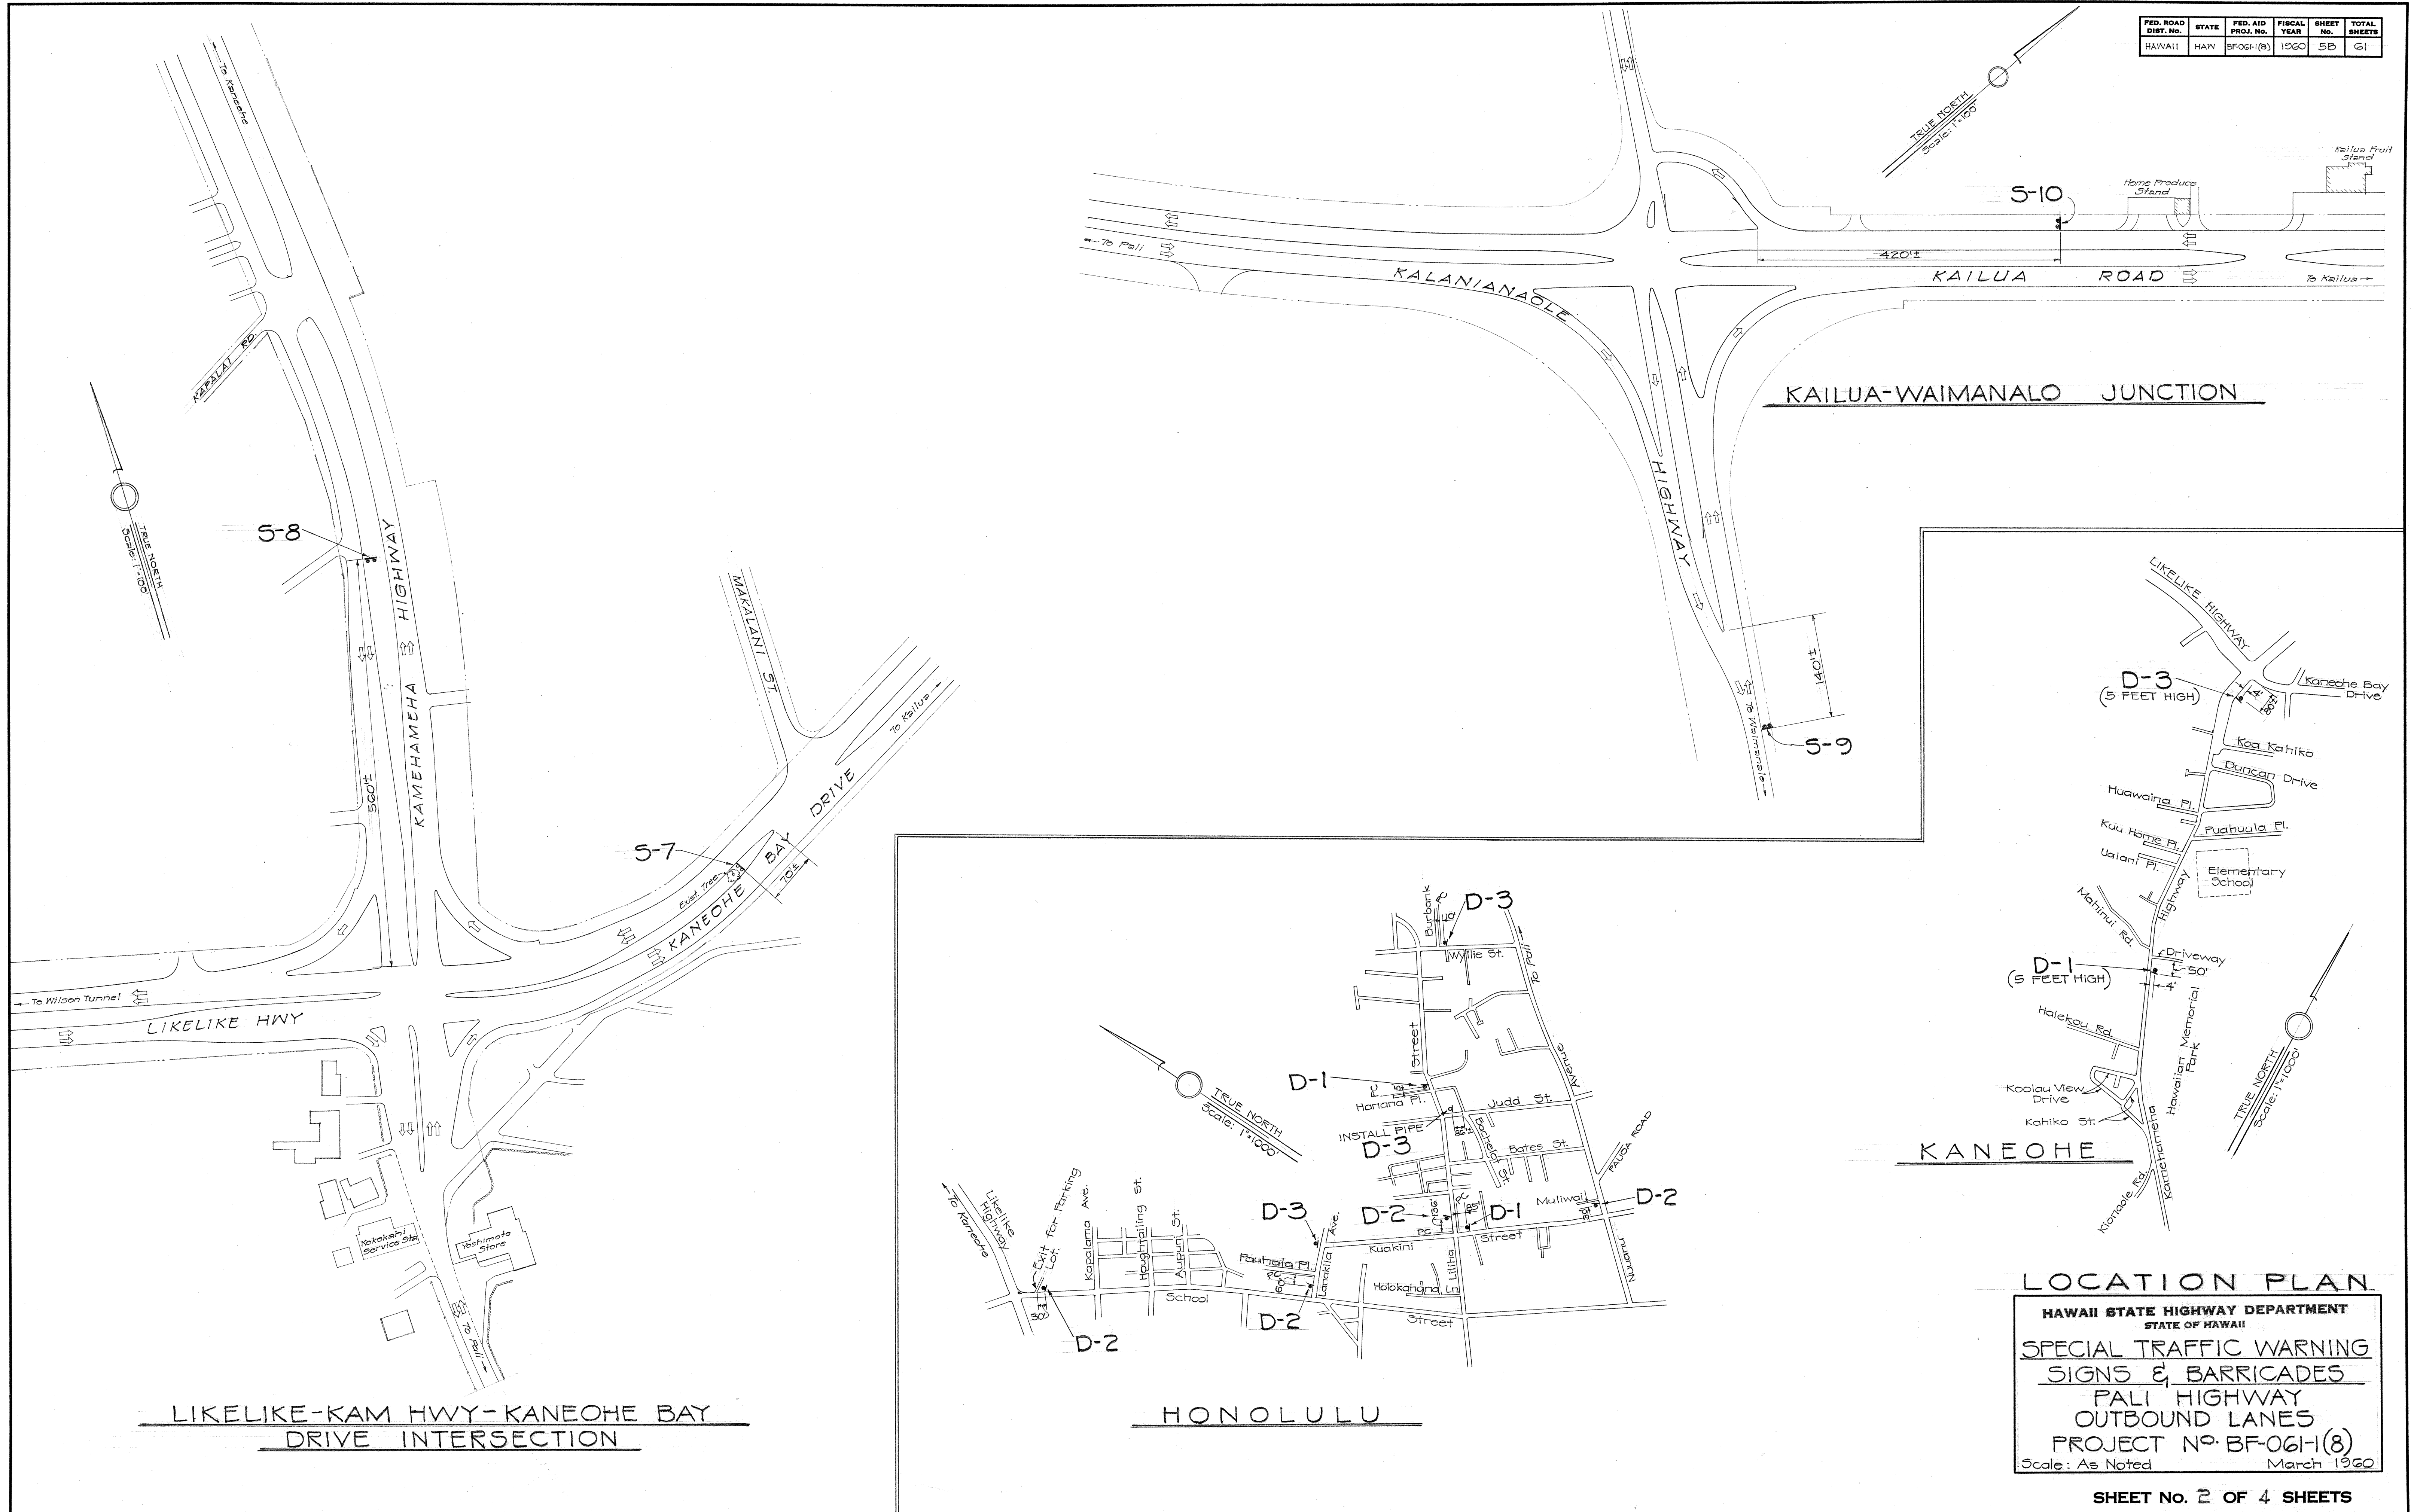


SURVEY PLOTTED BY:	DATE:
DESIGNED BY:	DATE:
DRAWN BY:	DATE:
CHECKED BY:	DATE:
NOTED BY:	DATE:
QUANTITIES CHECKED BY:	DATE:
CHECKED BY:	DATE:
ORIGINAL PLAN No.	

LOCATION PLAN
HAWAII STATE HIGHWAY DEPARTMENT
STATE OF HAWAII
SPECIAL TRAFFIC WARNING
SIGNS & BARRICADES
FALL HIGHWAY
OUTBOUND LANES
PROJECT NO. BF-061(8)
Scale: As Noted
March 1960


SHEET NO. 2 OF 4 SHEETS

.8148.5B


FED. ROAD DIST. NO.	STATE	FED. AID PROJ. NO.	FISCAL YEAR	SHEET NO.	TOTAL SHEETS
HAWAII	HAW.	BF-061-1(8)	1960	50	61

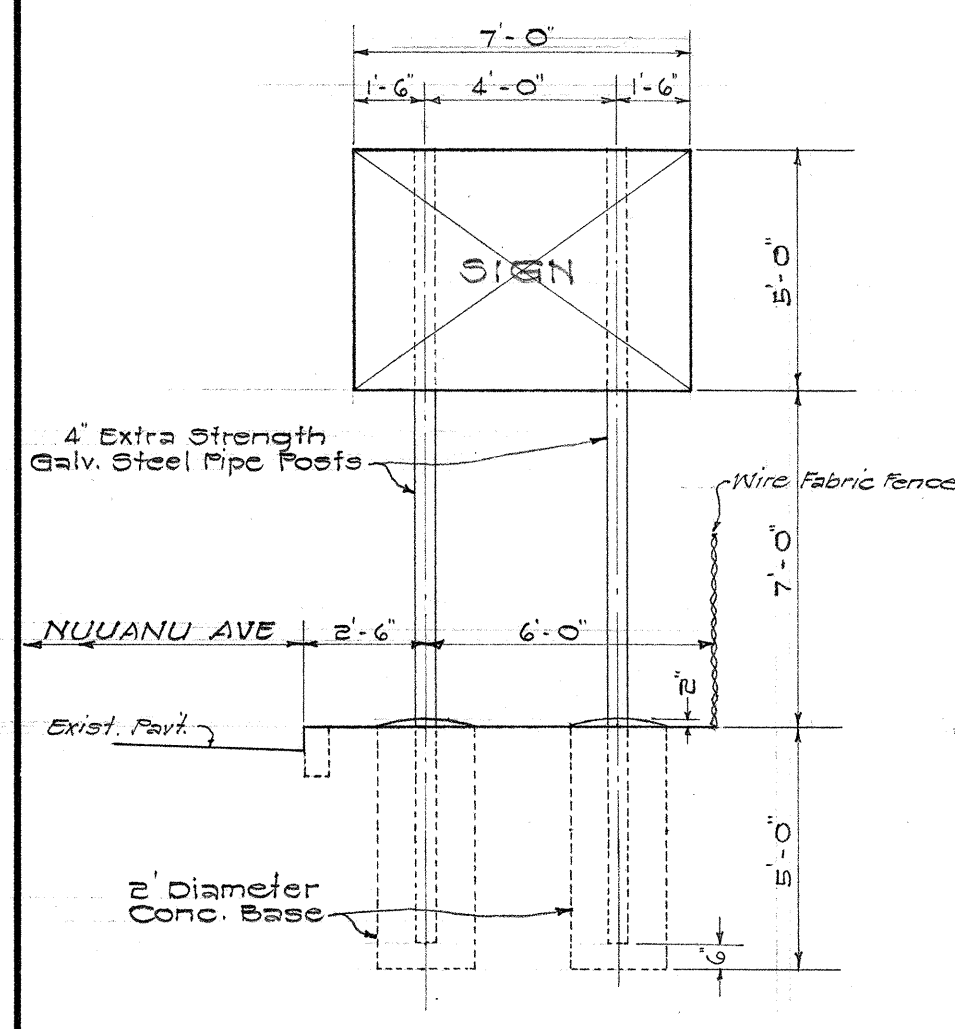


B-1 SIGN
ON NUUANU AVENUE
BELOW JUDD ST.

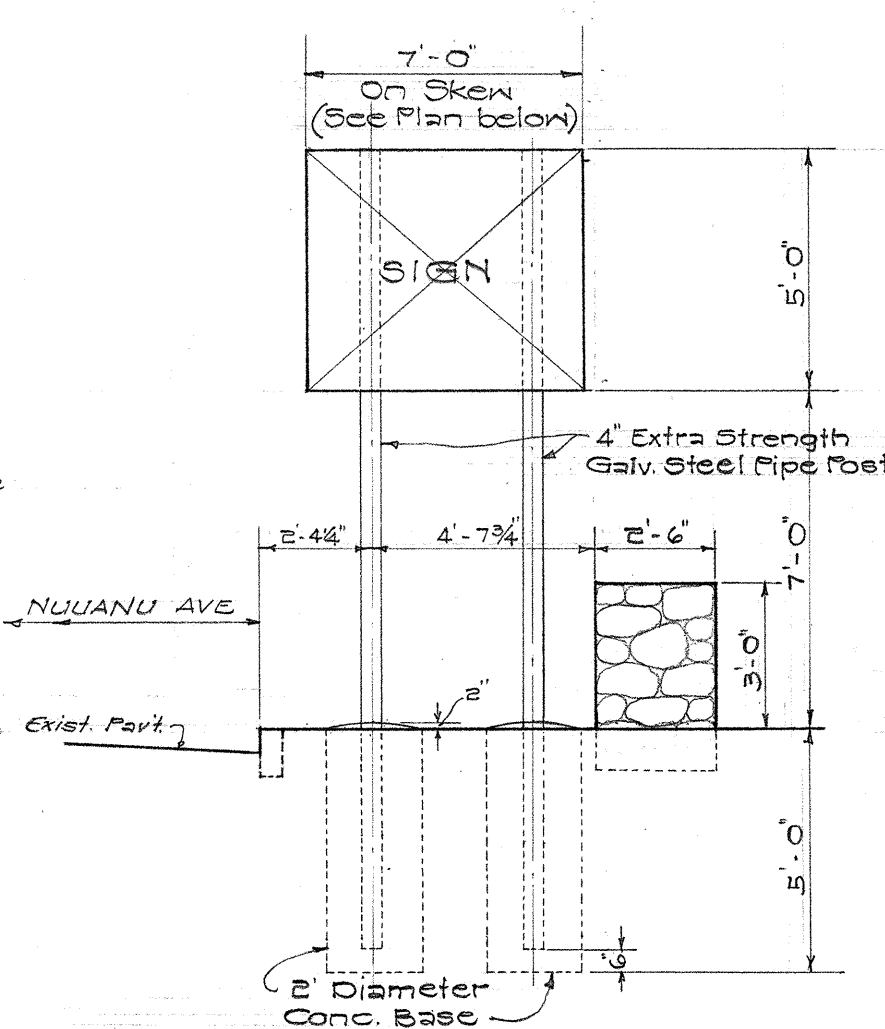


ELEVATION "A-A"

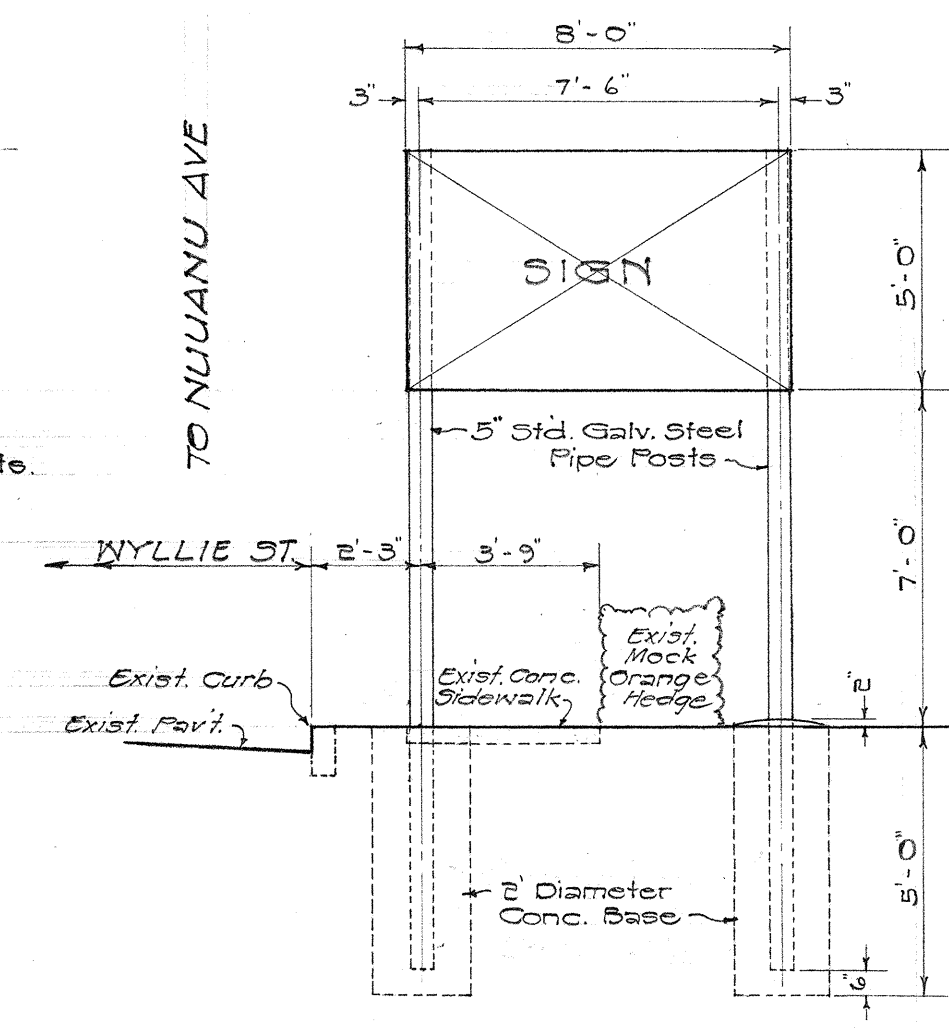


B-3 SIGN
ON WYLLIE ST.

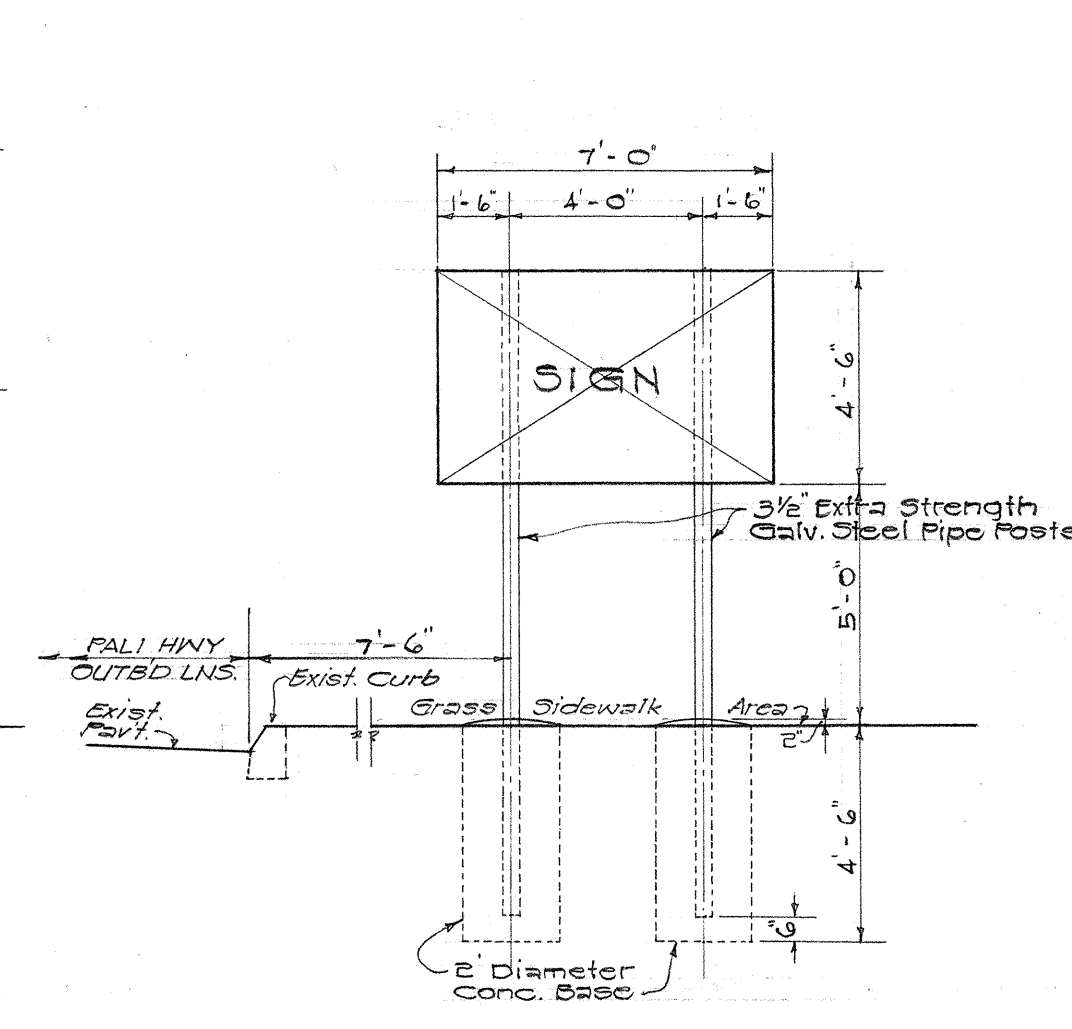


B-4 SIGN
CARTER'S CORNER

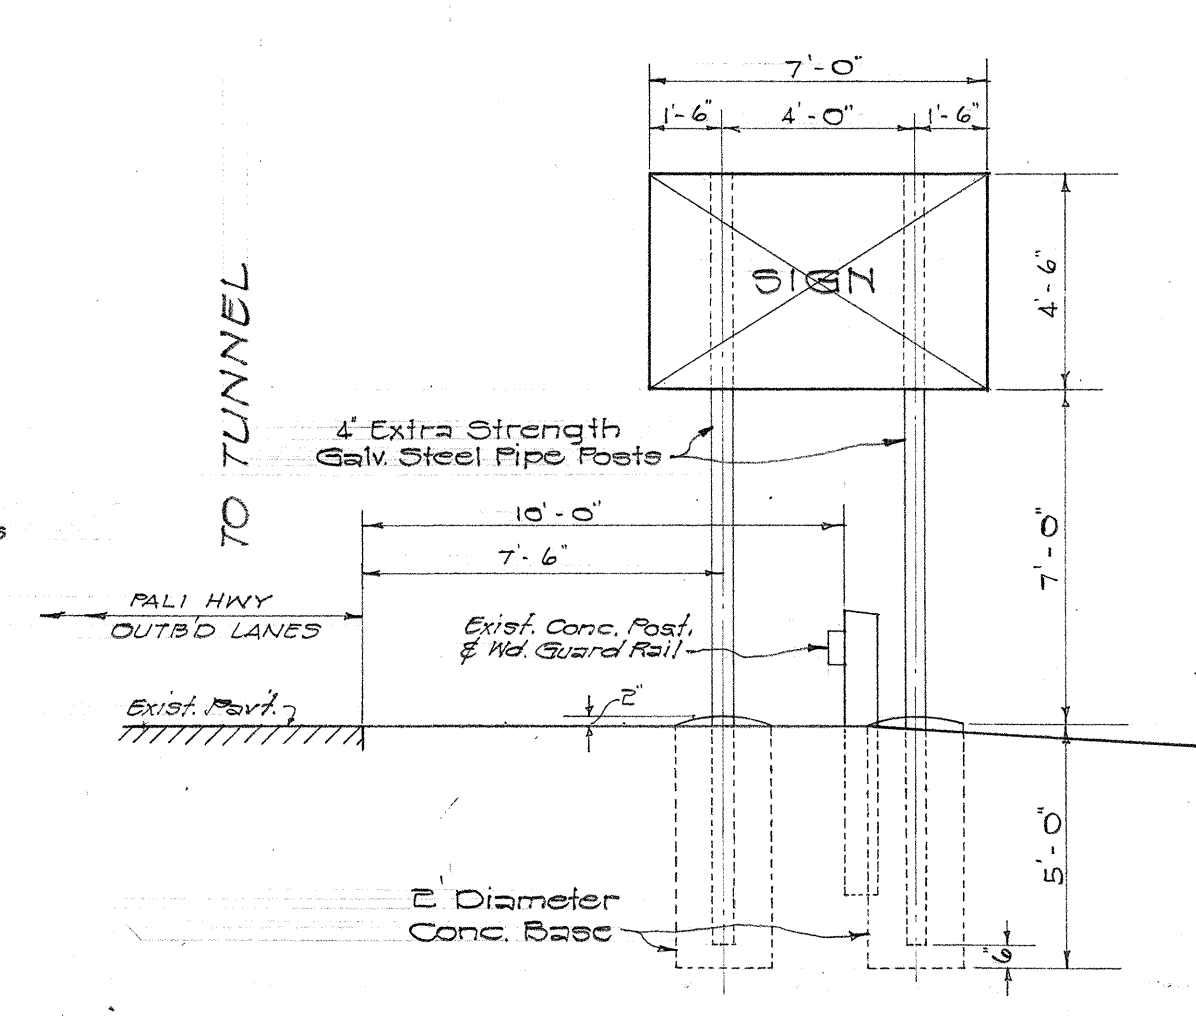


B-5 SIGN
NEAR PALI LOOKOUT ROAD

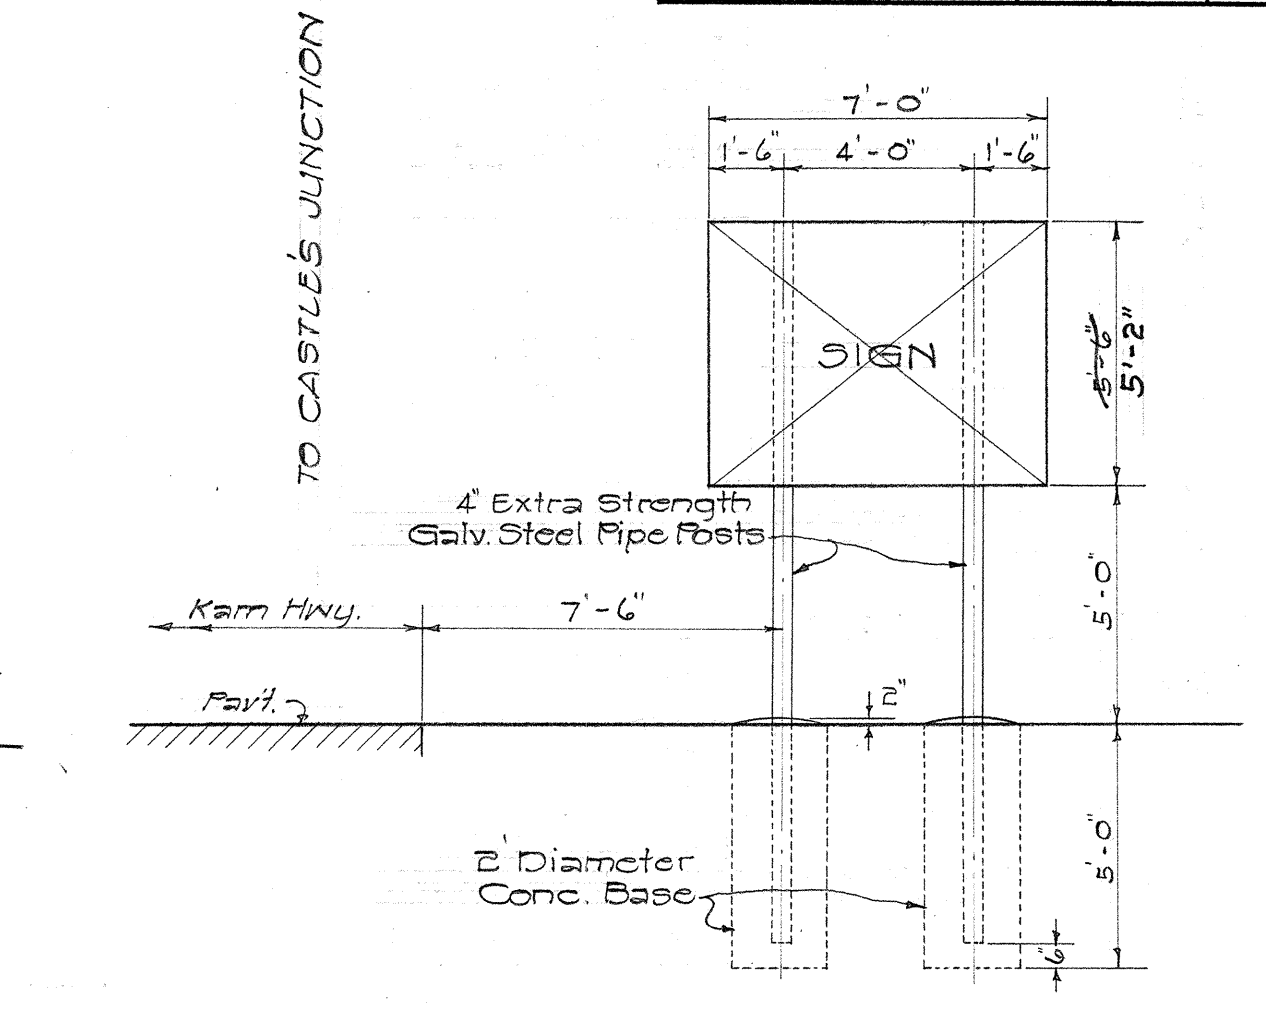


B-6 SIGN
NEAR CASTLE'S JUNCTION

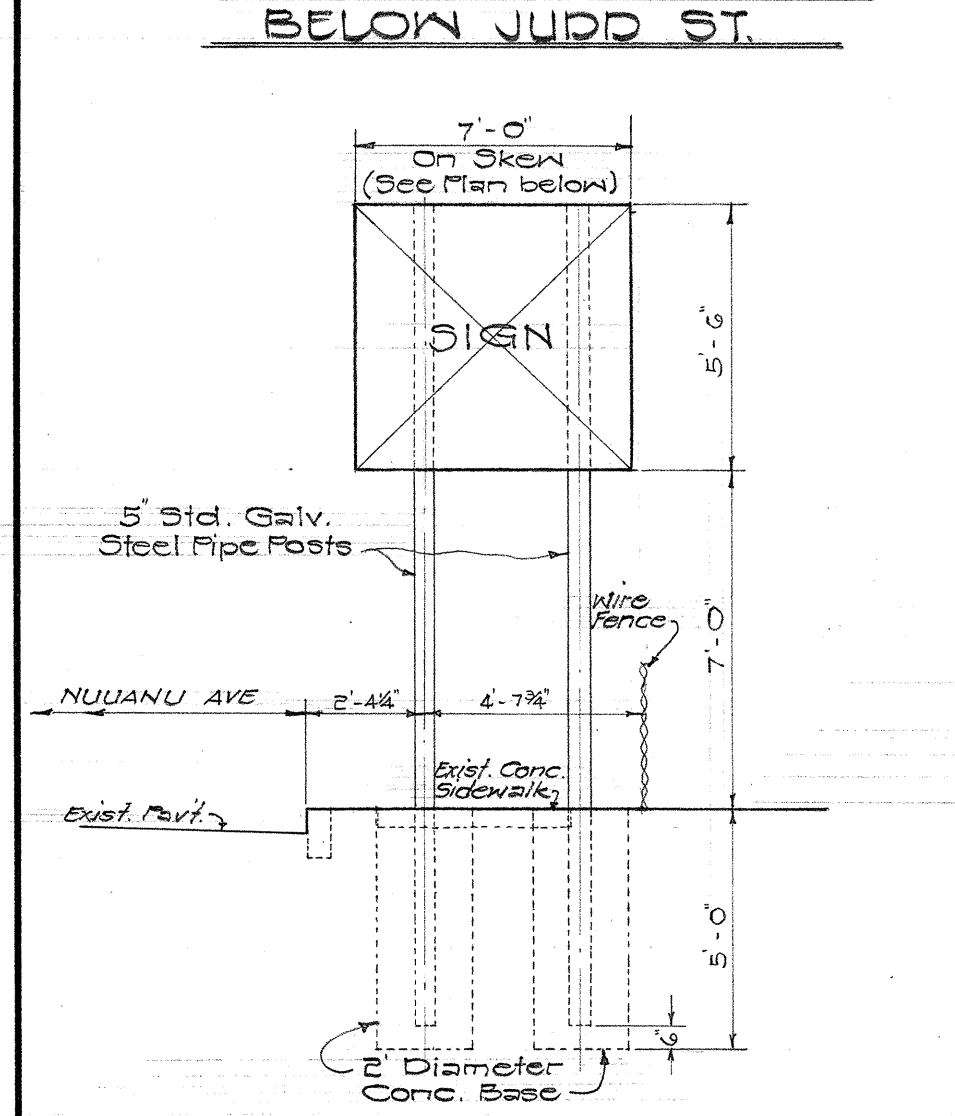


B-2 SIGN - PLAN VIEW
ON NUUANU AVE
BELOW WYLLIE ST.

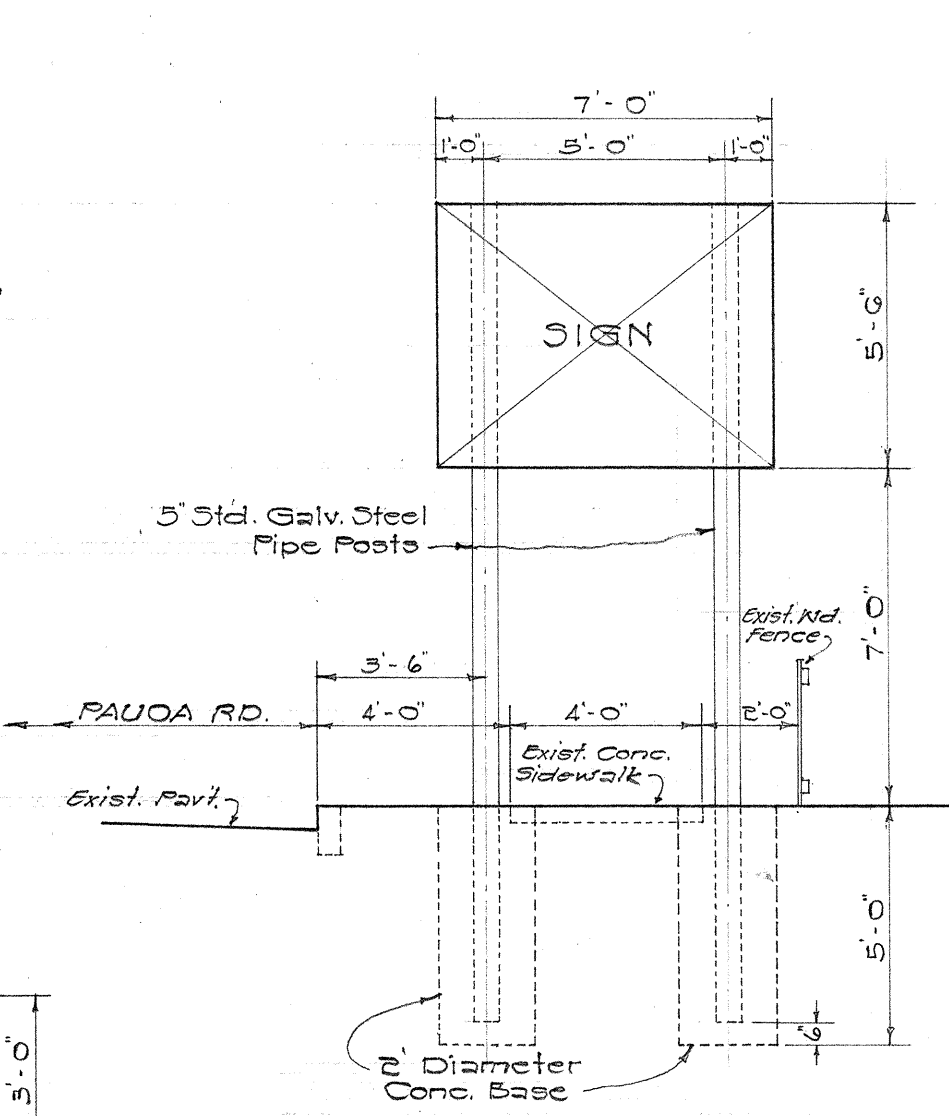


S-2 SIGN
PAUOA ROAD
AT FUNCHAL LANE

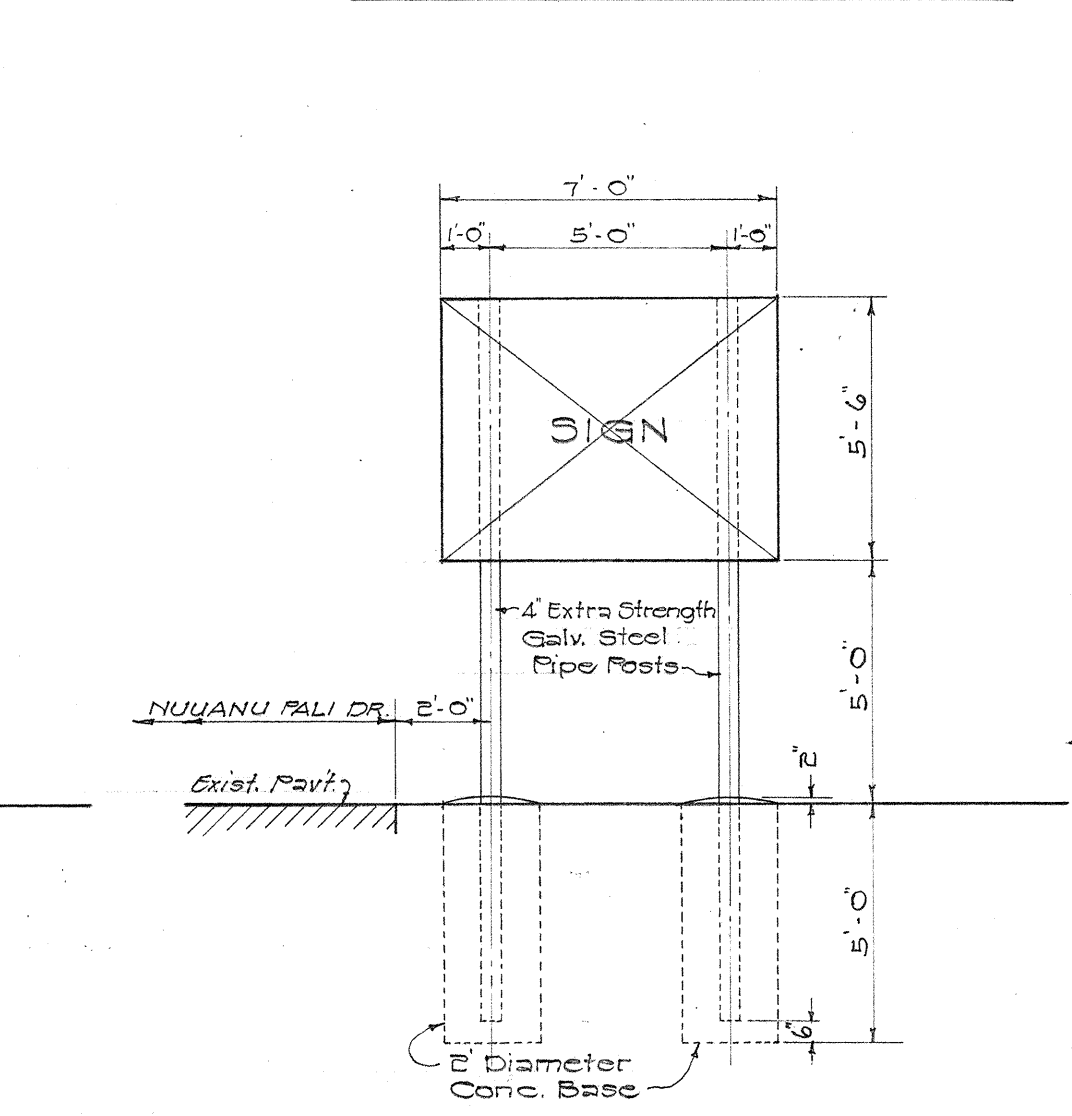


S-3 SIGN
PALI HWY - NUUANU PALI DR
JUNCTION BELOW RESERVOIR NO. 4

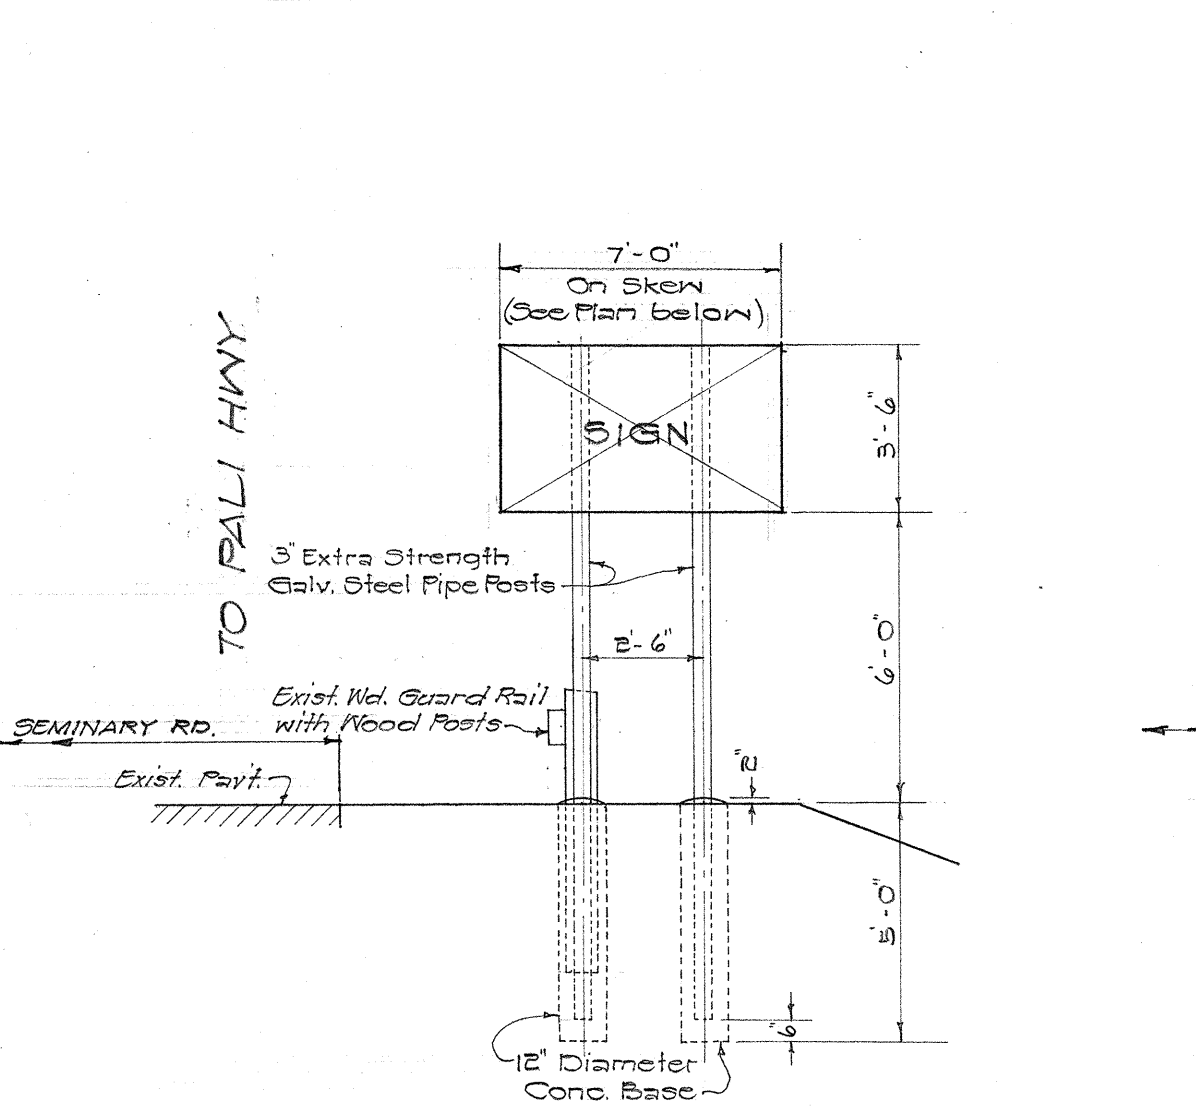


ELEVATION "B-B"

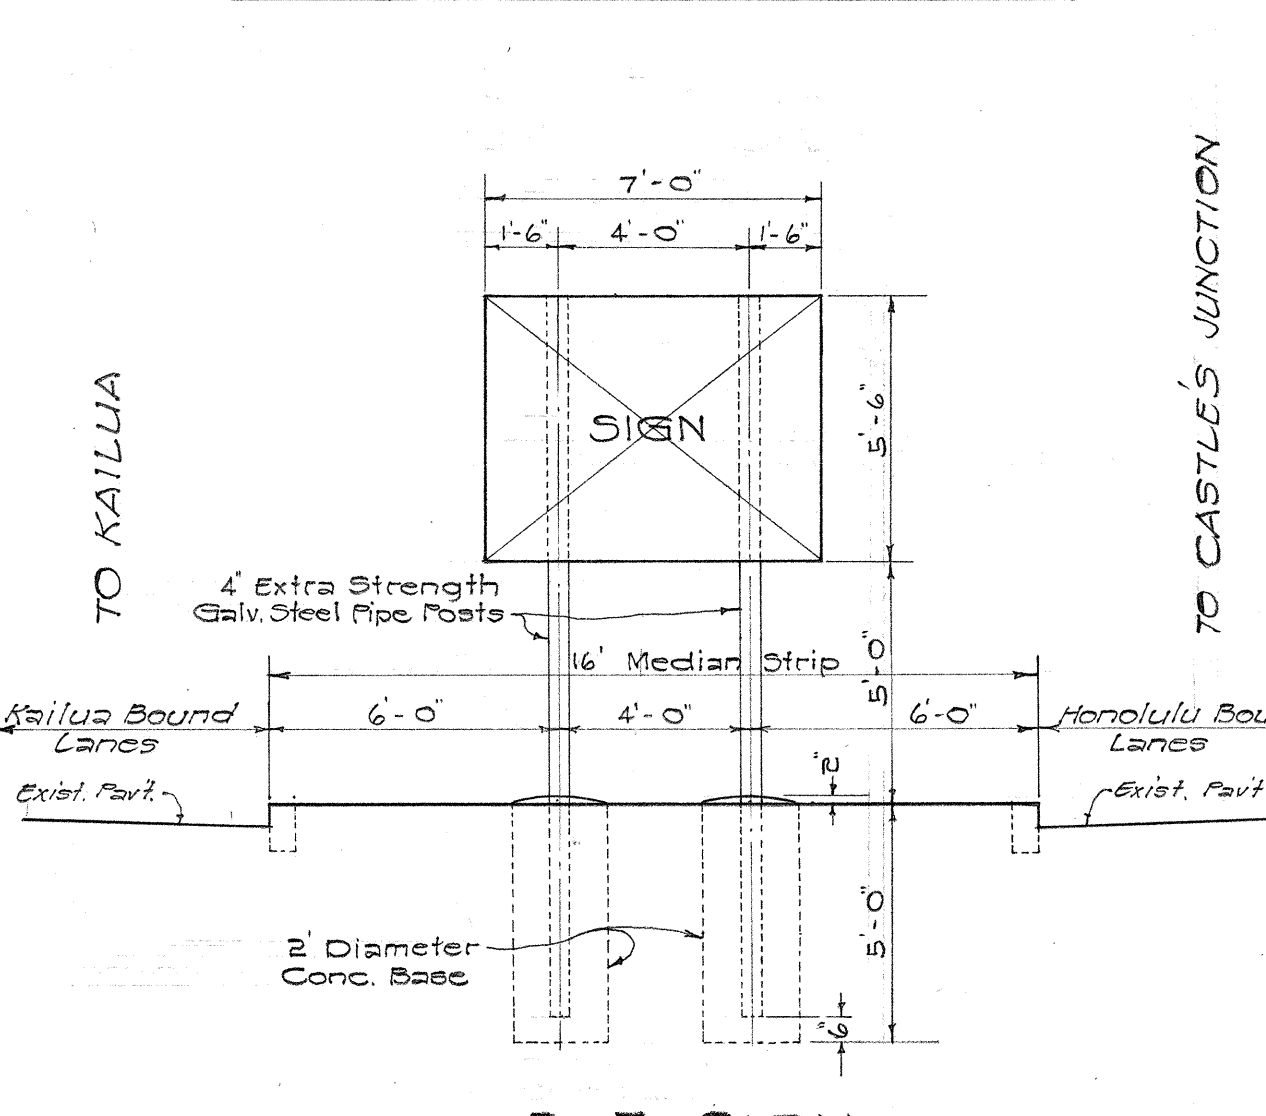


B-7 SIGN
CASTLE'S JUNCTION

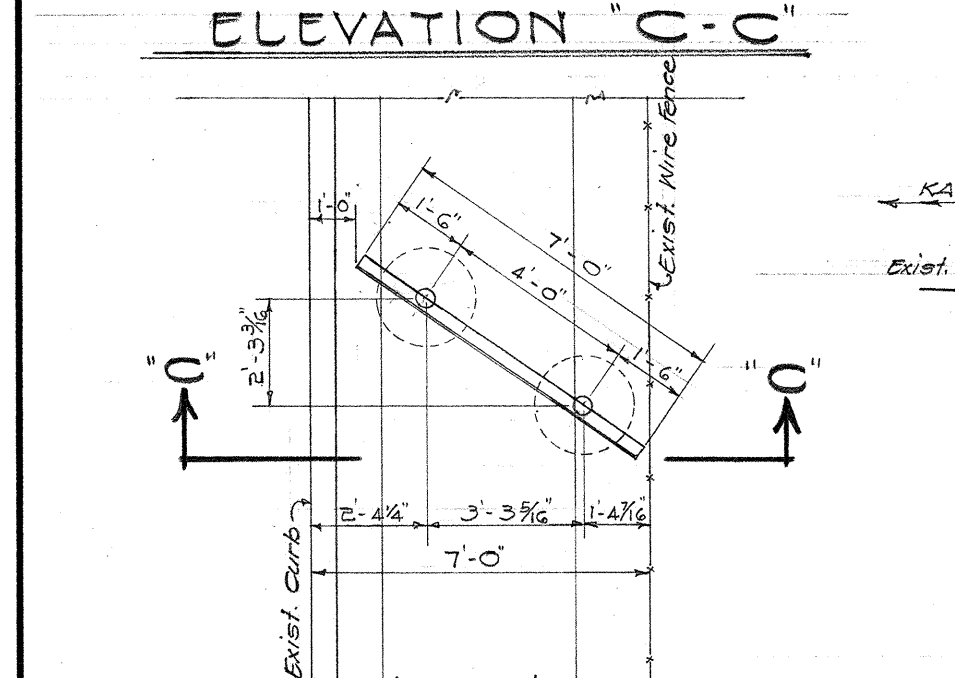


S-1 SIGN - PLAN VIEW
ON NUUANU AVE
BELOW KUAKINI ST.

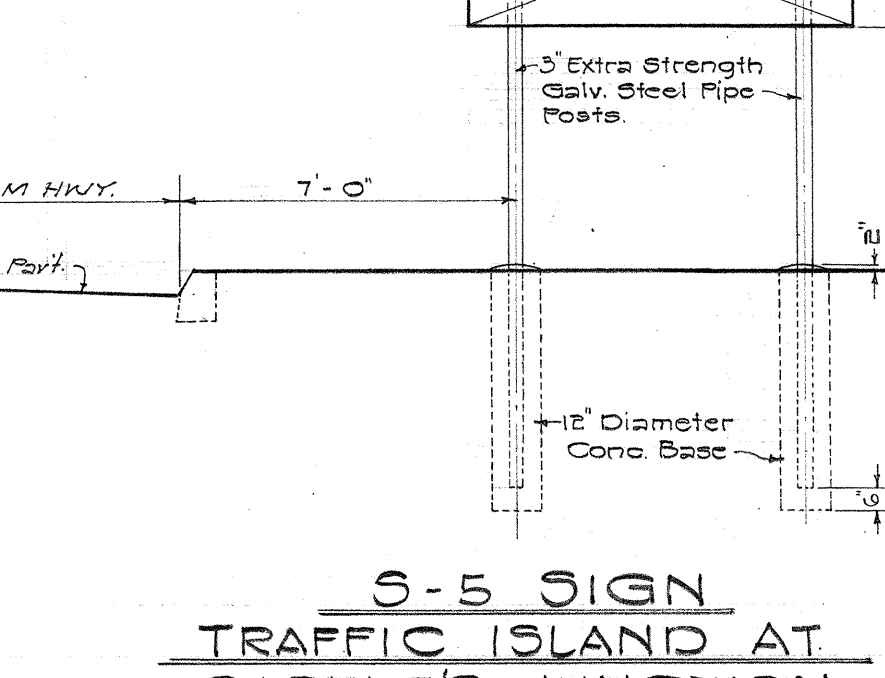


S-5 SIGN
TRAFFIC ISLAND AT
CASTLE'S JUNCTION

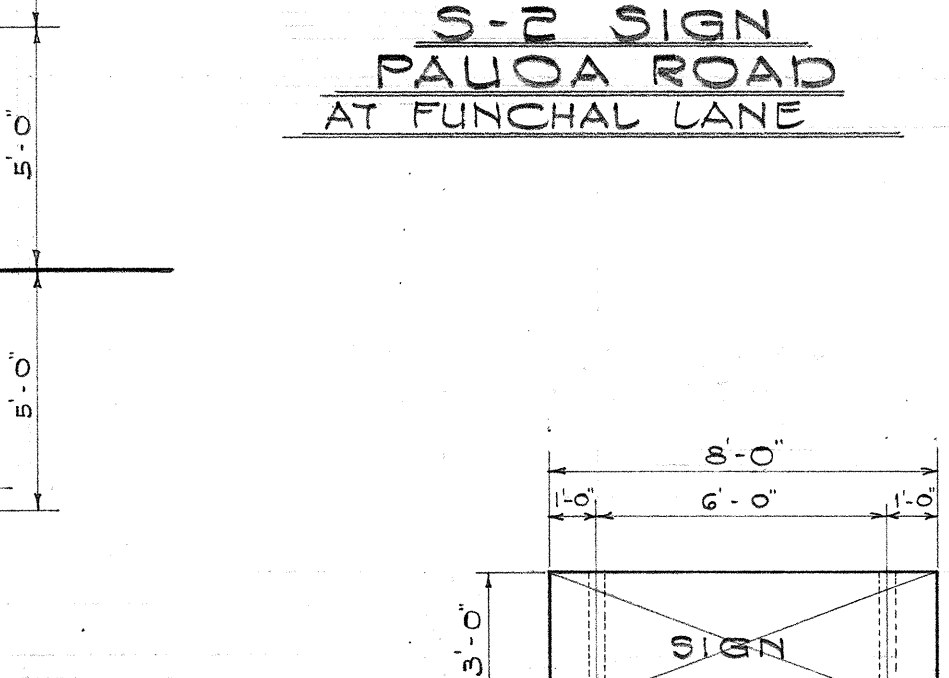


S-7 SIGN
Kaneohe Bay Drive

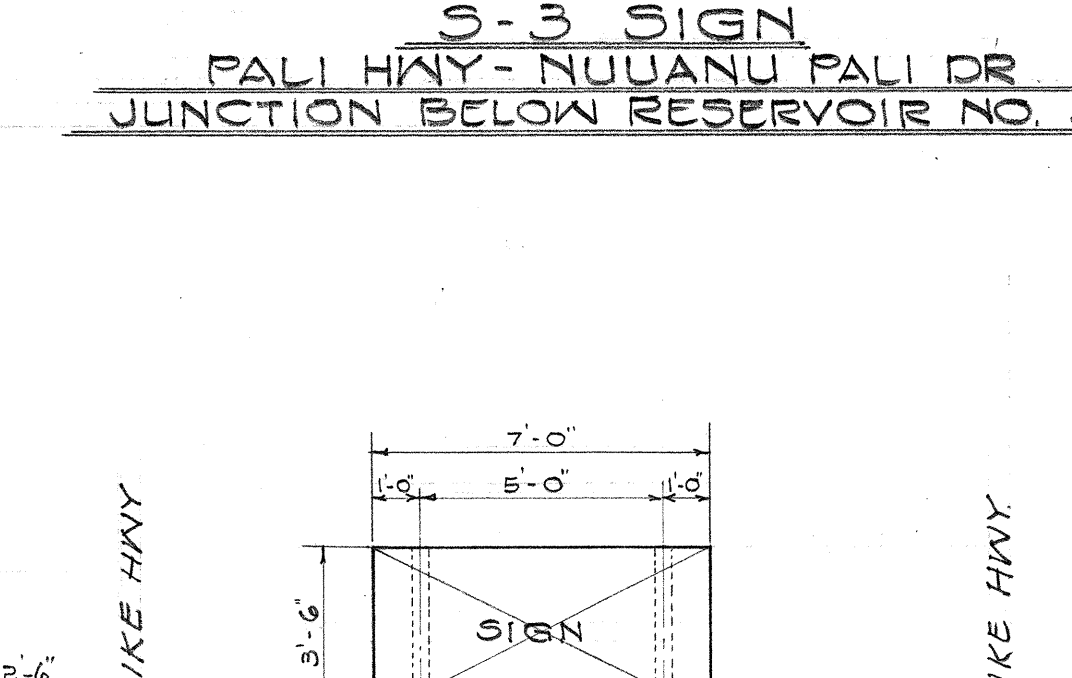

S-8 SIGN
KAM HIGHWAY NEAR
LIKELIKE - BAY DRIVE
INTERSECTION

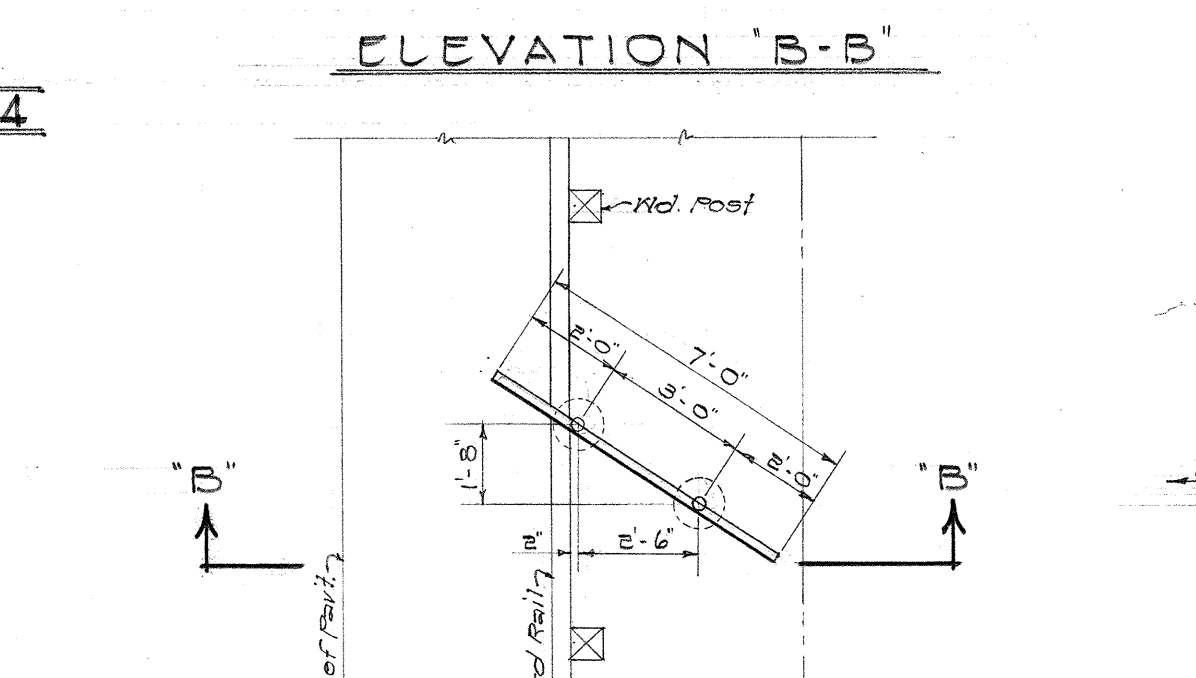

S-4 SIGN - PLAN VIEW
ST. STEPHEN'S SEMINARY ROAD
AT PALI HIGHWAY

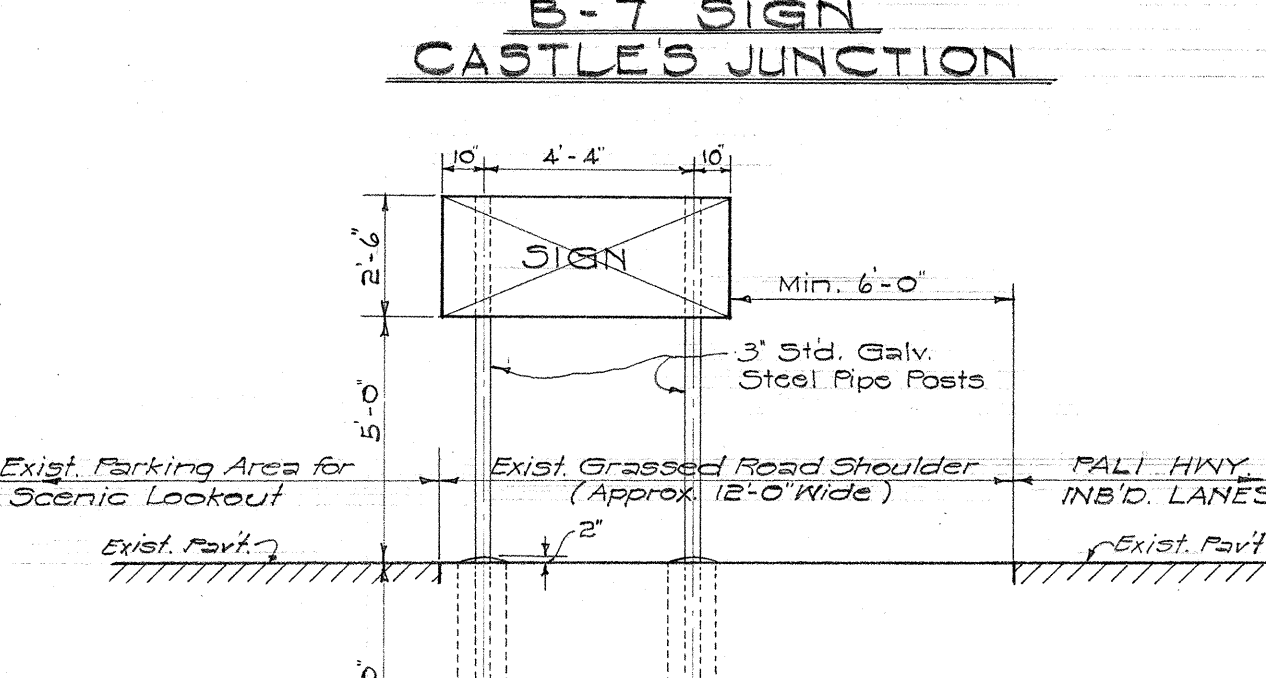

S-13 SIGN
PALI HWY - IN-B'D LANES AT SCENIC LOOKOUT

SIGN INSTALLATION DETAILS



HAWAII STATE HIGHWAY DEPARTMENT
STATE OF HAWAII
**SPECIAL TRAFFIC WARNING
SIGNS AND BARRICADES**
PALI HIGHWAY
OUTBOUND LANES
PROJ. NO. BF-061-1(8)
SCALE: 1/4" = 1'-0"
MARCH 10, 1960

NOTE:
Concrete for all Concrete Base shall be Class "D-1"





SURVEY PLOTTED BY	DATE
ORIGINAL PLAN	NO.
TRACED BY	NO.
QUANTITIES CHECKED BY	NO.

REVISED: APRIL 12, 1960
APRIL 23, 1960





FED. ROAD DIST. NO.	STATE	FED. AID PROJ. NO.	FISCAL YEAR	SHEET NO.	TOTAL SHEETS
HAWAII	HAW.	BF-061-1(8)	1960	50	61

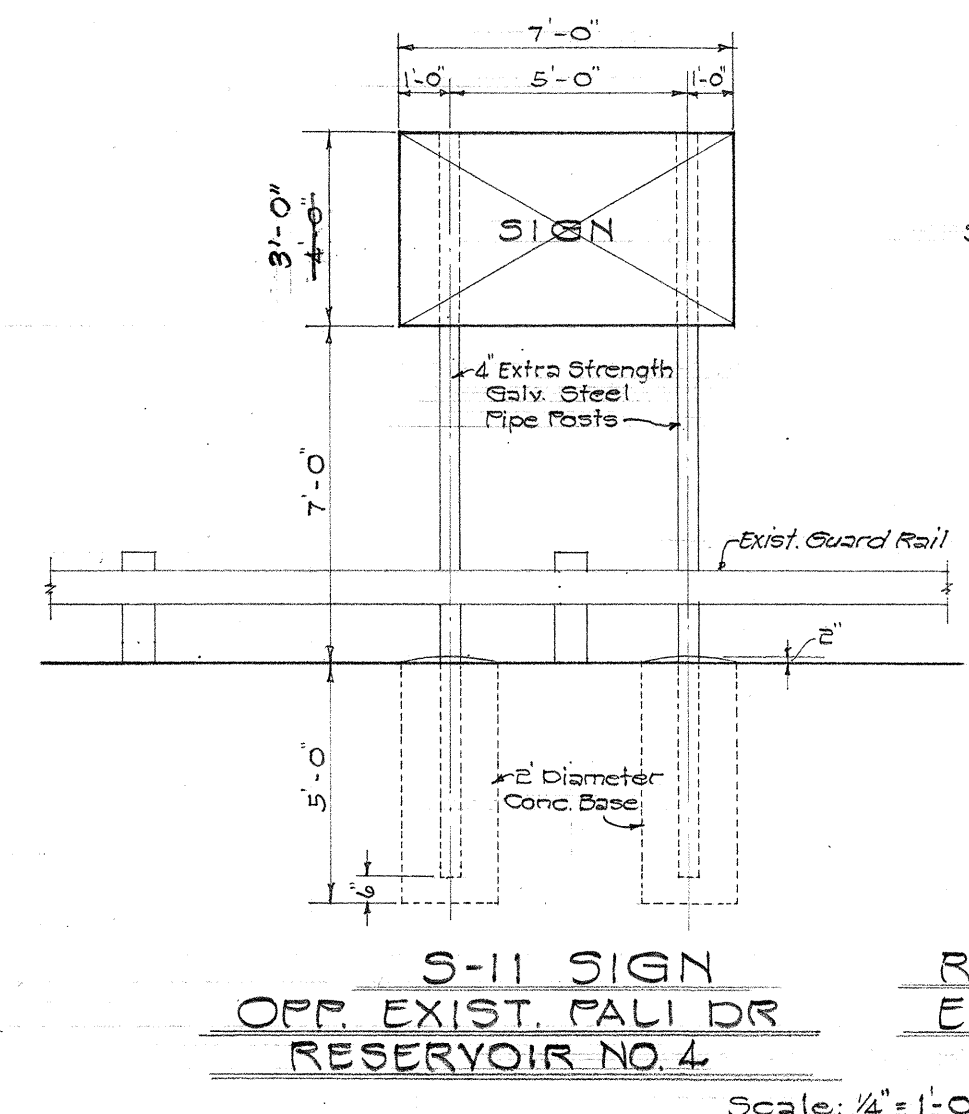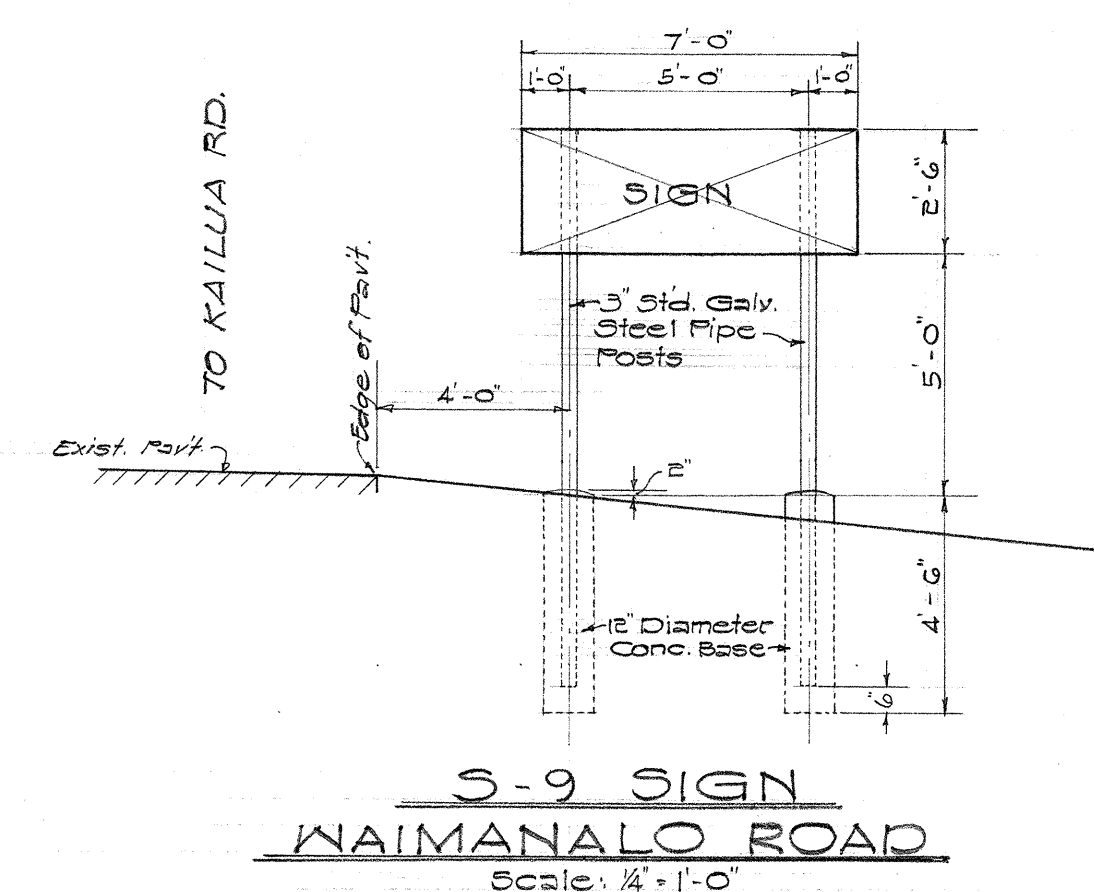

RIGHT SIDE ELEVATION

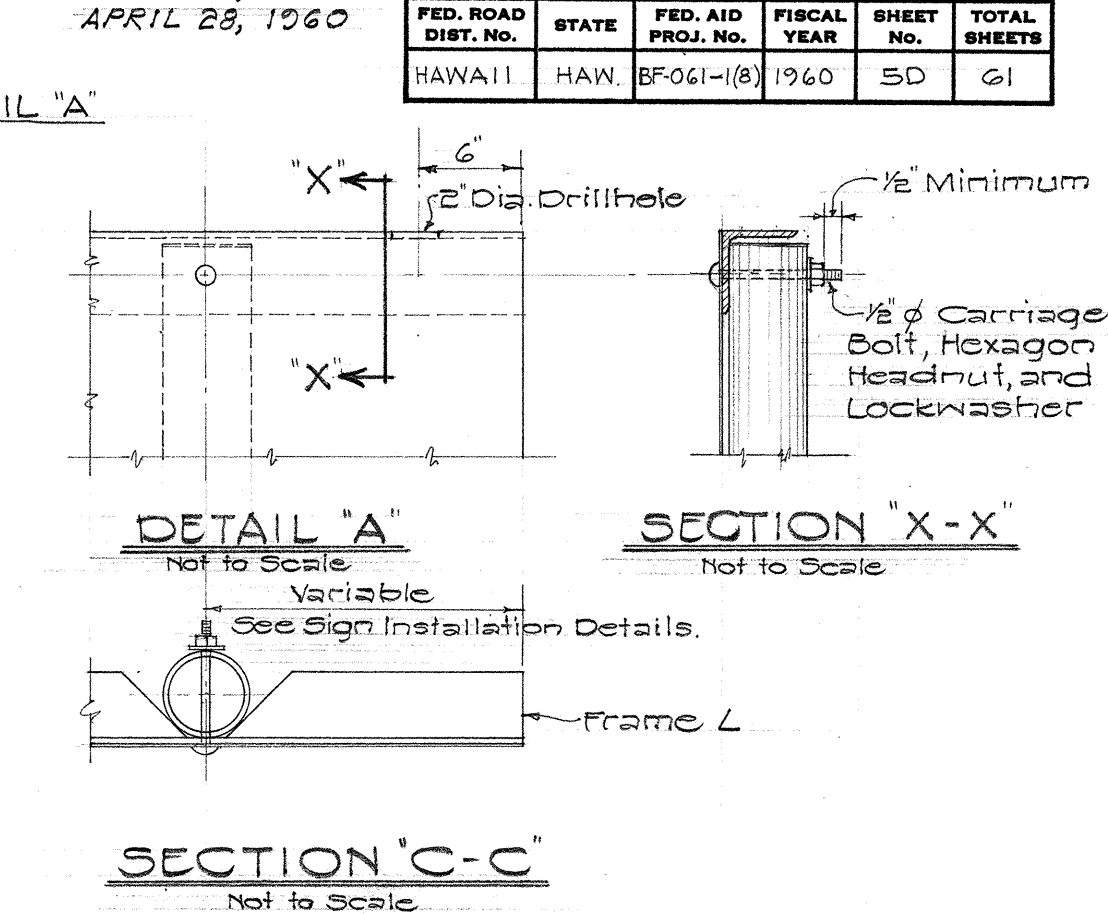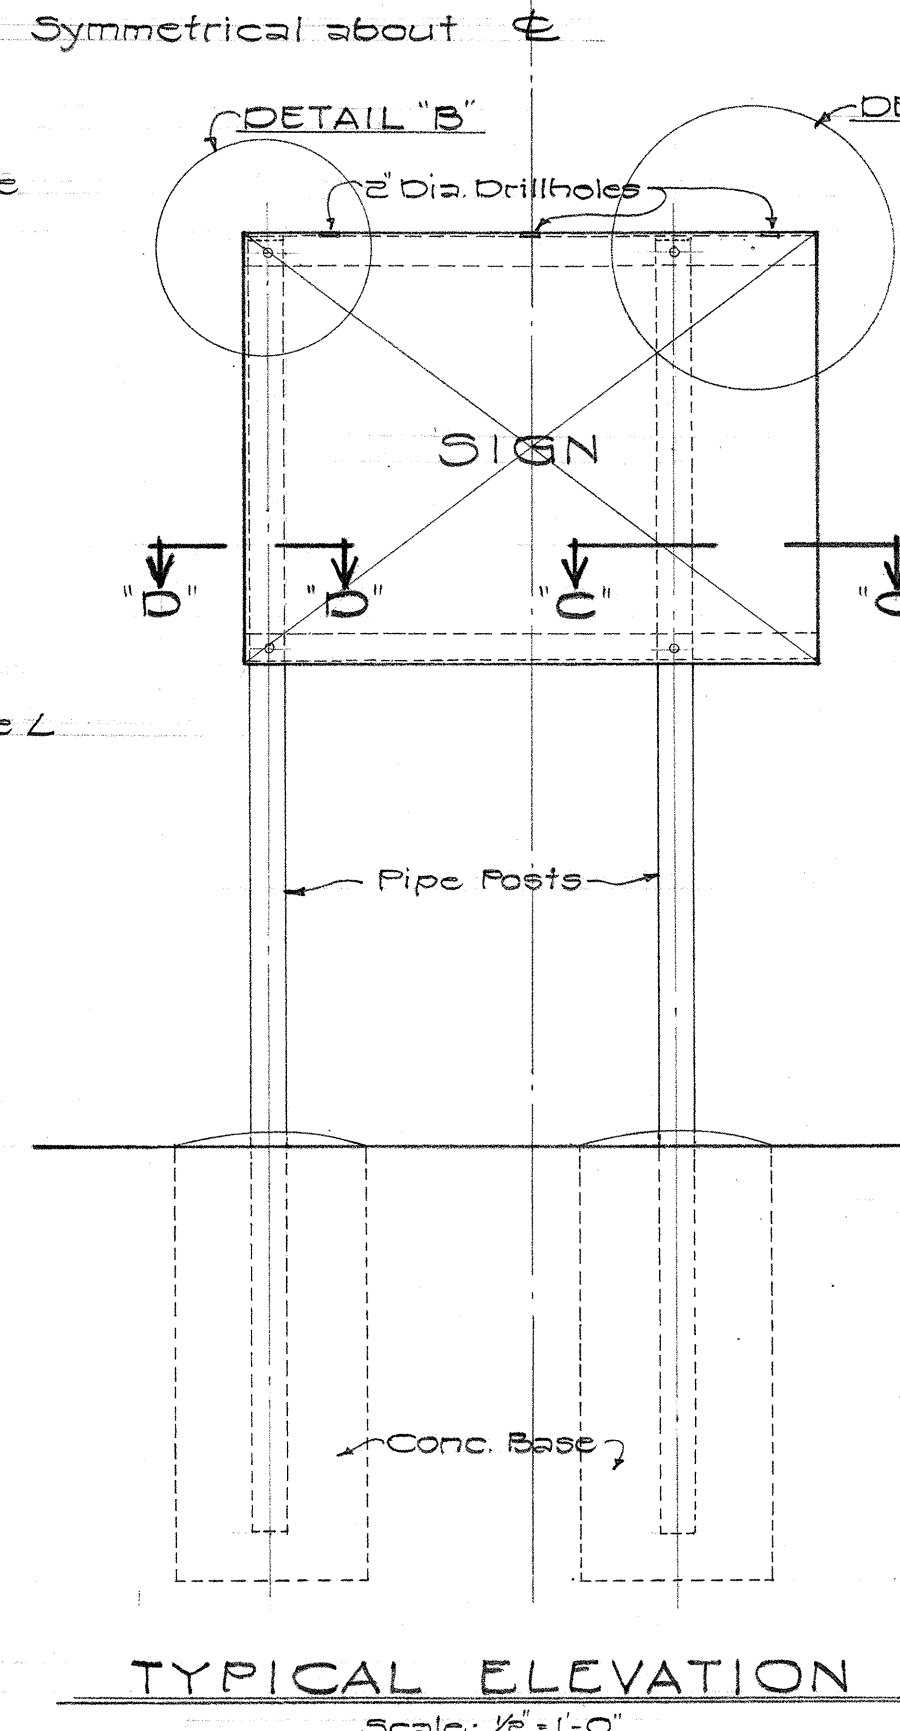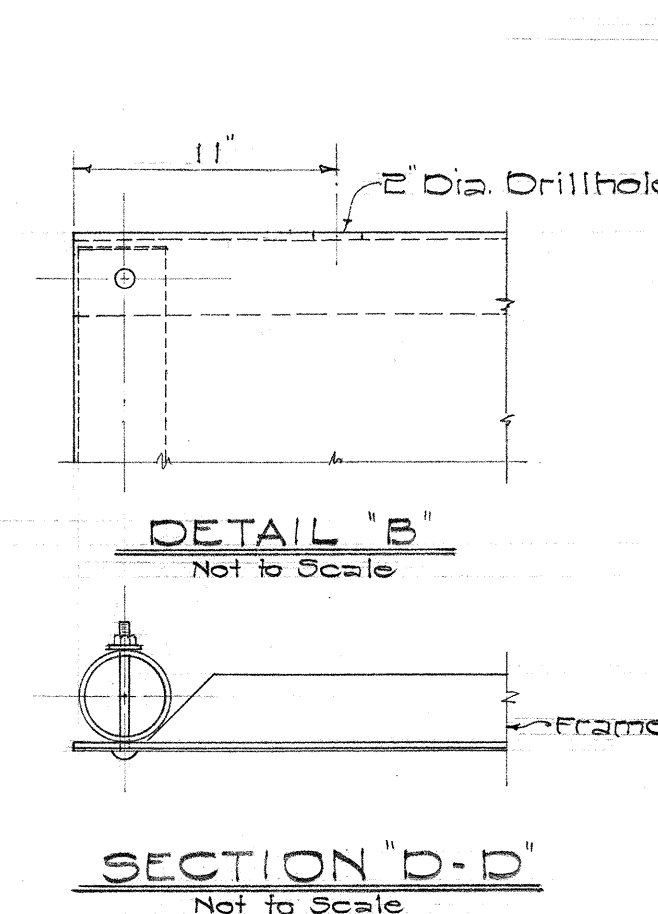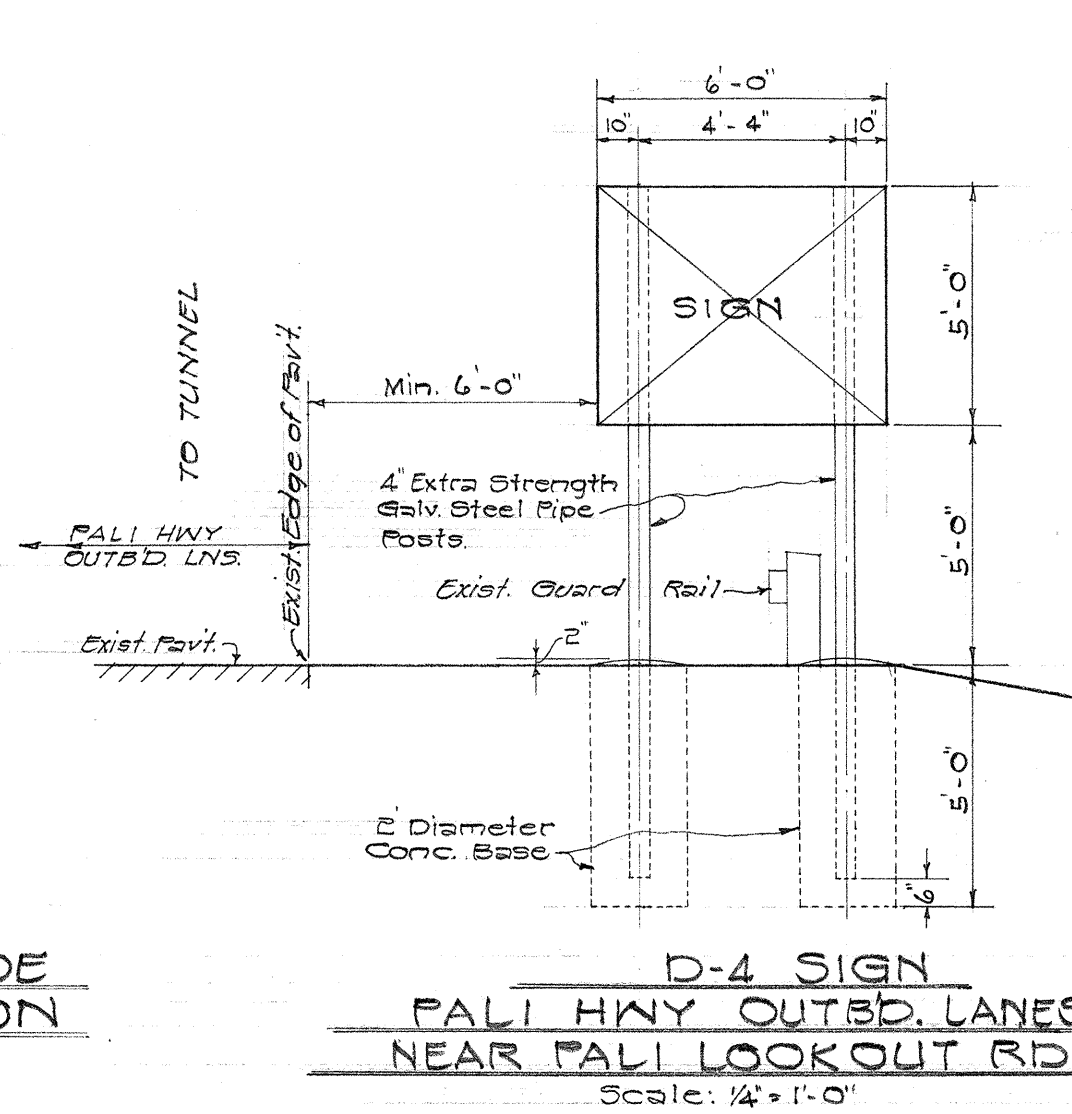


- NOTE:
- For size and frame dimensions, see Sheet Nos. 8148.5C and 8148.5D.
 - For size and position of Pipe Posts, see Sheet Nos. 8148.5C and 8148.5D.
 - Concrete for all Conc. Base shall be Class "D-1".
 - 2" Diameter Drillholes in upper L frame of Sign "S-1" to "S-7" inclusive only.










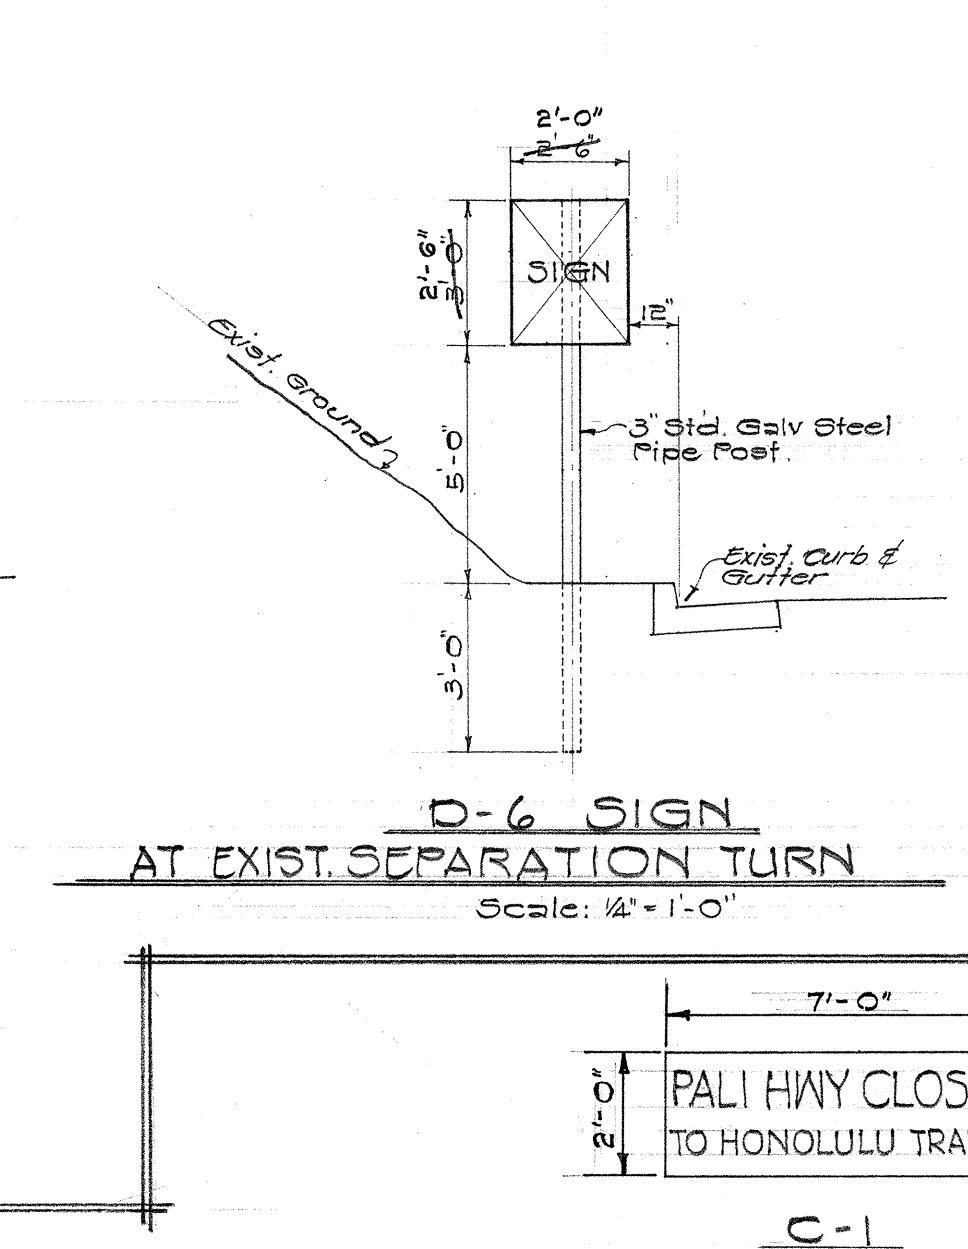
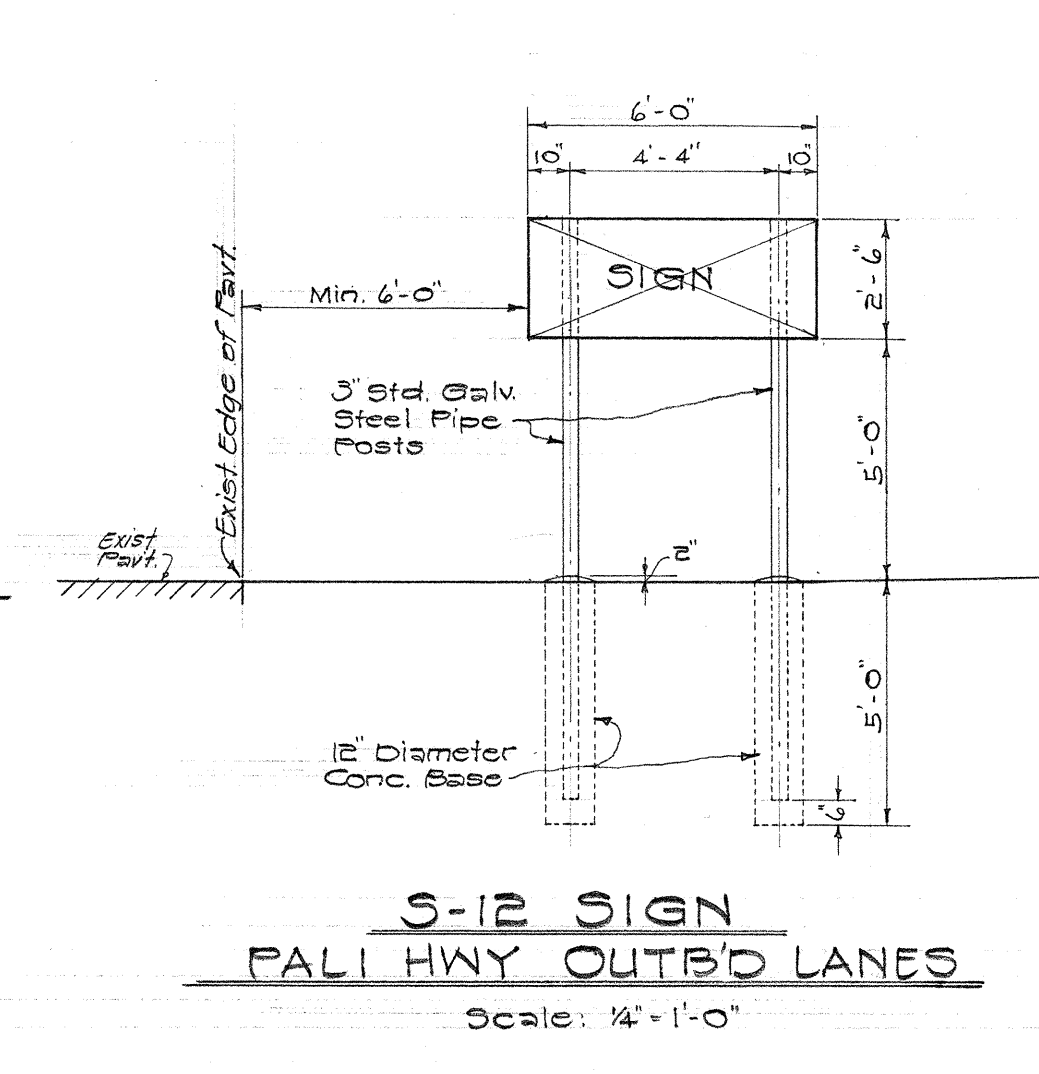
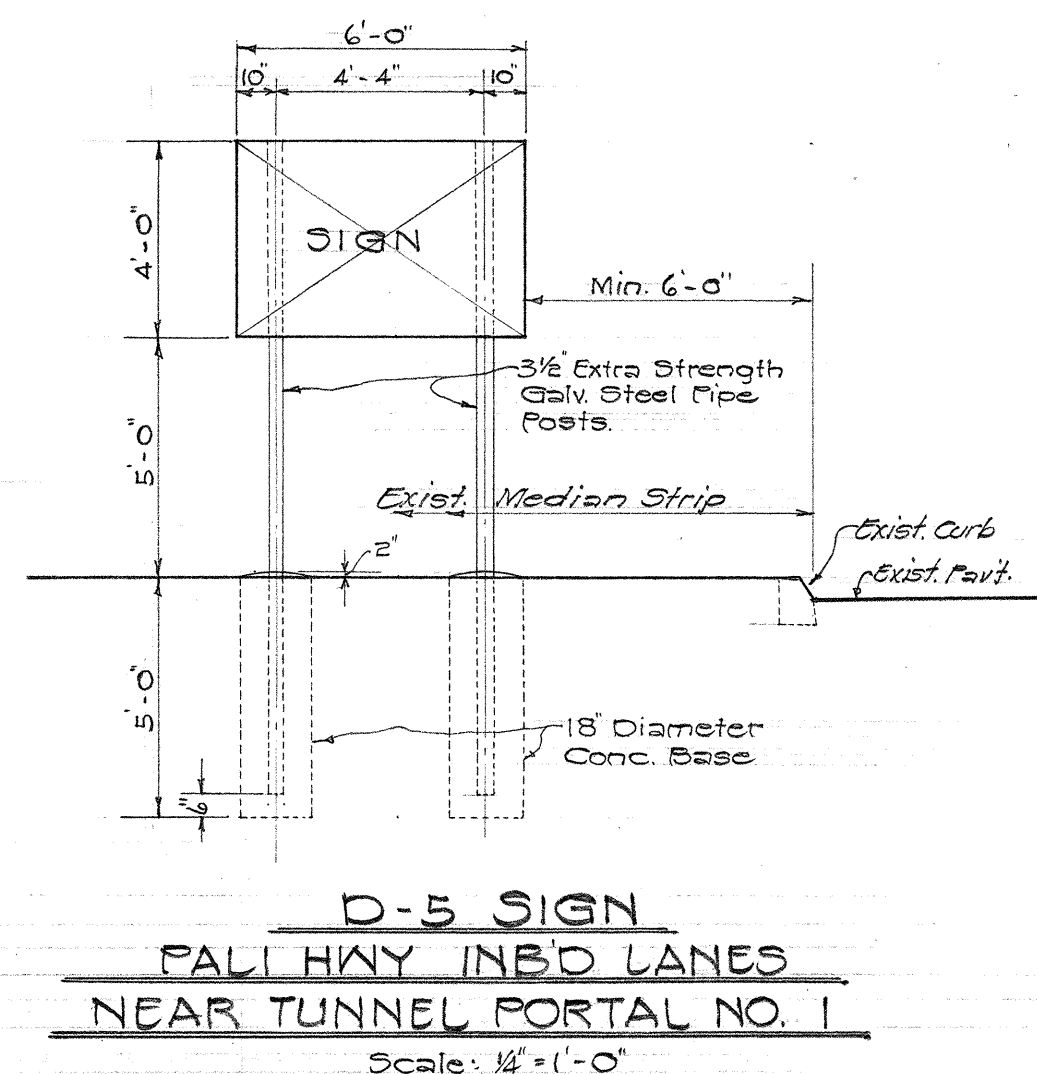
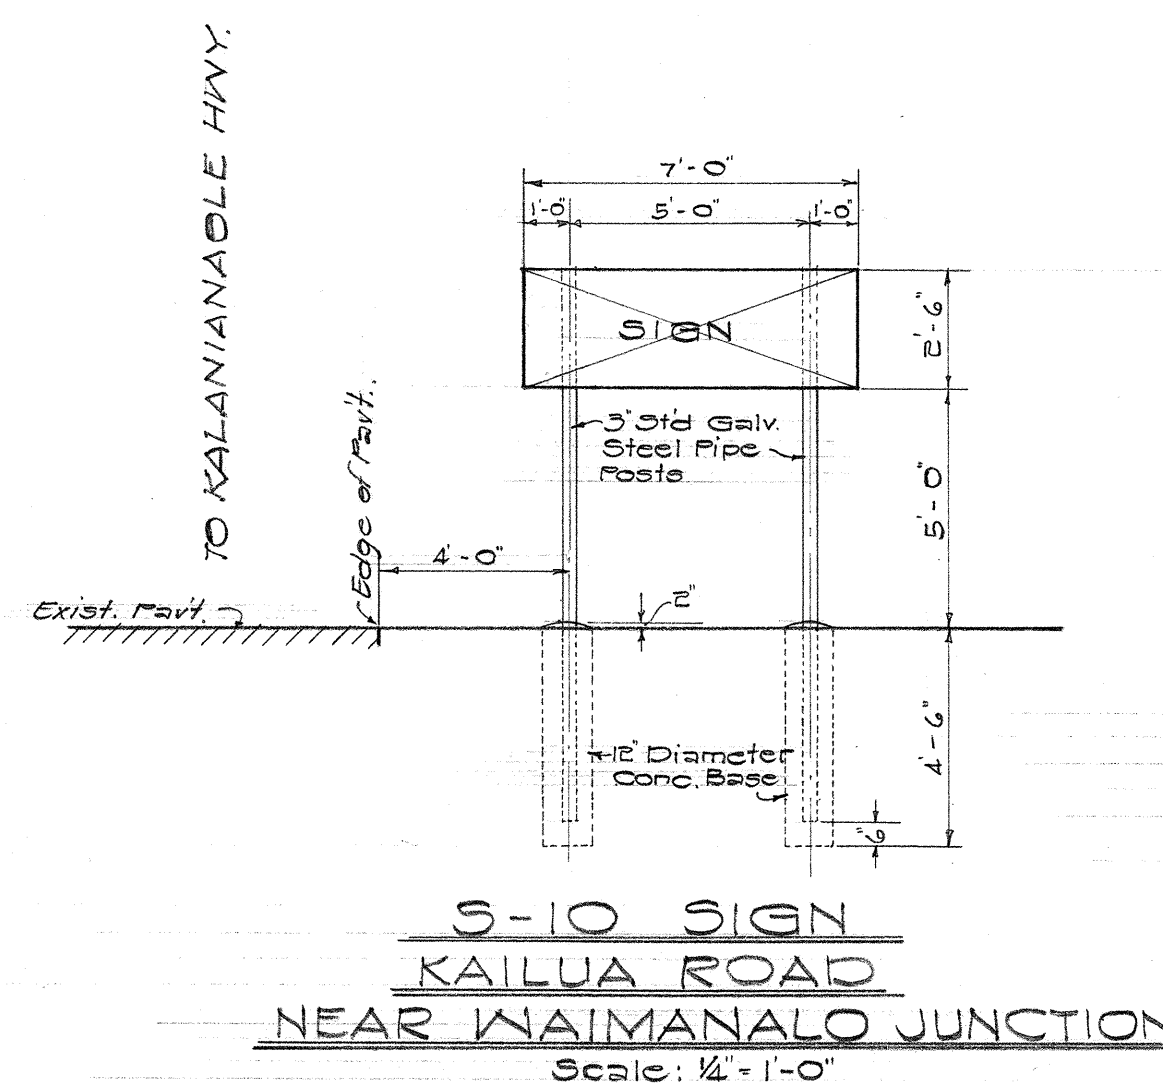


CAUTION CROSS-OVER AHEAD

CAUTION CROSS-OVER AHEAD

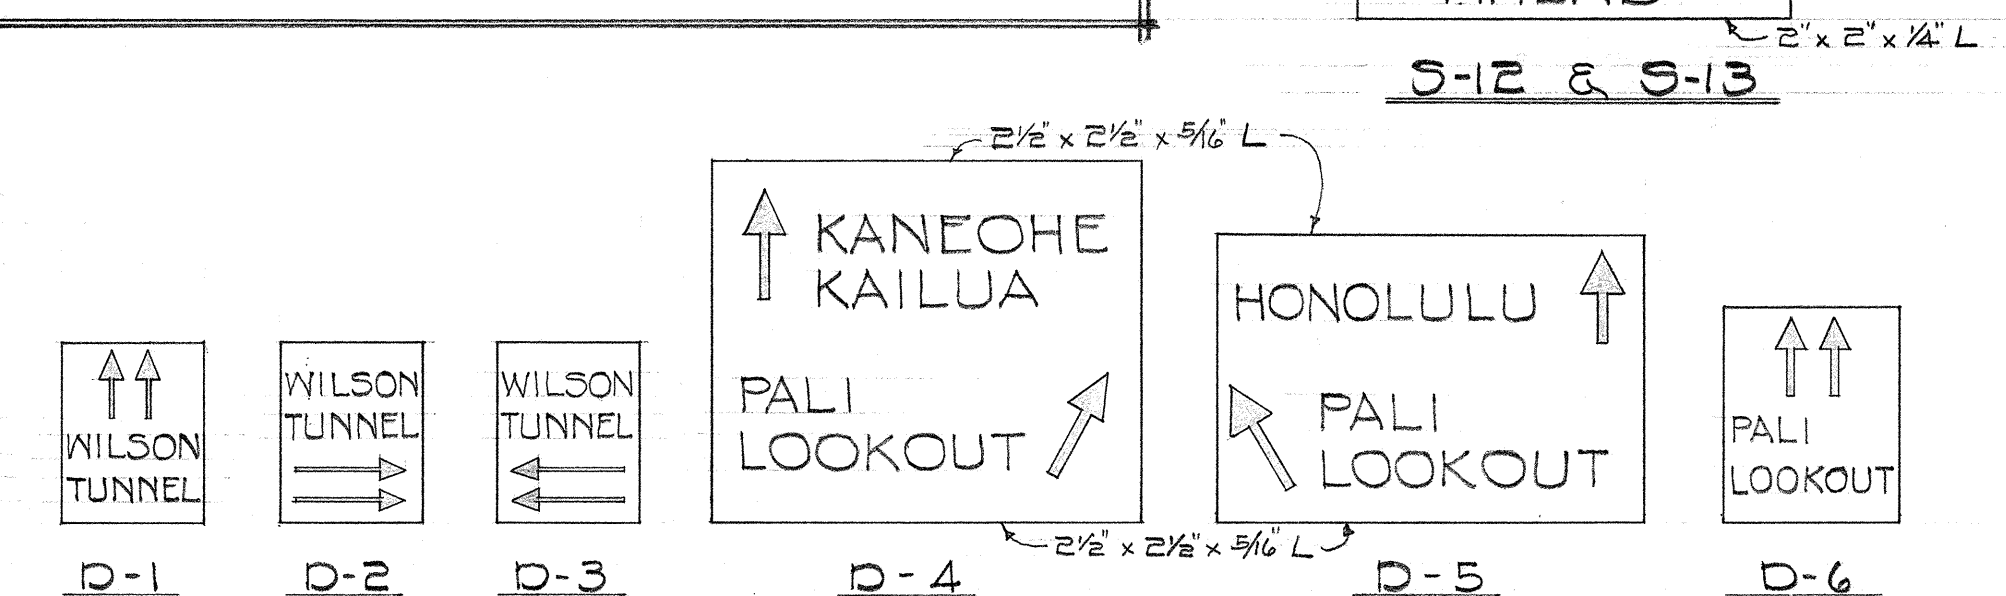

NOTE: Sheet Steel for all sign plates 24" or larger in any dimension shall be 16 gauge thickness, U.S. Standard.

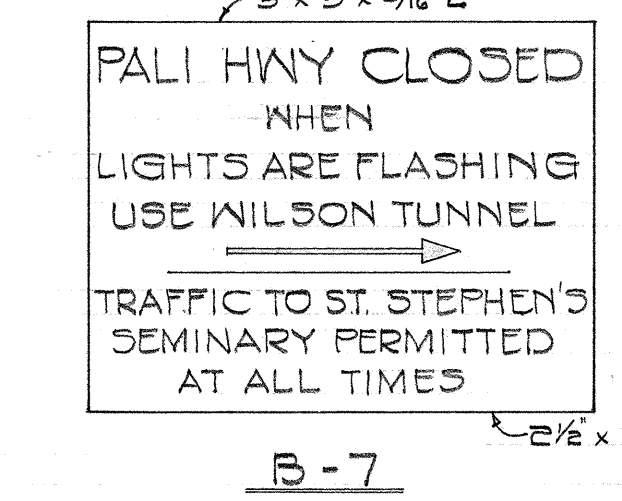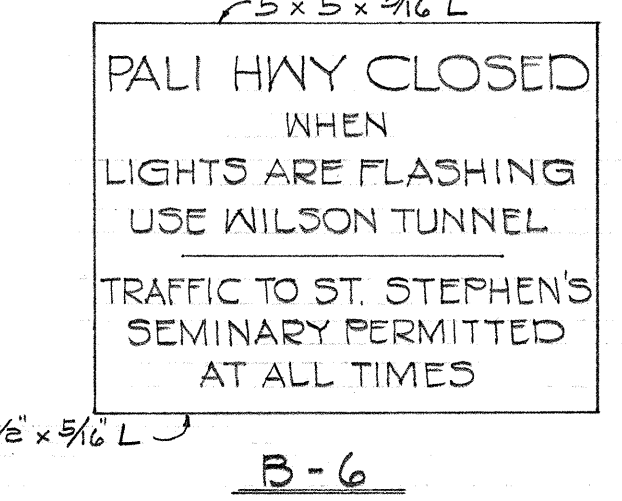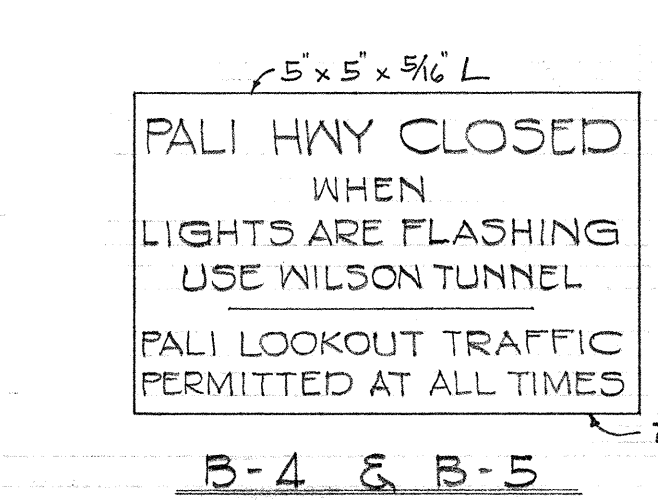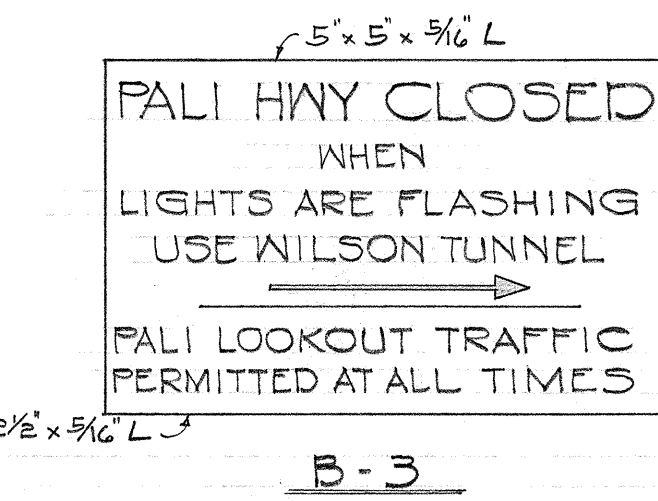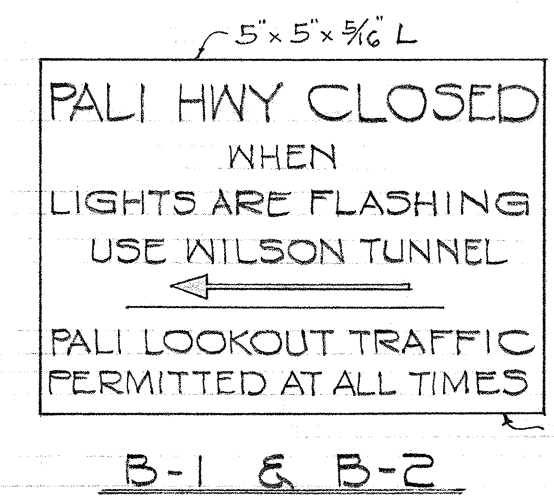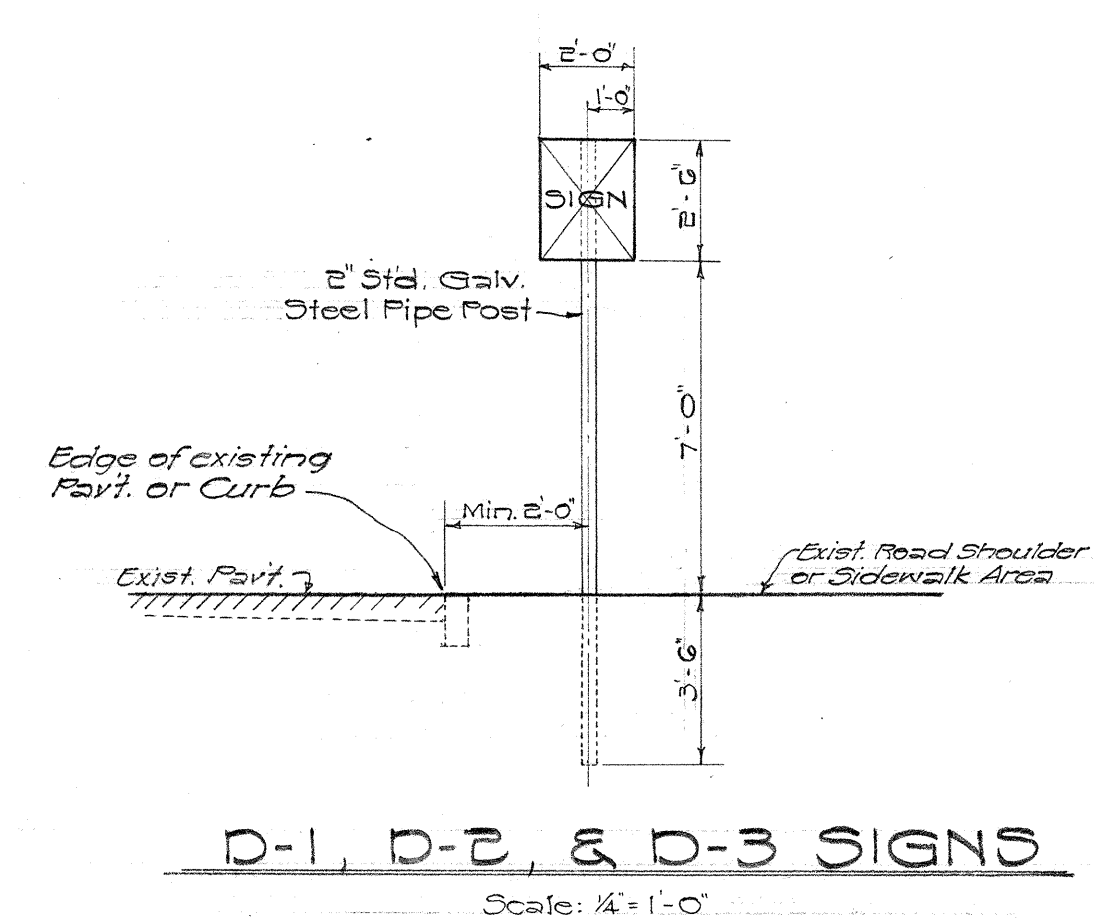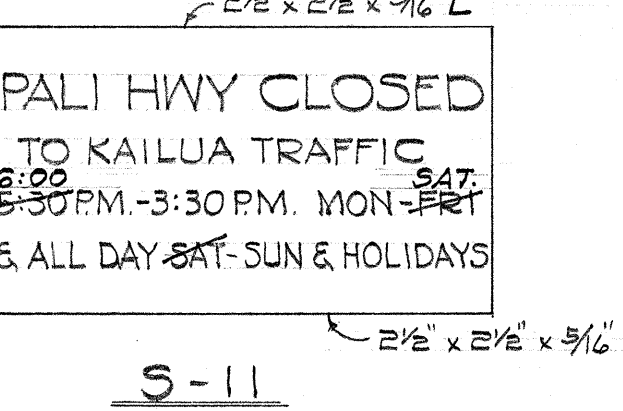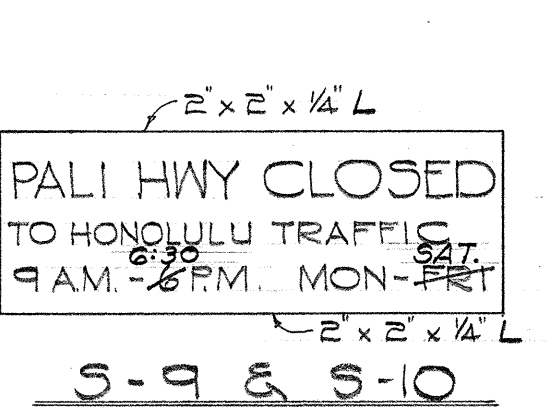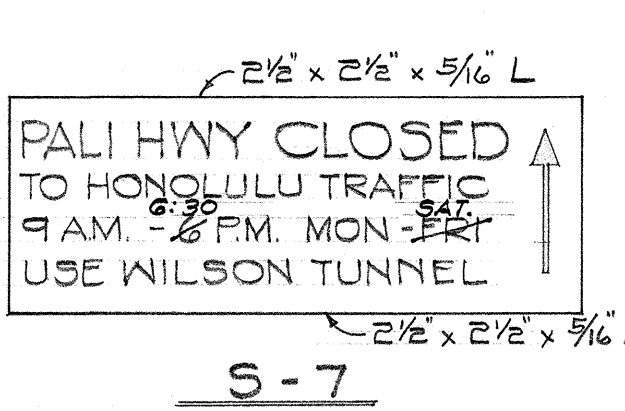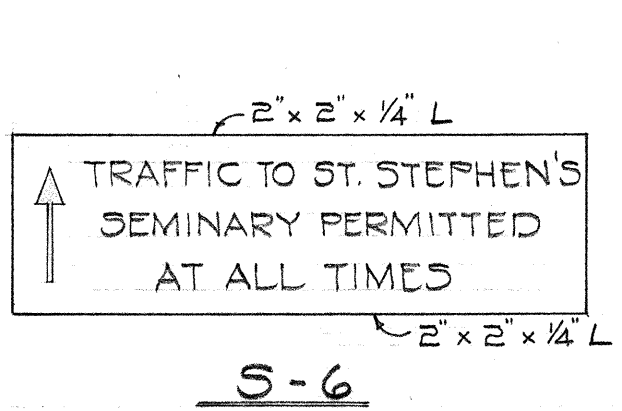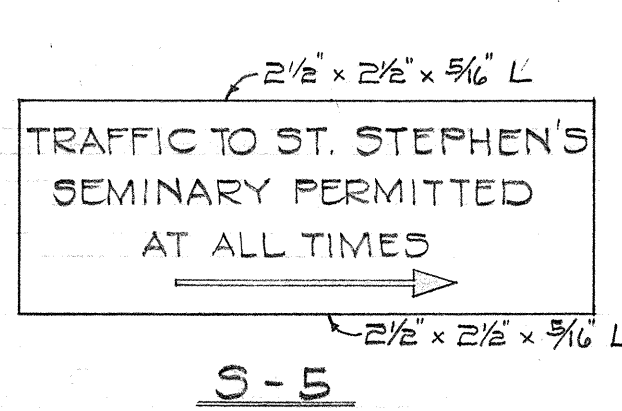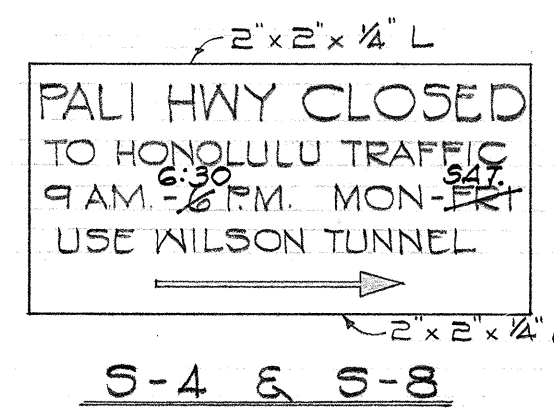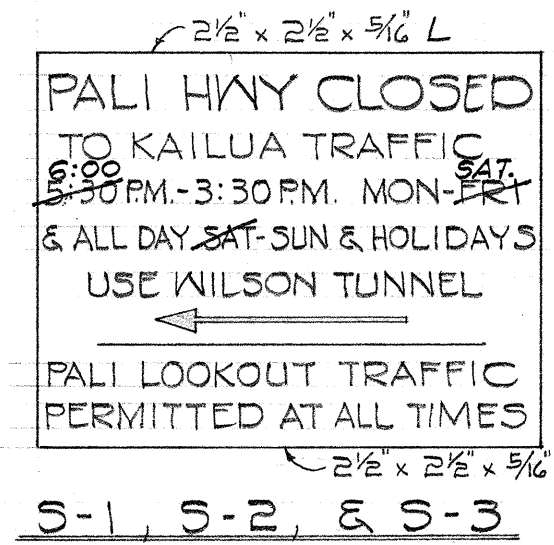

SIGN INSTALLATION, SIGN SCHEDULES, AND CONNECTION DETAILS

HAWAII STATE HIGHWAY DEPARTMENT
STATE OF HAWAII
SPECIAL TRAFFIC WARNING SIGNS AND BARRICADES
PALI HIGHWAY OUTBOUND LANES
PROJ. NO. BF-061-1(8)
SCALE: AS NOTED
MARCH 13, 1960

SIGN PANEL LAYOUT
Scale: 3/8" = 1'-0"

SHEET NO. 4 OF 4 SHEETS

8148.5D