

INDEX TO DRAWINGS	
SHEET NO.	DESCRIPTION
1	TITLE SHEET
2-3	TYPICAL SECTIONS
4-5	PLAN AND PROFILE
5A-5D	SPECIAL WARNING SIGNS
6	DETAIL OF SPECIAL CATCH BASIN
7-9	MISCELLANEOUS DETAILS
10-11	HIGHWAY LIGHTING SYSTEM AND TRAFFIC SIGNS
12	DISPOSAL & STOCKPILE SITES
13-19	STANDARD DETAILS
20-29	CROSS SECTIONS
30-37	PARTIAL BR. NO. 4-A, BRIDGE NO. 4-B, PARTIAL BR. NO. 4-C
38-43	BRIDGE NO. 5-A


SHEET NO.	DESCRIPTION
44-49	BRIDGE NO. 7-A
50-55	BRIDGE NO. 8-A
56-58	TYPICAL BRIDGE DETAILS
59-61	STANDARD BRIDGE DETAILS

STATE OF HAWAII
HAWAII STATE HIGHWAY DEPARTMENT
HONOLULU, HAWAII
AS-BUILT
PLANS OF
PALI HIGHWAY
PORTAL 4A TO HAIRPIN TURN
OUTBOUND LANES
FEDERAL AID PROJECT NO. BF-061-I(8)
DISTRICT OF KOOLAUPOKO
ISLAND OF OAHU

SCALES


PLAN	1 IN. = 50 FT.
PROFILE	HOR. 1 IN. = 50 FT.
	VERT. 1 IN. = 20 FT.
CROSS SECTION	HOR. 1 IN. = 10 FT.
	VERT. 1 IN. = 10 FT.

CONVENTIONAL SIGNS	
Centerline	125
Boundary Lines	or
Fences (Named)	
Existing Roadways	
Circular Culvert	
Box Culvert	
Bridge	
Telephone Pole	
Electric Power Pole	
Water Main	W ₂ W ₂ (W ₄ , 8, 12, Etc.)
Storm Drain	SD ₁₂ SD ₁₂ (SD ₁₈ , 24, Etc.)
Concrete Drop Intake	
Standard Catch Basin	
Standard Manhole	M.H.S.
Sewer Manhole	S.S. S.S. S.S.
Telephone Manhole	T.M.H.
Fire Hydrant	F.H.
Tree (Large, named)	Mango Coco
Railroad	
Haw'n Telephone Underground Cable	HTC
Water Meter	WM

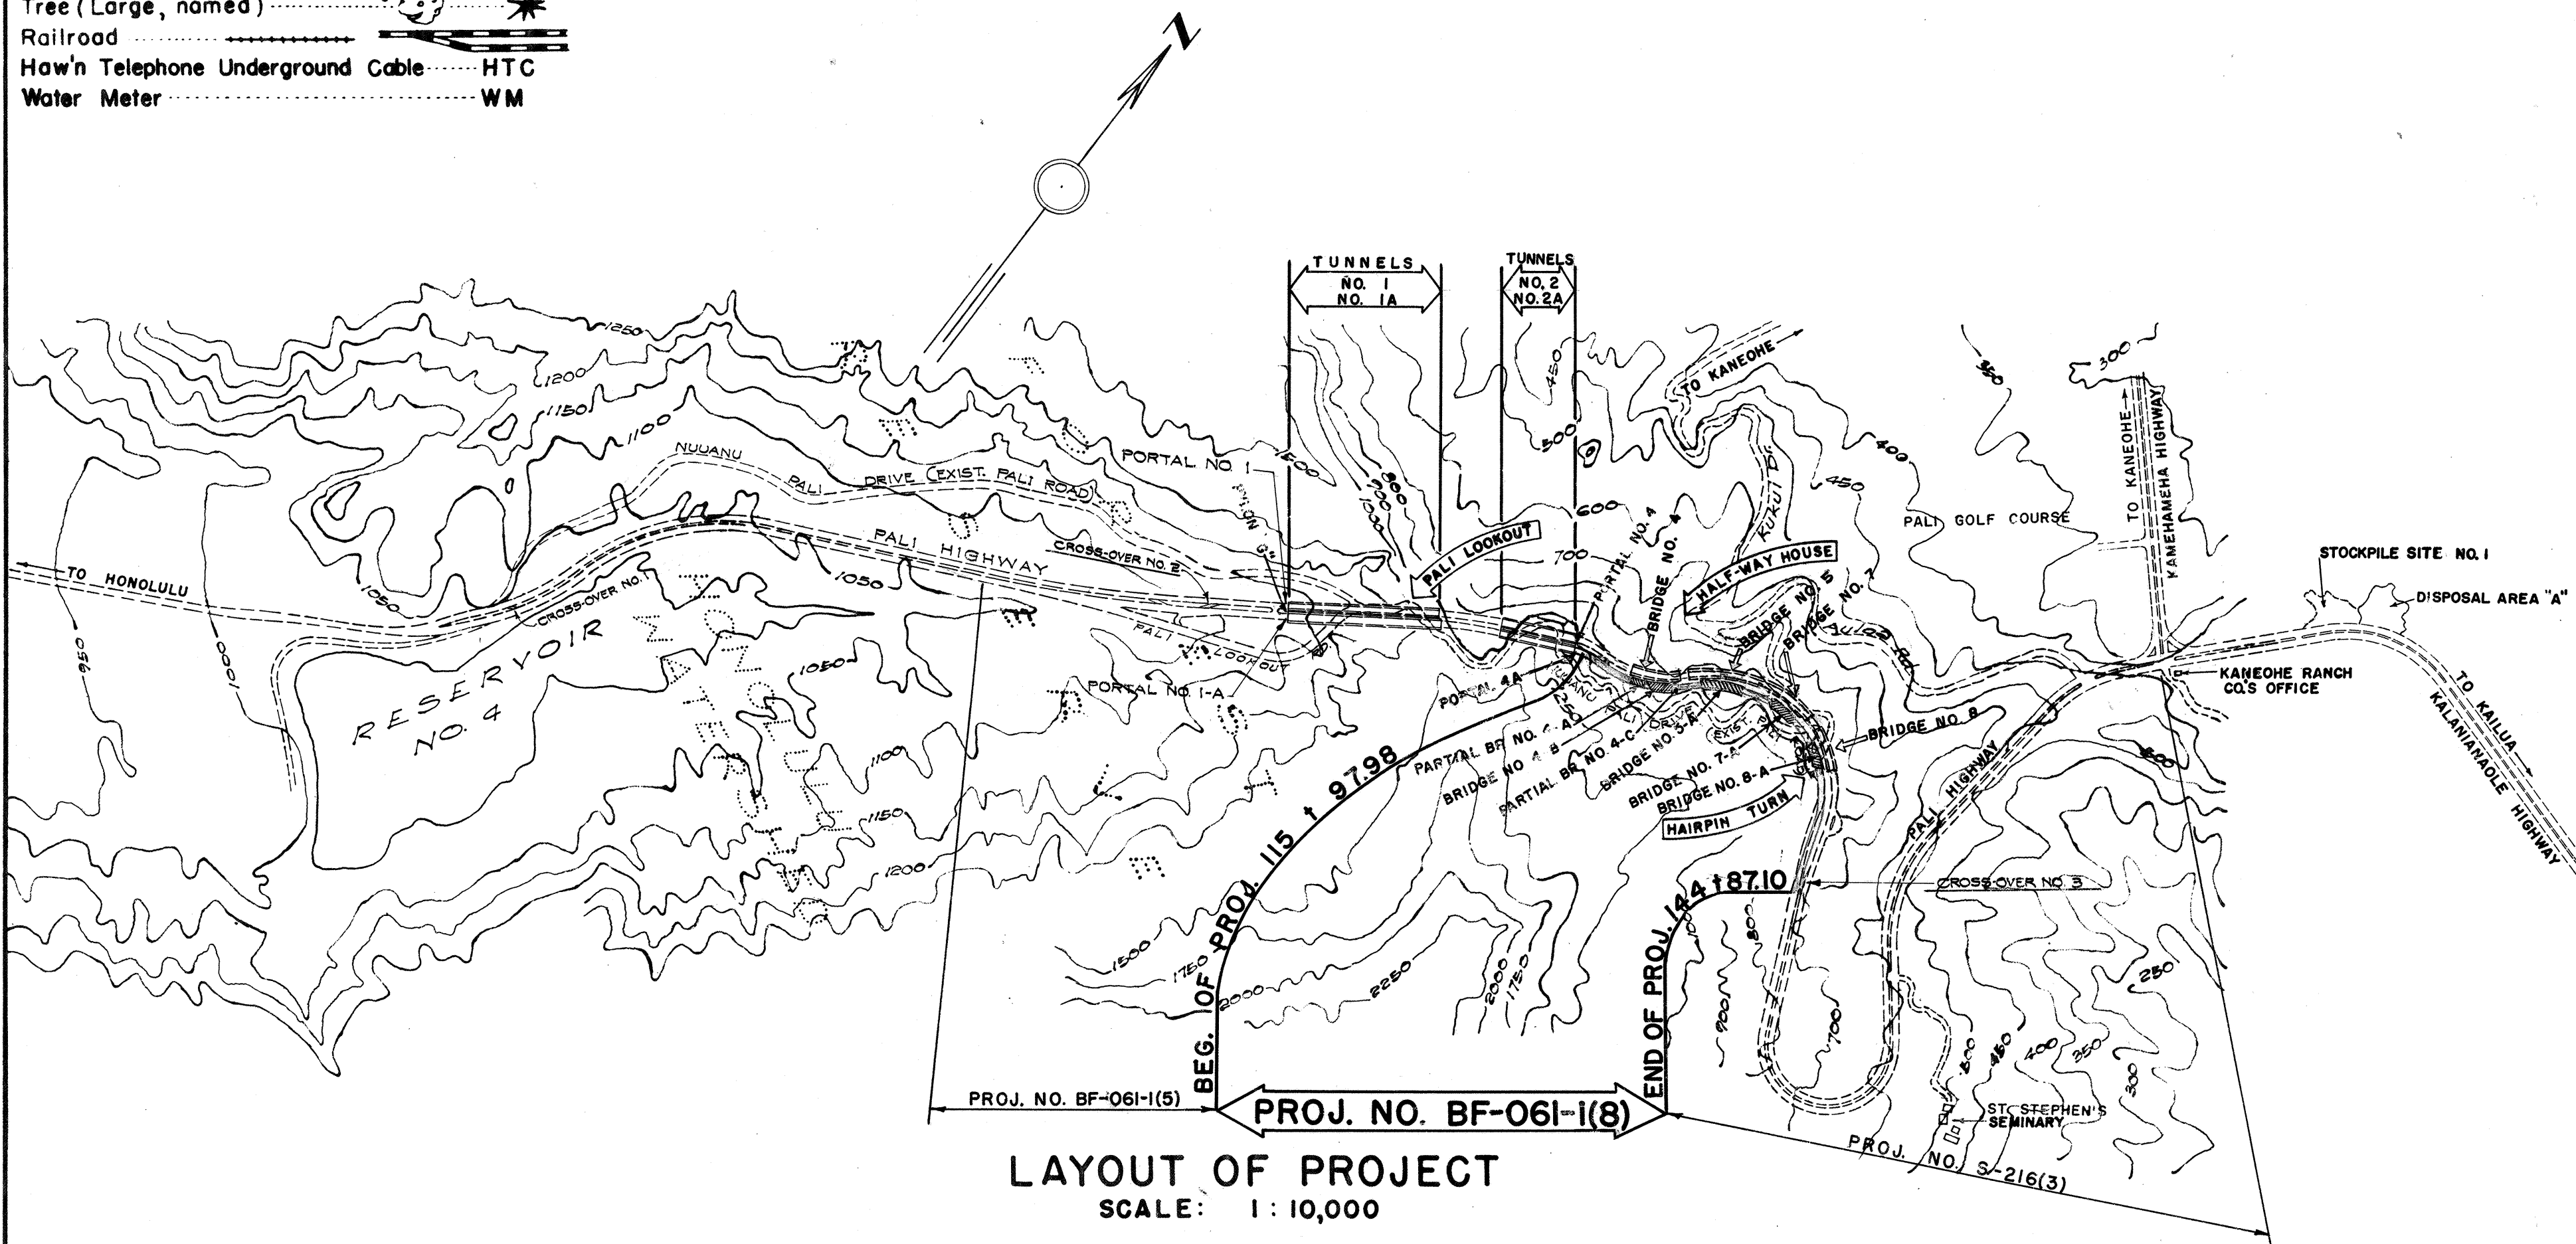

LAYOUT OF PROJECT
SCALE: 1:10,000

Gross Length of Project..... 0.547 Mile
Bridges Over 20' 0" Span..... 0.122 Mile
Net Length of Roadway..... 0.425 Mile

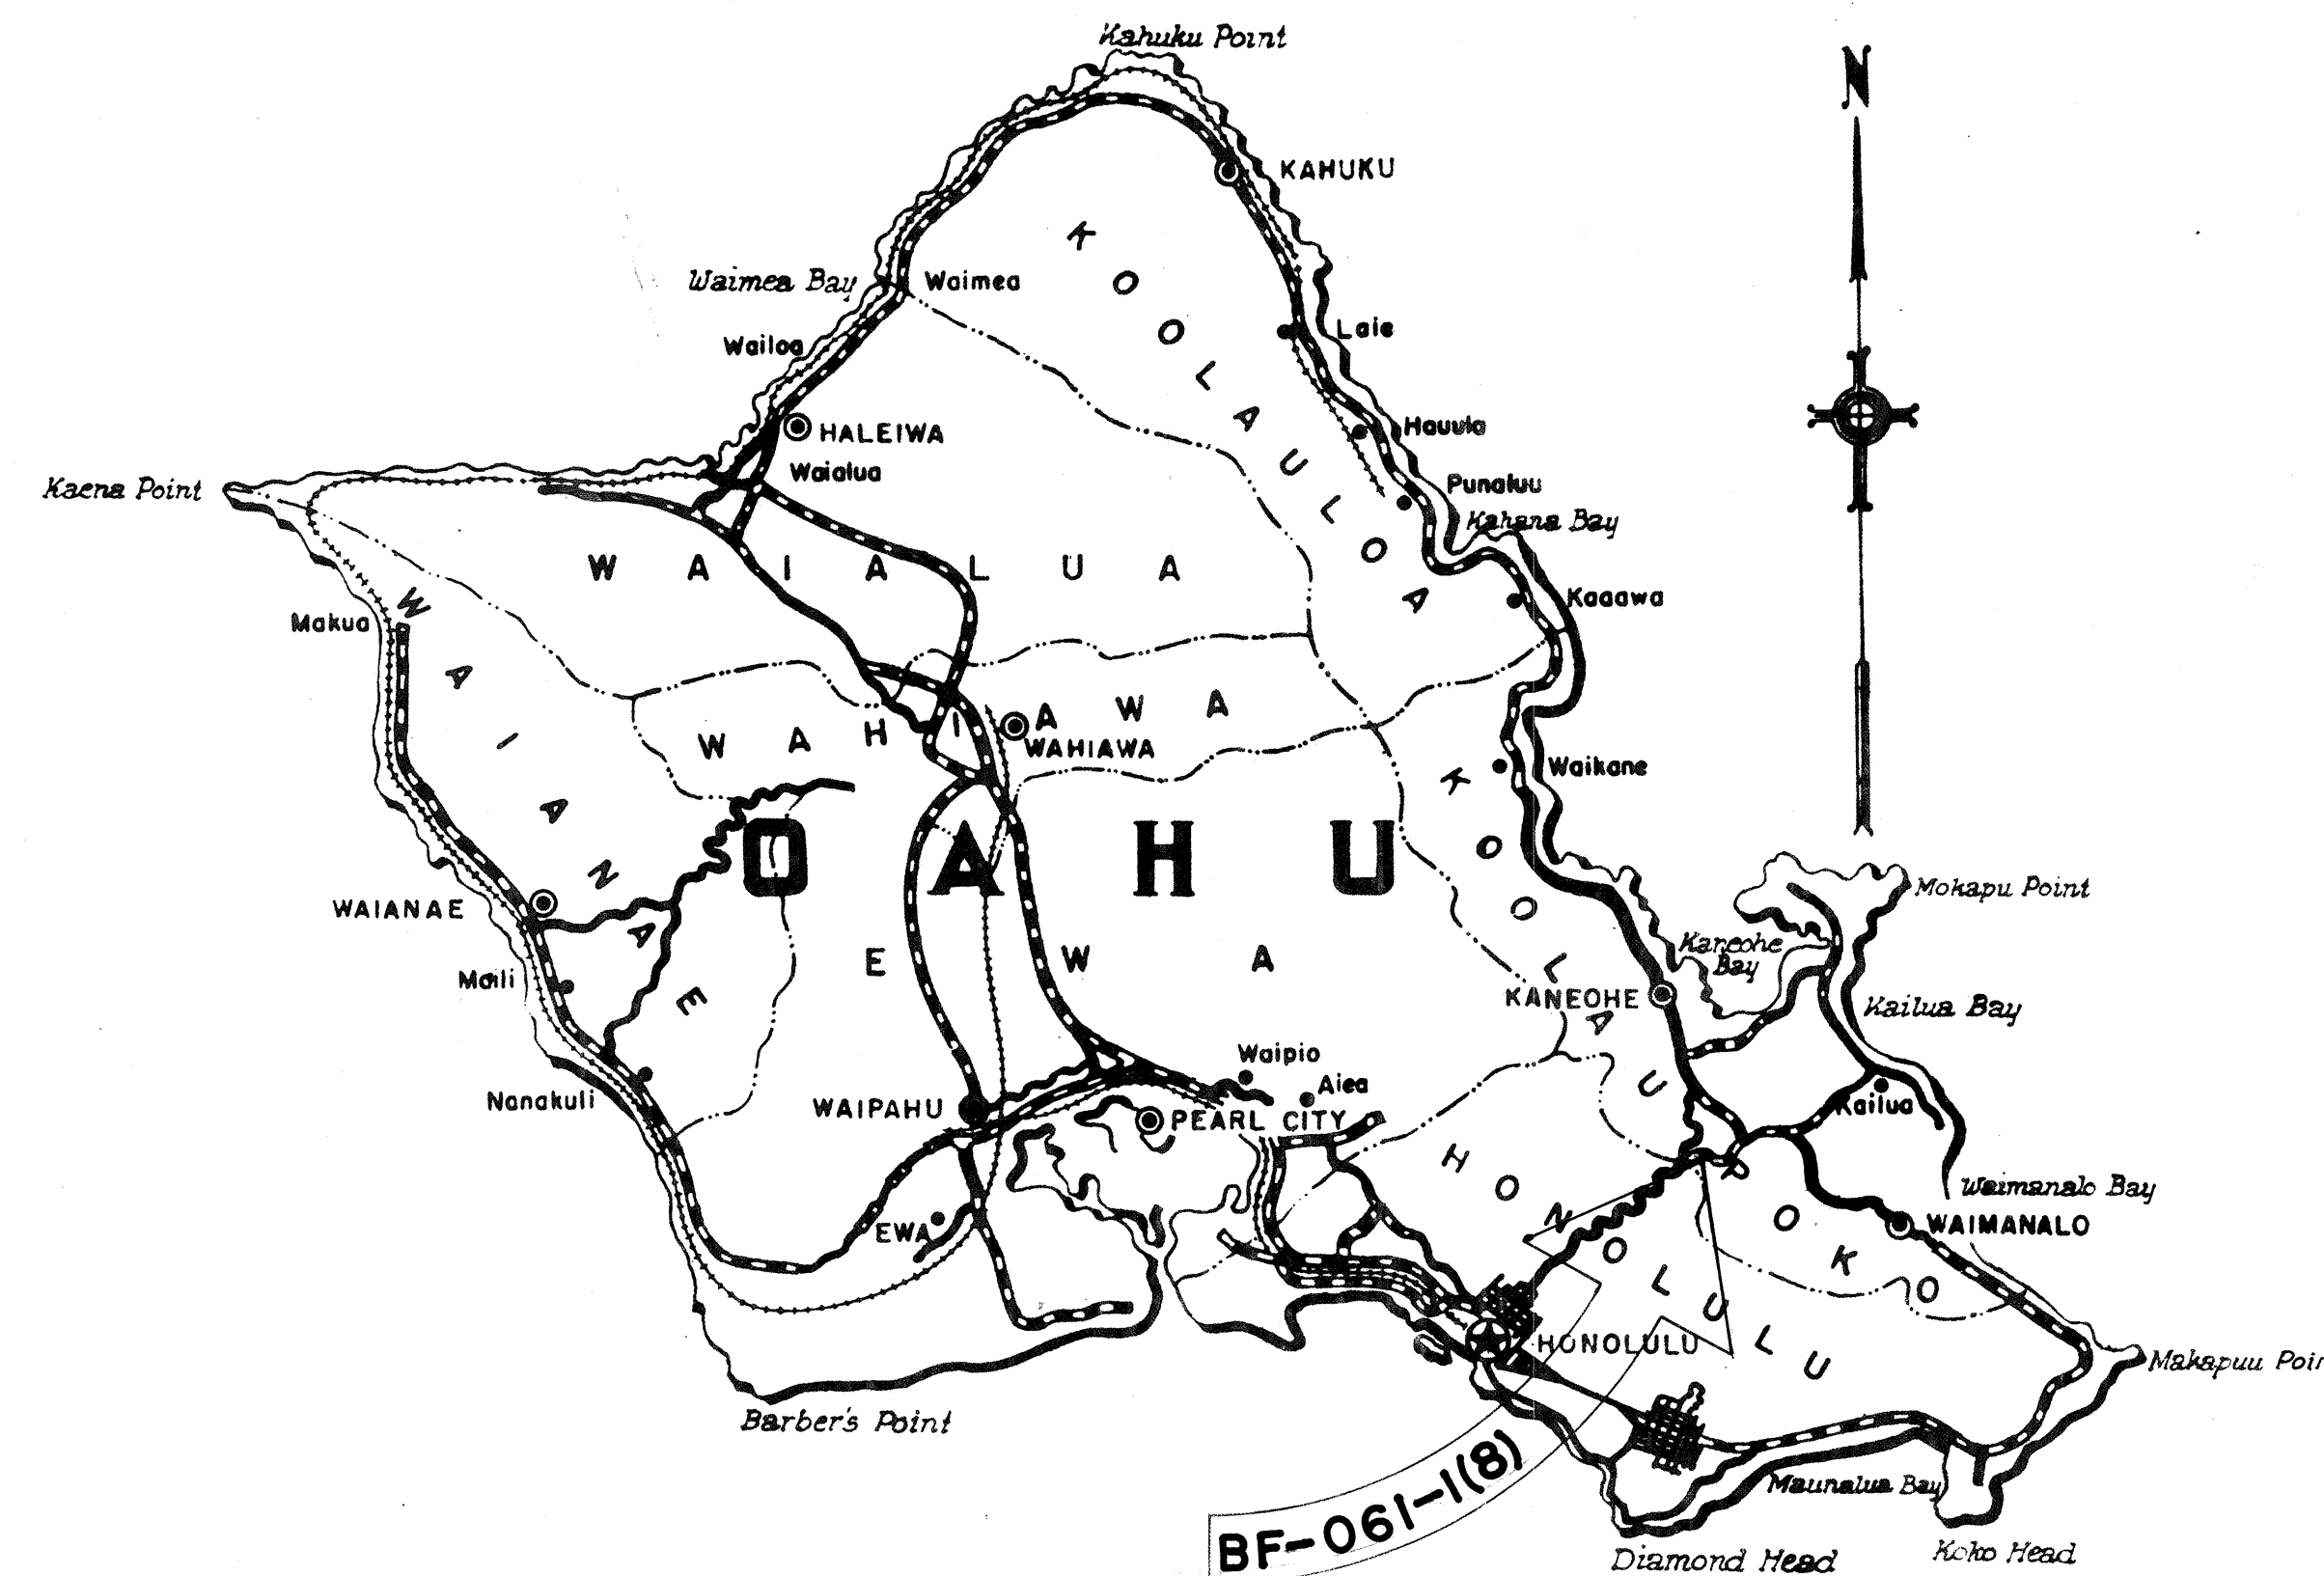

Federal Aid Projects Previously Constructed Or Under Construction

NOTE: ALL CHANGES MADE DURING
CONSTRUCTION ARE SHOWN IN
RED ON THESE TRACINGS
AND CHECKED BY :

J. Okazaki
PROJECT ENGINEER

8/6/63
DATE

APPROVED
[Signature]
STATE HIGHWAY ENGINEER

DEPARTMENT OF COMMERCE
BUREAU OF PUBLIC ROADS
APPROVED:
DIVISION ENGINEER DATE

8148.01