


INDEX TO DRAWINGS	
SHEET NO.	DESCRIPTION
1	TITLE SHEET
2	TYPICAL SECTIONS


STATE OF HAWAII  
DEPARTMENT OF TRANSPORTATION  
DIVISION OF HIGHWAYS  
HONOLULU, HAWAII

AS BUILT  
PLANS FOR  
THE RECONSTRUCTION & RESURFACING  
OF PORTION OF  
KALANIANA'OLE HIGHWAY  
(KAPAA QUARRY RD. TO WAIMANALO JCT.)  
PROJ. NO. B-61-01-60  
AND  
KAILUA ROAD  
(WAIMANALO JCT. TO KAILUA TOWN)  
PROJ. NO. C-61-01-60

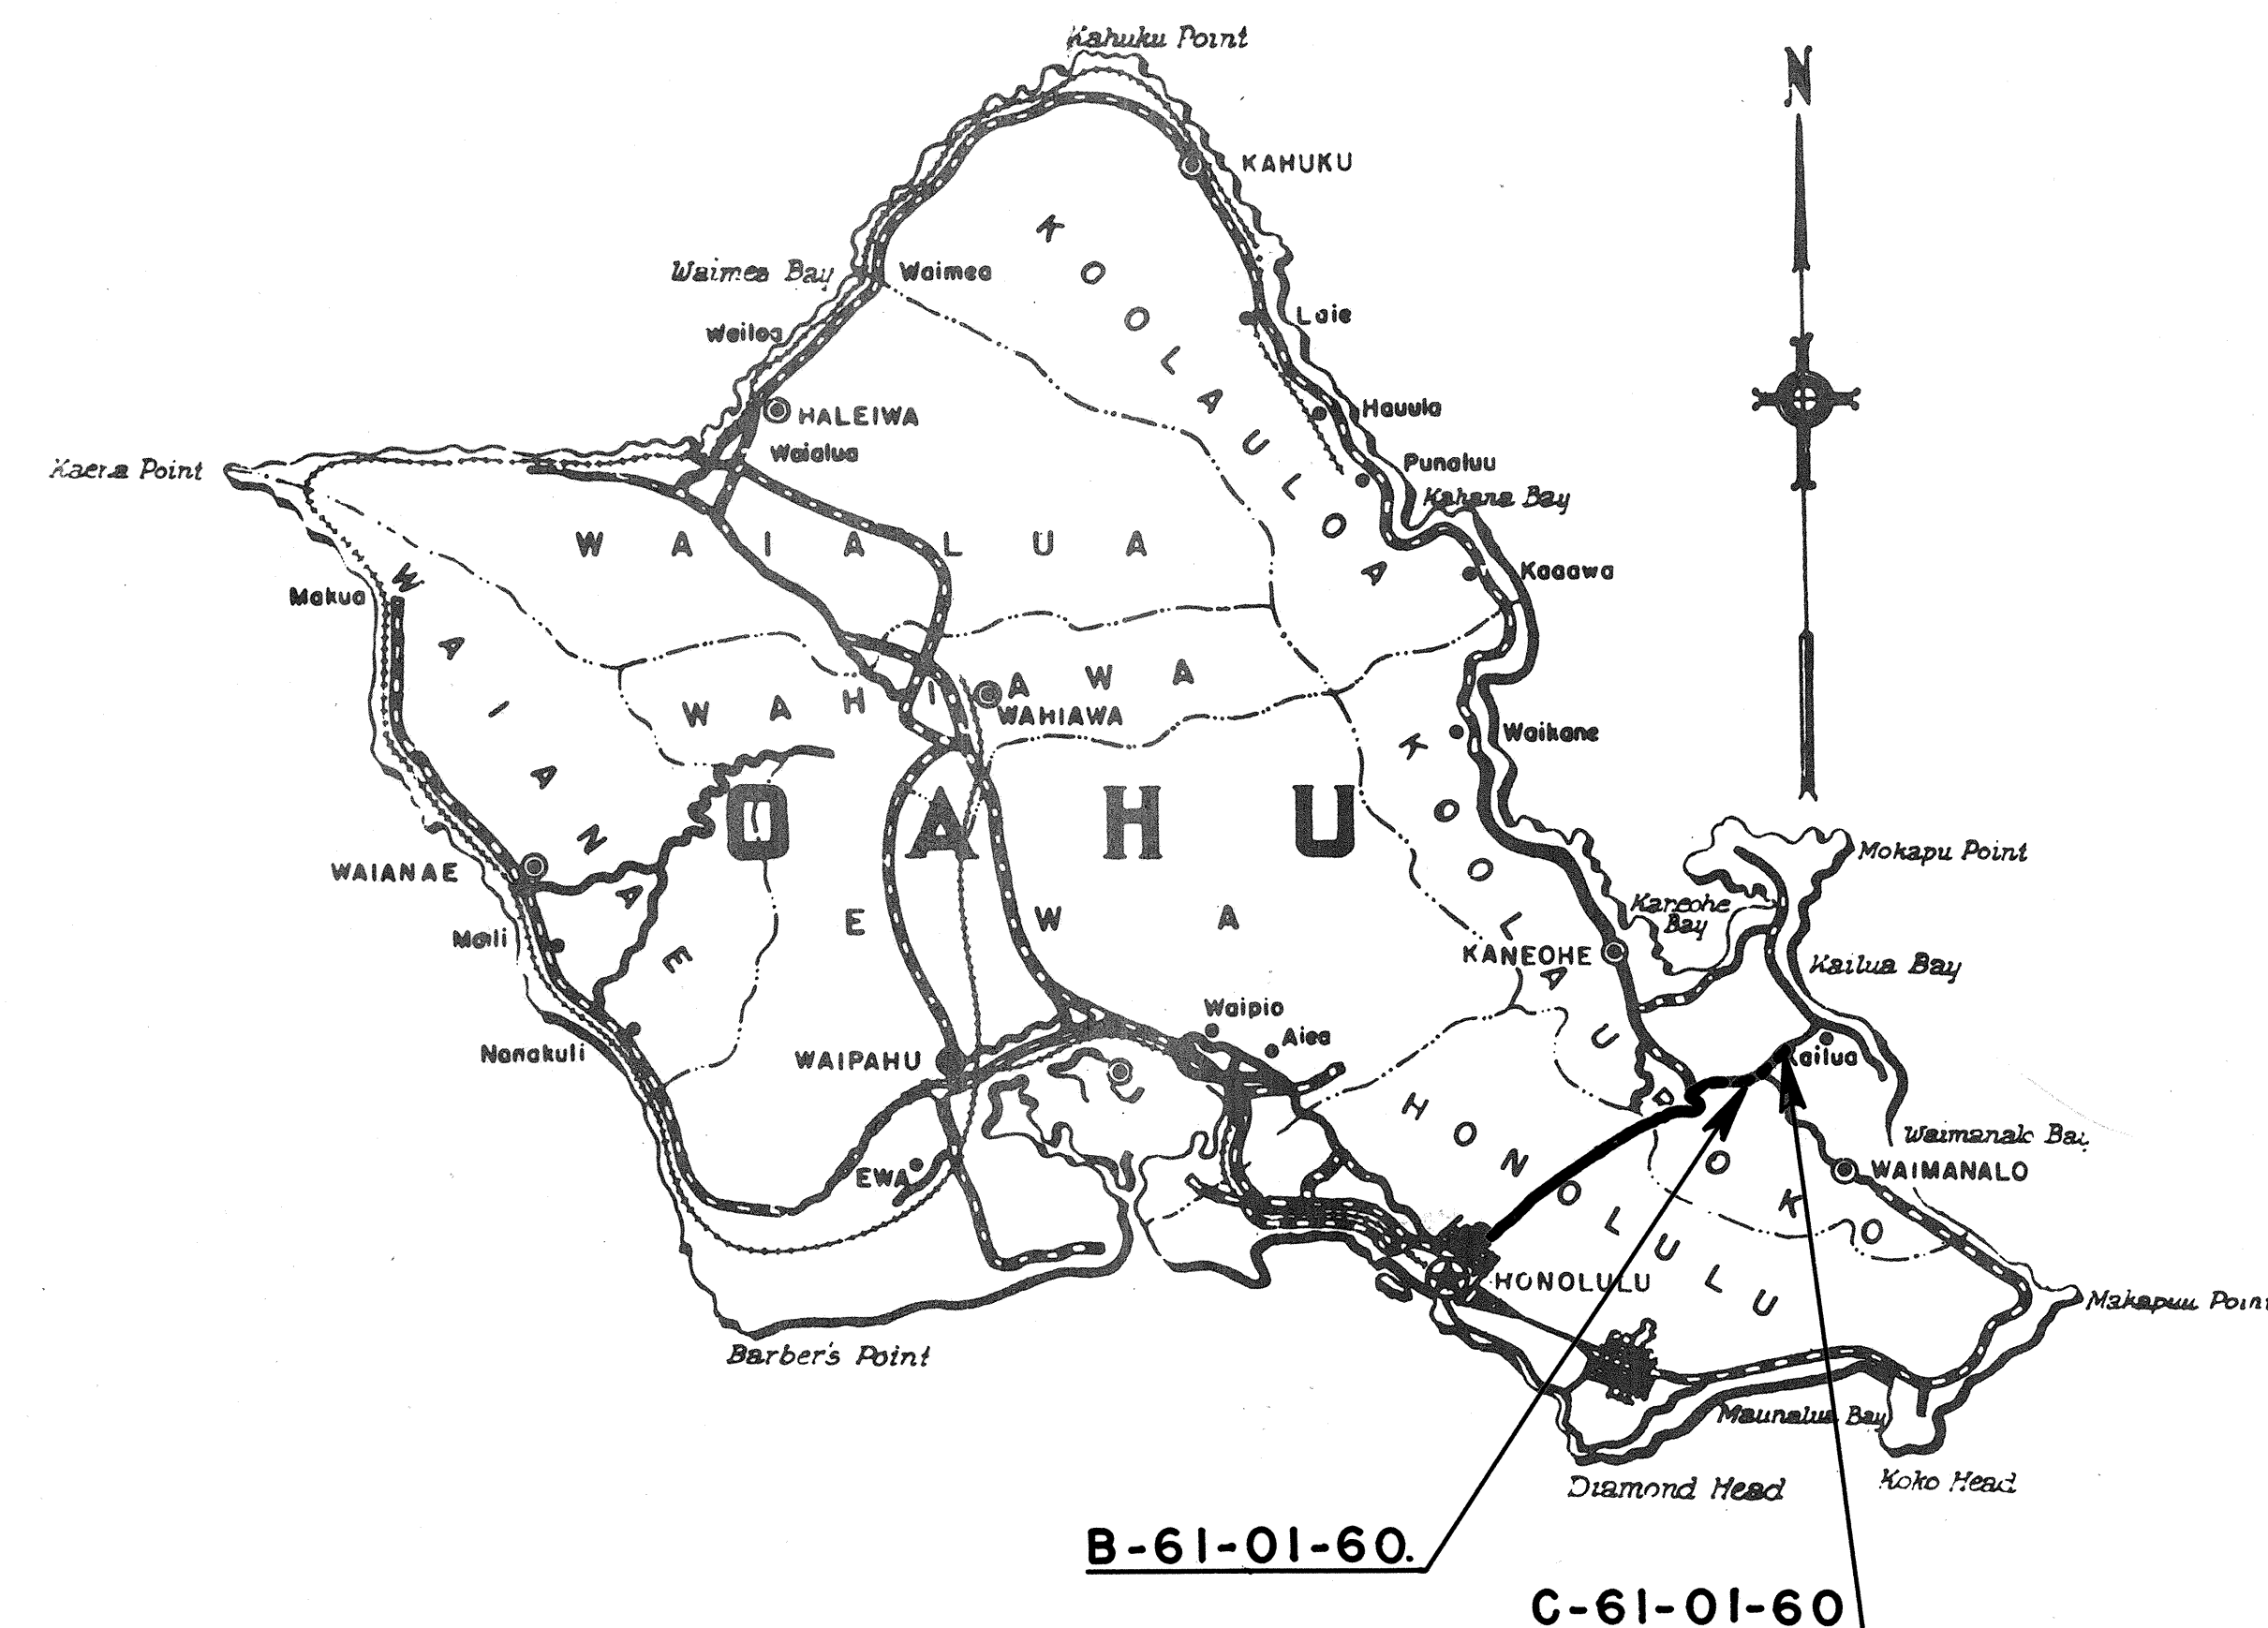

Federal Aid Projects Previously Constructed Or Under Construction

LAYOUT OF PROJECT  
Scale: 1" = 2000'

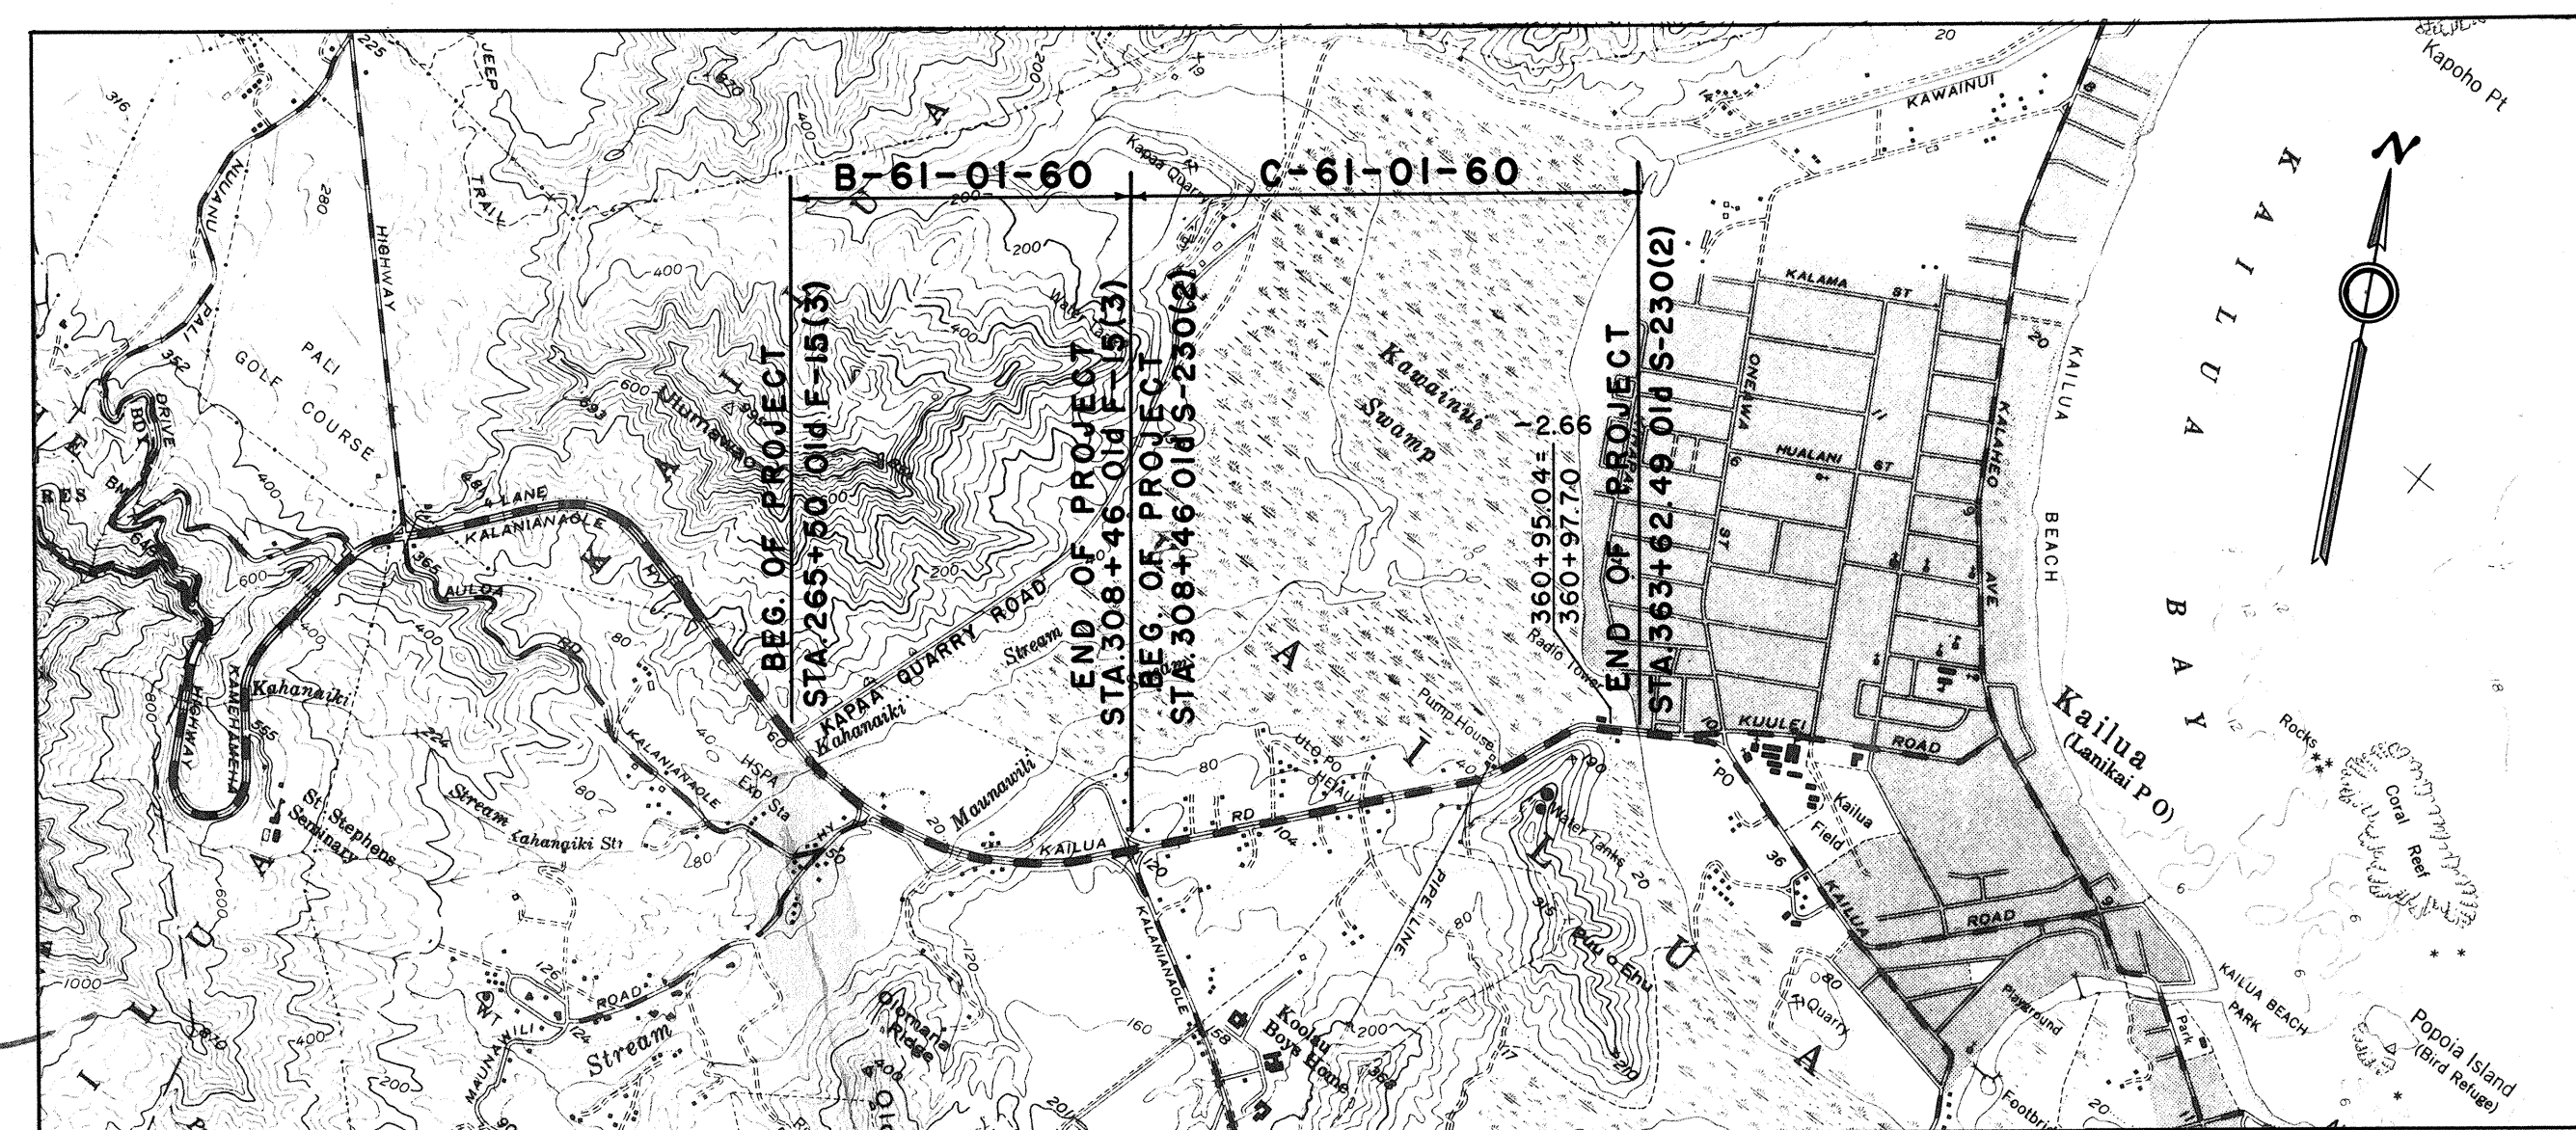

LENGTH OF PROJECT  
B-61-01-60.....0.814 Mi.  
C-61-01-60.....1.045 Mi.  
TOTAL LENGTH.....1.859 Mi.

NOTE:  
All Changes Made During  
Construction Have Been Noted In  
Red On These Tracings And  
Checked By:

*T. Harano*  
DISTRICT ENGINEER

1/18/62  
DATE

APPROVED: DATE 7/7/60  
*J. C. Myatt*  
ACTING DIRECTOR OF TRANSPORTATION