




TYPICAL SECTION AS ORIGINALLY CONSTRUCTED
Scale: 1/4" = 1'-0"

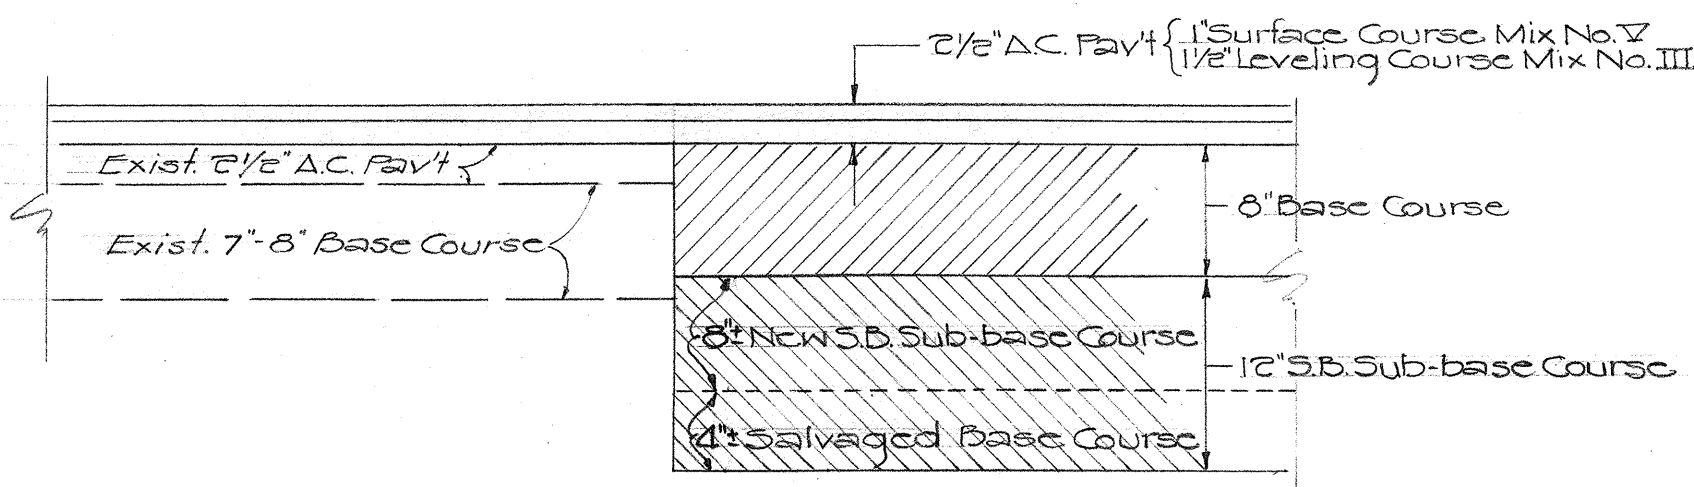

TYPICAL DETAIL FOR TRANSVERSE AND LONGITUDINAL JOINTS
Scale: Not to scale

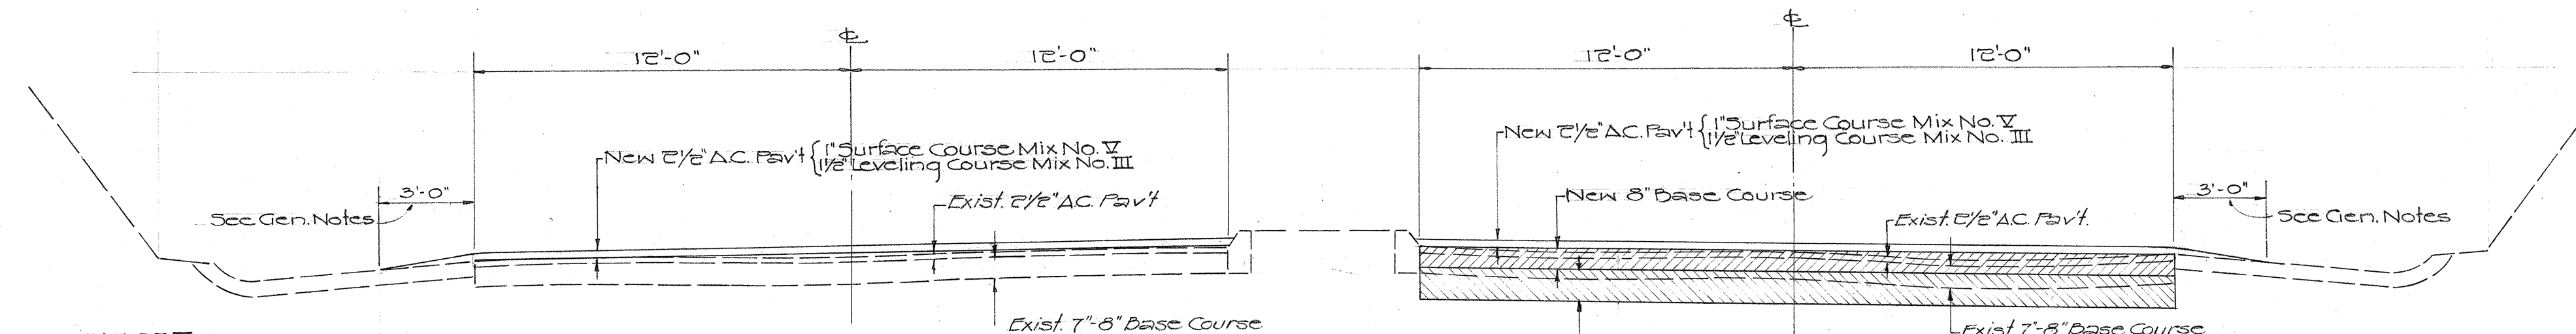

TYPICAL SECTION (RESURFACING ONLY)
Scale: 1/4" = 1'-0"

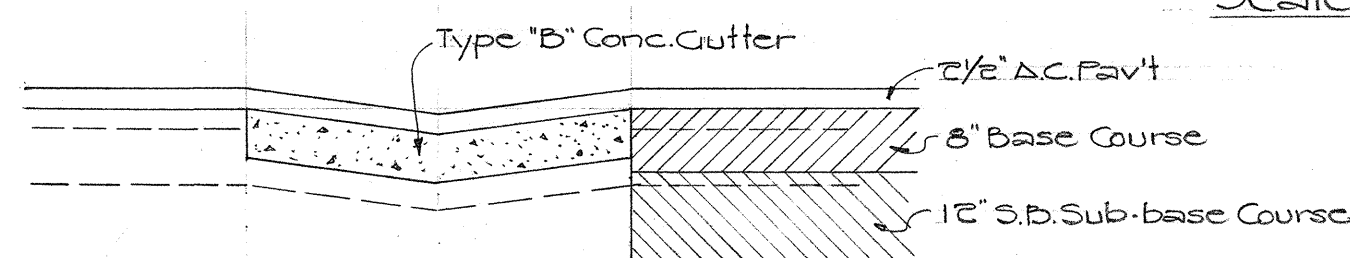


TYPICAL SECTION - RECONSTRUCTED BASE & RESURFACING AT TYPE "B" CONCRETE GUTTER SECTION
Scale: Not to scale

GENERAL NOTES

- 1- New Resurfaced Pavement adjacent to Concrete Gutters 2 1/2' wide or less, shall be feathered-out over the entire width of the Gutter.
- 2- New Resurfaced Pavement adjacent to P.C.C. Pavement and 8' wide Concrete Gutters, shall be feathered-out over the concrete to a point 3' from the edge of pavement.
- 3- Untreated base - Top soil shall be placed on all Grassed Shoulder areas abutting the new Resurfaced Pavement to a point 8' from the edge of pavement. The following Shoulder Locations to receive top soil, untreated base:
Outbound Lanes: Sta. 265+50 to Sta. 277+40
Sta. 278+70 to Sta. 287+00
Sta. 291+50 to Sta. 294+50
Sta. 297+10 to Sta. 303+00
Inbound Lanes: Sta. 265+50 to Sta. 347+10
Sta. 347+20 to Sta. 357+50
- 4- Untreated Base Material shall be placed on all Dirt Shoulder areas abutting the new Resurfaced Pavement to a point 8' from the edge of pavement. The following Shoulder Locations to receive Untreated Base Materials:
Outbound Lanes: Sta. 277+40 to Sta. 278+70
Sta. 287+00 to Sta. 291+50
Sta. 294+50 to Sta. 297+10
Inbound Lanes: Sta. 347+10 to Sta. 347+20
Sta. 357+50 to Sta. 363+00
- 5- Contractor shall provide a smooth connection to Existing Pavement at Beg. and End of Project and at all Sideroad Connections.

TYPICAL SECTION (RECONSTRUCTED BASE & RESURFACING)
Scale: 1/4" = 1'-0"

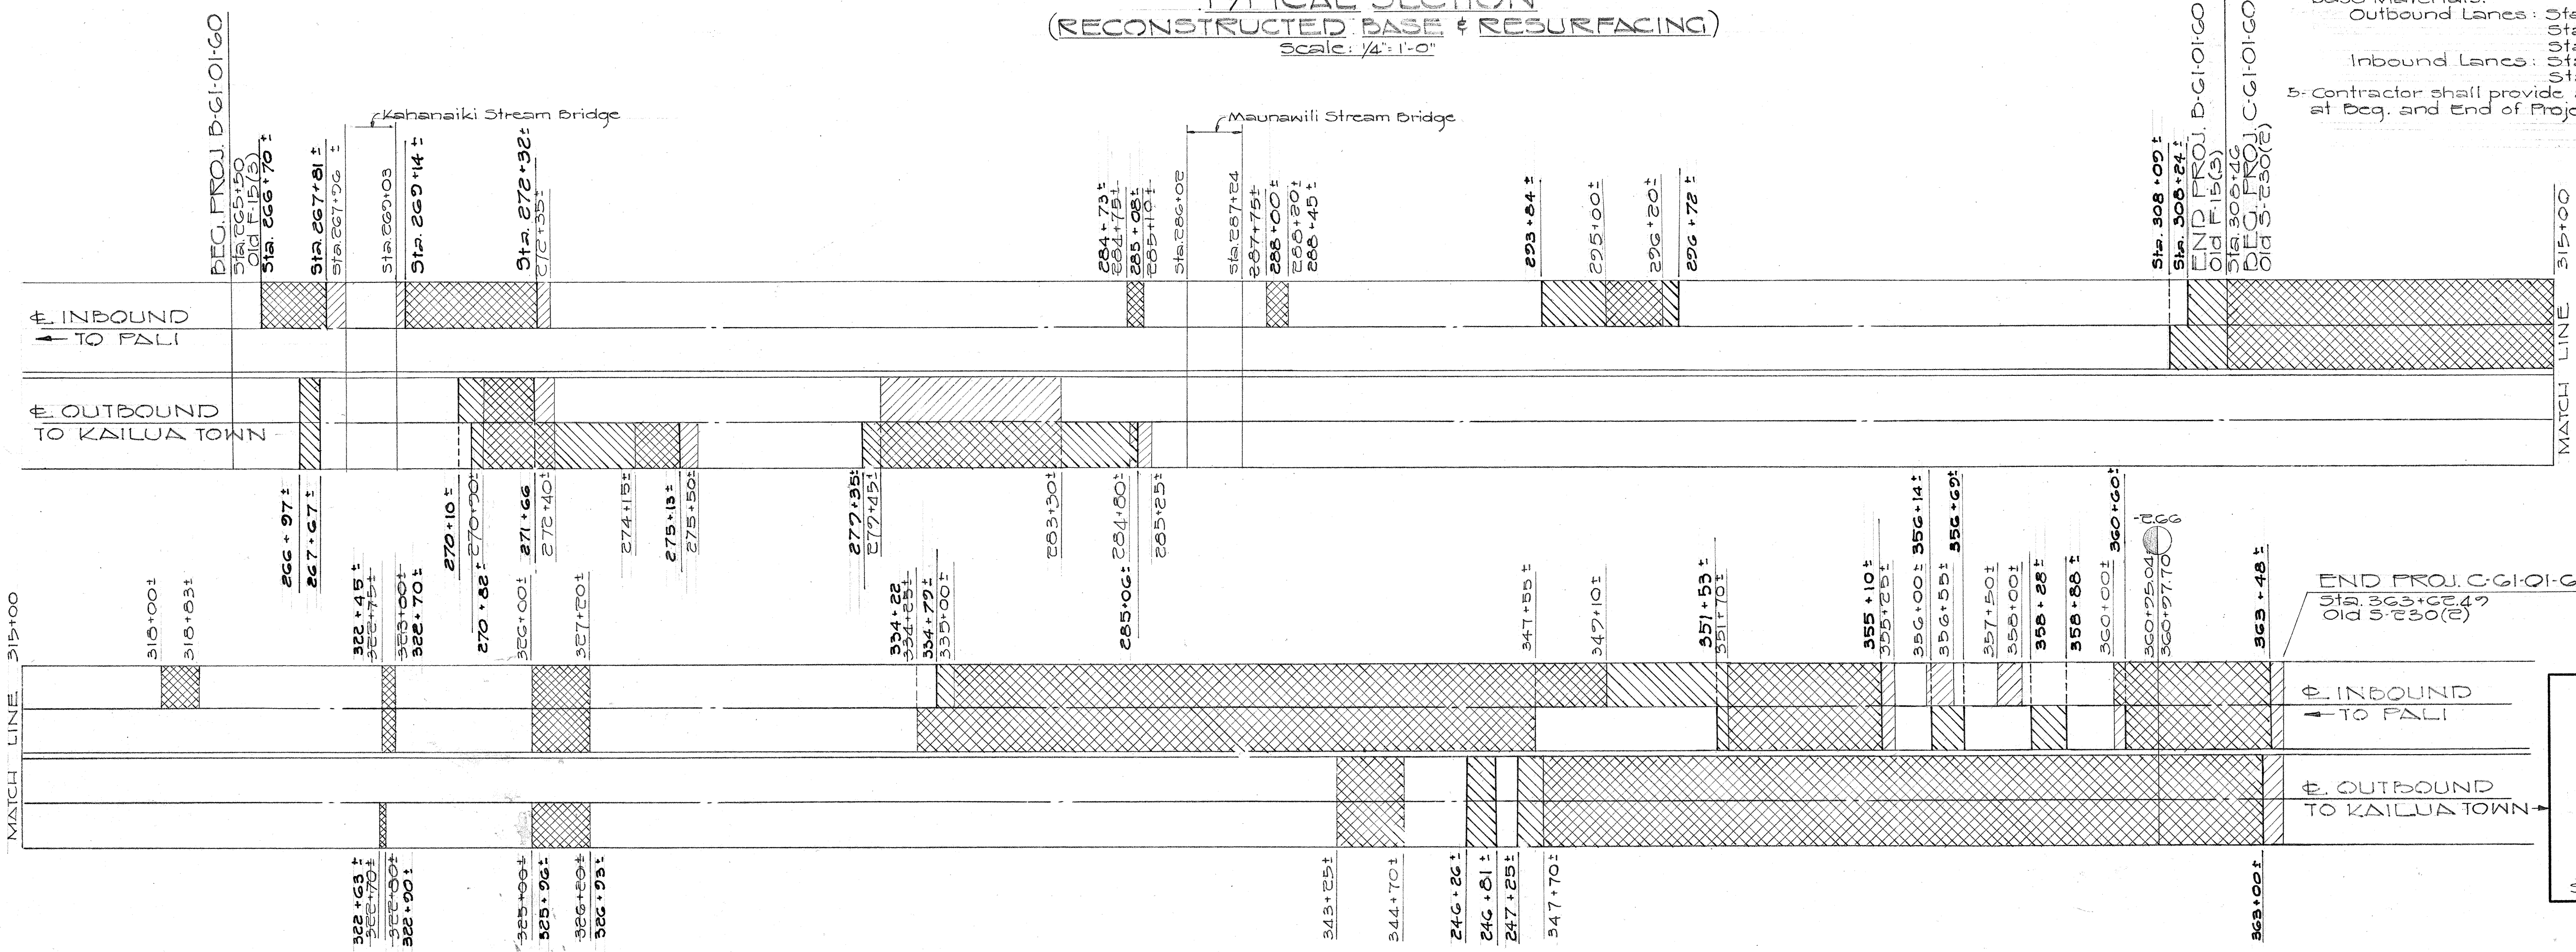

LEGEND

- TO BE RESURFACED ONLY
- TO BE RECONSTRUCTED
- AS BUILT

HAWAII STATE HIGHWAY DEPARTMENT
STATE OF HAWAII

TYPICAL SECTIONS

PROJ. NO. B-G-01-60
PROJ. NO. C-G-01-60

Scale: As Noted June 1960

SHEET NO. 2 OF 2 SHEETS

ORIGINAL PLAN	DESIGNED BY	DATE
NOTE BOOK	TRACED BY	
No.	QUANTITIES CHECKED BY	
	CHECKED BY	