

FED. ROAD DIST. NO.	STATE	FED. AID PROJ. NO.	FISCAL YEAR	SHEET NO.	TOTAL SHEETS
HAWAII	HAW	5	1960	14	176

CURVE DATA

	3-CC	FO-1	KU-1	KU-2	KU-3	KU-5
Δ	12°40'50"	9°57'53"	77°34'	25°08'36"	75°38'57"	27°31'18"
R	120'	300'	50'	66'	38'	56'
T	13.33'	26.18'	40.18'	14.72'	29.50'	13.71'
L	26.56'	52.18'	67.02'	28.96'	50.17'	26.90'
KU-6	MA-1	MA-2	MA-3	MA-4	TL-2	
Δ	26°36'54"	4°24'35"	57°56'02"	55°07'48"	27°31'35"	56°46'41"
R	69.92'	40'	20'	25'	25'	45'
T	16.54'	15.12'	11.07'	12.50'	6.12'	24.32'
L	32.48'	28.91'	20.22'	23.18'	12.01'	44.59'

BEG. PROJ. BU-061-1(7)
UNIT 5
STA. 34 + 96.47

END PROJ. BU-061-1(6), UNIT 4


TAPERS

6:120	19:180	14:210			
OFFSET	DIST.	OFFSET	DIST.	OFFSET	DIST.
0	0	0	0	0	0
.09	10	.29	15	.22	17.5
.37	20	1.18	30	.88	35.0
.84	30	2.78	45	1.95	52.5
1.50	40	4.75	60	3.50	70.0
3.00	60	9.50	90	7.00	105.0
4.50	80	14.25	120	10.50	140.0
5.16	90	16.22	135	12.05	157.5
5.63	100	17.62	150	13.12	175.0
5.91	110	18.71	165	13.78	192.5
6.00	120	19.00	180	14.00	210.0

RATIO CURVE DATA

3:45	8:80
DIST.	OFFSET
0	0
10	.15
20	.59
30	1.33
40	2.37
50	3.12
60	4.48
70	6.12
80	8.00

SURVEY PLOTTED BY: _____
DESIGNED BY: _____
DRAWN BY: _____
CHECKED BY: _____
ORIGINAL PLAN NO. _____
NOTE BOOK NO. _____

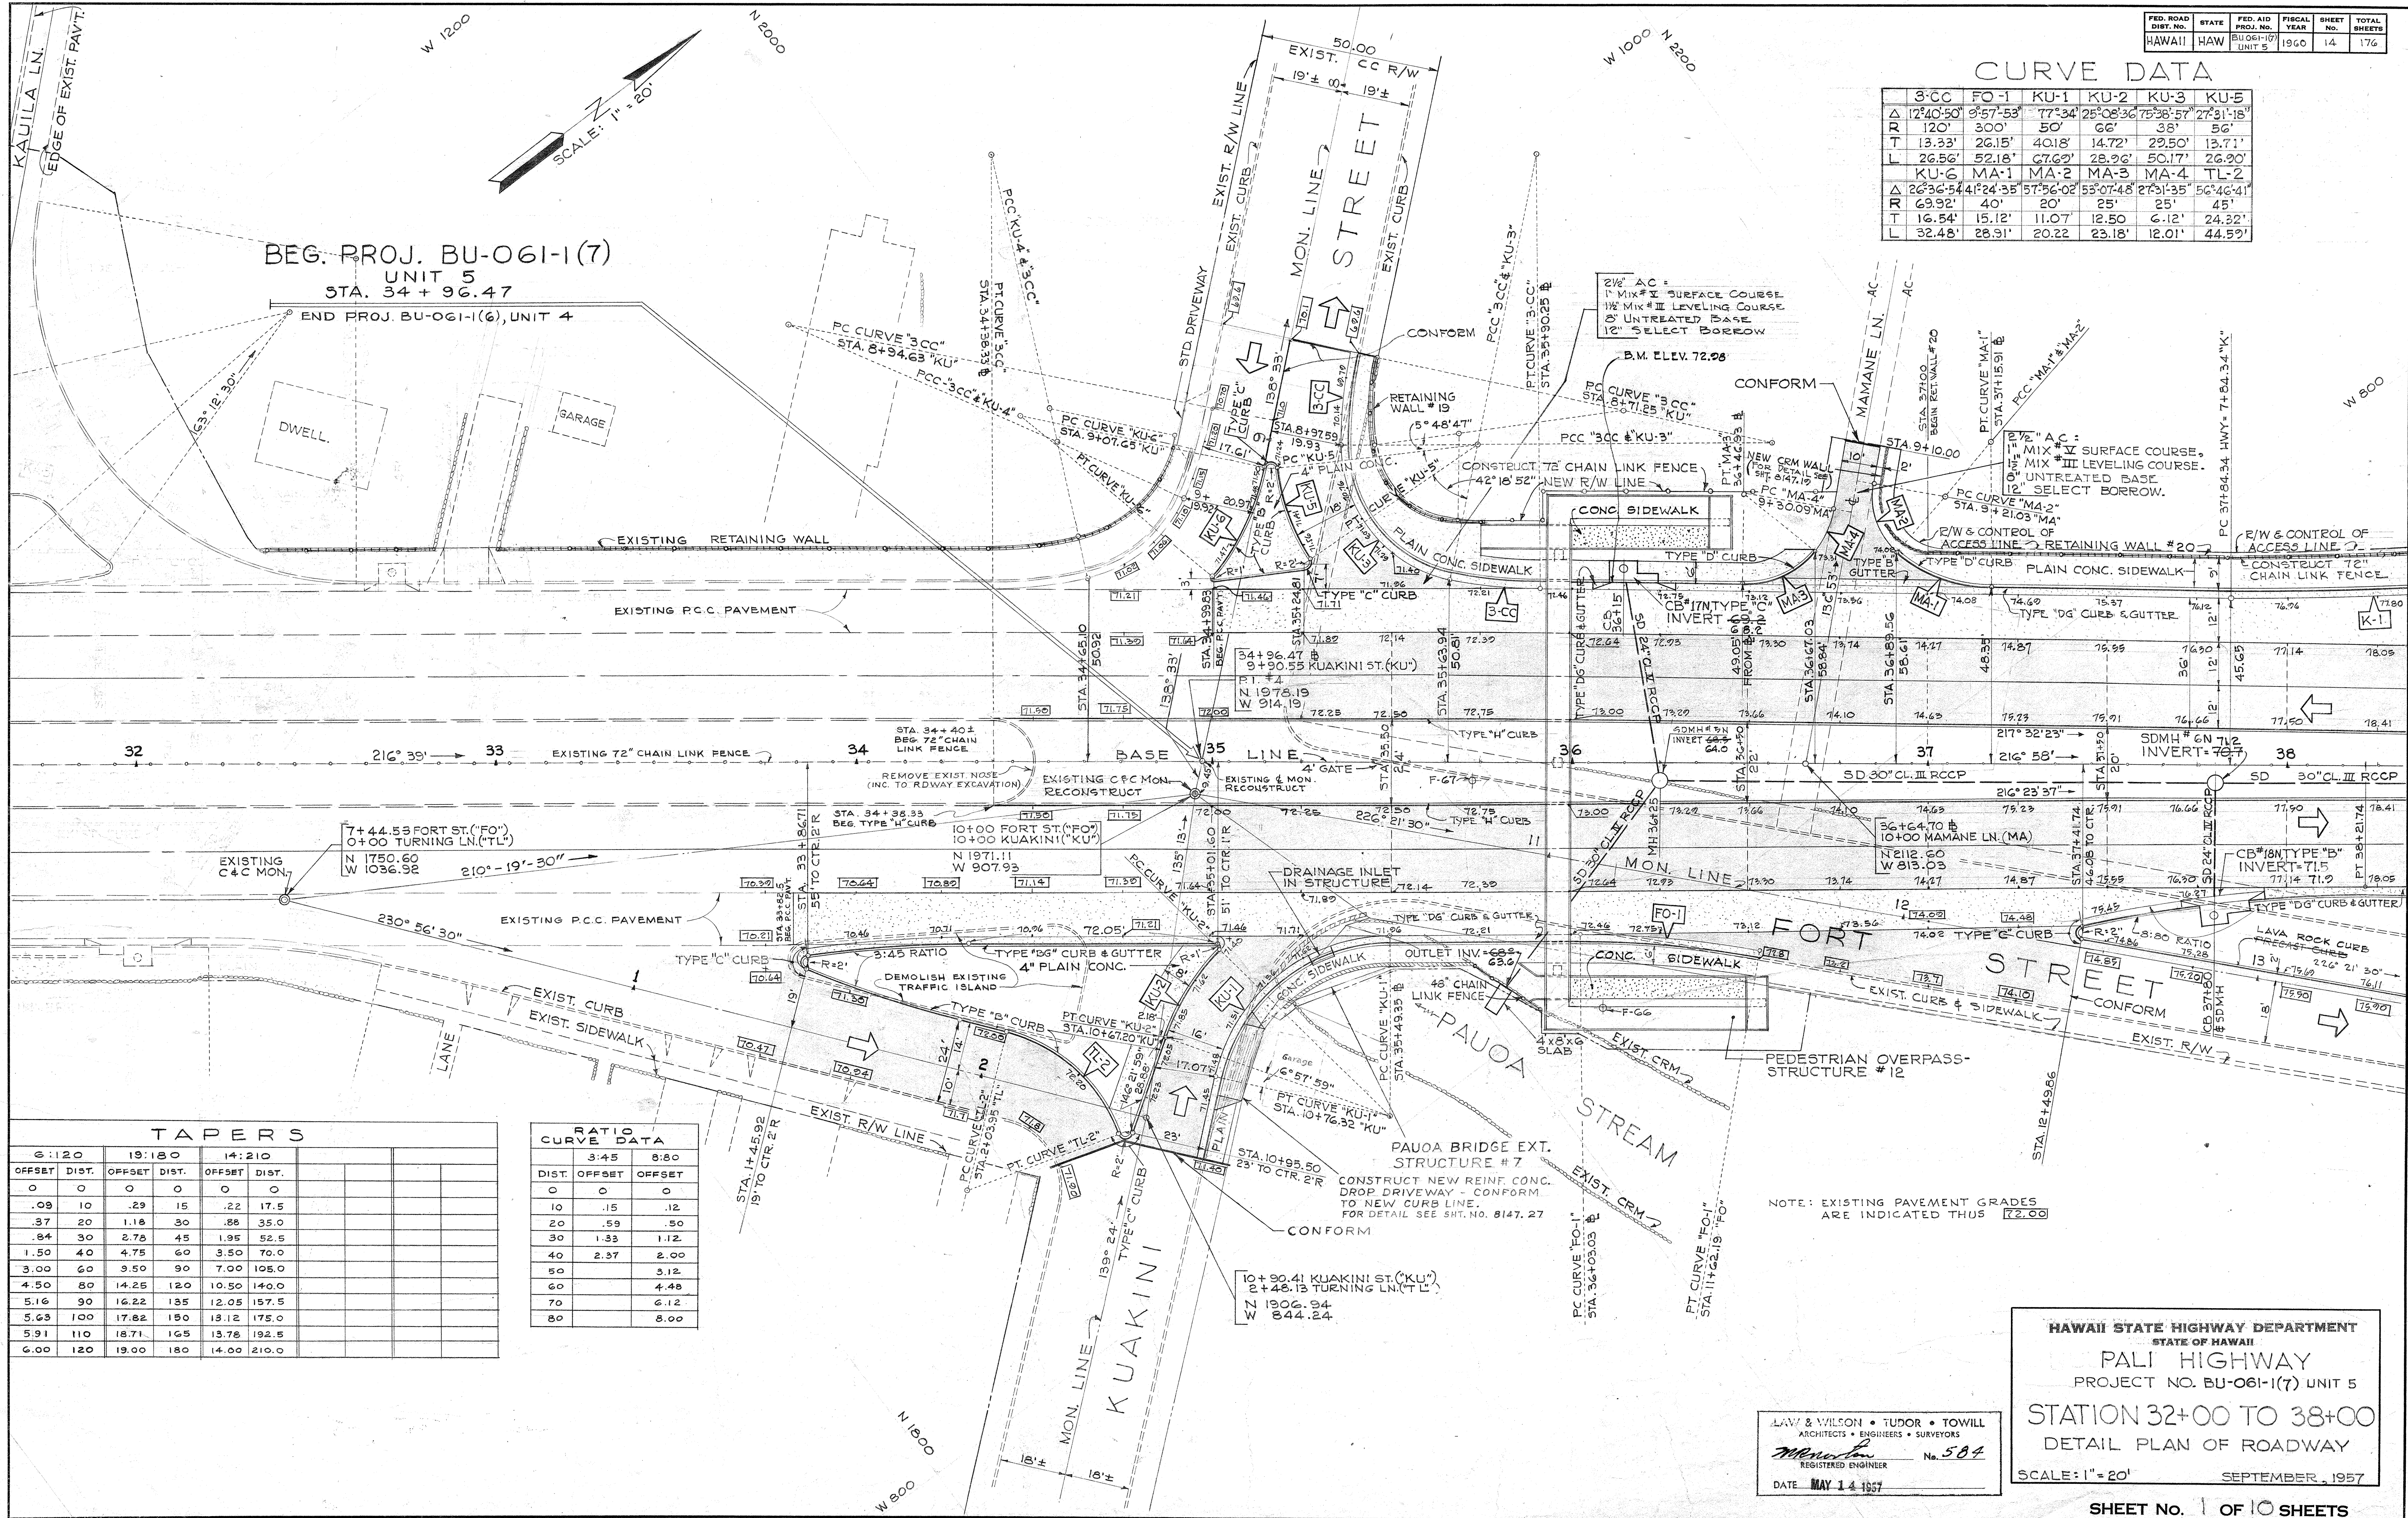

NOTE: EXISTING PAVEMENT GRADES ARE INDICATED THUS $\overline{72.00}$


LAW & WILSON • TUDOR • TOWILL
ARCHITECTS • ENGINEERS • SURVEYORS
REGISTERED ENGINEER No. 584
DATE MAY 14 1957

HAWAII STATE HIGHWAY DEPARTMENT
STATE OF HAWAII
PALI HIGHWAY
PROJECT NO. BU-061-1(7) UNIT 5
STATION 32+00 TO 38+00
DETAIL PLAN OF ROADWAY
SCALE: 1" = 20'
SEPTEMBER, 1957

SHEET NO. 1 OF 10 SHEETS


B. S147.14

FED. ROAD DIST. NO.	STATE	FED. AID PROJ. NO.	FISCAL YEAR	SHEET NO.	TOTAL SHEETS
HAWAII	HAW.				

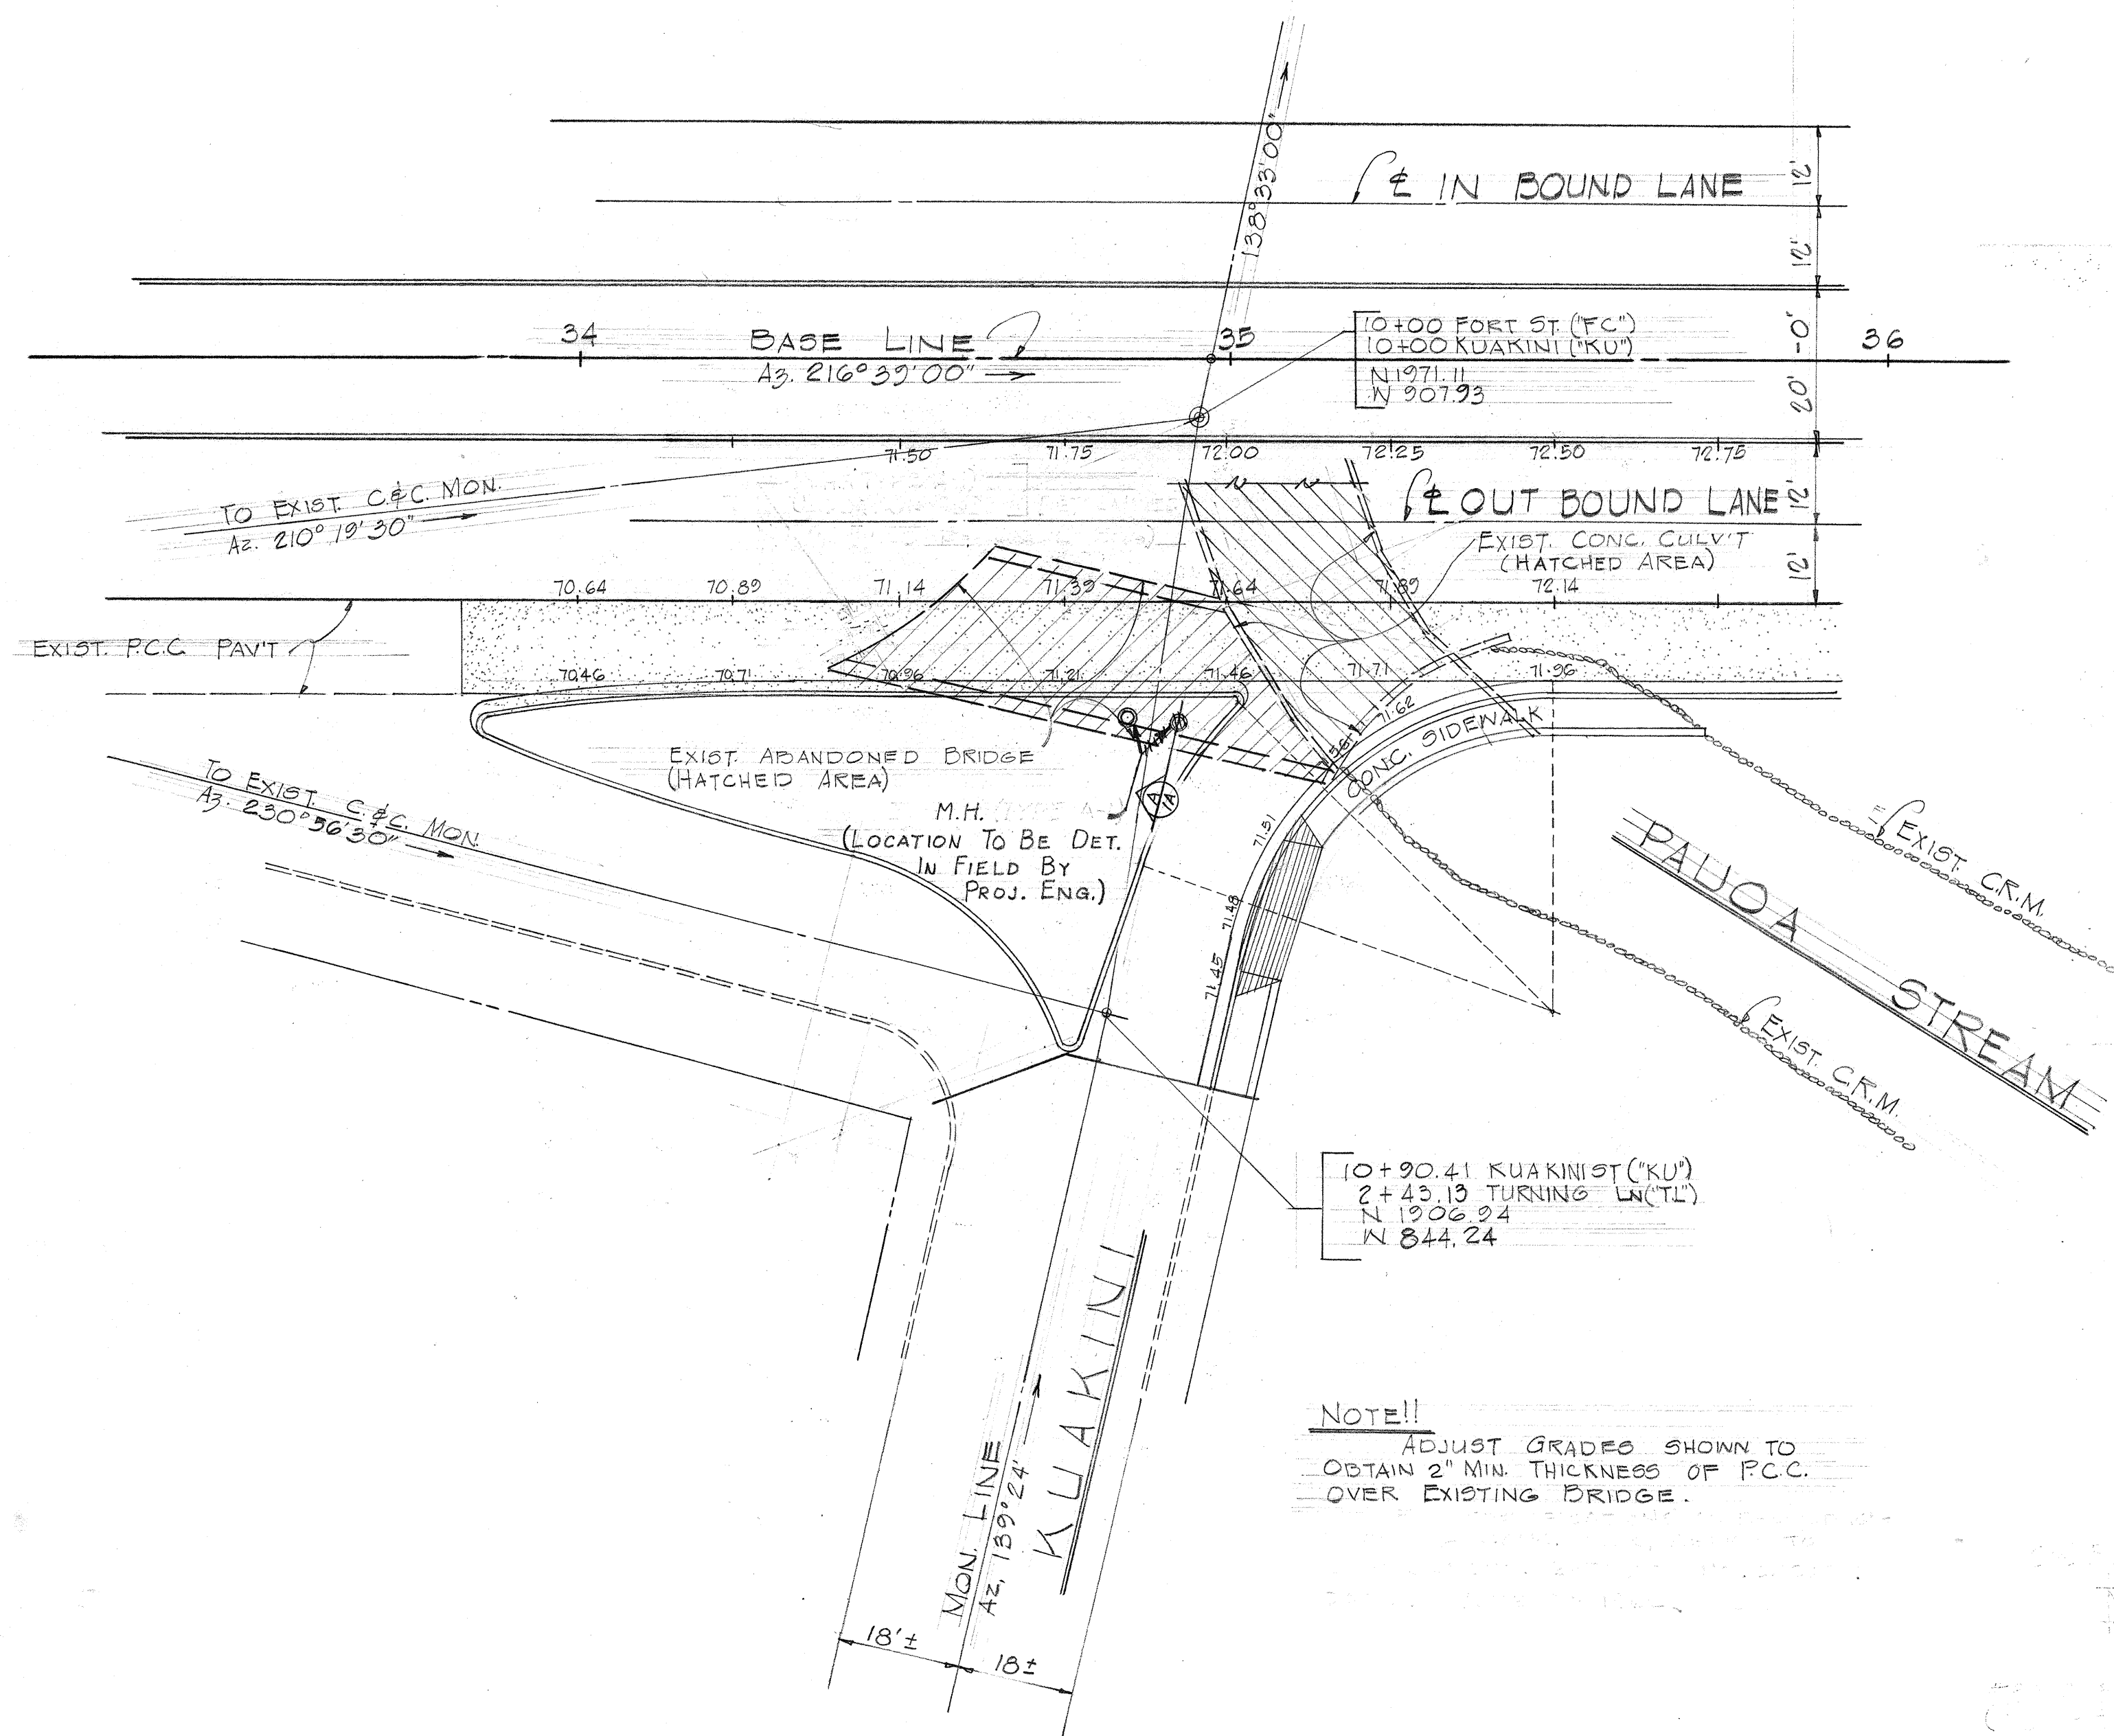

LOCATION PLAN

Scale: 1" = 20'-0"

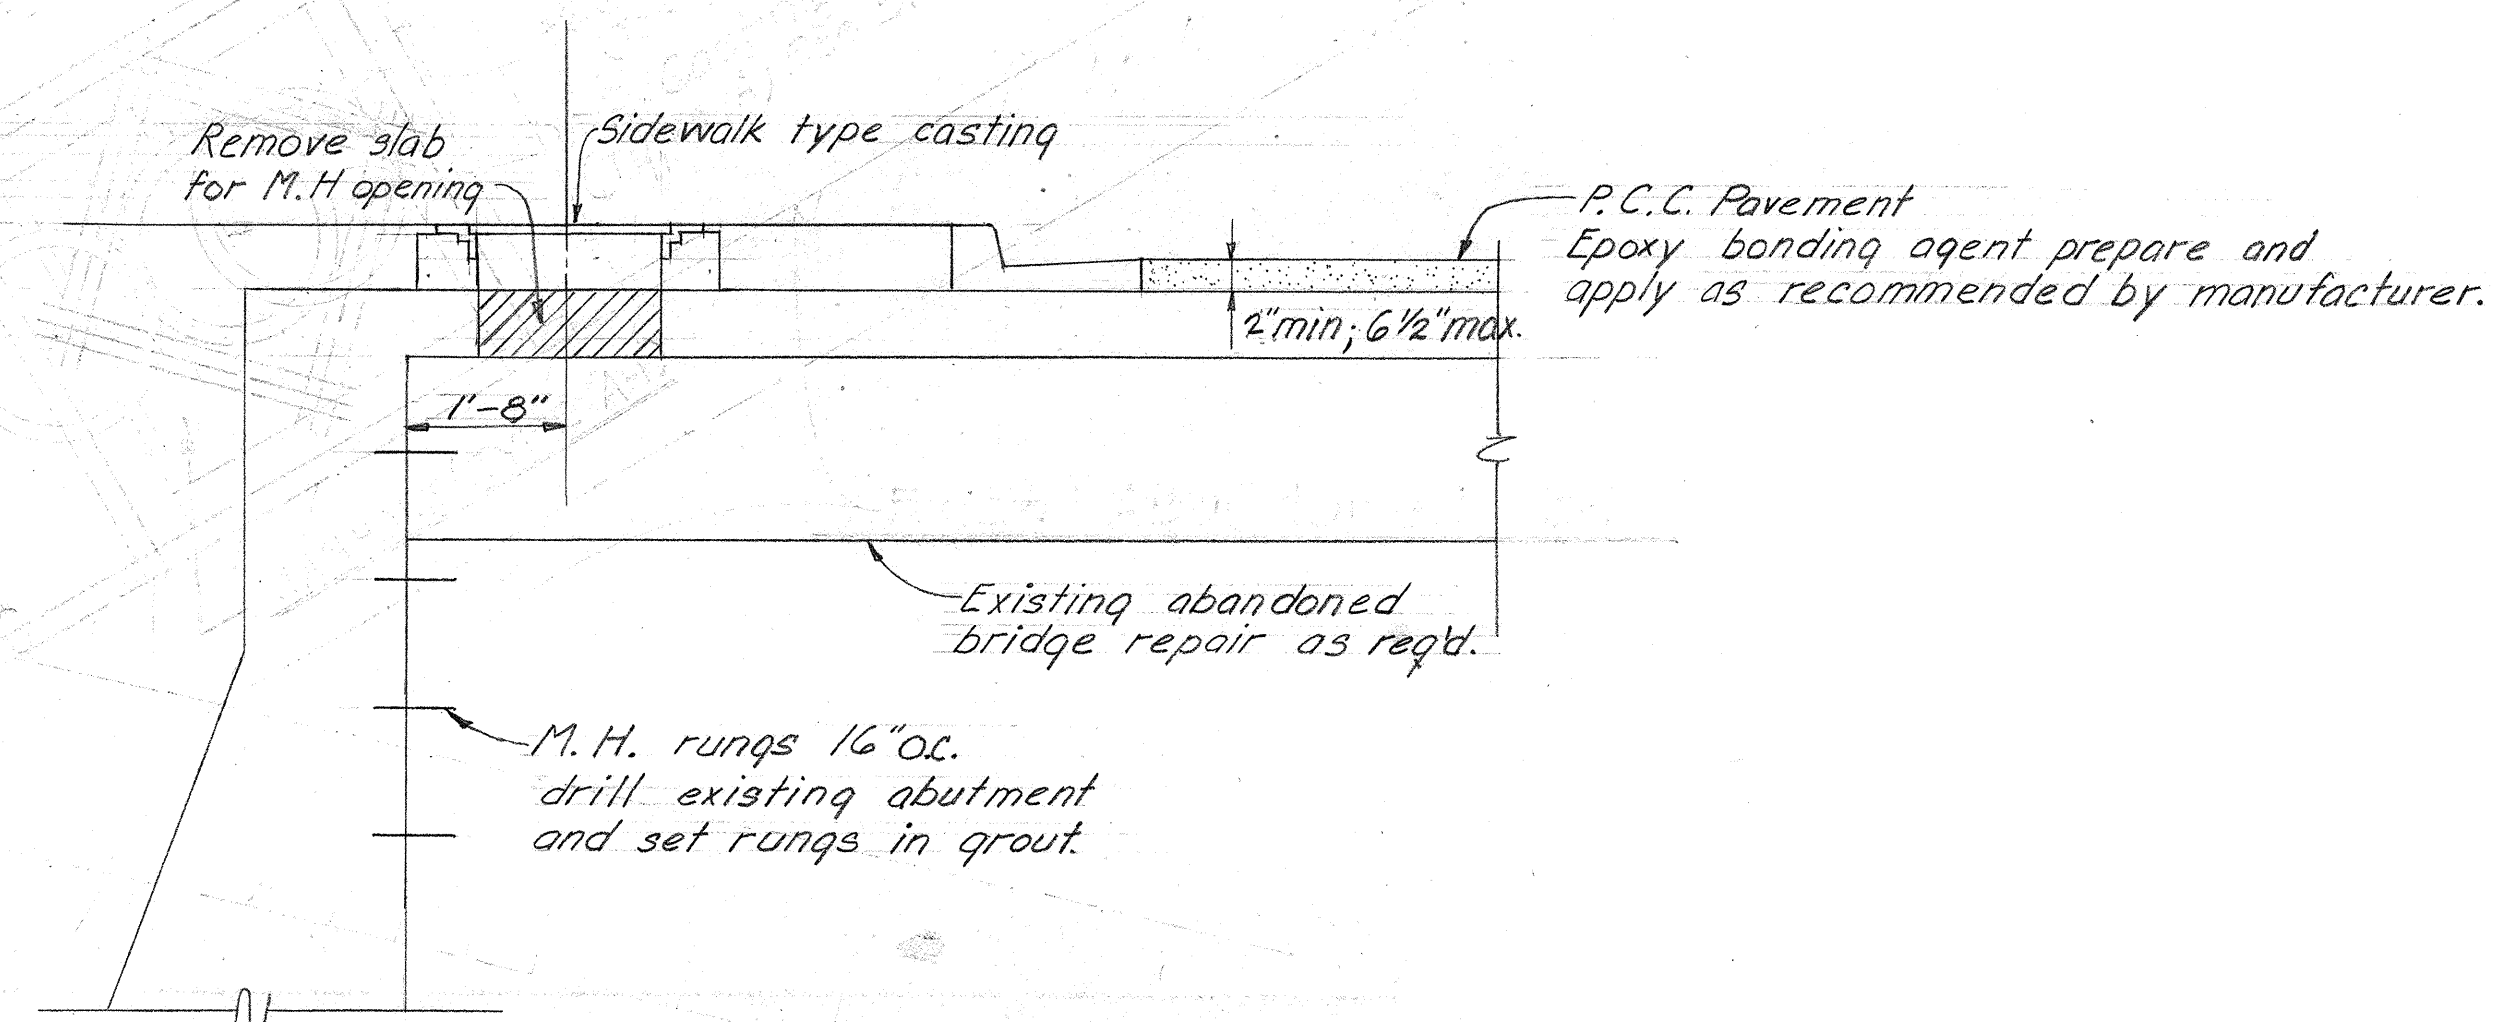

SECTION A-A

Scale: 1/2" = 1'-0"

ORIGINAL PLAN	DATE
SURVEY PLOTTED BY	
DRAWN BY	
TRACED BY	
NOTED BY	
CHECKED BY	
NO.	


STATE OF HAWAII
DEPARTMENT OF TRANSPORTATION
HIGHWAYS DIVISION

PALI HIGHWAY
PROJ. NO. BU-061(1) UNIT 2
MANHOLE DETAILS

SHEET No. 1A OF 10 SHEETS


B. 8147.14 A

W1000

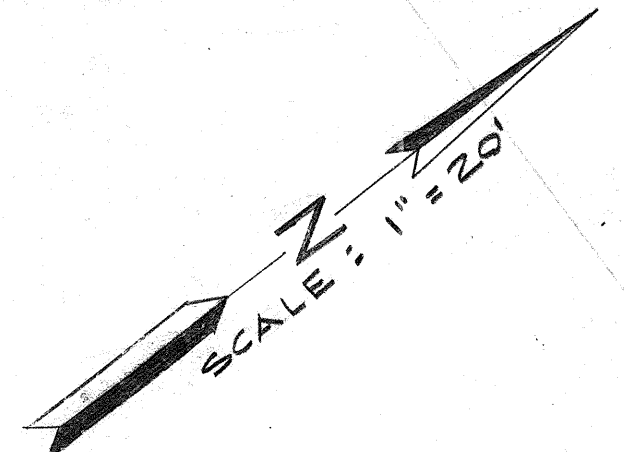


CURVE DATA

	J-2	J-3	K-1	K-2
Δ	127°24'34"	55°28'25"	37°50'23"	30°24'36"
R	30.00	30.00	500.00	481.26
T	60.71	15.77	171.38	131.55
L	66.71	29.05	330.21	256.83

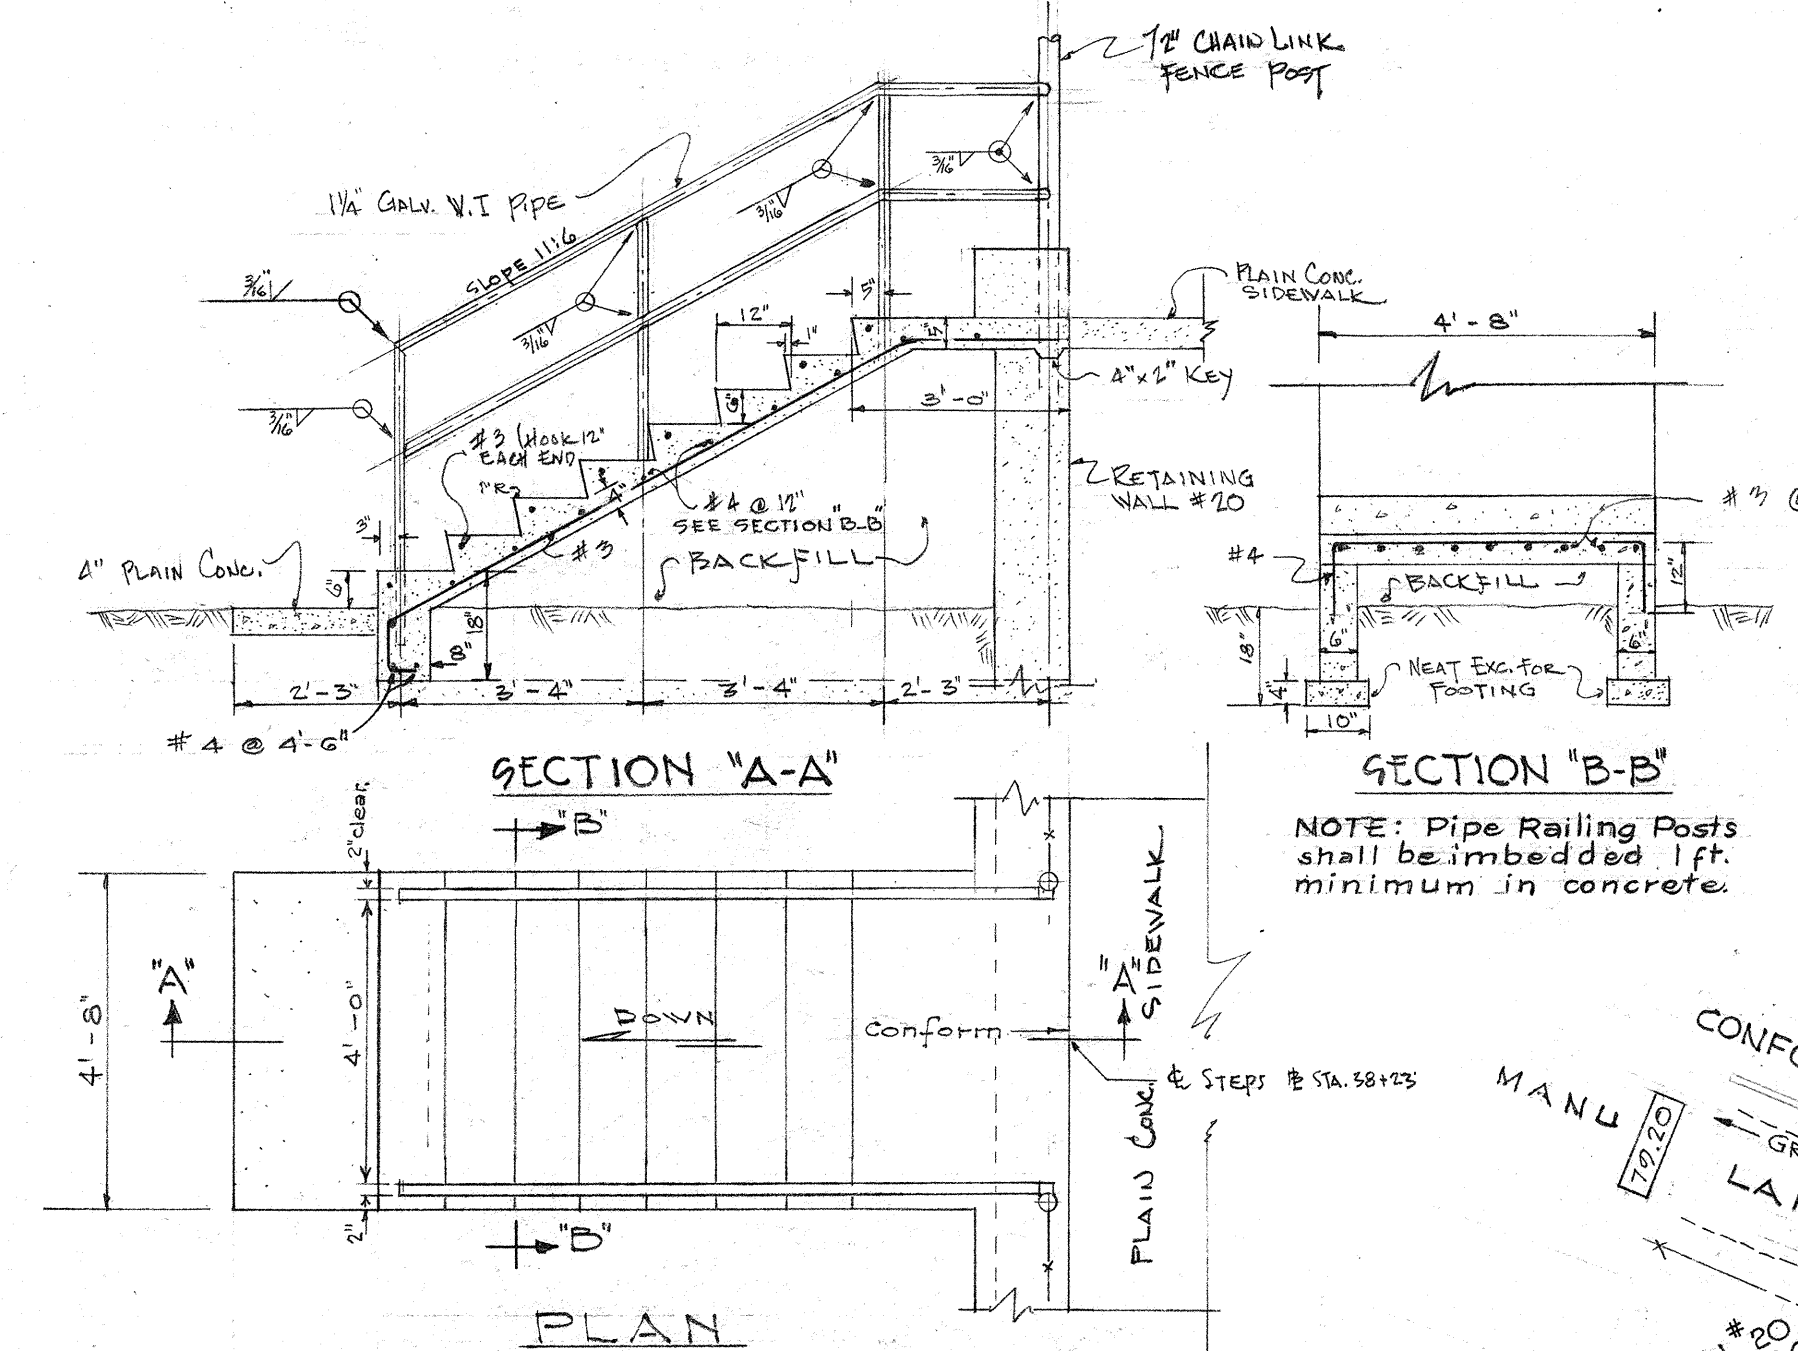

DETAIL OF STAIRWAY AT STA. 38+23 (L.T.)
Scale: 3/8" = 1'-0"

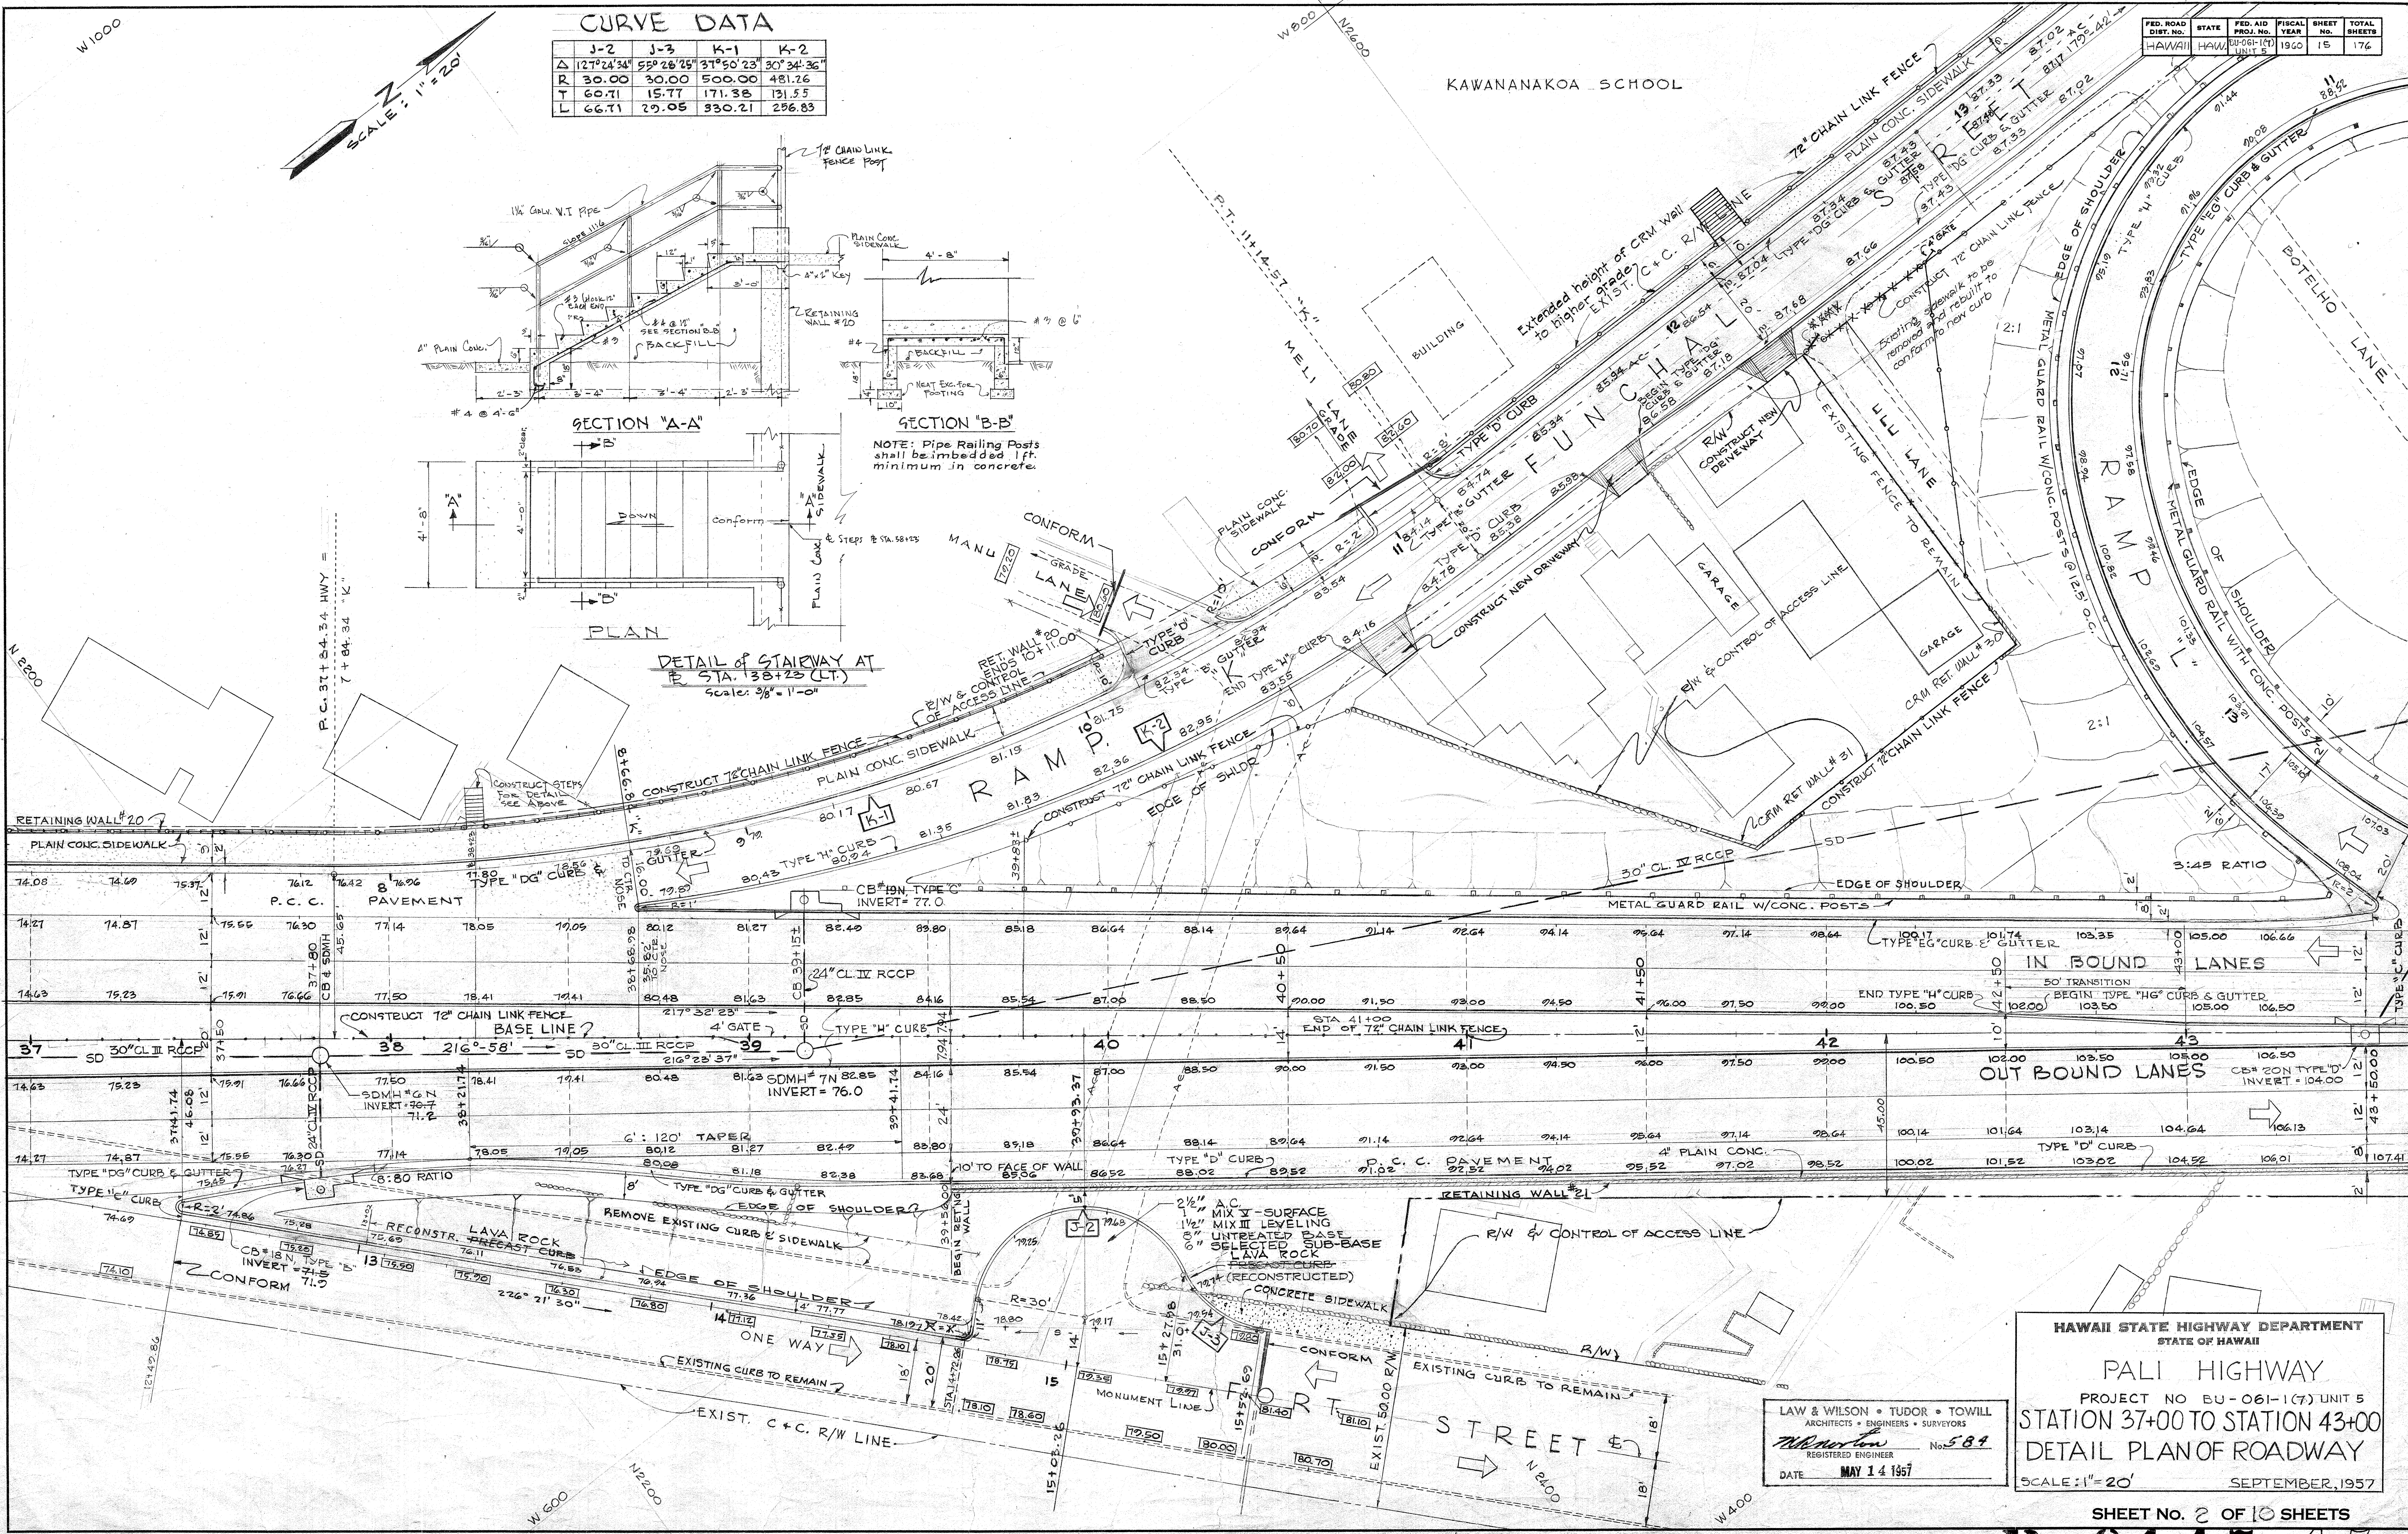

DATE _____
SURVEY PLOTTED BY _____
ORIGINAL PLAN _____
DRAWN BY _____
TRACED BY _____
NOTE BOOK _____
QUANTITIES CHECKED BY _____
CHECKED BY _____
No. _____


LAW & WILSON • TUDOR • TOWILL
ARCHITECTS • ENGINEERS • SURVEYORS
William Wilson
REGISTERED ENGINEER No. 584
DATE MAY 14 1957

HAWAII STATE HIGHWAY DEPARTMENT
STATE OF HAWAII
PALI HIGHWAY
PROJECT NO. BU-061-1(7) UNIT 5
STATION 37+00 TO STATION 43+00
DETAIL PLAN OF ROADWAY
SCALE: 1" = 20'
SEPTEMBER, 1957

B. S147.15

CURVE DATA					
	50	3-CC	K-3	L-1	L-2
Δ	15° 22' 00"	12° 40' 50"	83° 43' 35"	84° 36' 37"	148° 09' 23"
R	1500.00	120.00	30.00	140.00	90.00
T	202.36	13.33	26.88	127.41	315.49
L	402.30	26.56	43.84	206.74	232.72
L-5	M-1	M-2	PA-1	PA-2	
Δ	8° 15' 54"	6° 29' 00"	3° 31' 31"	80° 16' 20"	76° 44' 48"
R	307.03	1442.00	1442.00	38.00	15.00
T	22.18	81.67	44.38	32.04	11.88
L	44.29	163.17	88.72	53.24	20.09

FED. ROAD DIST. NO.	STATE	FED. AID PROJ. NO.	FISCAL YEAR	SHEET NO.	TOTAL SHEETS
HAWAII	HAW.	BUC61-1(7)	1960	16	176

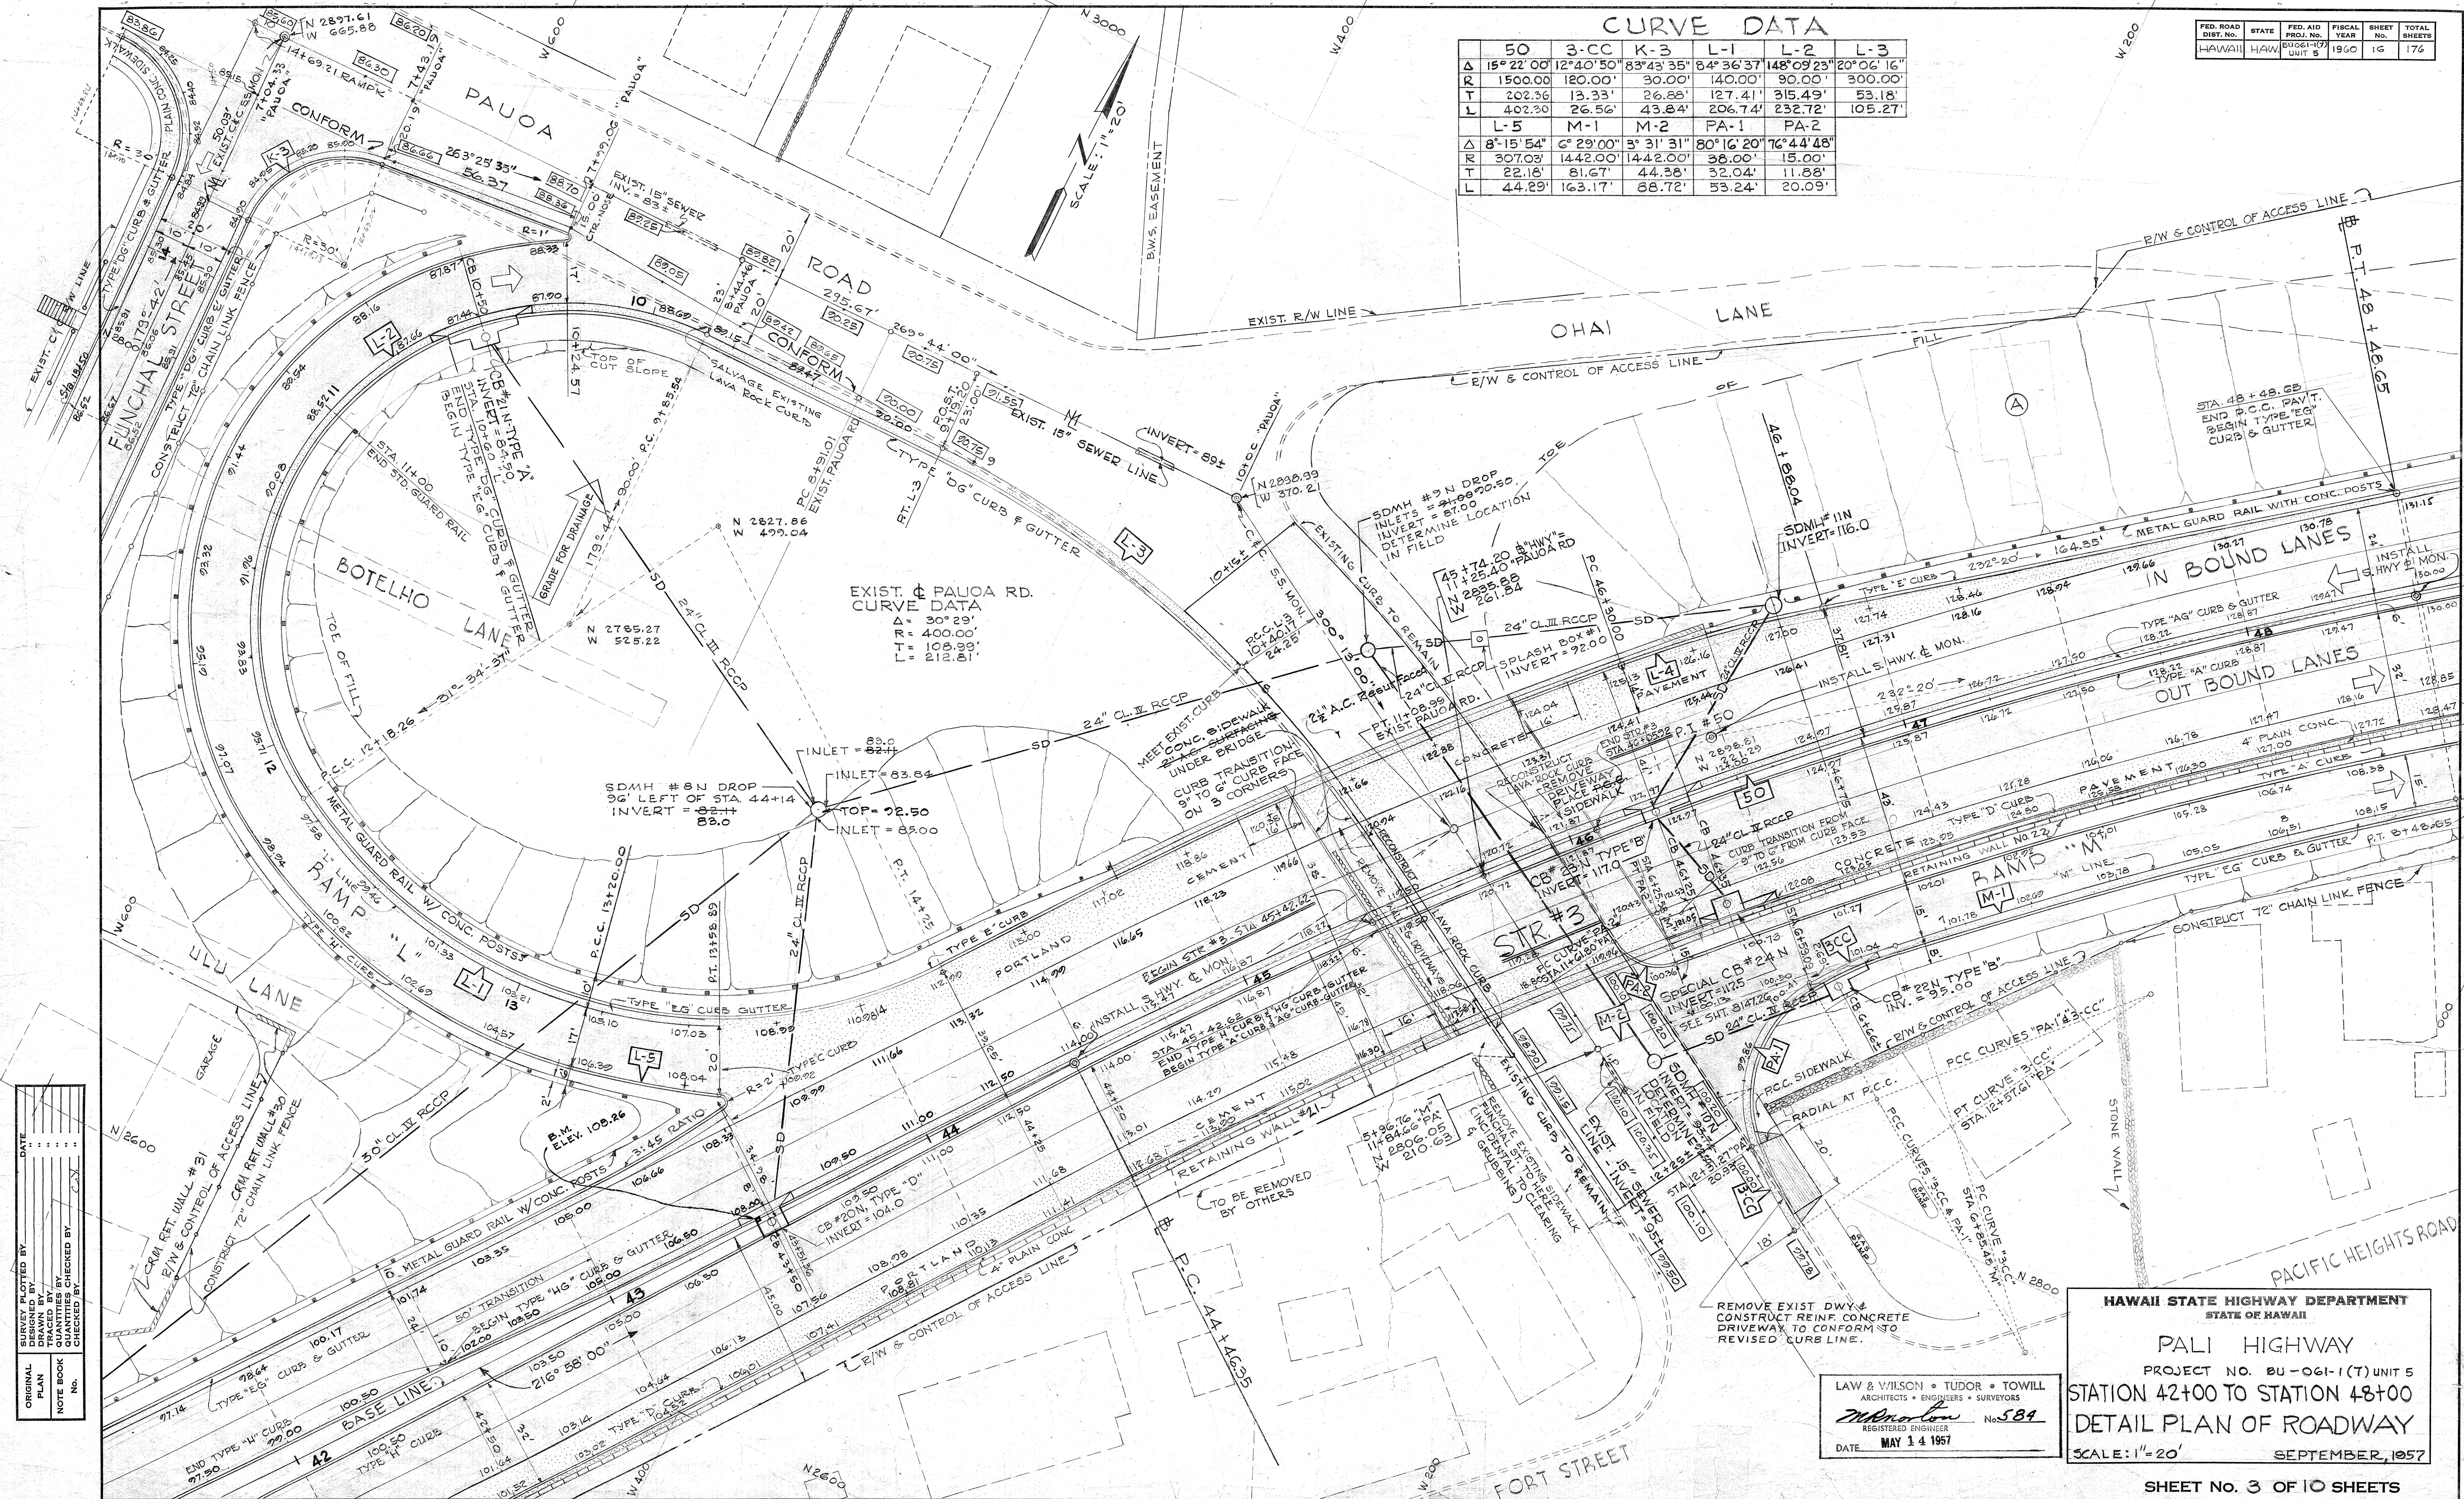

DESIGNED BY	DATE
TRACED BY	
QUANTITIES BY	
NOTE BOOK	
CHECKED BY	
NO.	


LAW & WILSON • TUDOR • TOWILL
ARCHITECTS • ENGINEERS • SURVEYORS
M. Wilson
REGISTERED ENGINEER No. 584
DATE MAY 14 1957

HAWAII STATE HIGHWAY DEPARTMENT
STATE OF HAWAII
PALI HIGHWAY
PROJECT NO. BU-061-1(7) UNIT 5
STATION 42+00 TO STATION 48+00
DETAIL PLAN OF ROADWAY
SCALE: 1" = 20' SEPTEMBER, 1957

SHEET NO. 3 OF 10 SHEETS

B. S147.16

FED. ROAD DIST. NO.	STATE	FED. AID PROJ. NO.	FISCAL YEAR	SHEET NO.	TOTAL SHEETS
HAWAII	HAWAII	BU-061-1(7)	1960	17	176

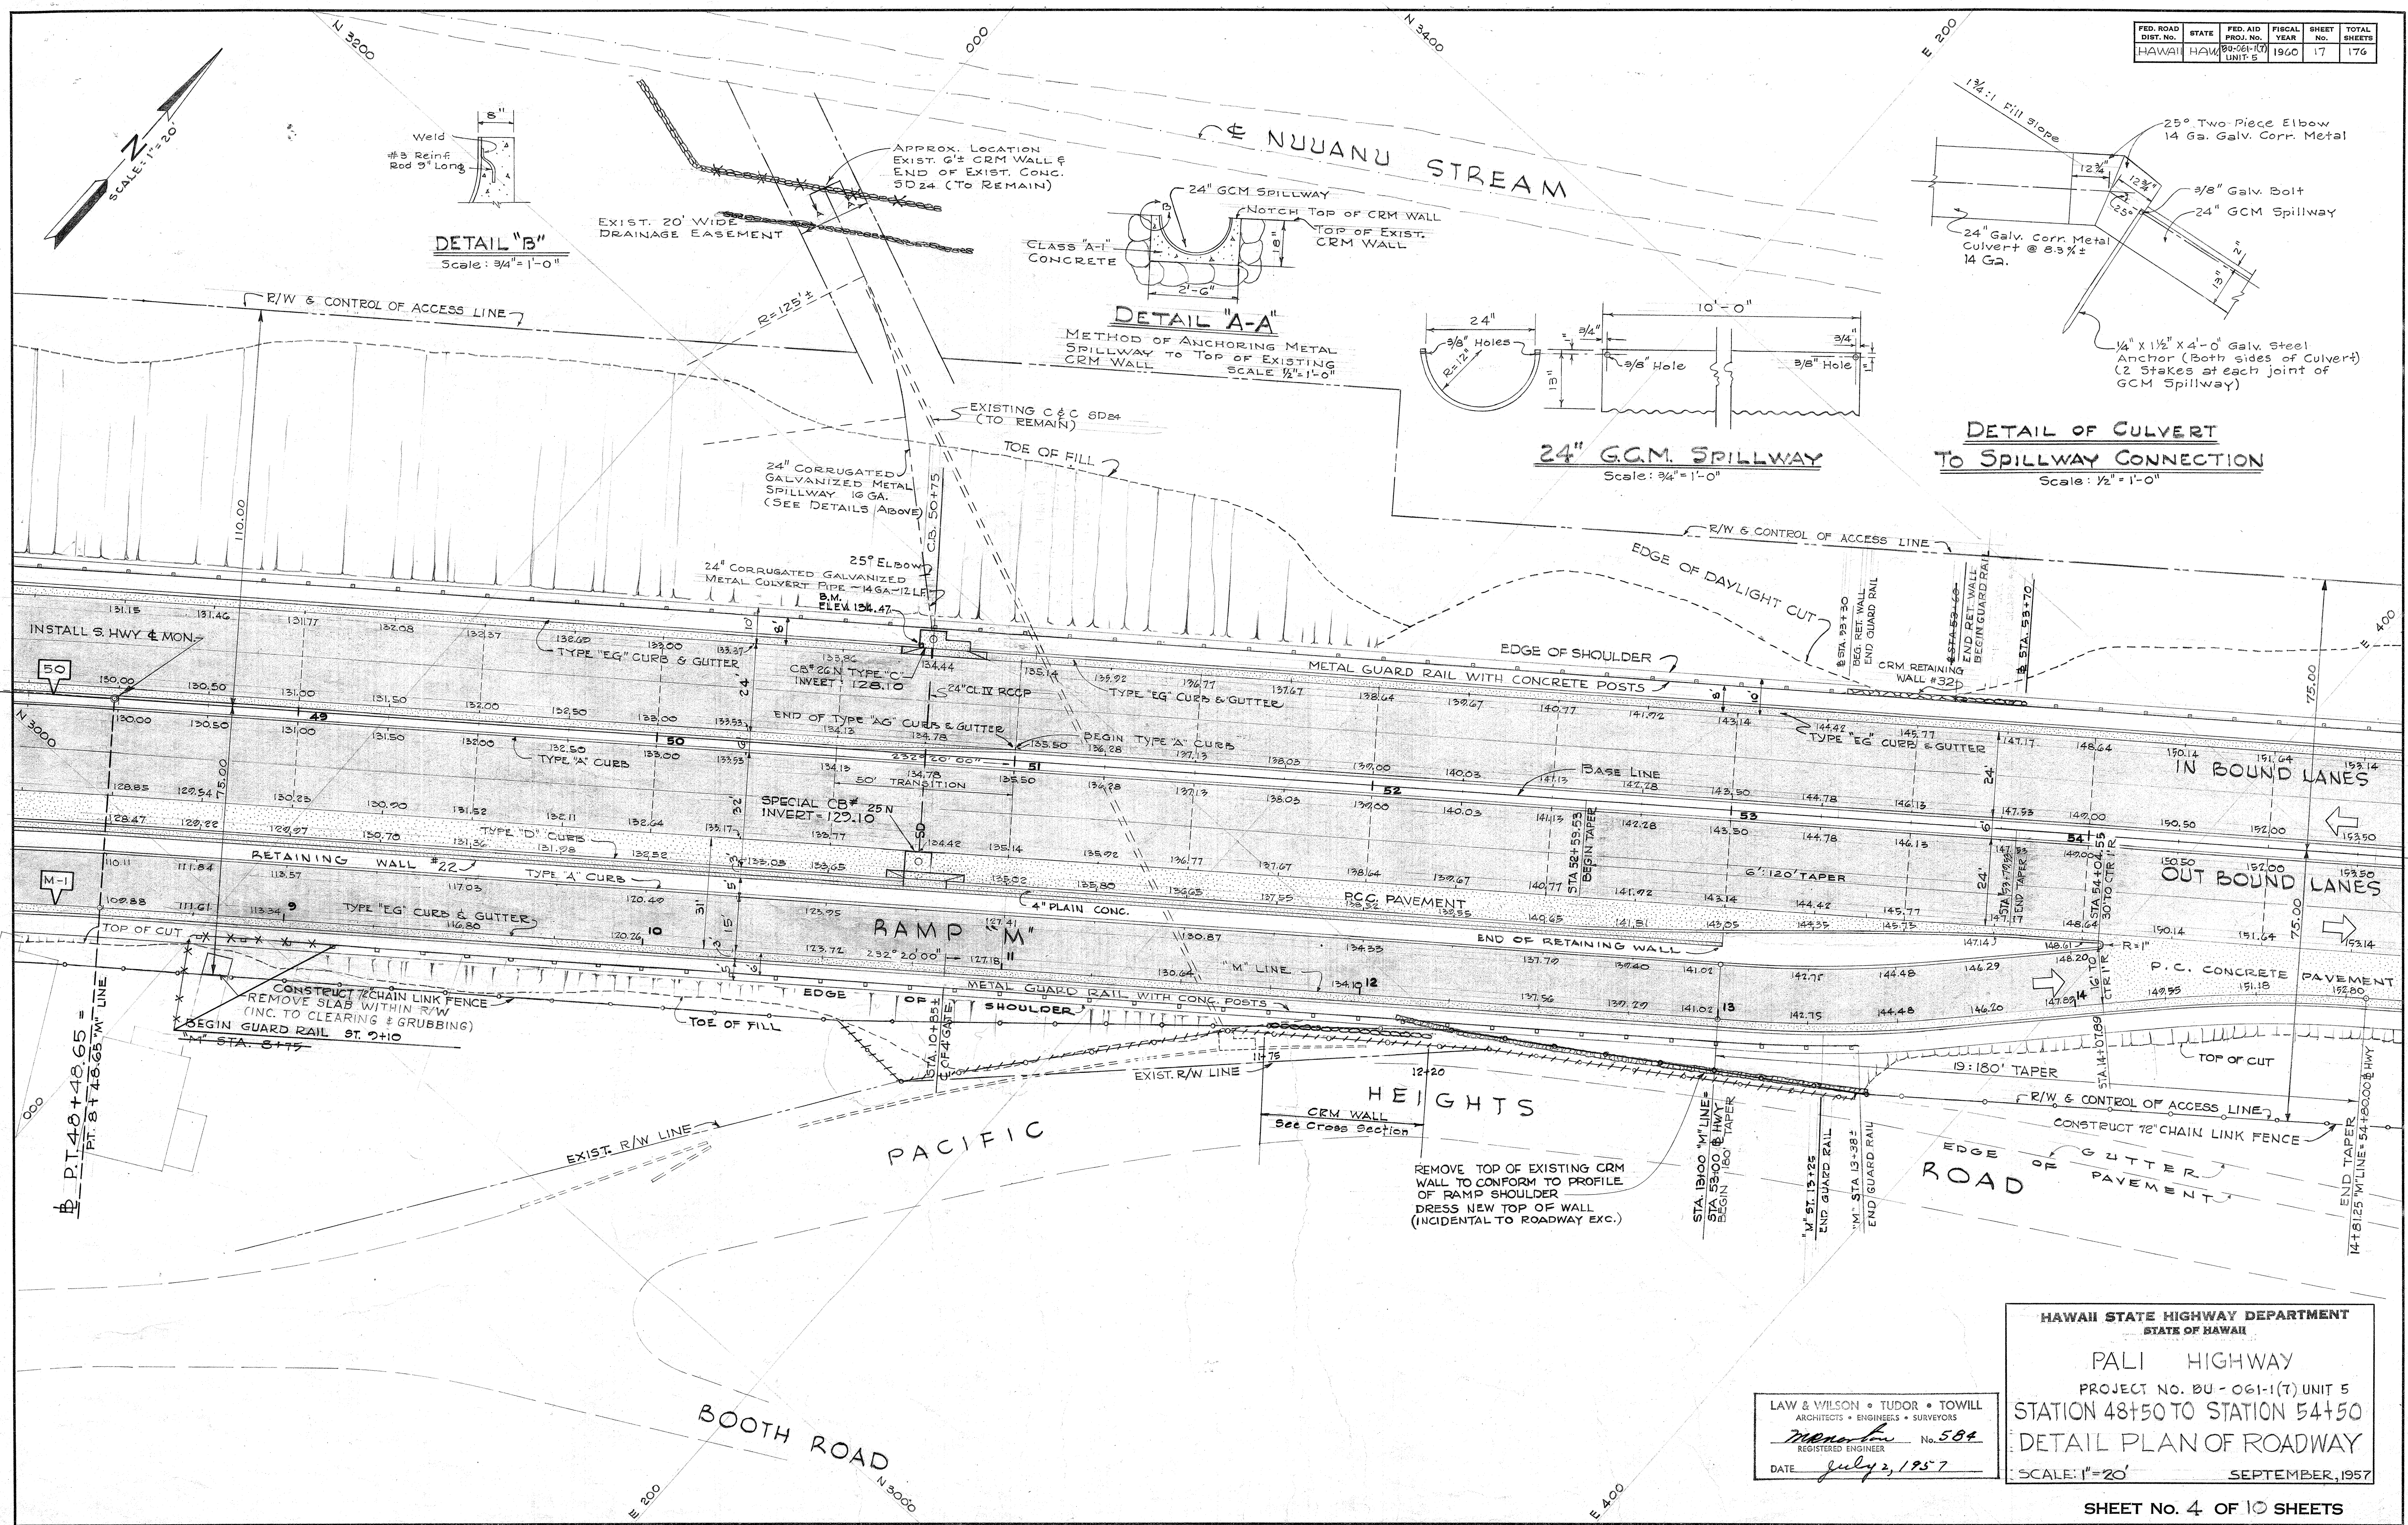

DETAIL "B"
Scale: 3/4" = 1'-0"

DETAIL "A-A"
METHOD OF ANCHORING METAL SPILLWAY TO TOP OF EXISTING CRM WALL
Scale: 1/2" = 1'-0"

24" GCM SPILLWAY
Scale: 3/4" = 1'-0"

DETAIL OF CULVERT TO SPILLWAY CONNECTION
Scale: 1/2" = 1'-0"

HEIGHTS
CRM WALL
See Cross Section






ORIGINAL PLAN	DESIGNED BY	DATE
NOTE BOOK	QUANTITIES BY	
NO.	CHECKED BY	

LAW & WILSON • TUDOR • TOWILL
ARCHITECTS • ENGINEERS • SURVEYORS
W. W. Wilson No. 584
REGISTERED ENGINEER
DATE July 2, 1957

HAWAII STATE HIGHWAY DEPARTMENT
STATE OF HAWAII
PALI HIGHWAY
PROJECT NO. BU-061-1(7) UNIT 5
STATION 48+50 TO STATION 54+50
DETAIL PLAN OF ROADWAY
SCALE: 1" = 20'
SEPTEMBER, 1957

FED. ROAD DIST. NO.	STATE	FED. AID PROJ. NO.	FISCAL YEAR	SHEET NO.	TOTAL SHEETS
HAWAII	HAW.	BU-061-10	UNIT 5	18	176

CURVE DATA					
	54	55	PK-1	55A	
Δ	24°18'	12°09'	24°16'07"	90°00'	
R	1,000.00	503.25	216.88	6.00	
T	215.29	53.56	46.63	6.00	
L	424.11	106.71	91.86	9.42	

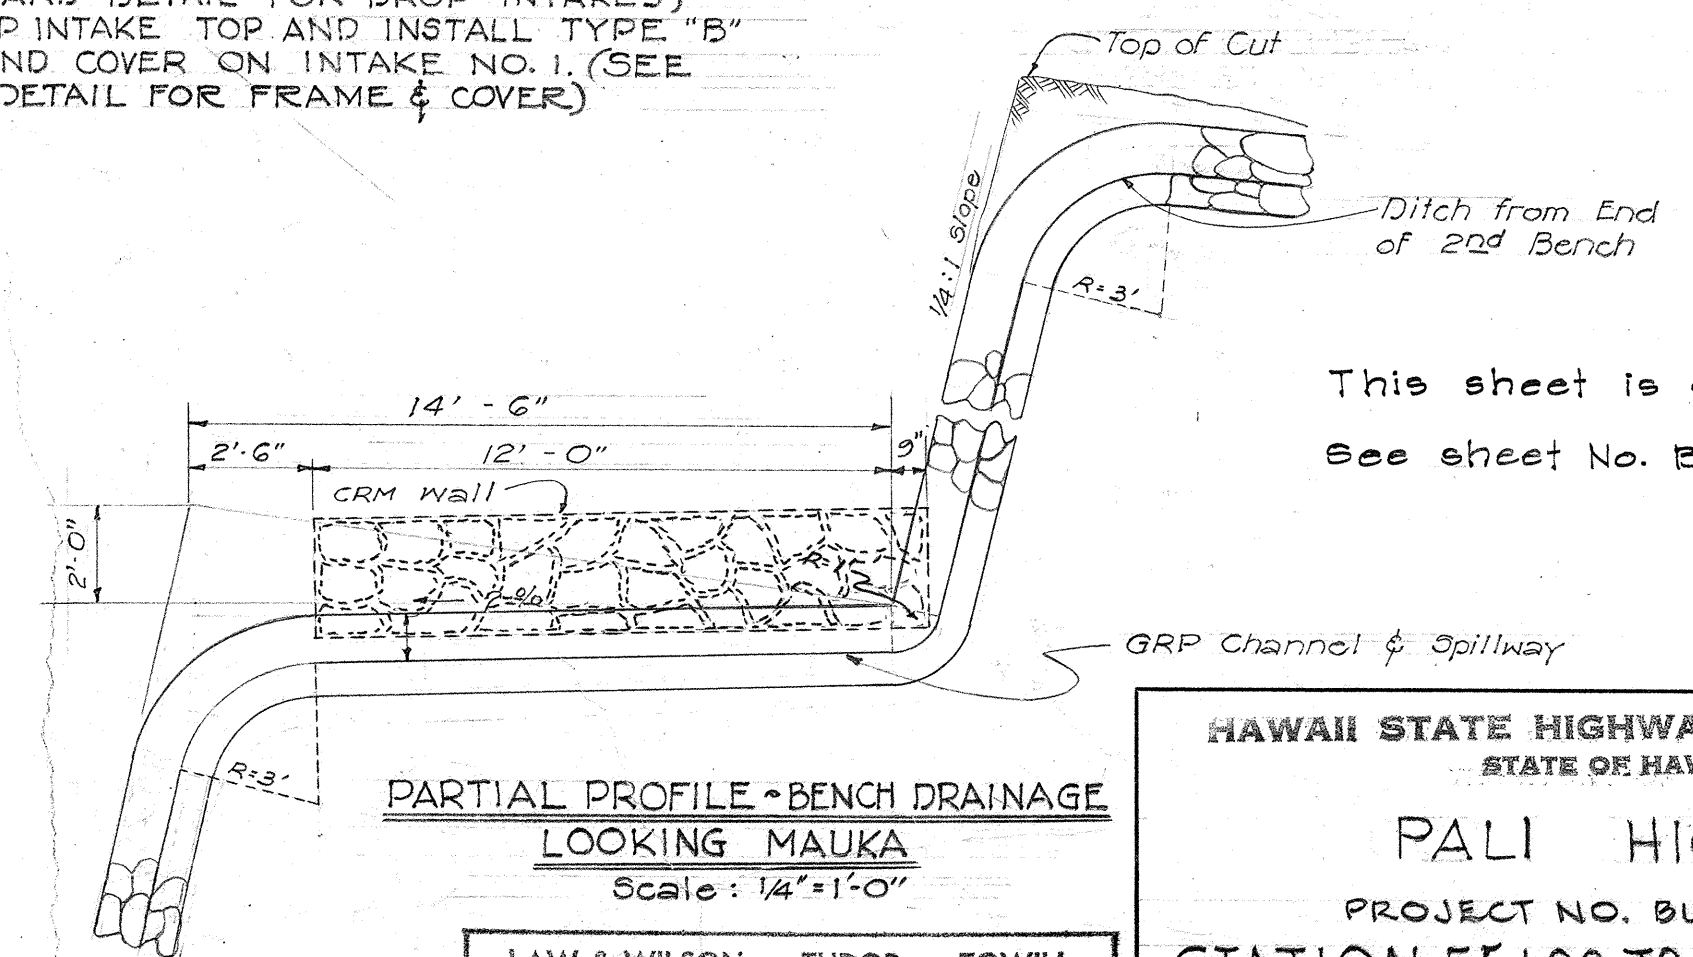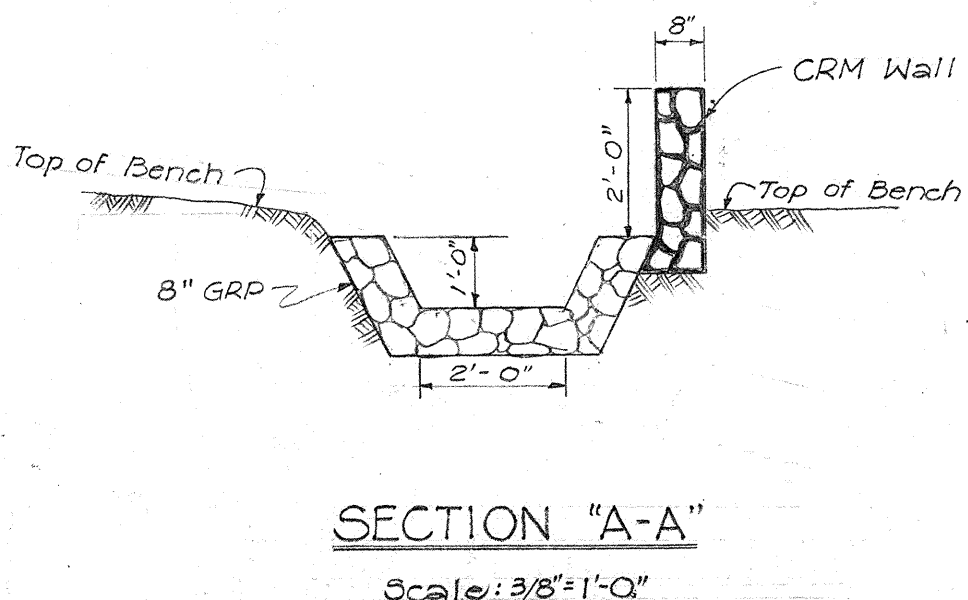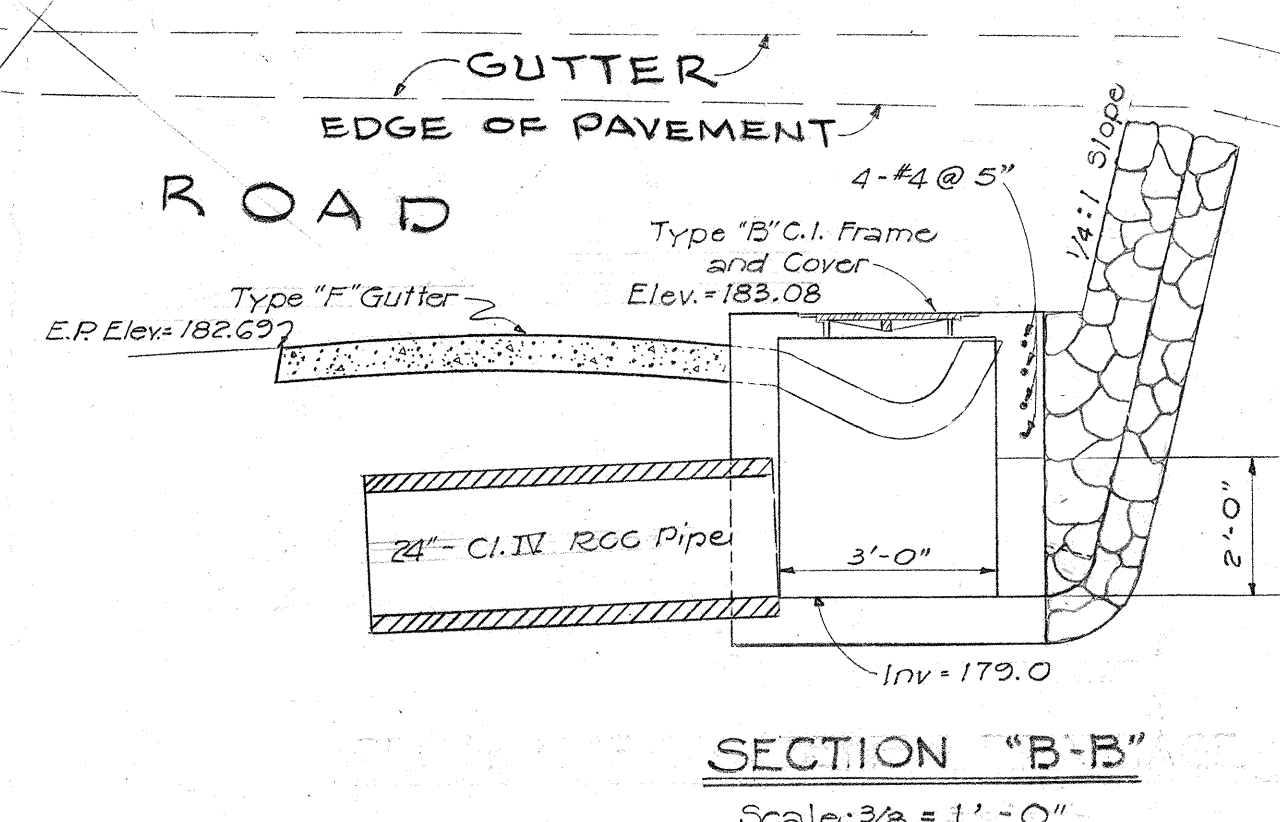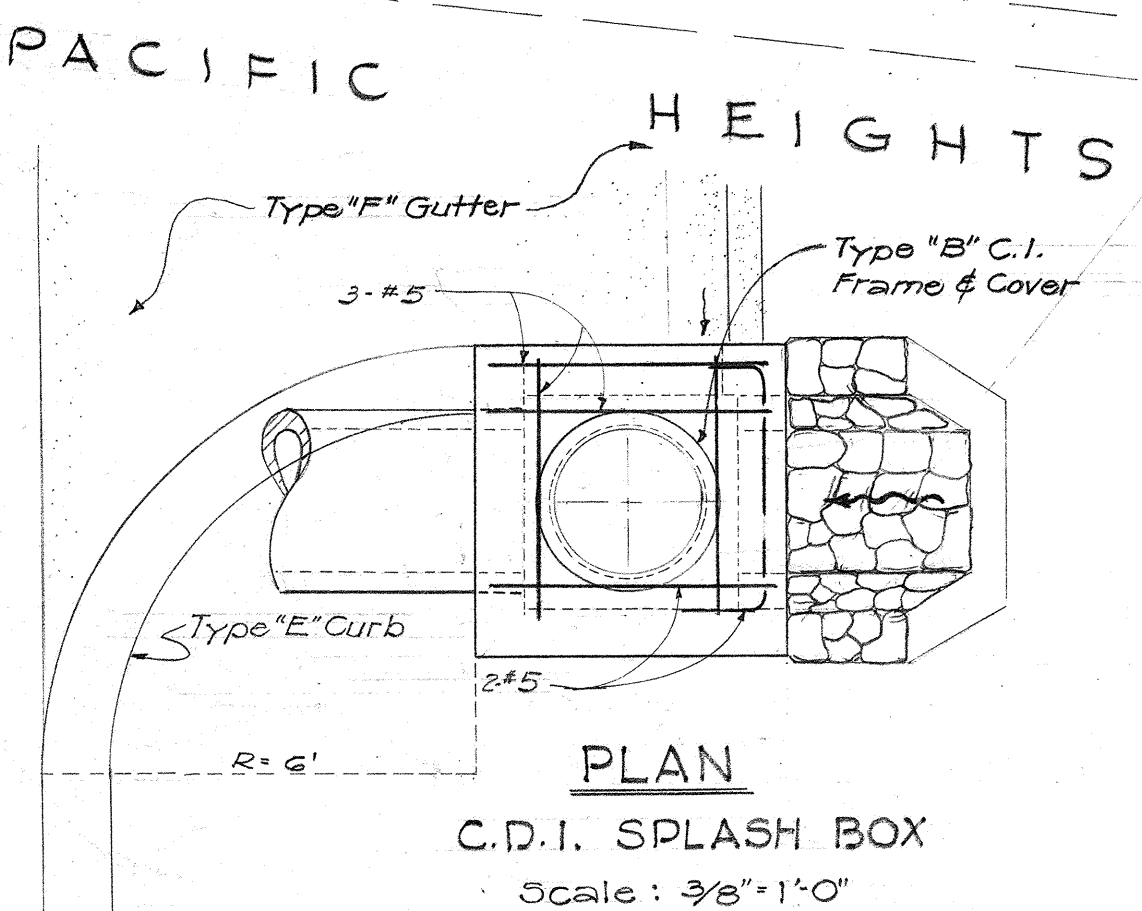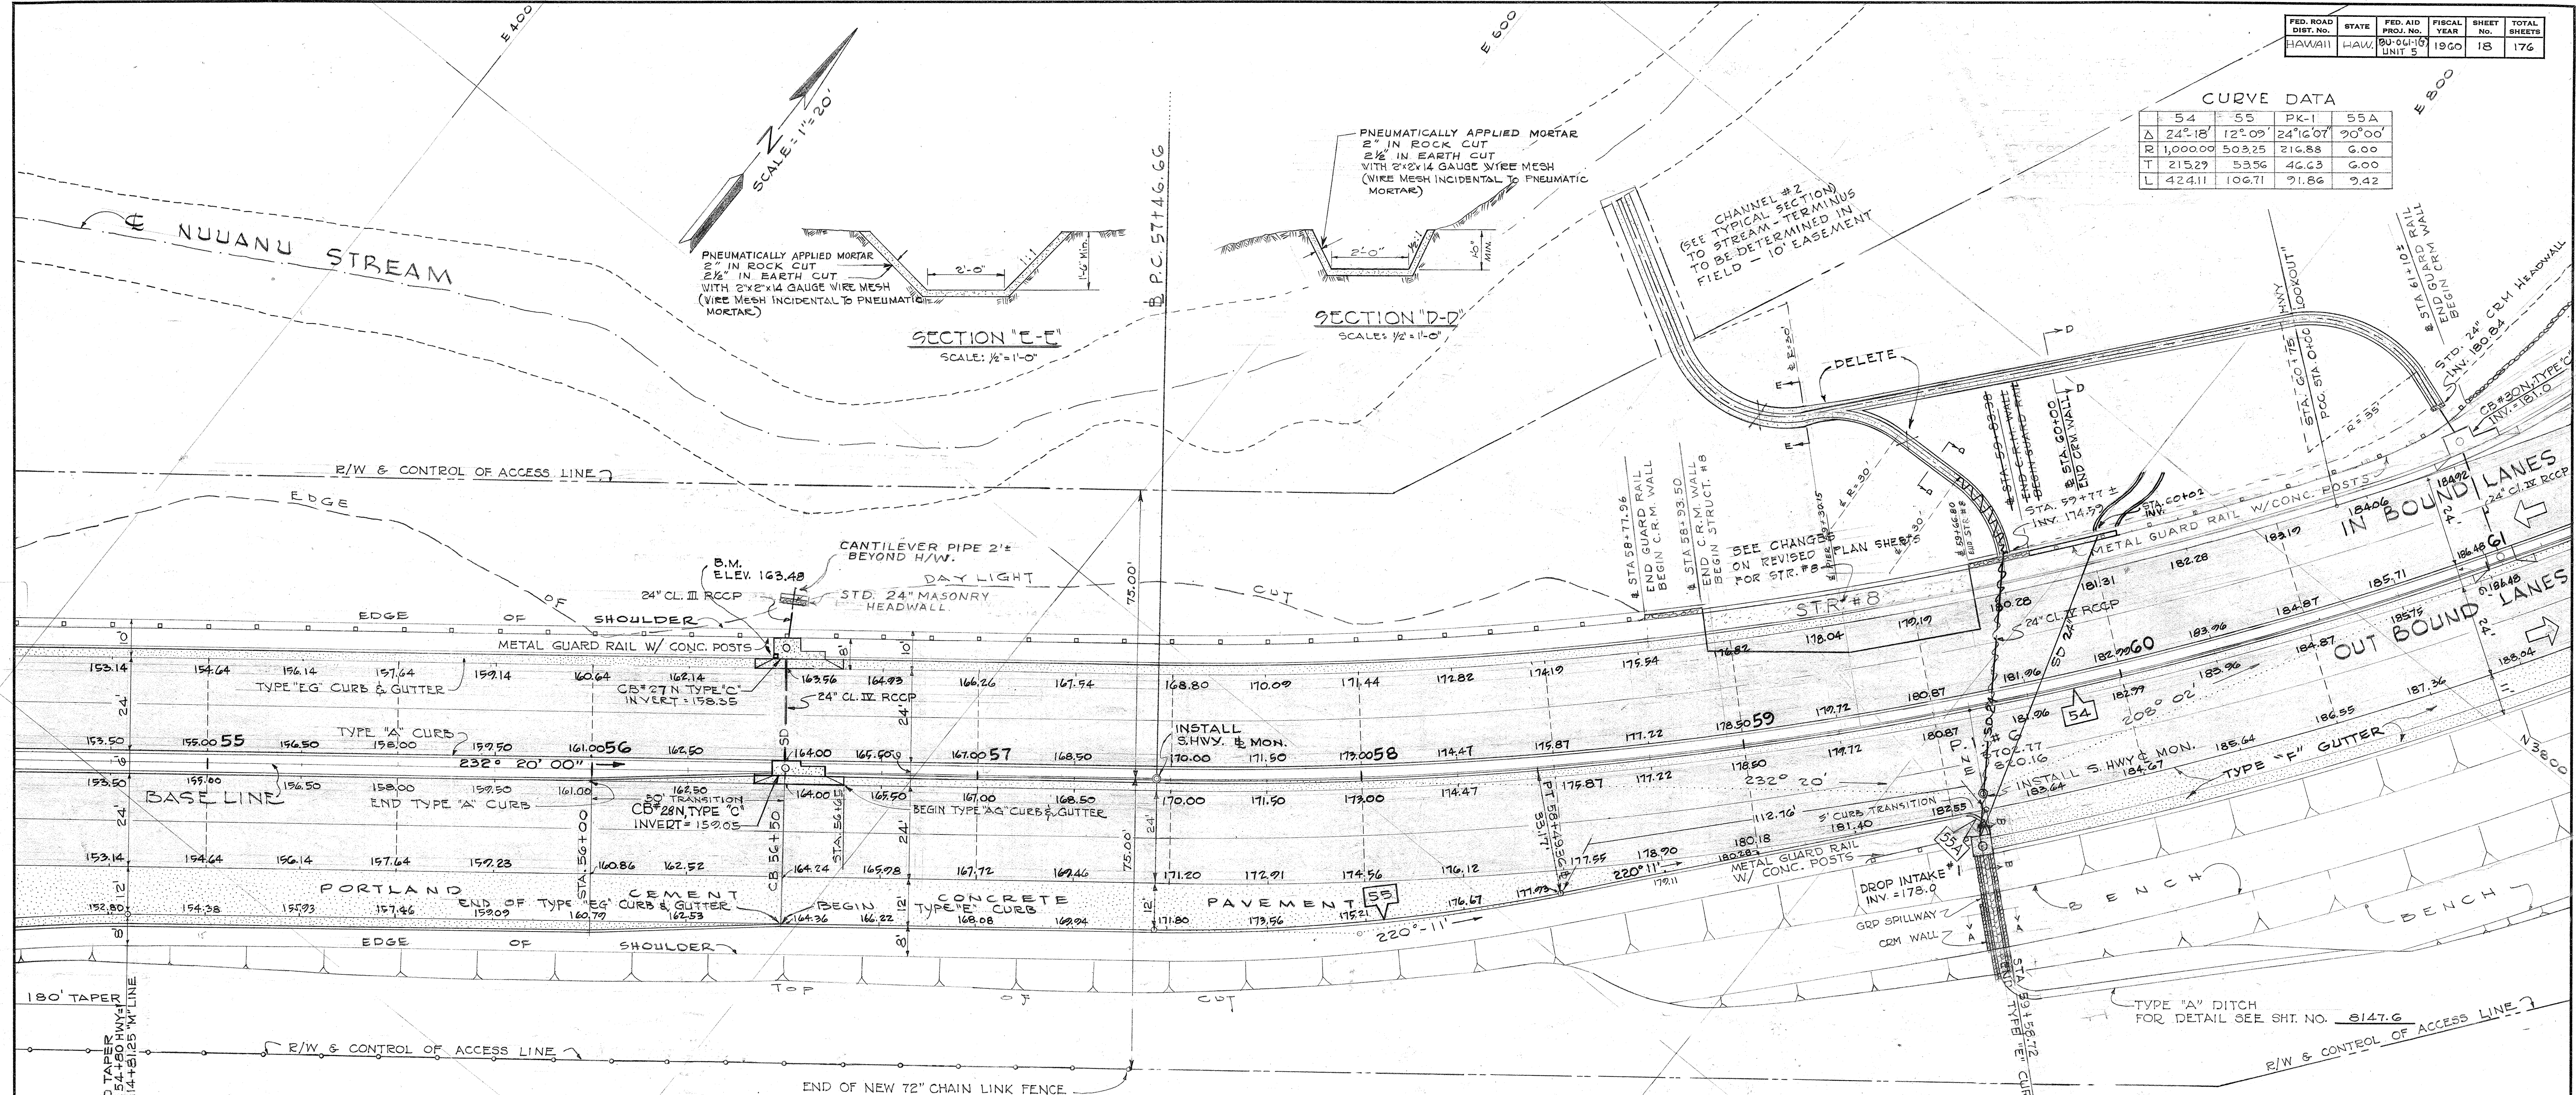

DETAIL OF BENCH DRAINAGE SYSTEM

Scale: As Noted

(SEE STANDARD DETAIL FOR DROP INTAKES) MODIFY DROP INTAKE TOP AND INSTALL TYPE \"B\" C.I. FRAME AND COVER ON INTAKE NO. 1. (SEE STANDARD DETAIL FOR FRAME & COVER)

This sheet is superseded
See sheet No. B.8147.18A

HAWAII STATE HIGHWAY DEPARTMENT
STATE OF HAWAII


PALI HIGHWAY
PROJECT NO. BU-061-1(7) UNIT 5
STATION 55+00 TO STATION 61+00
DETAIL PLAN OF ROADWAY
SCALE: AS NOTED SEPTEMBER, 1957

LAW & WILSON • TUDOR • TOWILL
ARCHITECTS • ENGINEERS • SURVEYORS
Lawson No. 584
REGISTERED ENGINEER
DATE July 2, 1957





DESIGNED BY: _____
CHECKED BY: _____
DATE: _____
ORIGINAL PLAN NO. _____
NOTE BOOK NO. _____

FED. ROAD DIST. NO.	STATE	FED. AID PROJ. NO.	FISCAL YEAR	SHEET NO.	TOTAL SHEETS
HAW-411	HAW.	8U-061(7) UNIT 5	1955	18A	176

CURVE DATA					
54	55	PK-1	55A		
Δ 24° 18'	12° 03'	24° 16' 07"	90° 00'		
R 1,000.00	503.25	216.88	6.00		
T 215.27	53.56	46.43	6.00		
L 424.11	106.71	91.86	9.42		

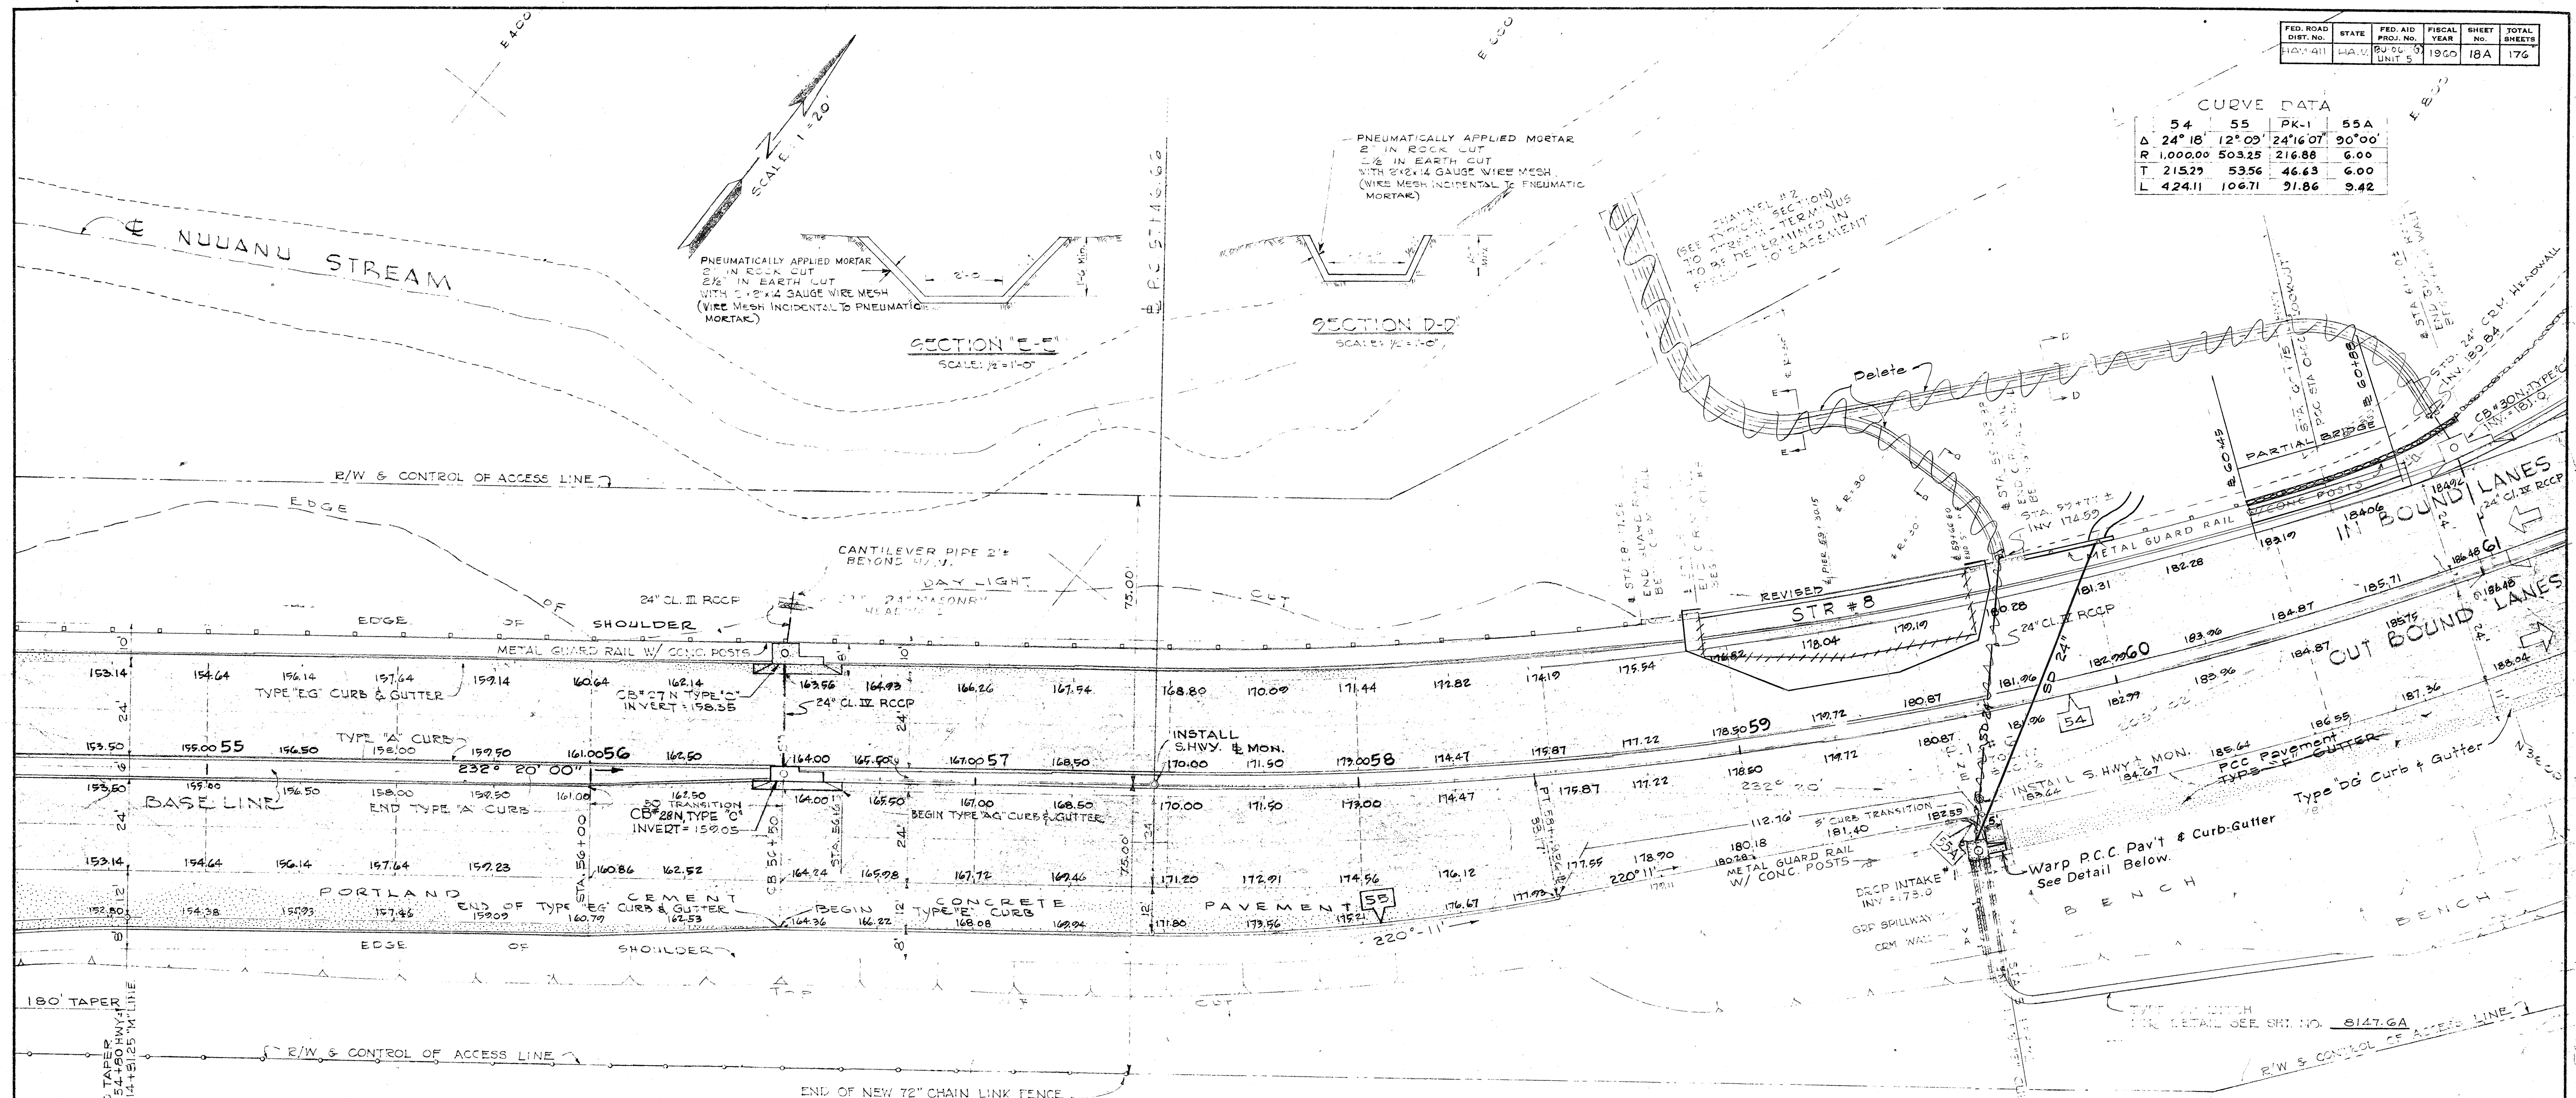

SURVEY PLOTTED BY: DATE: DESIGNED BY: TRACED BY: QUANTITIES BY: CHECKED BY: ORIGINAL PLAN No. NOTE BOOK No.

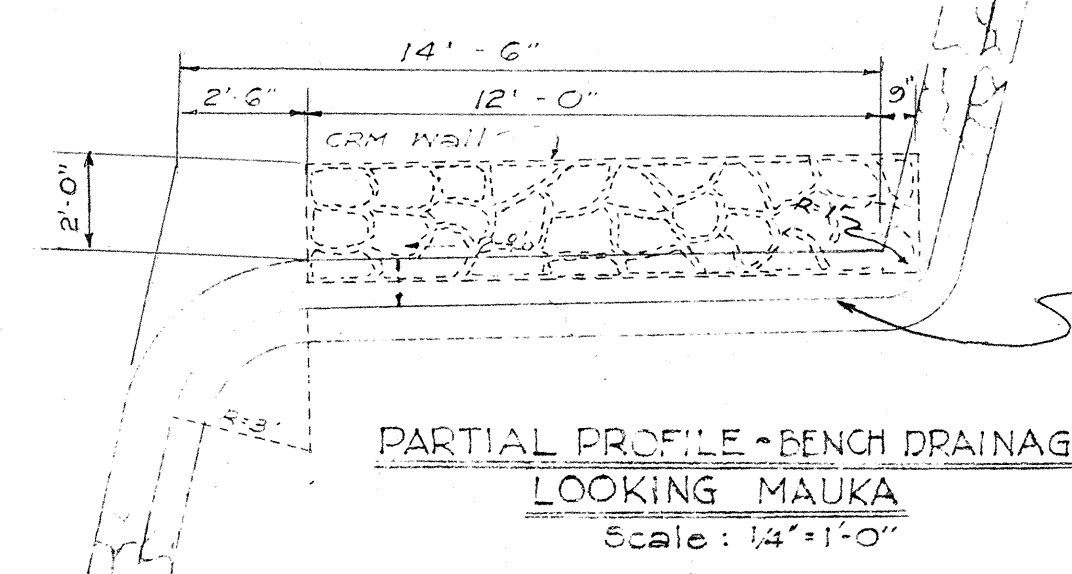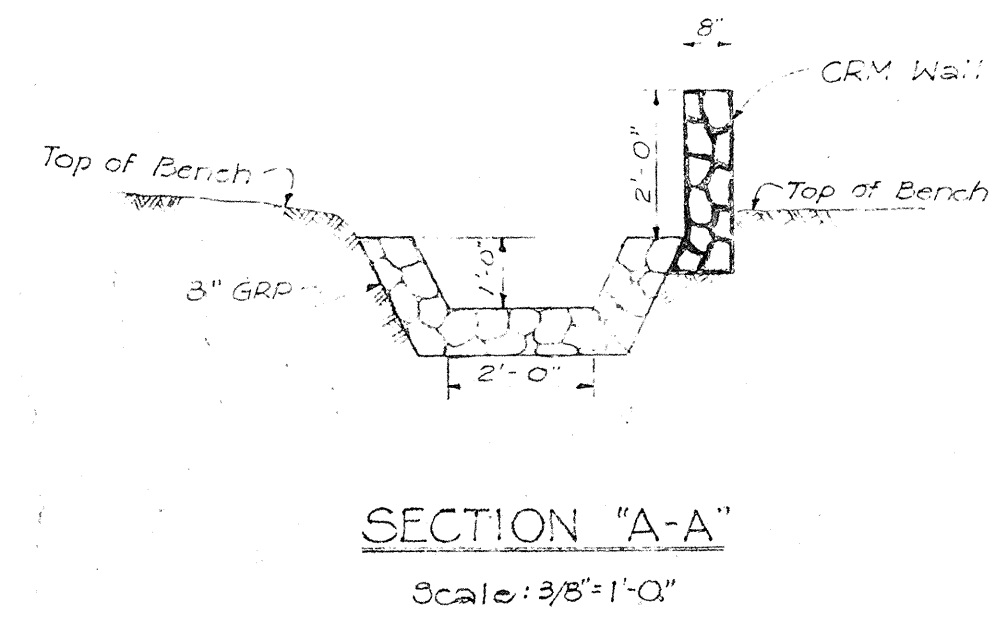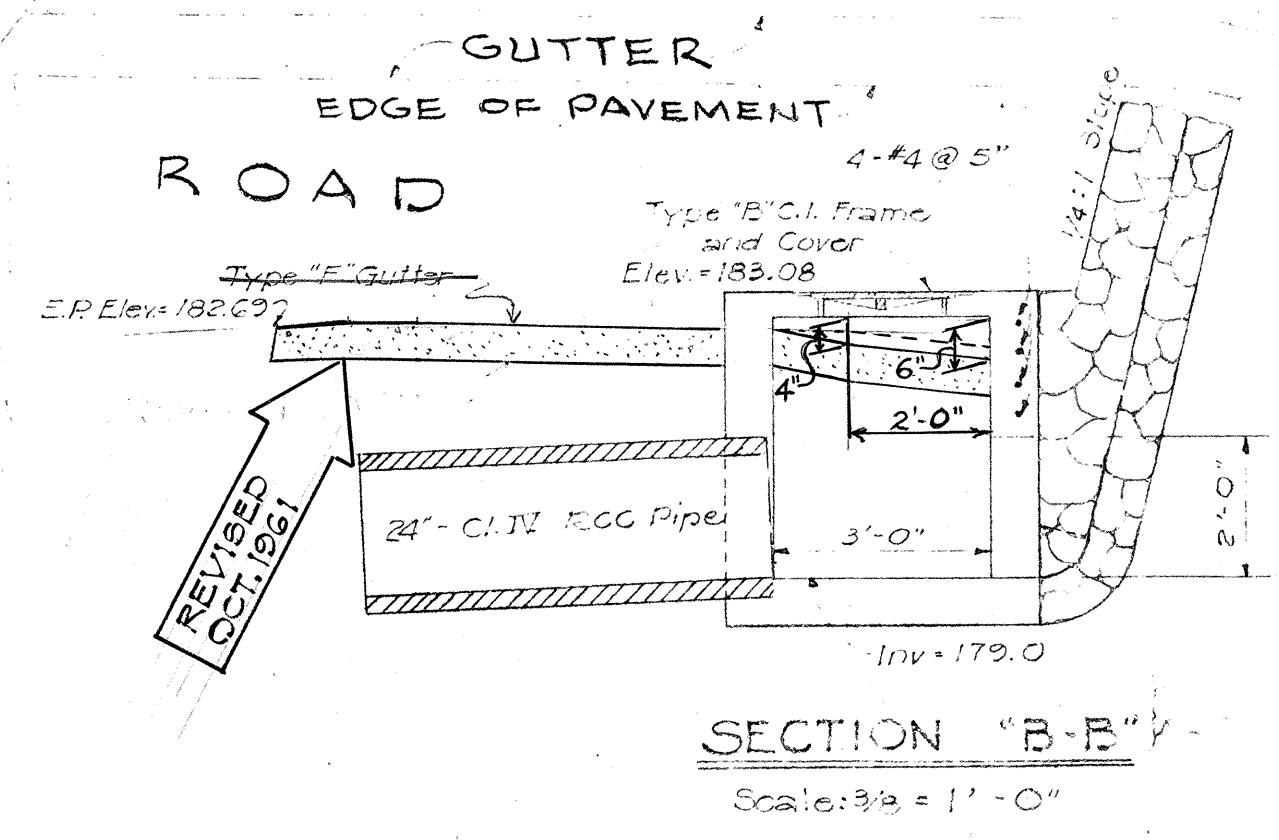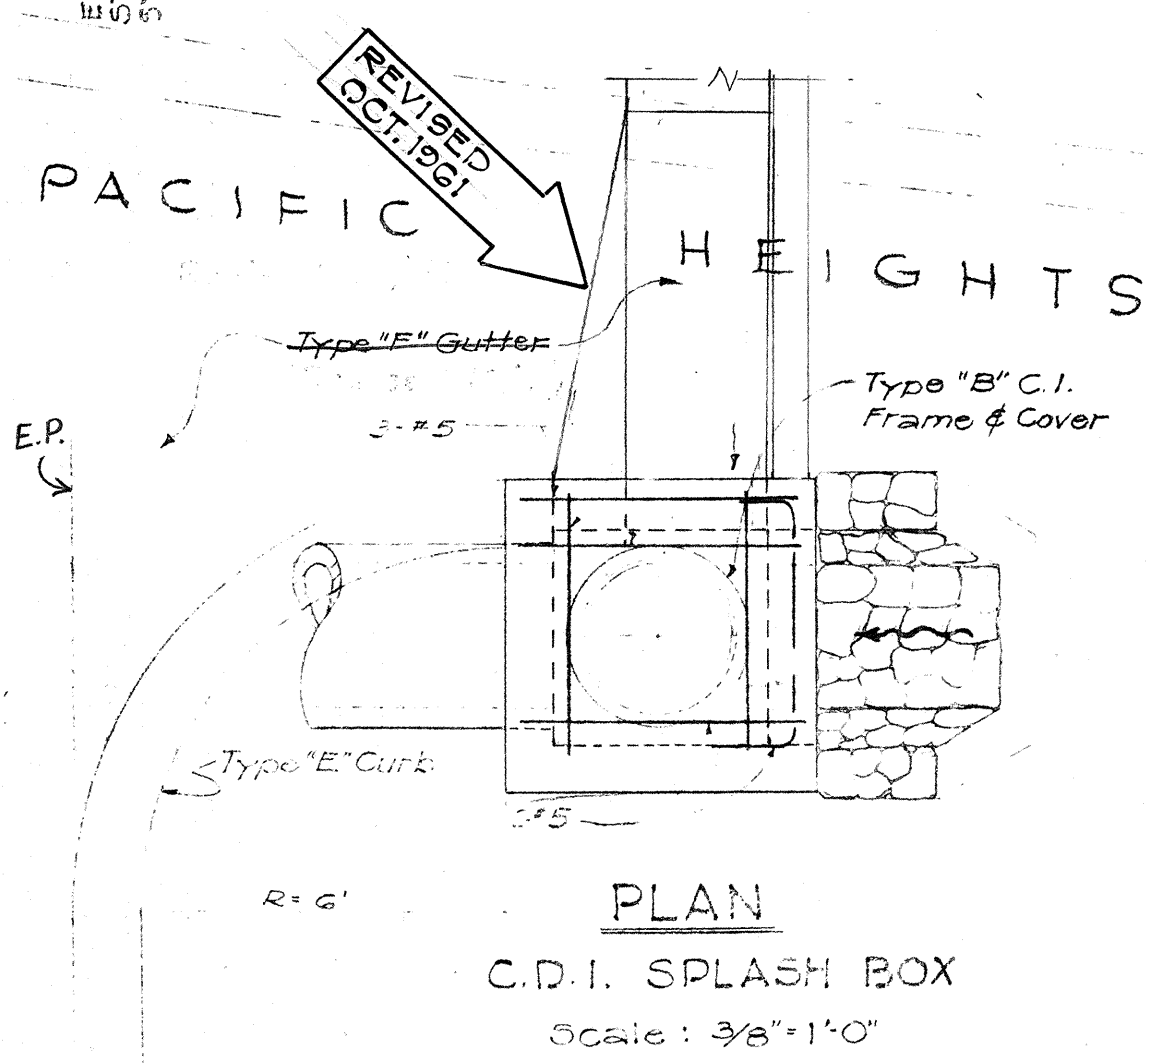

NOTE: This Sht. Supplements Sht. No. B-8147-18 Dated Sept. 1957.
GRP Channel & Spillway

DETAIL OF BENCH DRAINAGE SYSTEM

Scale: As Noted


DATE: July 23, 1957

STATE HIGHWAY DEPARTMENT
PALI HIGHWAY
PROJECT NO. 8U-061(7) UNIT 5
STATION 55+00 TO STATION 61+00
DETAIL PLAN OF ROADWAY
SCALE: AS NOTED
OCTOBER, 1961

SHEET No. 5 OF 10 SHEETS

B.S147.18A

FED. ROAD DIST. NO.	STATE	FED. AID PROJ. NO.	FISCAL YEAR	SHEET NO.	TOTAL SHEETS
HAWAII	HAW	80-061-10	1960	17	176

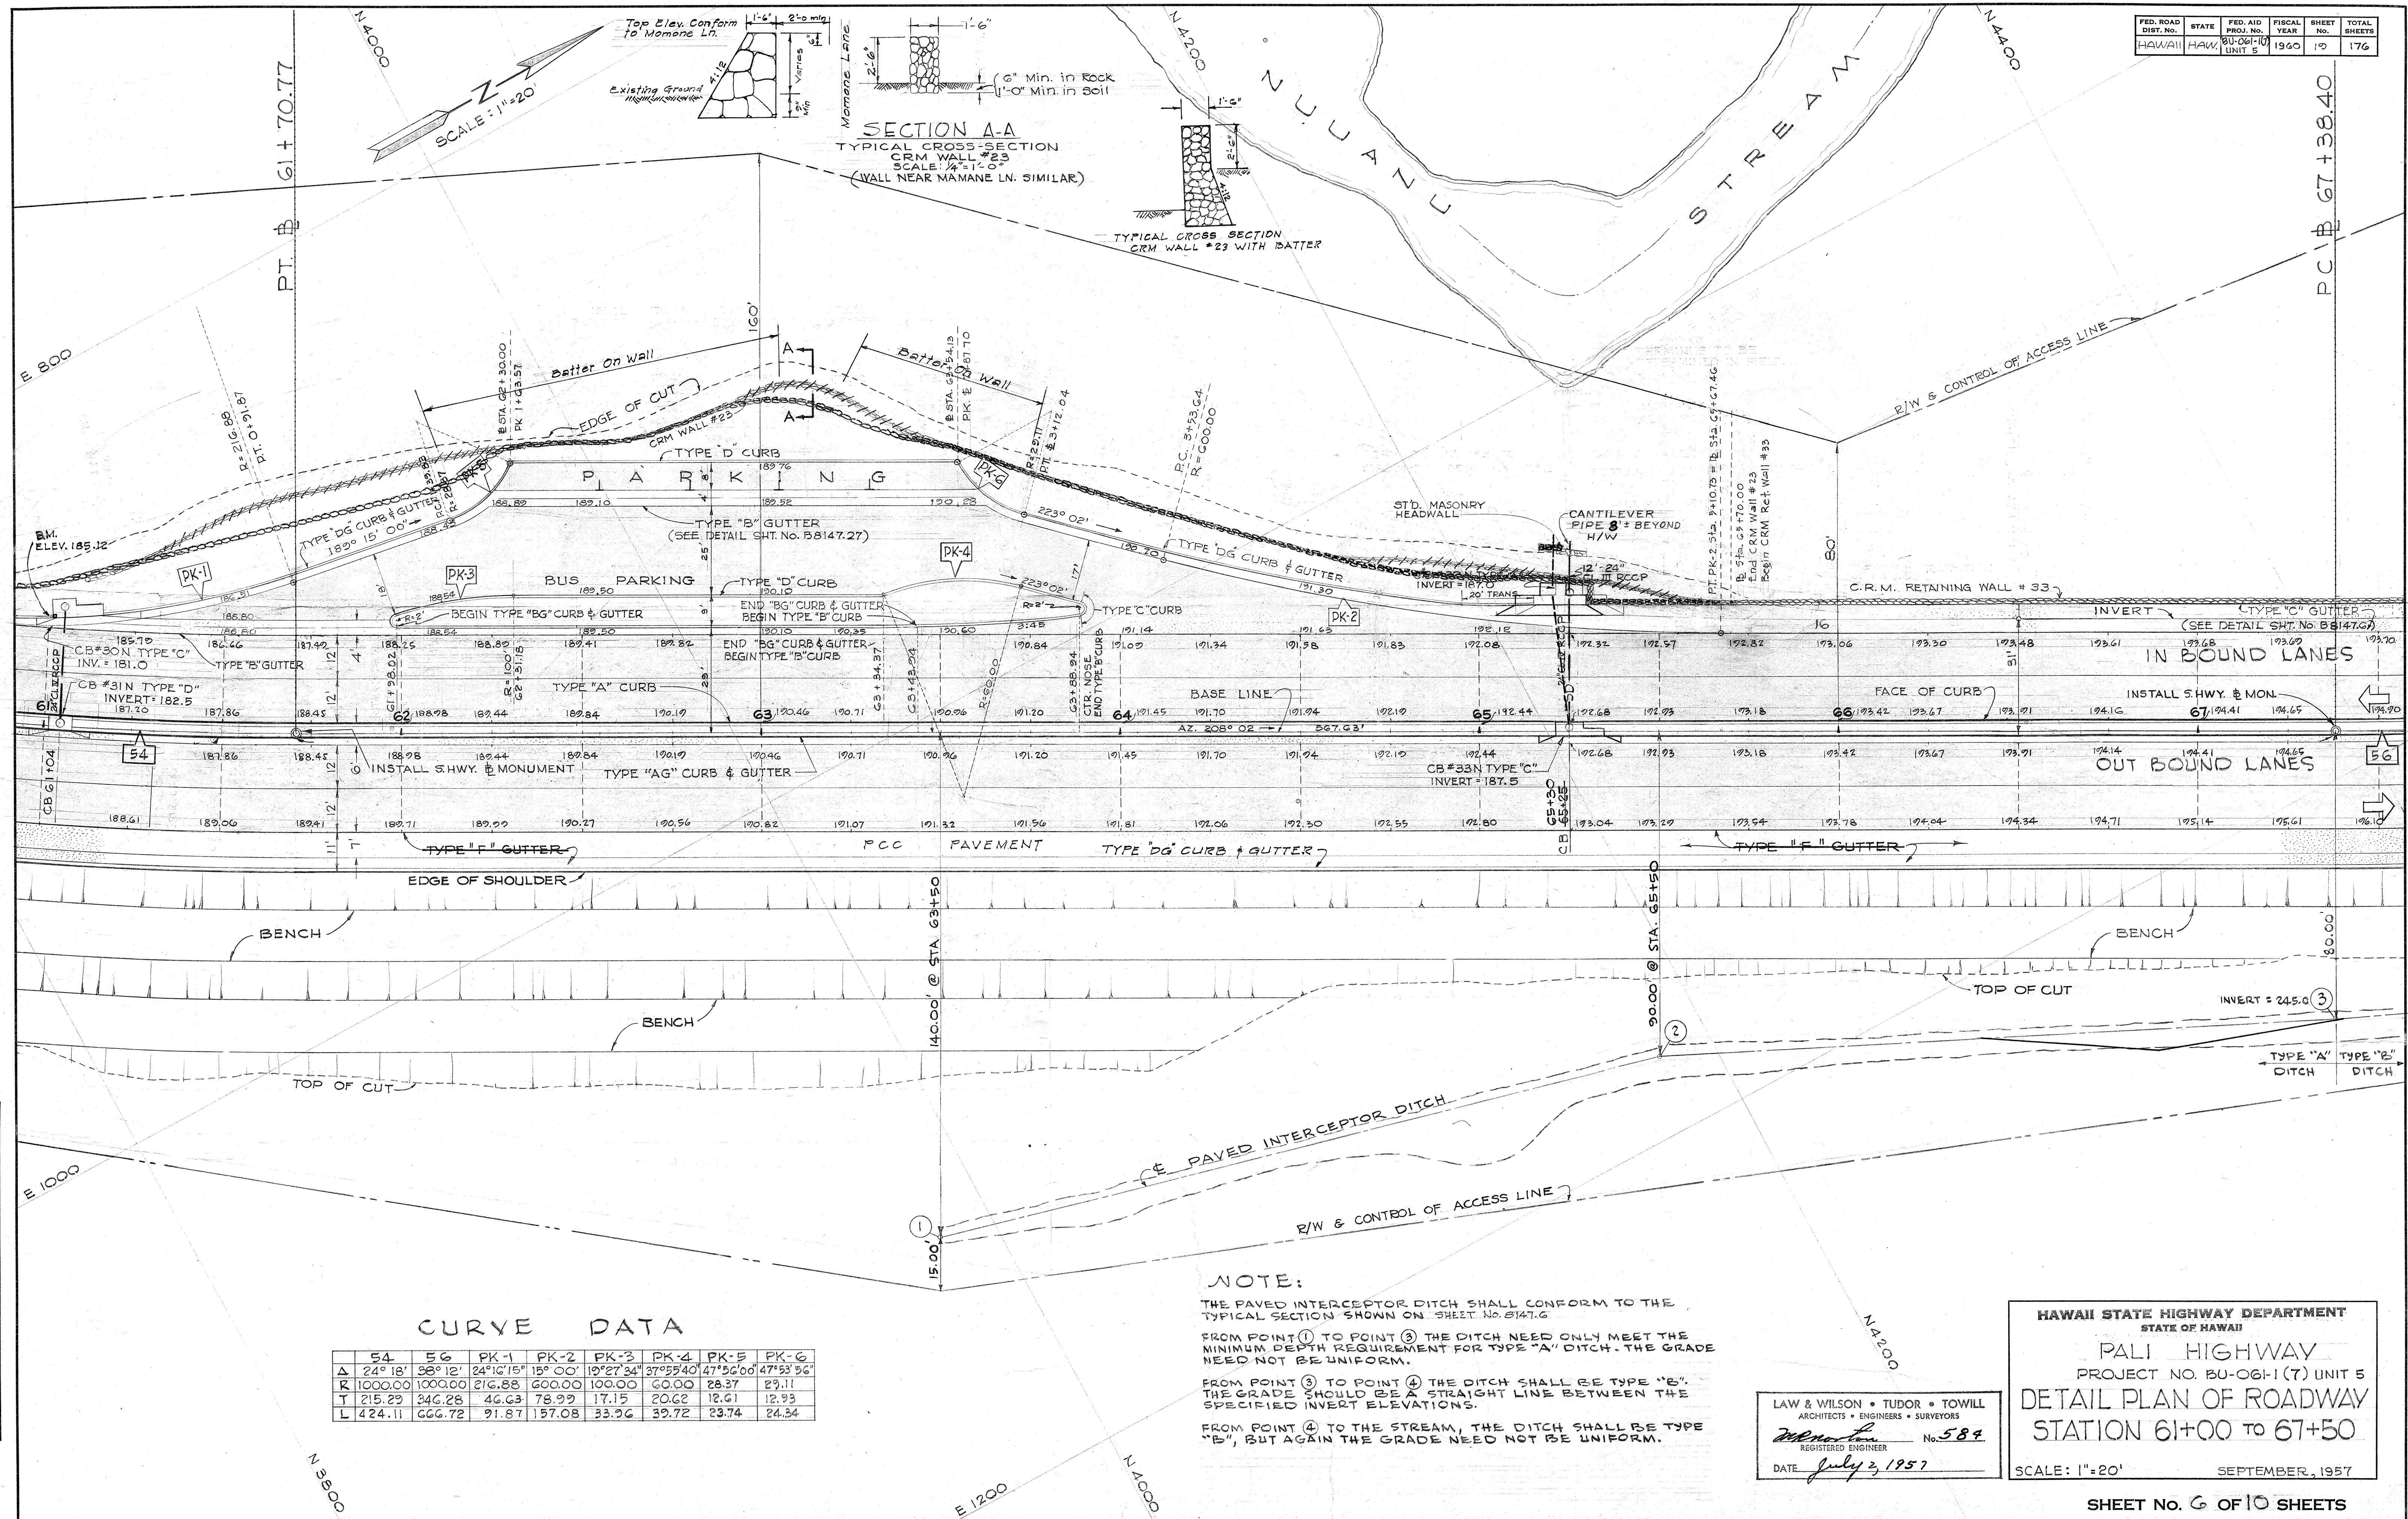

DATE	
SURVEY PLOTTED BY	
DESIGNED BY	
DRAWN BY	
CHECKED BY	
NOTE BOOK NO.	

CURVE DATA

	54	56	PK-1	PK-2	PK-3	PK-4	PK-5	PK-6
Δ	24° 18'	38° 12'	24° 16' 15"	15° 00'	10° 27' 34"	37° 55' 40"	47° 56' 06"	47° 53' 56"
R	1000.00	1000.00	216.88	600.00	100.00	60.00	28.37	29.11
L	215.29	346.28	46.63	78.99	17.15	20.62	12.61	12.93
T	424.11	666.72	91.87	157.08	33.96	39.72	23.74	24.34

NOTE:

THE PAVED INTERCEPTOR DITCH SHALL CONFORM TO THE TYPICAL SECTION SHOWN ON SHEET No. 8147.6

FROM POINT ① TO POINT ③ THE DITCH NEED ONLY MEET THE MINIMUM DEPTH REQUIREMENT FOR TYPE "A" DITCH. THE GRADE NEED NOT BE UNIFORM.

FROM POINT ③ TO POINT ④ THE DITCH SHALL BE TYPE "B". THE GRADE SHOULD BE A STRAIGHT LINE BETWEEN THE SPECIFIED INVERT ELEVATIONS.

FROM POINT ④ TO THE STREAM, THE DITCH SHALL BE TYPE "B", BUT AGAIN THE GRADE NEED NOT BE UNIFORM.

LAW & WILSON • TUDOR • TOWILL
ARCHITECTS • ENGINEERS • SURVEYORS
REGISTERED ENGINEER
No. 584
DATE July 2, 1957

HAWAII STATE HIGHWAY DEPARTMENT
STATE OF HAWAII
PALI HIGHWAY
PROJECT NO. 80-061-1(7) UNIT 5
DETAIL PLAN OF ROADWAY
STATION 61+00 TO 67+50
SCALE: 1"=20'
SEPTEMBER, 1957


SHEET No. 6 OF 10 SHEETS

B. 8147.19

FED. ROAD DIST. NO.	STATE	FED. AID PROJ. NO.	FISCAL YEAR	SHEET NO.	TOTAL SHEETS
HAWAII	HAW	BU02-17	1960	20	176


CURVE DATA

	56	N-1
Δ	38° 12' 14" 29' 22"	
R	1000.00	317.71
T	346.26	40.89
L	666.72	80.85

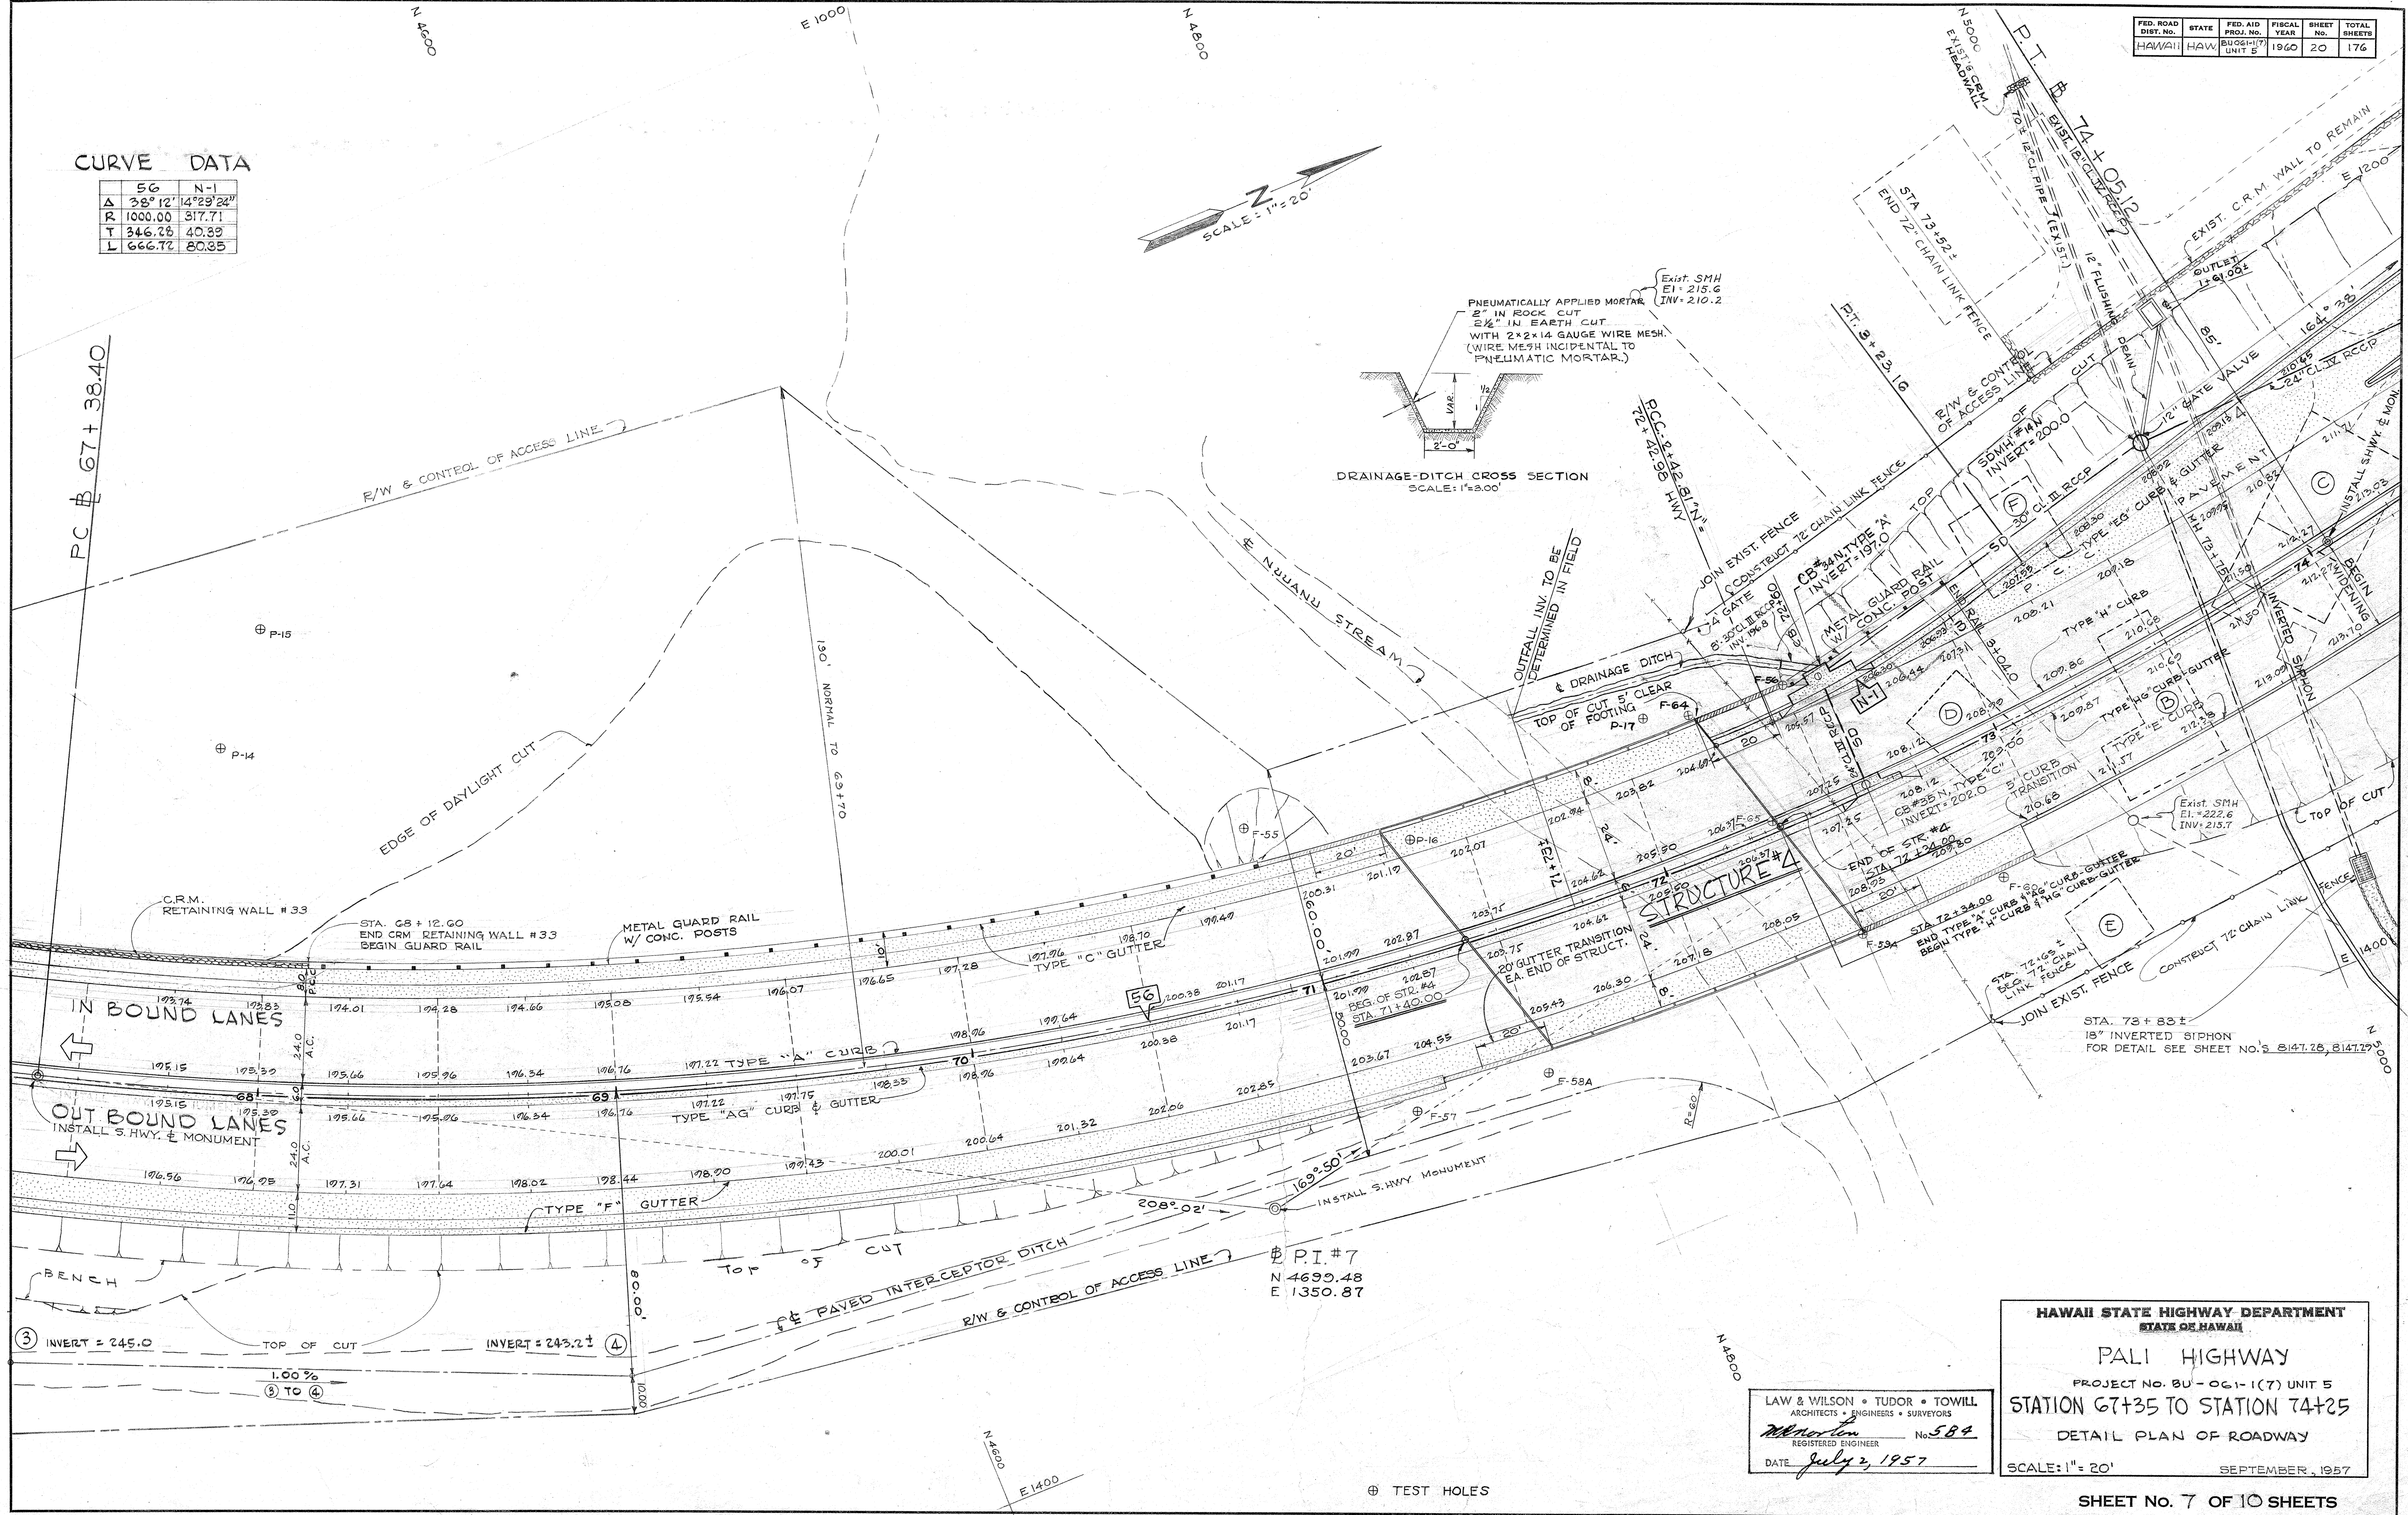

Exist. SMH
EI = 215.6
INV = 210.2

PNEUMATICALLY APPLIED MORTAR
2" IN ROCK CUT
2 1/2" IN EARTH CUT
WITH 2x2x1/4 GAUGE WIRE MESH.
(WIRE MESH INCIDENTAL TO PNEUMATIC MORTAR.)

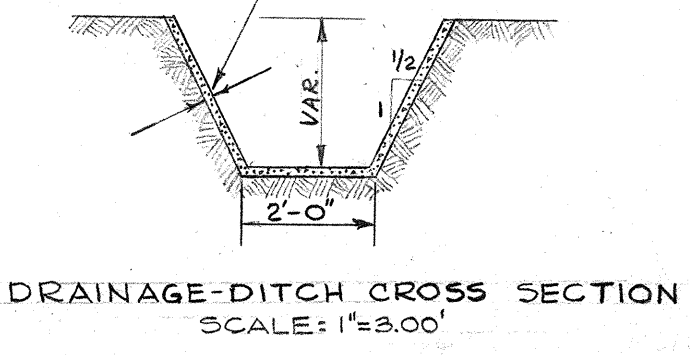

HAWAII STATE HIGHWAY DEPARTMENT
STATE OF HAWAII

PALI HIGHWAY

PROJECT NO. BU-061-1(7) UNIT 5

STATION 67+35 TO STATION 74+25

DETAIL PLAN OF ROADWAY

SCALE: 1" = 20'

SEPTEMBER, 1957

LAW & WILSON • TUDOR • TOWILL
ARCHITECTS • ENGINEERS • SURVEYORS

Alfred Tudor No. 584
REGISTERED ENGINEER

DATE July 2, 1957

DATE _____

DESIGNED BY _____

TRACED BY _____

QUANTITIES BY _____

CHECKED BY _____

ORIGINAL PLAN _____



NOTE BOOK _____

NO. _____


FED. ROAD DIST. NO.	STATE	FED. AID PROJ. NO.	FISCAL YEAR	SHEET NO.	TOTAL SHEETS
HAWAII	HAW	ENR-101(7) UNIT 5	1960	204	176

CURVE DATA

	56	N-1
A	38° 12'	4° 29' 24"
R	1000.00	317.71
T	346.76	40.39
L	666.72	80.35

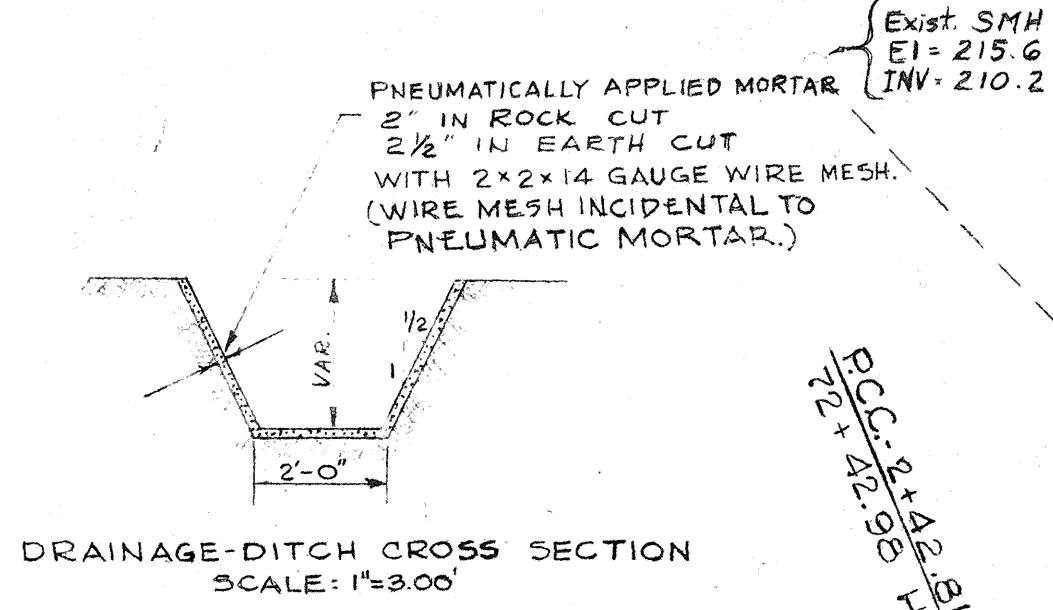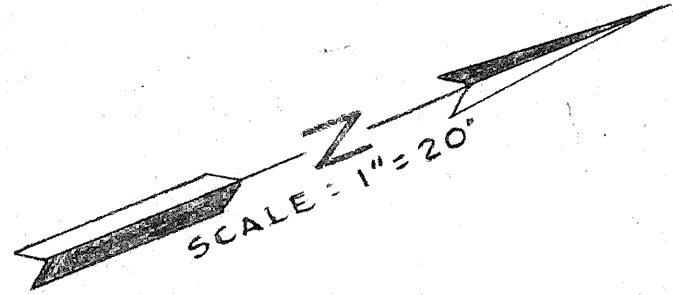

DATE	DESIGNED BY	CHECKED BY
1957	WILSON	WILSON
1957	WILSON	WILSON
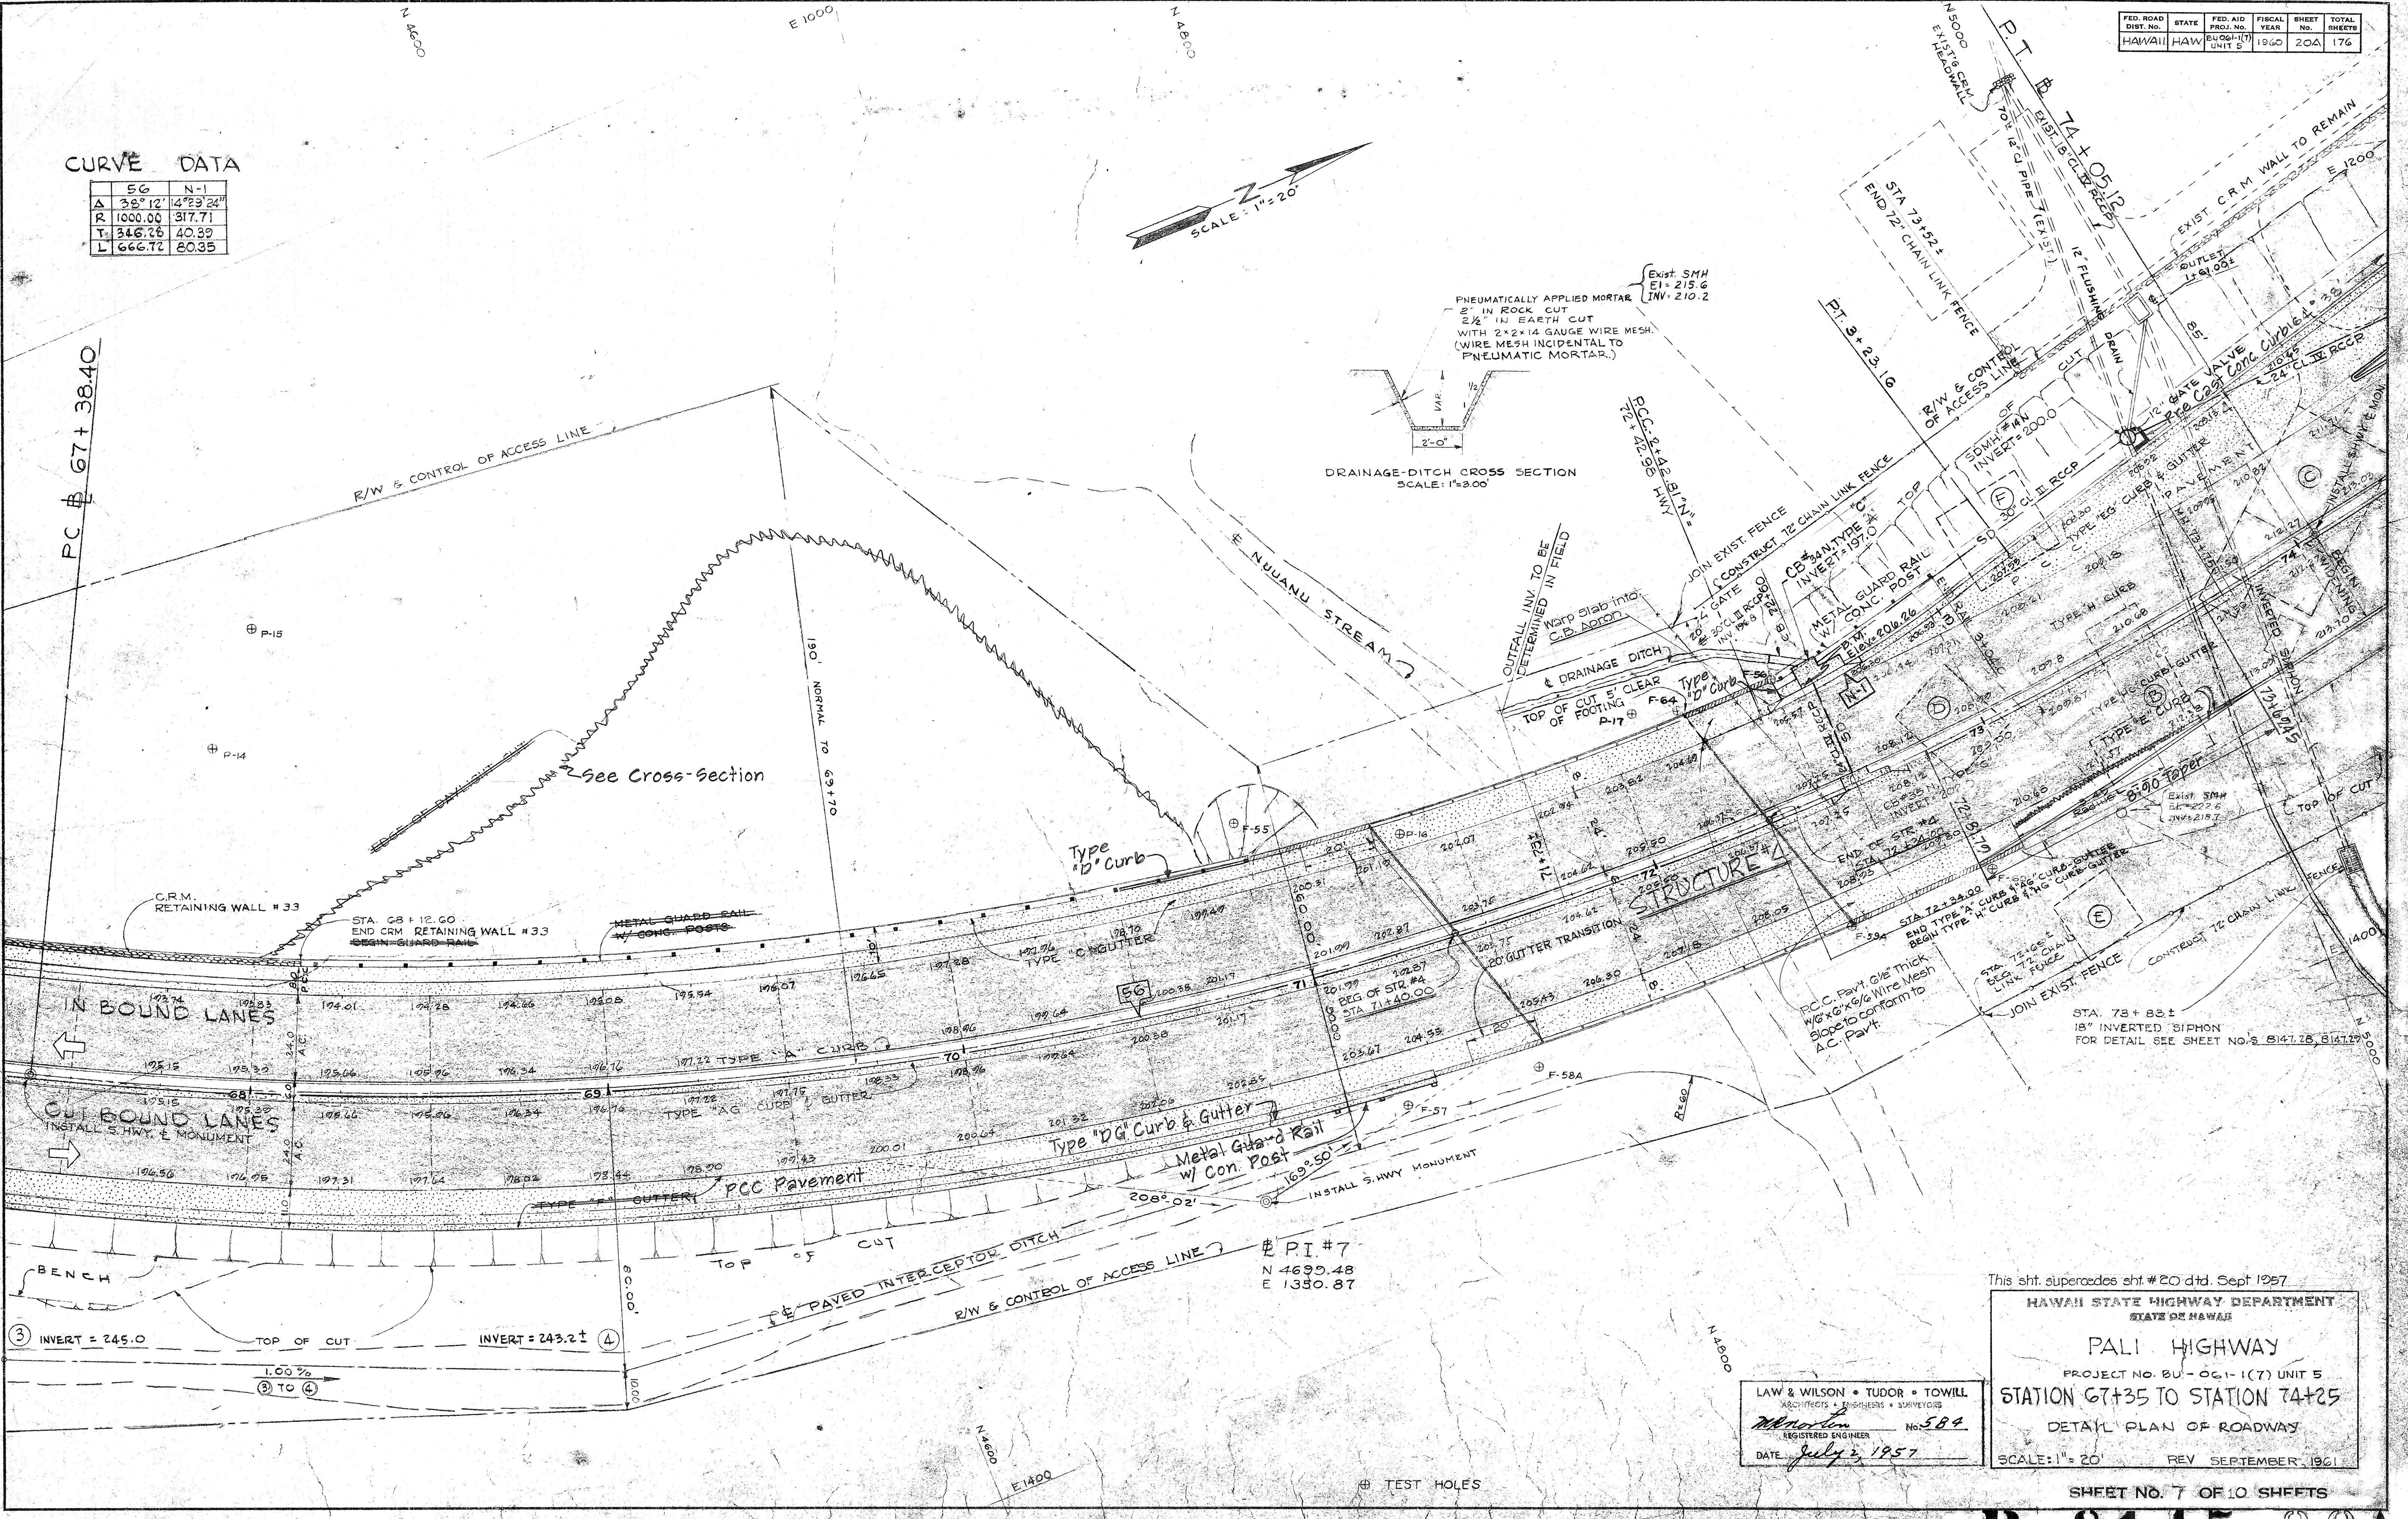

This sh't. supercedes sh't. #20 dtd. Sept. 1957.

HAWAII STATE HIGHWAY DEPARTMENT
STATE OF HAWAII

PALI HIGHWAY
PROJECT NO. BU-061-1(7) UNIT 5
STATION 67+35 TO STATION 74+25
DETAIL PLAN OF ROADWAY
SCALE: 1"=20' REV. SEPTEMBER, 1961

SHEET NO. 7 OF 10 SHEETS

LAW & WILSON • TUDOR • TOWILL
ARCHITECTS • ENGINEERS • SURVEYORS
W. W. Wilson
REGISTERED ENGINEER No. 584
DATE July 3, 1957

B. 8147.20A

Storm Drainage Revised 5/26/66

CURVE DATA



SHEET No. 8 OF 10 SHEETS







This detail is superseded
by sheet no. B.8147.73A
and B.8147.73B

ORIGINAL PLAN	SURVEY PLOTTED BY _____	DATE _____
	DESIGNED BY _____	" " " "
	DRAWN BY _____	" " " "
	TRACED BY _____	" " " "
	QUANTITIES BY _____	" " " "
NOTE BOOK	QUANTITIES CHECKED BY _____	" " " "
NO. _____	CHECKED BY _____	" " " "

FED. ROAD DIST. NO.	STATE	FED. AID PROJ. NO.	FISCAL YEAR	SHEET NO.	TOTAL SHEETS
HAWAII	HAW	BU-061(7) UNIT 5	1960	22	176

CURVE DATA

	57	58	59	P-2	P-3	NU-1	NU-2	C-1	C-2	C-3
Δ	48°38'	48°38'	48°38'	46°25'33"	22°43'01"	11°00'01"	2°53'09"	91°42'12"	77°09'38"	77°09'38"
R	1000.00	1000.00	1000.00	200.00	964.00	963.37	296.00	20.00	20.00	36.00
L	451.87	451.87	451.87	85.72	193.66	92.78	25.60	20.59	15.95	28.72
T	848.61	848.61	848.61	161.96	382.24	184.99	51.07	32.01	26.93	48.48

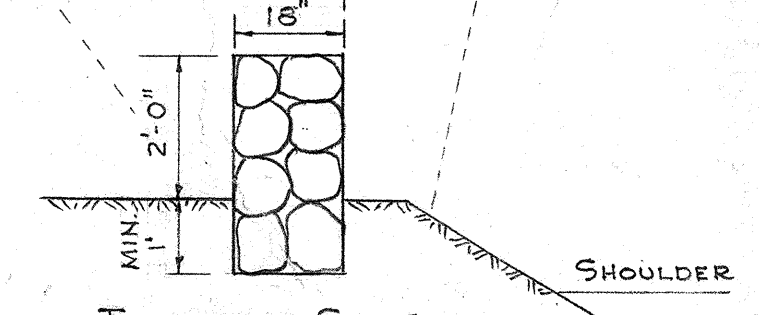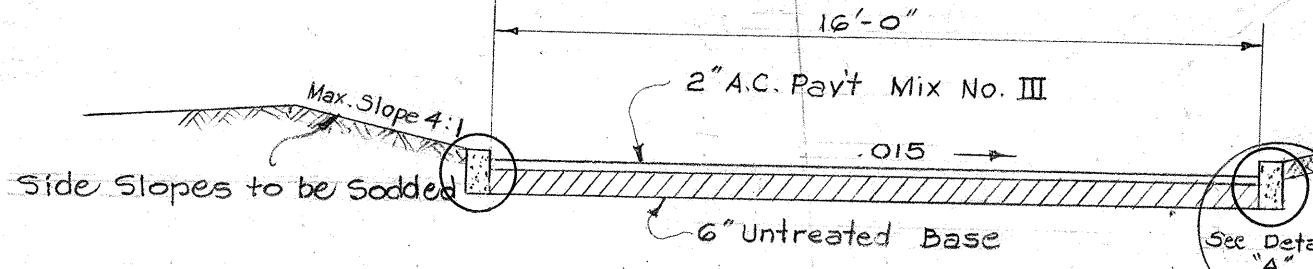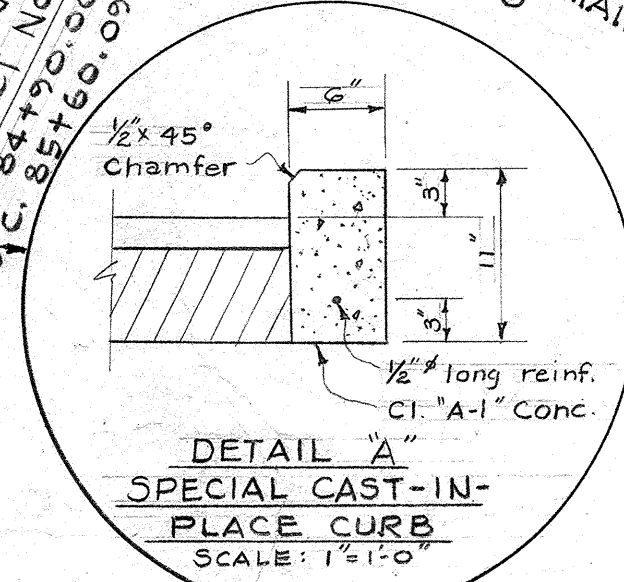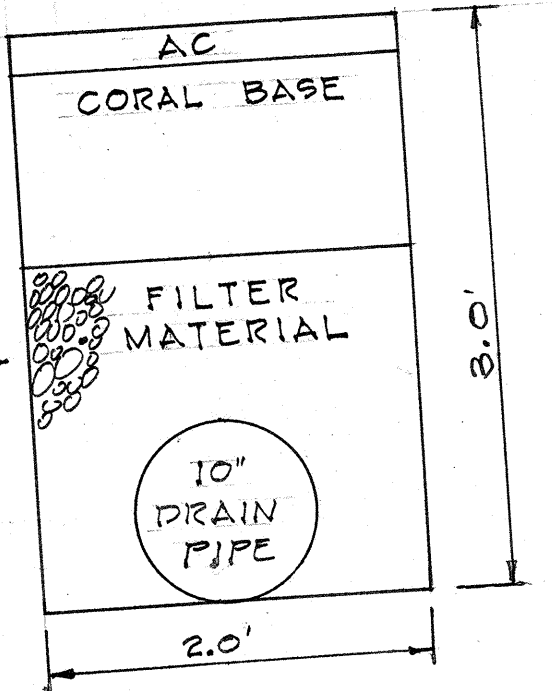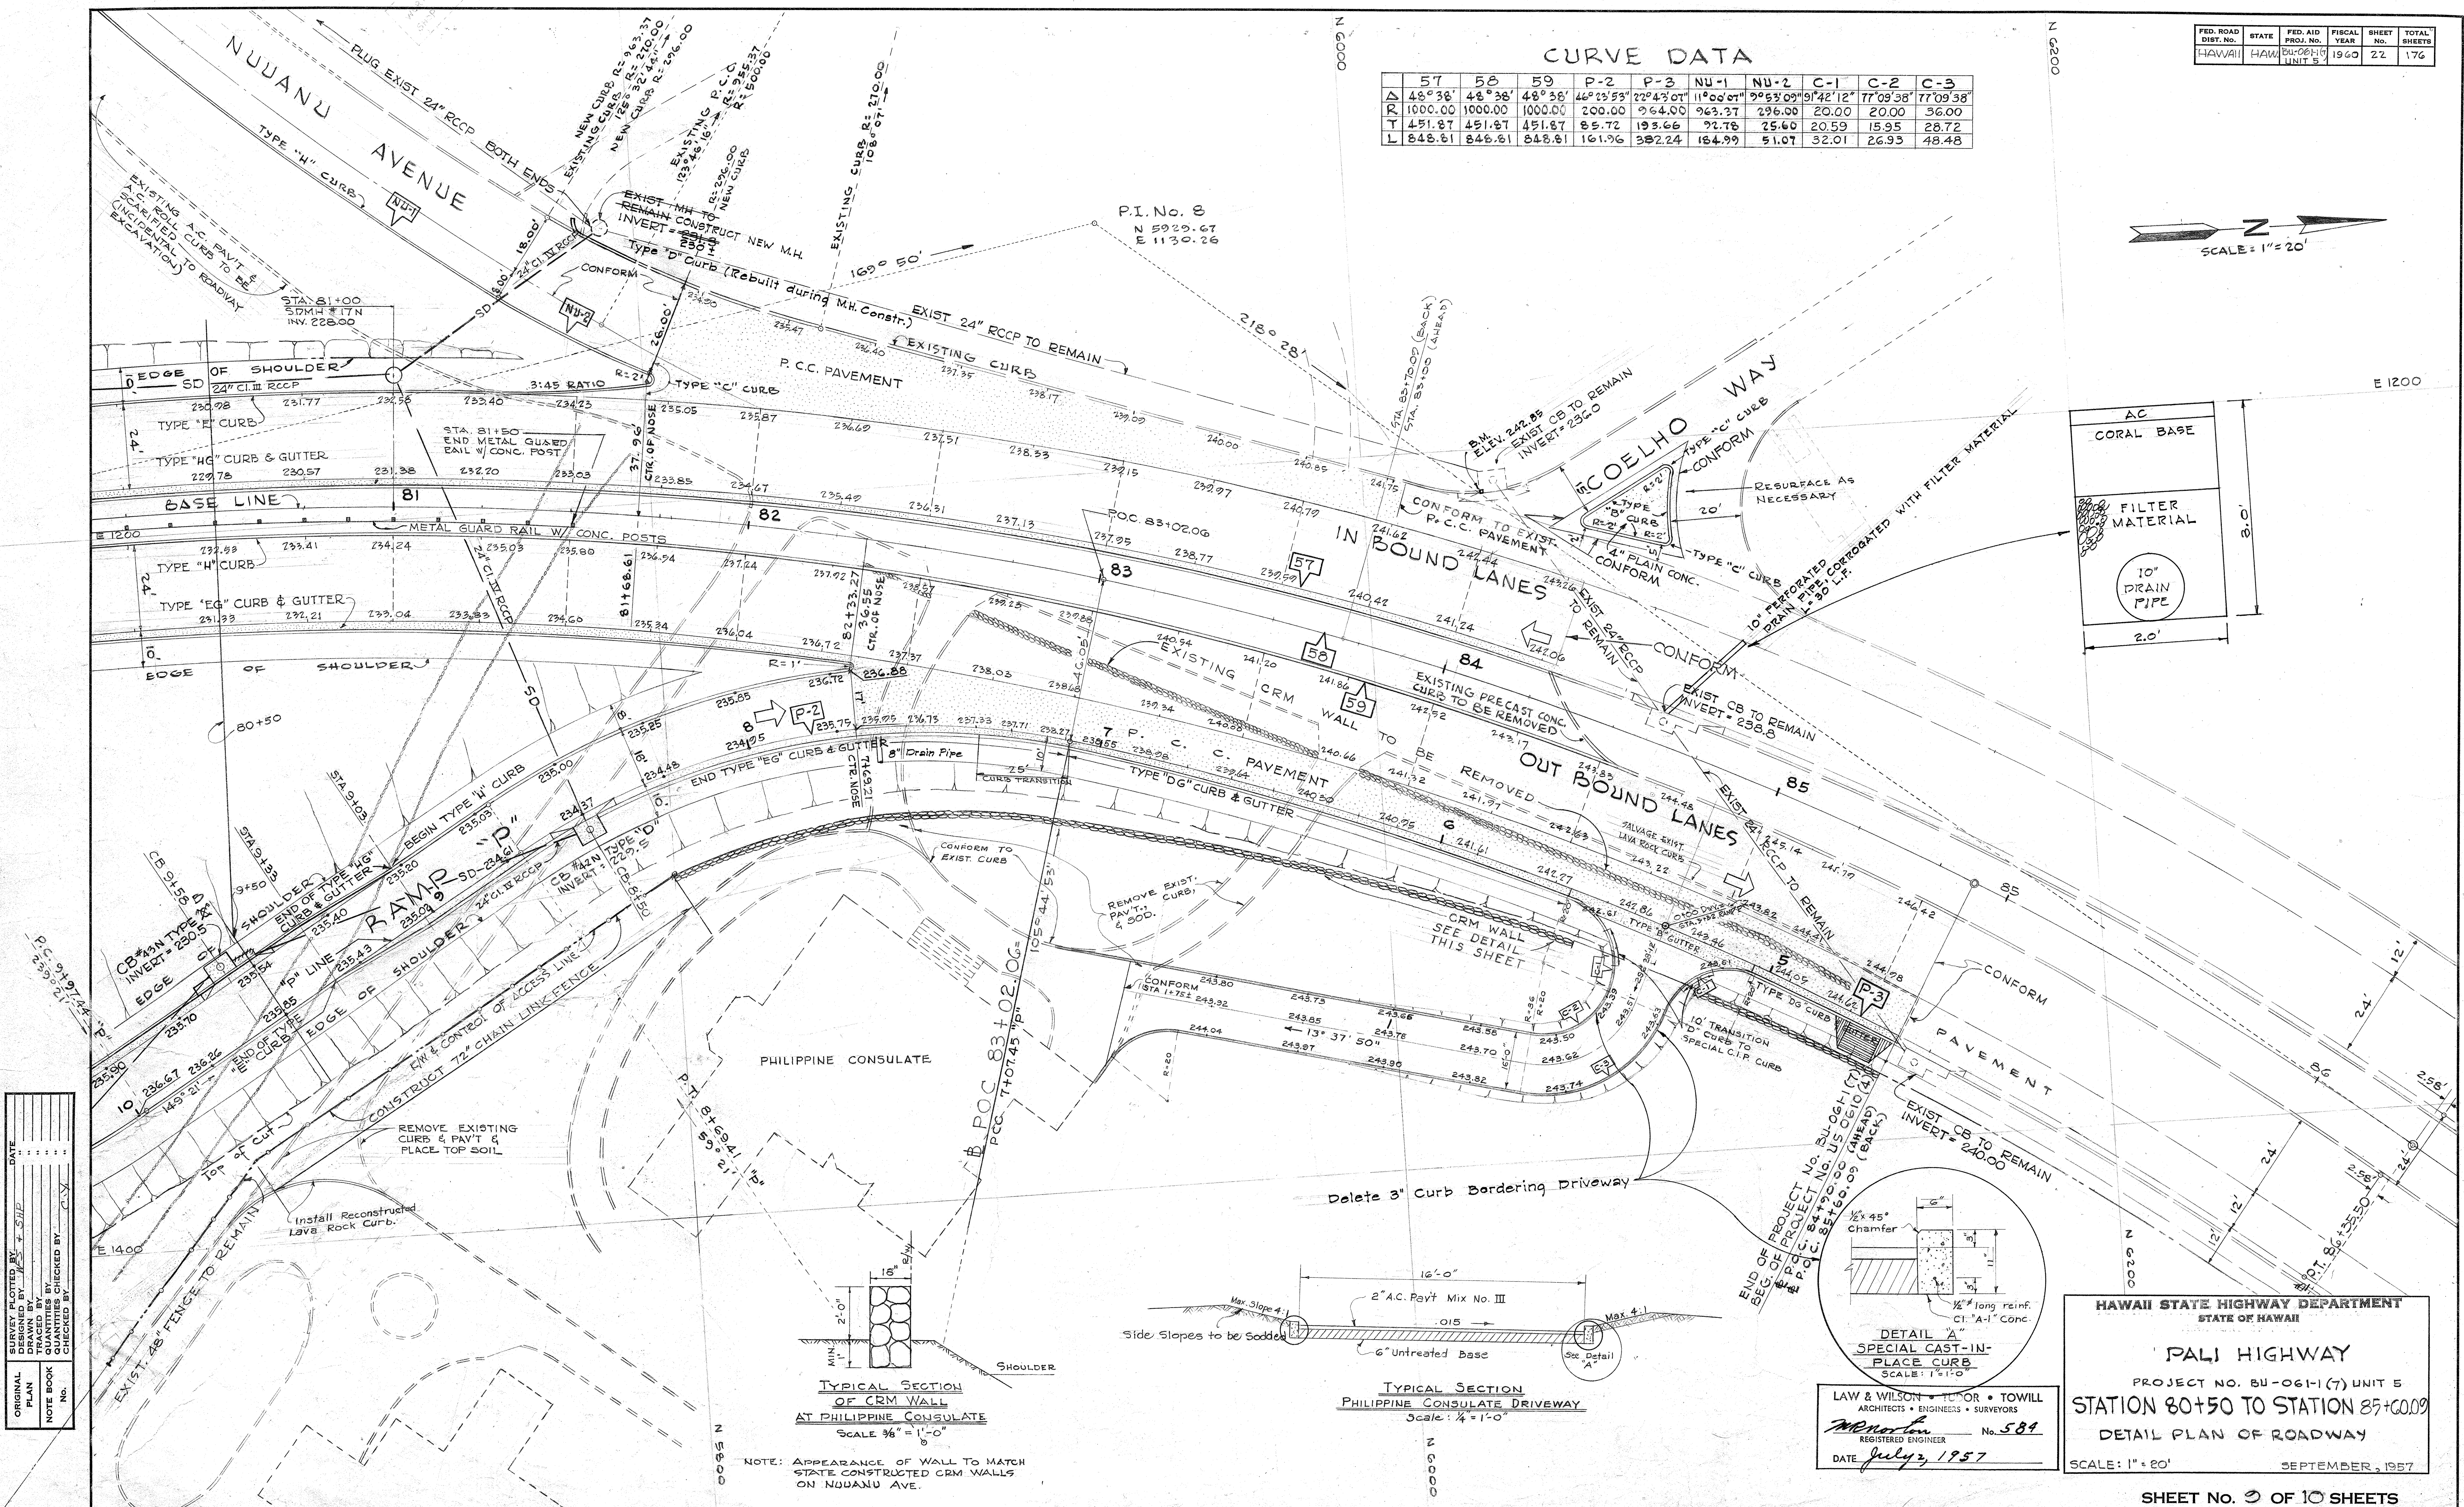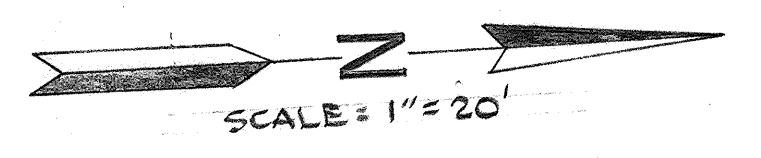

HAWAII STATE HIGHWAY DEPARTMENT
STATE OF HAWAII

PALI HIGHWAY

PROJECT NO. BU-061(7) UNIT 5
STATION 80+50 TO STATION 85+00.00
DETAIL PLAN OF ROADWAY

SCALE: 1"=20' SEPTEMBER, 1957

LAW & WILSON • TOWILL
ARCHITECTS • ENGINEERS • SURVEYORS



REGISTERED ENGINEER No. 584
DATE July 3, 1957

DATE: 7/3/57
DESIGNED BY: W.S. & S.H.P.
CHECKED BY: C.K.
ORIGINAL PLAN
NOTED BY: C.K.
NO. 584

B.8147.22

CURVE DATA

	N-3	N-4	N-5	Q-1	NU-1	NU-2
Δ	28°00'28"	96°25'48"	26°54'40"	166°00'	11°00'07"	9°53'09"
R	216.00	35.00	50.00	170.00	963.37	296.00
T	53.87	39.21	11.96	1384.54	92.78	25.60
L	105.59	58.95	23.48	492.53	184.99	51.07

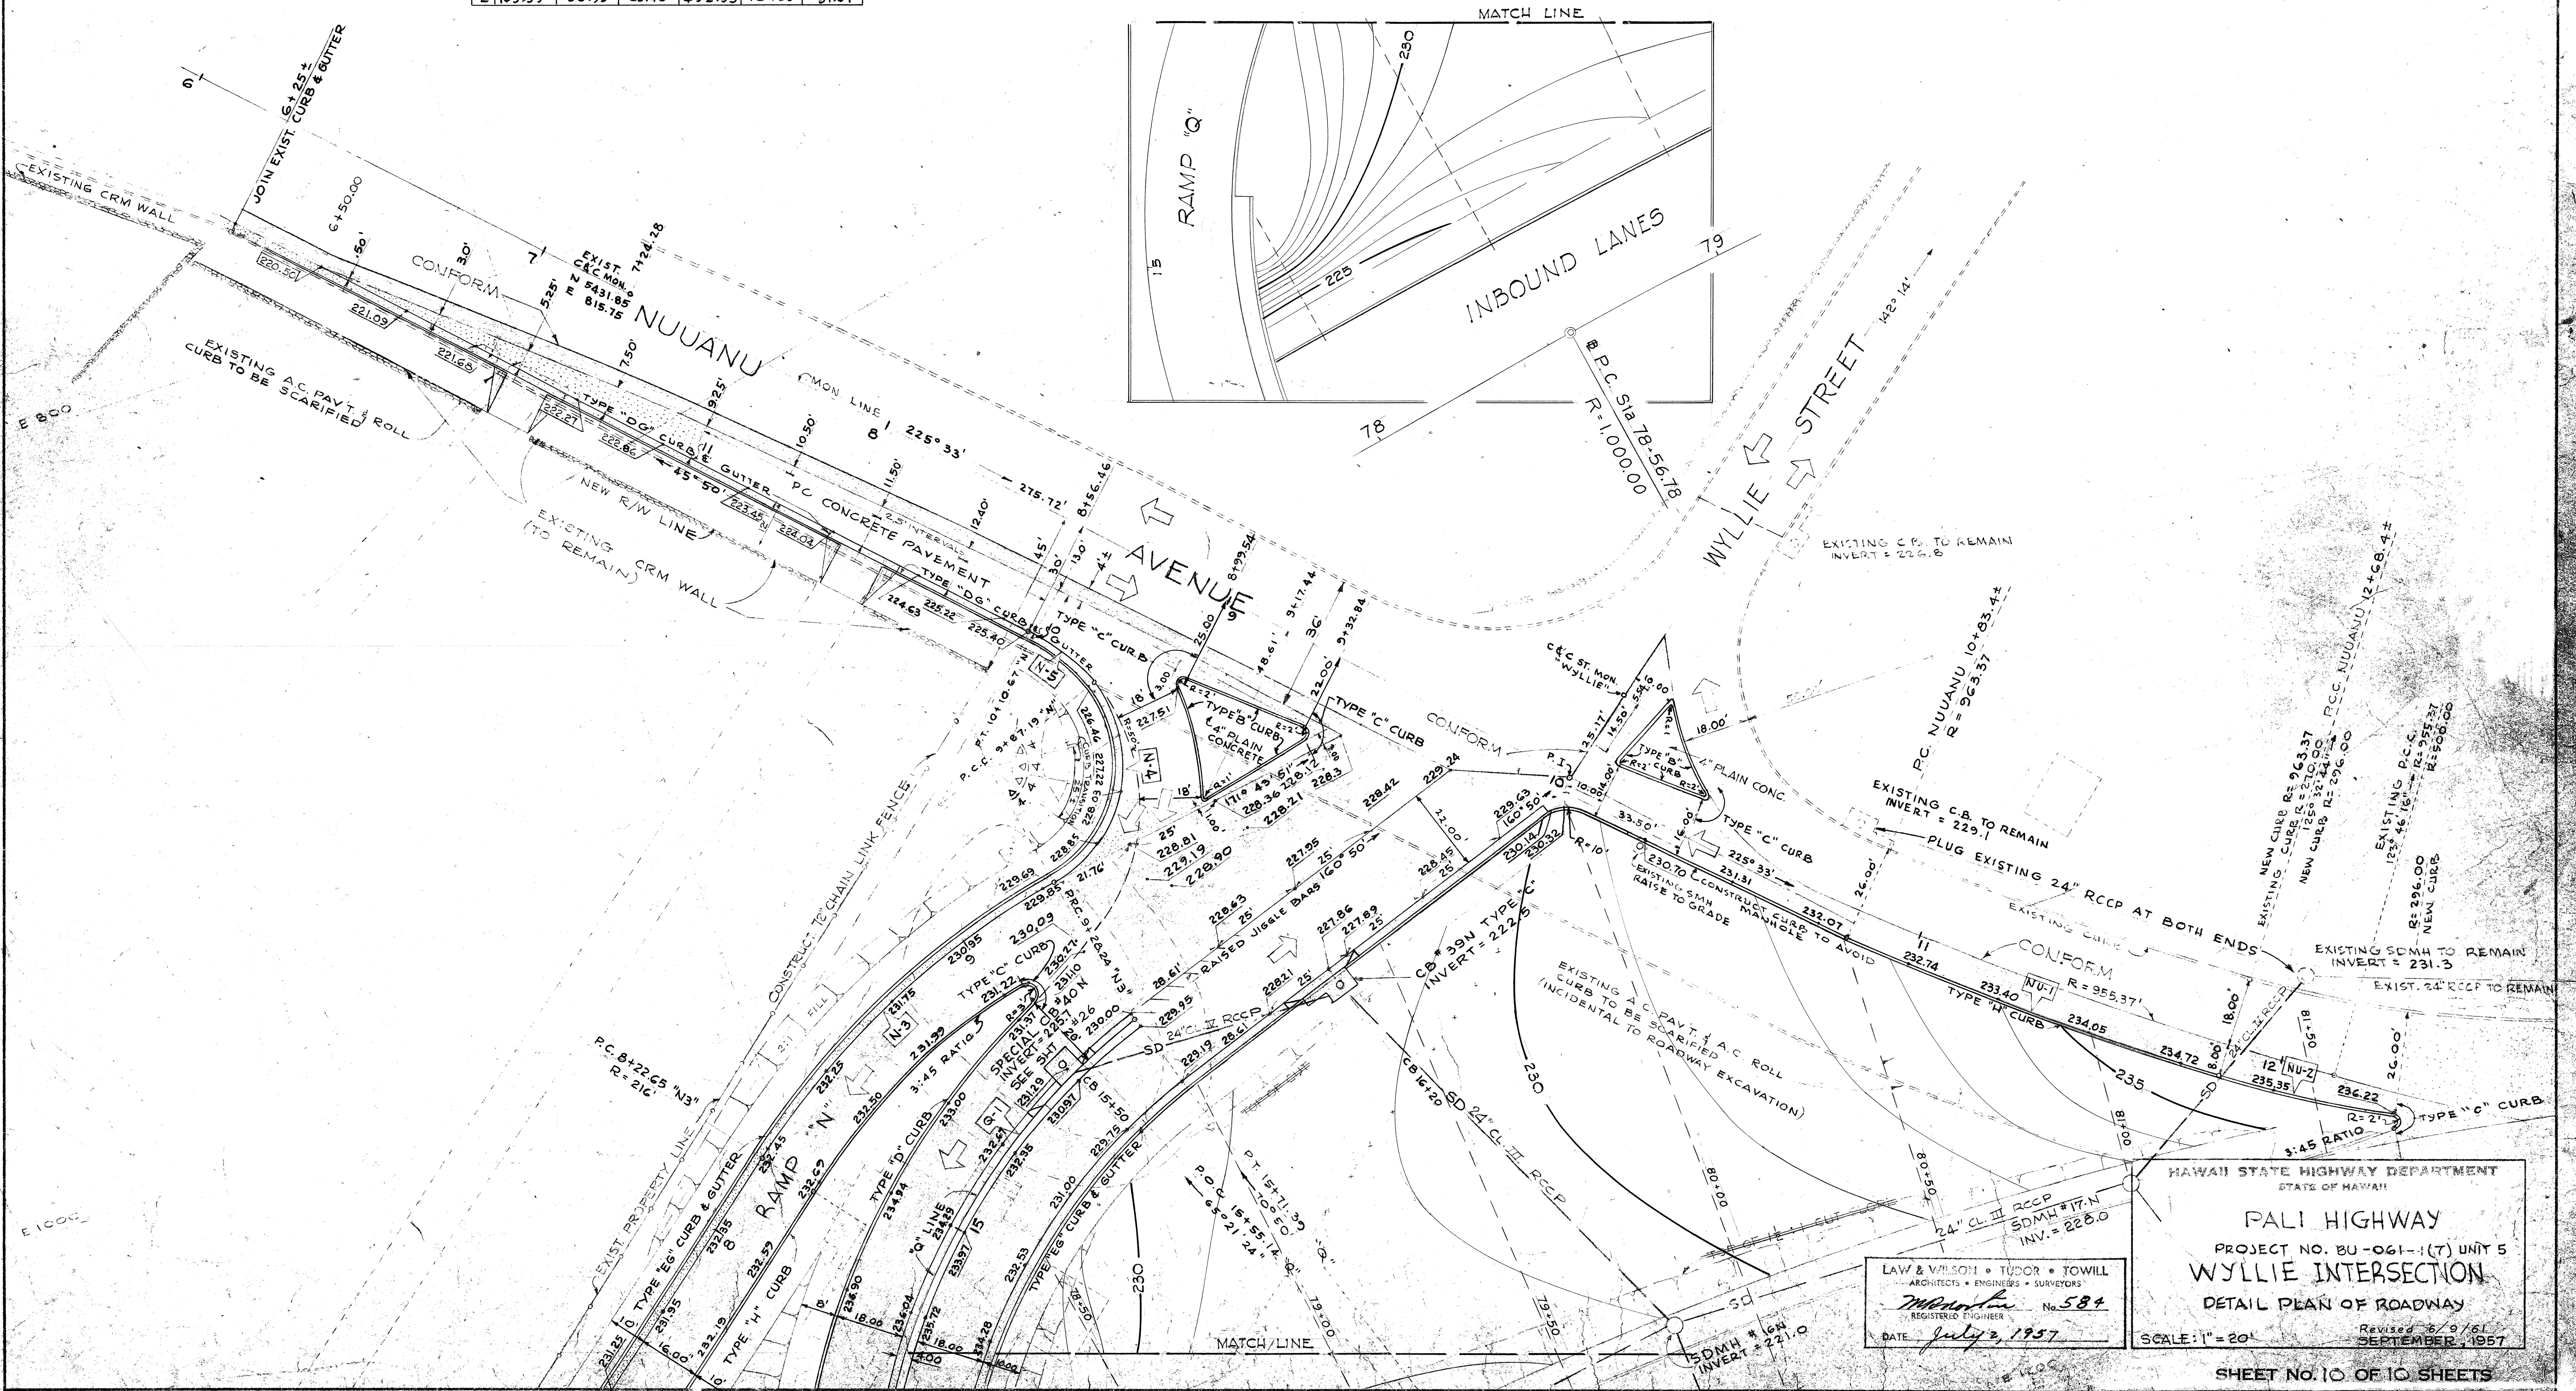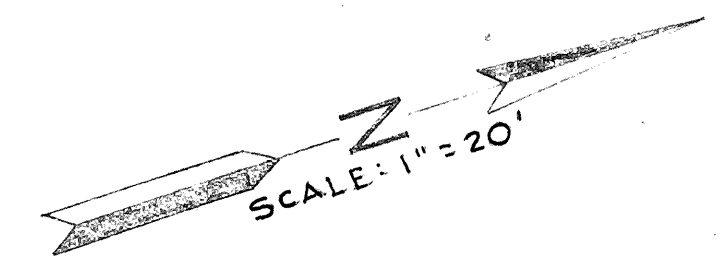

DATE	DESIGNED BY	CHECKED BY
ORIGINAL PLAN	DRAWN BY	NOTED BY
NOTE BOOK	QUANTITIES CHECKED BY	

LAW & WILSON • TUDOR • TOWILL
ARCHITECTS • ENGINEERS • SURVEYORS
McDonnell
REGISTERED ENGINEER No. 584
DATE July 3, 1957

HAWAII STATE HIGHWAY DEPARTMENT
STATE OF HAWAII
PALI HIGHWAY
PROJECT NO. BU-061-1(7) UNIT 5
WYLLIE INTERSECTION
DETAIL PLAN OF ROADWAY
Revised 8/9/51
SEPTEMBER, 1957
SCALE: 1" = 20'


SHEET NO. 10 OF 10 SHEETS

B.8147.23A

THIS SHT. SUPERCEDES SHT. No.
B.8147.23 DTD. SEPT. 1957.

A hand-drawn diagram of a line with arrows at both ends, labeled 'Z' and 'SCALE: 1" = 20''.

DETAIL FOR
SPECIAL CATCH BASIN
SCALE = 1/2" = 1'-0"

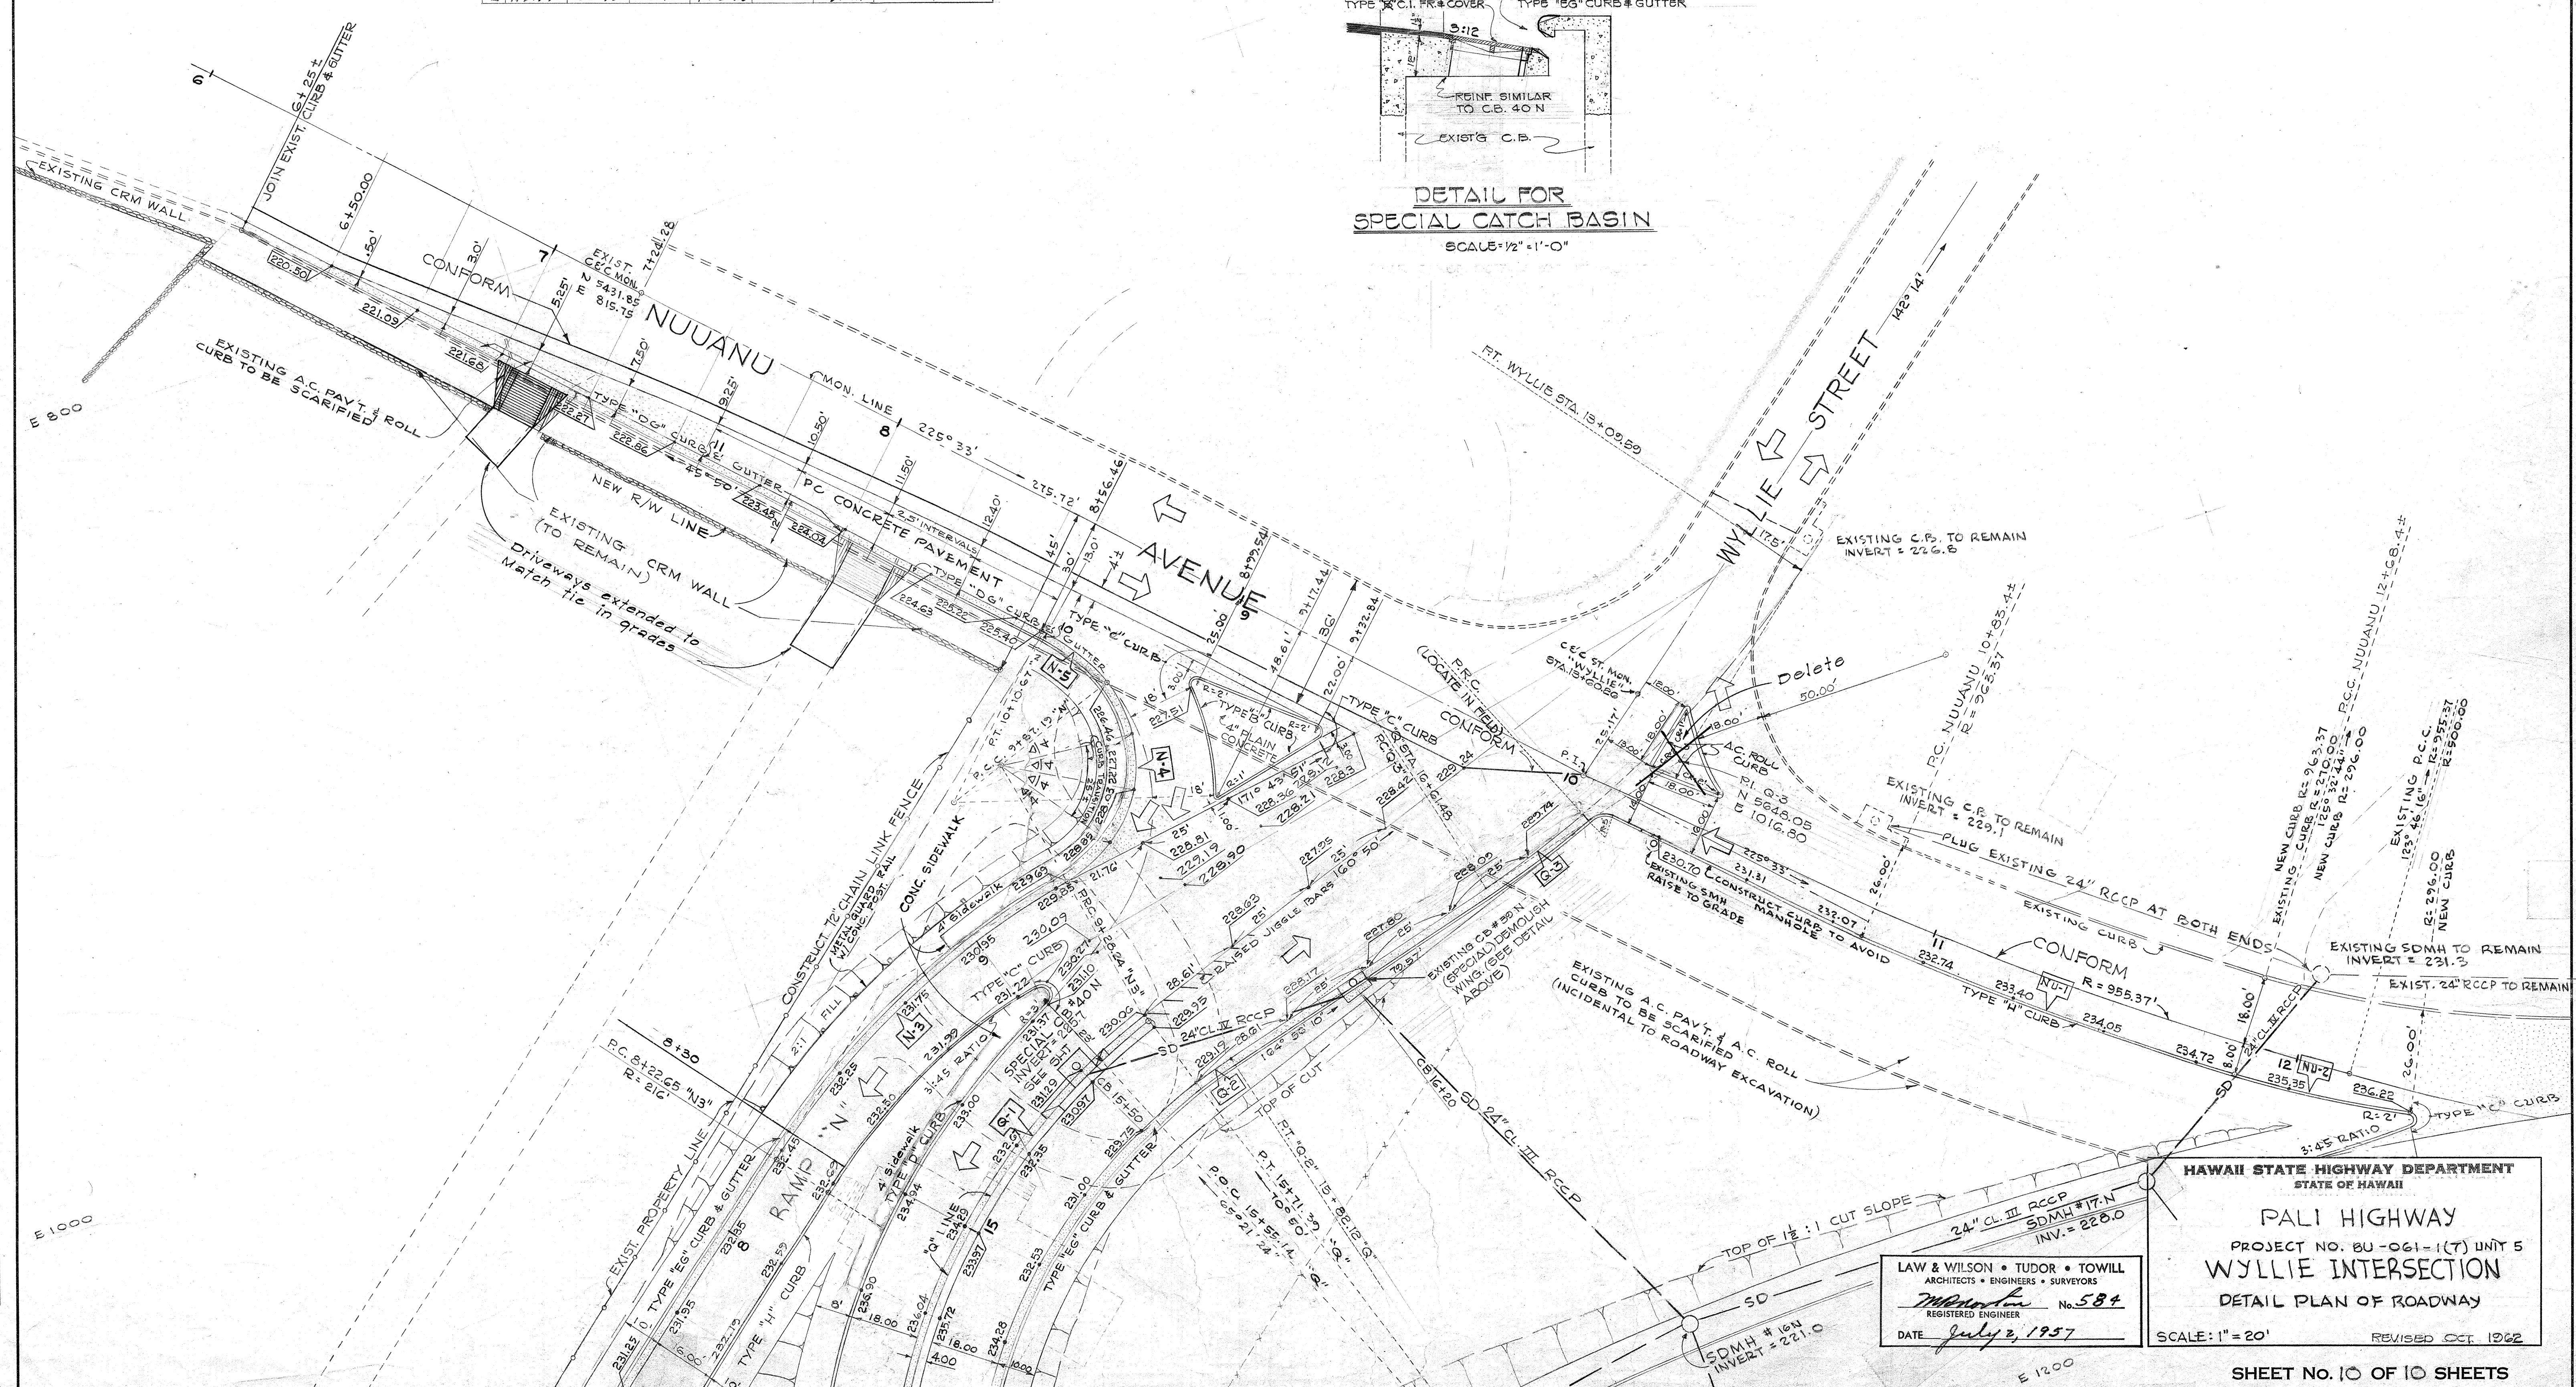

ORIGINAL PLAN	SURVEY PLOTTED BY _____ DESIGNED BY <u>hcs</u> DRAWN BY _____ TRACED BY _____ QUANTITIES BY _____ QUANTITIES CHECKED BY _____ CHECKED BY <u>C.N.</u>	DATE _____ " _____ " _____ " _____ " _____ " _____ " _____
NOTE BOOK No.		

3:45 PM

HAWAII STATE HIGHWAY DEPARTMENT
STATE OF HAWAII

PALI HIGHWAY

PROJECT NO. BU-061-(7) UNIT 5

WYLLIE INTERSECTION

DETAIL PLAN OF ROADWAY

SCALE: 1" = 20'

REVISED OCT. 1962

SHEET No. 10 OF 10 SHEETS

B. S 147. 23 A