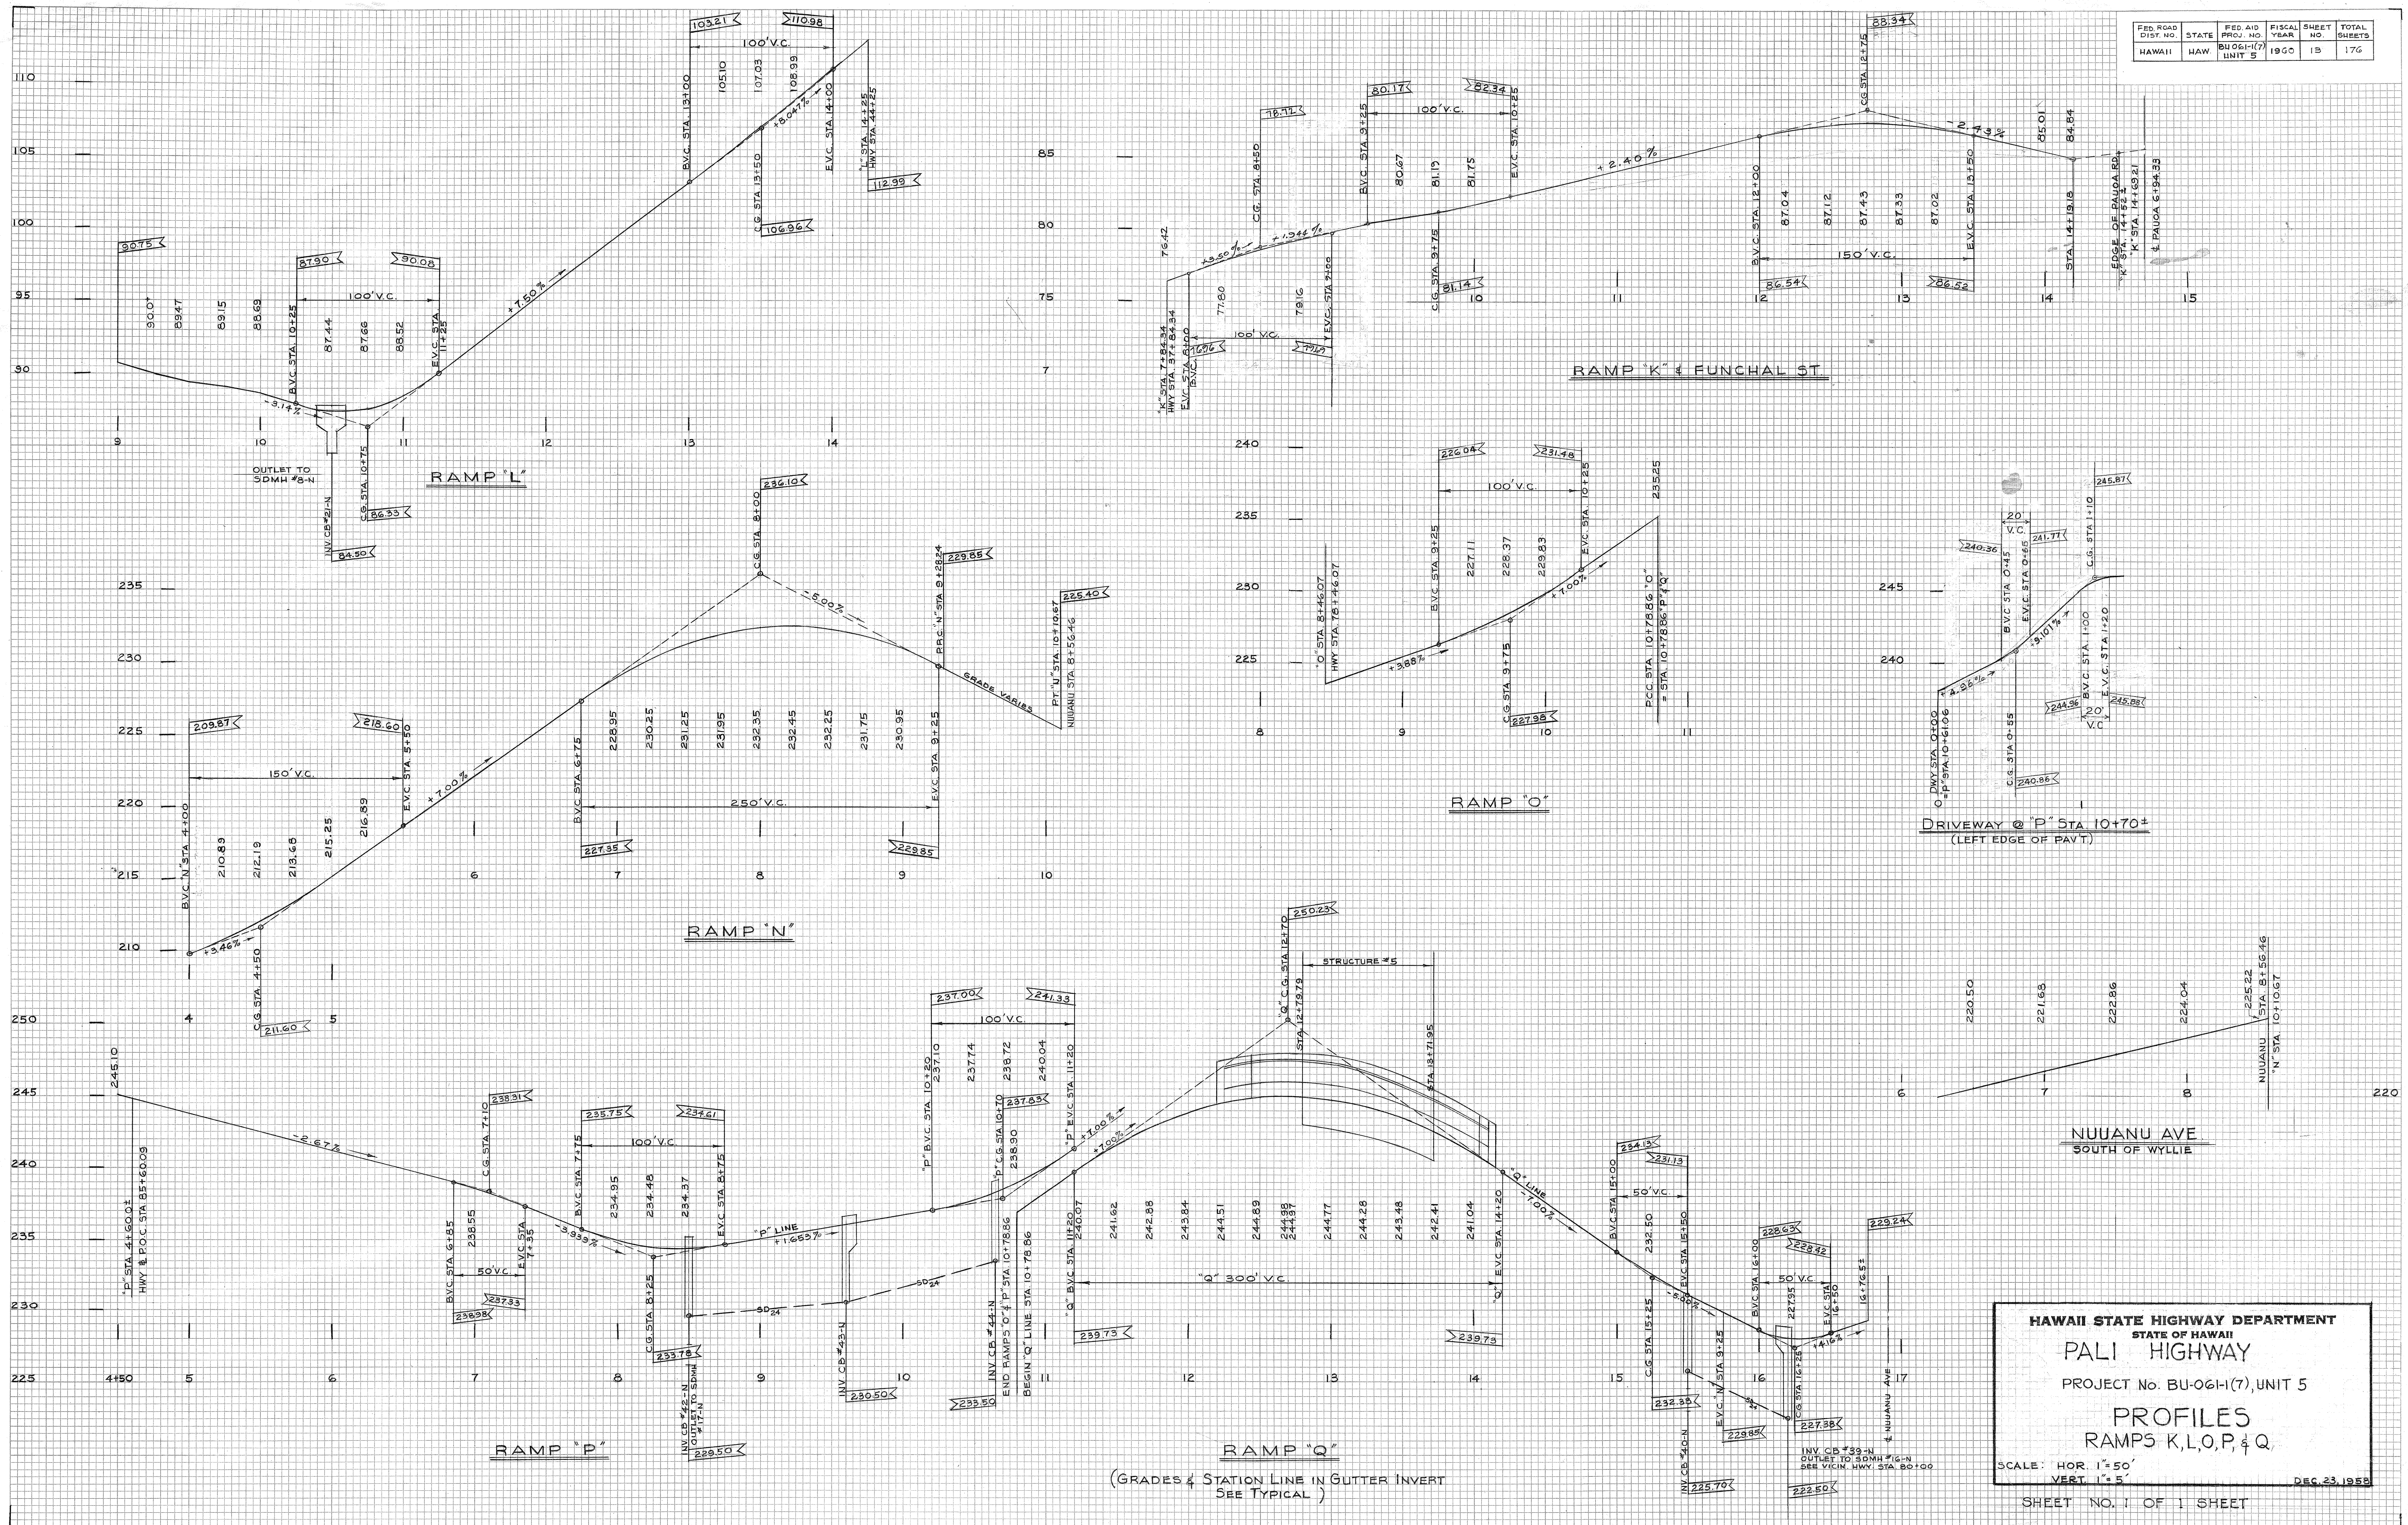


FINAL SURVEY		BY	DATE
SURVEYED _____			
PLOTTED _____			
NOTE BOOK _____			
TEMPLATE _____			
AREAS _____			
AREAS CHECKED _____			
NO. _____			

[illegible]

HAWAII STATE HIGHWAY DEPARTMENT
STATE OF HAWAII
PALI HIGHWAY
PROJECT No. BU-06H(7), UNIT 5
PROFILES
RAMPS K, L, O, P, & Q.
SCALE: HOR. 1"=50'
VERT. 1"=5'
DEC. 23, 1958
SHEET NO. 1 OF 1 SHEET