



FED. ROAD DIST. No.	STATE	FED. AID PROJ. No.	FISCAL YEAR	SHEET No.	TOTAL SHEETS
HAWAII	HAW.	BU-OGI-1 (T) UNIT 5	1960	59A	176

GENERAL NOTES


1. Exact location of Cement Asbestos Conduits to be determined in the field by the Engineer.
2. Pavement markings by others.
3. Existing Traffic Signal Equipment to be returned to the Department of Traffic, C & C of Honolulu.

LEGEND



- Future Traffic Signal Standard
- Future Controller Box
- Future Cement Asbestos Conduit (Size indicated)
- New Cement Asbestos Conduit (Size indicated)
- ▨ Pedestrians Crossing
- Power Pole
- ⊙ Existing Traffic Light on Utility Pole
- ⊙ Existing Traffic Light Standard

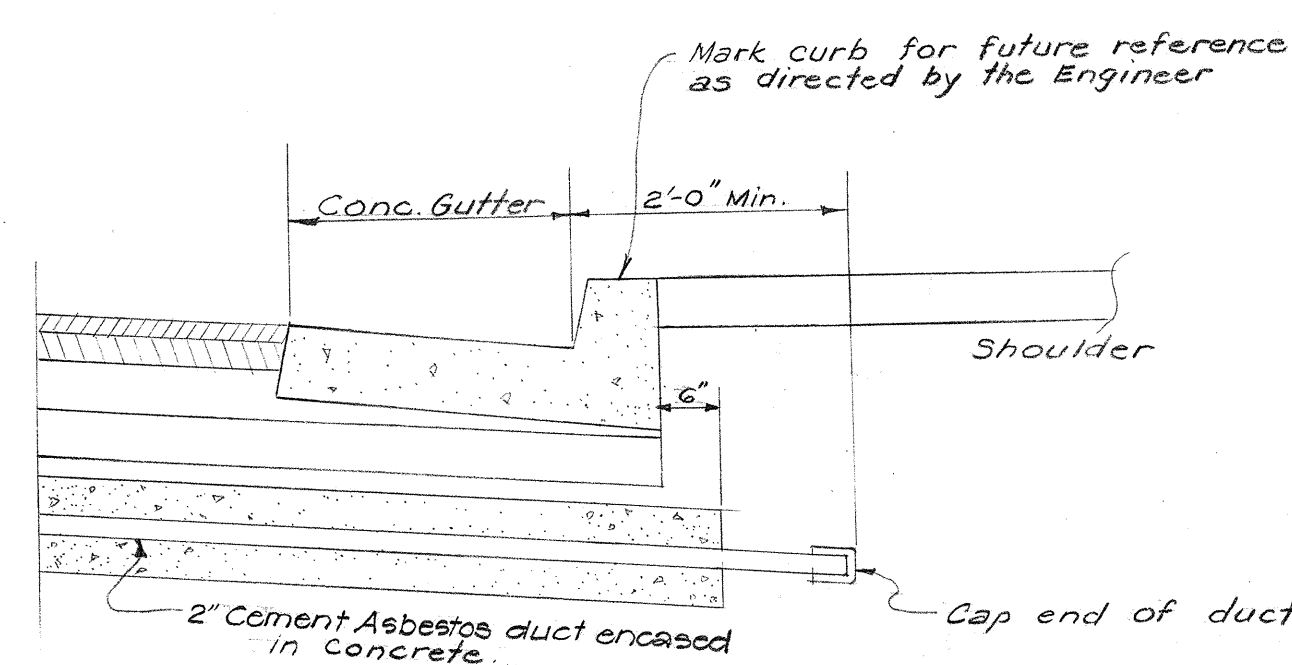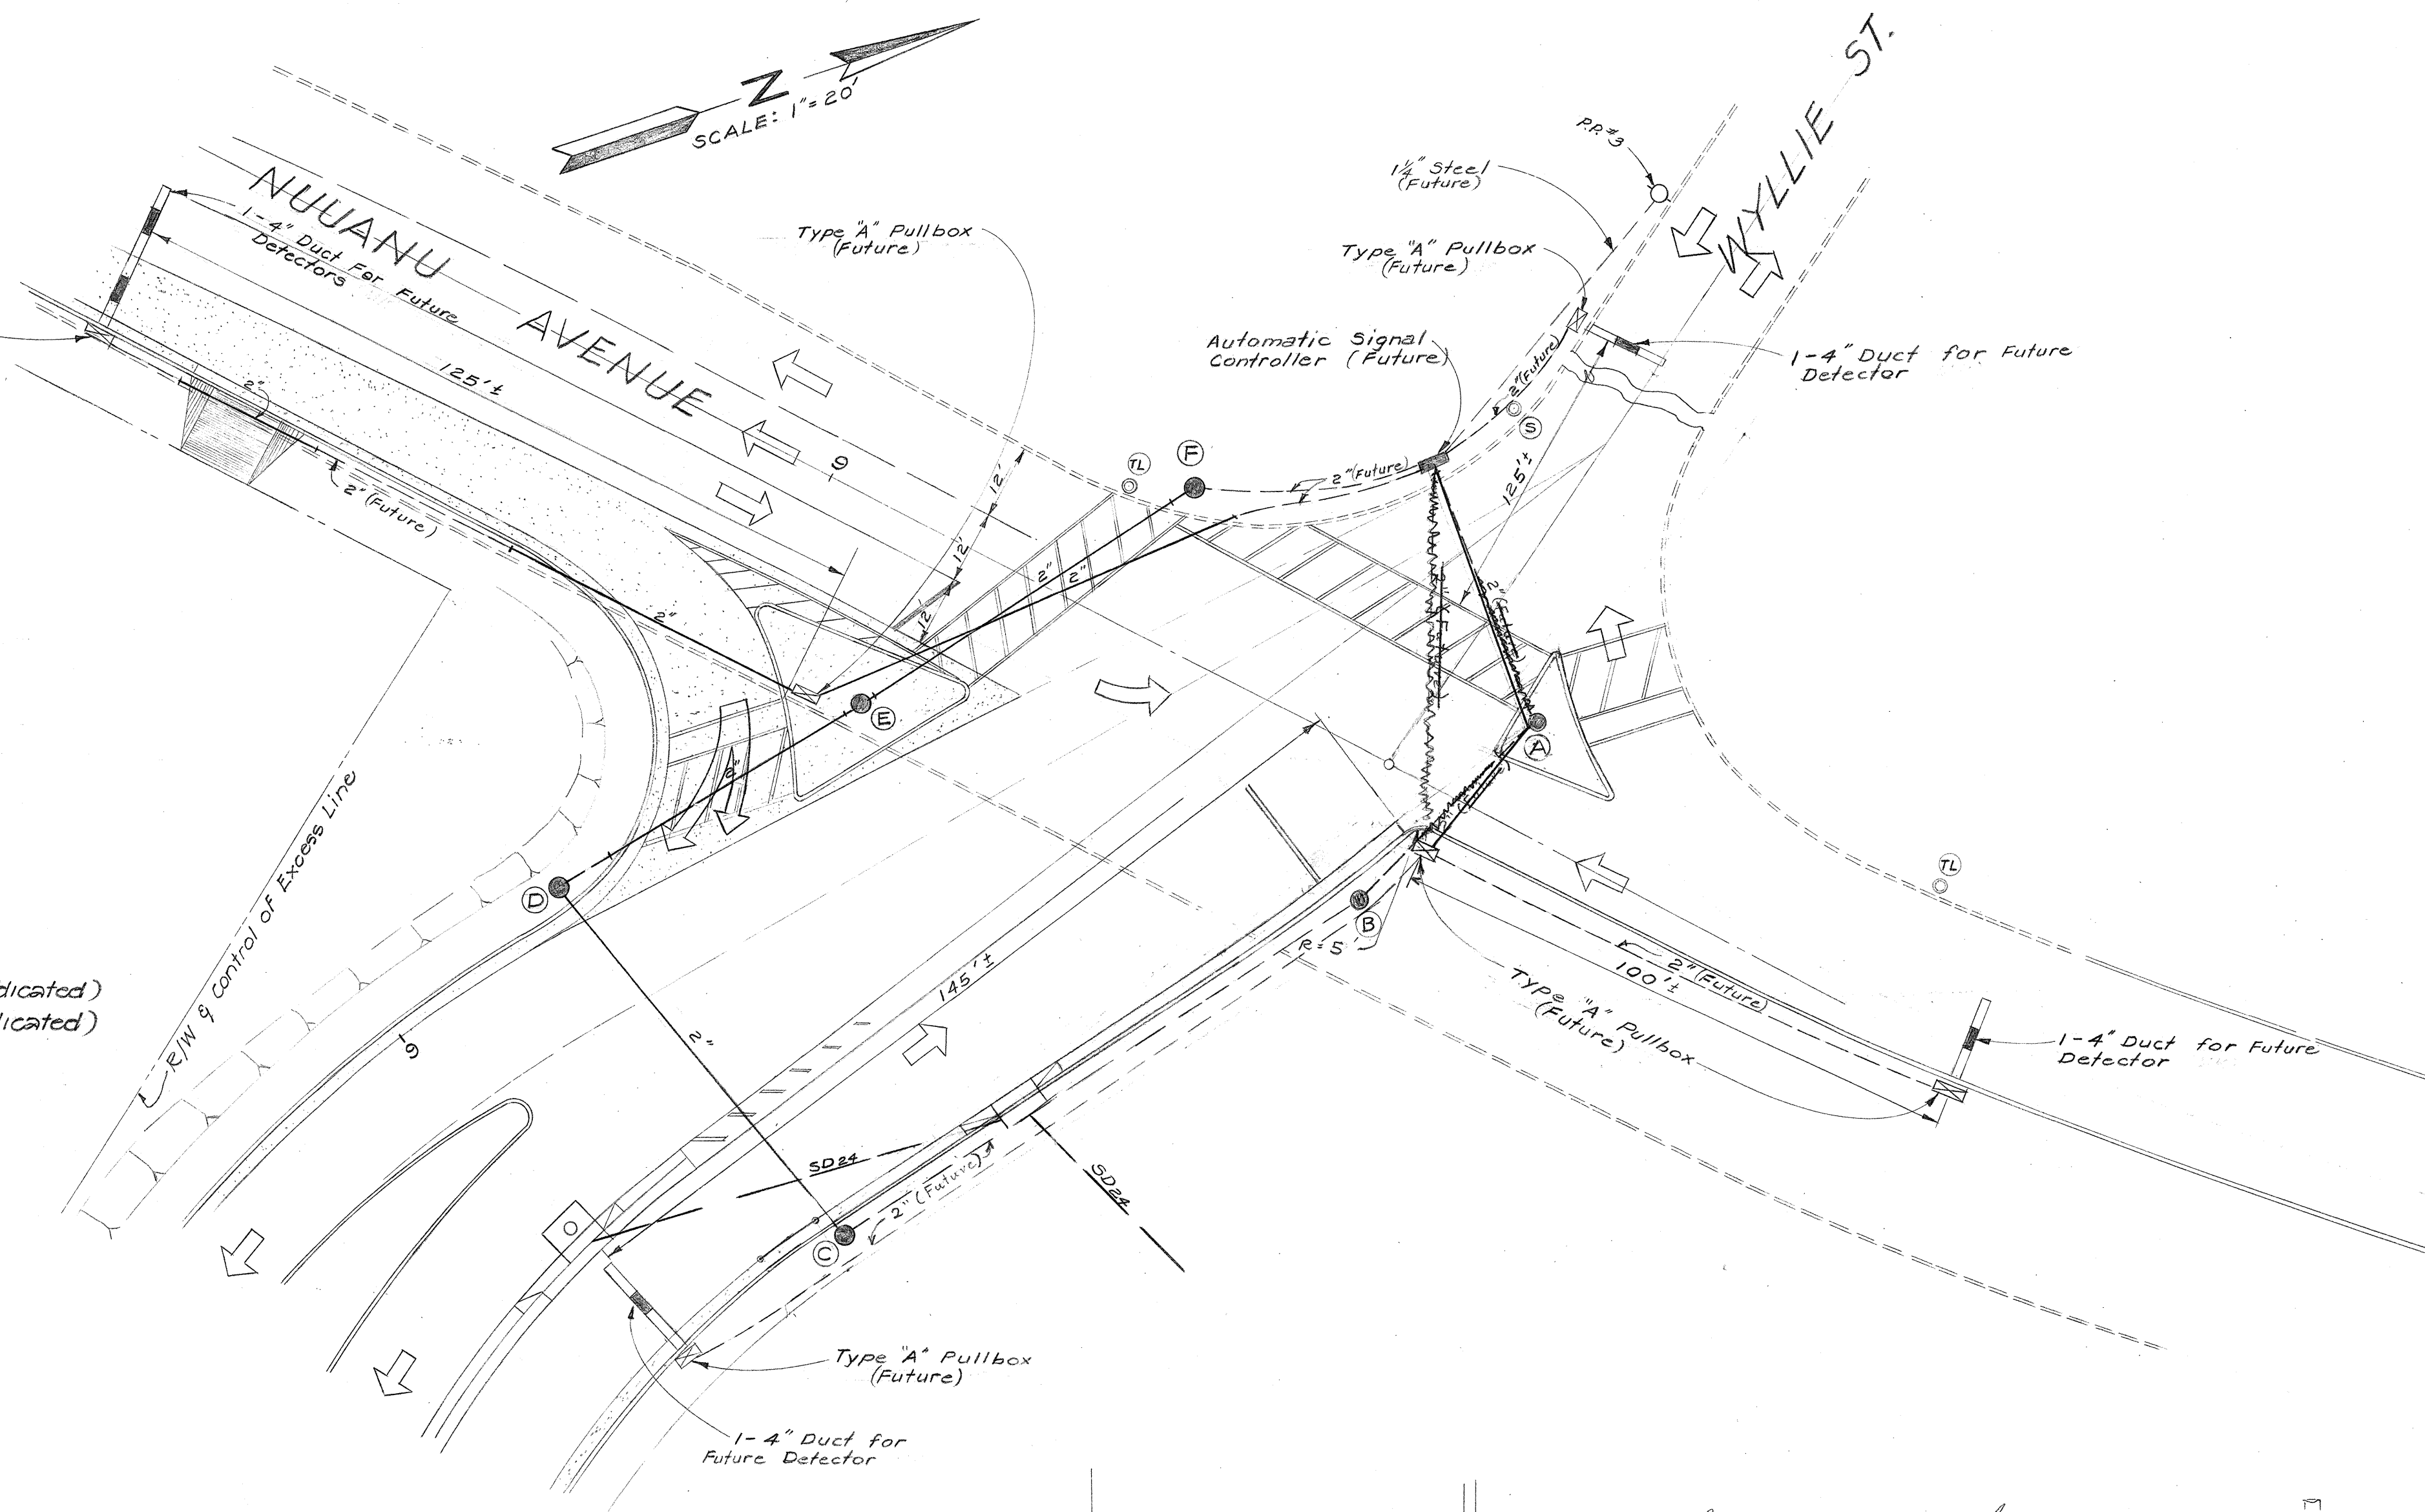

TYPICAL DETAIL OF
CEMENT ASBESTOS CONDUIT ENDS
Scale: 3/4" = 1'-0"

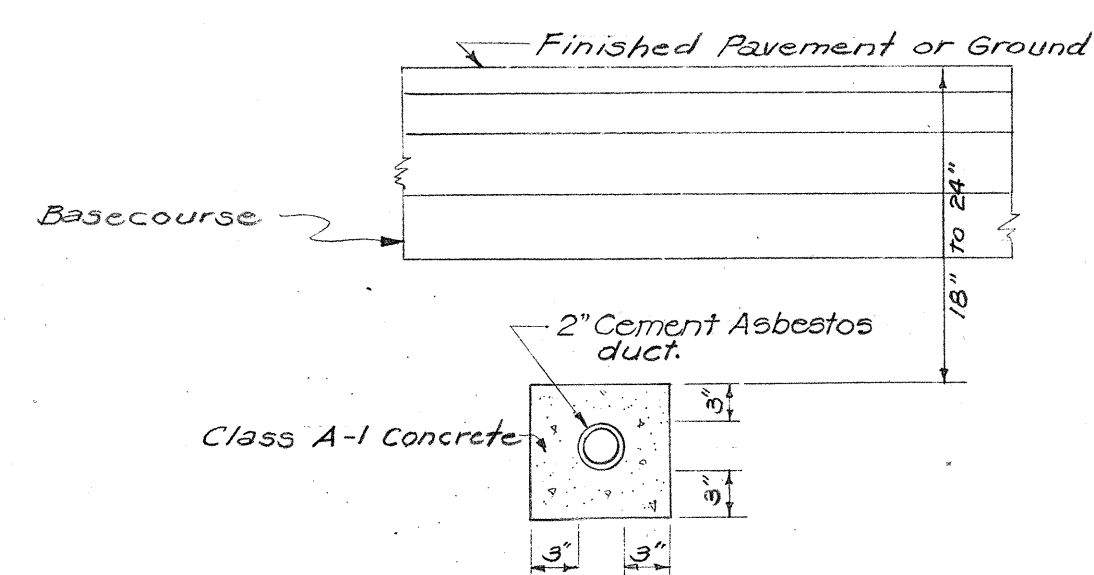

DETAIL OF CONCRETE
ENCASED CONDUIT
Scale: 1 1/2" = 1'-0"

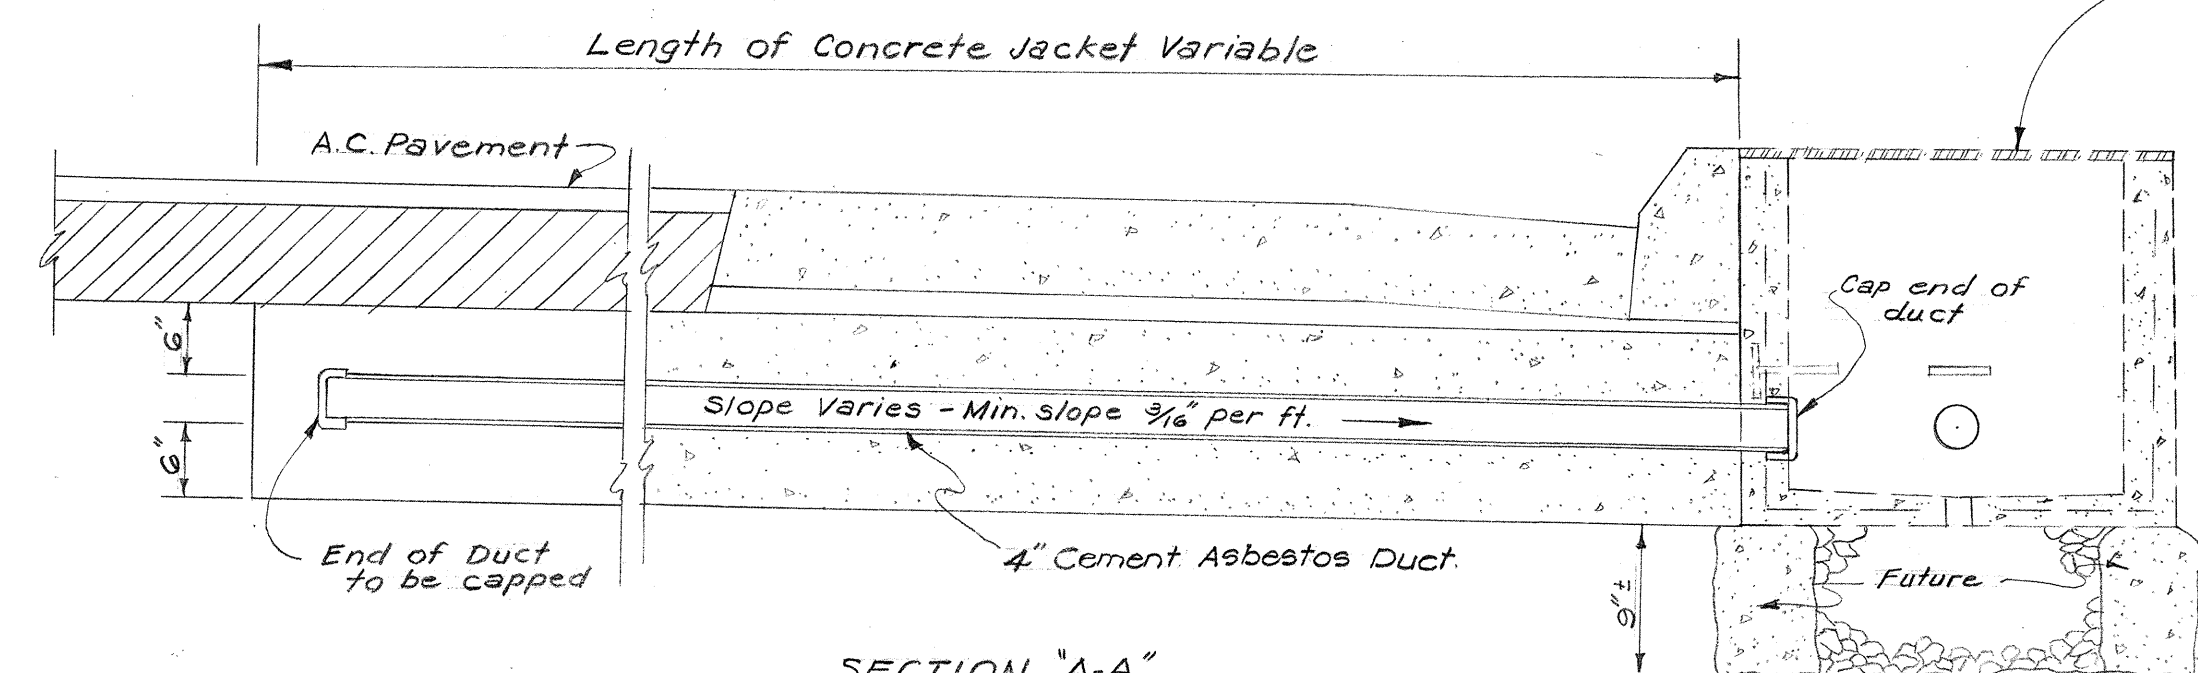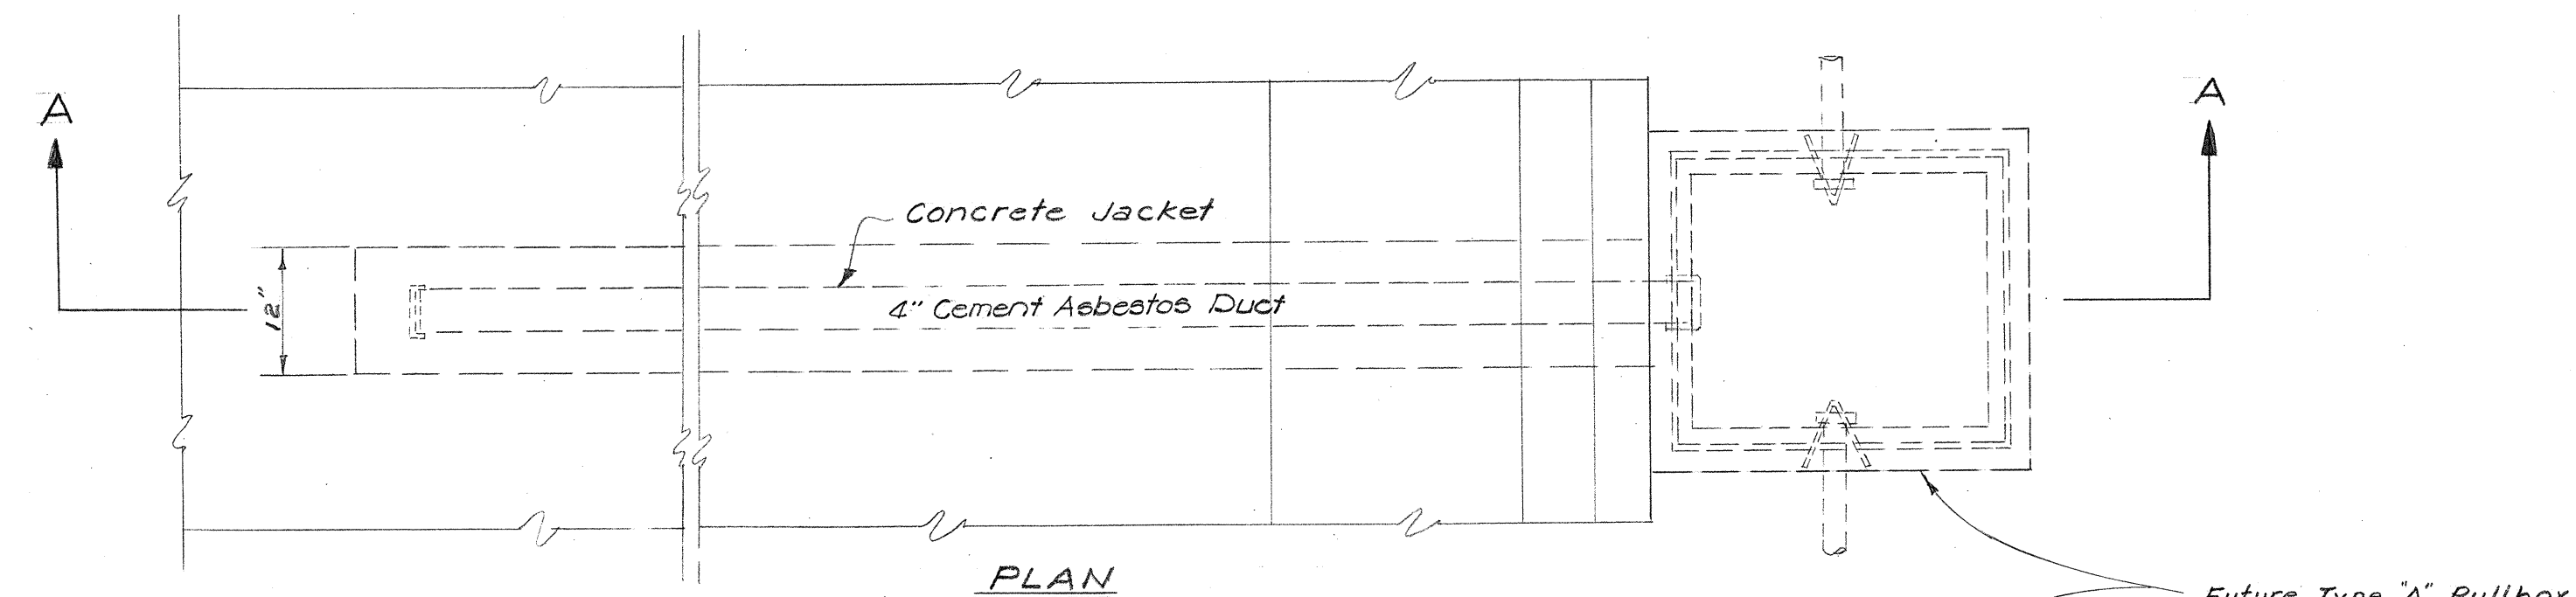

SECTION 'A-A'
DETAIL OF CEMENT ASBESTOS DUCTS
FOR MAGNETIC DETECTORS
Scale: 3/4" = 1'-0"

NOTE: This Sheet Supersedes Sheet No.
B.8147.59 Dated January, 1960.

HAWAII STATE HIGHWAY DEPARTMENT
STATE OF HAWAII

DUCT INSTALLATION FOR
FUTURE TRAFFIC SIGNAL SYSTEM
WYLLIE ST. & NUUANU AVE.

PROJ. No. BU-OGI-1 (T) UNIT 5

REVISED SHEET
DATE: OCTOBER 1962

SHEET No. 1 OF 1 SHEETS

B.8147.59