
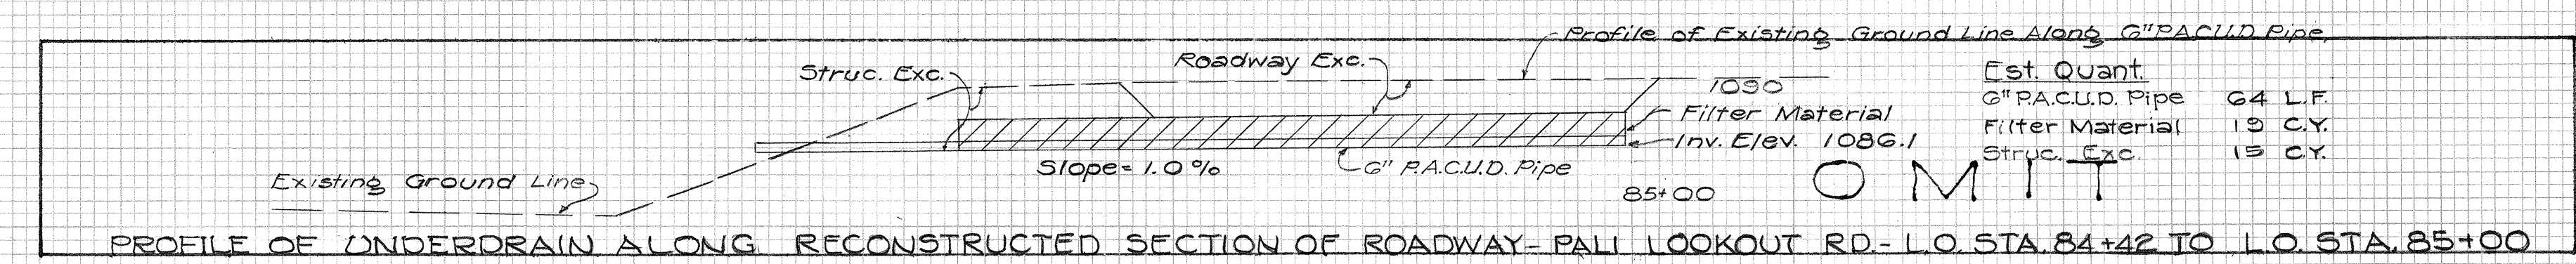
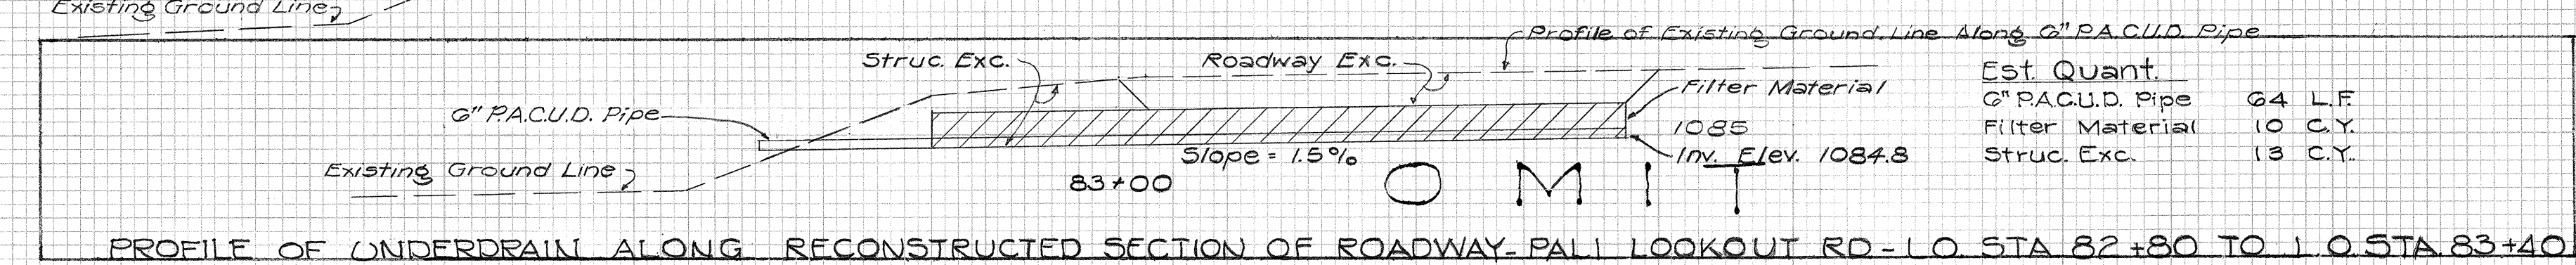
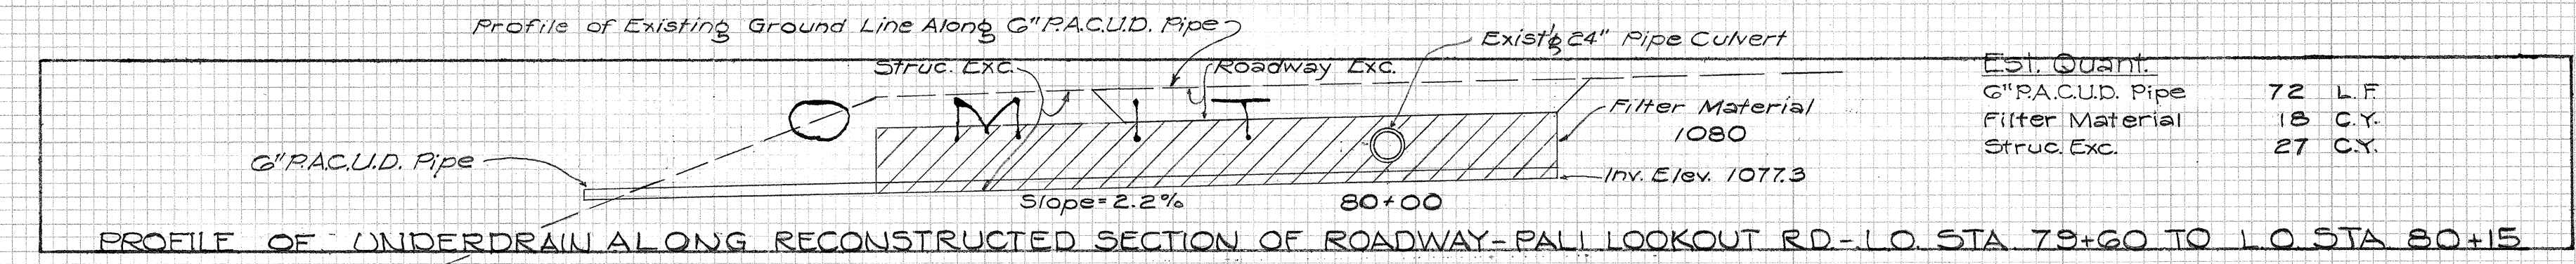
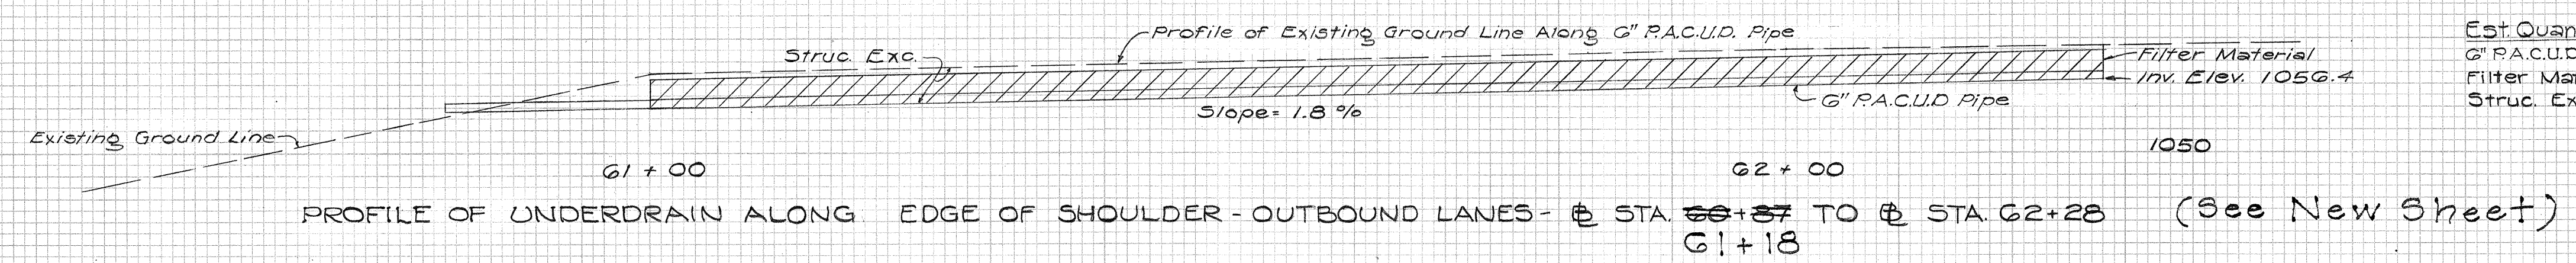
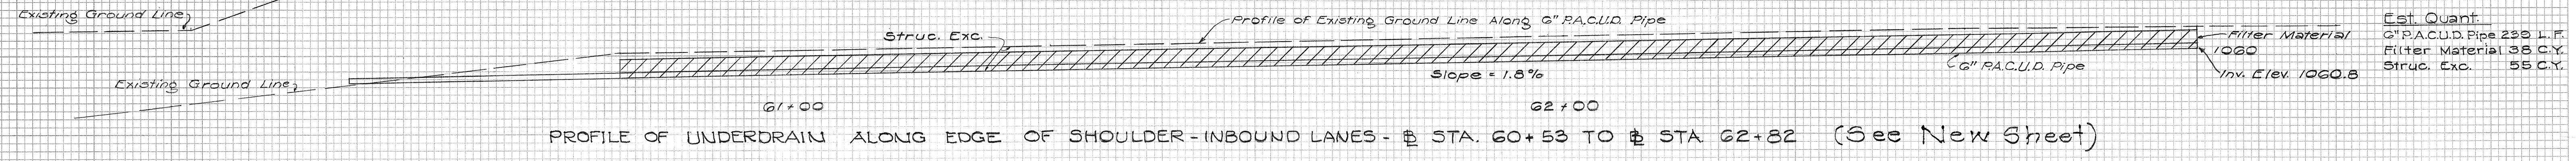
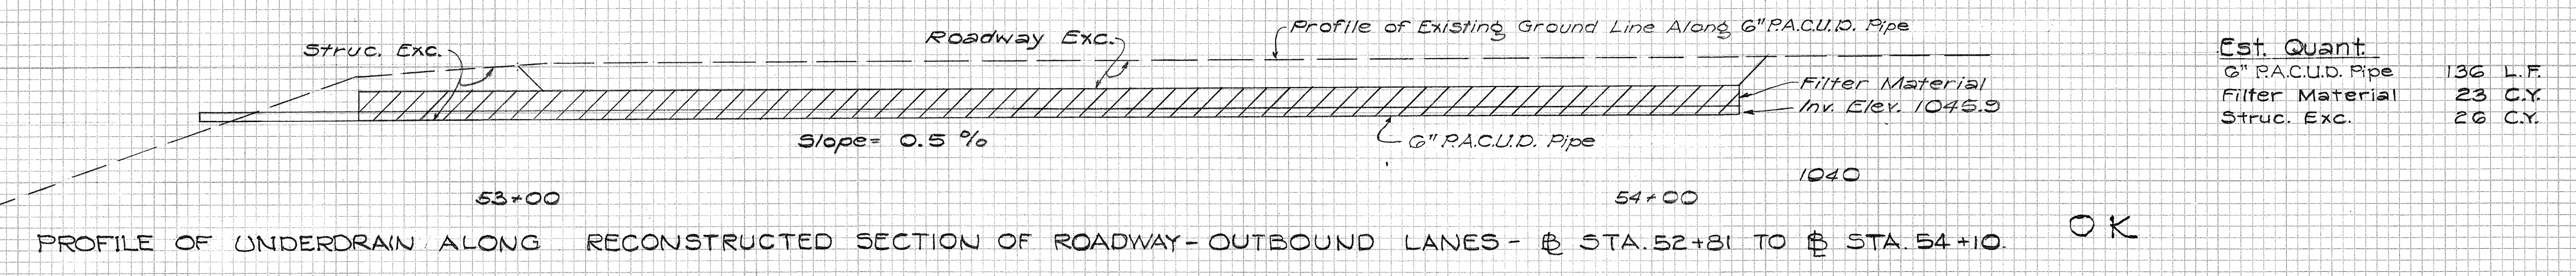
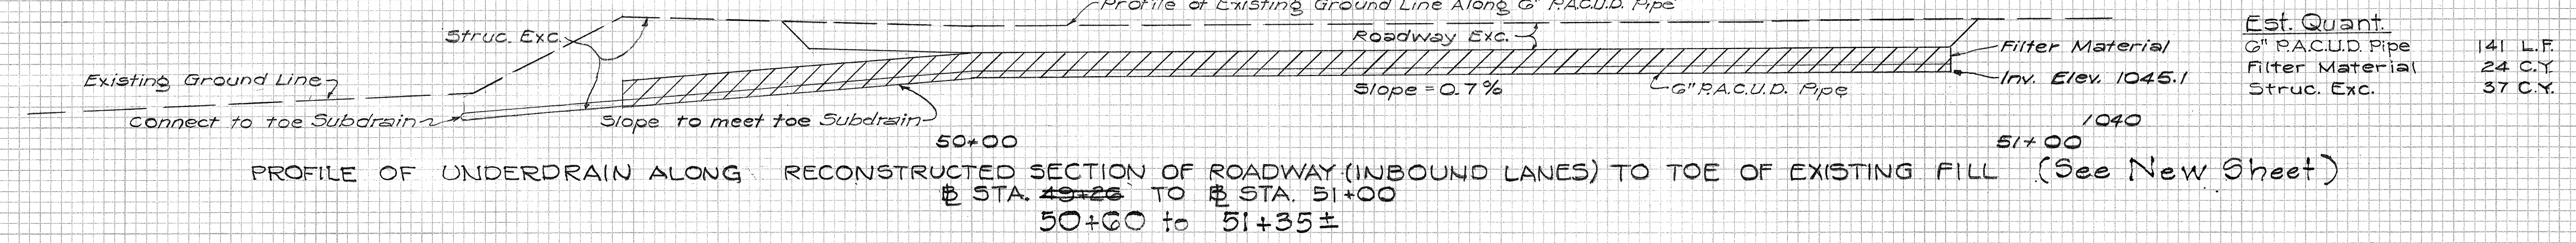


FED. ROAD DIST. No.	STATE	FED. AID PROJ. No.	FISCAL YEAR	SHEET No.	TOTAL SHEETS
HAWAII	HAW.	BF-061-111	1960	9	24

DATE	BY	NO.
FINAL SURVEY	SURVEYED	PLOTTED
NOTE BOOK	TEMP. PLATE	AREAS CHECKED

DATE	BY	NO.
ORIGINAL SURVEY	SURVEYED	PLOTTED
NOTE BOOK	TEMP. PLATE	AREAS CHECKED

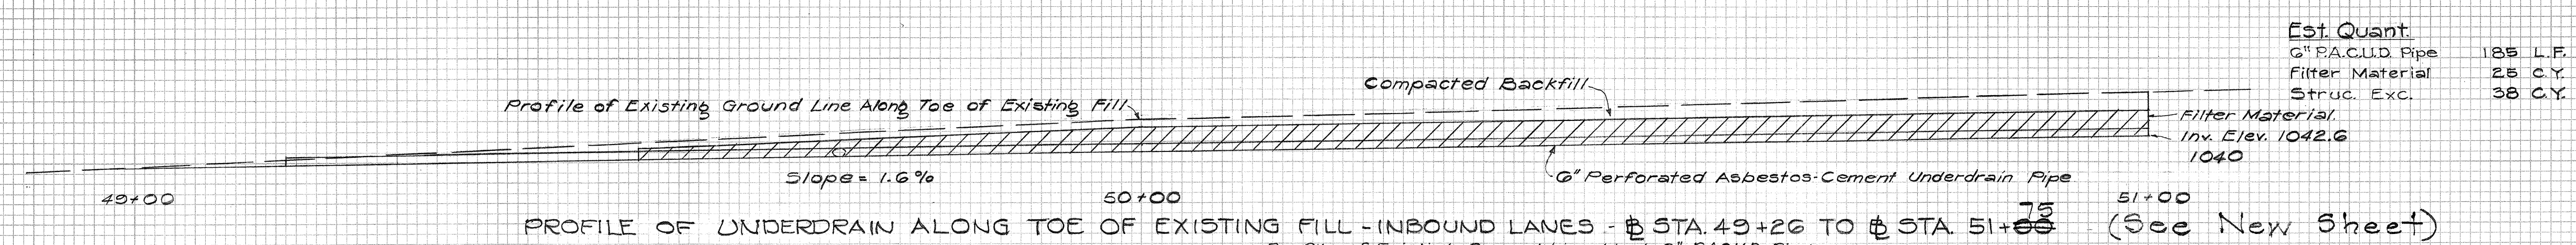

NOTE:
L.O. STA. = PALI LOOKOUT ROAD STATION

PROFILE OF UNDERDRAINS
Scale: Hor: 1" = 10'
Vert: 1" = 10' Oct 27, 1960

