


INDEX TO DRAWINGS	
SHEET NO.	DESCRIPTION
1	TITLE SHEET
2-3	TYPICAL SECTIONS
4-7	ROADWAY PLANS
8	PAVEMENT GRADE PLAN
9	PROFILE OF UNDERDRAINS
10	DETAILS OF CONCRETE SPILLWAY AND UNDERDRAINS
11	DETAILS OF METAL GUARD RAIL
12-15	TRAFFIC ROUTING PLAN, DIRECTIONAL, REGULATORY, AND WARNING SIGNS
18	CROSS SECTION
19-24	STANDARD DETAILS

CONVENTIONAL SIGNS	
Centerline	125
Boundary Lines	Or
Fences (Named)	
Existing Roadways	
Circular Culvert	
Box Culvert	
Bridge	
Telephone Pole	
Electric Power Pole	
Water Main	W ₂ (W ₄ , 8, 12, Etc.)
Storm Drain	SD ₁₂ (SD ₁₈ , 24, Etc.)
Concrete Drop Intake	
Standard Catch Basin	
Standard Manhole	M.H.S.
Sewer Manhole	S.M.H.
Telephone Manhole	T.M.H.
Fire Hydrant	F.H.
Tree (Large, named)	Mano
Railroad	
Haw'n Telephone Underground Cable	HTC
Water Meter	WM

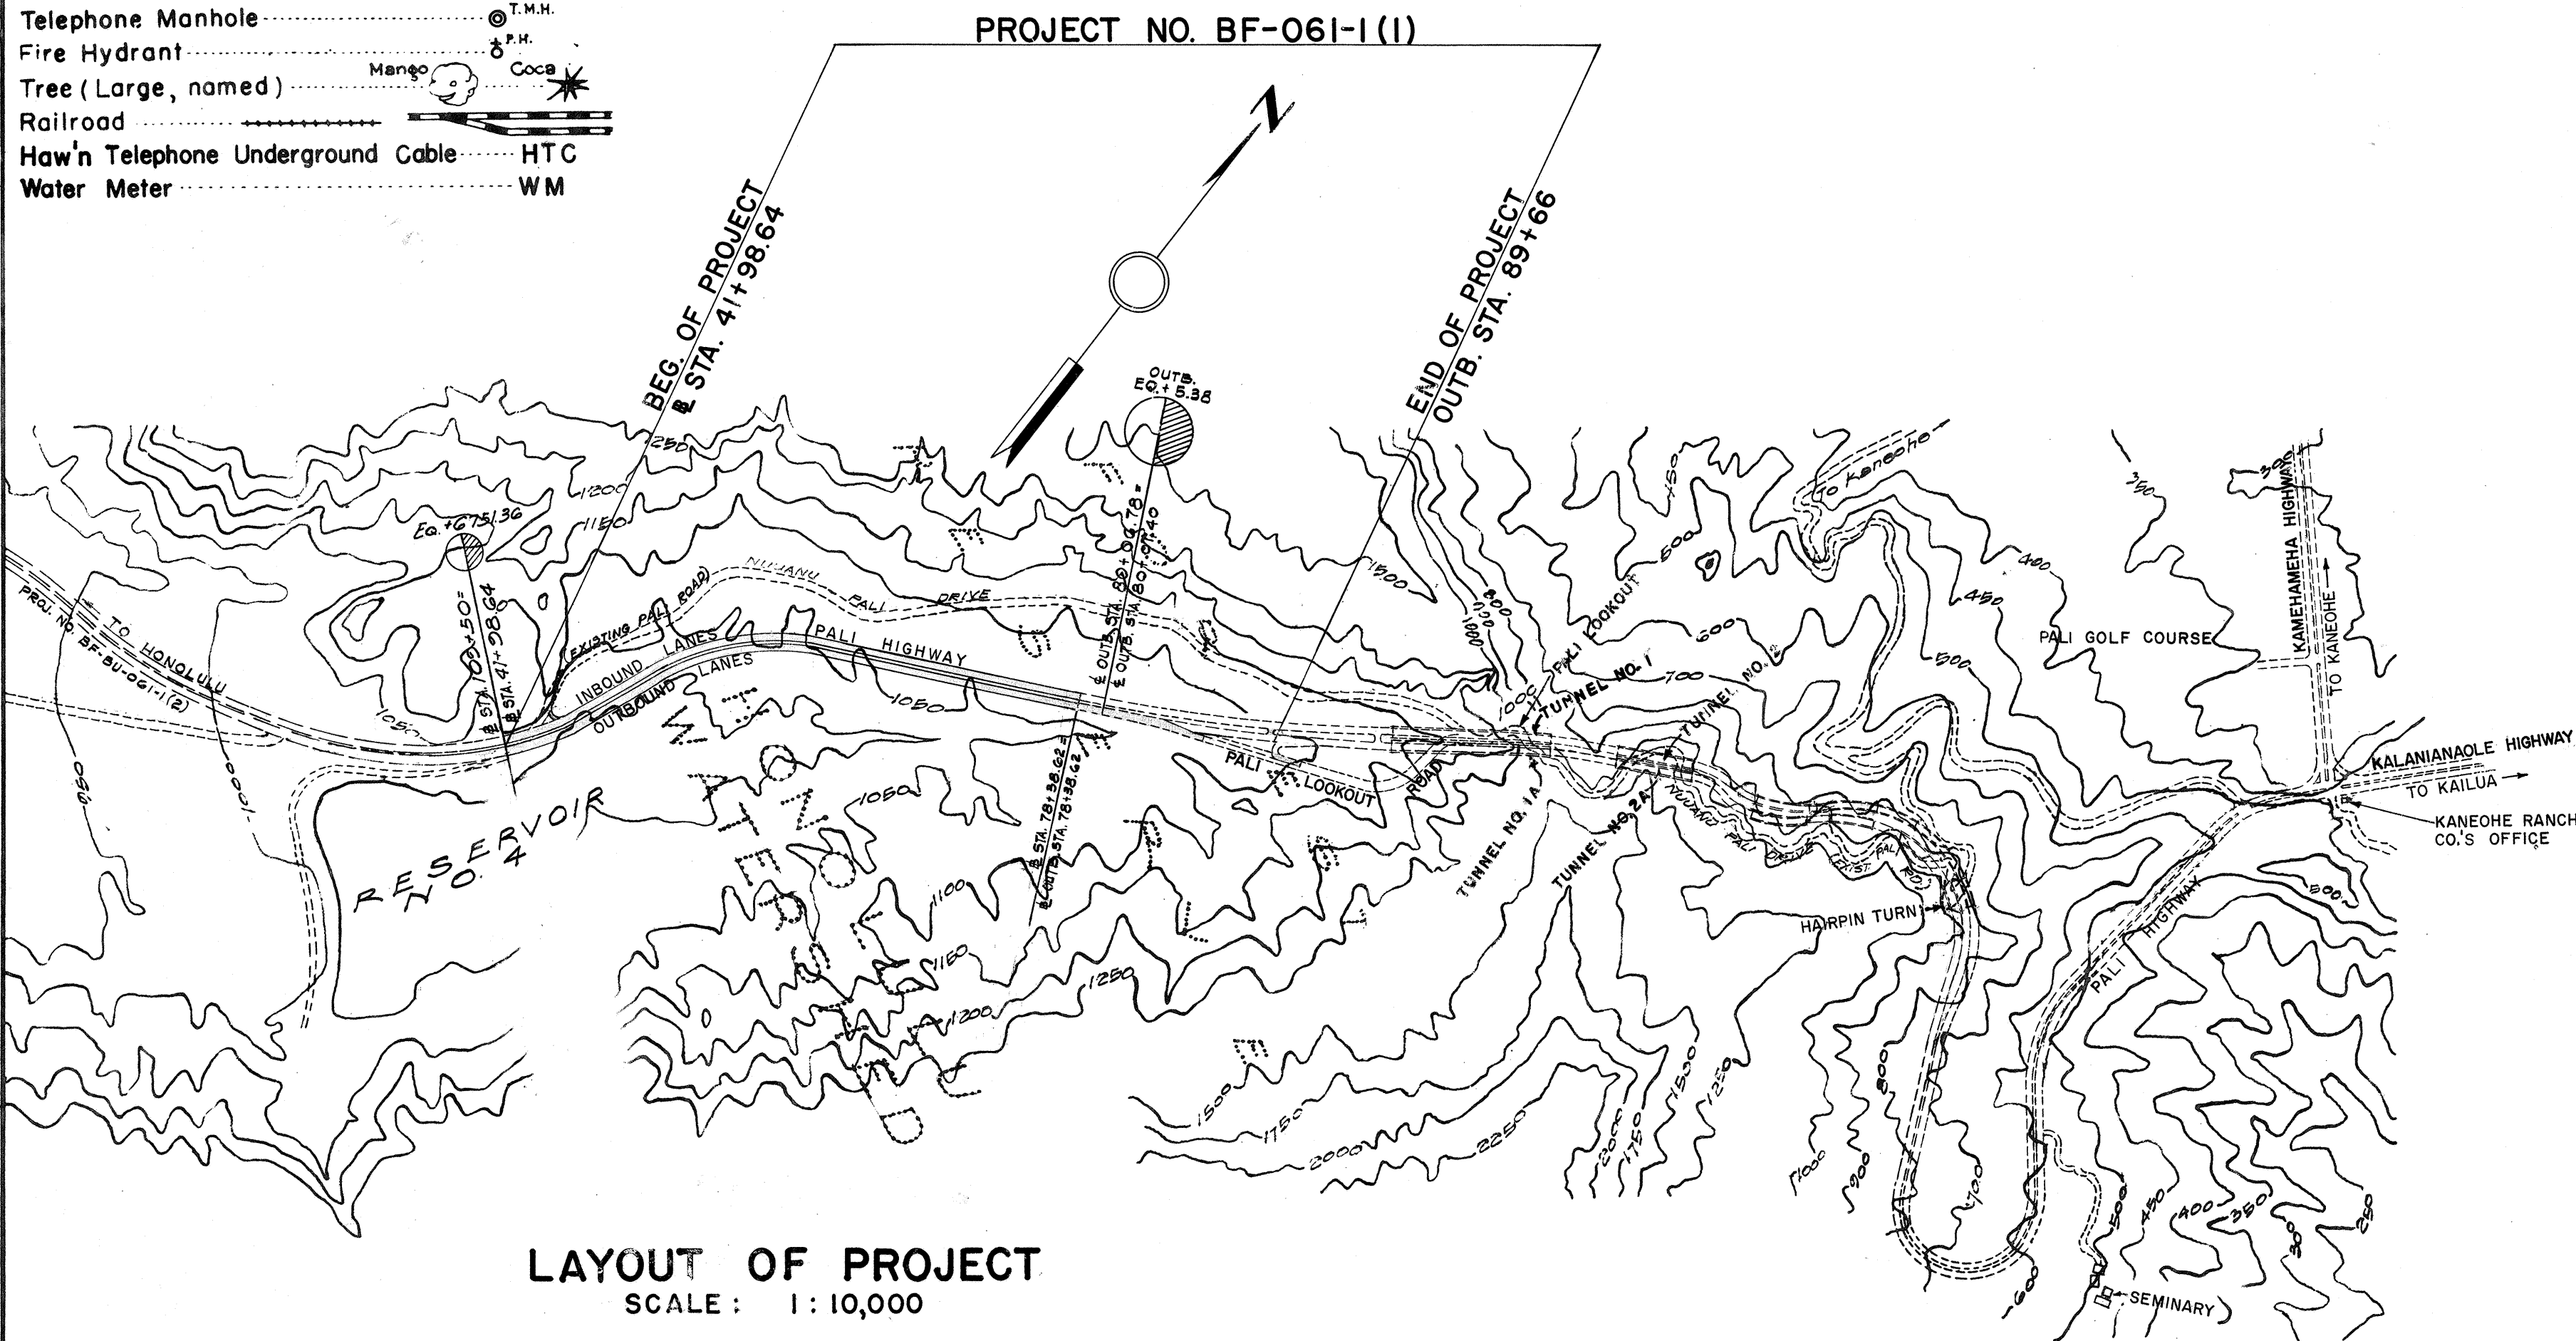


LAYOUT OF PROJECT
SCALE: 1:10,000

Gross and Net Length of Project-----0 904 M¹c

STATE OF HAWAII
DEPARTMENT OF TRANSPORTATION
DIVISION OF HIGHWAYS
HONOLULU, OAHU, HAWAII
AS BUILT
PLANS OF
RECONSTRUCTING, WIDENING, AND RESURFACING
OF A PORTION OF PALI HIGHWAY
FEDERAL AID PROJECT NO. BF-061-I(1)
DISTRICT OF HONOLULU
ISLAND OF OAHU

SCALES	
PLAN	1 IN. = 50 FT.
PROFILE	HOR. 1 IN. = 50 FT. VERT. 1 IN. = 5 FT.
CROSS SECTION	HOR. 1 IN. = 10 FT. VERT. 1 IN. = 10 FT.

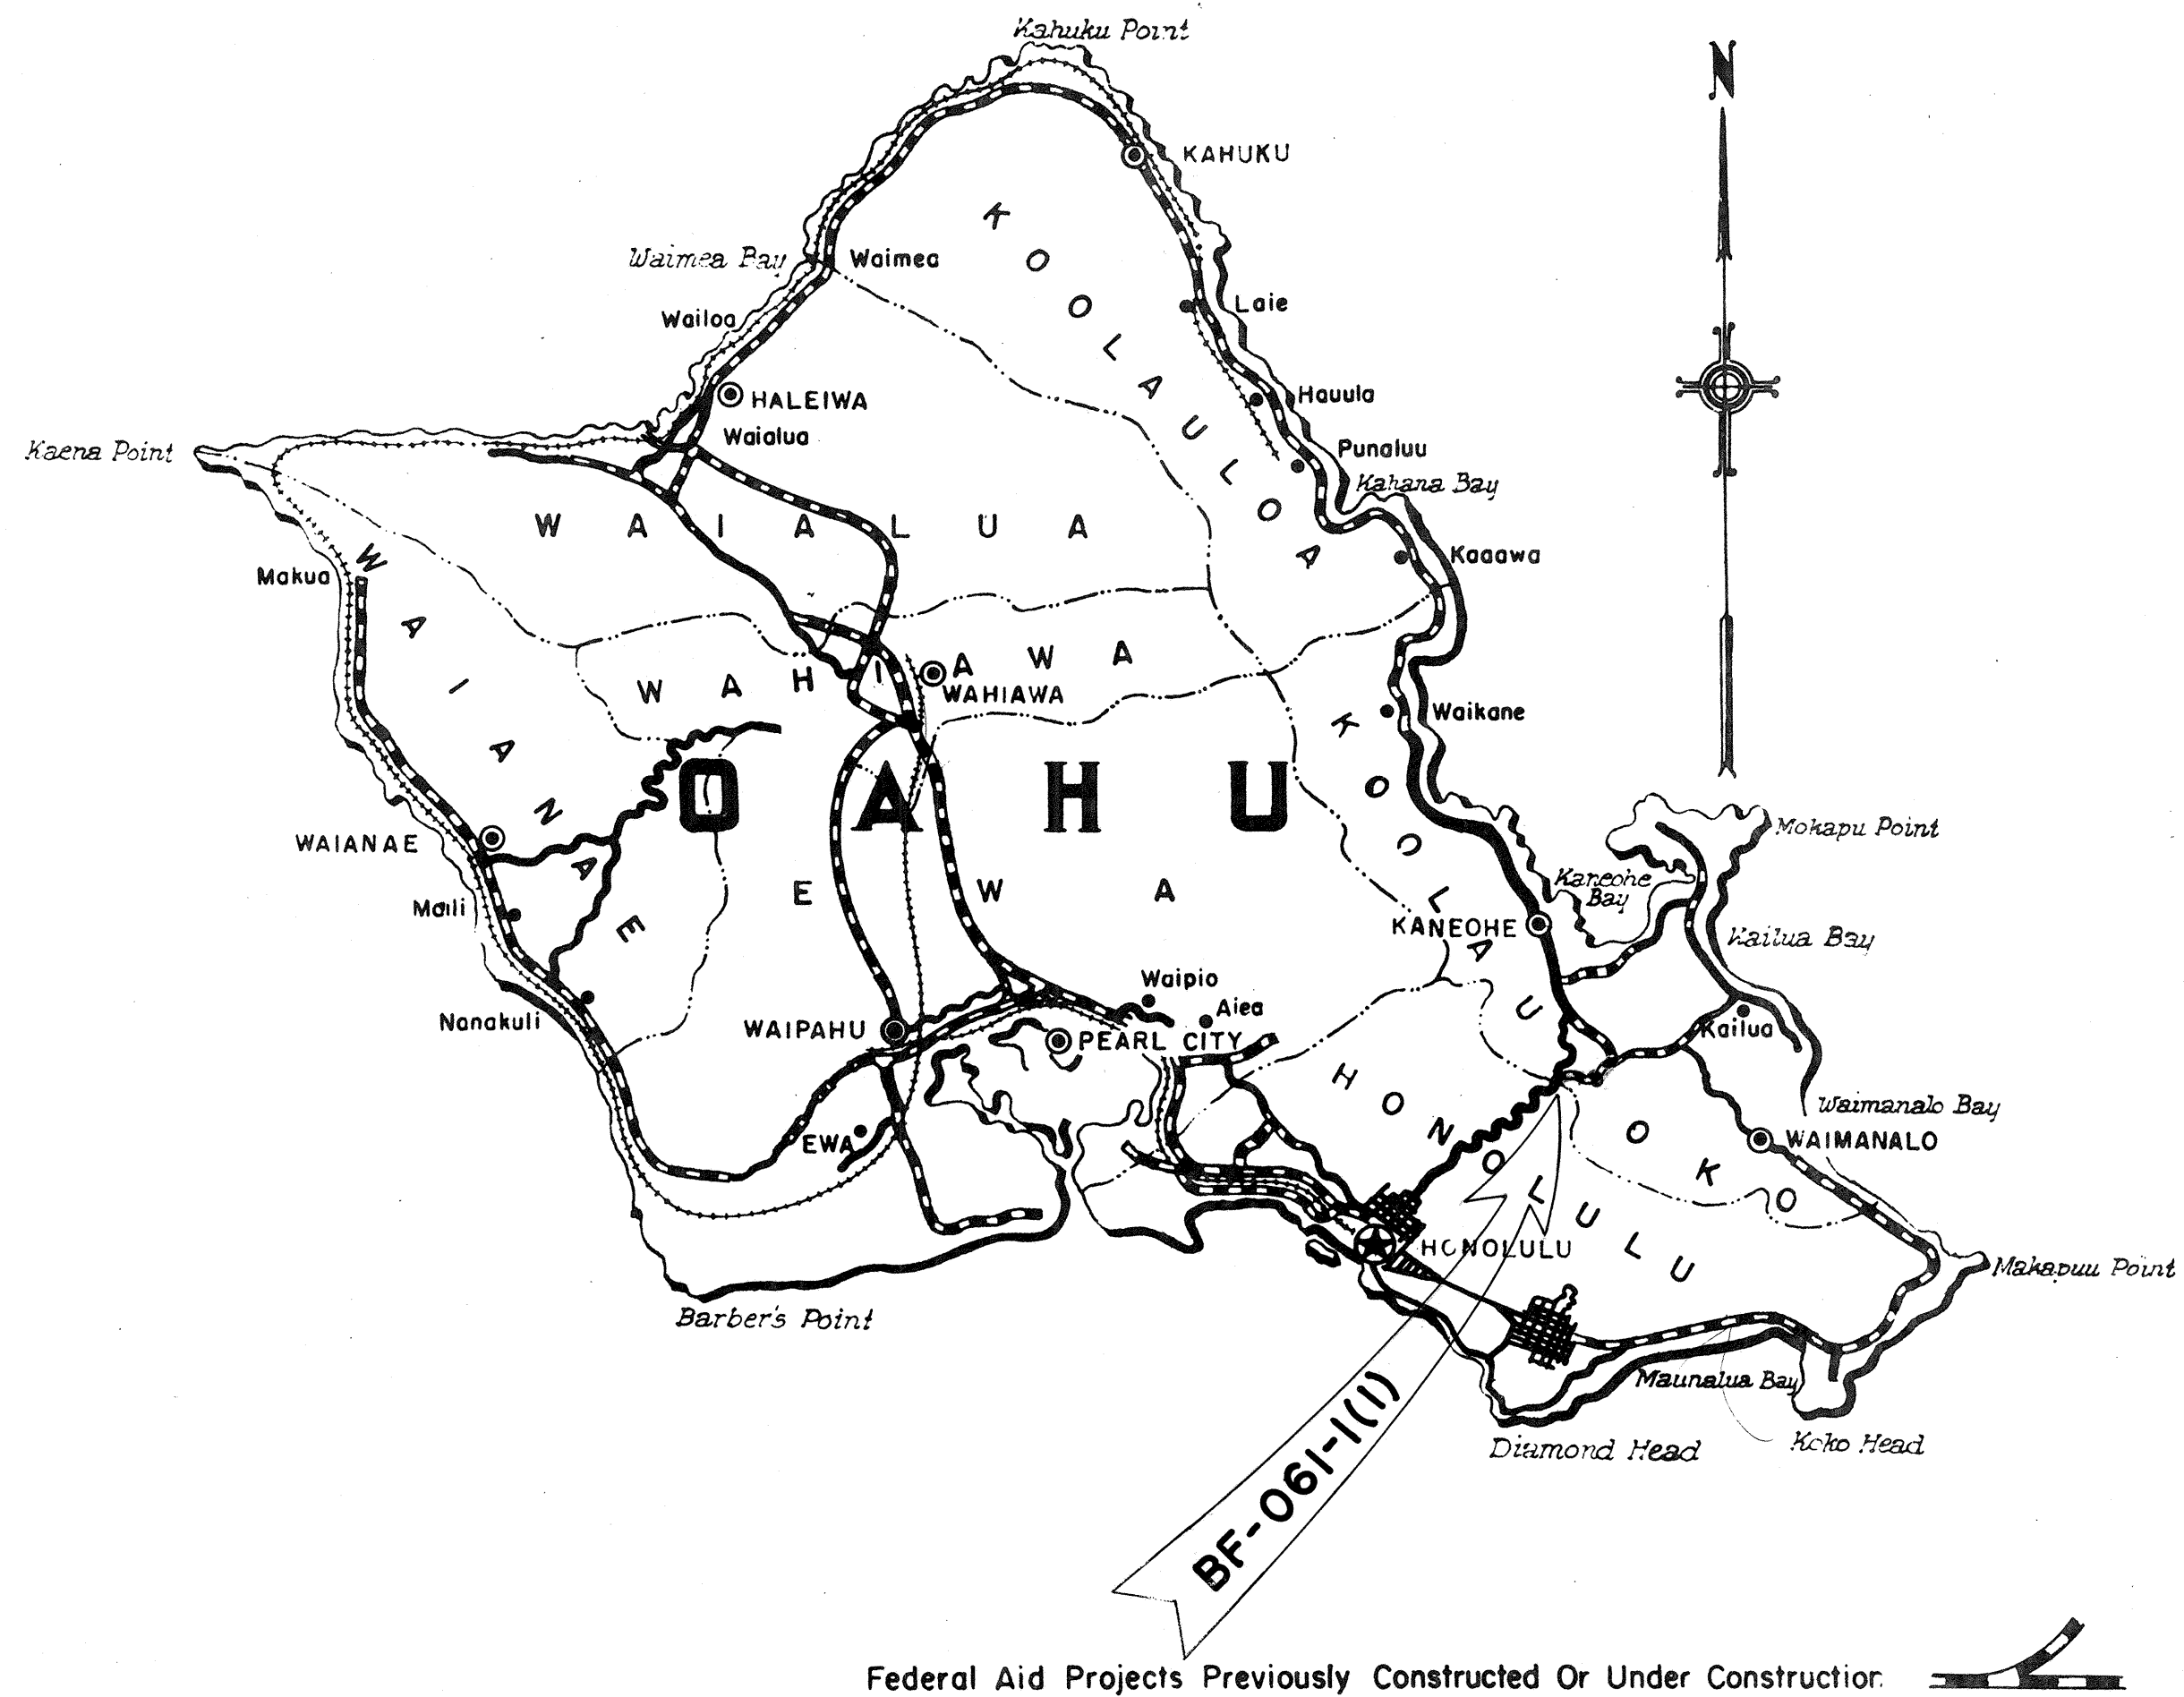

NOTE:
ALL CHANGES MADE DURING CONSTRUCTION
HAVE BEEN NOTED ON THESE TRACINGS IN
RED AND CHECKED BY:

T. M. Chua
PROJECT ENGINEER
8/6/63
DATE

DEPARTMENT OF COMMERCE BUREAU OF PUBLIC ROADS	
APPROVED:	
DIVISION ENGINEER	DATE

APPROVED *[Signature]* DATE 11/17/60
DIRECTOR OF TRANSPORTATION

SURVEY PLOTTED BY	
ORIGINAL PLAN	
TRACED BY	
NOTE BOOK	
CHECKED BY	