


FED. ROAD DIST. NO.	STATE	FED. AID PROJ. NO.	FISCAL YEAR	SHEET NO.	TOTAL SHEETS
HAWAII	HAWAII	06-1(1)	1960	12	24

GENERAL LAYOUT PLAN

Scale: 1" = 200'

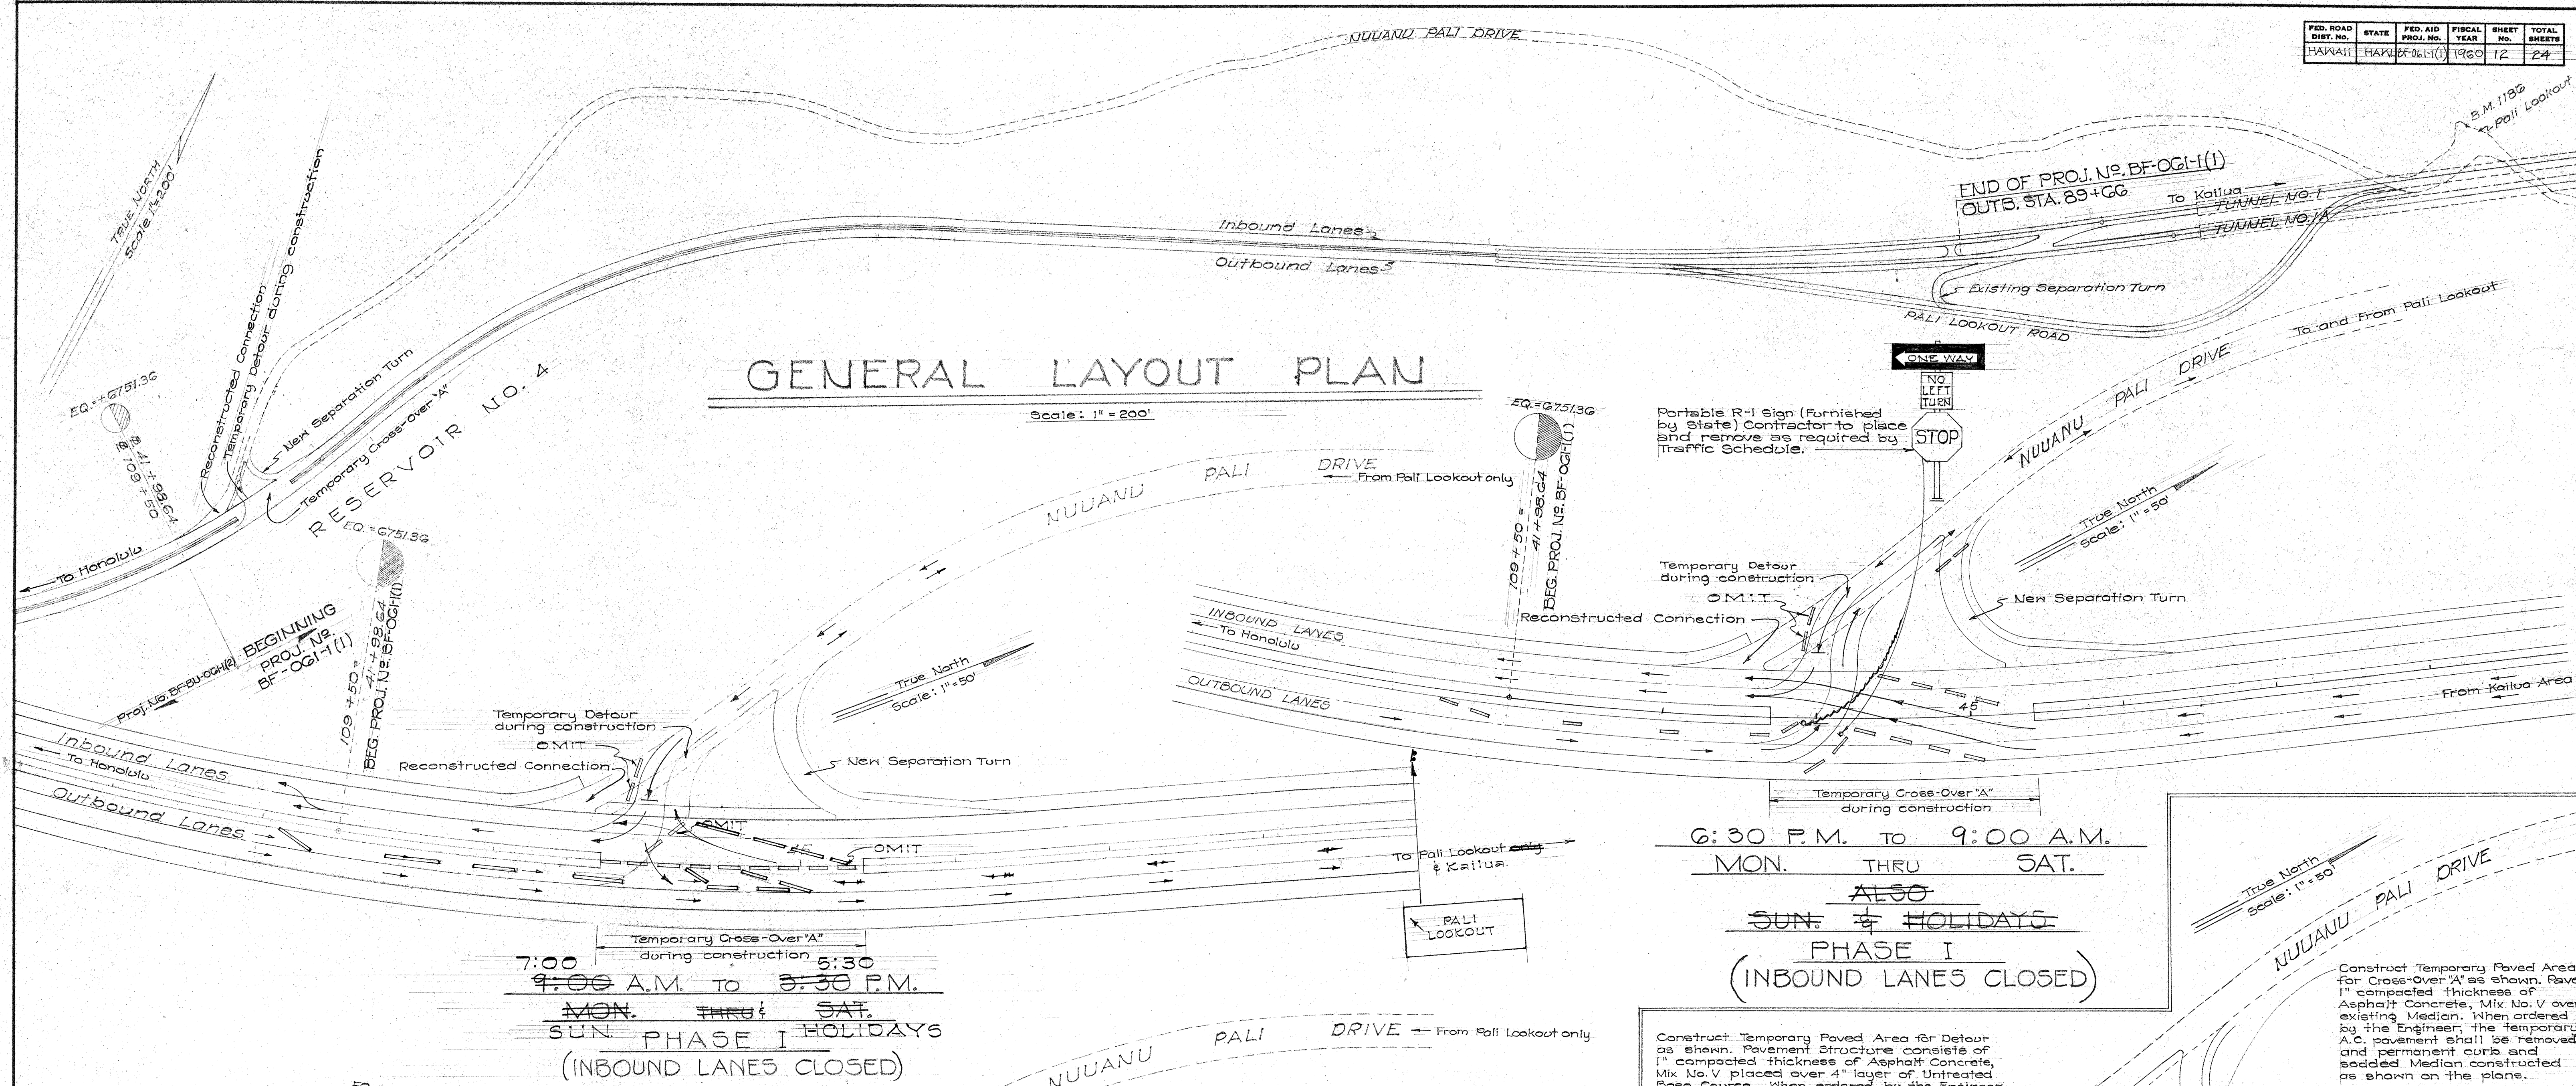

7:00 A.M. TO 5:30 P.M.
~~MON. THRU SAT.~~
SUN. PHASE I HOLIDAYS
(INBOUND LANES CLOSED)

6:30 P.M. TO 9:00 A.M.
~~MON. THRU SAT.~~
SUN. & HOLIDAYS
PHASE I
(INBOUND LANES CLOSED)

LEGEND:

- SINGLE ARROW, —> = ONE LANE TRAFFIC
- DOUBLE ARROW, <—> = TWO LANE TRAFFIC
- +— = STOP
- ===== = BARRICADES

PLAN SHOWING TEMPORARY PAVED DETOUR AND CROSS-OVER

NOTE:
The furnishing, by the contractor, of all labor, materials, tools, equipment, and doing all the work involved in the construction of temporary A.C. paved areas for Detour and the Cross-Over shall be paid for under the various contract item of work.
All work involved in the removing of the above paved area shall be considered as incidental to the item of Roadway Excavation and no separate payment will be made therefor.

DEPARTMENT OF TRANSPORTATION
DIVISION OF HIGHWAYS
STATE OF HAWAII
TRAFFIC ROUTING PLAN
RECONSTRUCTING, WIDENING AND
RESURFACING - PALI HIGHWAY
PROJECT NO. BF-OGI-1(1)
Scales: As Noted Sept. 1960

SHEET No. 1 OF 4 SHEETS

SURVEY PLOTTED BY	DATE
DRAWN BY	
TRACED BY	
QUANTITIES CHECKED BY	
CHECKED BY	
ORIGINAL PLAN	
NOTE BOOK No.	

FED. ROAD DIST. NO.	STATE	FED. AID PROJ. NO.	FISCAL YEAR	SHEET NO.	TOTAL SHEETS
HAWAII	HAW	BF-OGI-1	1960	13	24

By Others
 Mondays through Saturdays:
 9:00 A.M. to 3:30 P.M. - Barricades in Closed position.
 3:30 P.M. to 9:00 A.M. - Barricades Removed.
 Sundays and Holidays: - Barricades Removed.


TRAFFIC ON OUTBOUND LANES (PHASE I INBOUND LANES CLOSED)

Mondays through Saturdays:
 9:00 A.M. to 3:30 P.M. - Two-Lane traffic to Pali Lookout only.
 3:30 P.M. to 9:00 P.M. - Two-Lane traffic in Kailua direction only (Also to Pali Lookout).
 9:00 P.M. to 9:00 A.M. - Two-Lane traffic in Honolulu direction only.
 Sundays and Holidays: - Two-Lane traffic in Honolulu direction only.

NOTE:
 Barricades at Cross-Over #2 will be furnished and handled by others.

TRAFFIC ON NUUANU PALI DRIVE (PHASE I INBOUND LANES CLOSED)

Mondays through Saturdays:
 9:00 A.M. to 9:00 P.M. - One-Lane traffic toward Honolulu only.
 9:00 P.M. to 9:00 A.M. - Two-Way traffic.
 Sundays and Holidays: - Two-Way traffic.

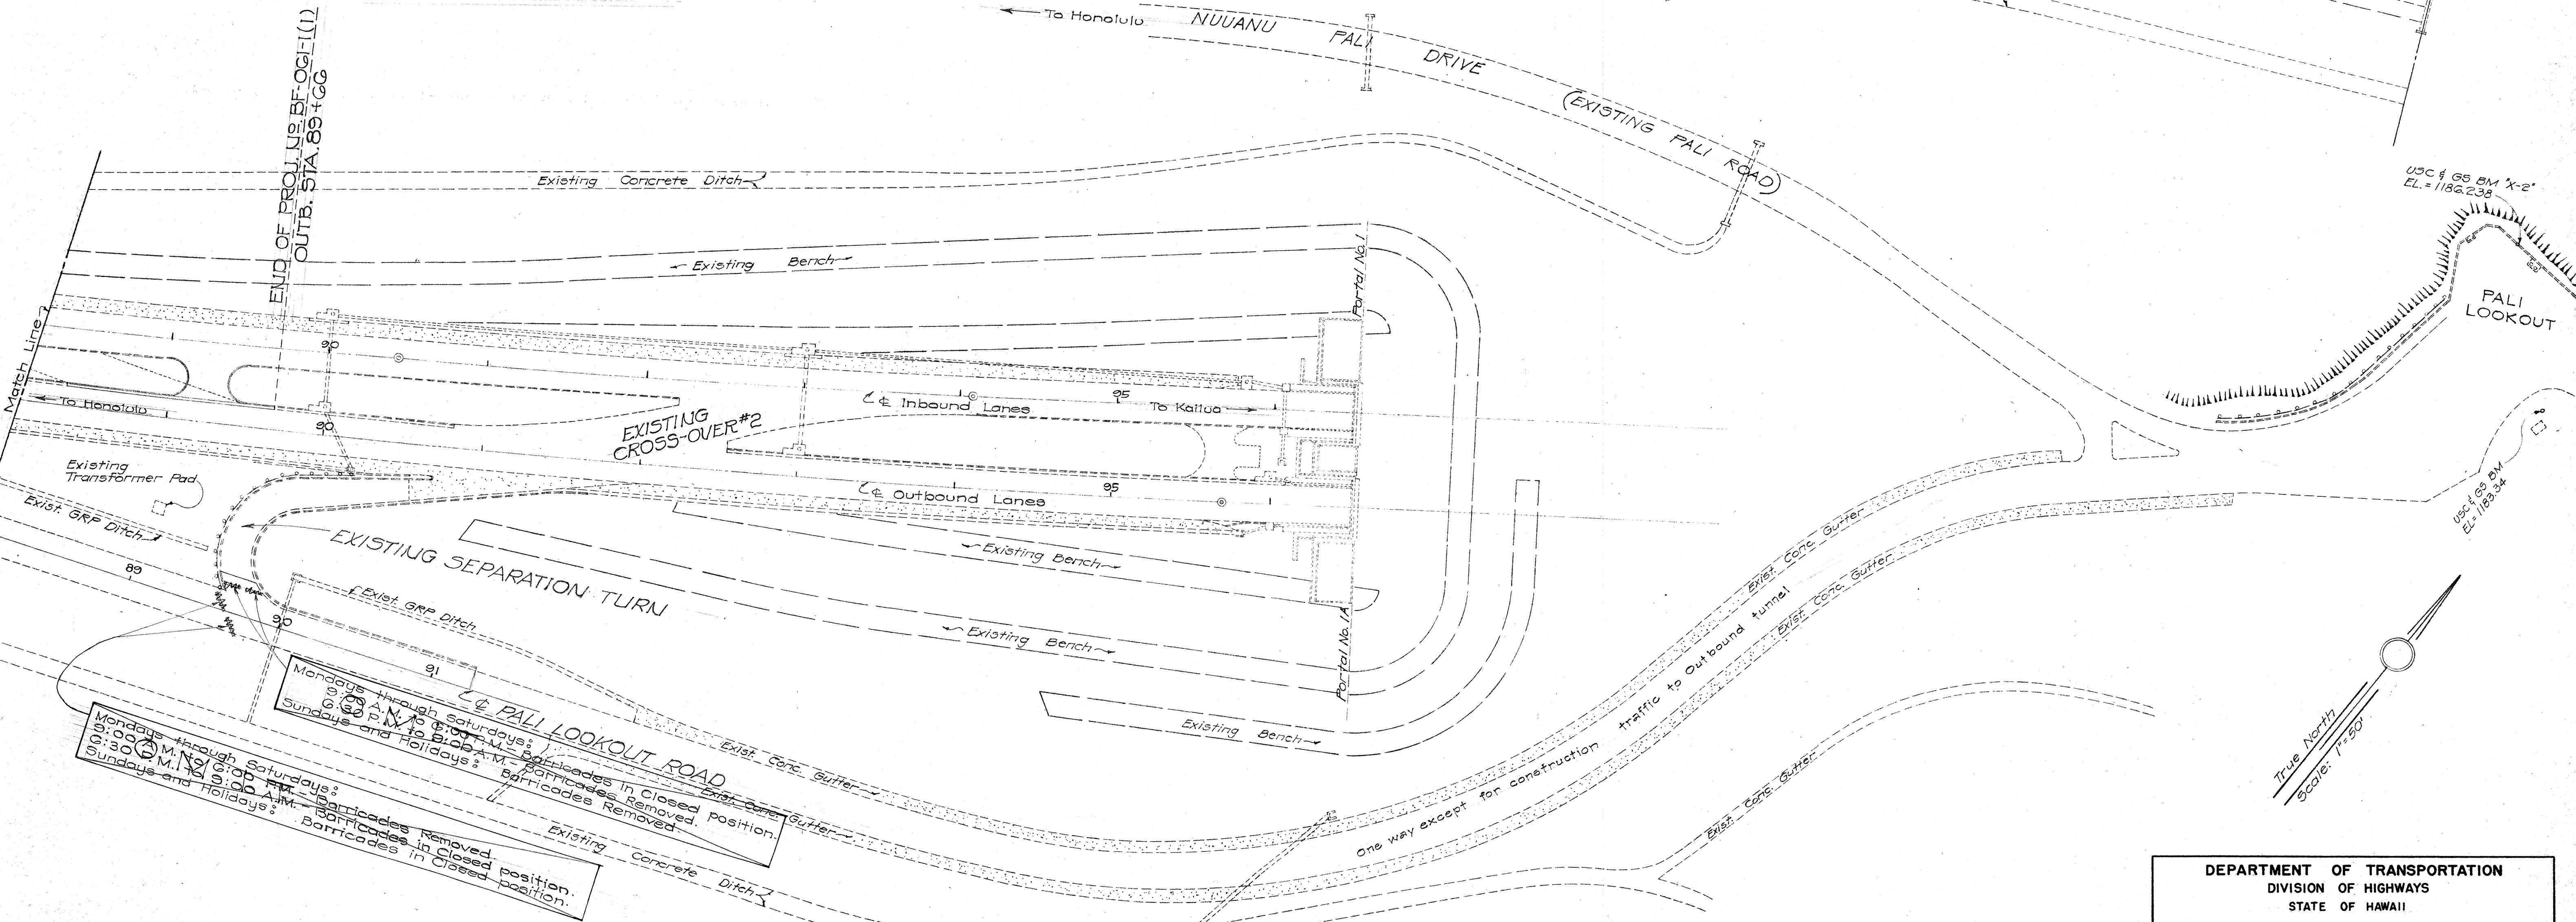

TRAFFIC ON PALI LOOKOUT ROAD (PHASE I INBOUND LANES CLOSED)


Mondays through Saturdays:
 9:00 A.M. to 9:00 P.M. - Two-Lane traffic to Pali Lookout only.
 9:00 P.M. to 9:00 A.M. - One-Lane traffic via Existing Separation Turn to Pali Lookout only.
 Sundays and Holidays: Same as 9:00 P.M. to 9:00 A.M. above.
 One-way except for construction traffic to Outbound tunnel.

TRAFFIC PHASE I


DEPARTMENT OF TRANSPORTATION
 DIVISION OF HIGHWAYS
 STATE OF HAWAII

TRAFFIC ROUTING PLAN
 RECONSTRUCTING, WIDENING AND
 RESURFACING - PALI HIGHWAY
 PROJECT NO. BF-OGI-1(1)
 Scale: 1" = 50' Sept. 1960


SHEET No. 2 OF 4 SHEETS

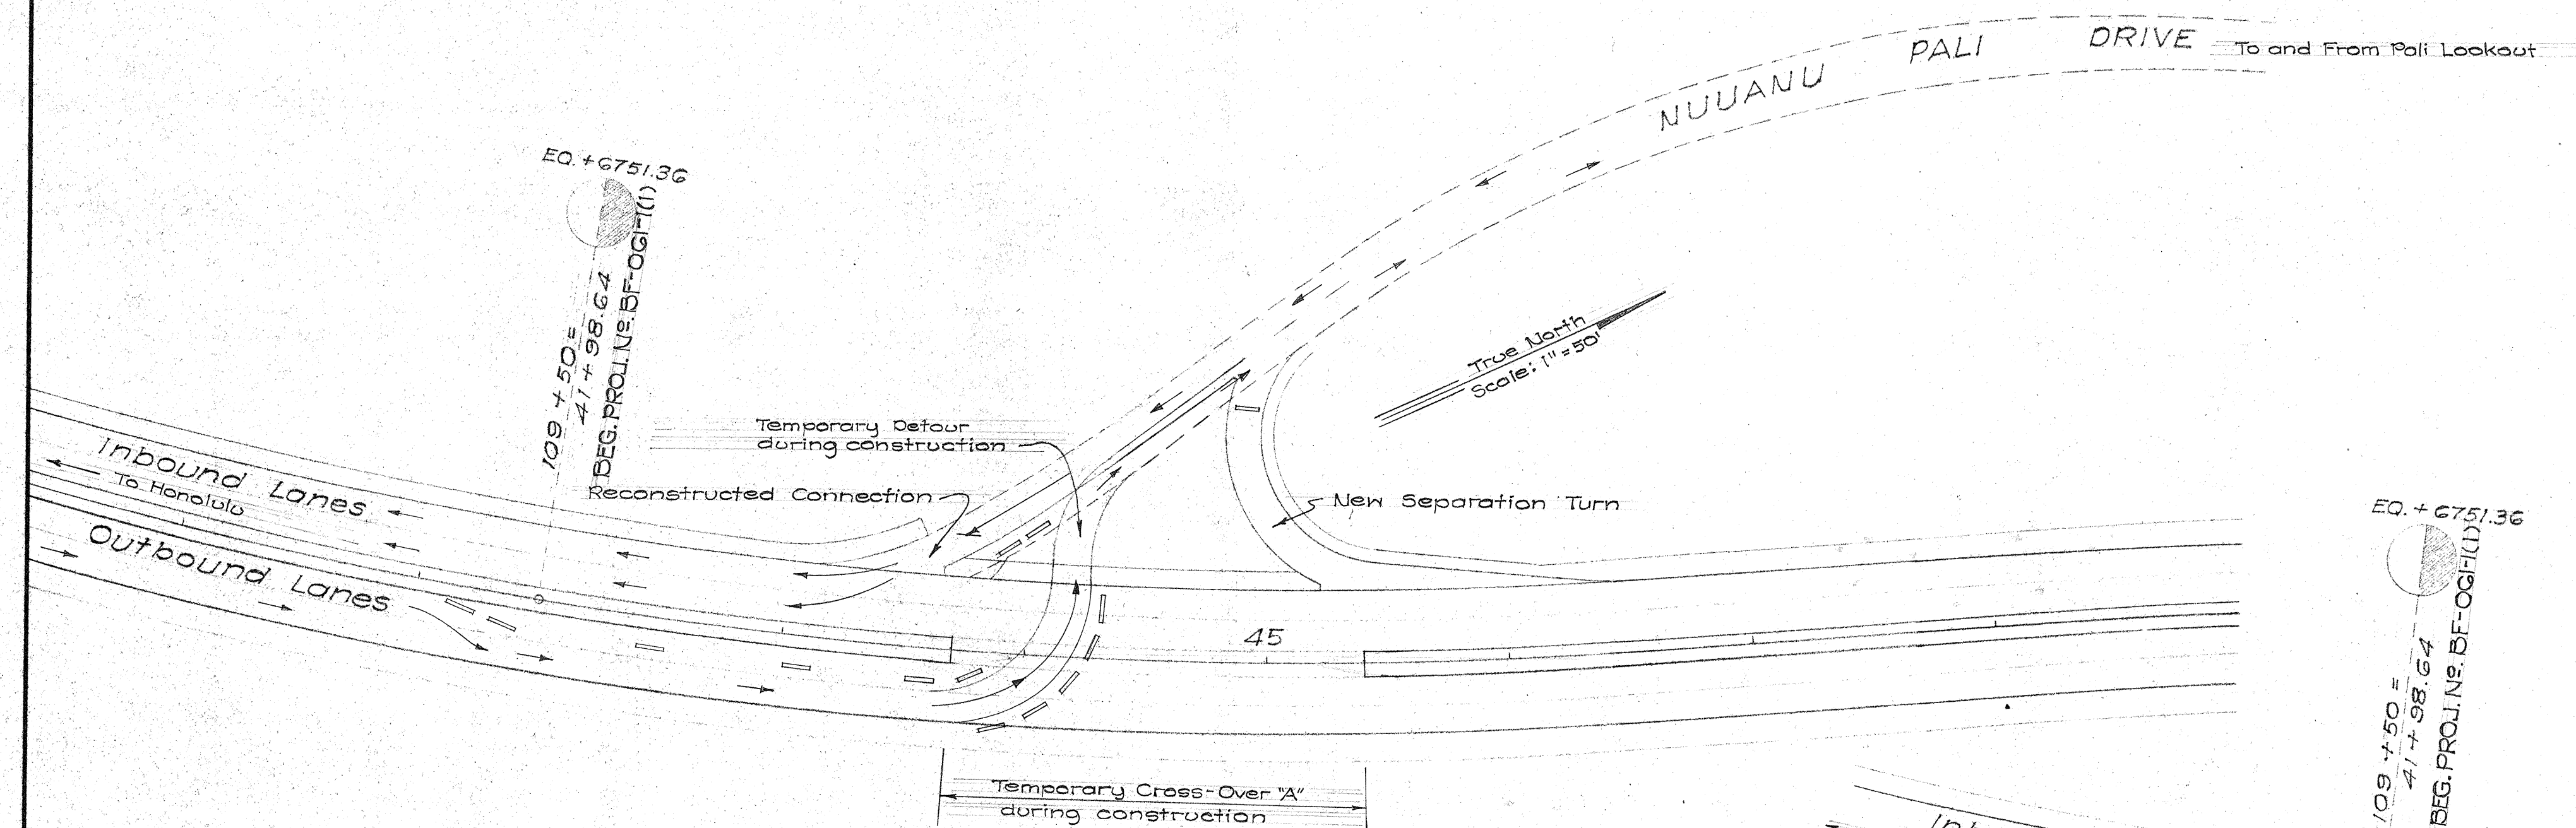

9:00 A.M. TO 3:30 P.M.
MON. THRU SAT.
PHASE II
(OUTBOUND LANES CLOSED)

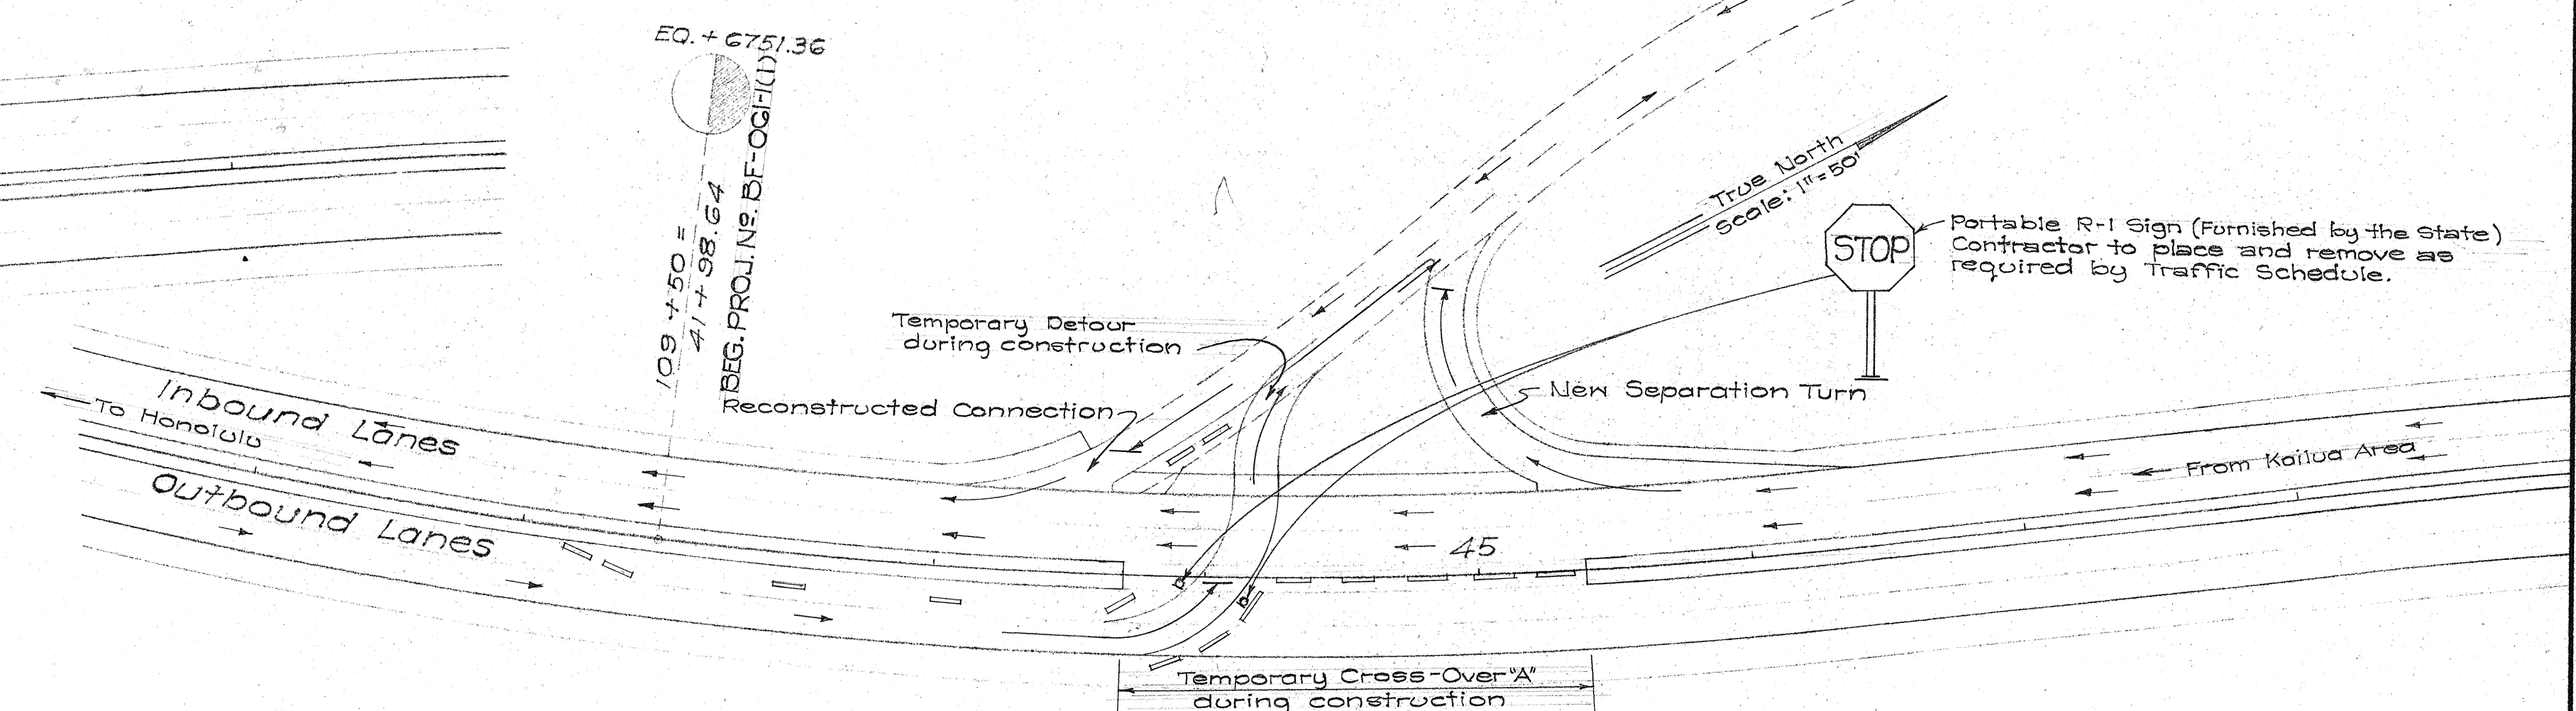

6:30 P.M. TO 9:00 A.M.
MON. THRU SAT.
ALSO
SUN. & HOLIDAYS
PHASE II
(OUTBOUND LANES CLOSED)

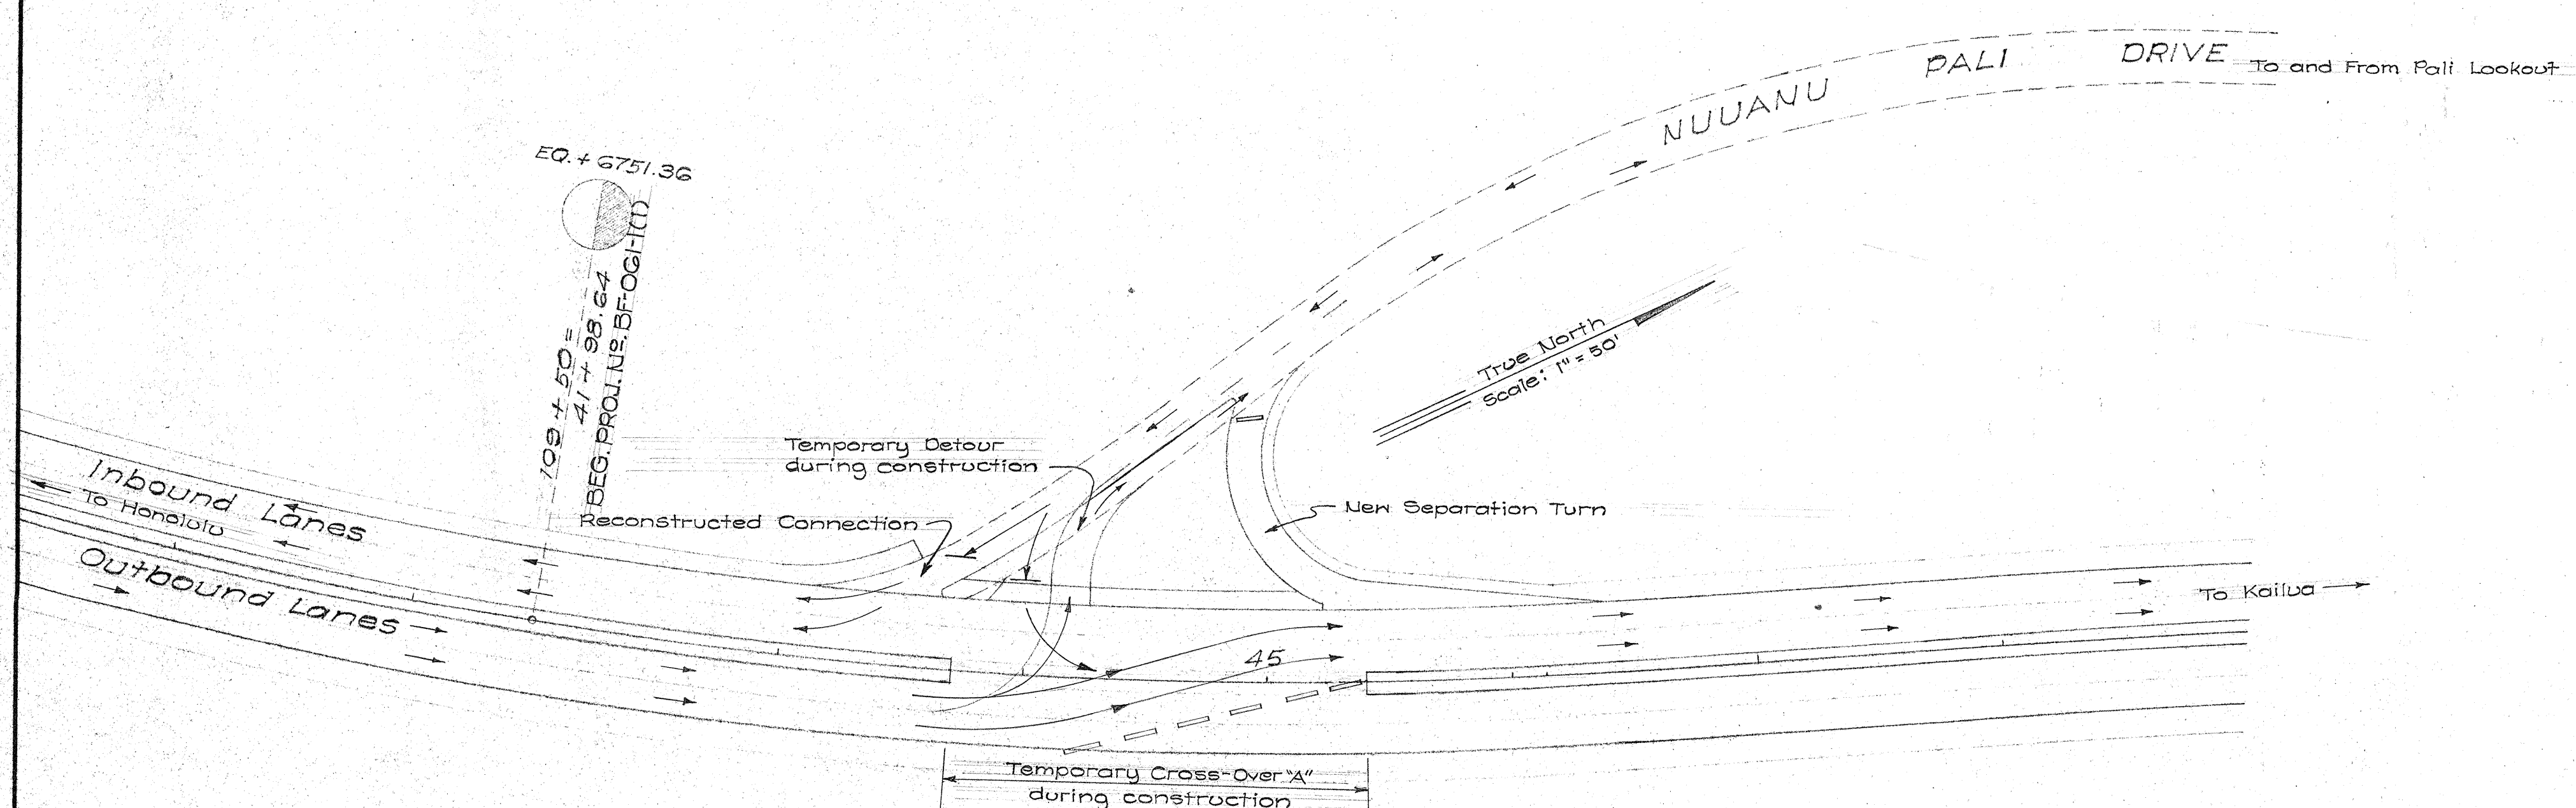

3:30 P.M. TO 6:00 P.M.
MON. THRU SAT.
PHASE II
(OUTBOUND LANES CLOSED)

LEGEND

- SINGLE ARROW, → = ONE-LANE TRAFFIC
- DOUBLE ARROW, ↔ = TWO-LANE TRAFFIC
- +— = STOP
- == == = BARRICADES

TRAFFIC PHASE II

DEPARTMENT OF TRANSPORTATION
DIVISION OF HIGHWAYS
STATE OF HAWAII

TRAFFIC ROUTING PLAN
RECONSTRUCTING, WIDENING AND
RESURFACING - PALI HIGHWAY
PROJECT NO. BF-061-1(1)
Scale: 1" = 50' Sept, 1960

SURVEY PLOTTED BY	DATE
DESIGNED BY	
DRAWN BY	
CHECKED BY	
QUANTITIES CHECKED BY	
NOTE BOOK	
No.	

FED. ROAD DIST. NO.	STATE	FED. AID PROJ. NO.	FISCAL YEAR	SHEET NO.	TOTAL SHEETS
HAWAII	HAW	BF-OGI-1	1960	15	24

