


PLAN
DATE
BY
CHECKED
DATE
BY
NOTE BOOK
NO.


PROFILE
DATE
BY
CHECKED
DATE
BY
NOTE BOOK
NO.

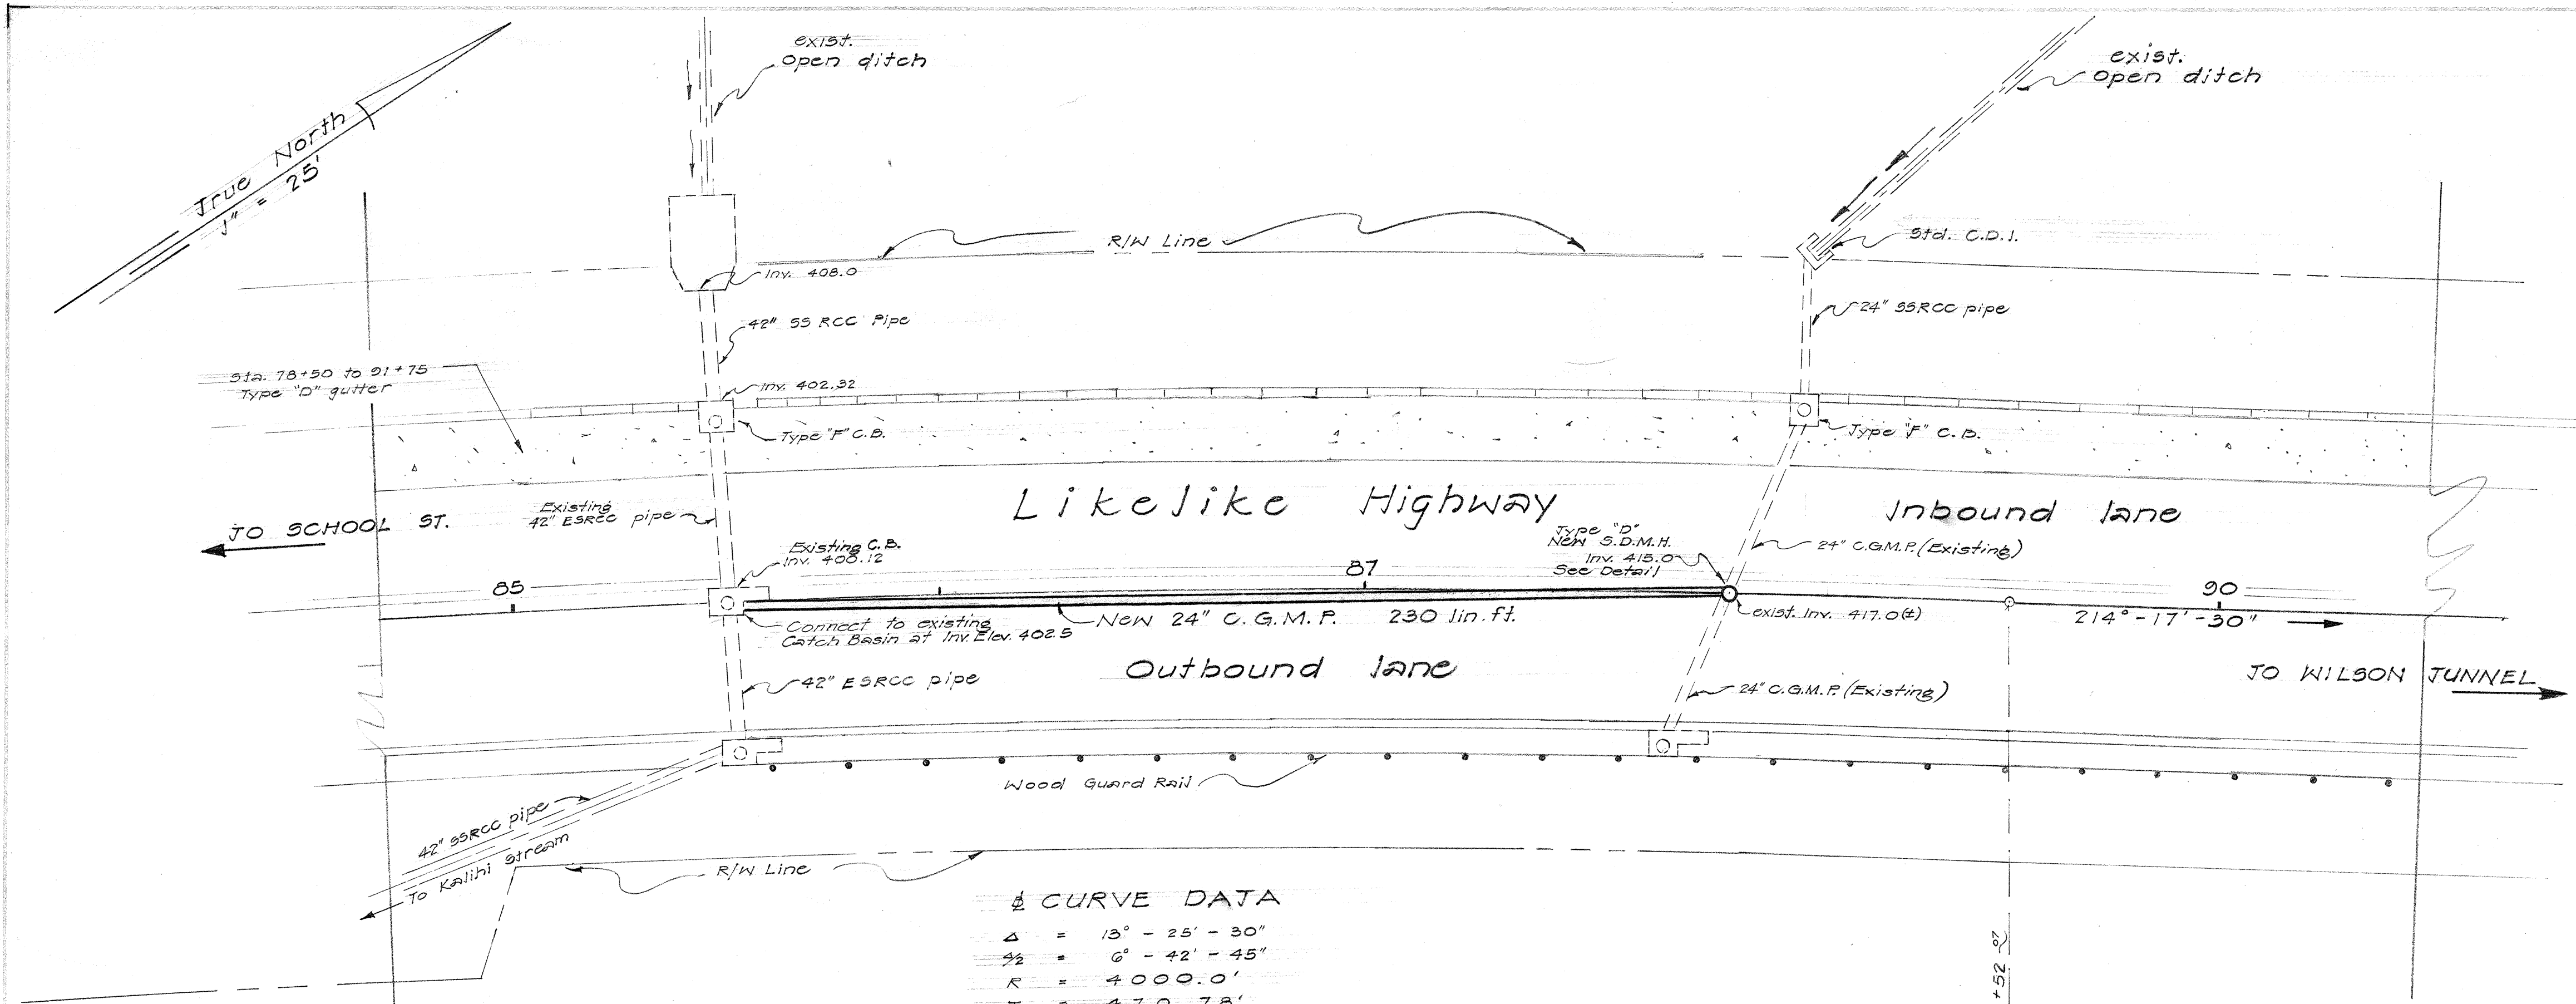

1/2 CURVE DATA

Δ	=	13° - 25' - 30"
$\Delta 2$	=	6° - 42' - 45"
R	=	4000.0'
T	=	470.78'
C	=	935.10'
L_c	=	937.24'
SE	=	0.04' / ft.


PLAN
SCALE: 1" = 25'

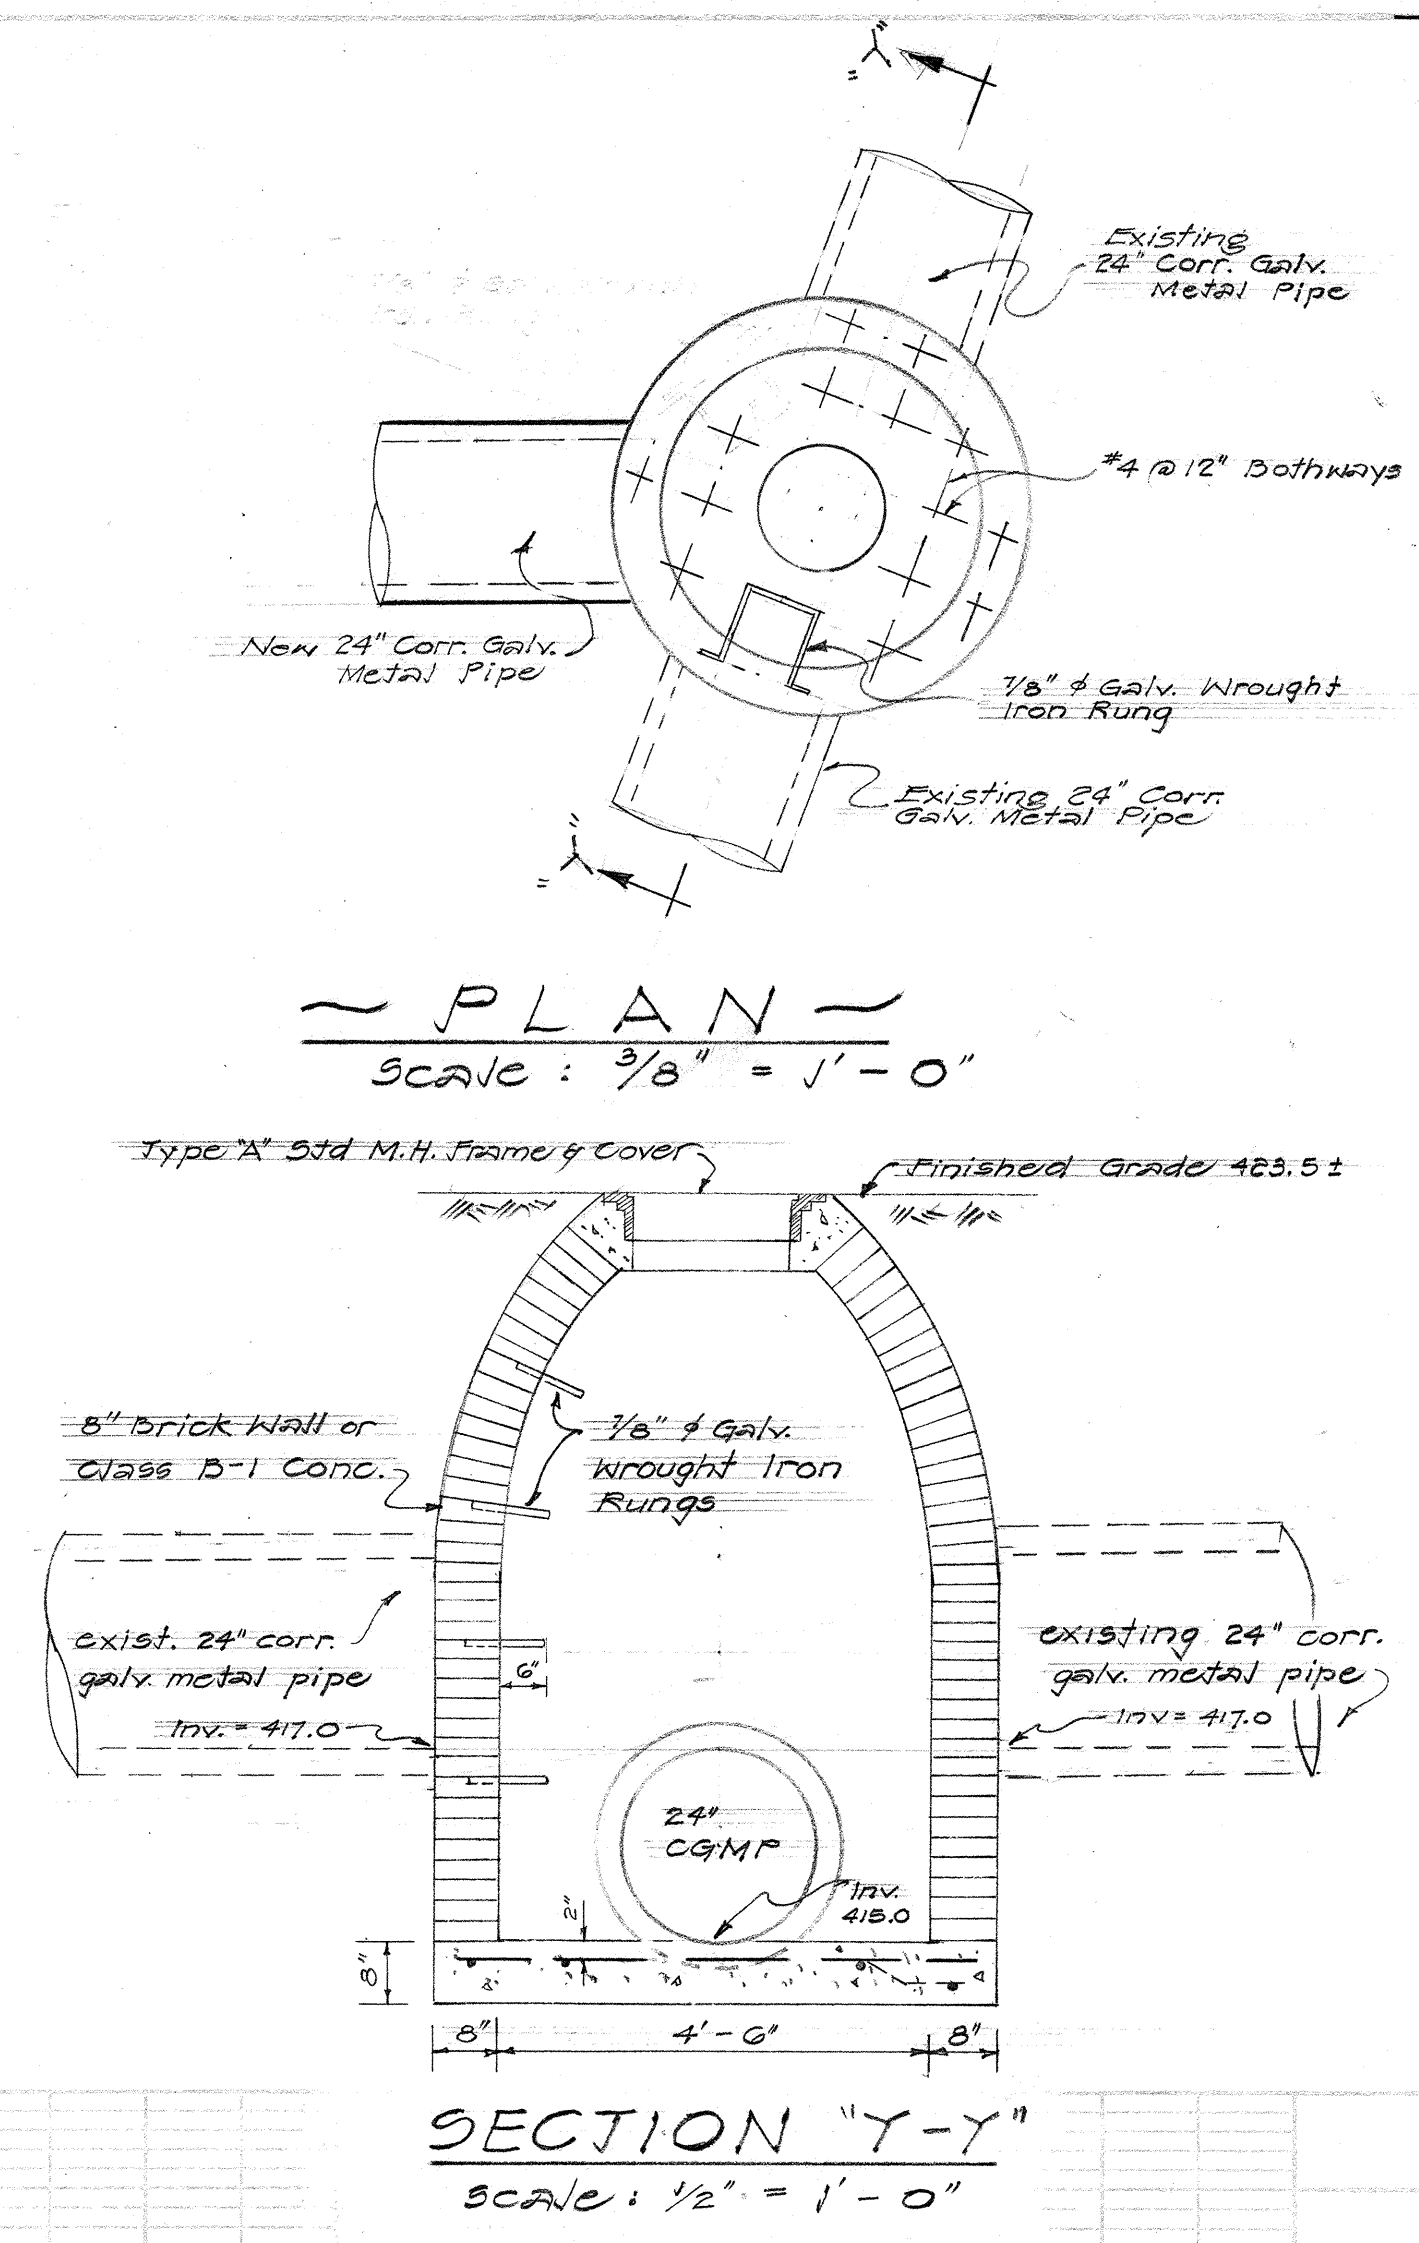

DETAIL OF TYPE "D" SDMH
Scale: as Shown

ESTIMATED QUANTITIES

Exc.	225 c.y.
24" Corr. Galv. Metal	
Pipe 14 Ga.	235 L.F.
Brick Wall for SDMH	9 L.F.
Type "A" C.I. Frame & Cover	1 Ea.

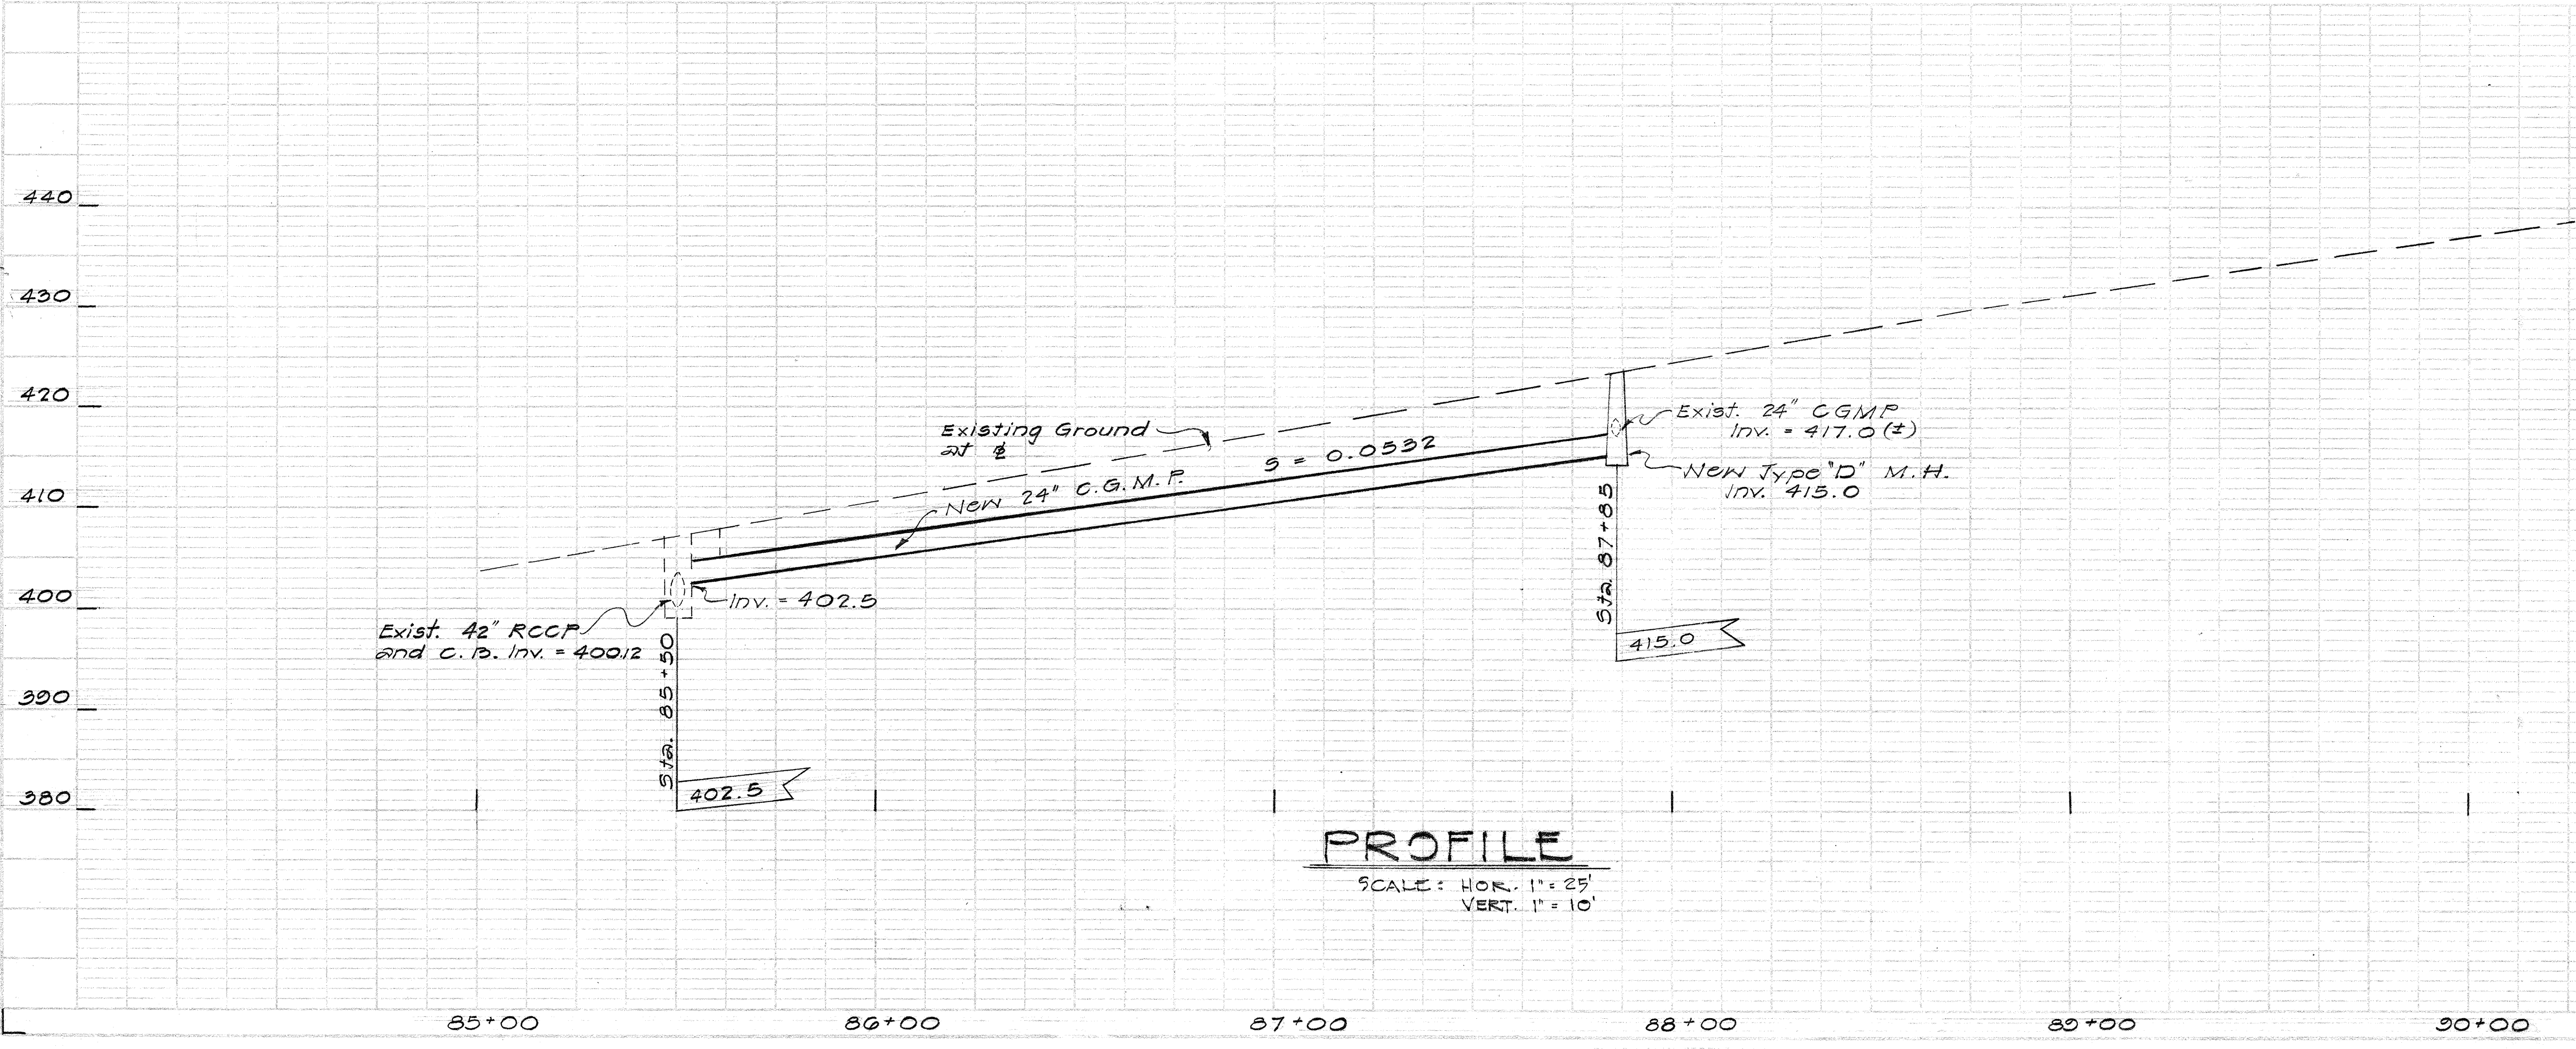

PROFILE
SCALE: HOR. 1" = 25'
VERT. 1" = 10'

DEPARTMENT OF TRANSPORTATION
DIVISION OF HIGHWAYS
STATE OF HAWAII
STORM DRAIN
LIKELIKE HIGHWAY (AT KUA FOHAKU DR.)
PROJ. No. A-630-01-60
SCALE: AS NOTED
NOV. 1960