





DATE	BY	SURVEYED	PLOTTED	NOTED	CHECKED

DATE	BY	SURVEYED	PLOTTED	NOTED	CHECKED

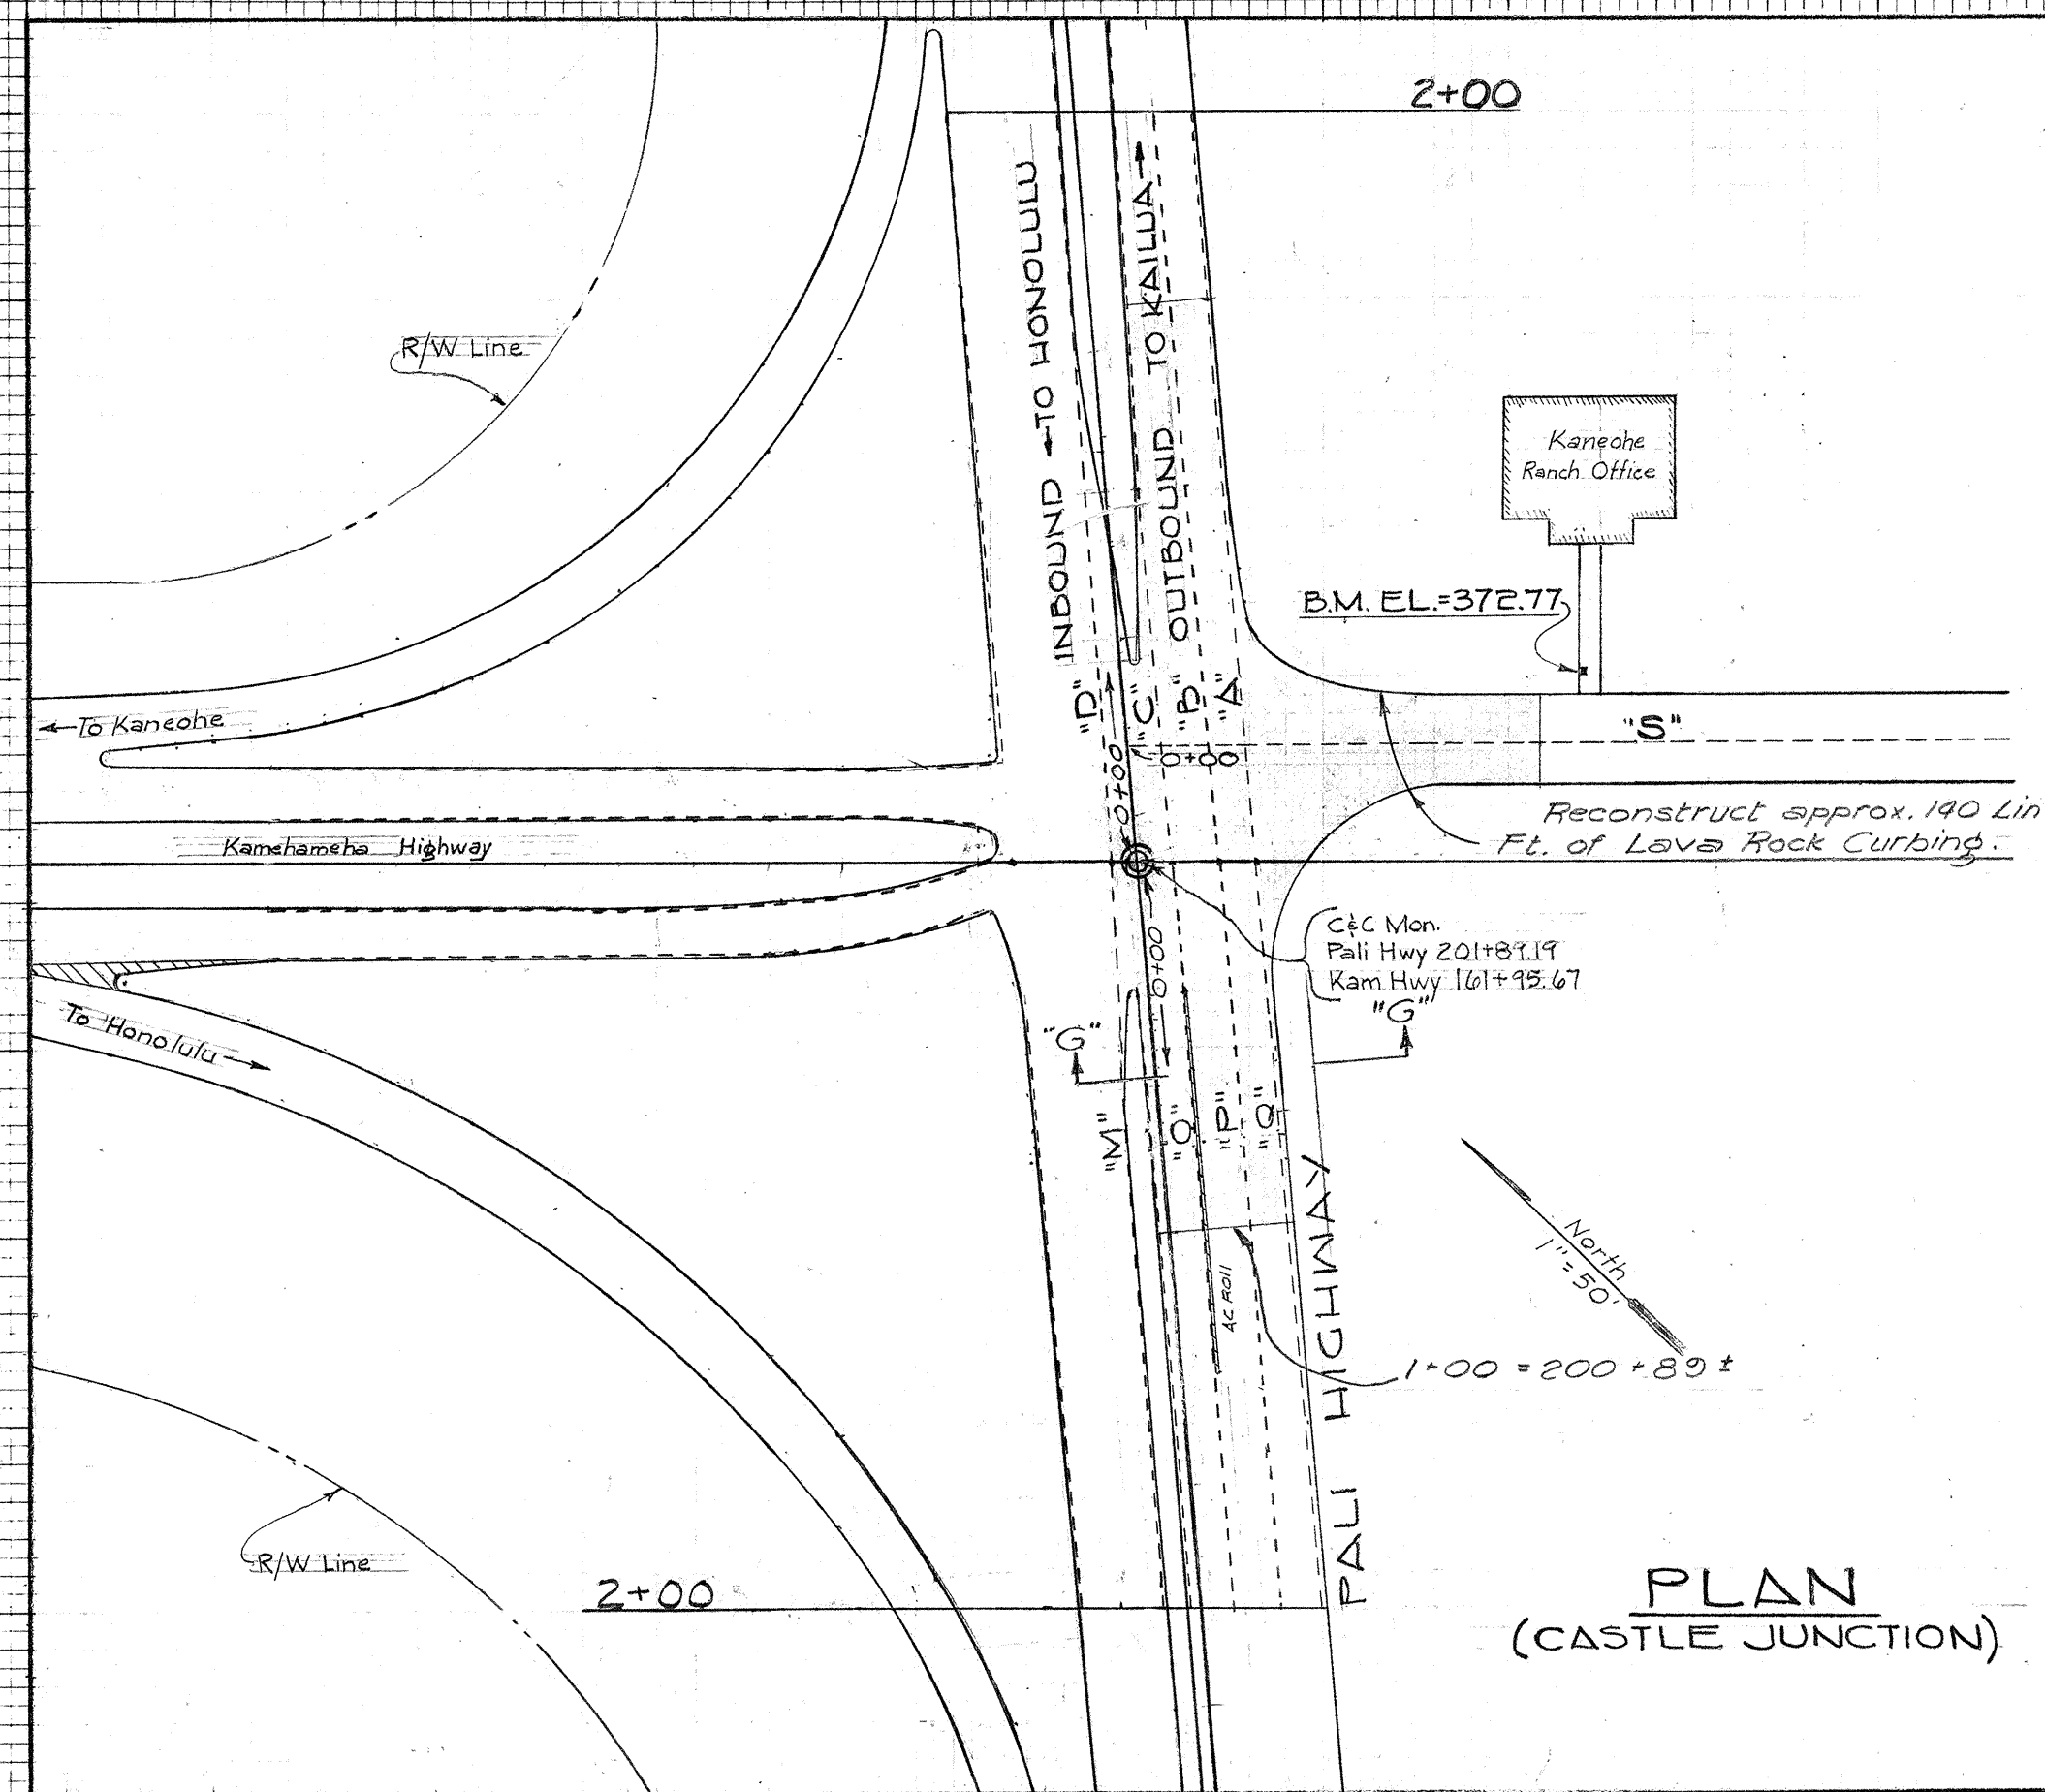

GENERAL NOTES

- 1- New Resurfaced Pavement adjacent to concrete gutters 2 1/2' wide or less shall be feathered-out over the entire width of the gutter.
- 2- New Resurfaced Pavement adjacent to concrete gutters 8' wide shall be feathered-out over the concrete to a point 3' from the edge of pavement.
- 3- Shoulder areas with 3" base course and bituminous treatment Type-III, shall be laid with AC as shown in Typical Section, Sheet No. 2. Locations are as noted below:
 Outbound Lanes: Sta 160+10± to 175+32± 162+70± to 171+75 143+00-145+00
 Sta 182+18± to 190+20± 172+47± to 176+00 196+30-201+50
 Sta 196+33± to 202+24± 182+15± to 190+30
 Inbound Lanes: Sta 143+00± to 148+72±
 Sta 161+10± to 168+00± 160+30± to 167+25
 Sta 173+50± to 179+10± 173+30± to 179+20
 Sta 184+21± to 186+77± 184+30± to 186+80
 Untreated Base Material:
 4- Top soil shall be placed on all grassed shoulder areas abutting the new resurfaced pavement to a point 8' from the edge of pavement. The following shoulder locations to receive Top Soil: Untreated Base Material
 Outbound Lanes: Sta 210+10± to 223+37±
 Sta 230+00± to 232+00±
 Sta 236+25± to 236+50±
 Inbound Lanes: Sta 236+40± to 239+81±
 Sta 223+10± to 232+00±
 5- Untreated base material shall be placed on all dirt shoulder areas abutting the new resurfaced pavement to a point 8' from the edge of pavement. The following shoulder locations to receive untreated base material:
 Outbound Lanes: Sta 143+00± to 148+72±
 Inbound Lanes: Sta 250+78± to 252+12±
 6- Parking area between Sta 160+00± and 162+10± along Outbound Lanes shall be resurfaced with 1" AC.
 7- P.C.C. pavement along medial strip at Kapaa Quarry Road intersection shall be resurfaced with 2 1/2" AC.
 8- Contractor shall provide smooth riding connection to existing pavement at Beg. of Project, all side-road connections, and End of Project. (For Castle Ranch Office Road Connection, See this Sheet.)

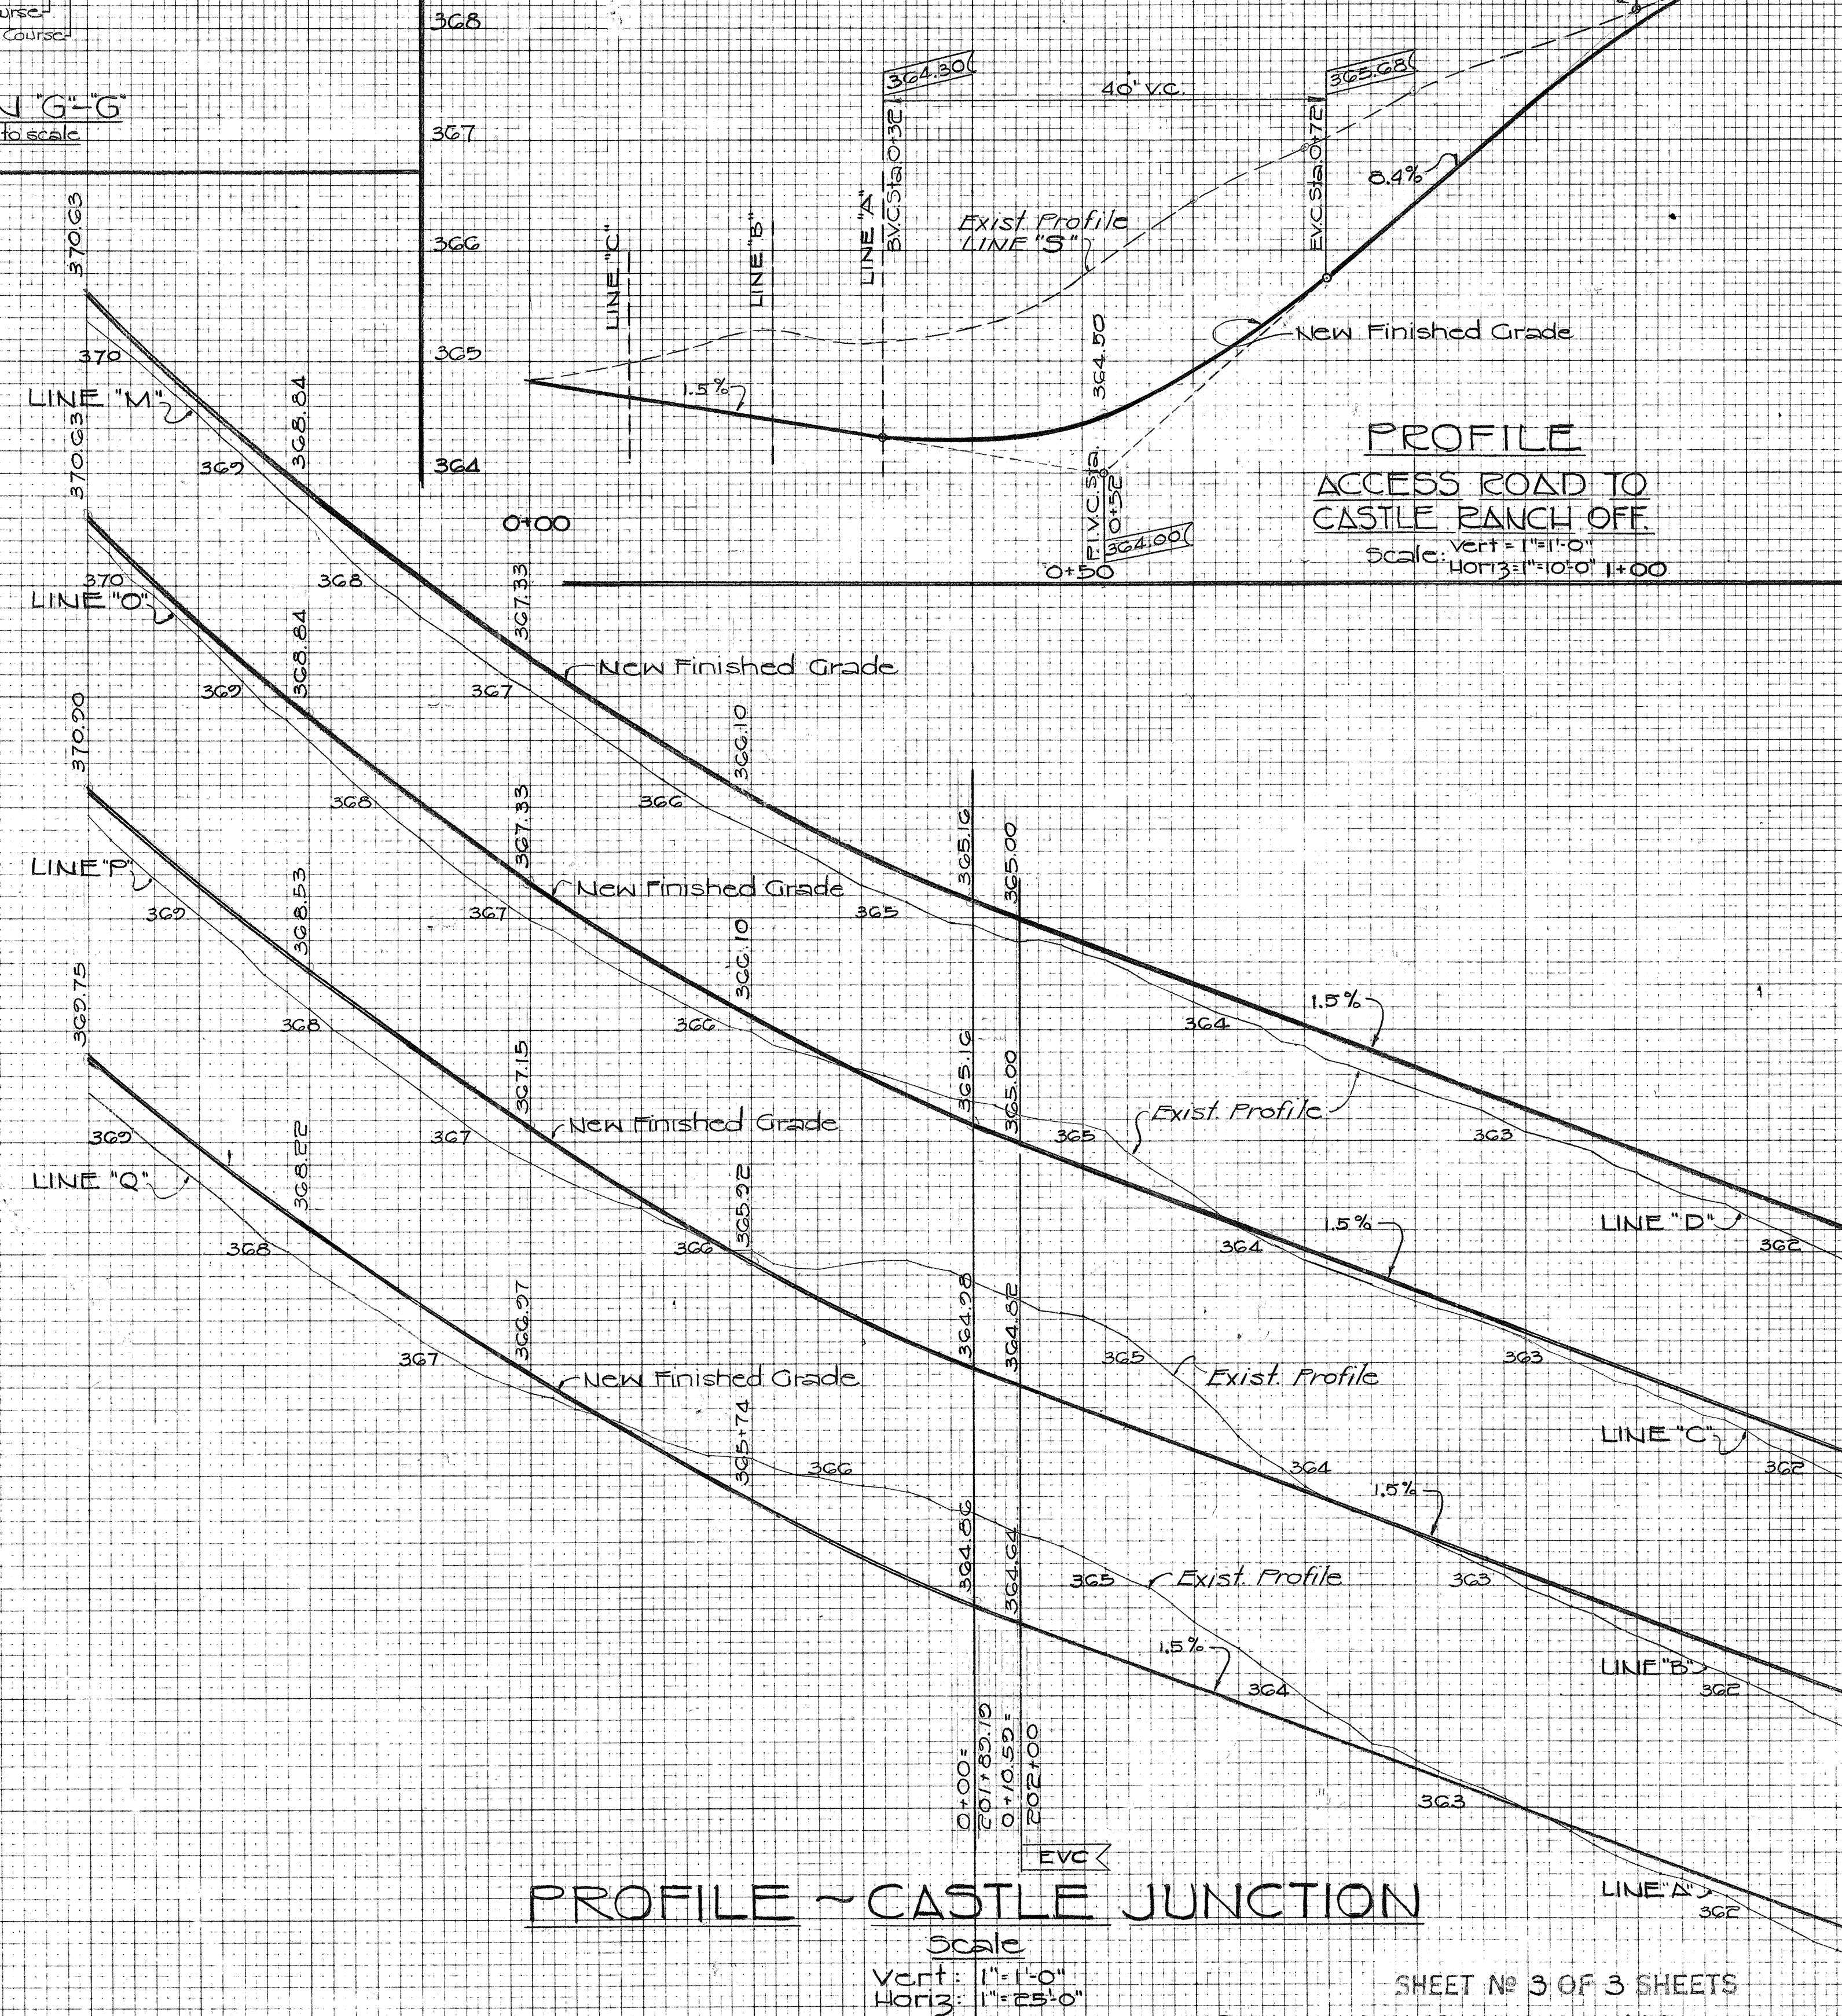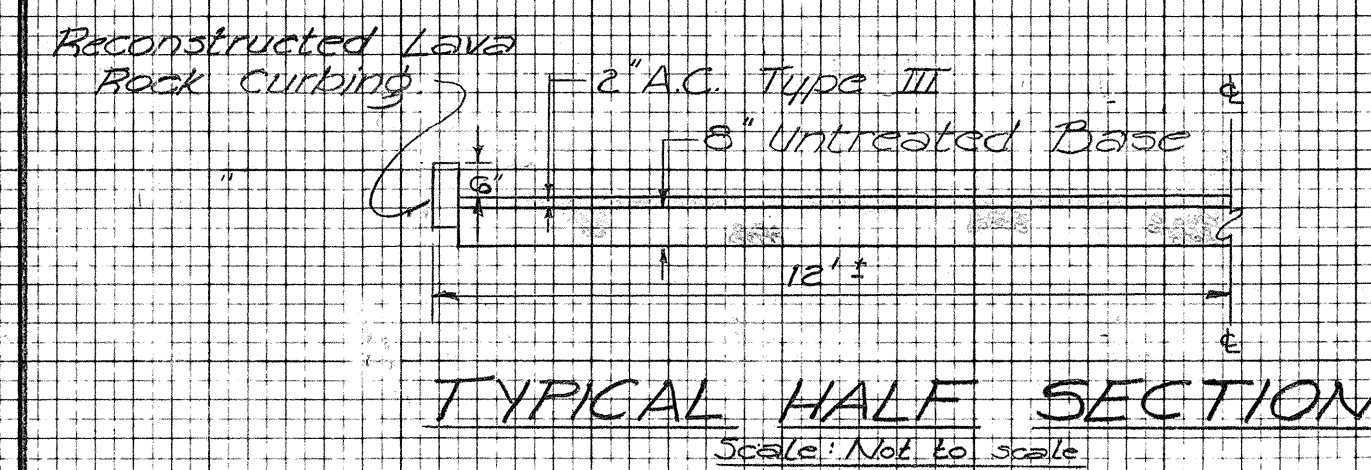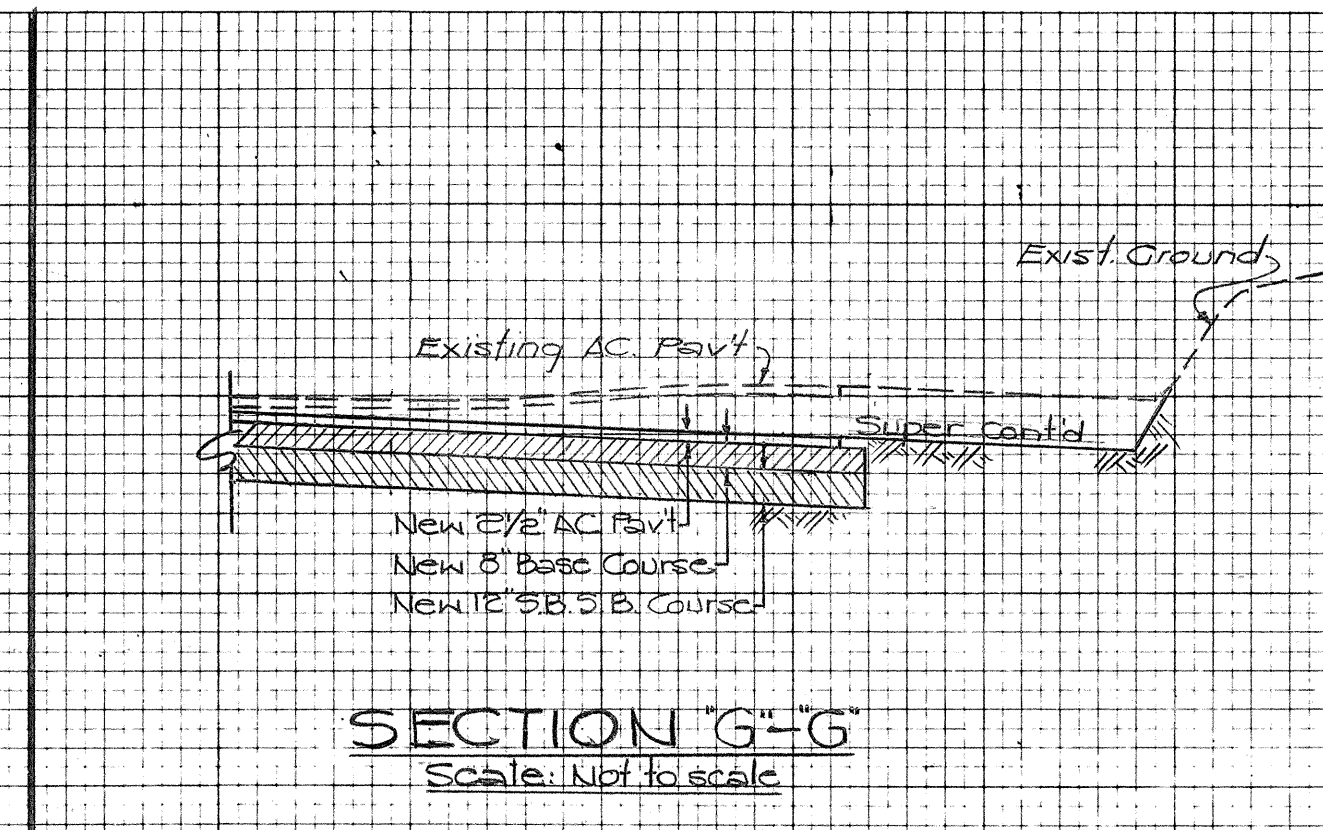

PROFILE ~ CASTLE JUNCTION

Scale
 Vert: 1"=10'
 Horiz: 1"=25'

SHEET No 3 OF 3 SHEETS

13-61-03-60