
INDEX TO DRAWINGS	
SHEET NO.	DESCRIPTION
1	TITLE SHEET
2	TYPICAL SECTIONS
3	PLAN & PROFILE
	(CASTLE JUNCTION)


STATE OF HAWAII
DEPARTMENT OF TRANSPORTATION
DIVISION OF HIGHWAYS
HONOLULU, HAWAII
AS BUILT
PLANS FOR

THE RECONSTRUCTION & RESURFACING OF PORTION OF PALI HIGHWAY & KALANIANAOLE HIGHWAY (HAIRPIN TURN TO KAPAA QUARRY RD. INTERSECTION) PROJ. NO. B-61-03-60

LAYOUT OF PROJECT
Scale: I" = 2000'

LENGTH OF PROJECT 2.170 Mi.

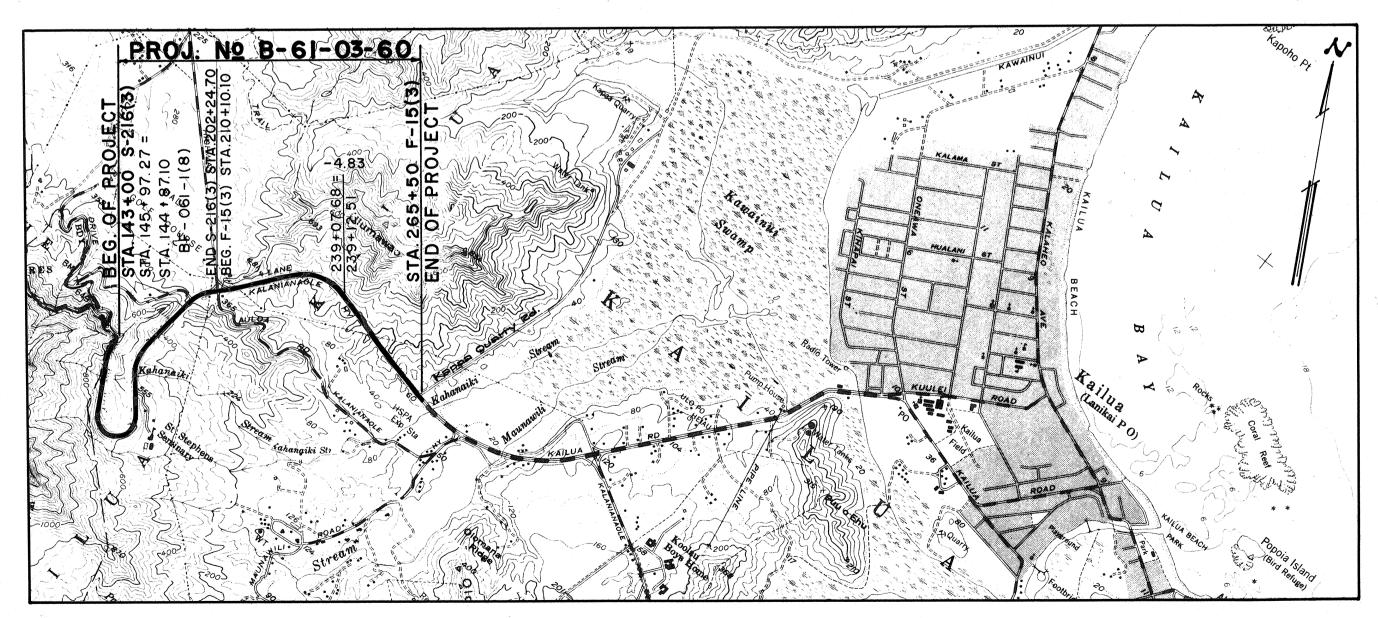

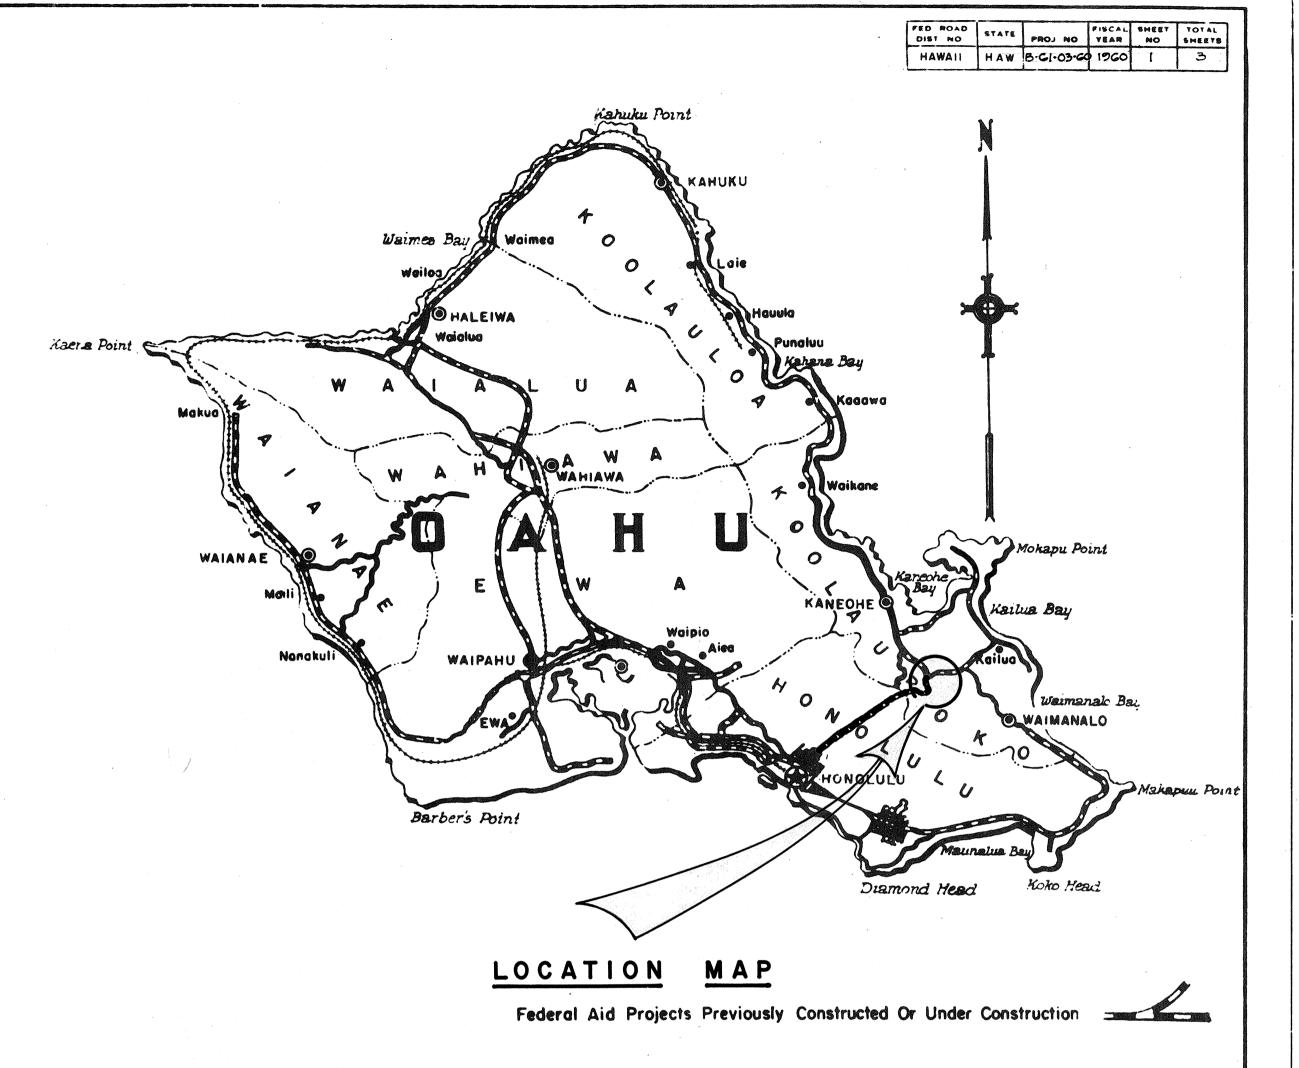


NOTE:

ALL CHANGES MADE DURING CONSTRUCTION HAVE BEEN NOTED IN THESE TRACINGS IN RED AND CHECKED BY

RESIDENT ENGINEER

9/1/6/
DATE

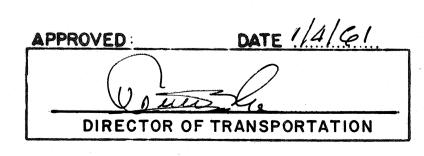

SHEET Nº 1 OF 3 SHEETS

]]]] 0 (6) 1[0 (1) 3] 0 (6) (

