

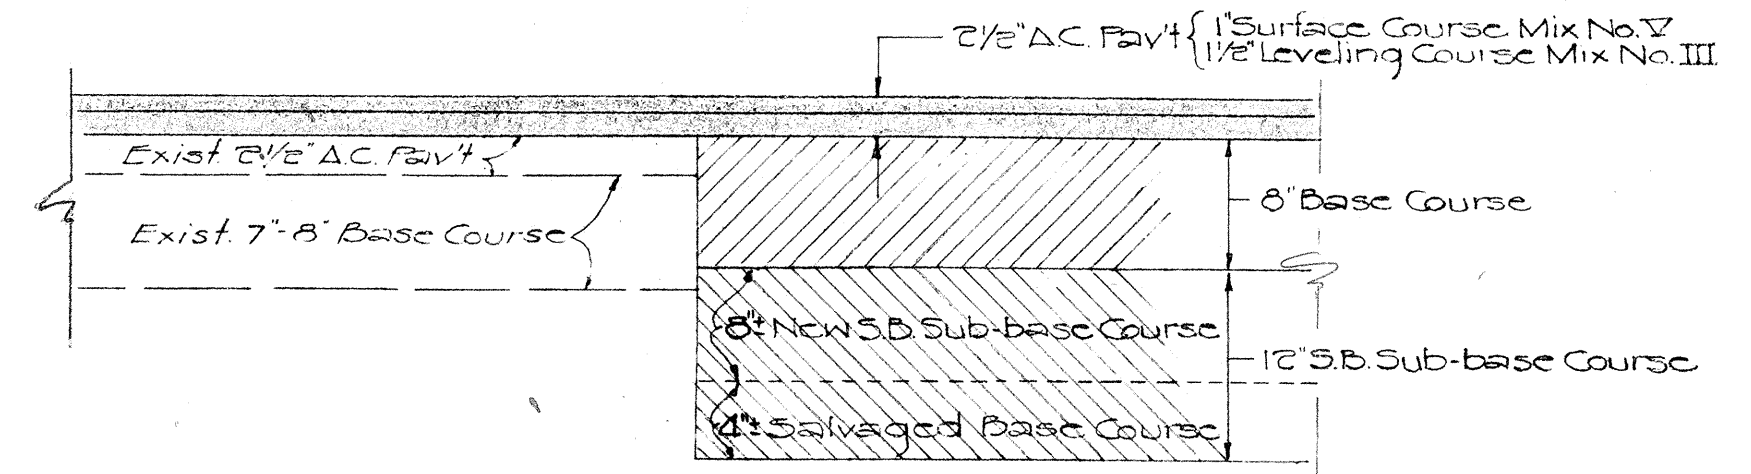


TYPICAL SECTION AS ORIGINALLY CONSTRUCTED
Scale: 1/4" = 1'-0"

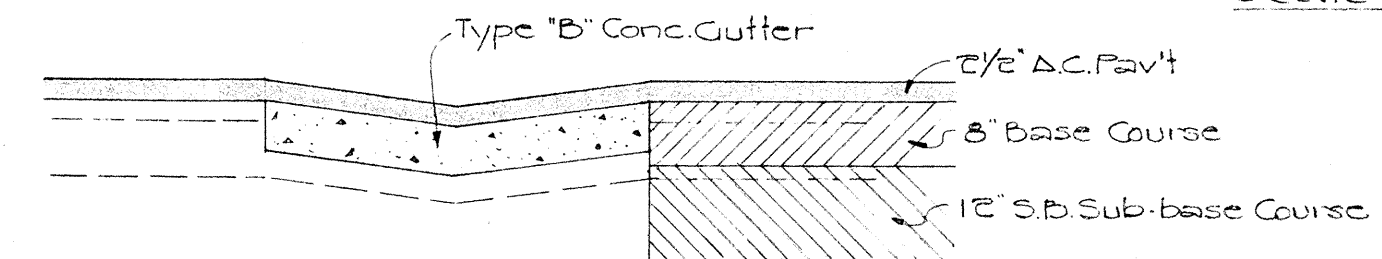

TYPICAL DETAIL FOR TRANSVERSE AND LONGITUDINAL JOINTS
Scale: Not to scale

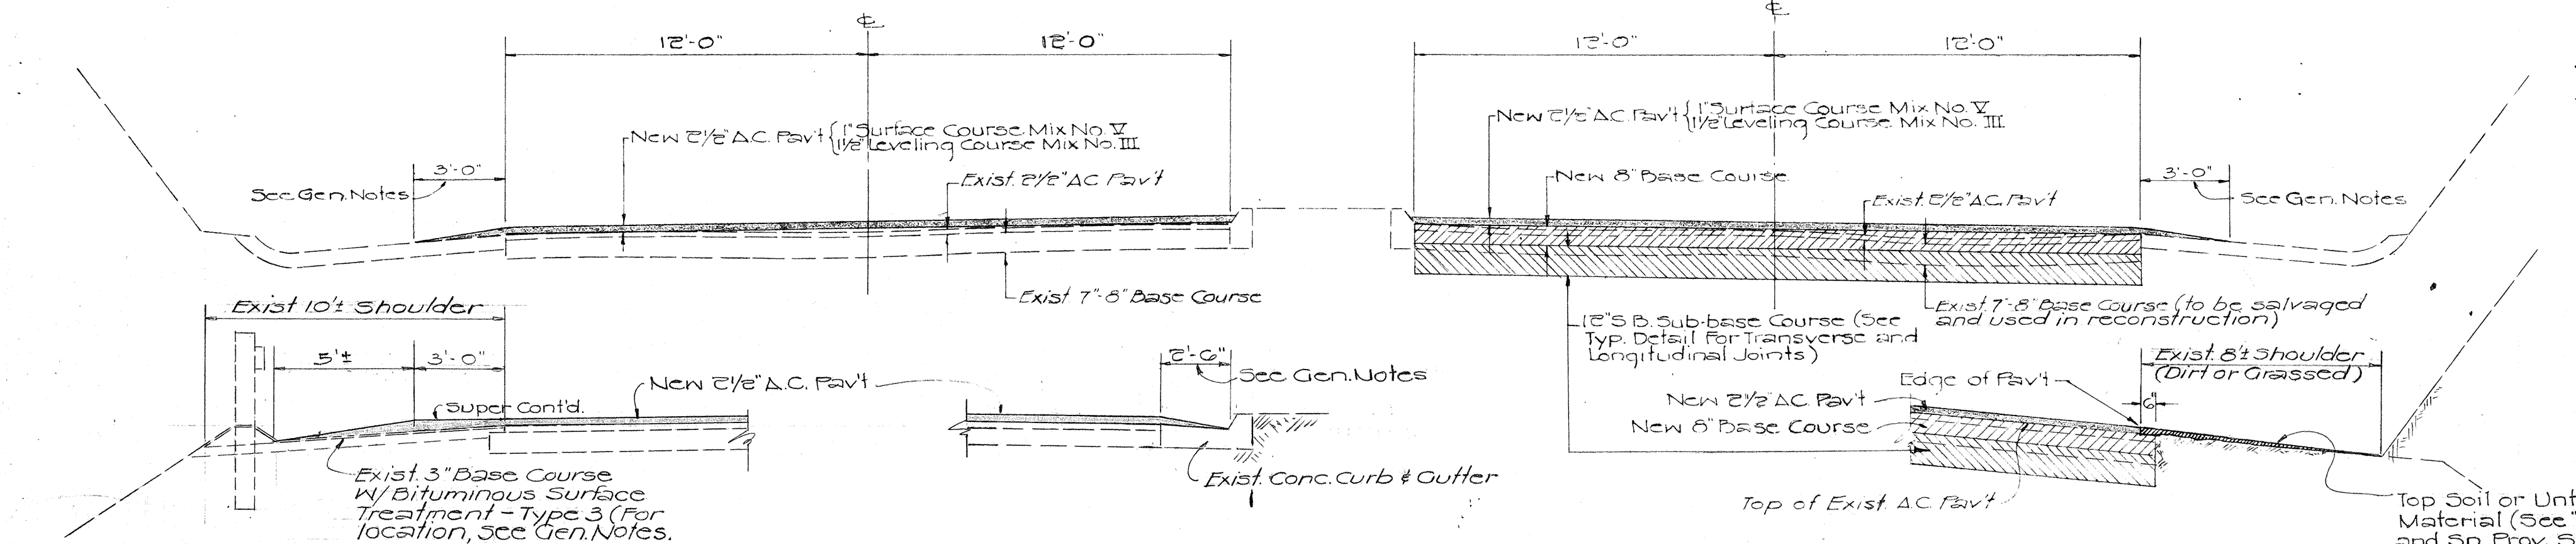


TYPICAL SECTION - RECONSTRUCTED BASE & RESURFACING AT TYPE "B" CONCRETE GUTTER SECTION
Scale: Not to Scale

NOTE:
1. For reconstructed base on one lane and resurfacing on both lanes, see Typical Detail for Transverse and Longitudinal Joints, this sheet.
2. Resurfacing or reconstruction on curve section of roadway shall include extra widening.
3. For General Notes, see Sheet No. 3.


TYPICAL SECTION (RESURFACING ONLY)
Scale: 1/4" = 1'-0"

TYPICAL SECTION (RECONSTRUCTED BASE & RESURFACING)
Scale: 1/4" = 1'-0"

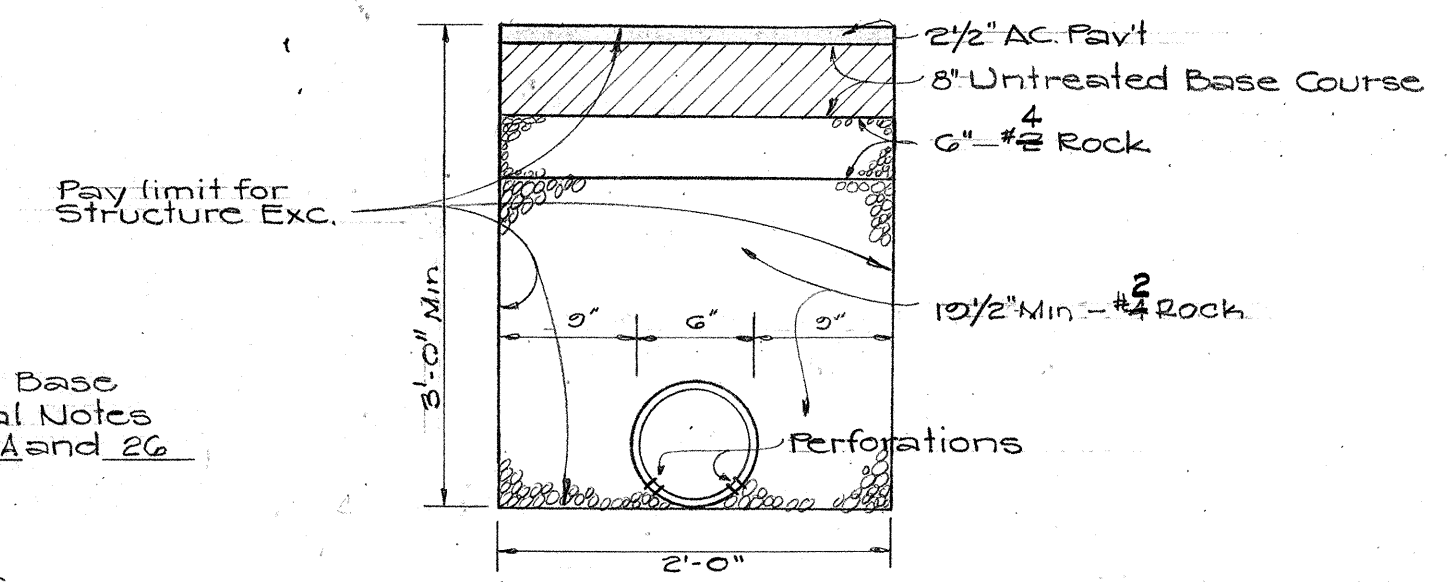


6" PERFORATED ASBESTOS CEMENT UNDERDRAIN PIPE
Scale: Not to scale

NOTE: Subdrains shall be installed in reconstructed areas where seepage water is visible when the subgrade is exposed or seepage conditions are suspected. The area anticipated is between Hairpin turn and Castle Junction.

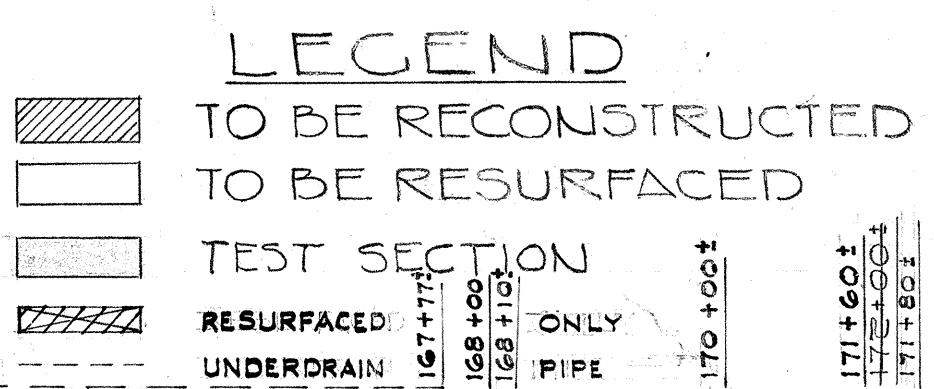

TEST SECTION "A" Not to Scale

TEST SECTION "B" Not to Scale

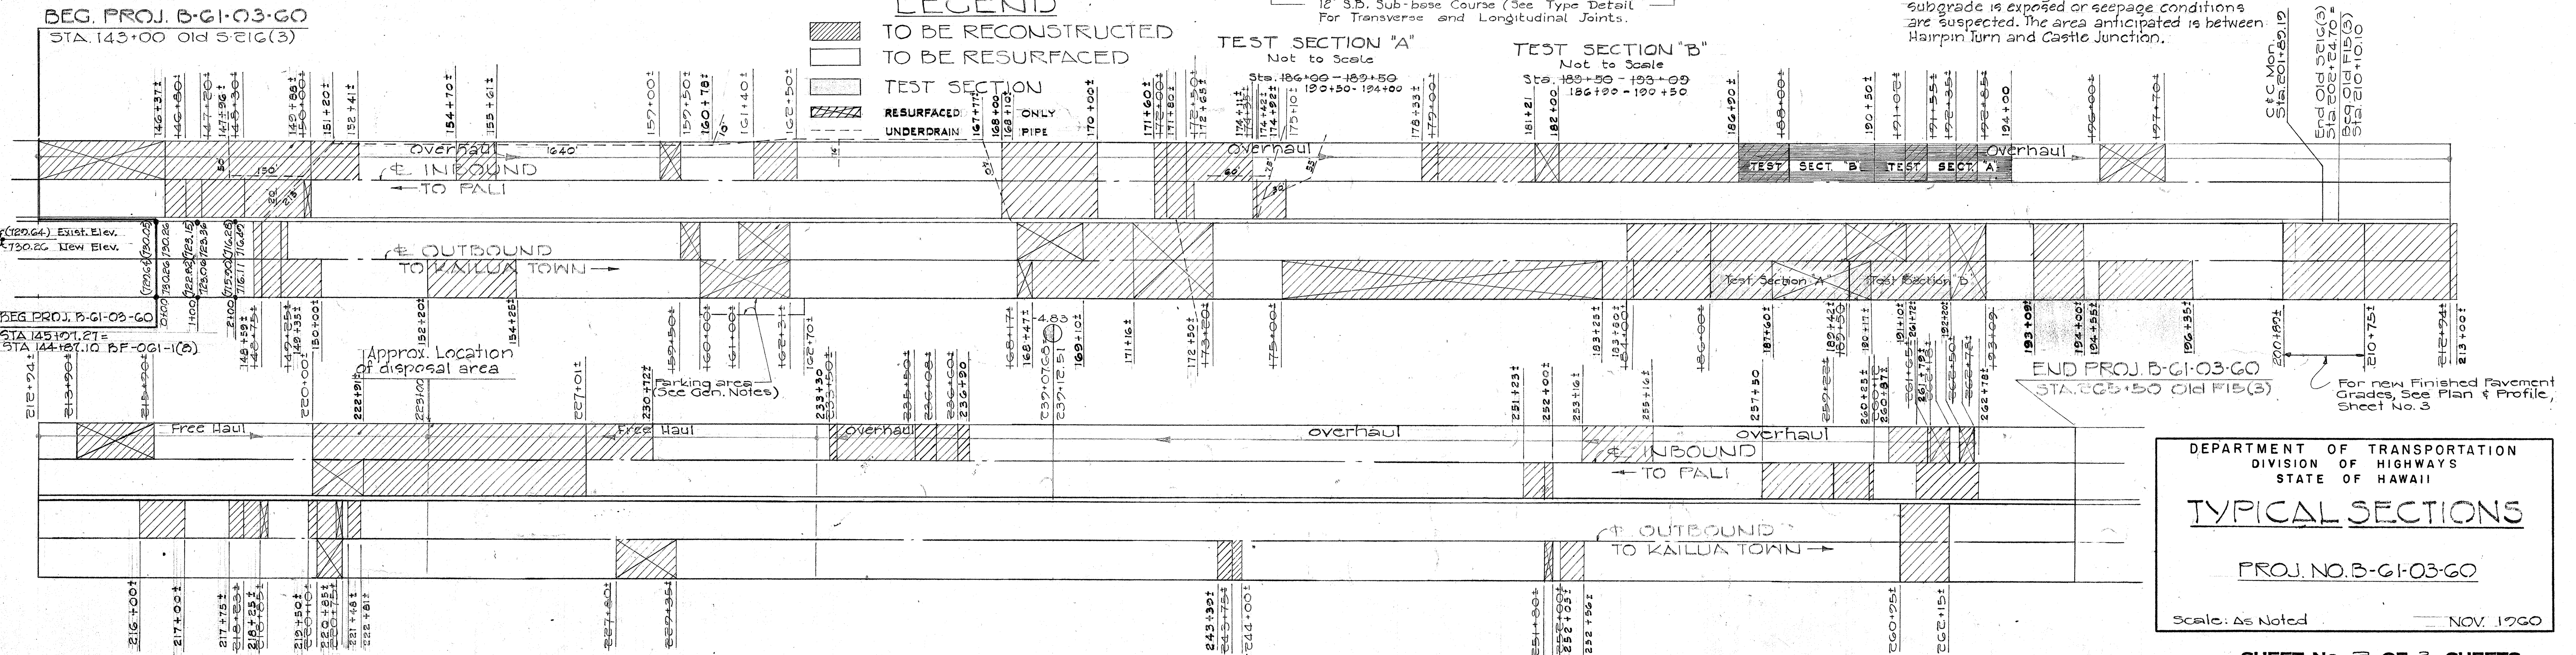

DEPARTMENT OF TRANSPORTATION
DIVISION OF HIGHWAYS
STATE OF HAWAII

TYPICAL SECTIONS

PROJ. NO. B-G-03-60

Scale: As Noted

NOV. 1960

SHEET No. 2 OF 3 SHEETS

DATE
DESIGNED BY
TRACED BY
QUANTITIES BY
CHECKED BY
NOTE BOOK
No.