



PLAN	SURVEYED	BY	DATE
NOTE BOOK	PLOTTED		
NO.	ALIGNMENT CHECKED		
	RT. OF WAY CHECKED		

PROFILE	SURVEYED _____	BY _____	DATE _____
NOTE BOOK	PLOTTED _____		
	GRADES CHECKED _____		
	B. M.'S NOTED _____		
NO.	STRUCTURE NOTATIONS CHKD _____		

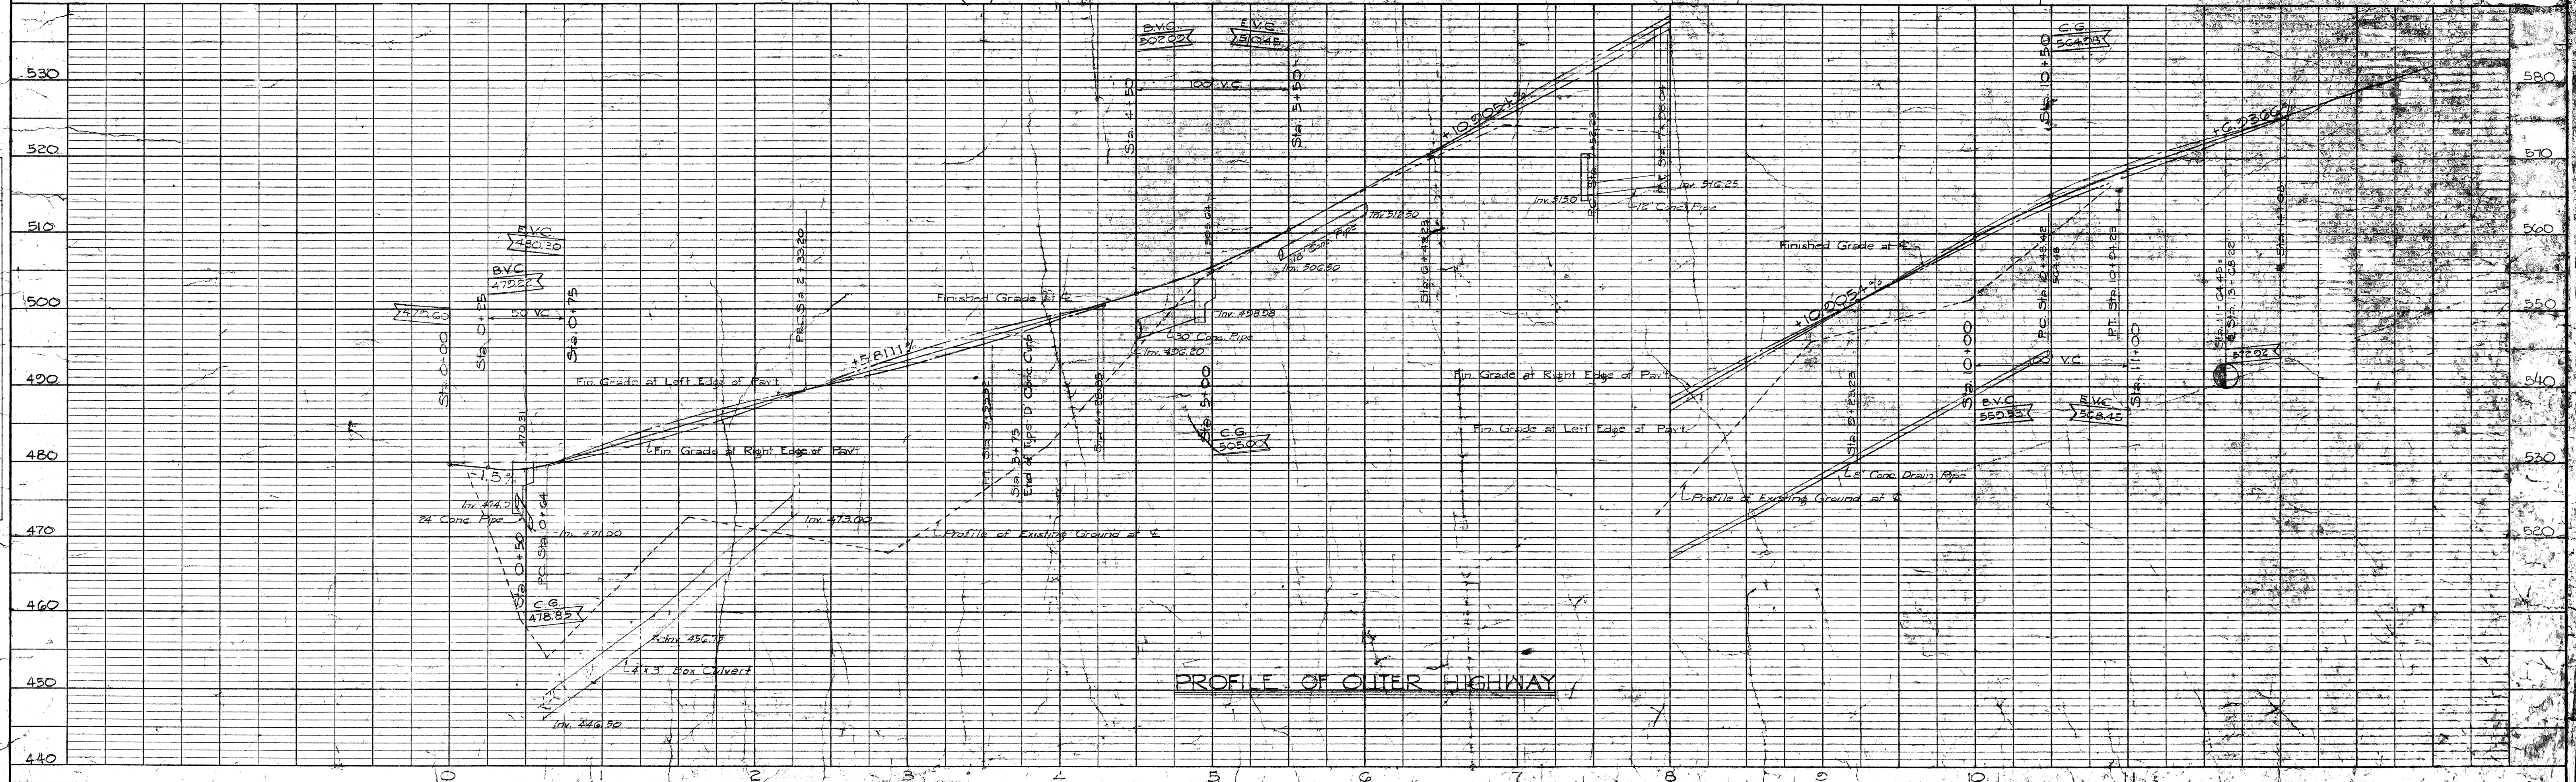

PLAN	DATE	BY	DATE
SURVEYED			
NOTED			
PLANNED			
CONSTRUCTED			
REVISIONS			
NO.			

PROFILE	DATE	BY	DATE
SURVEYED			
NOTED			
PLANNED			
CONSTRUCTED			
REVISIONS			
NO.			

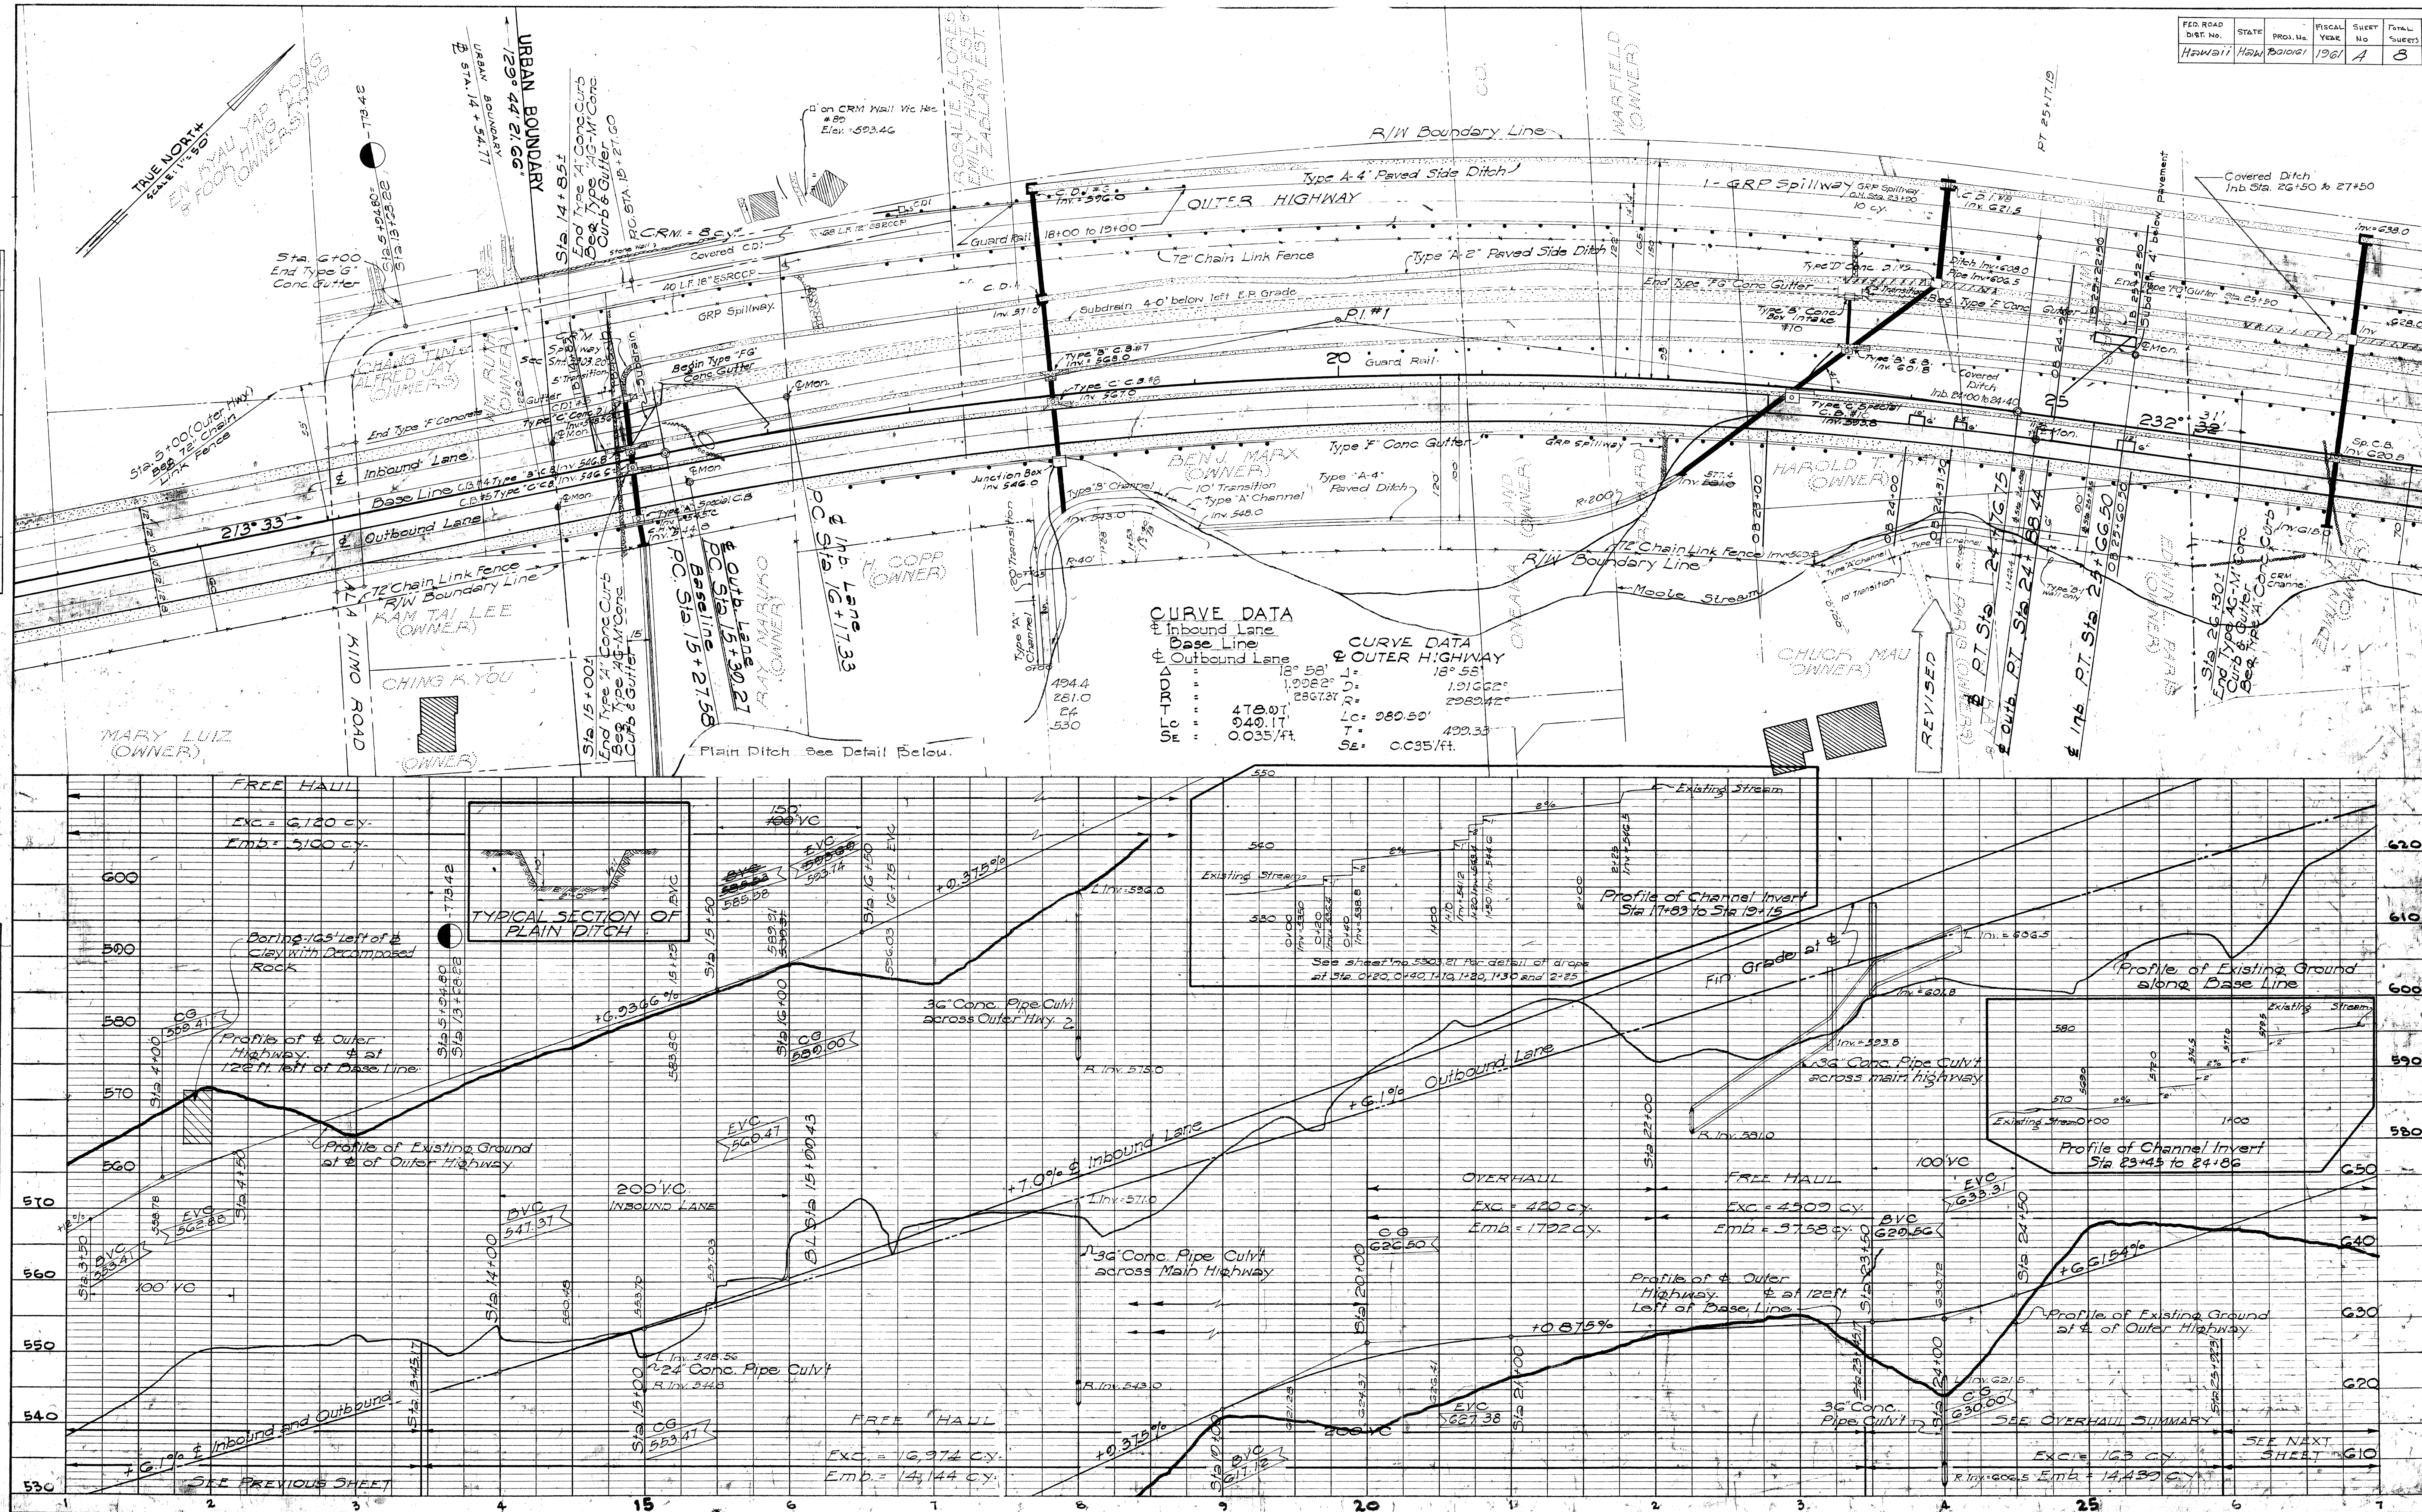

PLAN	DATE	BY	DATE
SURVEYED			
NOTE BOOK			
ALIGNMENT CHECKED			
RT. OF WAY CHECKED			
NO.			

PROFILE	DATE	BY	DATE
SURVEYED			
NOTE BOOK			
GRADES CHECKED			
B. M. S. NOTED			
STRUCTURE NOTING CHD.			
NO.			

