




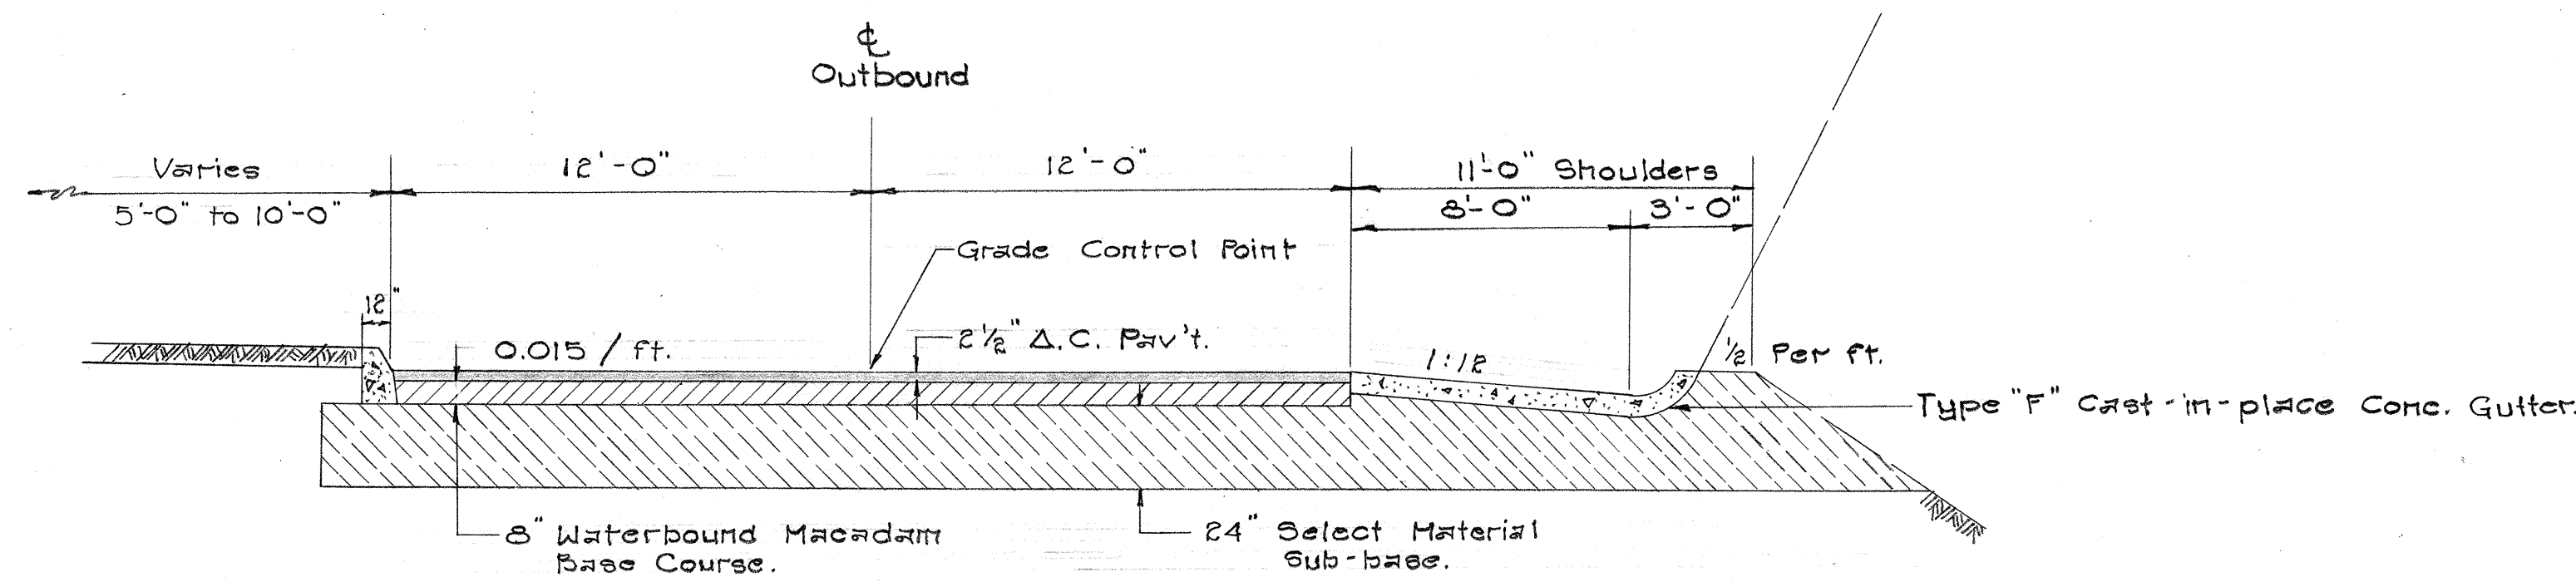



**TYPICAL SECTION ON TANGENT
(EXISTING)**
Scale: 1/4" = 1'-0"

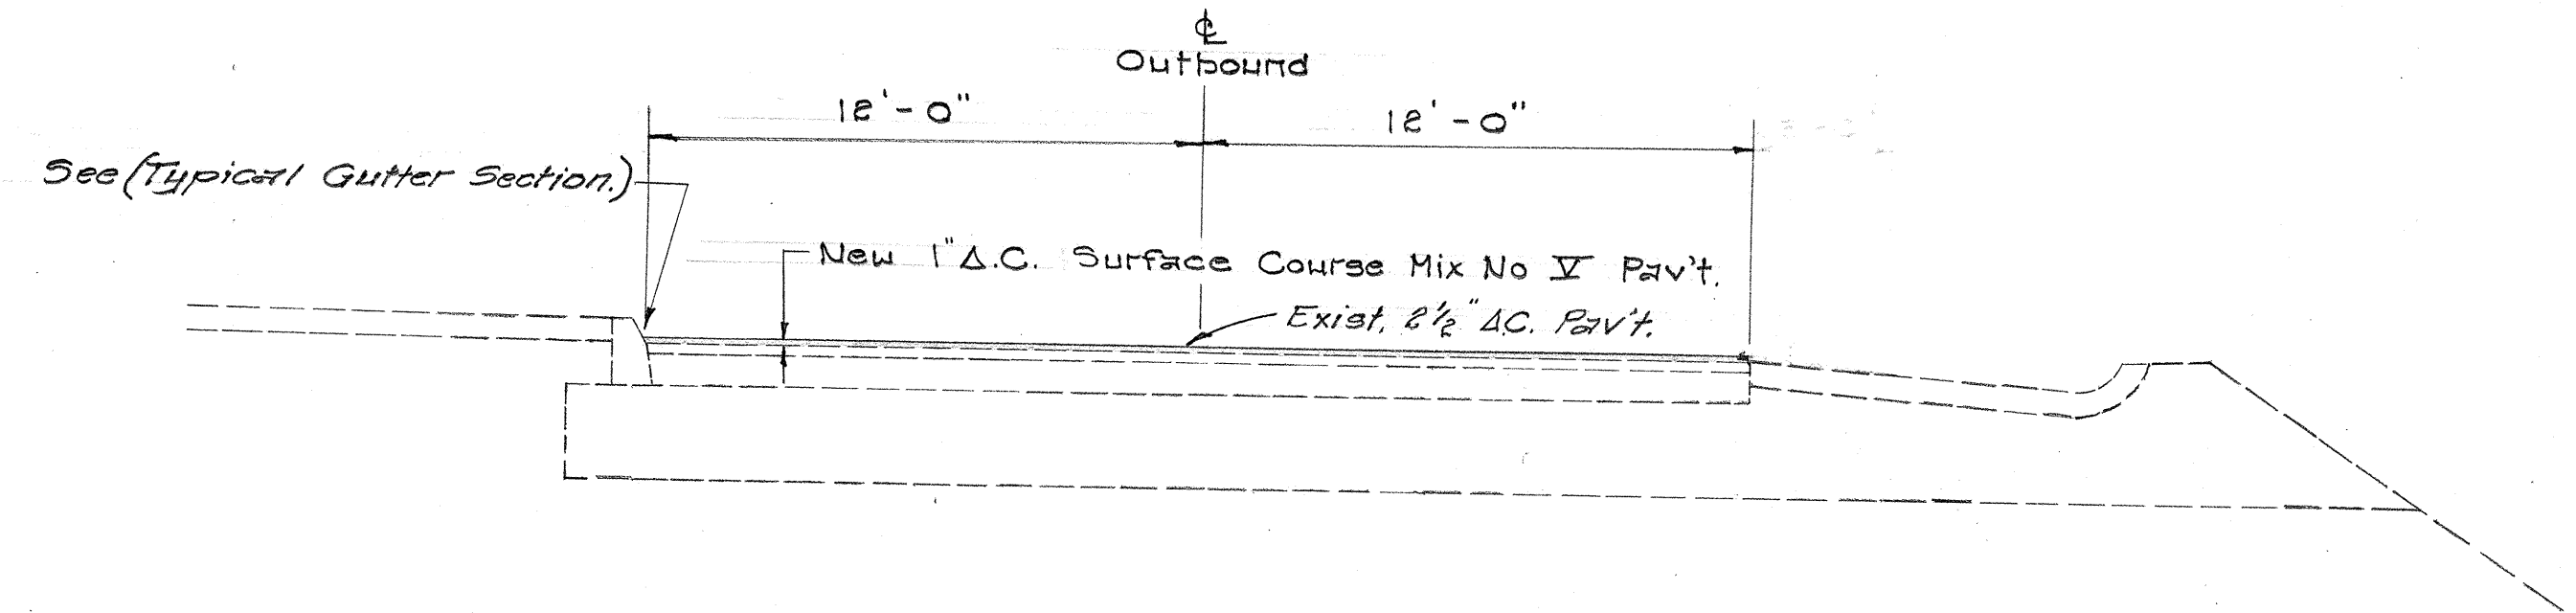


**TYPICAL SECTION
(RESURFACING ONLY)**
Scale: 1/4" = 1'-0"

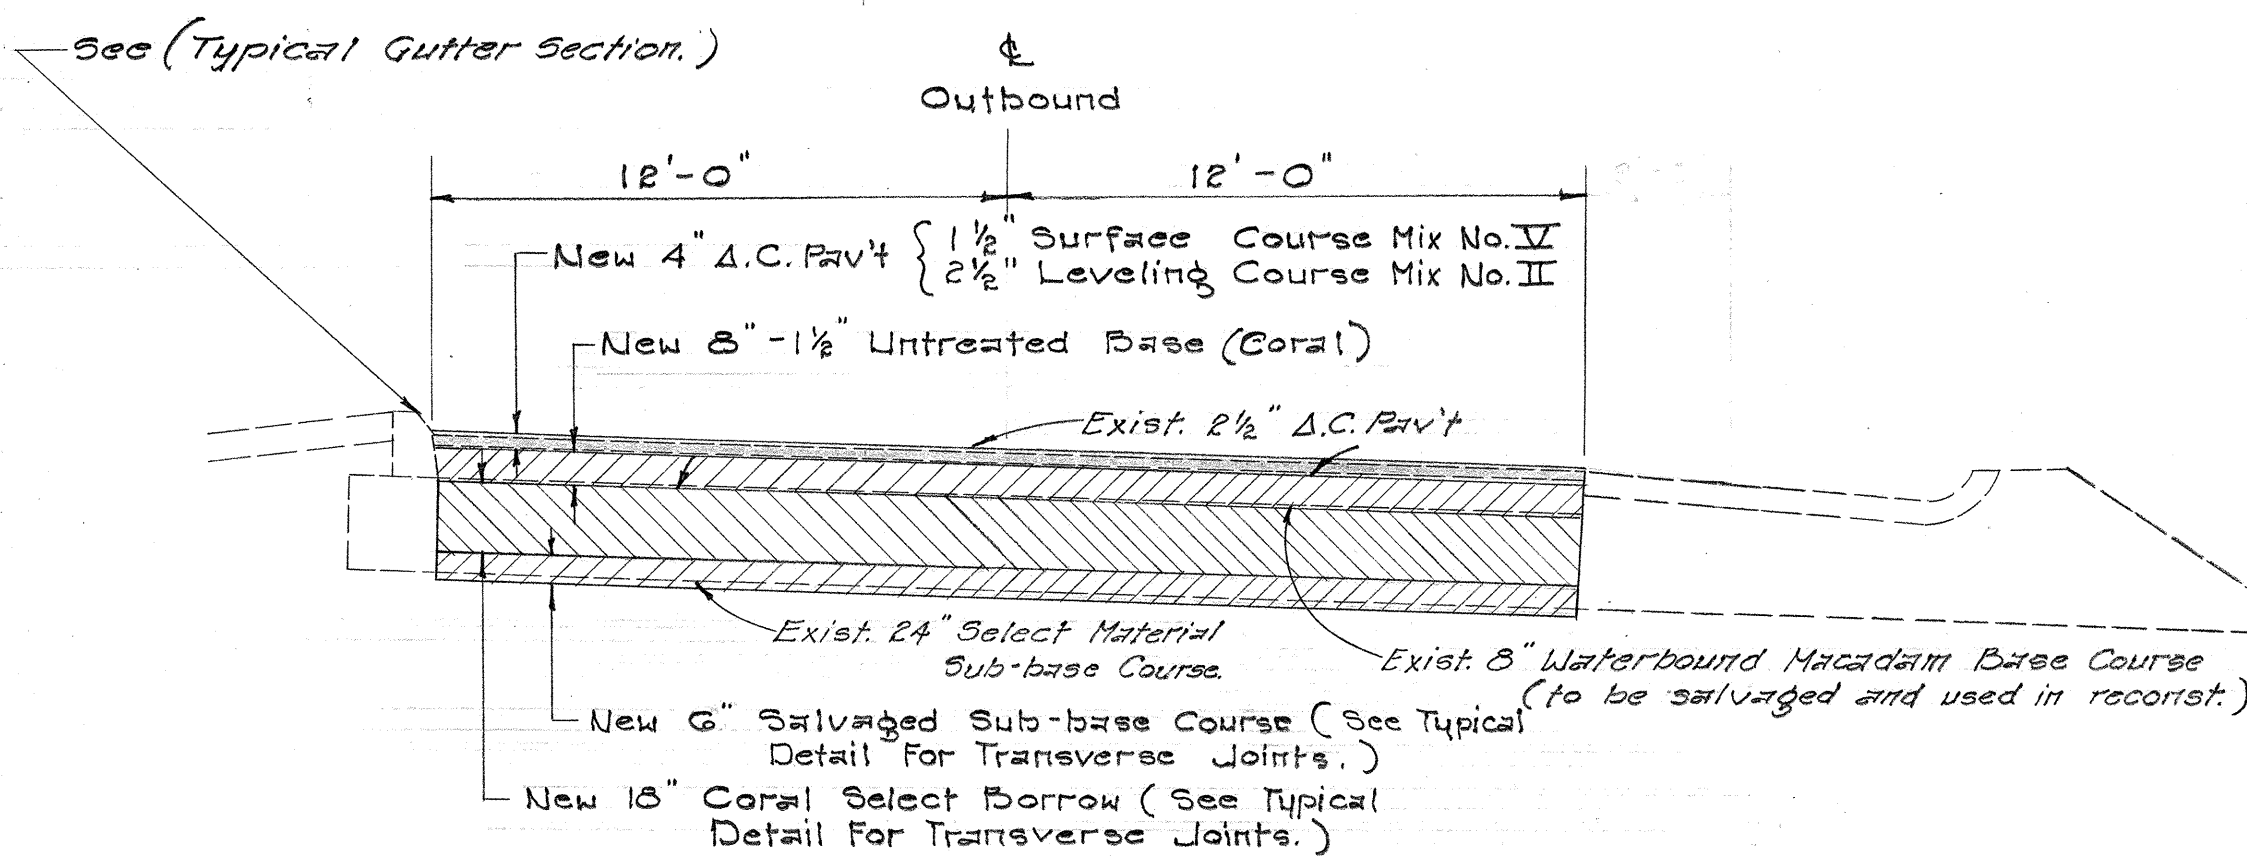


**TYPICAL SECTION ON CURVE
(RECONSTRUCTED BASE & RESURFACING)**
Scale: 1/4" = 1'-0"

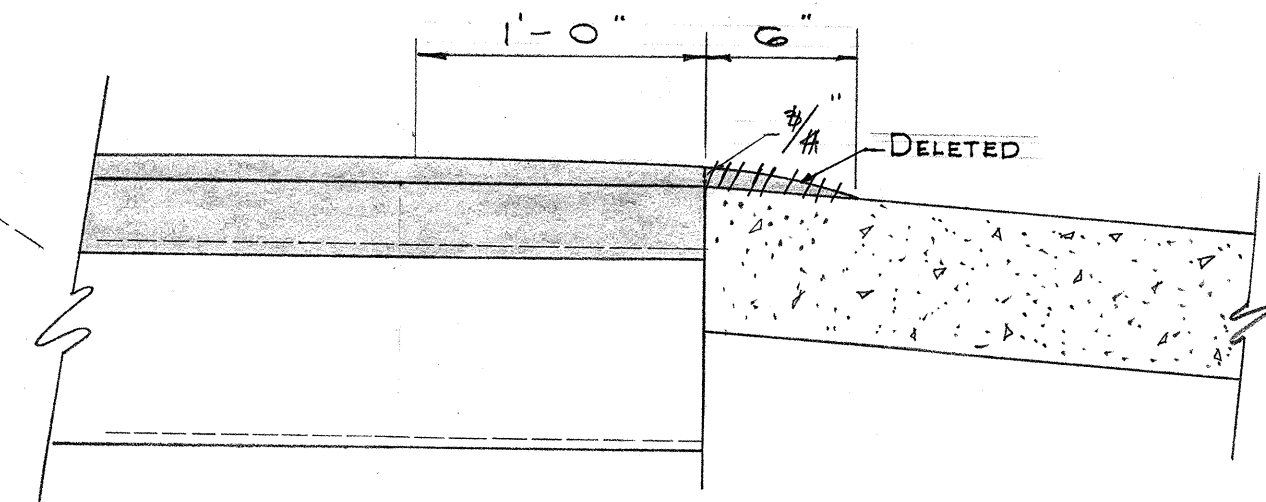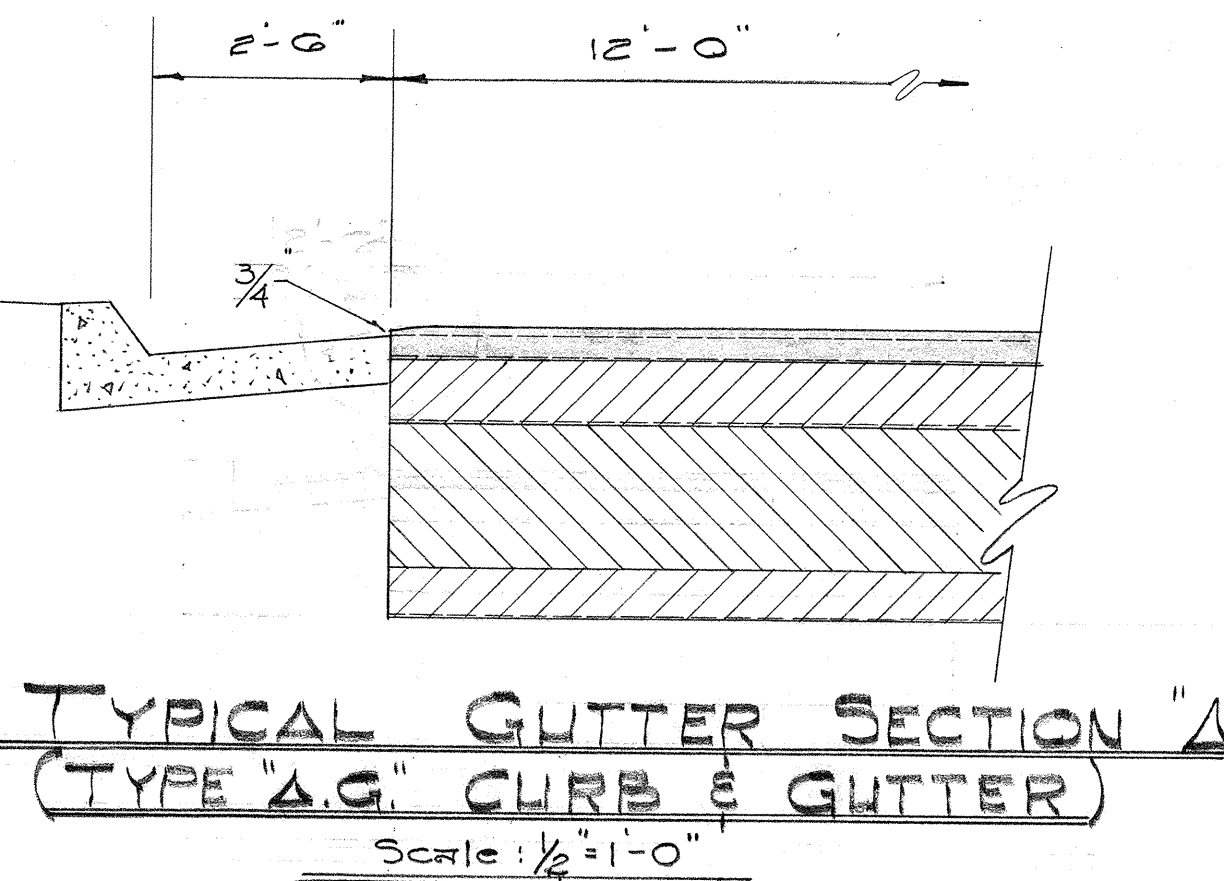

SECTION "A-A"
Scale: 1 1/2" = 1'-0"

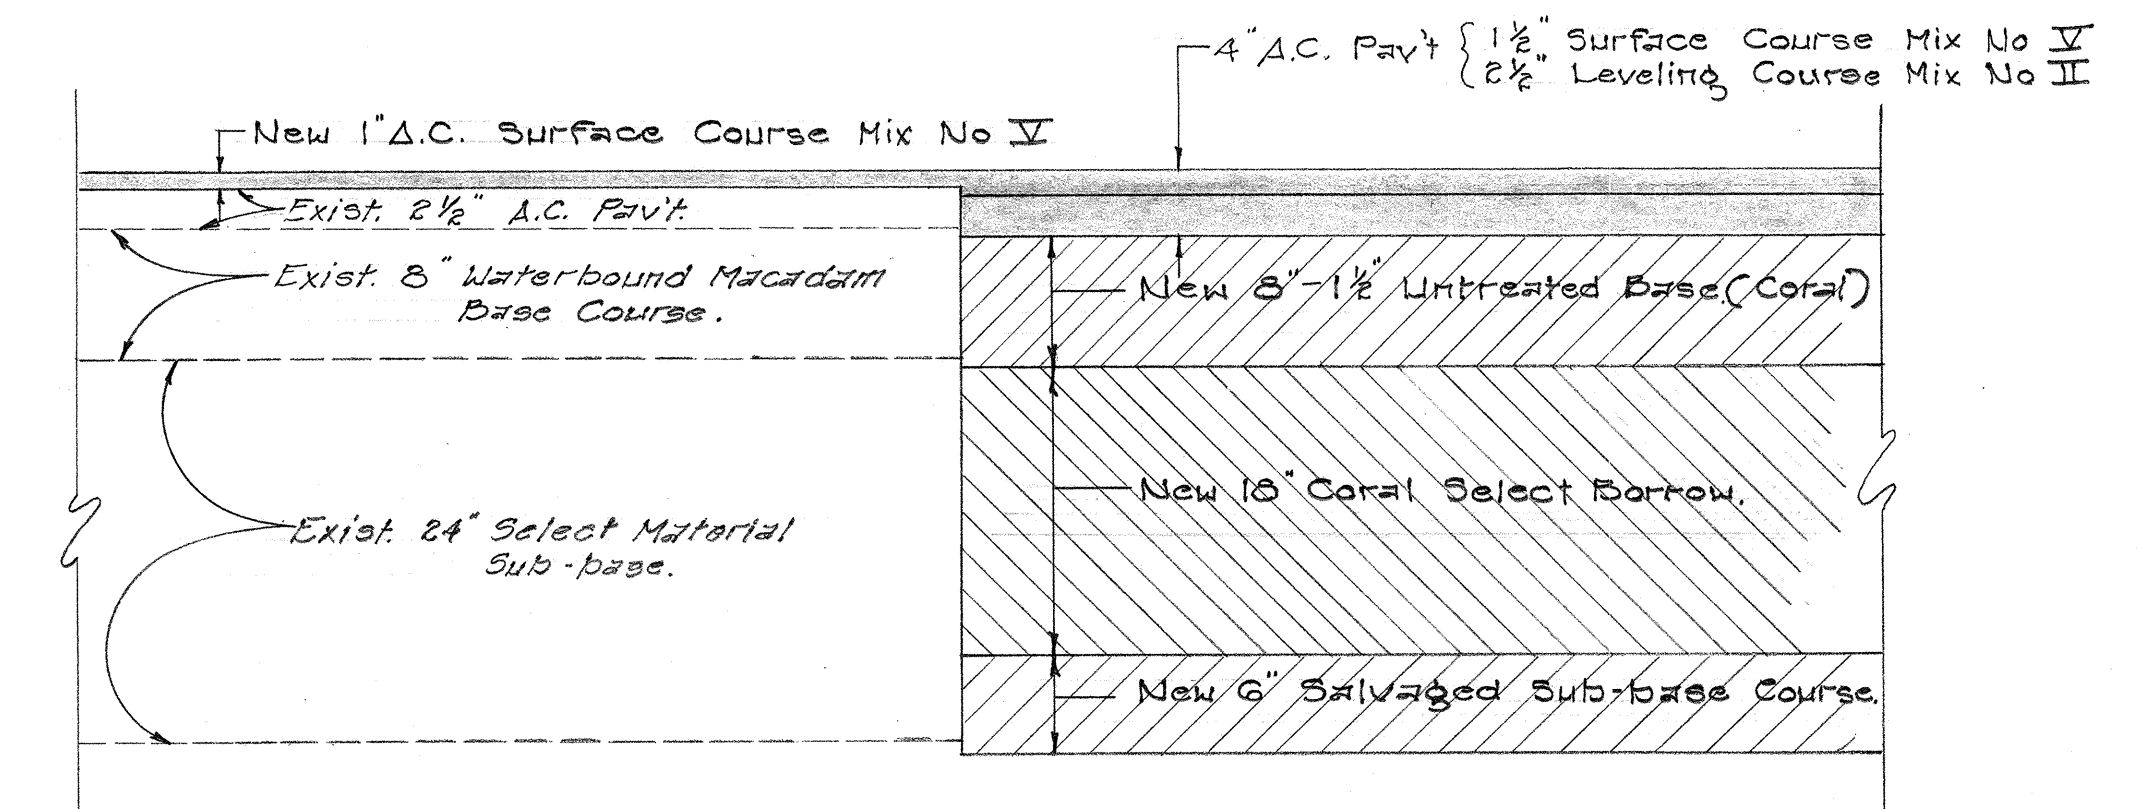

TYPICAL DETAIL FOR TRANSVERSE JOINTS
Scale: 1" = 1'-0"

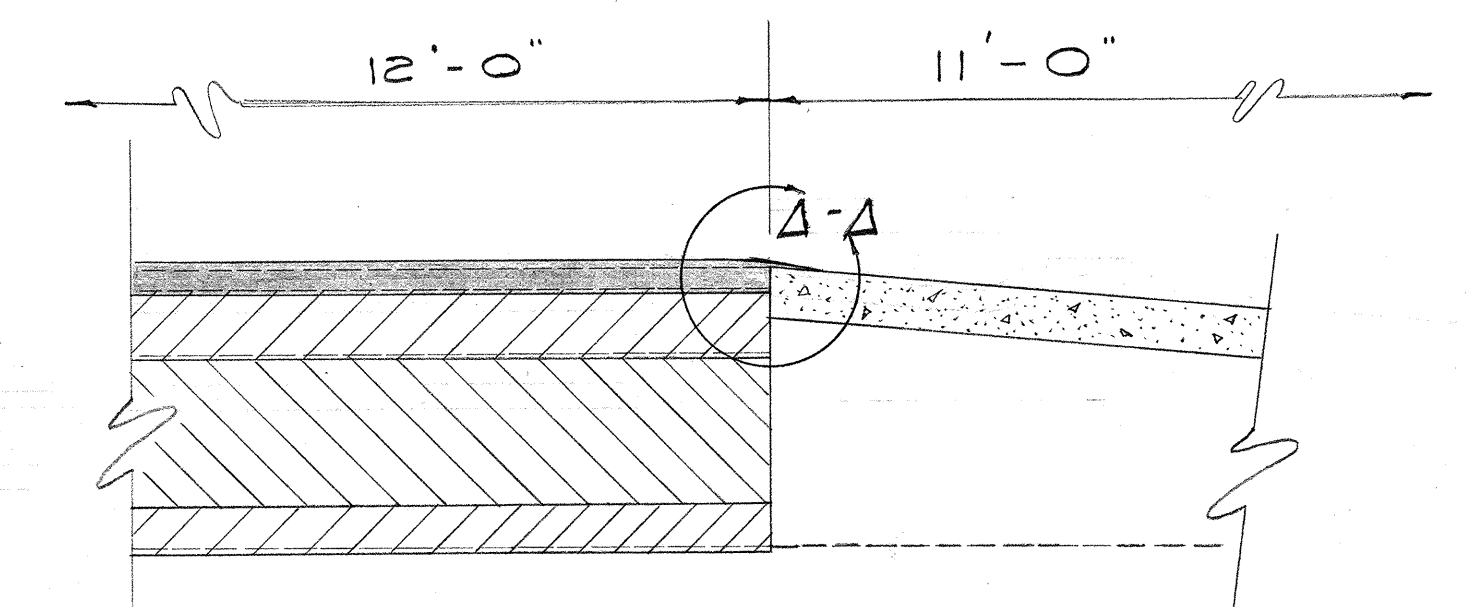

**TYPICAL GUTTER SECTION "B"
(TYPE "F" CAST-IN-PLACE CONC. GUTTER)**
Scale: 1/2" = 1'-0"

General Notes:

- 1- Approximate limits of reconstruction & resurfacing.
a- Reconstruction: sta. 6+00 to 23+00 & sta. 44+23.14 to 46+23.14.
b- Resurfacing with spot reconstruction as designated by the Engineer: sta. 23+00 to 44+23.14.
c- Resurfacing only: sta. 46+23.14 to 47+23.14.
- 2- New resurfaced pavement adjacent to concrete gutters 2 1/2 ft. wide or less shall be rounded-out to 3/4 in. at the edge of pavement. (See Typical Gutter Section "A".)
- 3- New resurfaced pavement adjacent to concrete gutters 8 ft. wide shall be rounded-out to 3/4 in. at the edge of pavement. (See Typical Gutter Section "B".)
- 4- See drainage sheets for drainage notes.
- 5- Construct smooth riding connections at beginning & end of project.

SURVEY PLOTTED BY	DATE
DRAWN BY	
TRACED BY	
QUANTITIES CHECKED BY	
CHECKED BY	
NOTE BOOK No.	

**TYPICAL SECTION ON TANGENT
(RECONSTRUCTED BASE & RESURFACING)**
Scale: 1/4" = 1'-0"

DEPARTMENT OF TRANSPORTATION DIVISION OF HIGHWAYS STATE OF HAWAII	
TYPICAL SECTIONS	
PROJ. NO. B-61-01-61	
Scale: As Noted	MAY 1961