


FED. ROAD DIST. NO.	STATE	FED. AID PROJ. NO.	FISCAL YEAR	SHEET NO.	TOTAL SHEETS
HAWAII	HAW.	P-061-1(II)	1966	8	16

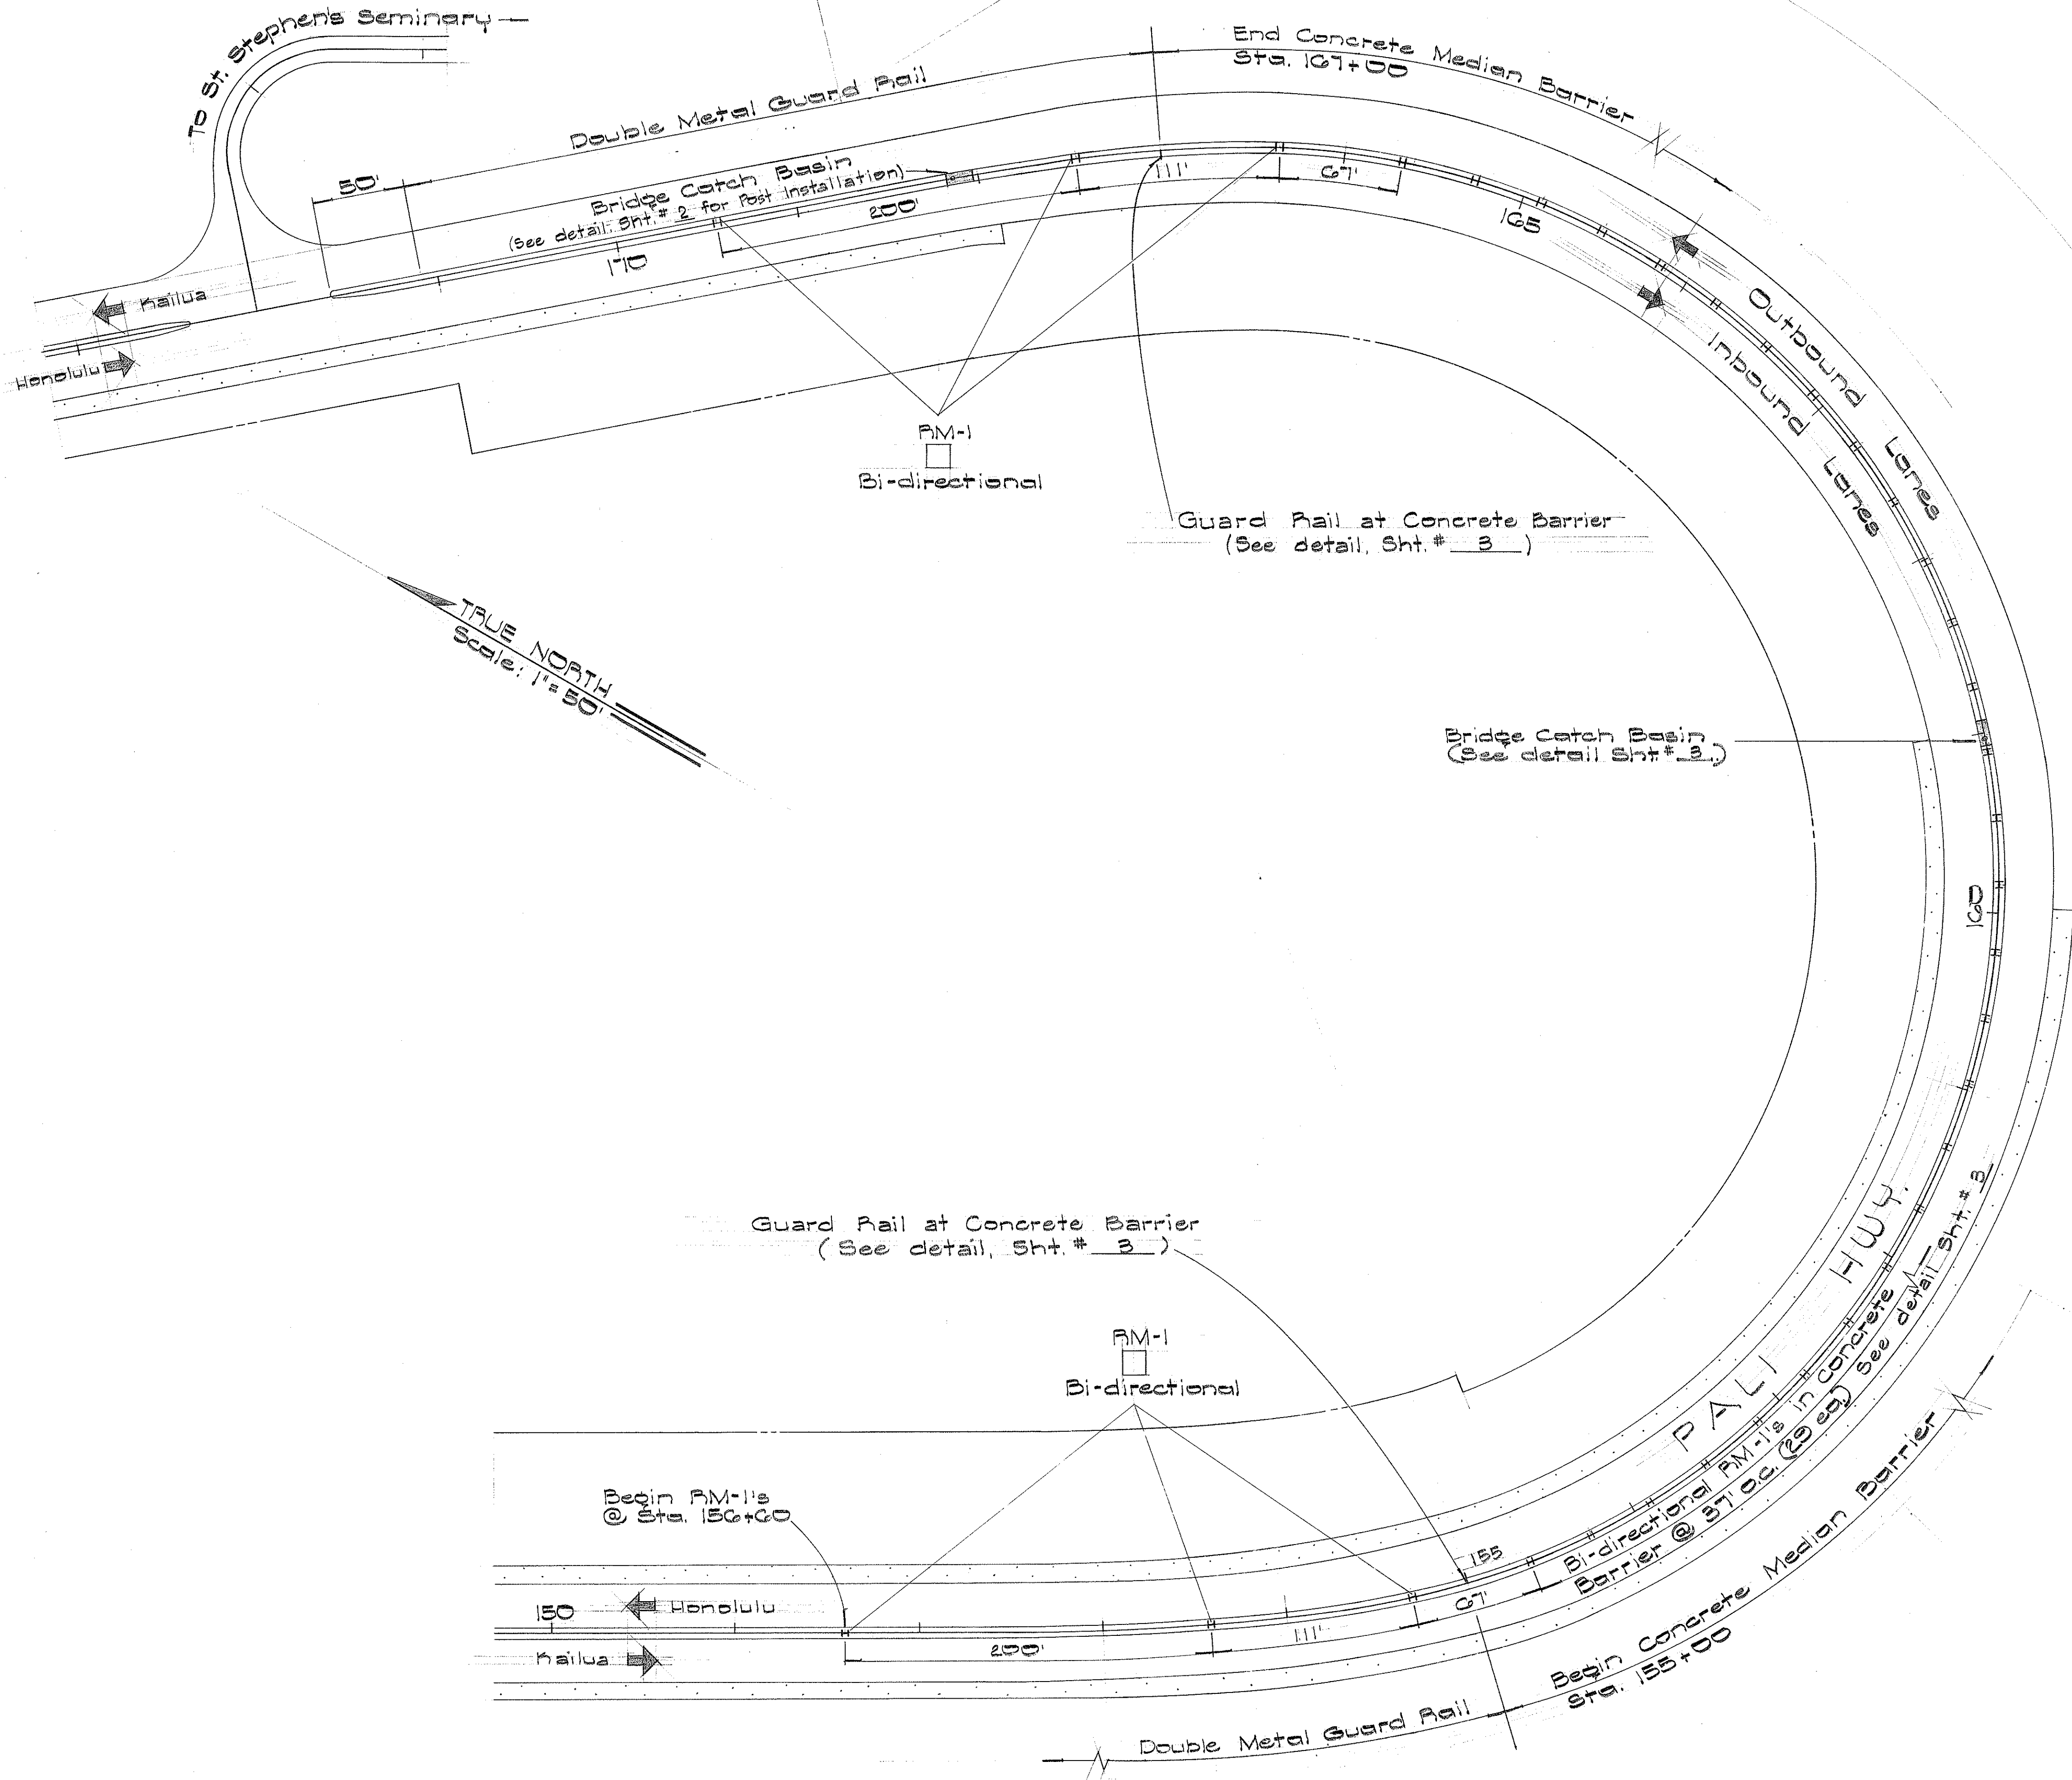

- NOTE:
1. P.M.-1's beginning from Sta. 150+00 to Sta. 167+00 shall be clear reflector markers.
 2. Pipe posts in Concrete Median barrier shall be 2 inches in diameter.
 3. Existing reflector markers shall be cleaned and relocated on pipe posts. (2 per post)
 4. Existing reflector markers on channel post shall be cleaned and relocated. (Beach)

STATE OF HAWAII
DEPARTMENT OF TRANSPORTATION
HIGHWAYS DIVISION

**CONCRETE MEDIAN BARRIER
LAYOUT**

MEDIAN GUARD RAIL ON PALI HIGHWAY
Proj. No. F-061-1(II)

Scale: as Shown March, 1966

SHEET No. OF SHEETS

ORIGINAL PLAN	DATE
DRAWN BY	
DESIGNED BY	
NOTED BY	
CHECKED BY	
No.	