

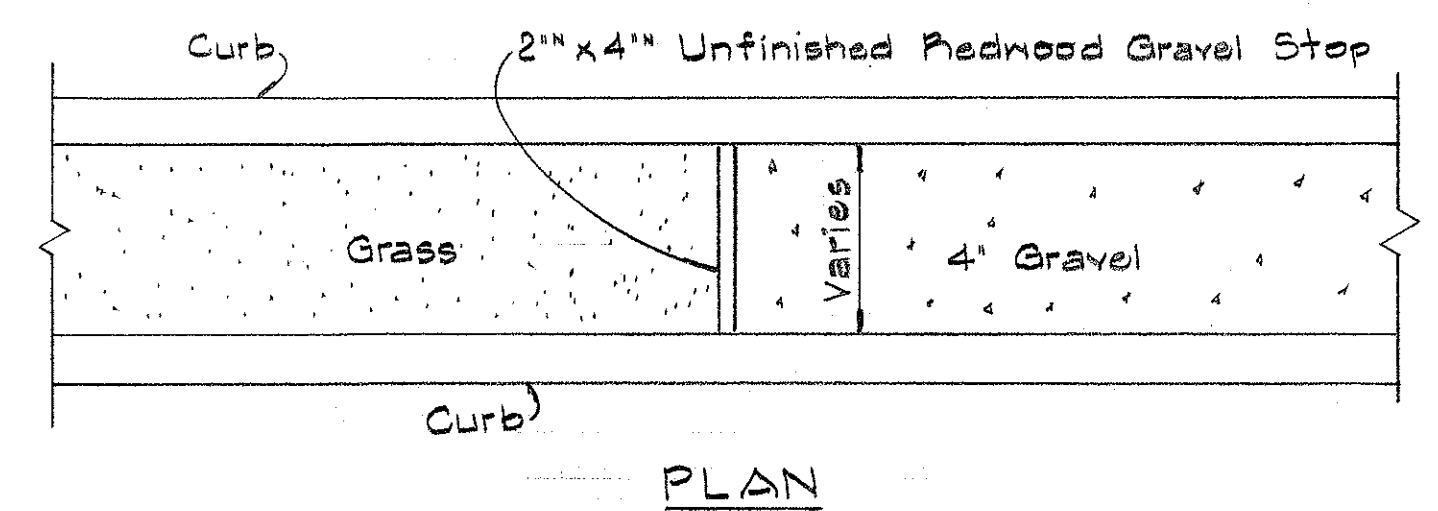
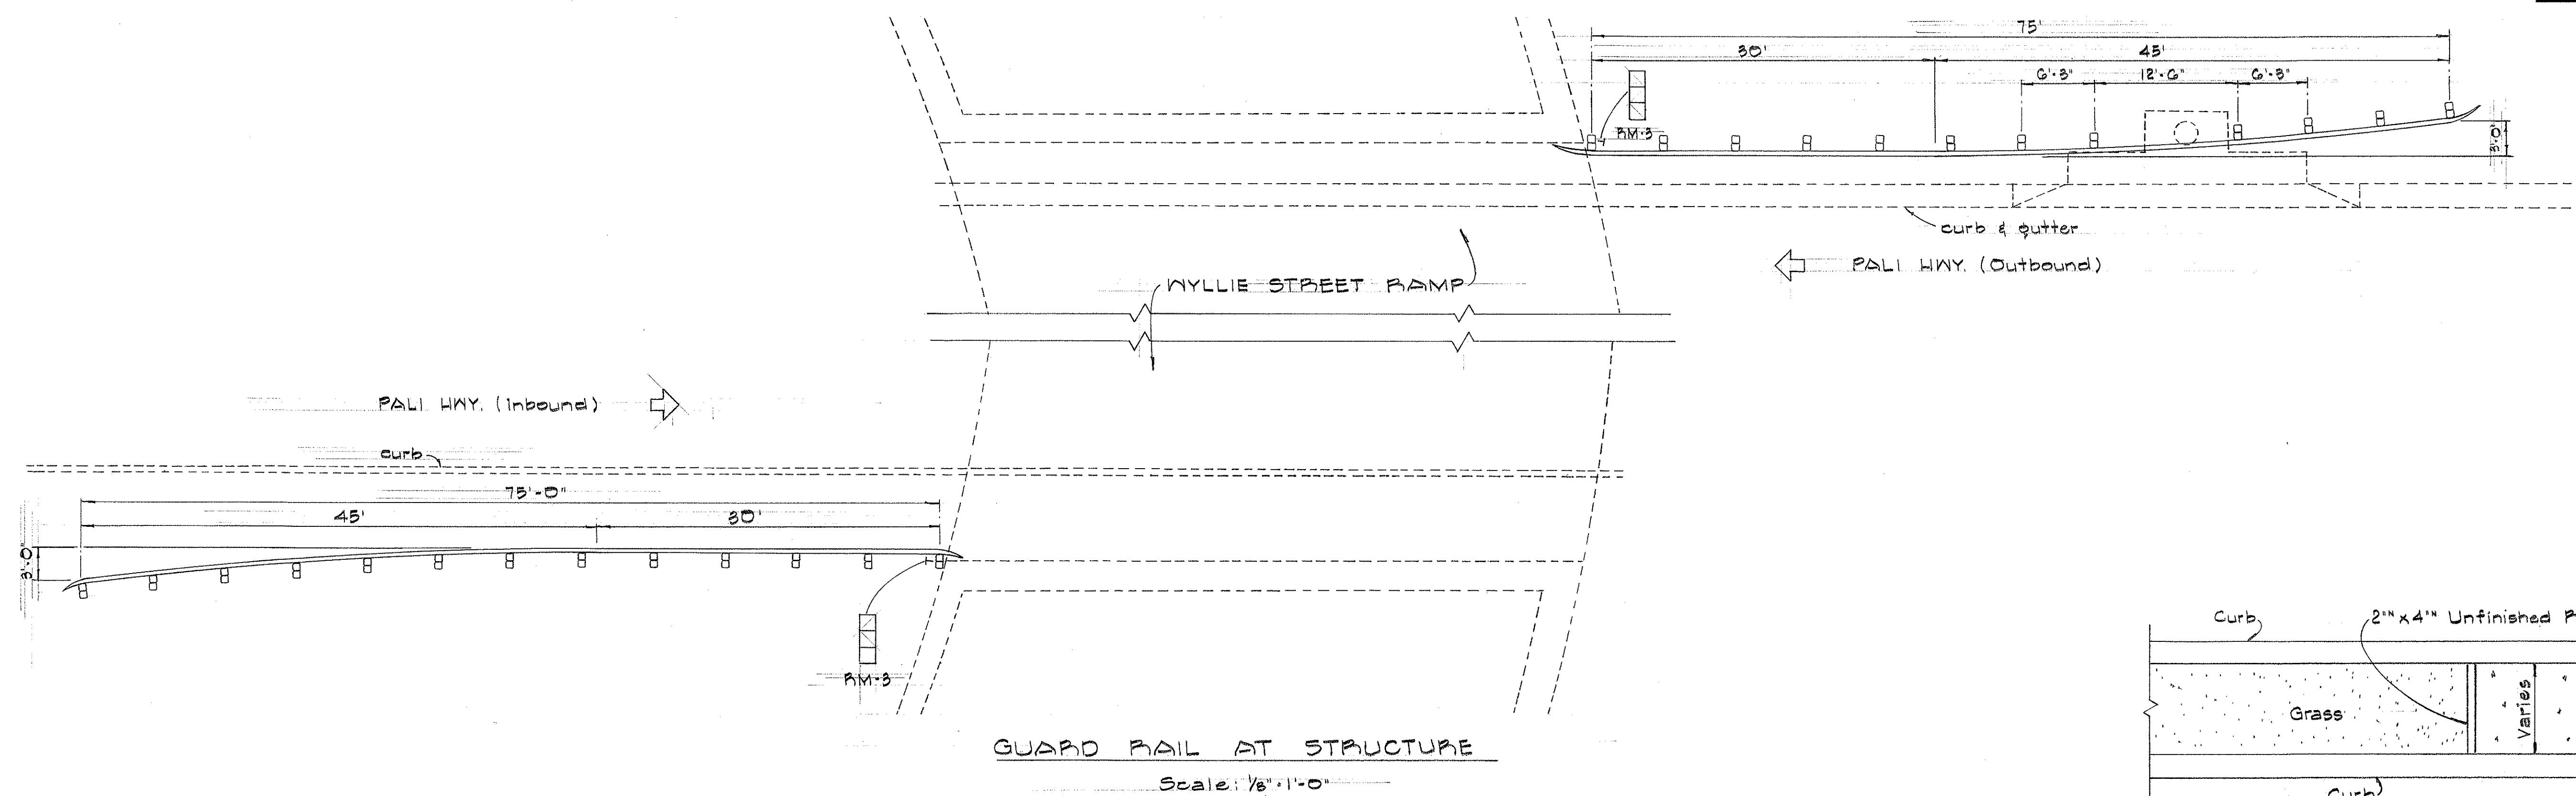


FED. ROAD DIST. NO.	STATE	FED. AID PROJ. NO.	FISCAL YEAR	SHEET NO.	TOTAL SHEETS
HAWAII	HAW.	F-061-(11)	1966	9	10

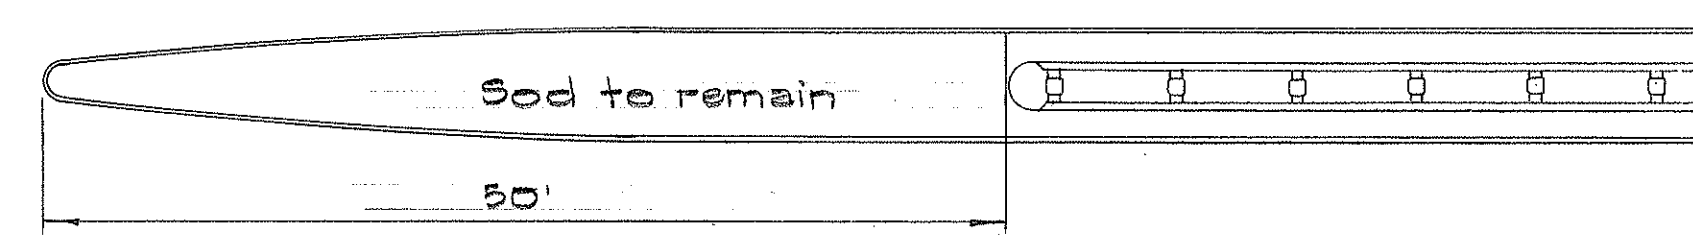

NOTE:
1. Redwood Gravel Stop shall be incidental to the various contract items.

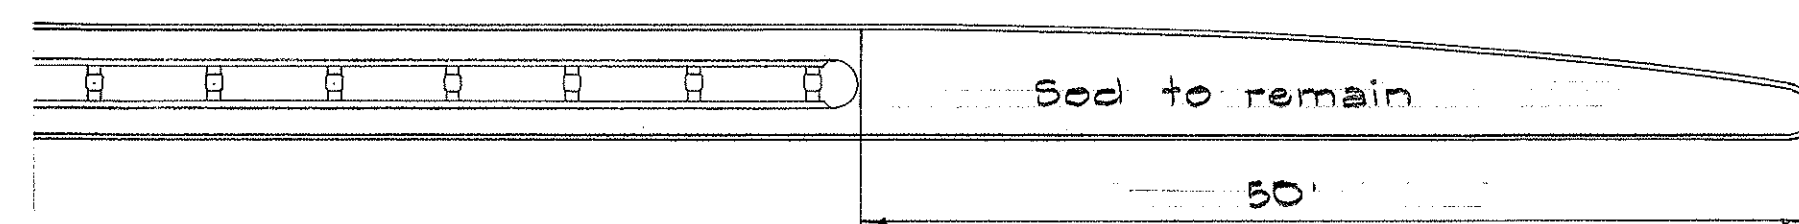

STATE OF HAWAII
DEPARTMENT OF TRANSPORTATION
HIGHWAYS DIVISION
GUARD RAIL AT STRUCTURE
TYPICAL DETAIL
MEDIAN OPENING
MEDIAN GUARD RAIL ON PALI HIGHWAY
Proj. No. F-061-1(11)
Scale: as Noted March, 1966
SHEET No. OF SHEETS