

[illegible]

STATE OF HAWAII
DEPARTMENT OF TRANSPORTATION
HIGHWAYS DIVISION
HONOLULU, HAWAII


PLANS FOR

PALI HIGHWAY

VICINITY OF KAILUA PORTAL
OF PALI TUNNELS TOWARDS KAILUA

FEDERAL AID PROJECT NO. F-061-1(12)
(GRADE AND DRAIN FACE OF LANDSLIDE AREA)

FED. ROAD DIST. NO.	STATE	FED. AID PROJ. NO.	FISCAL YEAR	SHEET NO.	TOTAL SHEETS
HAWAII	HAW.	F-061-1(12)	1966	1	4

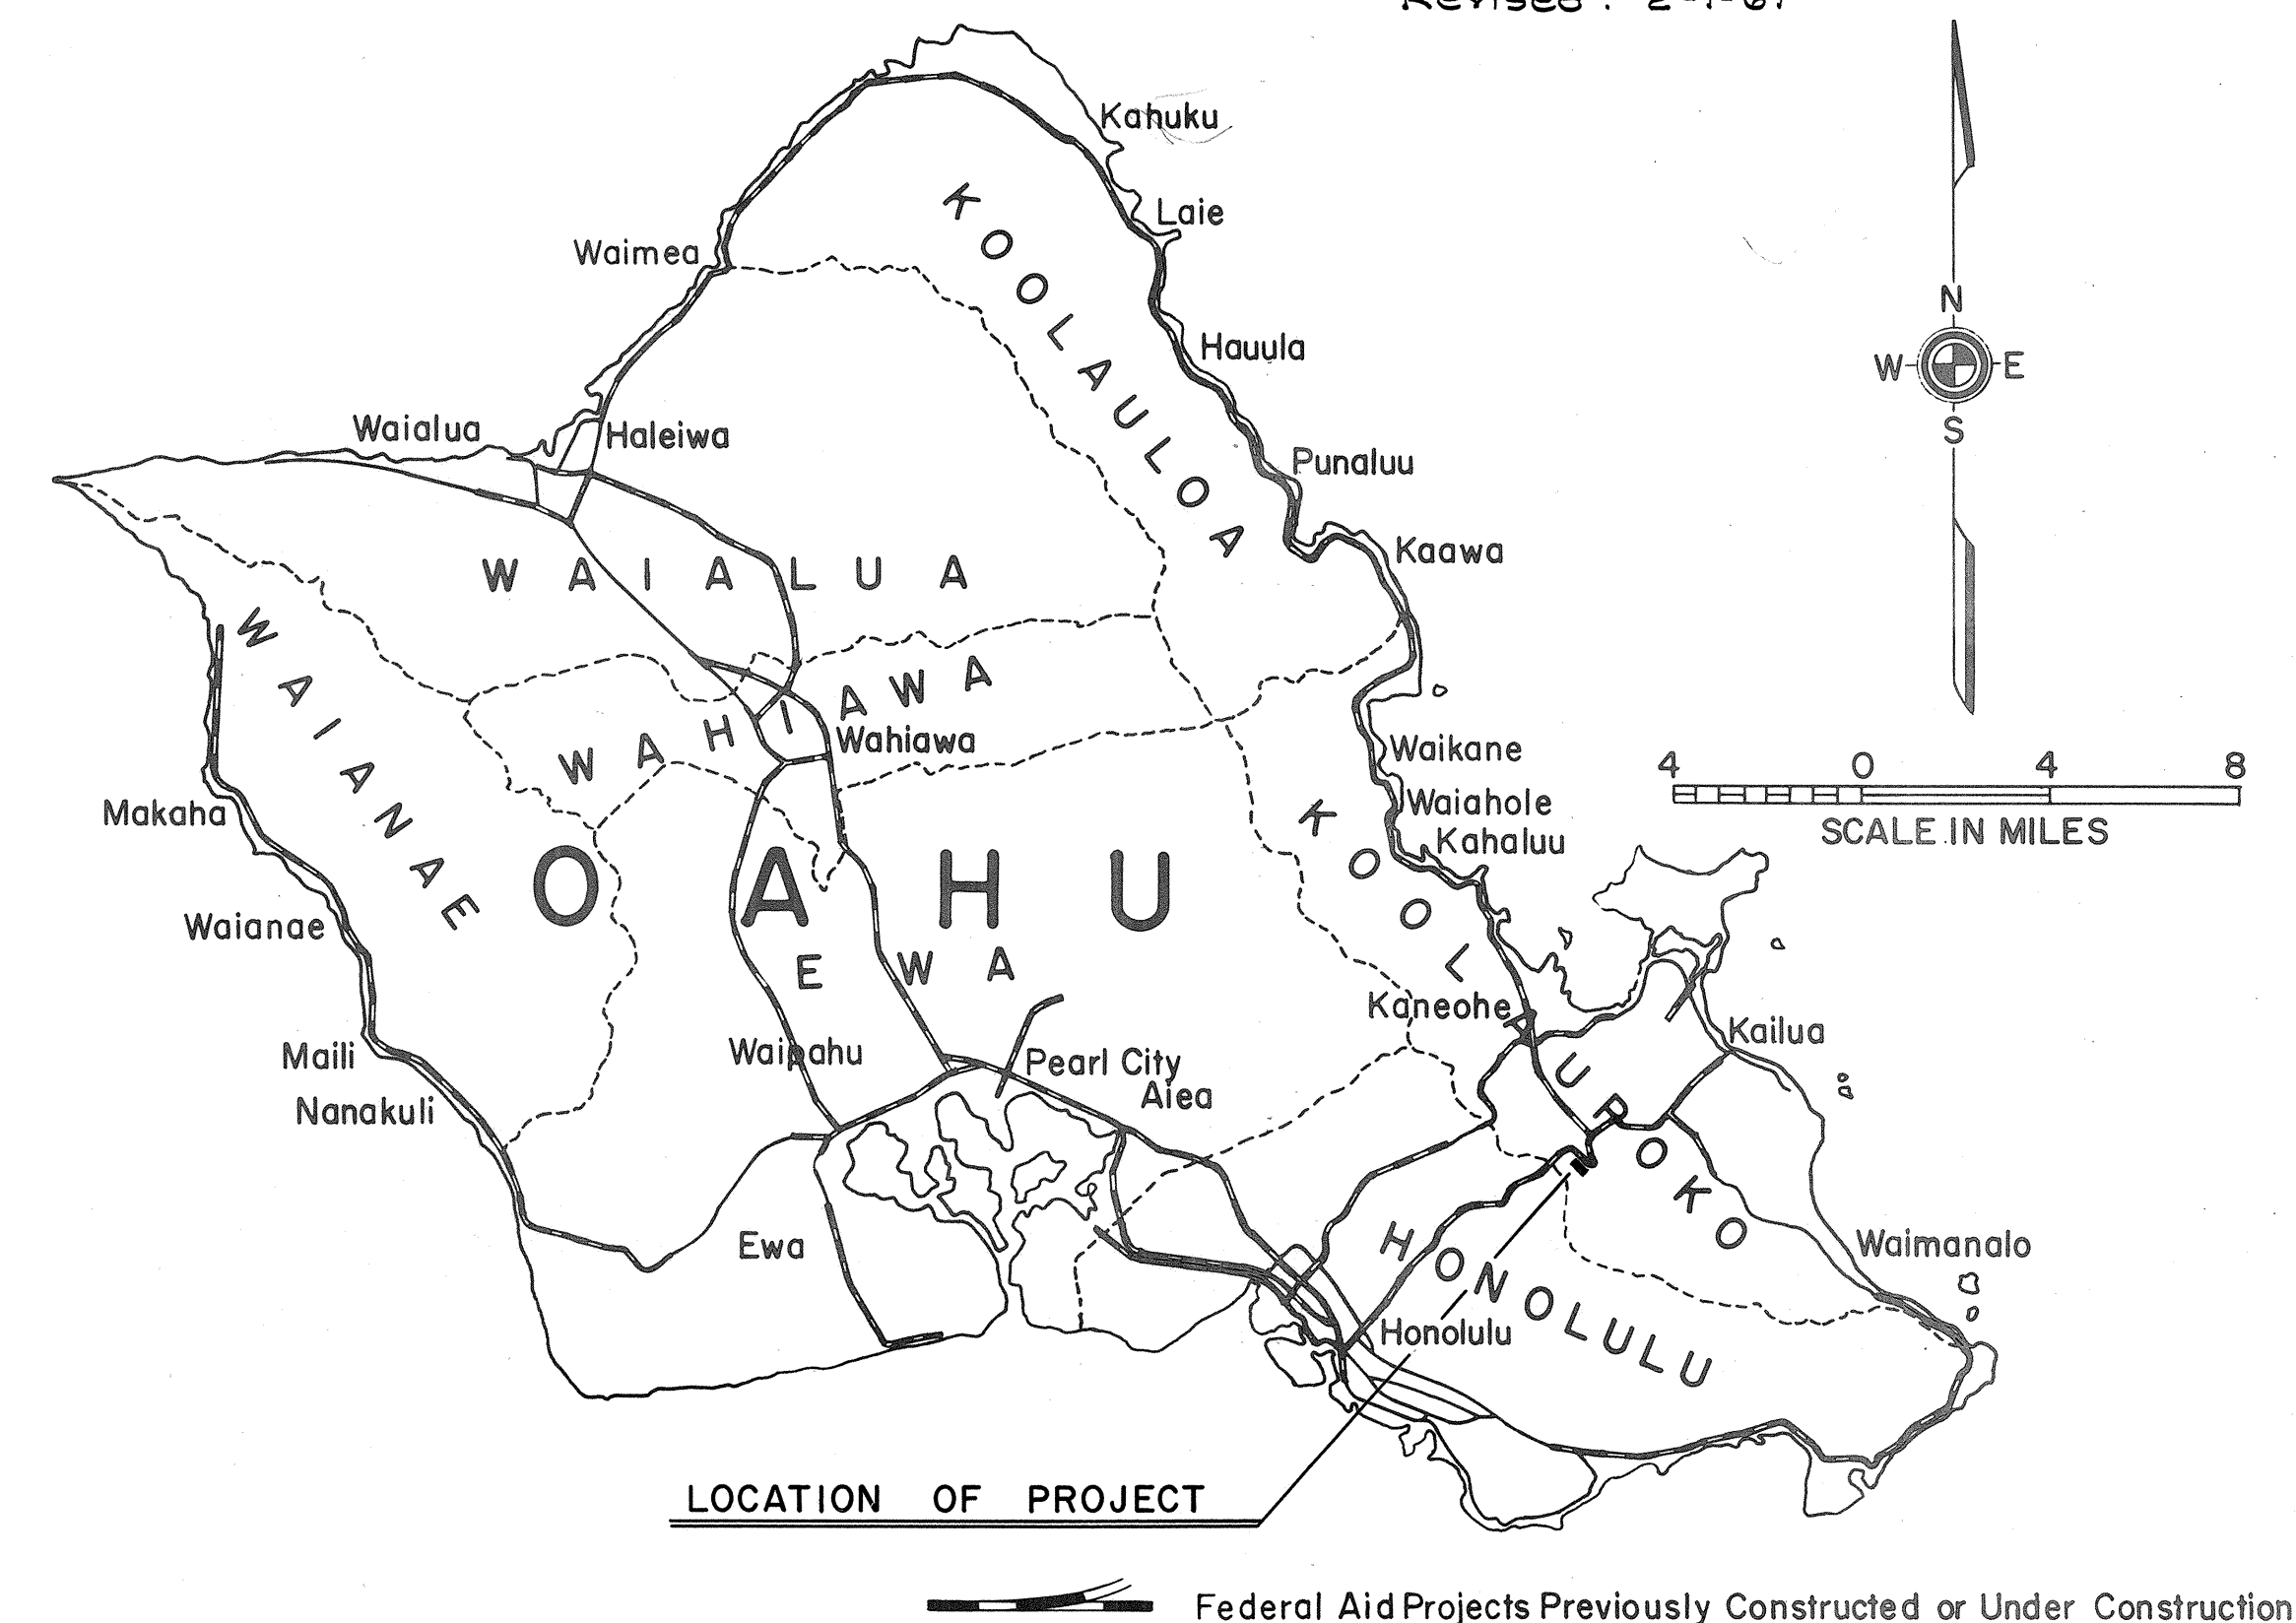

NO AS-BUILT CHANGES

DEPARTMENT OF COMMERCE BUREAU OF PUBLIC ROADS	
APPROVED:	
<i>John B. Dallen</i>	1-3-6
DIVISION ENGINEER	DATE