


[illegible]

STATE OF HAWAII
DEPARTMENT OF TRANSPORTATION
HIGHWAYS DIVISION
HONOLULU, HAWAII
"AS BUILT"
PLANS FOR
RECONSTRUCTION AND RESURFACING
OF PALI HIGHWAY
Carters Corner to Reservoir No. 4
PROJECT NO. 61B-01-68

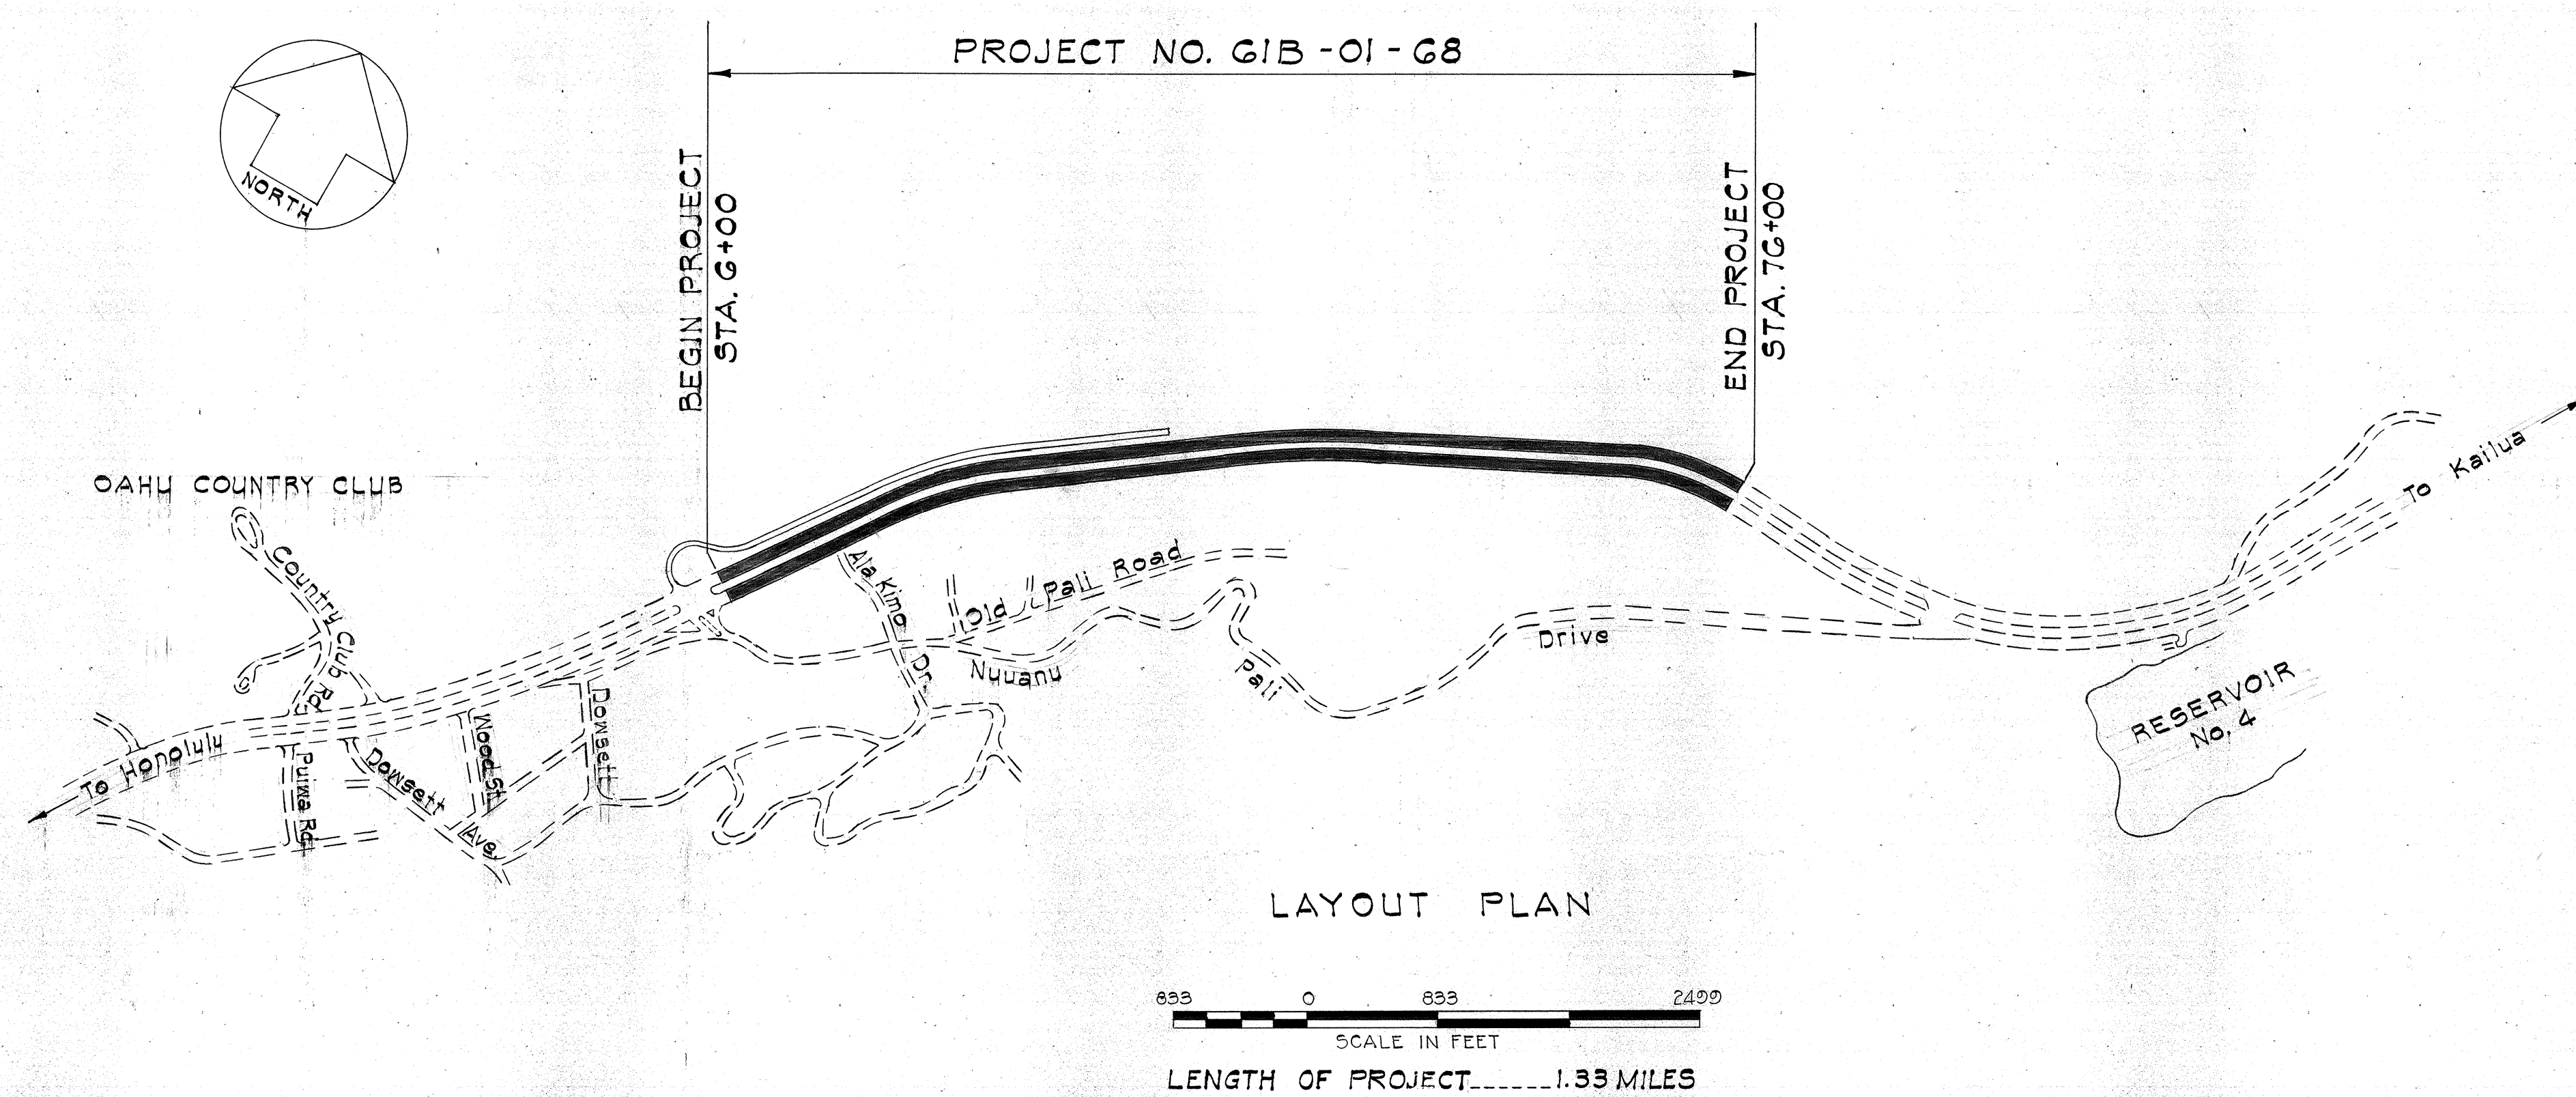

Felipe S. Cabane
PROJECT ENGINEER

APPROVED:

John H. C. C. C. C. 9/13/67
 DIR. OF TRANSPORTATION DATE