


FED. ROAD DIST. NO.	STATE	FED. AID PROJ. NO.	FISCAL YEAR	SHEET NO.	TOTAL SHEETS
HAWAII	HAW.	F-061-1(13)	1967	4	12

DESIGNED BY	DATE
CHECKED BY	
NOTED BY	
APPROVED BY	

DESIGNED BY	DATE
CHECKED BY	
NOTED BY	
APPROVED BY	

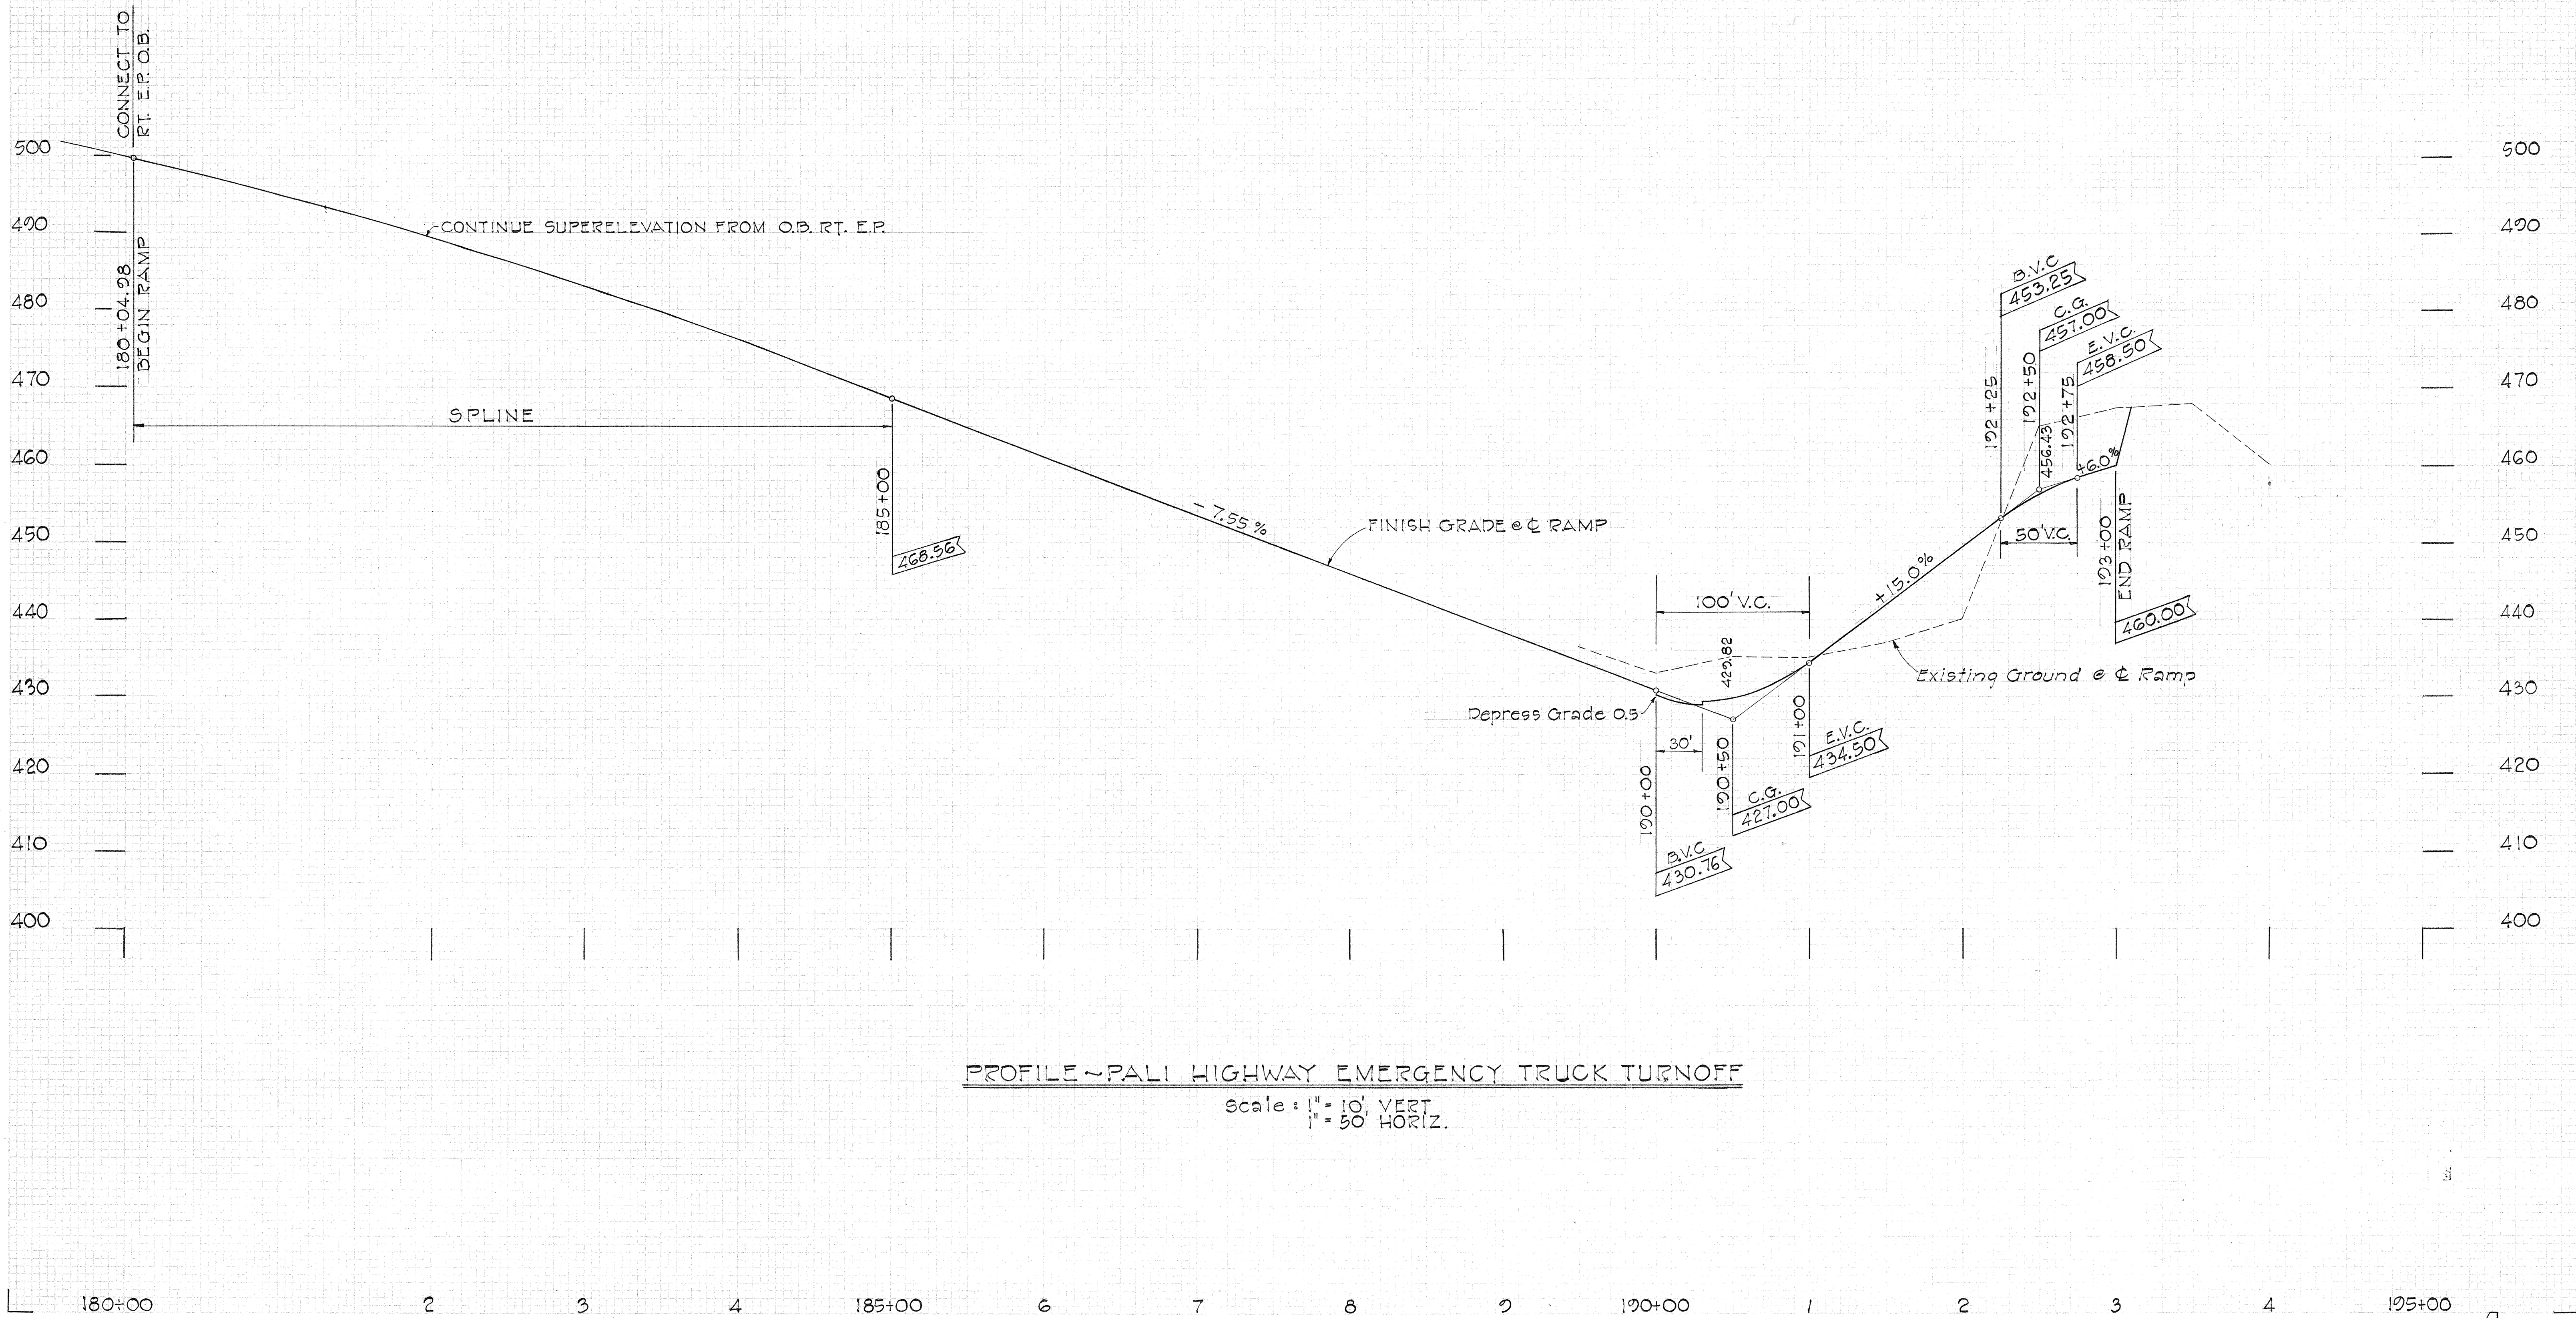

PROFILE - PALI HIGHWAY EMERGENCY TRUCK TURNOFF

Scale: 1" = 10' VERT.
1" = 50' HORIZ.