


FED. ROAD DIST. NO.	STATE	FED. AID PROJ. NO.	FISCAL YEAR	SHEET NO.	TOTAL SHEETS
HAWAII	HAW.	F-061-1(13)	1967	3	12

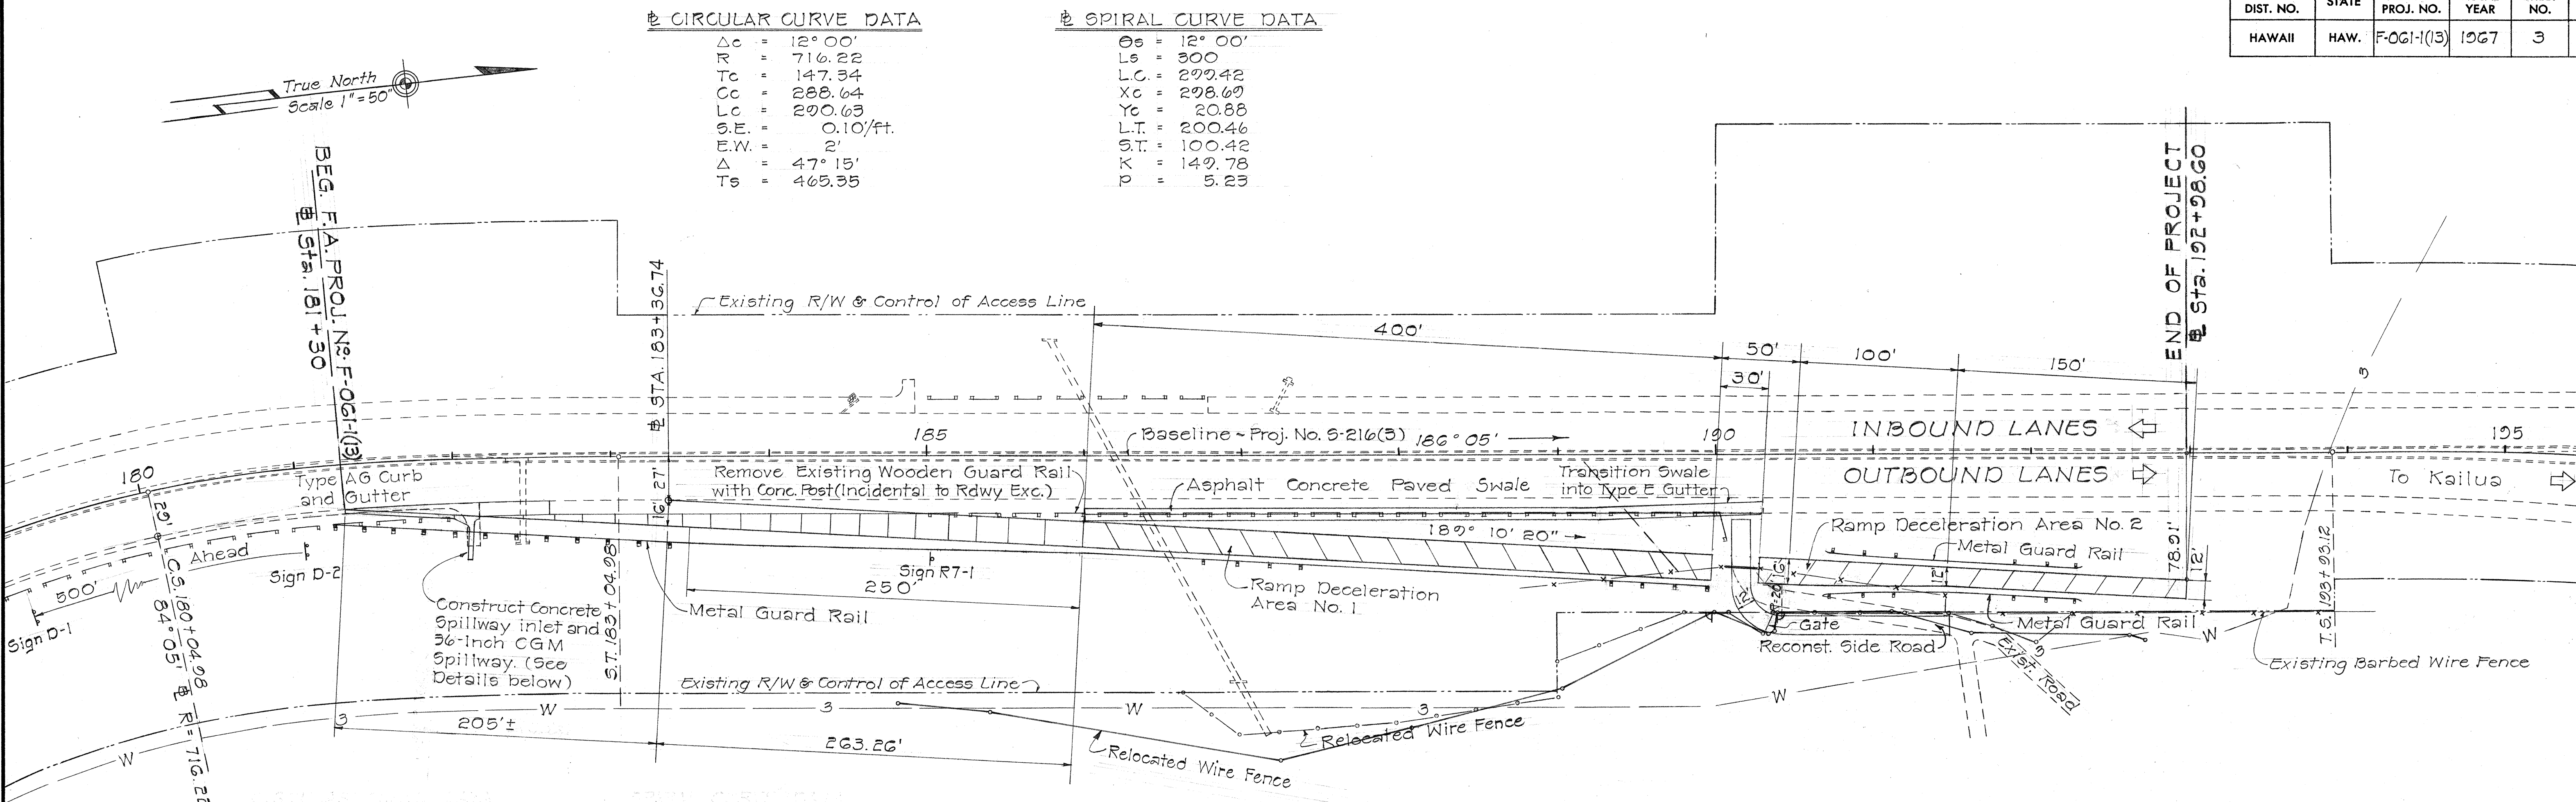

ESTIMATED QUANTITIES

Roadway Excavation	4,076	+/-	1,000	Cu. Yd.
Structure Excavation other than at Bridges	2.2	±		Cu. Yd.
6-Inch Untreated Base	1,032.2	+/-	150	Sq. Yd.
Prime Coat	280	+/-	65	Gal.
Asphalt Concrete Pavement, Mix No. IV	47.95	±	60	Ton
Class A-1 Concrete other than for Bridges	2.8	±		Cu. Yd.
36-Inch CGM Spillway (14 Gage)	12.2	+/-	5	Lin. Ft.
Type AG Curb and Gutter	60	±	70	Lin. Ft.
Metal Guard Rail	1,237.2	+/-	200	Lin. Ft.
Reconstructed Wire Fence	37.7	±	60	Lin. Ft.
New Posts for Reconstructed Fence	88	±	30	Each
New Wire for Reconstructed Fence	188	±	100	Lb.
Directional Sign with Posts			2	Each
Regulatory Sign with Post			1	Each
Crushed Rock, No. 3 Coarse	480.4	±	25	Cu. Yd.

GENERAL NOTES

- Origin of Azimuths "Kailua Δ and Coordinates" referred to "Kailua Δ".
- Details for Traffic Signs are shown on Sheet No. 7

STATE OF HAWAII
DEPARTMENT OF TRANSPORTATION
HIGHWAYS DIVISION

ROADWAY PLAN
AND SPILLWAY DETAILS
PALI HIGHWAY
EMERGENCY TRUCK TURNOFF
IN THE VICINITY OF CASTLE JUNCTION
F.A.P. NS-F-061-1(13)
SCALE: AS SHOWN NOVEMBER 1967

SHEET No. OF SHEETS

DATE	_____
SURVEY PLOTTED BY	_____
DRAWN BY	_____
CHECKED BY	_____
NOTE BOOK	_____
No.	_____

PLAN

SECTION A-A

CONCRETE SPILLWAY INLET AND CGM SPILLWAY DETAILS

