

INDEX TO DRAWINGS	
SHEET NO.	DESCRIPTION
1	TITLE SHEET
2	TYPICAL SECTIONS
3	ROADWAY PLAN
4	PROFILE
5-9	MISCELLANEOUS ROADWAY DETAILS
10-12	CROSS SECTIONS

STATE OF HAWAII

DEPARTMENT OF TRANSPORTATION

HIGHWAYS DIVISION

HONOLULU, HAWAII

"AS BUILT"

PLANS FOR CONSTRUCTION OF

PALI HIGHWAY EMERGENCY TRUCK TURNOFF


IN THE VICINITY OF CASTLE JUNCTION

FEDERAL AID PROJECT NO. F-061-I(13)

DISTRICT OF KOOLAUPOKO

ISLAND OF OAHU

FED. ROAD DIST. NO.	STATE	FED. AID PROJ. NO.	FISCAL YEAR	SHEET NO.	TOTAL SHEETS
HAWAII	HAW.	F-061-I(13)	1967	1	12

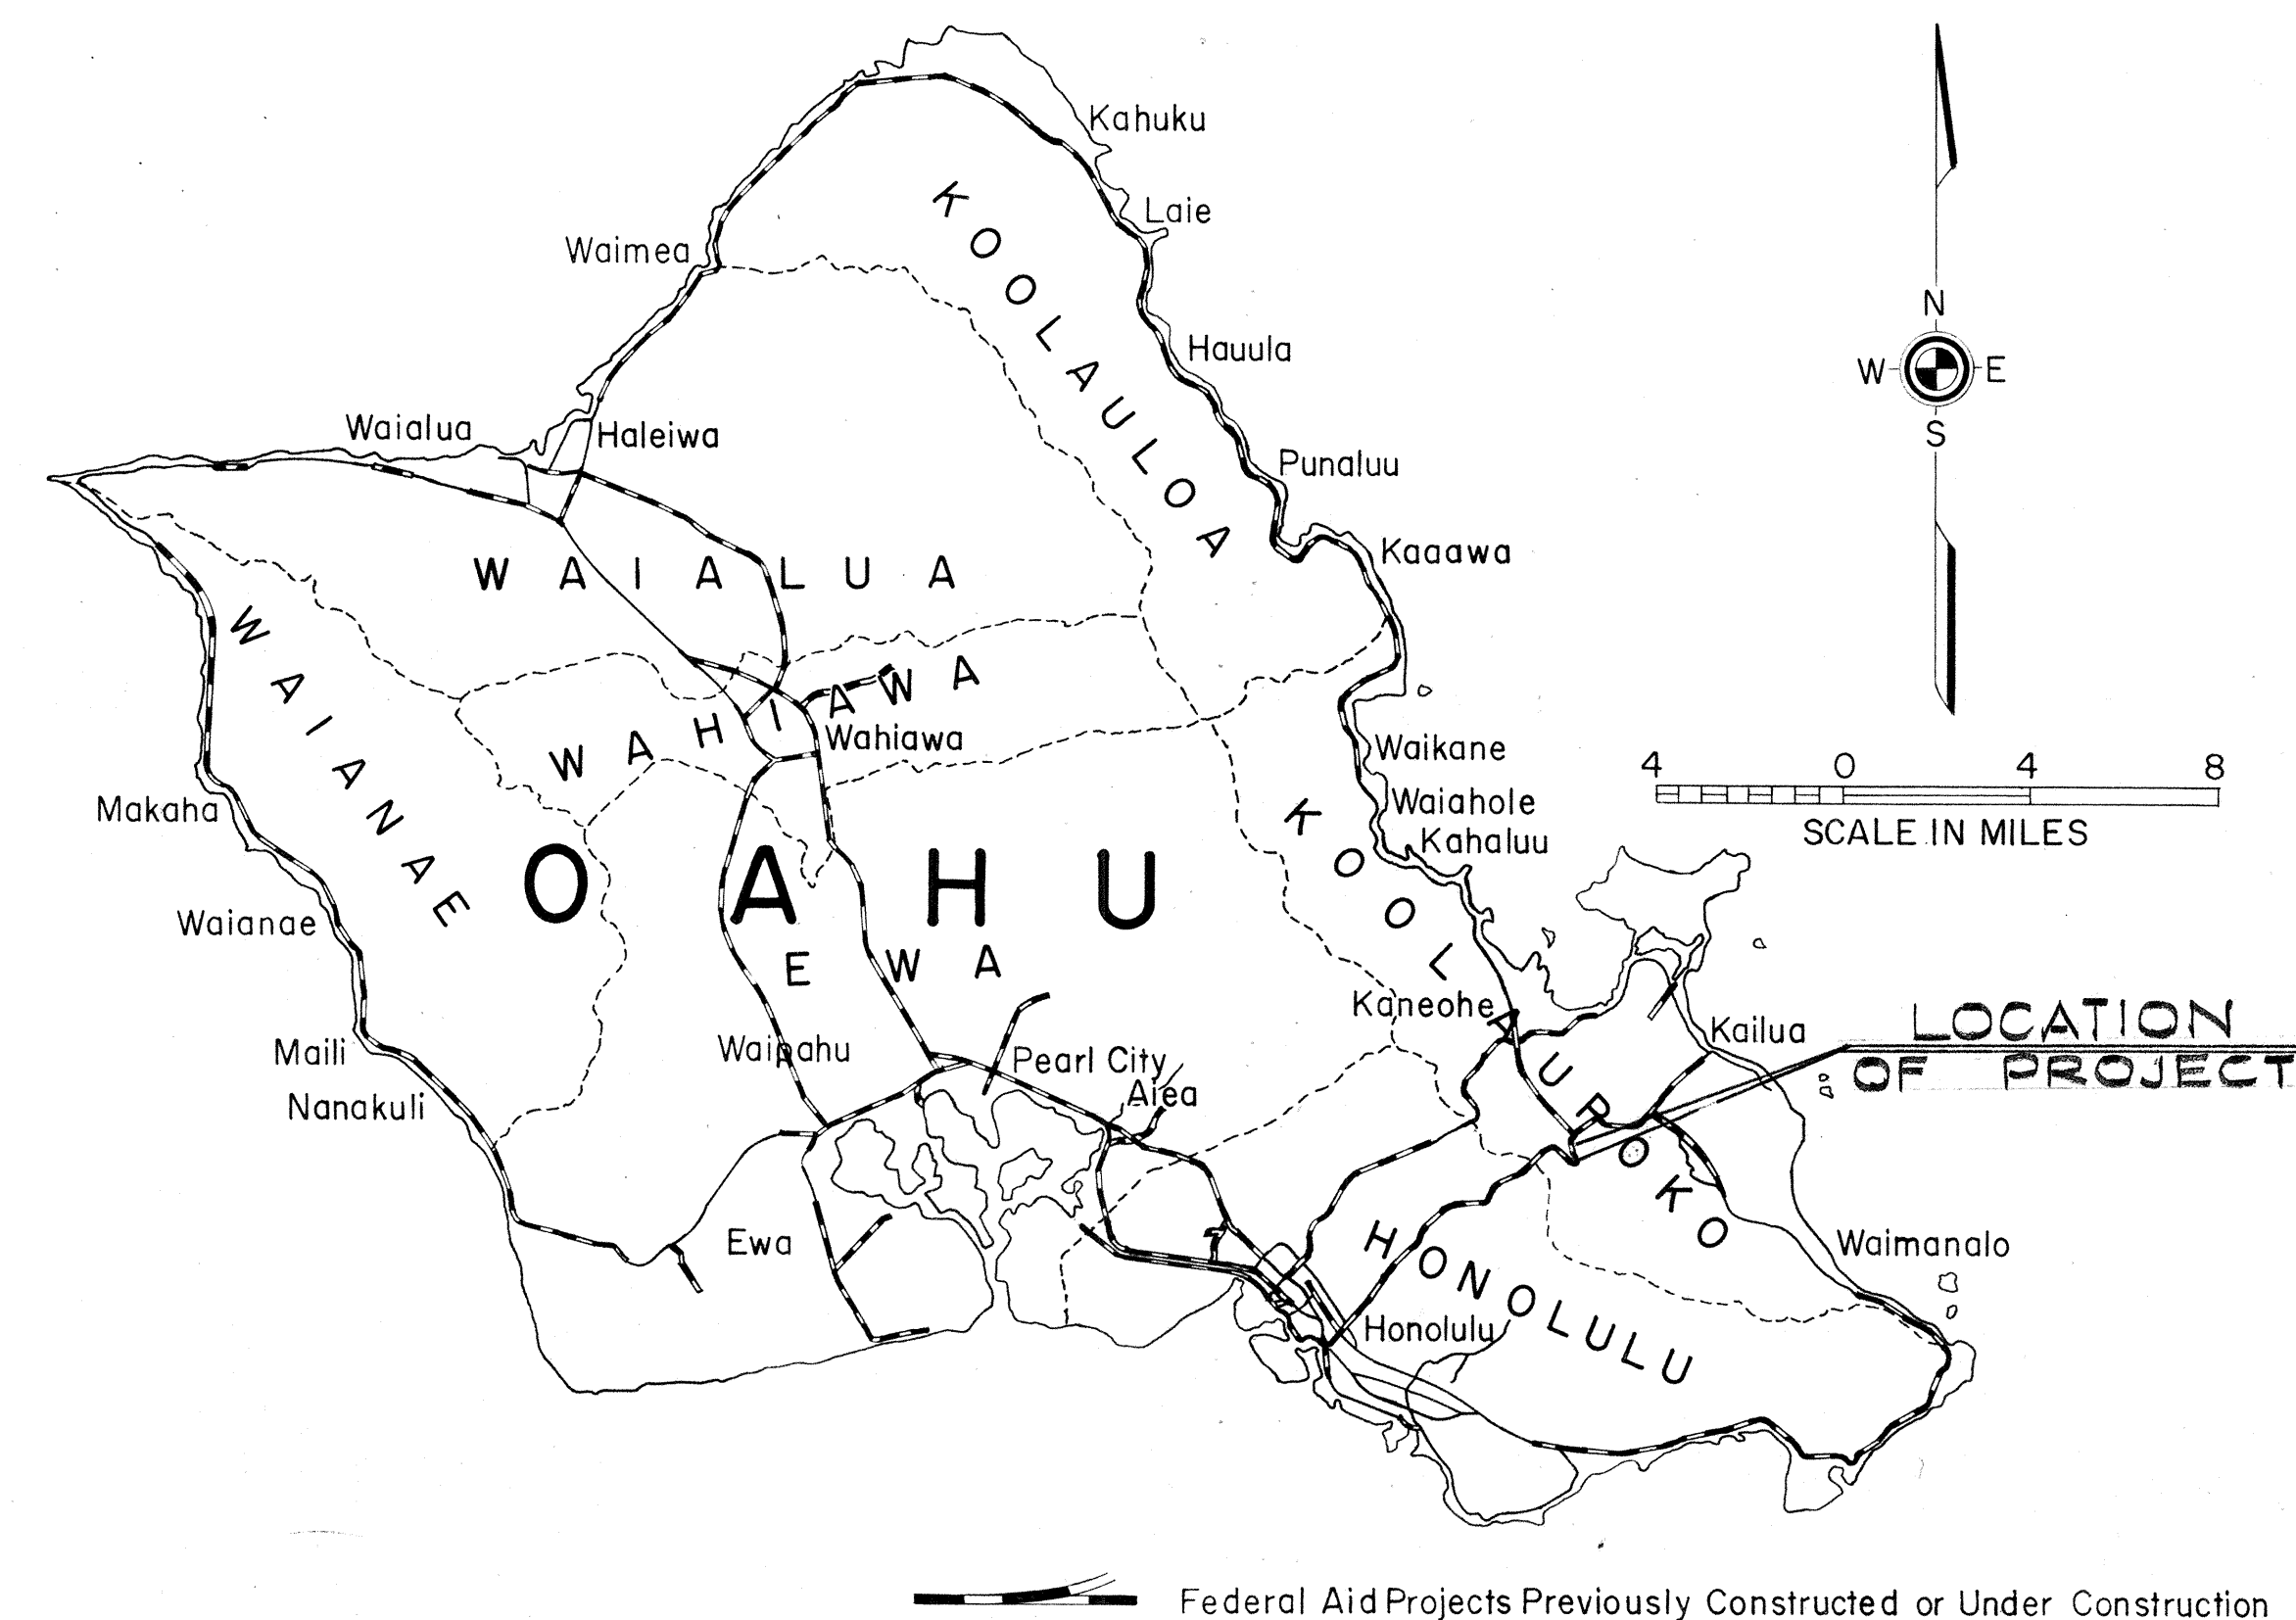

NOTE:

ALL CHANGES MADE DURING CONSTRUCTION HAVE BEEN


NOTED ON THESE TRACINGS IN RED AND CHECKED BY:

Philip A. Adams

PROJECT ENGINEER

May 30, 1967

DATE

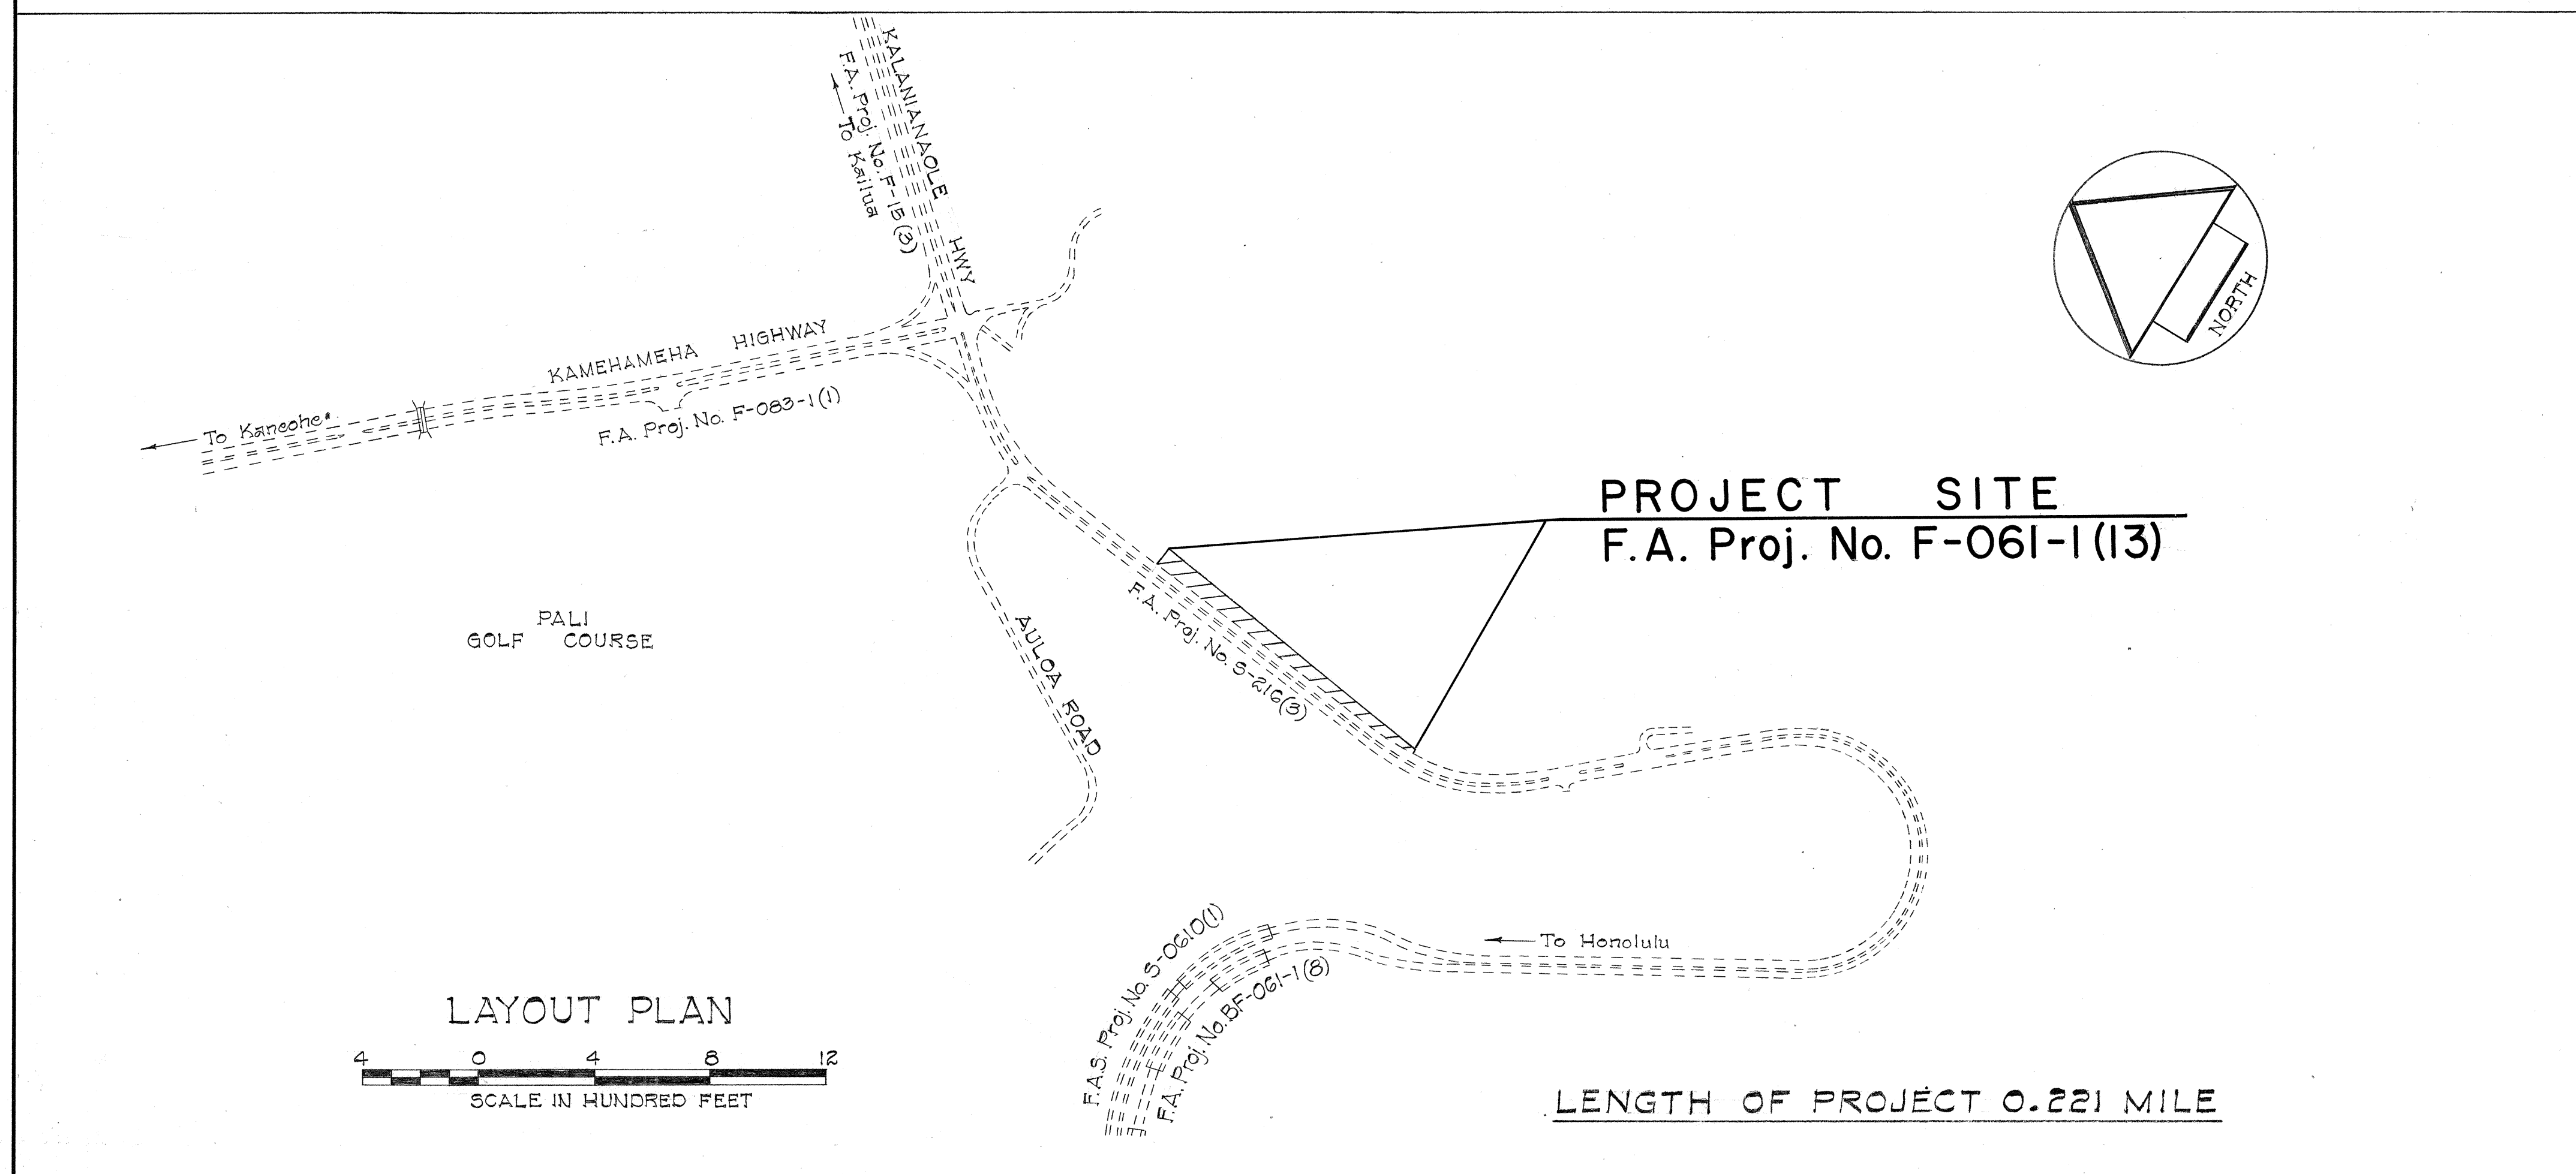

DEPARTMENT OF TRANSPORTATION

BUREAU OF PUBLIC ROADS

APPROVED:

Neil D. Dillingham

DIVISION ENGINEER

12-29-67

DATE

DEPARTMENT OF TRANSPORTATION

STATE OF HAWAII

APPROVED:

John W. A. [Signature]

DIR. OF TRANSPORTATION

12/1/67

DATE