




FED. ROAD DIST. NO.	STATE	FED. AID PROJ. NO.	FISCAL YEAR	SHEET NO.	TOTAL SHEETS
HAWAII	HAW.	F-OGI-1(13)	1967	2	12

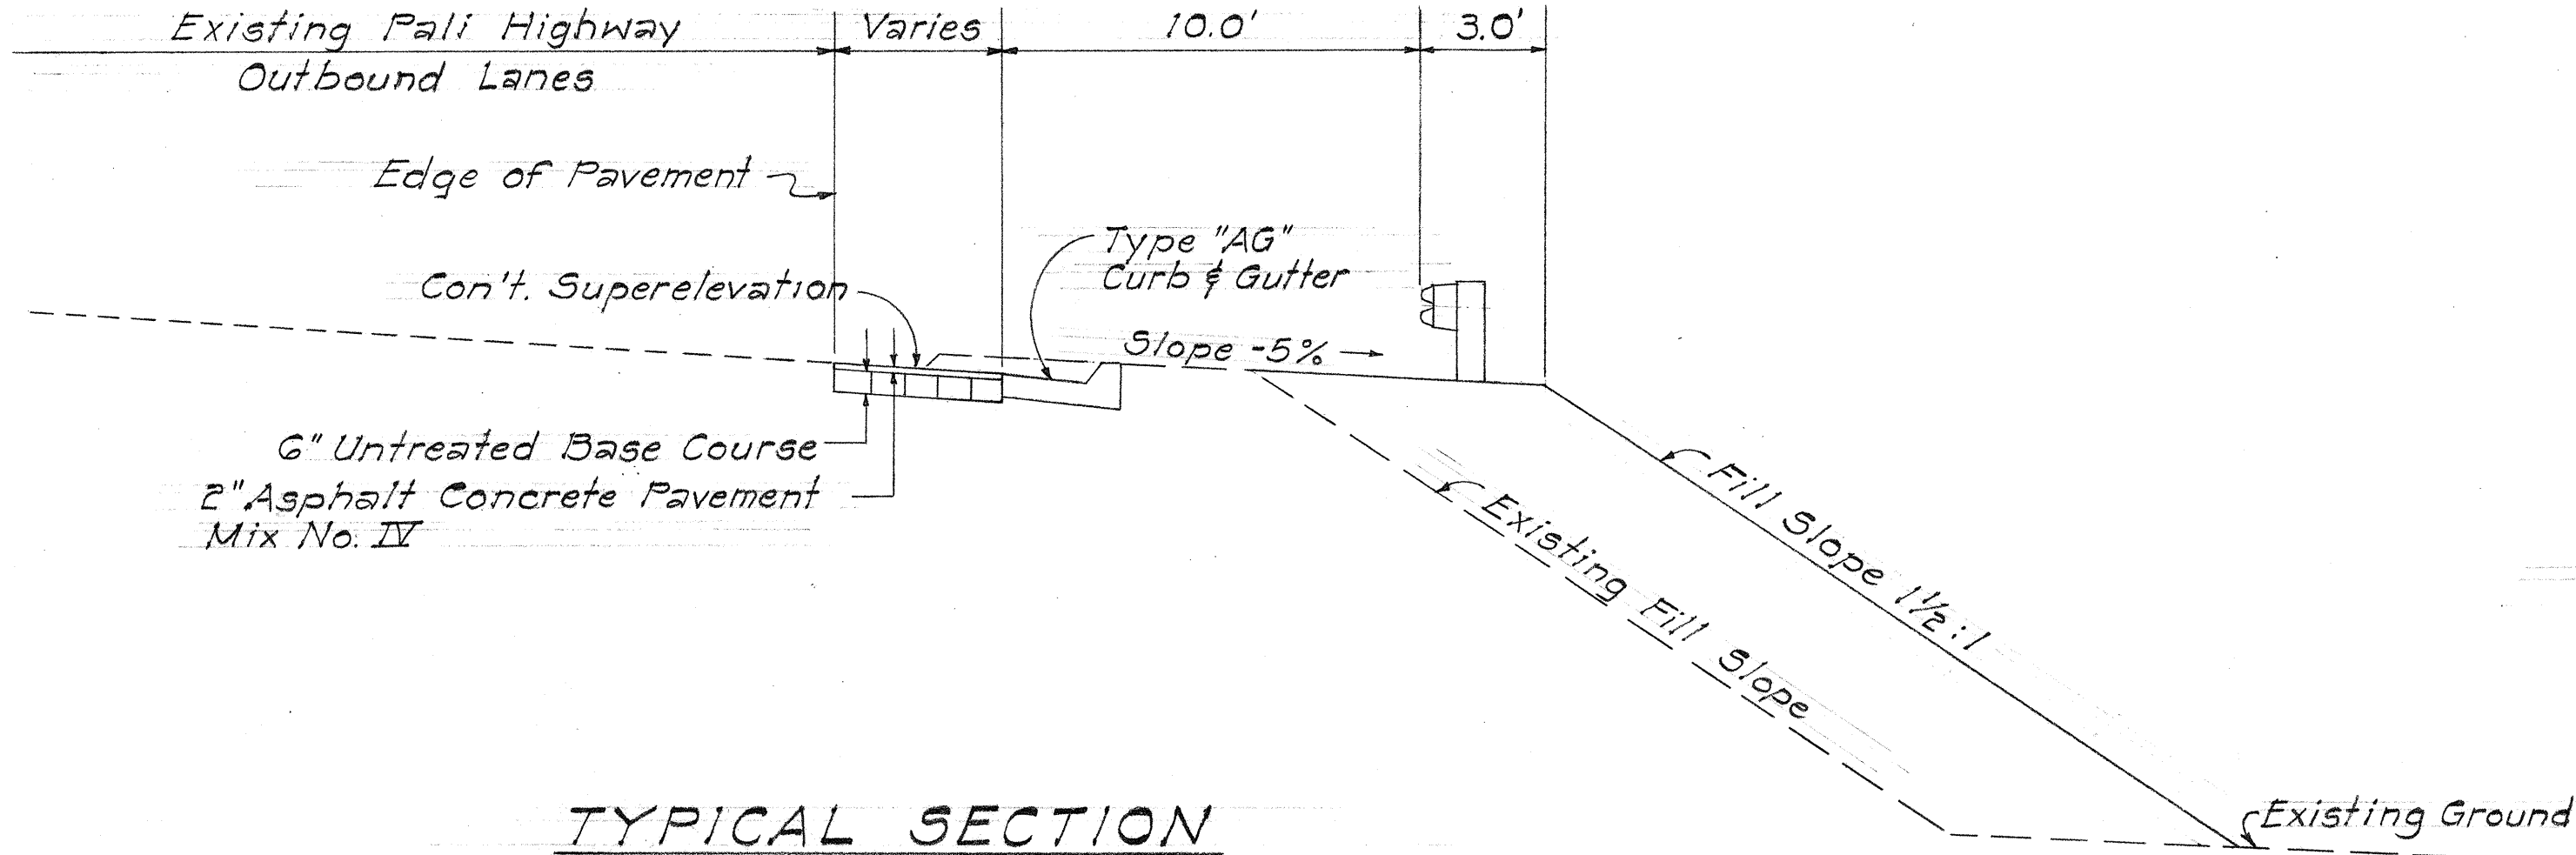


TYPICAL SECTION
STA. 181 + 30± TO STA. 182 + 15±
Scale: 1/4" = 1'-0"

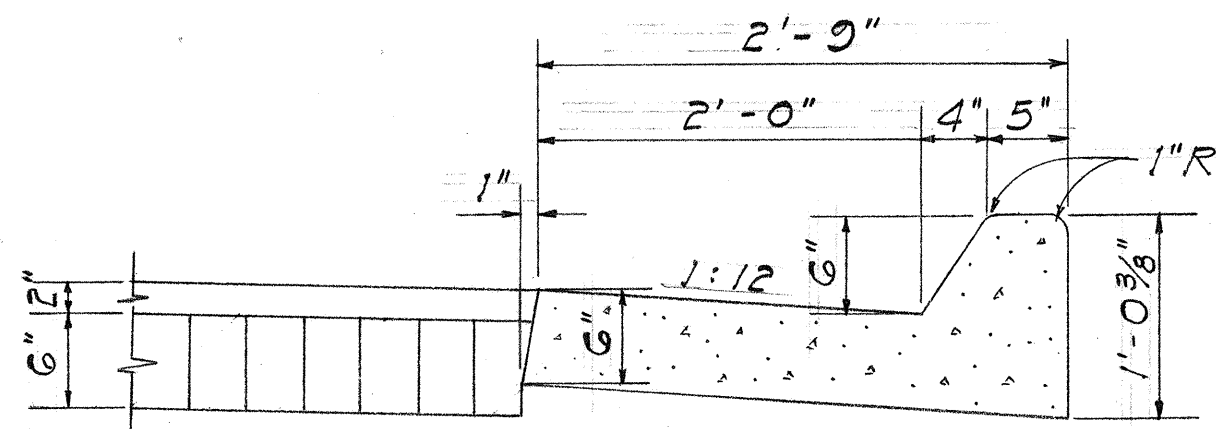


TYPE "AG" CURB & GUTTER
Scale: 1" = 1'-0"

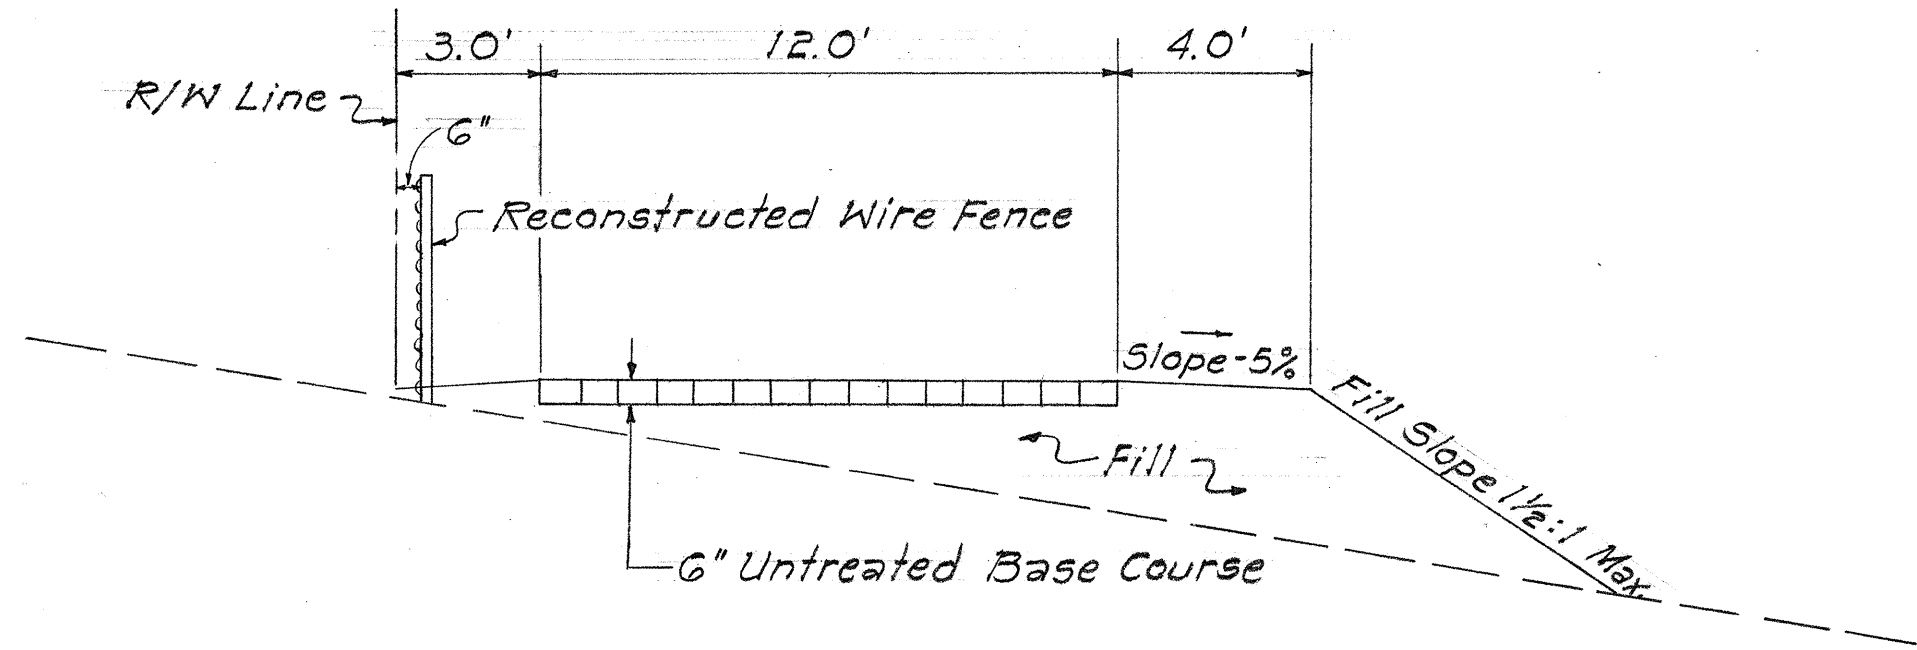


TYPICAL SECTION
SIDE ROAD
Scale: 1/4" = 1'-0"

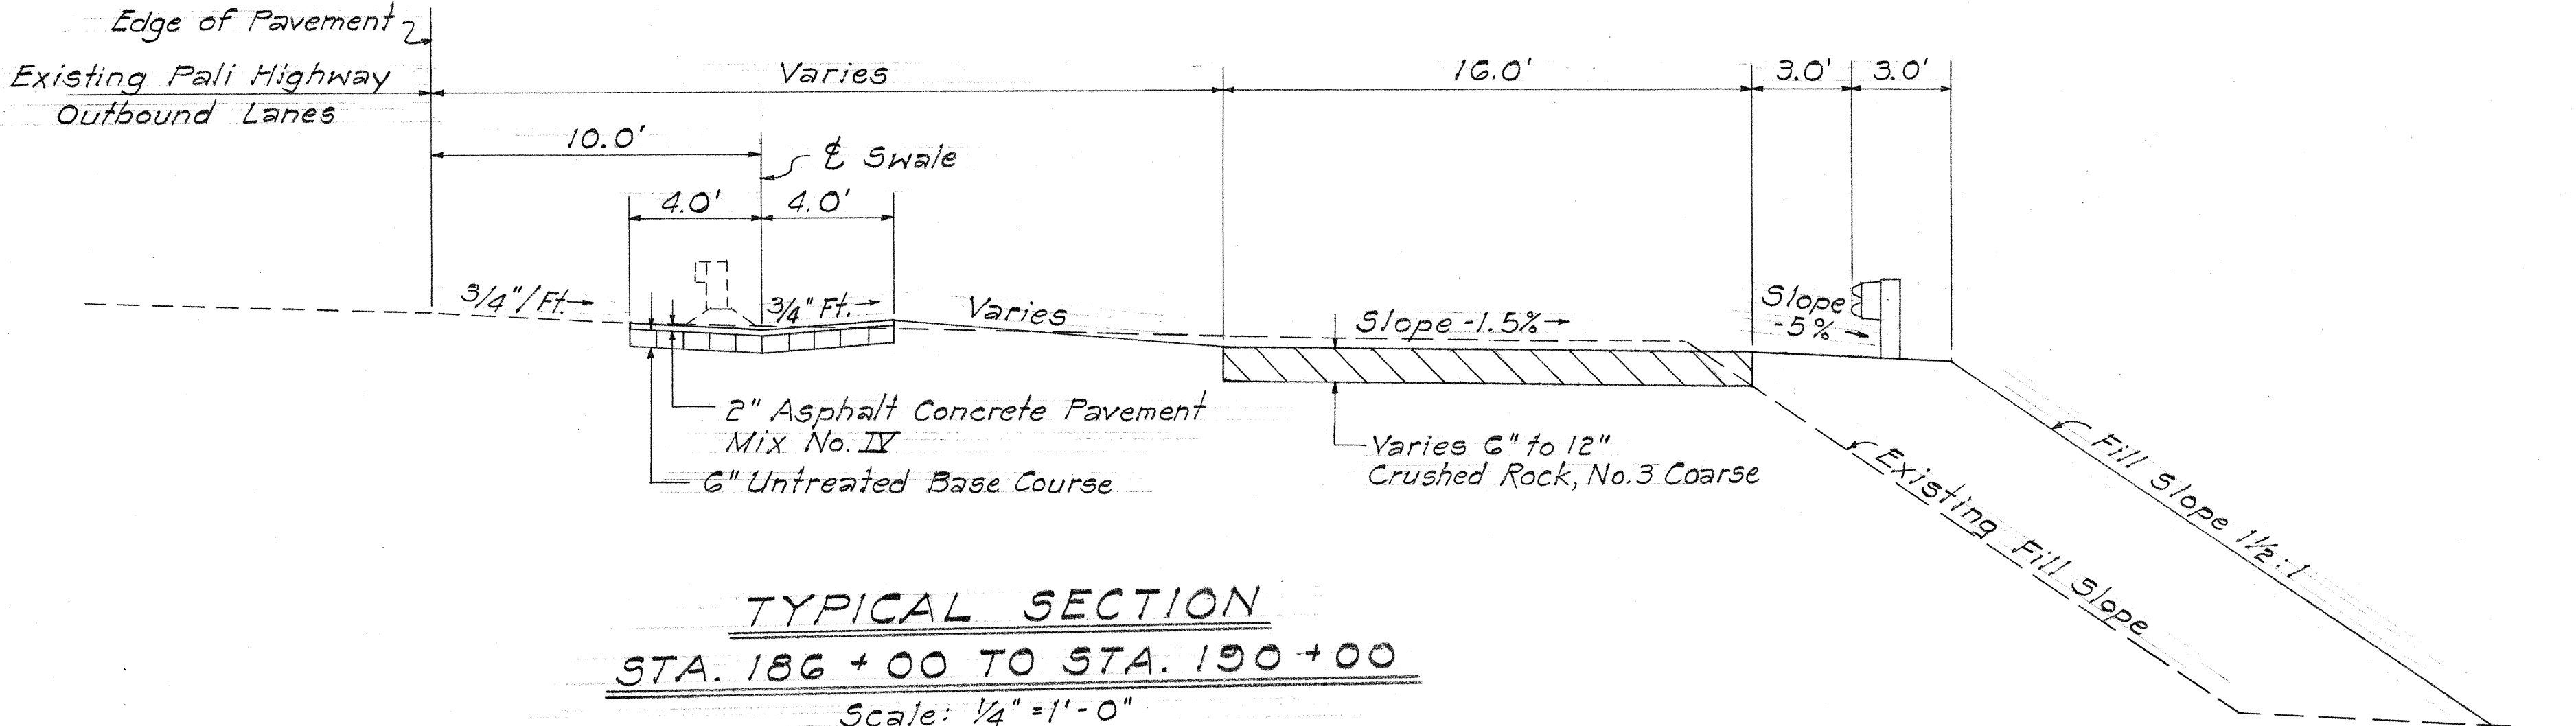


TYPICAL SECTION
STA. 186 + 00 TO STA. 190 + 00
Scale: 1/4" = 1'-0"

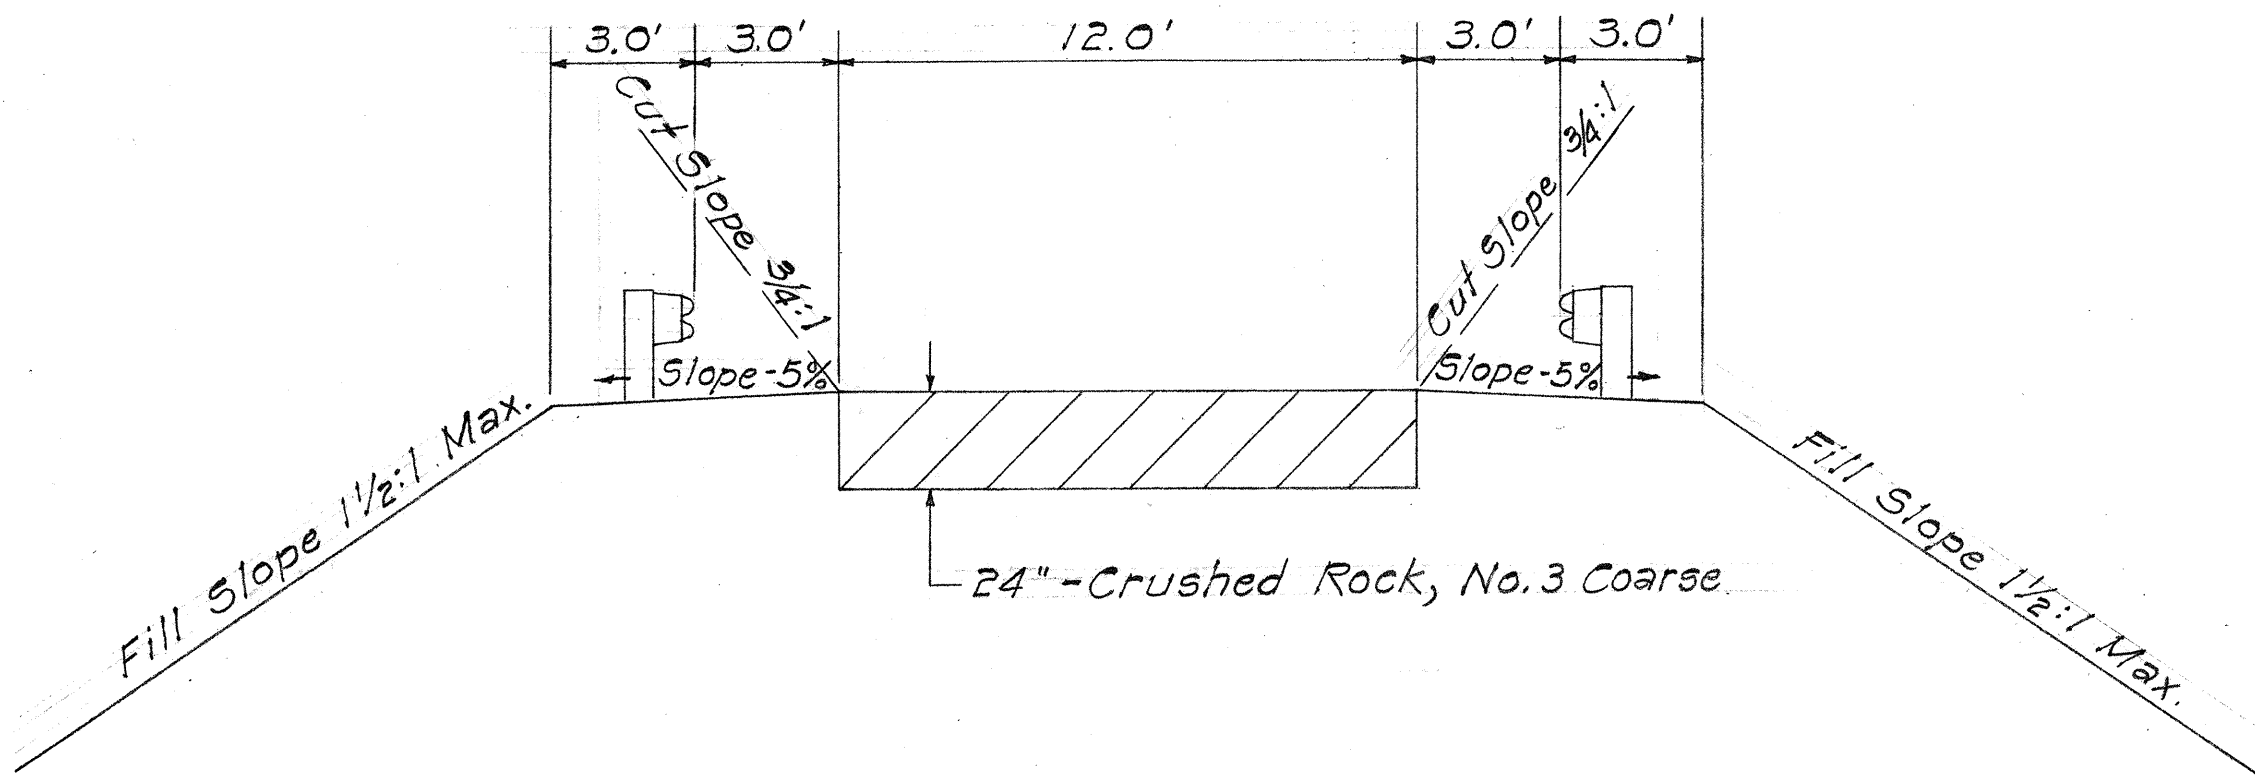


TYPICAL SECTION
STA. 191 + 50 TO STA. 193 + 00
Scale: 1/4" = 1'-0"

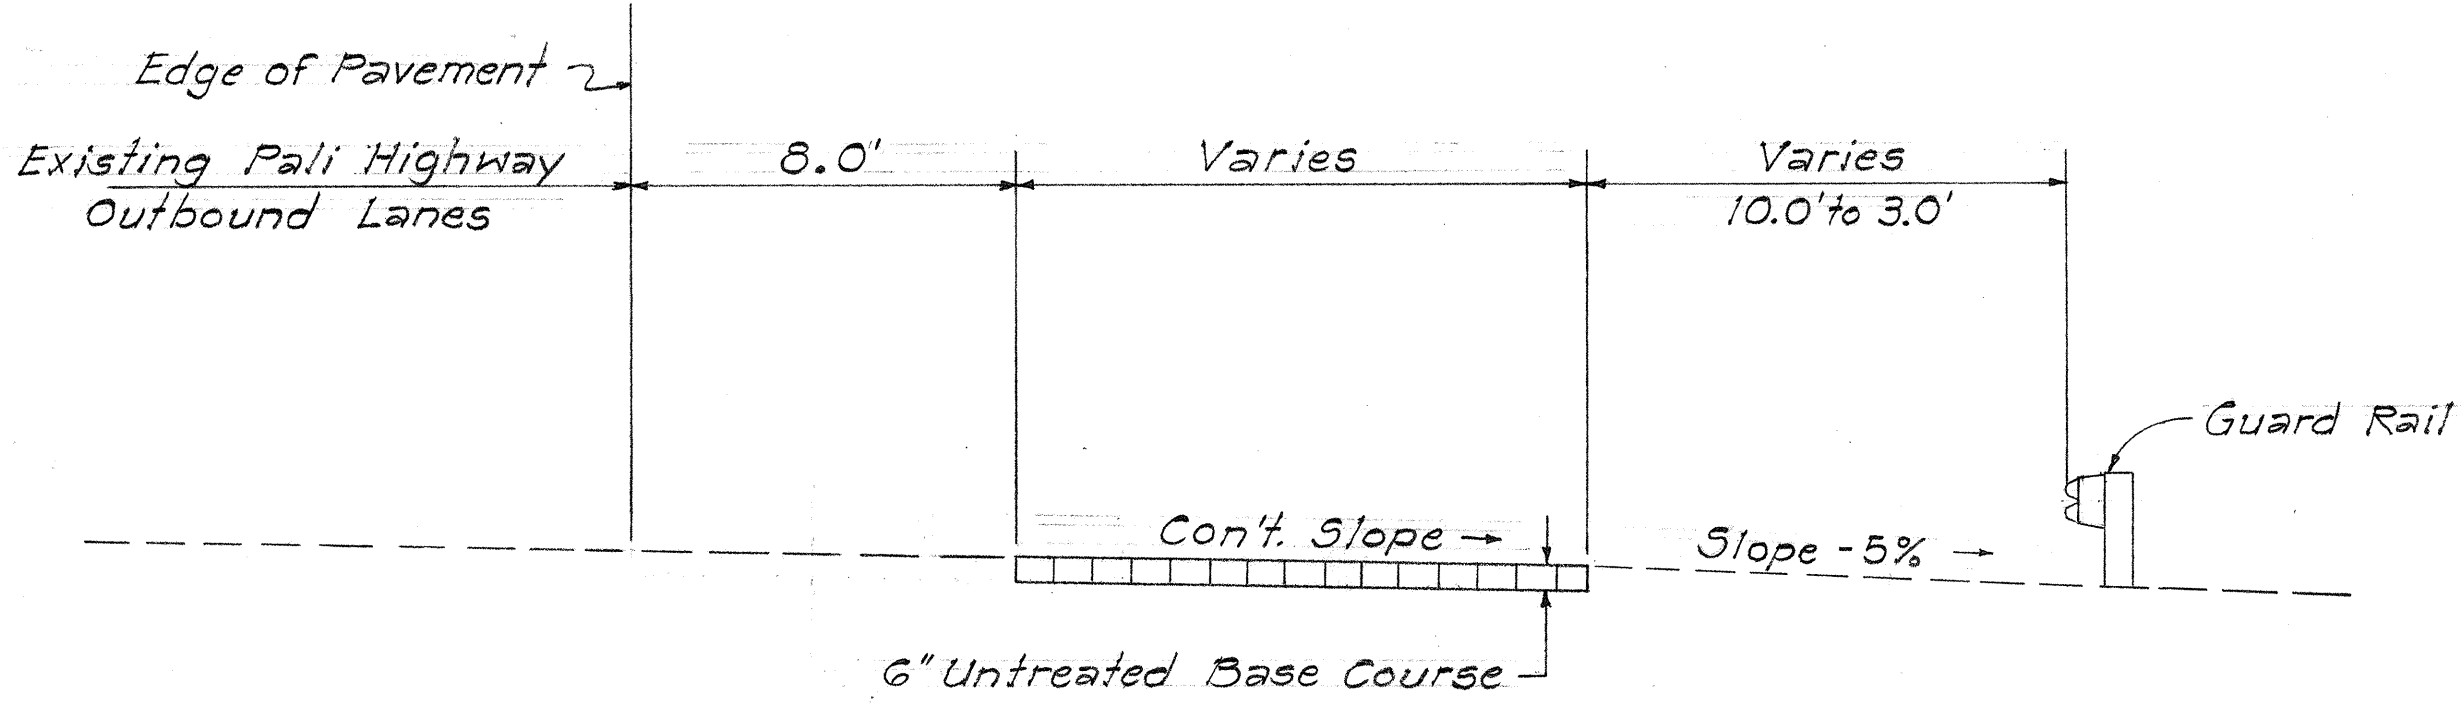

TYPICAL SECTION
STA. 182 + 25 TO STA. 186 + 00
Scale: 1/4" = 1'-0"

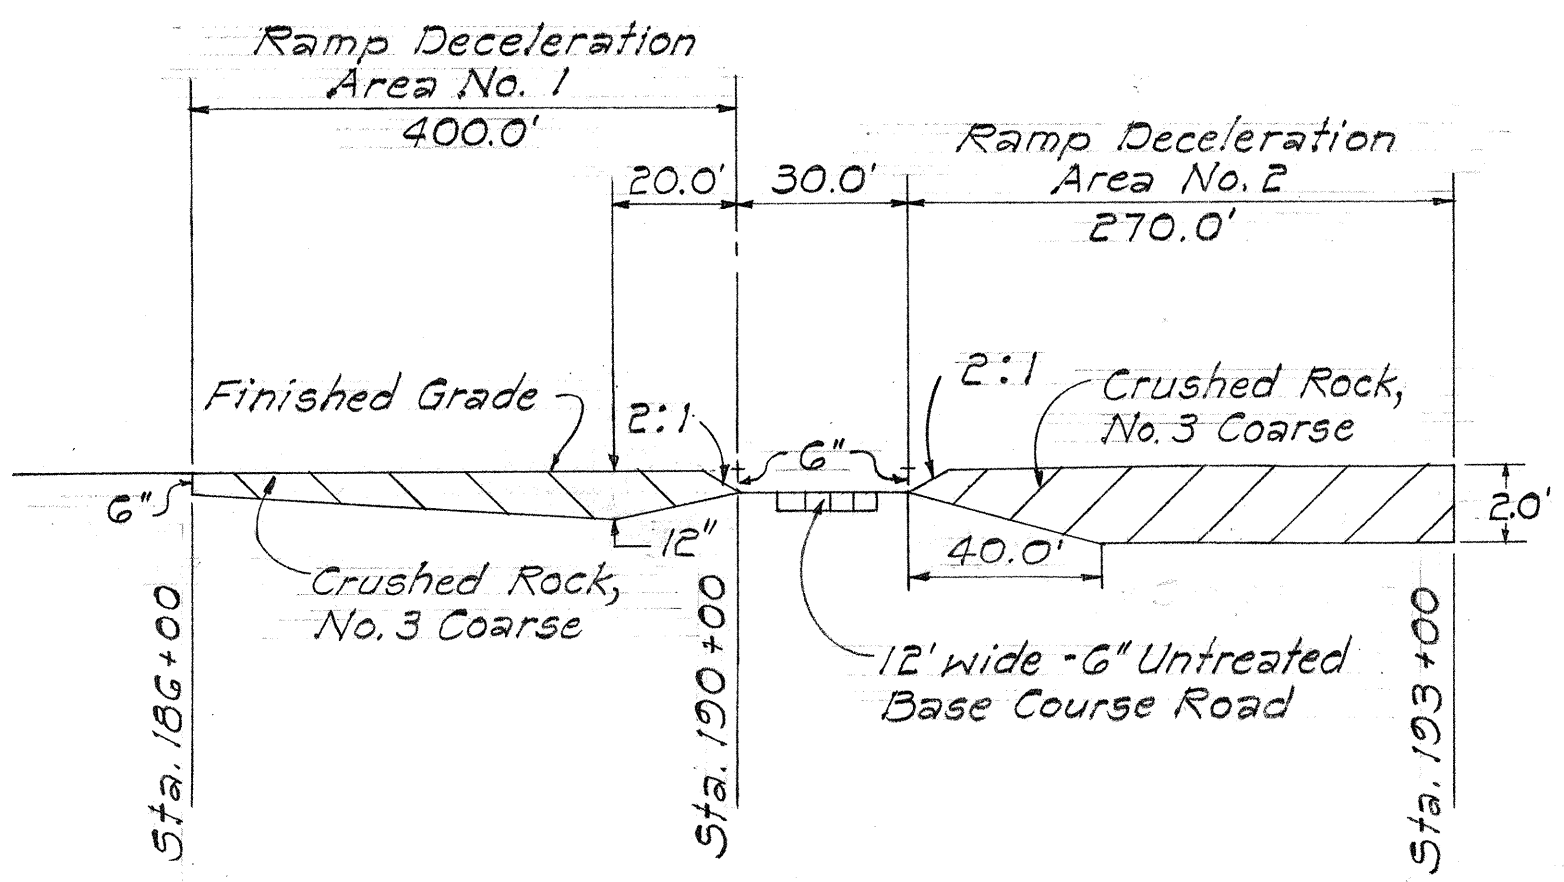

LONGITUDINAL SECTION
Not to Scale

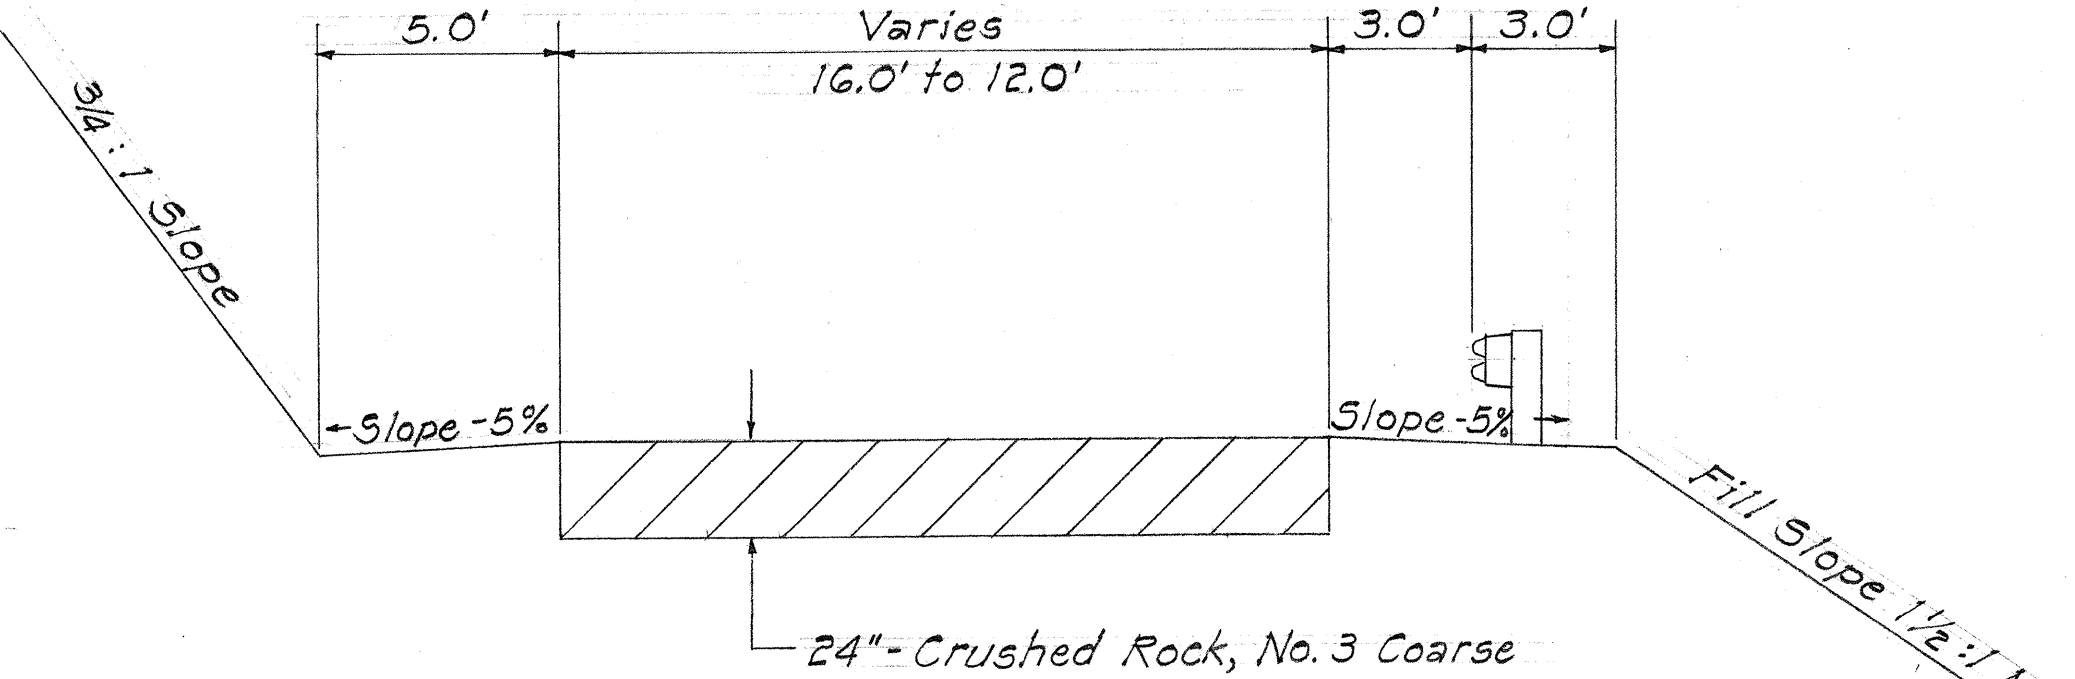

TYPICAL SECTION
STA. 190 + 30 TO STA. 191 + 50
Scale: 1/4" = 1'-0"

STATE OF HAWAII
DEPARTMENT OF TRANSPORTATION
HIGHWAYS DIVISION

TYPICAL SECTIONS
PALI HIGHWAY
EMERGENCY TRUCK TURNOFF
IN THE VICINITY OF CASTLE JUNCTION
F.A.P. NO. F-OGI-1(13)
SCALE: AS SHOWN NOVEMBER 1967
SHEET No. OF SHEETS

DATE	11/1/67
DESIGNED BY	W. J. B. /
CHECKED BY	W. J. B. /
NOTED BY	W. J. B. /
ORIGINAL	W. J. B. /