INDEX TO DRAWINGS	
SHEET NO.	DESCRIPTION
	TITLE SHEET
2	HIGHWAY LIGHTING PLAN AND
	DETAILS
3	HIGHWAY LIGHTING PLAN AND
	DETAILS
4	UNDERPASS LIGHTING PLAN
	AND DETAILS
5	STANDARD DETAILS-PULLBOXES
: :	
:	
,	
ani ana ana ang magana ana ana ang mana mana	
mentan international and a state international control of the state international cont	

STATE OF HAWAII

TRANSPORTATION DEPARTMENT OF HIGHWAYS DIVISION

HONOLULU, HAWAII

DISTRICT OF HONOLULU ISLAND OF OAHU


" AS BUILT "


HIGHWAY LIGHTING SYSTEM

ALONG PALI HIGHWAY

ROAD to WYLLIE RAMP PAUOA

PROJECT NO. 61B-02-68

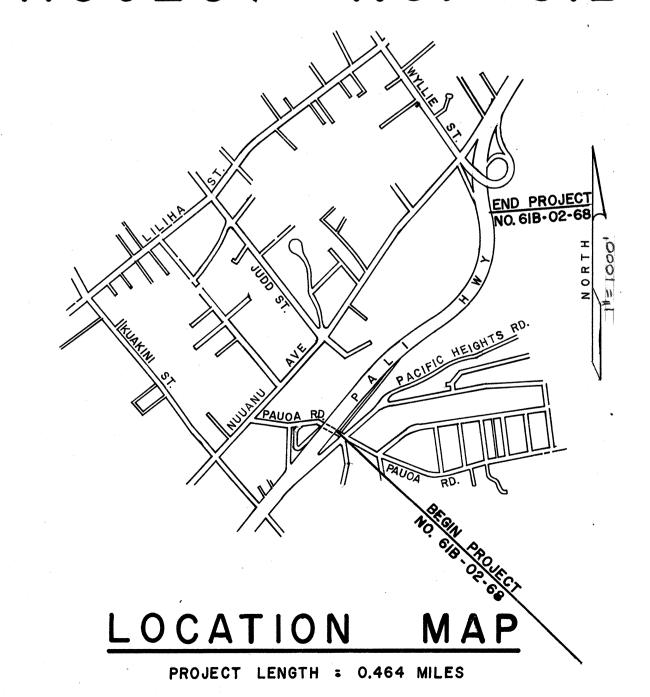

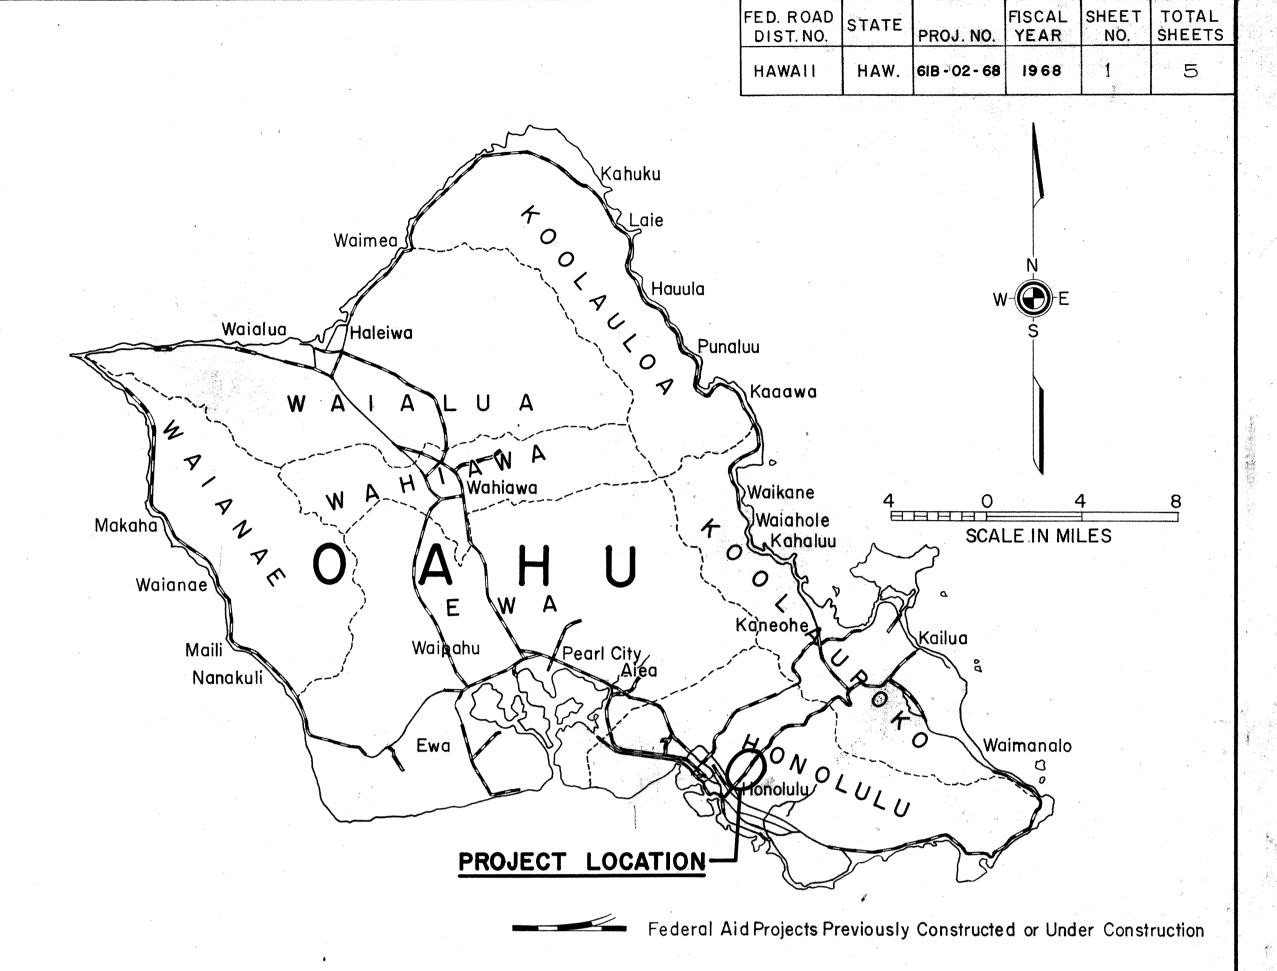

NOTE:

ALL CHANGES MADE DURING CONSTRUCTION HAVE BEEN NOTED IN RED ON THESE TRACINGS AND CHECKED BY: