



INDEX TO DRAWINGS	
SHEET NO.	DESCRIPTION
1	TITLE SHEET
2	RESURFACING SCHEDULE
3 & 4	RAISED PAVEMENT MARKERS

FED. ROAD DIST. NO.	STATE	PROJ. NO.	FISCAL YEAR	SHEET NO.	TOTAL SHEETS
HAWAII	HAW.	61B-02-69	1968	1	4

STATE OF HAWAII
DEPARTMENT OF TRANSPORTATION
HIGHWAYS DIVISION
HONOLULU, HAWAII

PLANS FOR
RESURFACING A PORTION OF
PALI HIGHWAY
KUAKINI STREET TO LAIMI ROAD
PROJECT NO. 61B-02-69

DISTRICT OF HONOLULU
ISLAND OF OAHU

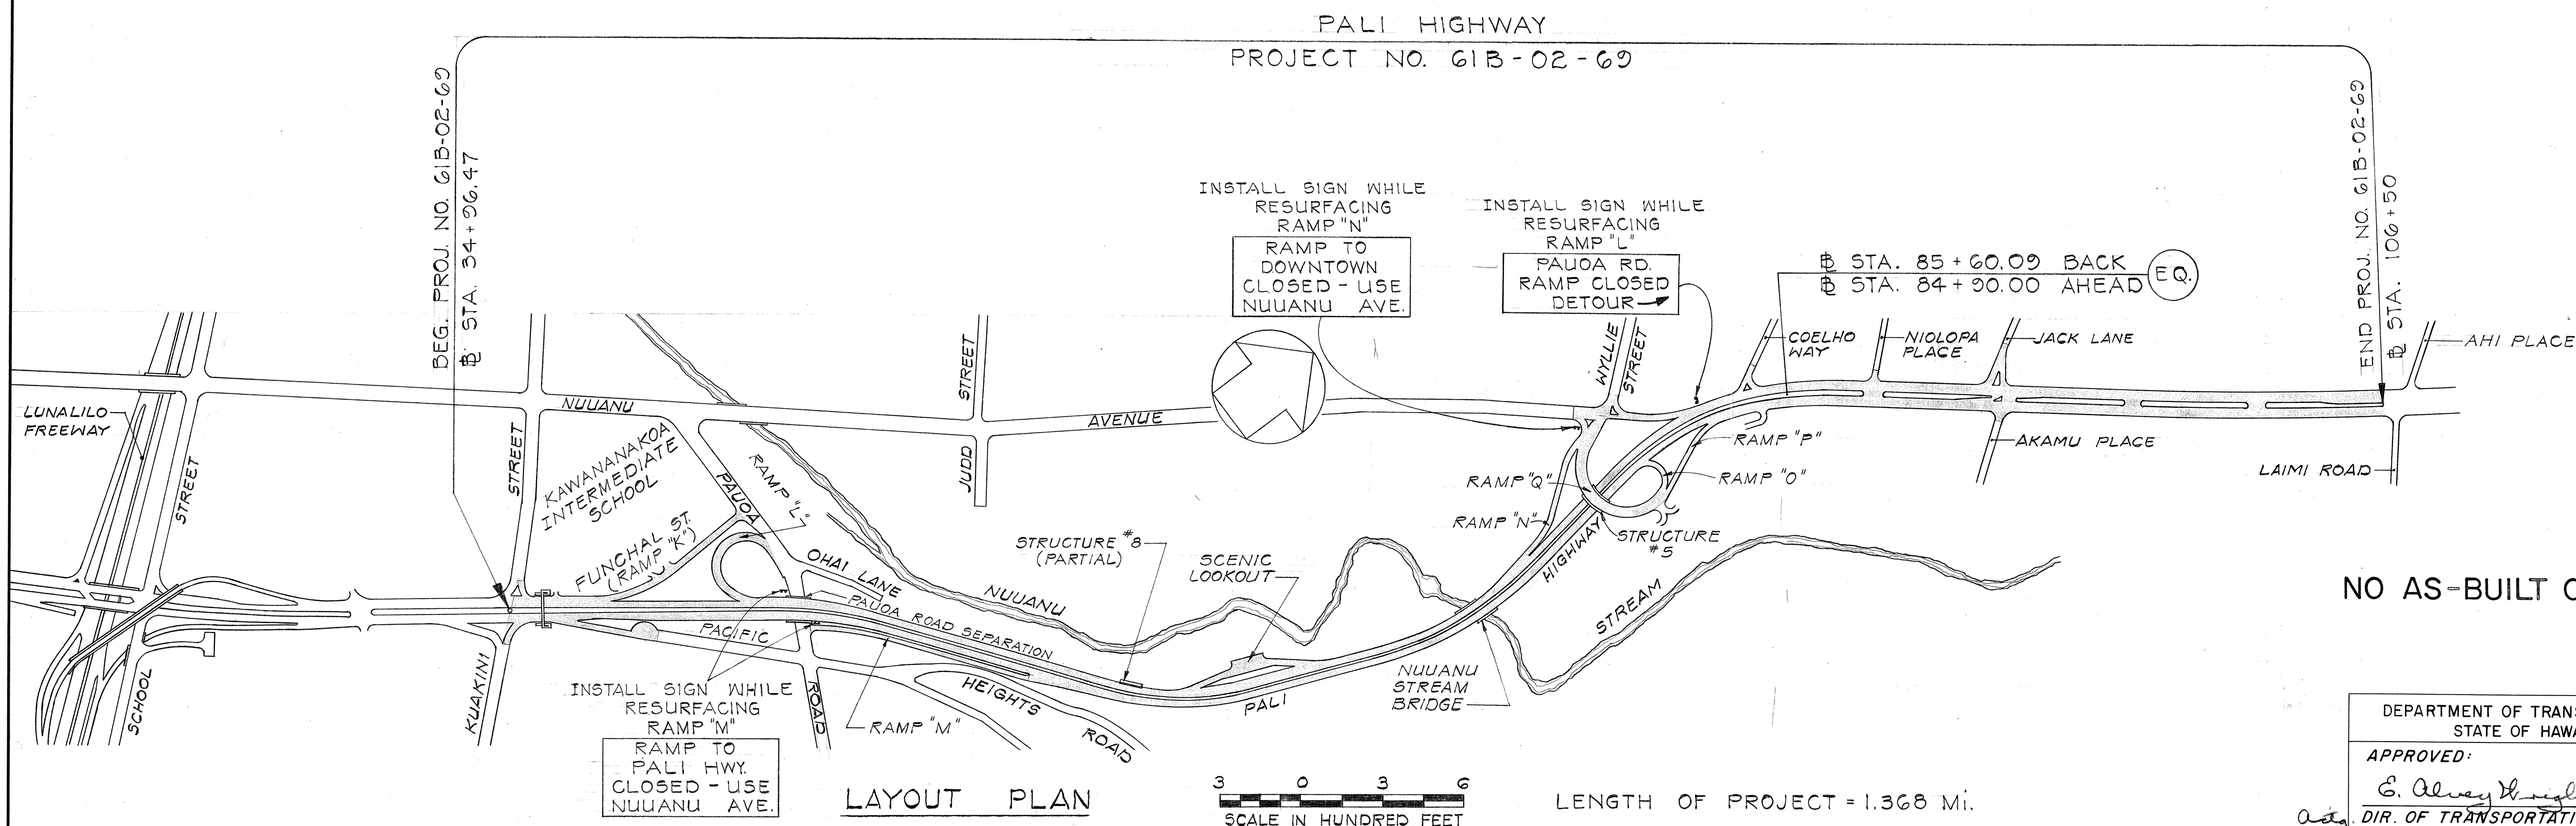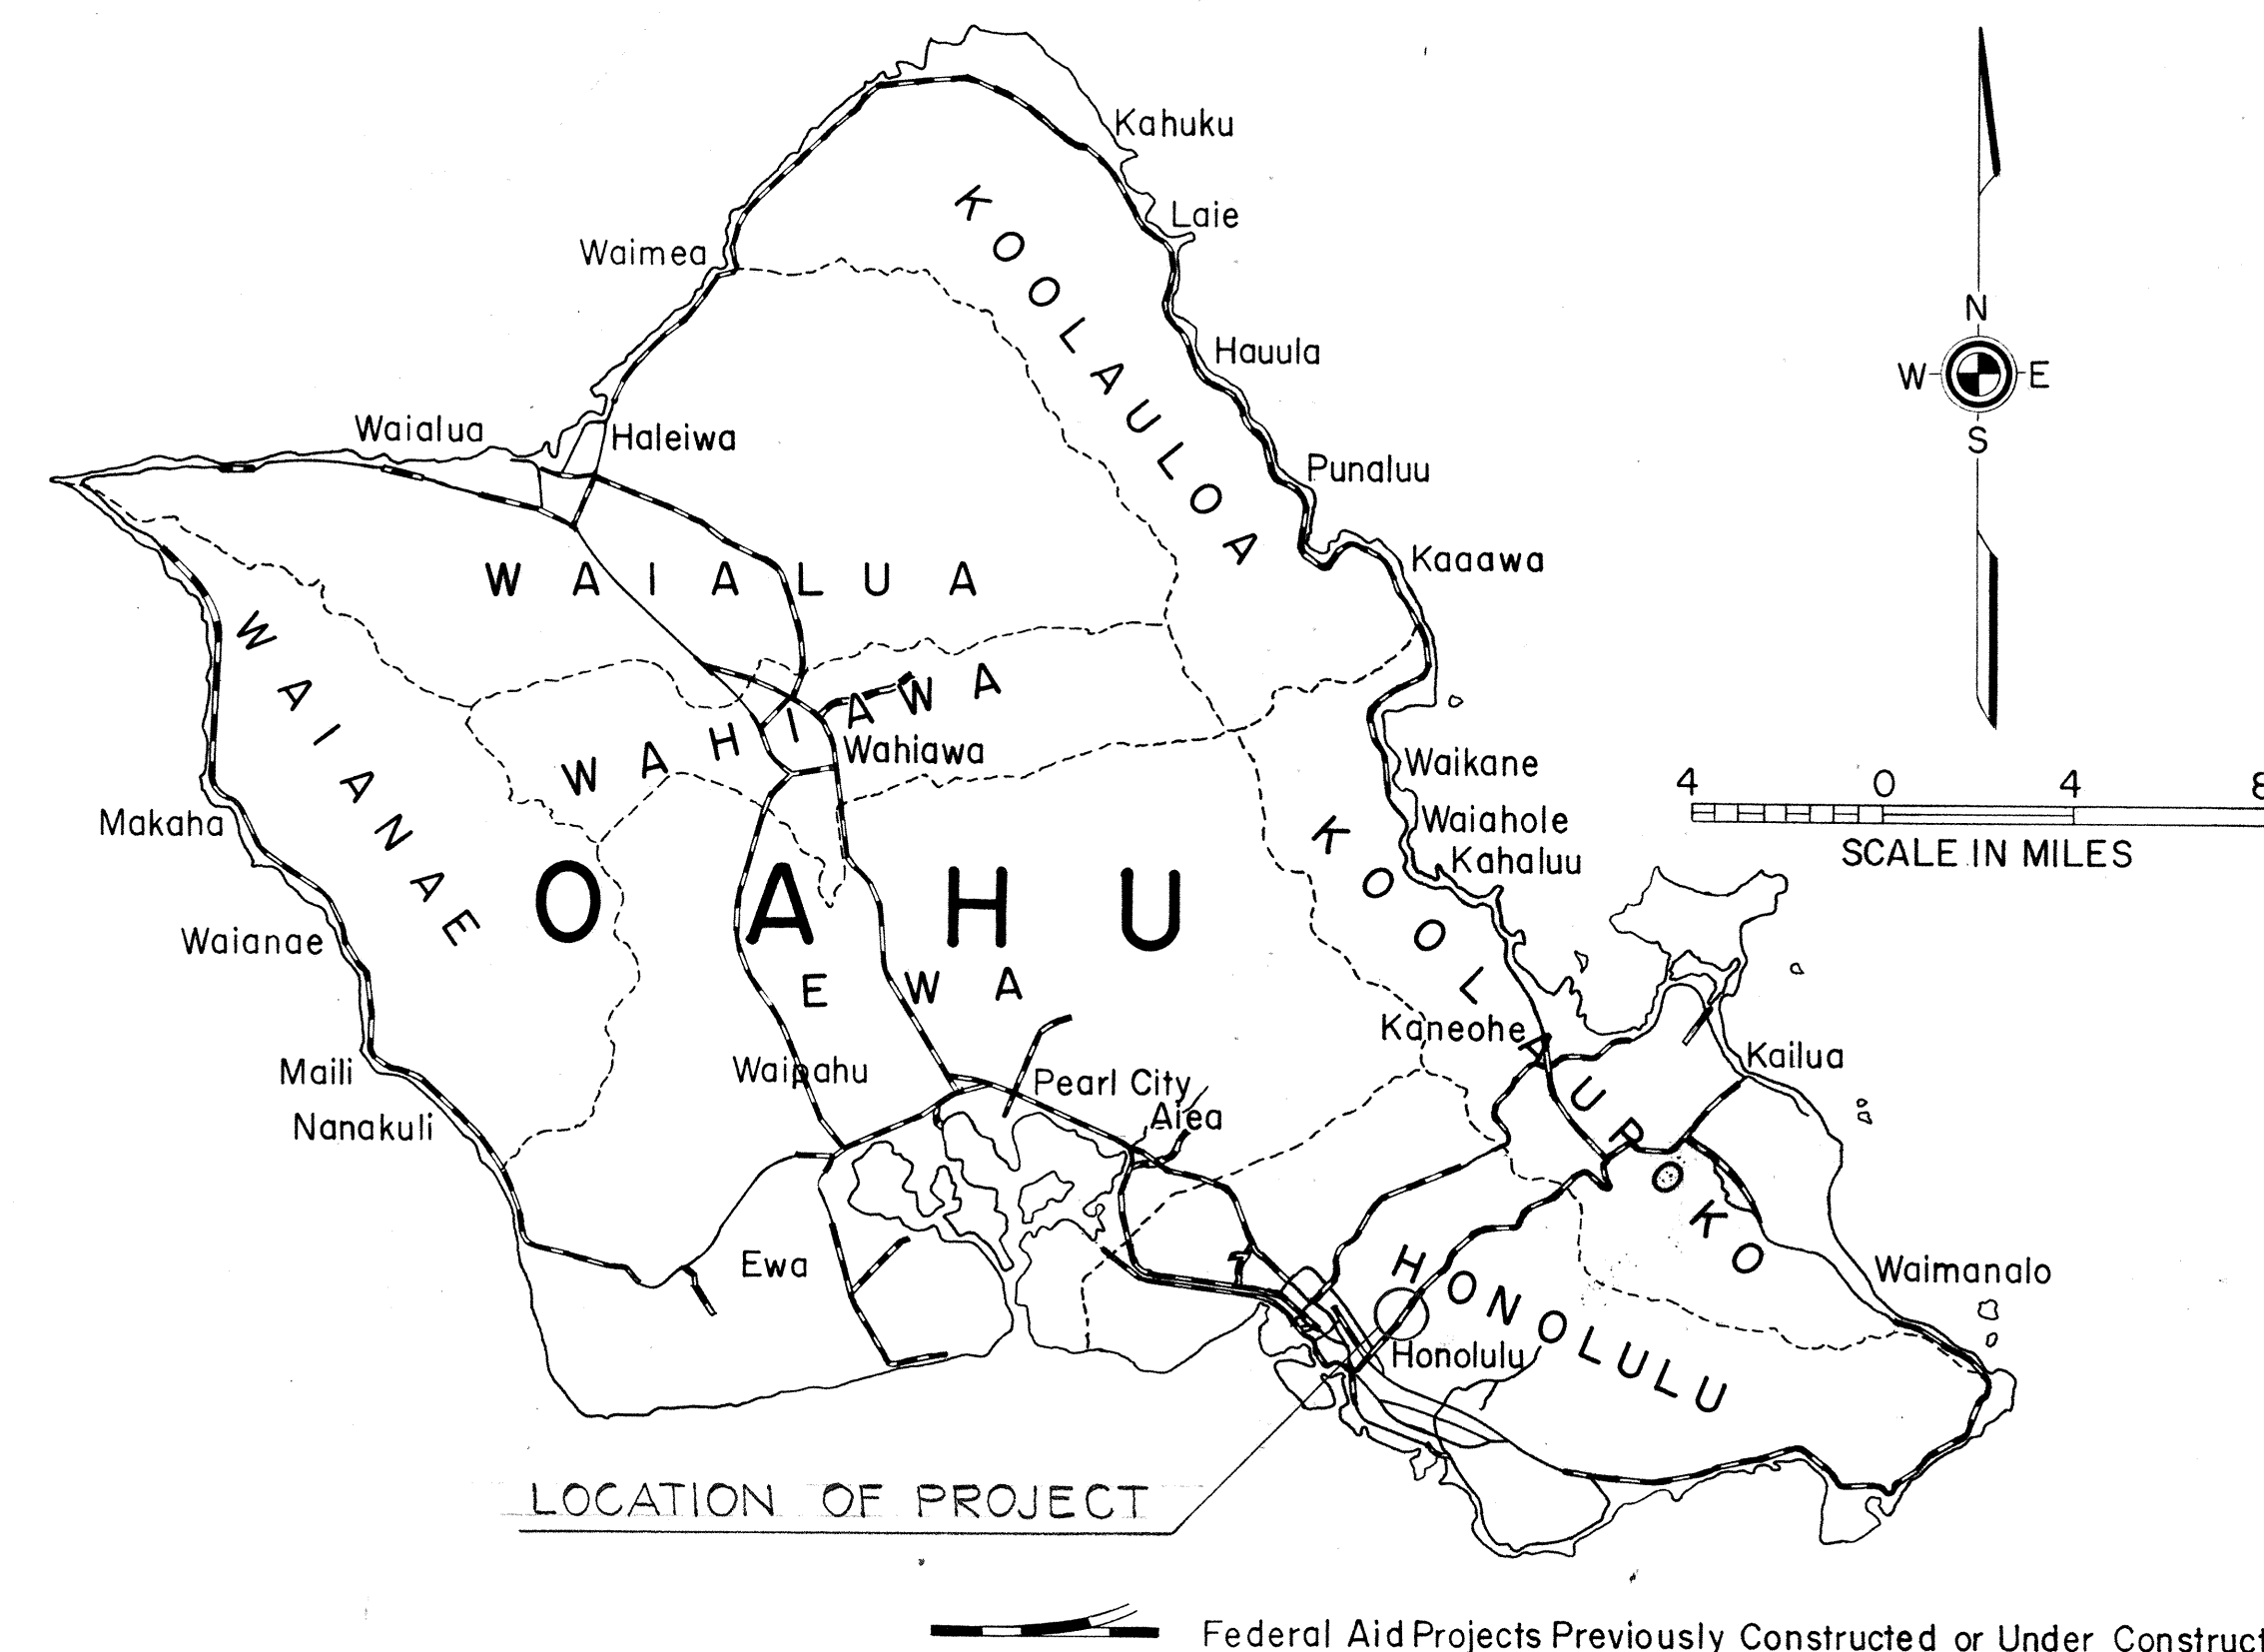

NO AS-BUILT CHANGES

DEPARTMENT OF TRANSPORTATION
STATE OF HAWAII
APPROVED: *E. Alvey Wright* 9/24/68
DIR. OF TRANSPORTATION DATE