


FED. ROAD DIST. NO.	STATE	FED. AID PROJ. NO.	FISCAL YEAR	SHEET NO.	TOTAL SHEETS
HAWAII	HAW.	F-061-1(14)	1969	009	10

NOTES

1. Height of New Guard Rail shall conform to height of Existing Guard Rail.
2. All existing delineators at these median openings shall be removed and stockpiled as directed by the Engineer.
3. All median noses and curbs shall remain intact.
4. Striping to be done by State forces prior to installation of guardrail.
5. Existing Guard Rail Noses shall be removed and stockpiled within the existing R/W as directed by the Engineer.

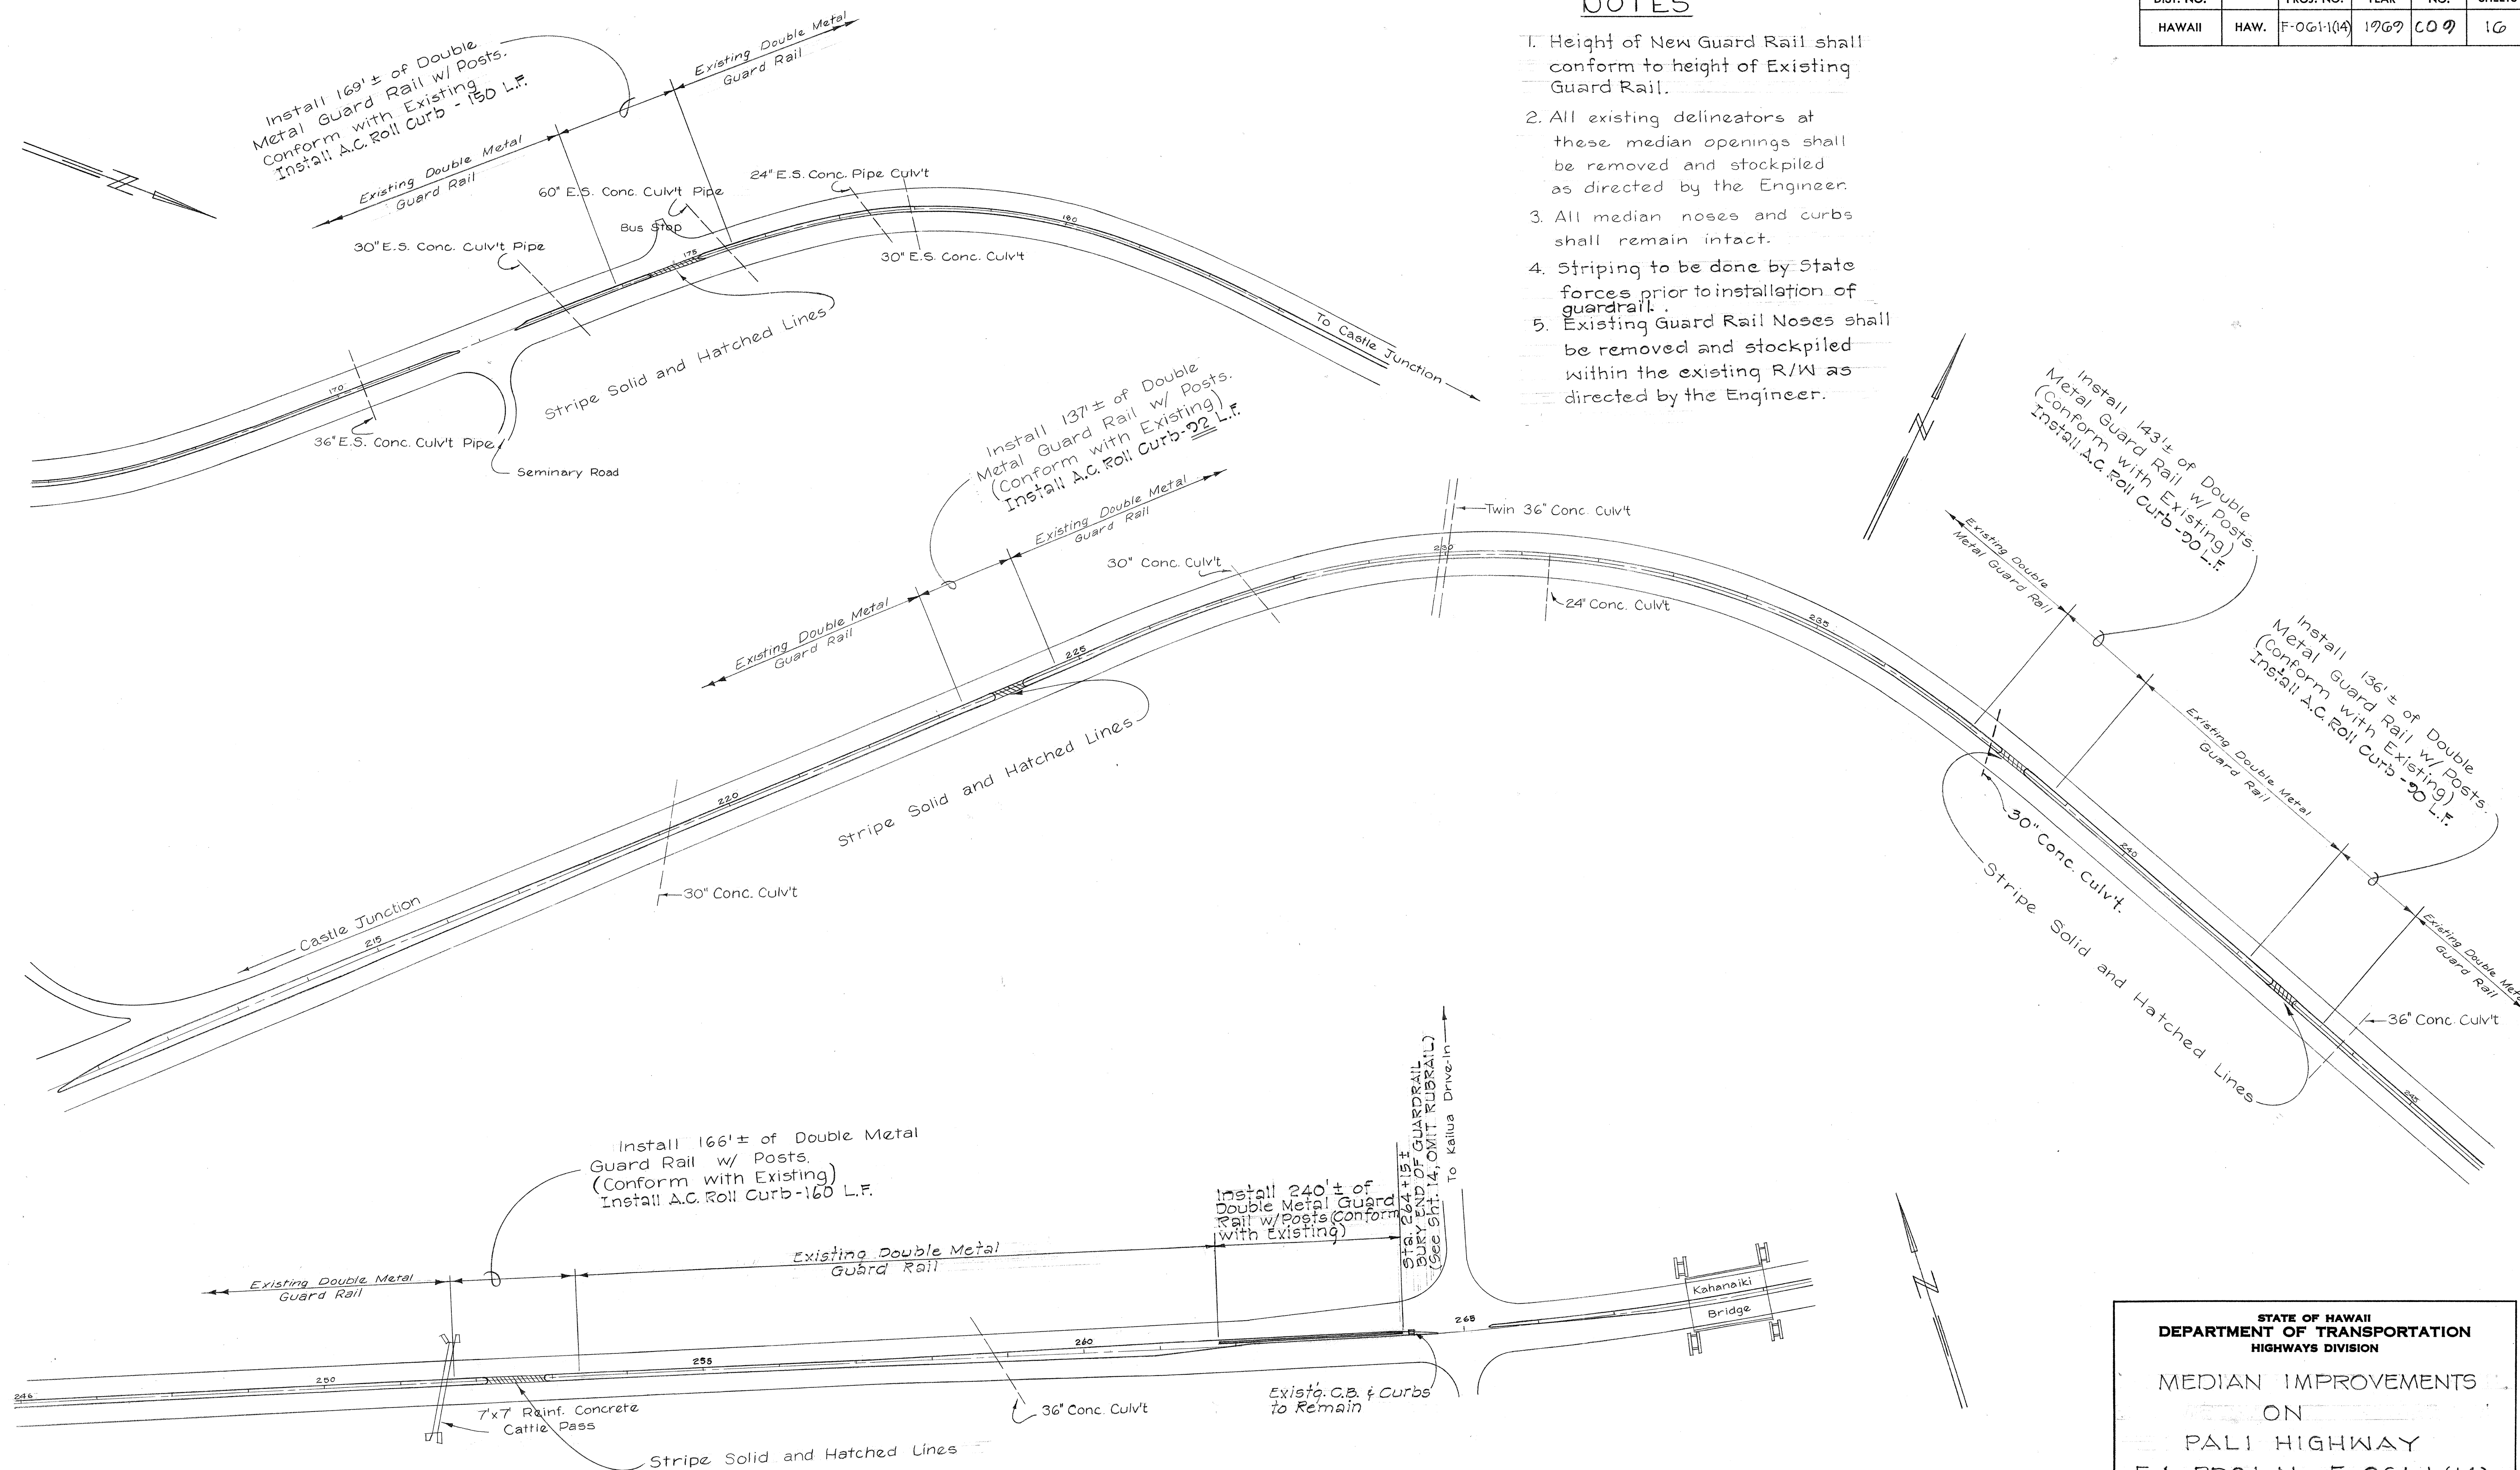

STATE OF HAWAII
DEPARTMENT OF TRANSPORTATION
HIGHWAYS DIVISION

MEDIAN IMPROVEMENTS
ON
PALI HIGHWAY
F.A. PROJ. No. F-061-1 (14)

SHEET No. 1 OF 10 SHEETS

July 16, 1969

009

SURVEY PLOTTED BY	DATE
DRAWN BY	
TRACED BY	
DESIGNED BY	
CHECKED BY	
ORIGINAL PLAN	
NOTE BOOK	
No.	