




FED. ROAD DIST. NO.	STATE	FED. AID PROJ. NO.	FISCAL YEAR	SHEET NO.	TOTAL SHEETS
HAWAII	HAW.	F-061-1(14)	1969	C.O. 6	16

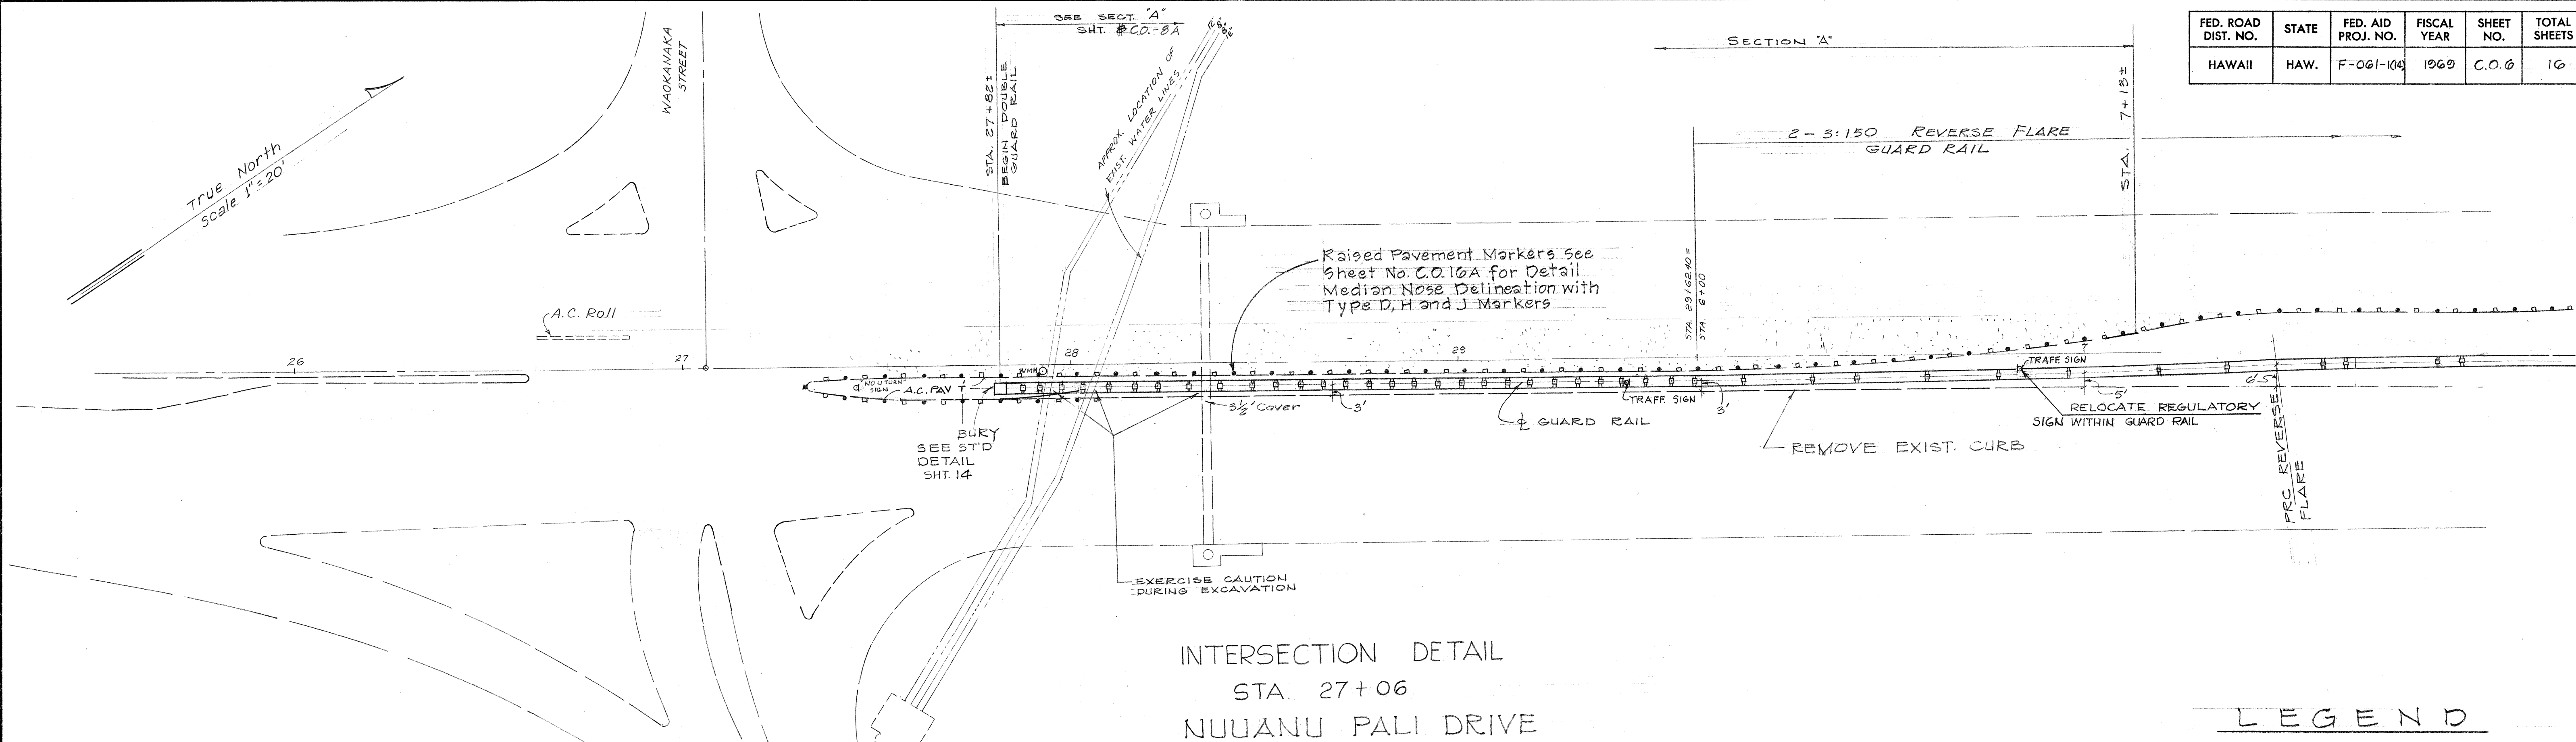

LEGEND

- Type "D" Marker
- Type "H" Marker
- Type "J" Marker

ORIGINAL PLAN	DATE
DESIGNED BY	TRACED BY
NOTED BY	CHECKED BY
NO.	

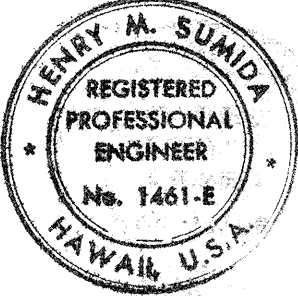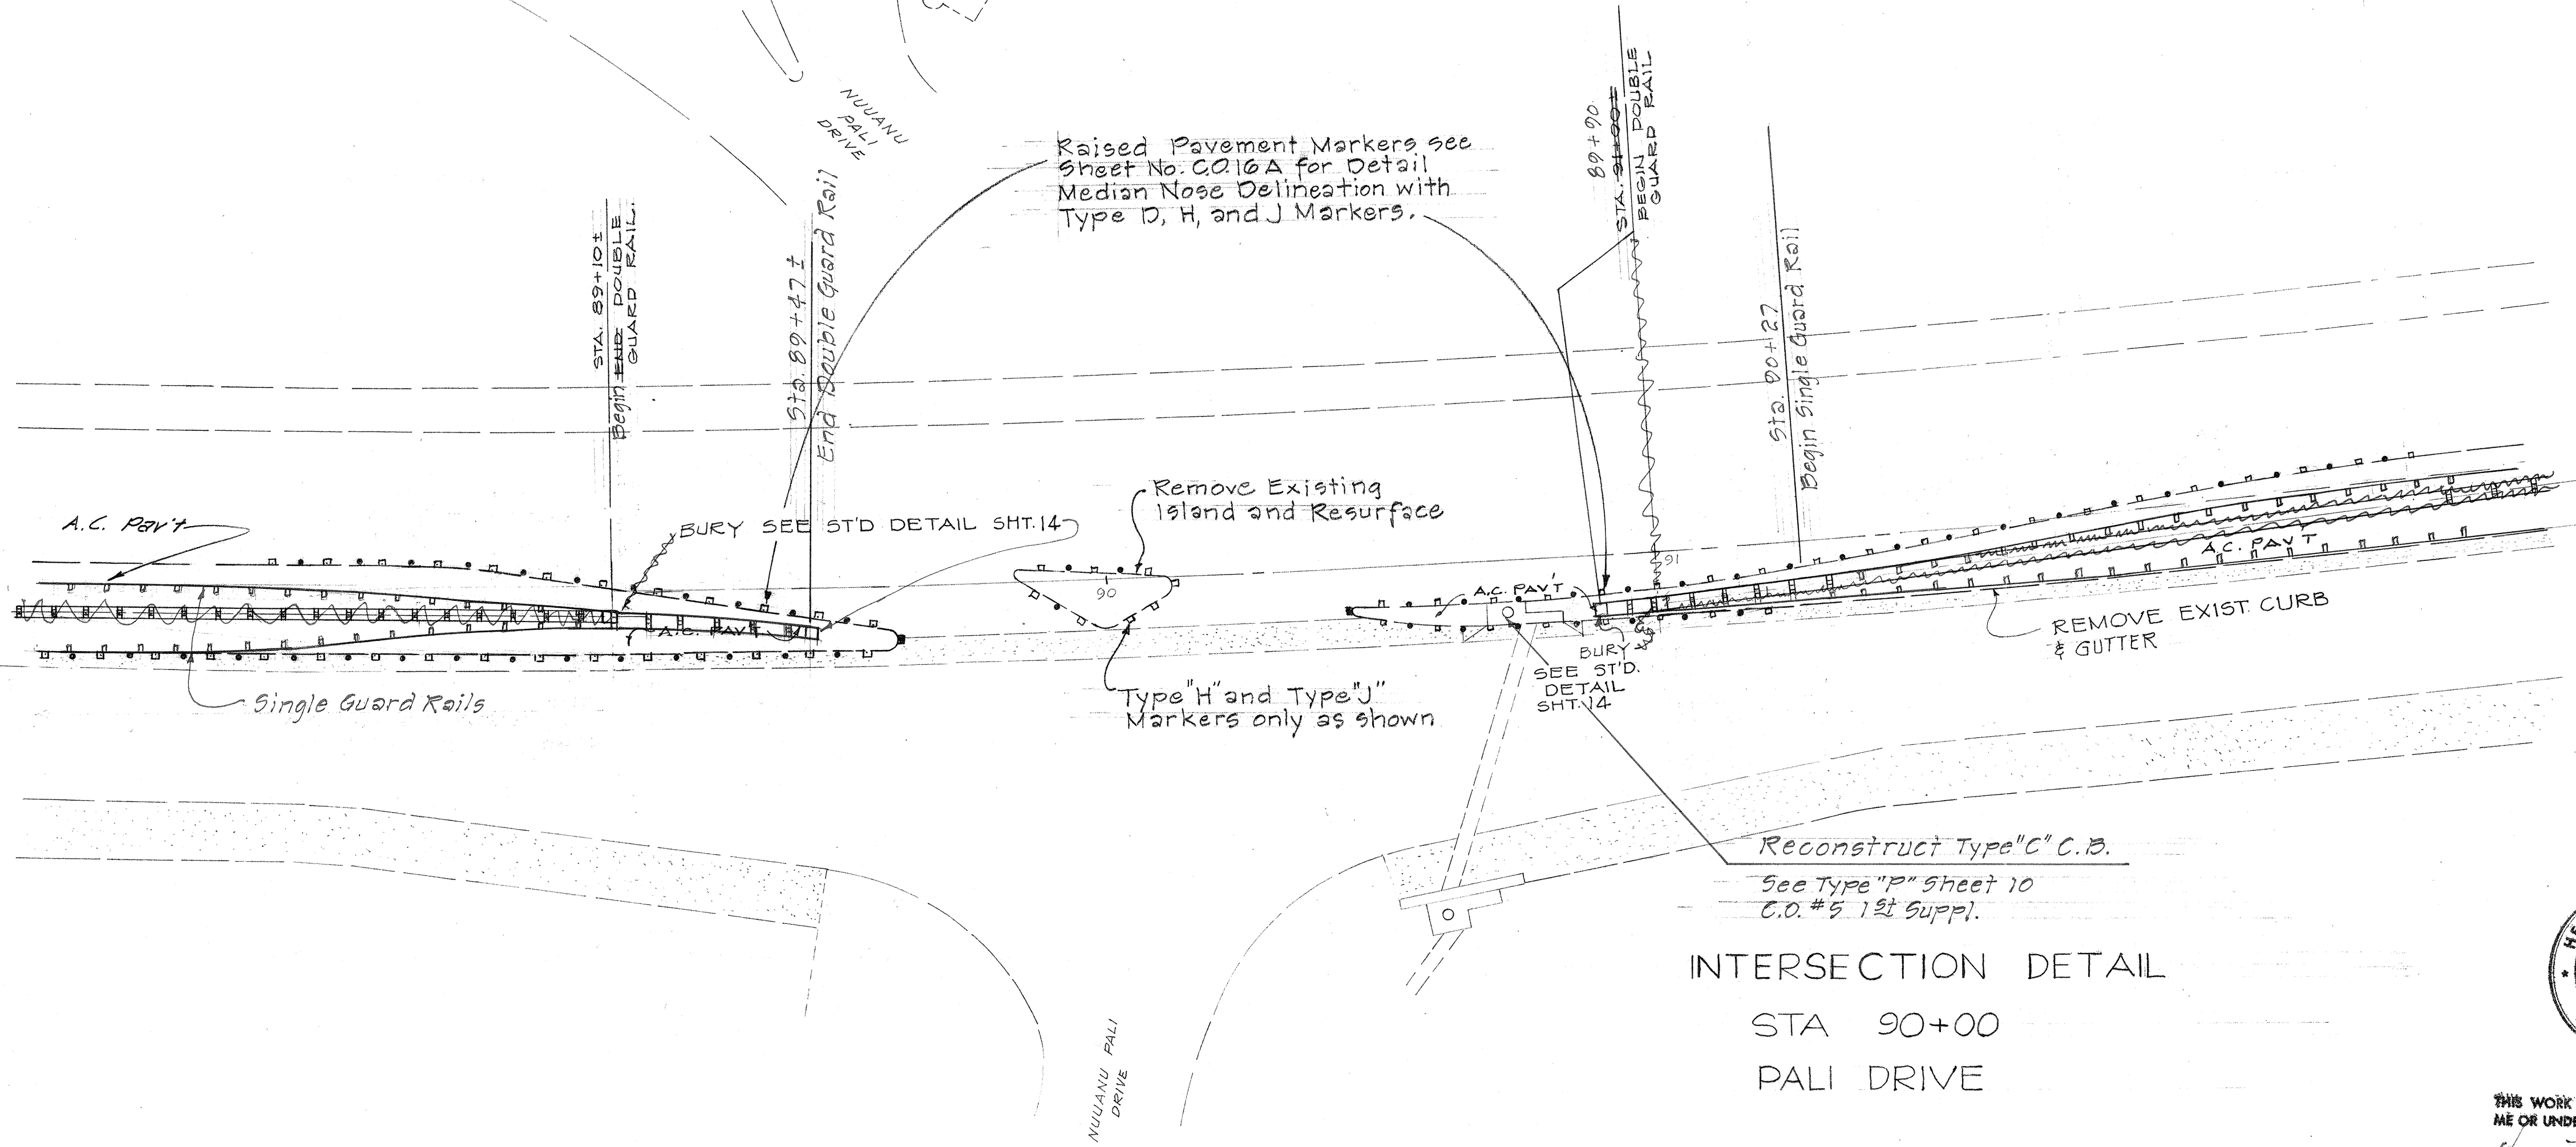

THIS WORK WAS PREPARED BY ME OR UNDER MY SUPERVISION.

STATE OF HAWAII
DEPARTMENT OF TRANSPORTATION
HIGHWAYS DIVISION

INTERSECTION DETAIL
MEDIAN IMPROVEMENTS
ON PALI HIGHWAY

F.A. PROJ. No. F-061-1(14)
Scale: As Noted

July 3, 1969 C O 6

