INDEX TO DRAWINGS	
SHEET NO.	DESCRIPTION
1	TITLE SHEET
2-5	GUARD RAIL LAYOUT
6-7	INTERSECTION DETAIL
8	TYPICAL SECTION
on the second control of the second control	GUARD RAILS AT
and the second s	MEDIAN OPENINGS
	CATCH BASIN RECON
10-11	STRUCTION & CURB
er en en de despublication plants de la constant de	\$ GUTTER DETAILS
12-16	STANDARD DETAILS
,	

STATE OF HAWAII

DEPARTMENT OF TRANSPORTATION
HIGHWAYS DIVISION

HONOLULU, HAWAII

"AS BUILT"
PLANS FOR


MEDIAN IMPROVEMENTS

ON PALI HIGHWAY
CARTER'S CORNER TO VICINITY OF

WAIMANALO JUNCTION

FEDERAL AID PROJECT No. F-061-1(14)

DISTRICTS OF HONOLULU AND KOOLAUPOKO
ISLAND OF OAHU

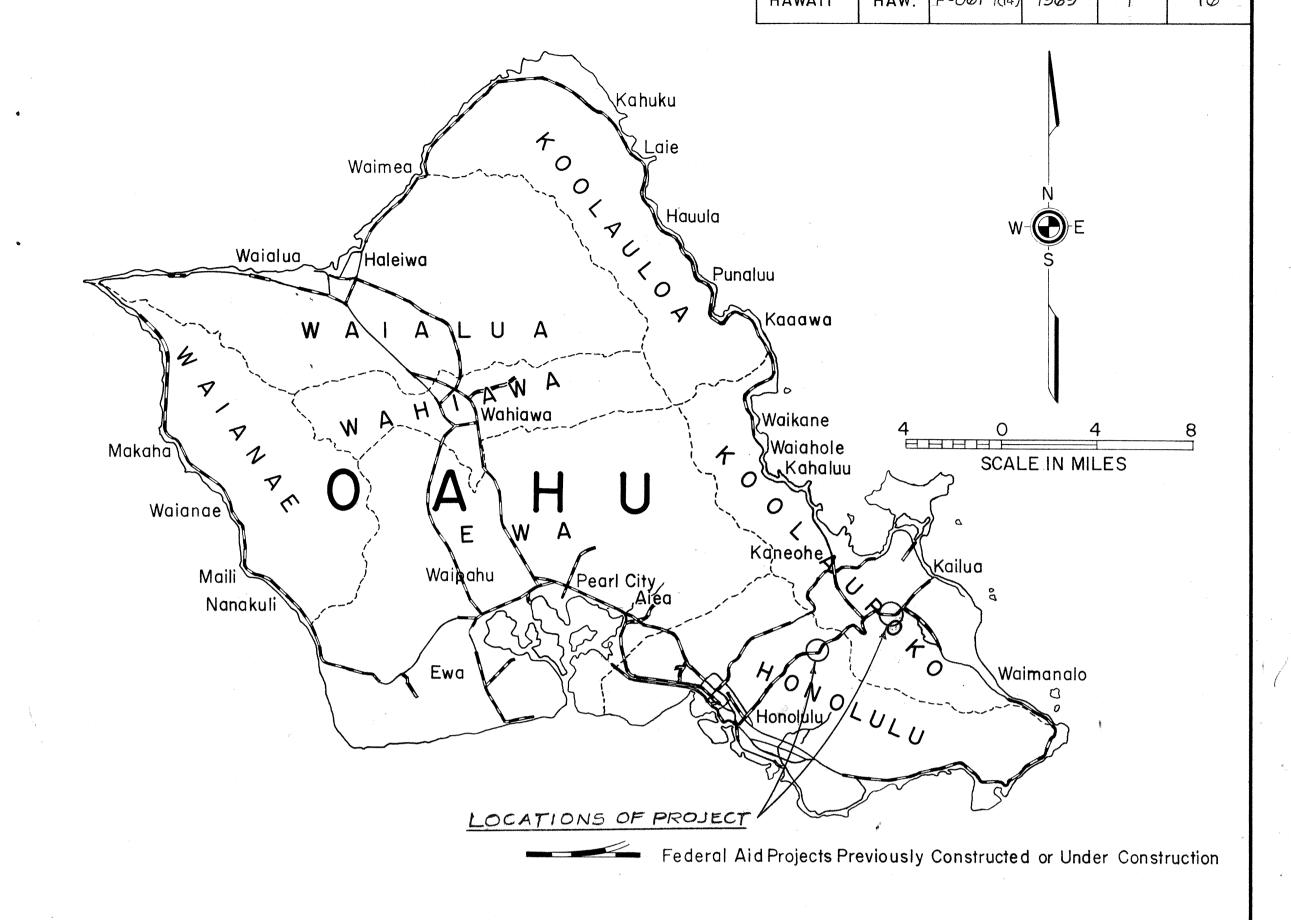

## NOTE:

ALL THE QUANTITIES SHOWN ARE ORIGINAL THEORETICAL QUANTITIES. FOR ACTUAL QUANTITIES REFER TO PROJECT LEDGER AND / OR COMPUTATION BOOK.

## CLASSIFICATION DATA

FED. AID FISCAL PROJ. NO. YEAR

ADT (1968) 30,500 ADT (1988) 39,000 DHV 12% T 1%

## NOTE:

ALL CHANGES MADE DURING CONSTRUCTION HAVE BEEN NOTED IN RED ON THESE TRACINGS AND CHECKED BY:

PROJECT ENGINEER

11-26-71 DATE

DEPARTMENT OF TRANSPORTATION
BUREAU OF PUBLIC ROADS

APPROVED:

Med Declarage 3-7-69
DIVISION ENGINEER DATE

DEPARTMENT OF TRANSPORTATION
STATE OF HAWAII

APPROVED:

C. Olivery Marie 3/24/63

DIR. OF TRANSPORTATION DATE

SCALE: AS NOTE:

SCALE: 1-500'

SCAL

rada August 1968

5