


FED. ROAD DIST. NO.	STATE	FED. AID PROJ. NO.	FISCAL YEAR	SHEET NO.	TOTAL SHEETS
HAWAII	HAW.	61B-05-70	1969	2	11

SURVEY PLOTTED BY	DATE
DRAWN BY	
DESIGNED BY	
QUANTITIES BY	
CHECKED BY	
ORIGINAL PLAN	
NOTE BOOK	
No.	

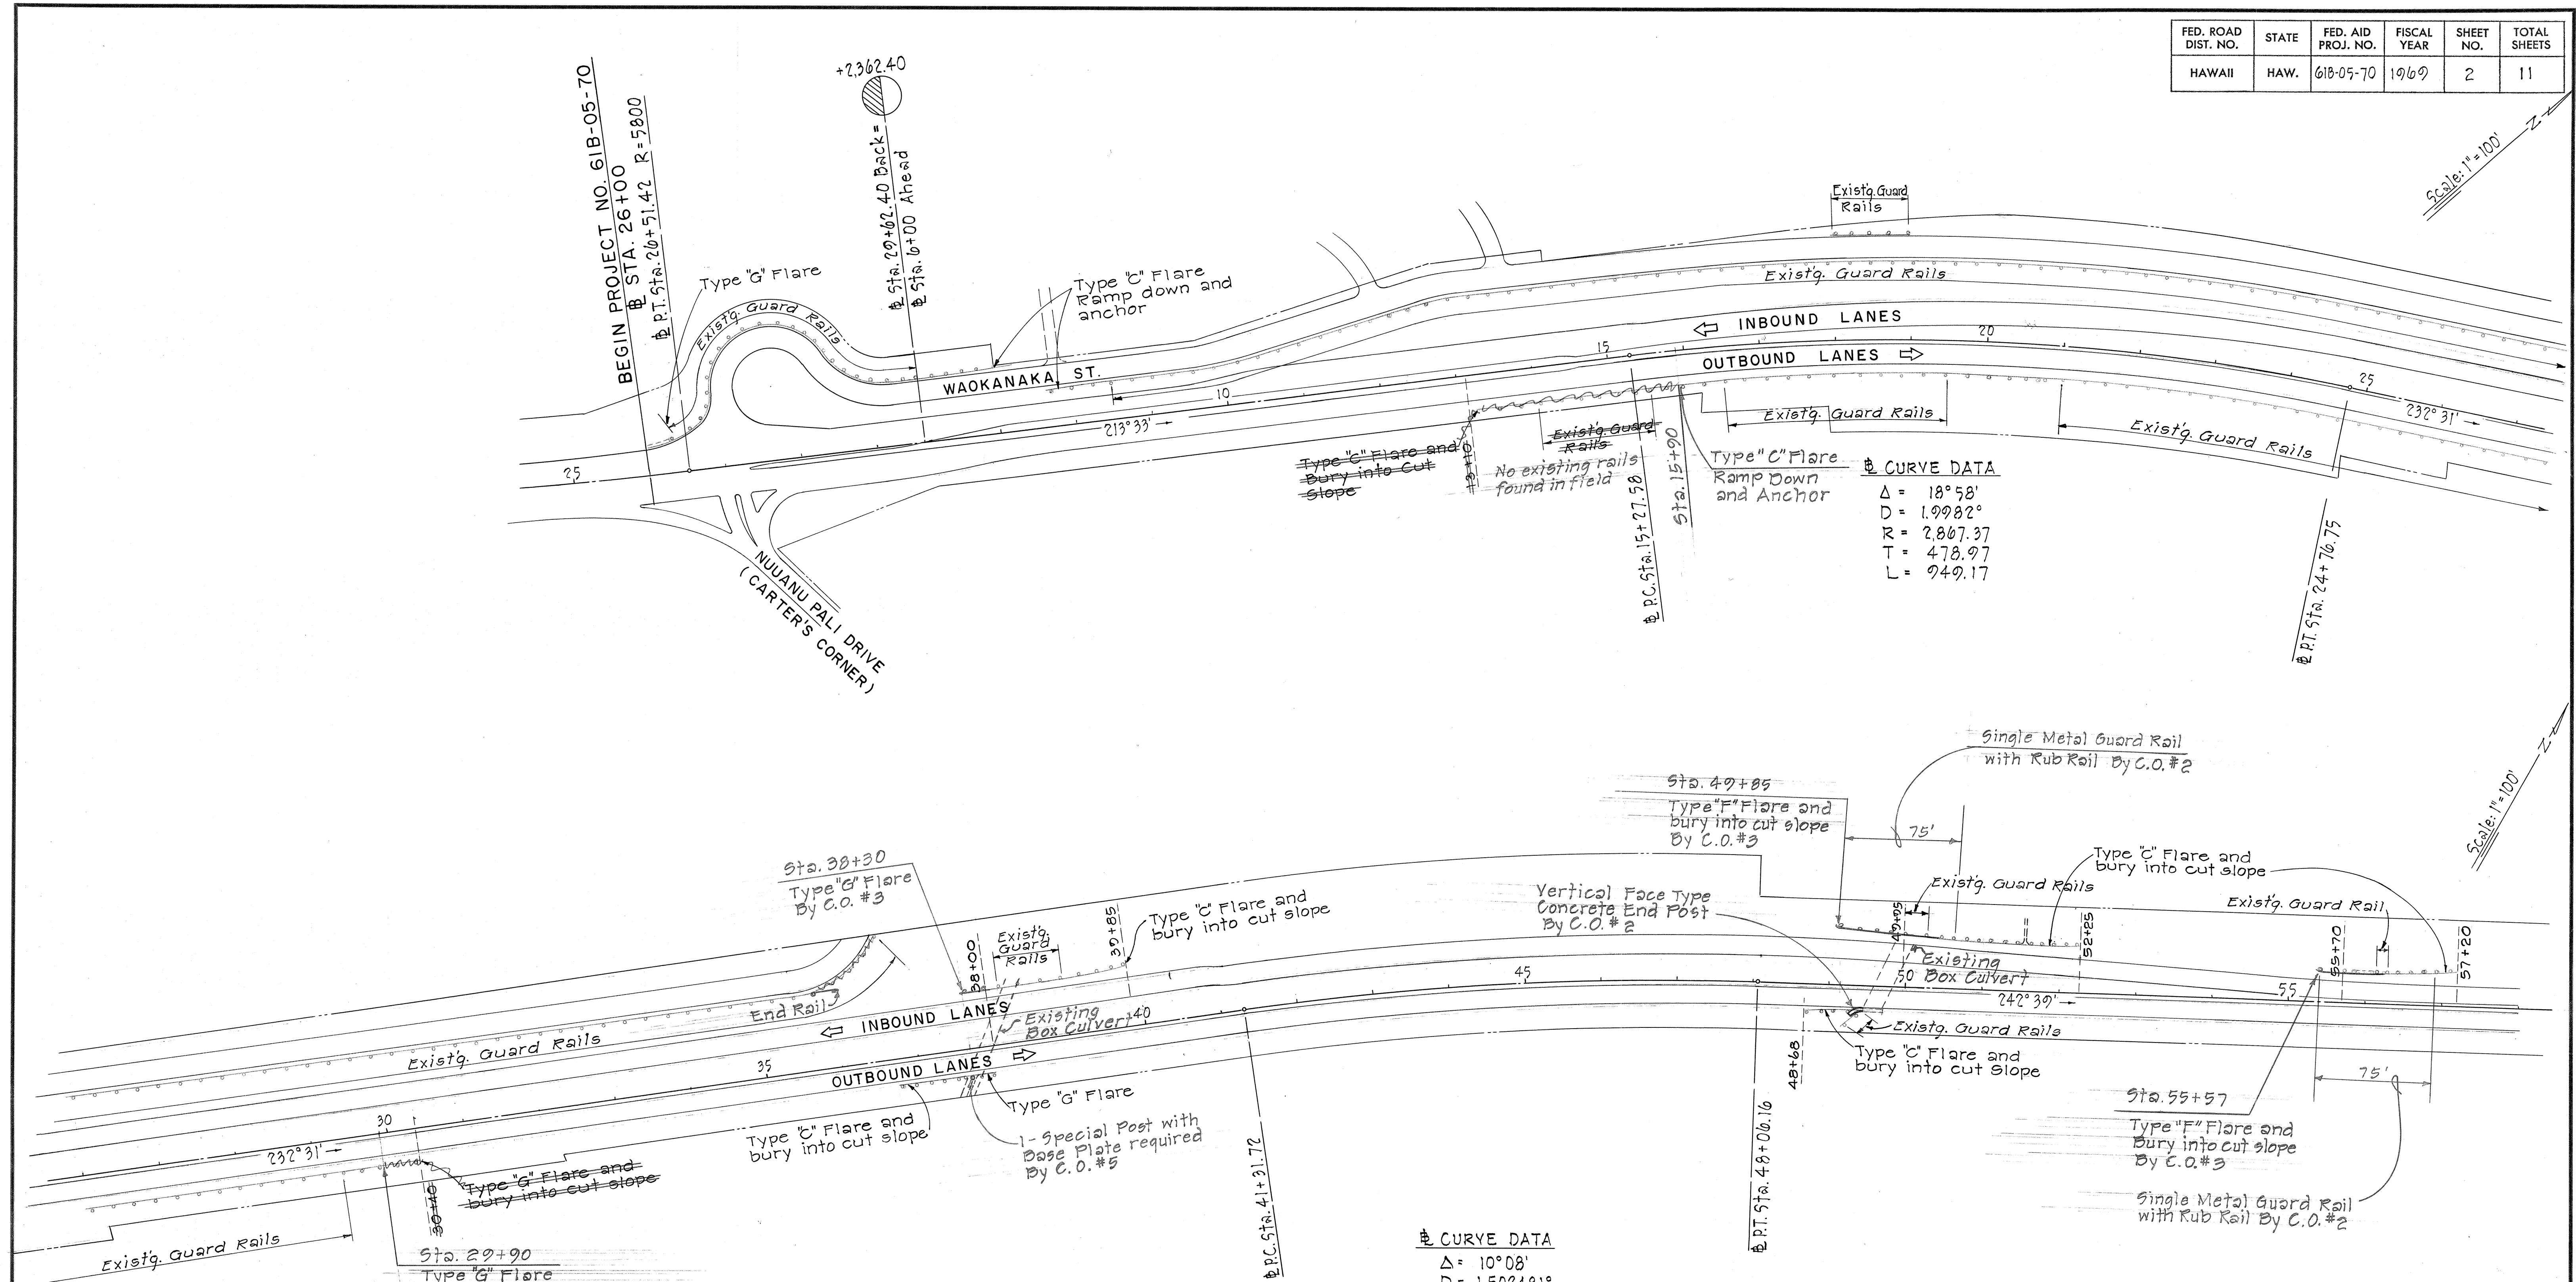

GENERAL NOTES

1. The exact location of 2 construction identification signs shall be determined in the field by the Engineer. Signs deleted by C.O. #1
2. Replace all existing wooden and metal guard rails with new metal guard rails and steel posts.
3. Removal of existing wooden guard rails and installing of new anchors shall be incidental to new metal guard rail. Salvaged wooden guard rails shall become the property of the Contractor.
4. Approximately 1,350 salvaged concrete posts shall be hauled and stockpiled as specified in the Special Provisions or as directed by the Engineer.
5. Salvaged metal guard rails shall be hauled and stockpiled as specified in the Special Provisions or as directed by the Engineer.

Curve Data

$\Delta = 10^\circ 08'$
$D = 1.502481^\circ$
$R = 3,813.41$
$T = 338.10$
$L = 674.44$

STATE OF HAWAII
DEPARTMENT OF TRANSPORTATION
HIGHWAYS DIVISION

PLAN



PROJ. NO. 61B-05-70

SHEET No. 1 OF 3 SHEETS

FED. ROAD DIST. NO.	STATE	FED. AID PROJ. NO.	FISCAL YEAR	SHEET NO.	TOTAL SHEETS
HAWAII	HAW.	61B-05-70	1969	3	11

⊕ CURVE DATA

$\Delta = 37^{\circ}12'$
 $D = 2^{\circ}00'$
 $R = 2864.79$
 $T = 964.12$
 $L = 1859.99$

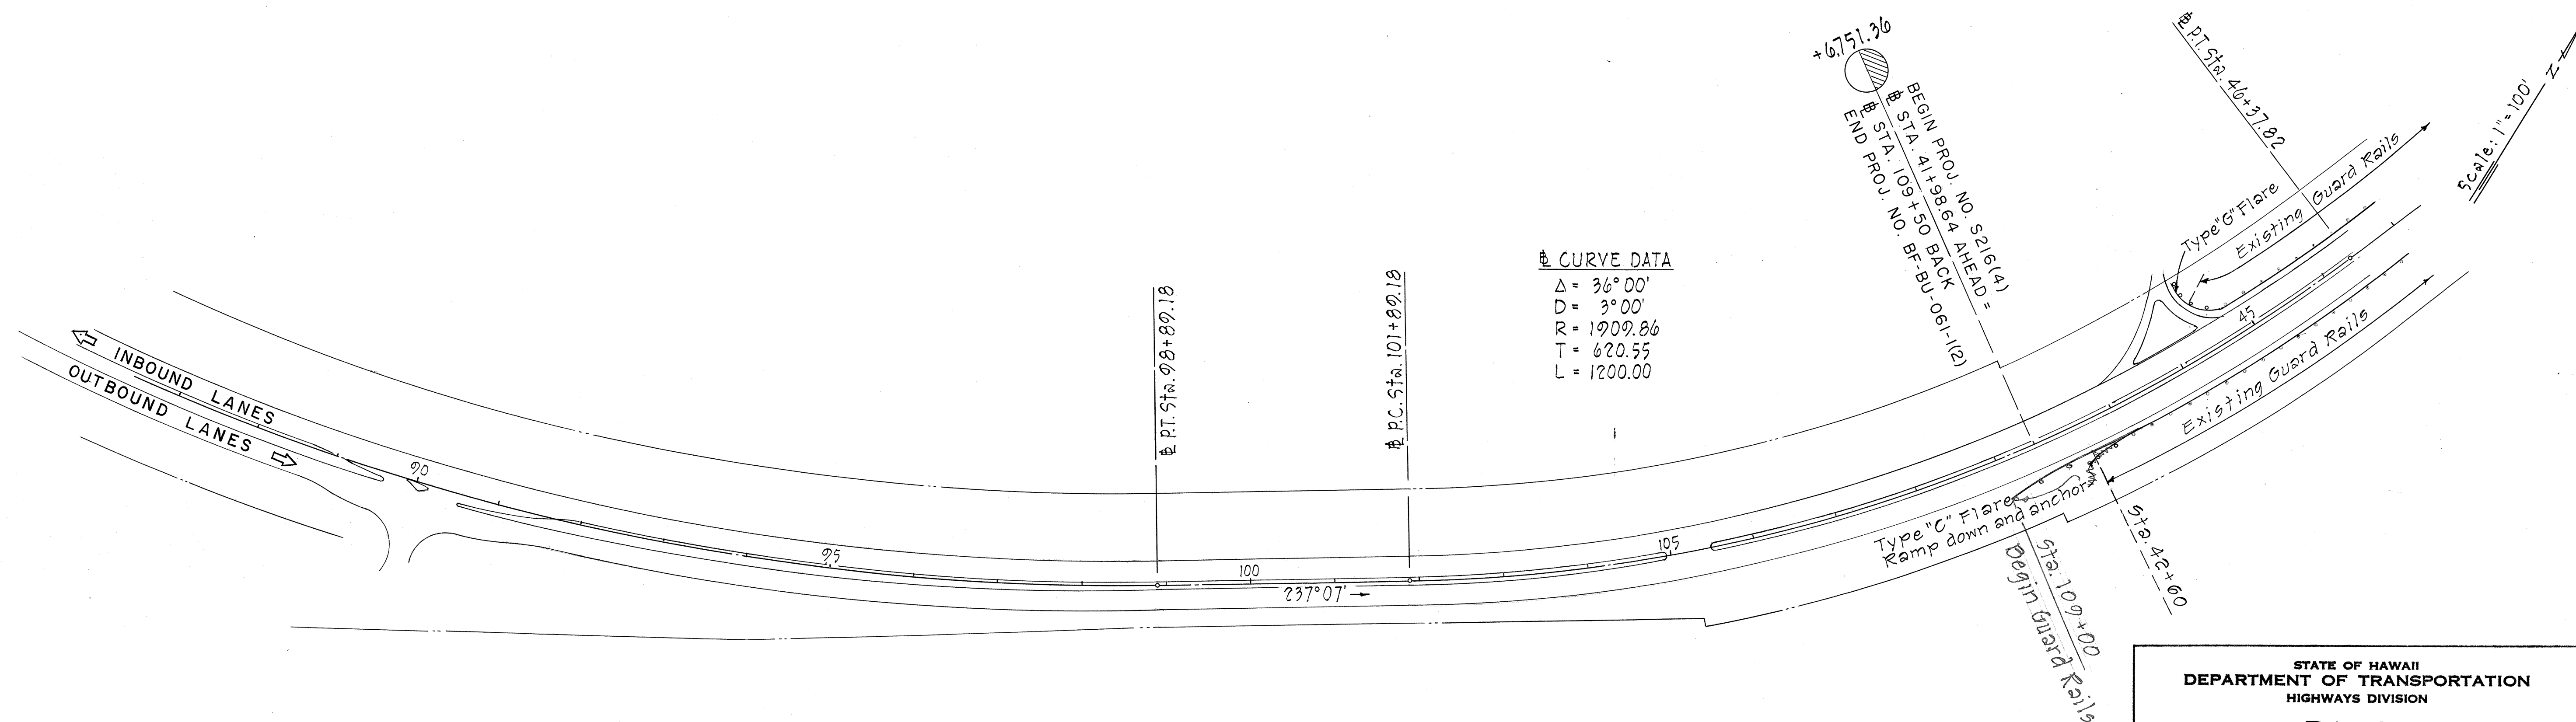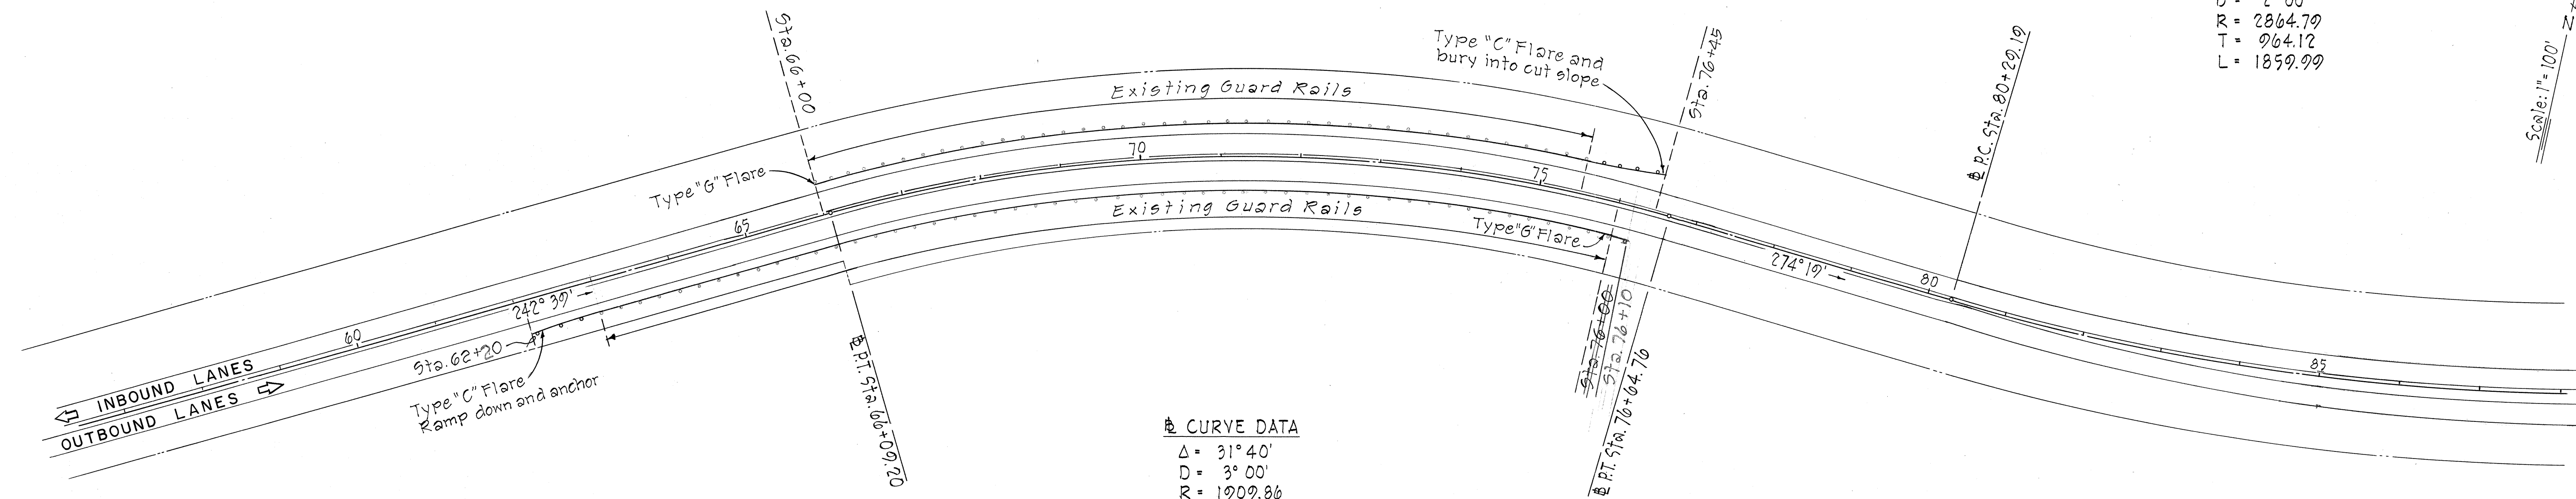

STATE OF HAWAII
DEPARTMENT OF TRANSPORTATION
HIGHWAYS DIVISION



PLAN

PROJ. NO. 61B-05-70

SHEET No. 2 OF 3 SHEETS

ORIGINAL	SURVEY PLOTTED BY	DATE
PLAN	DRAWN BY	"
NOTE BOOK	DESIGNED BY	"
QUANTITIES BY	CHECKED BY	"
No.		

FED. ROAD DIST. NO.	STATE	FED. AID PROJ. NO.	FISCAL YEAR	SHEET NO.	TOTAL SHEETS
HAWAII	HAW.	61B-05-70	1969	4	11

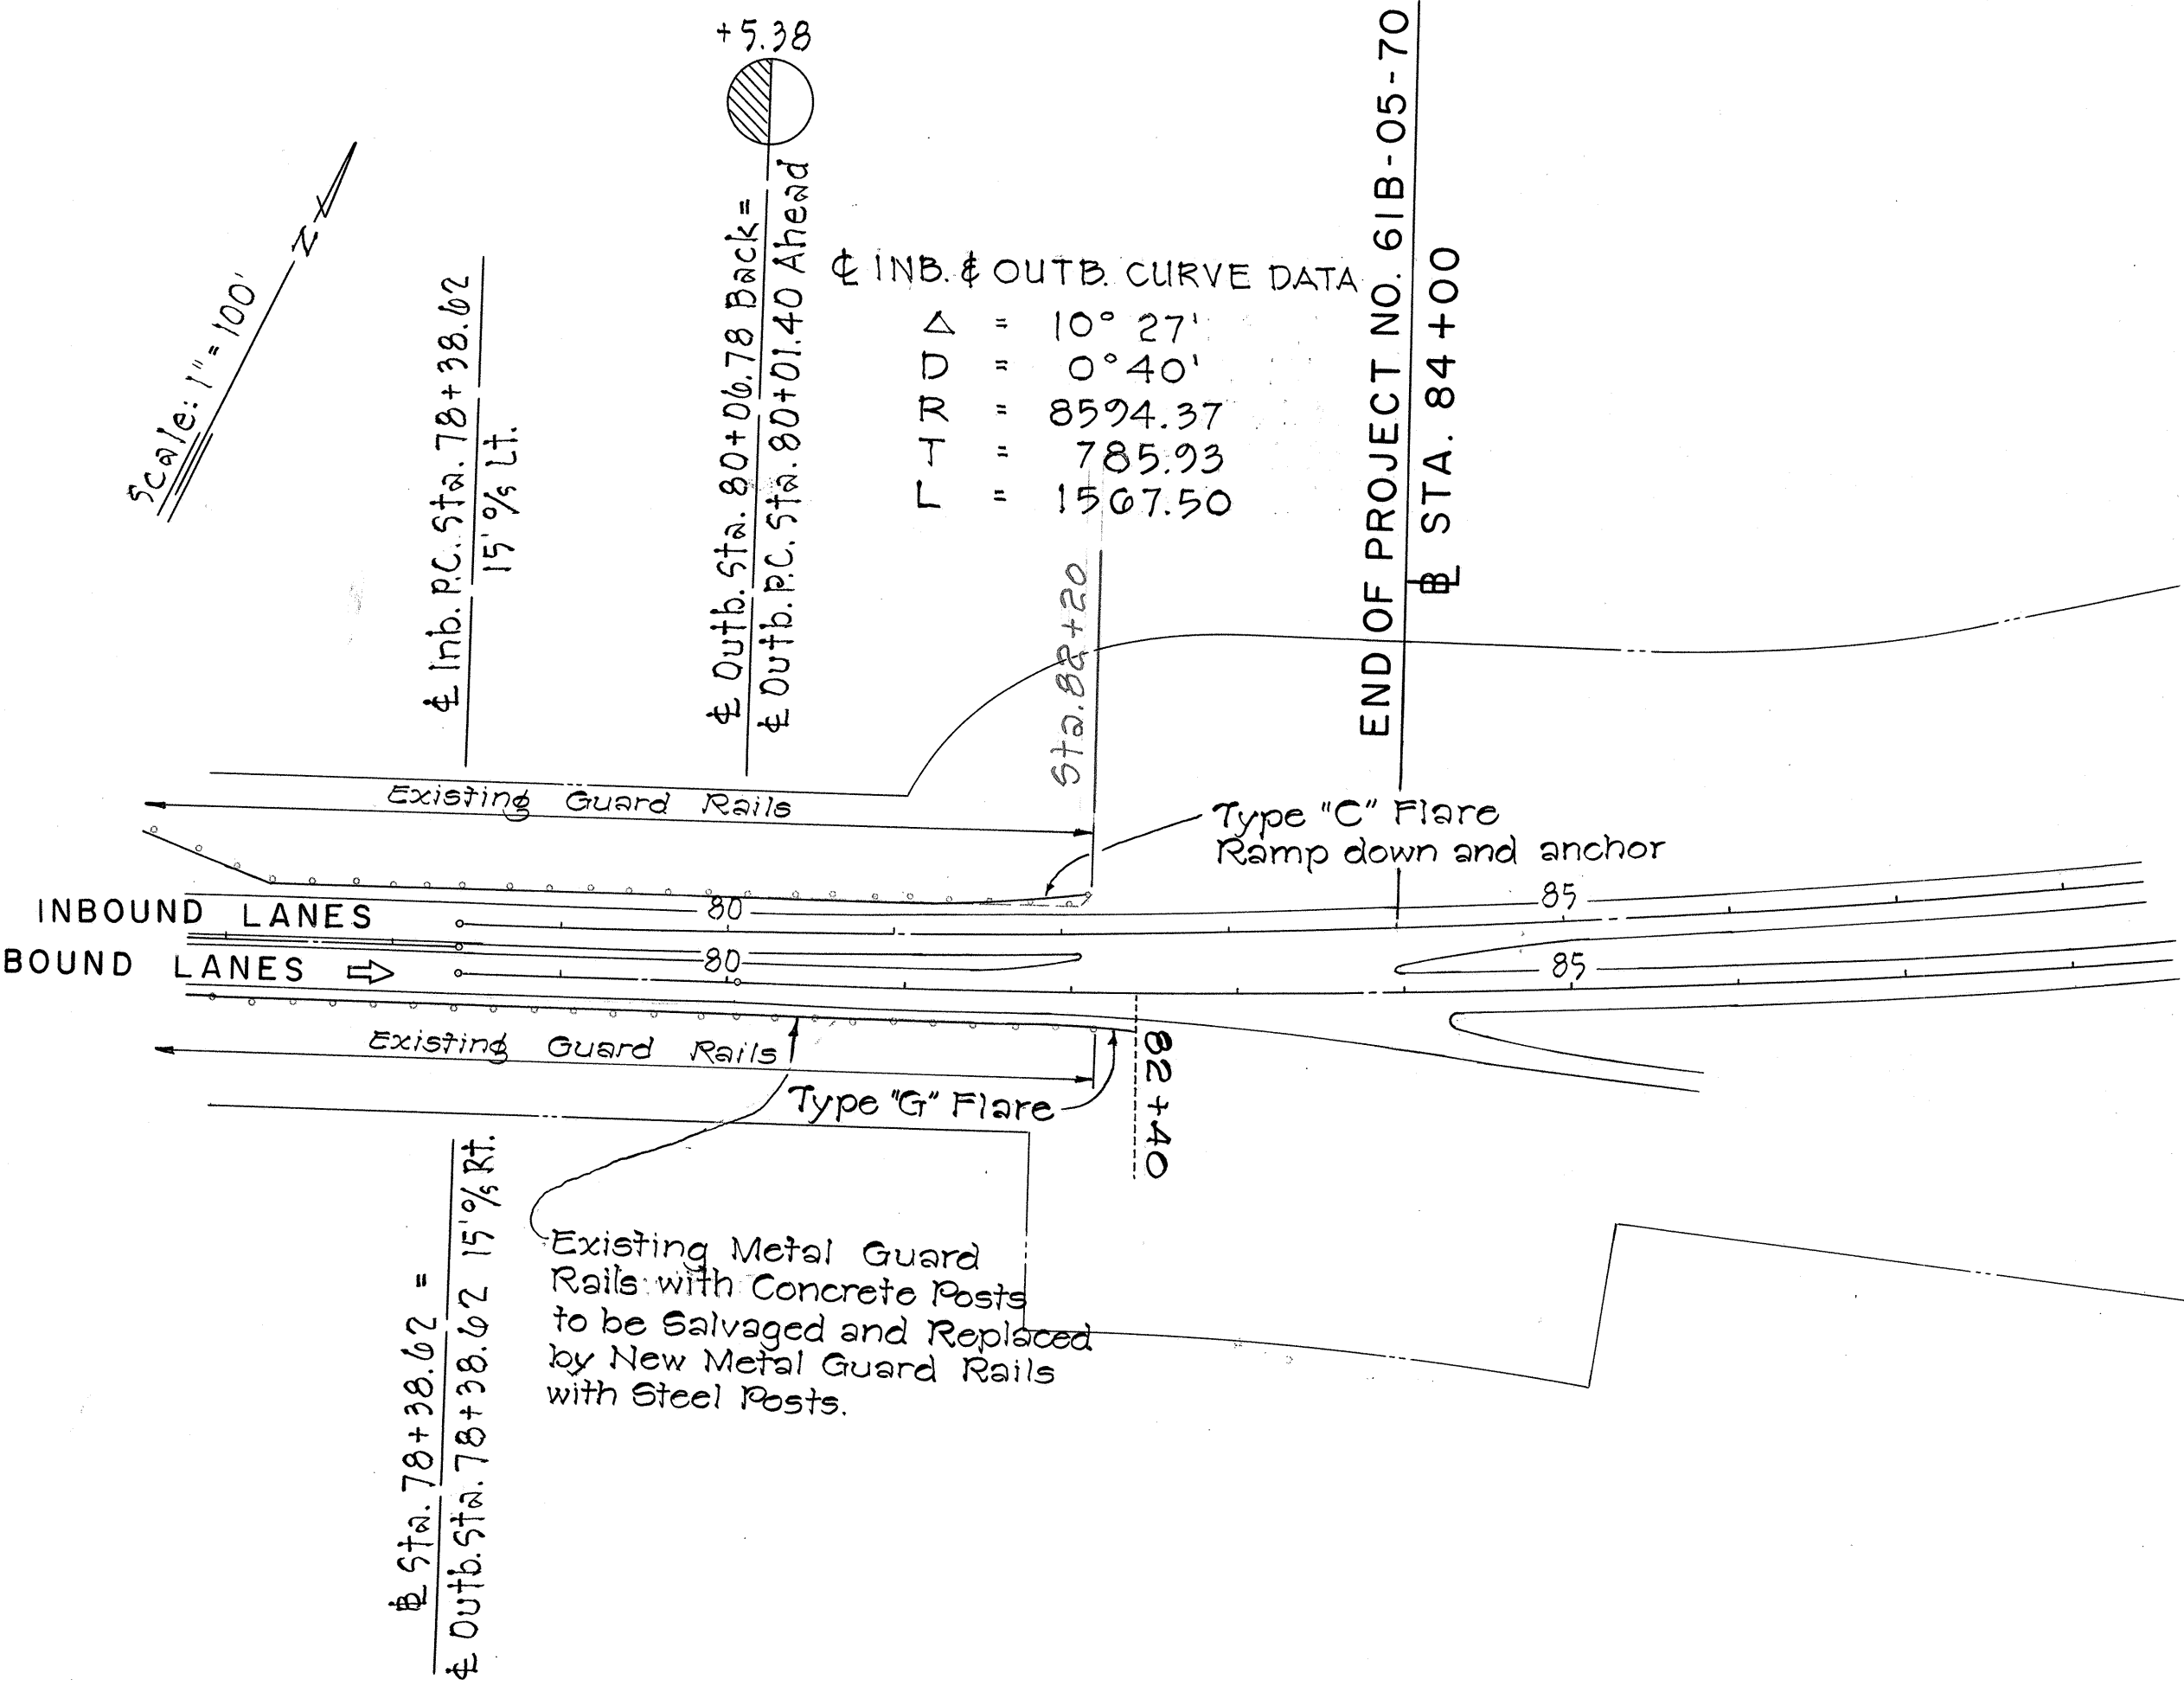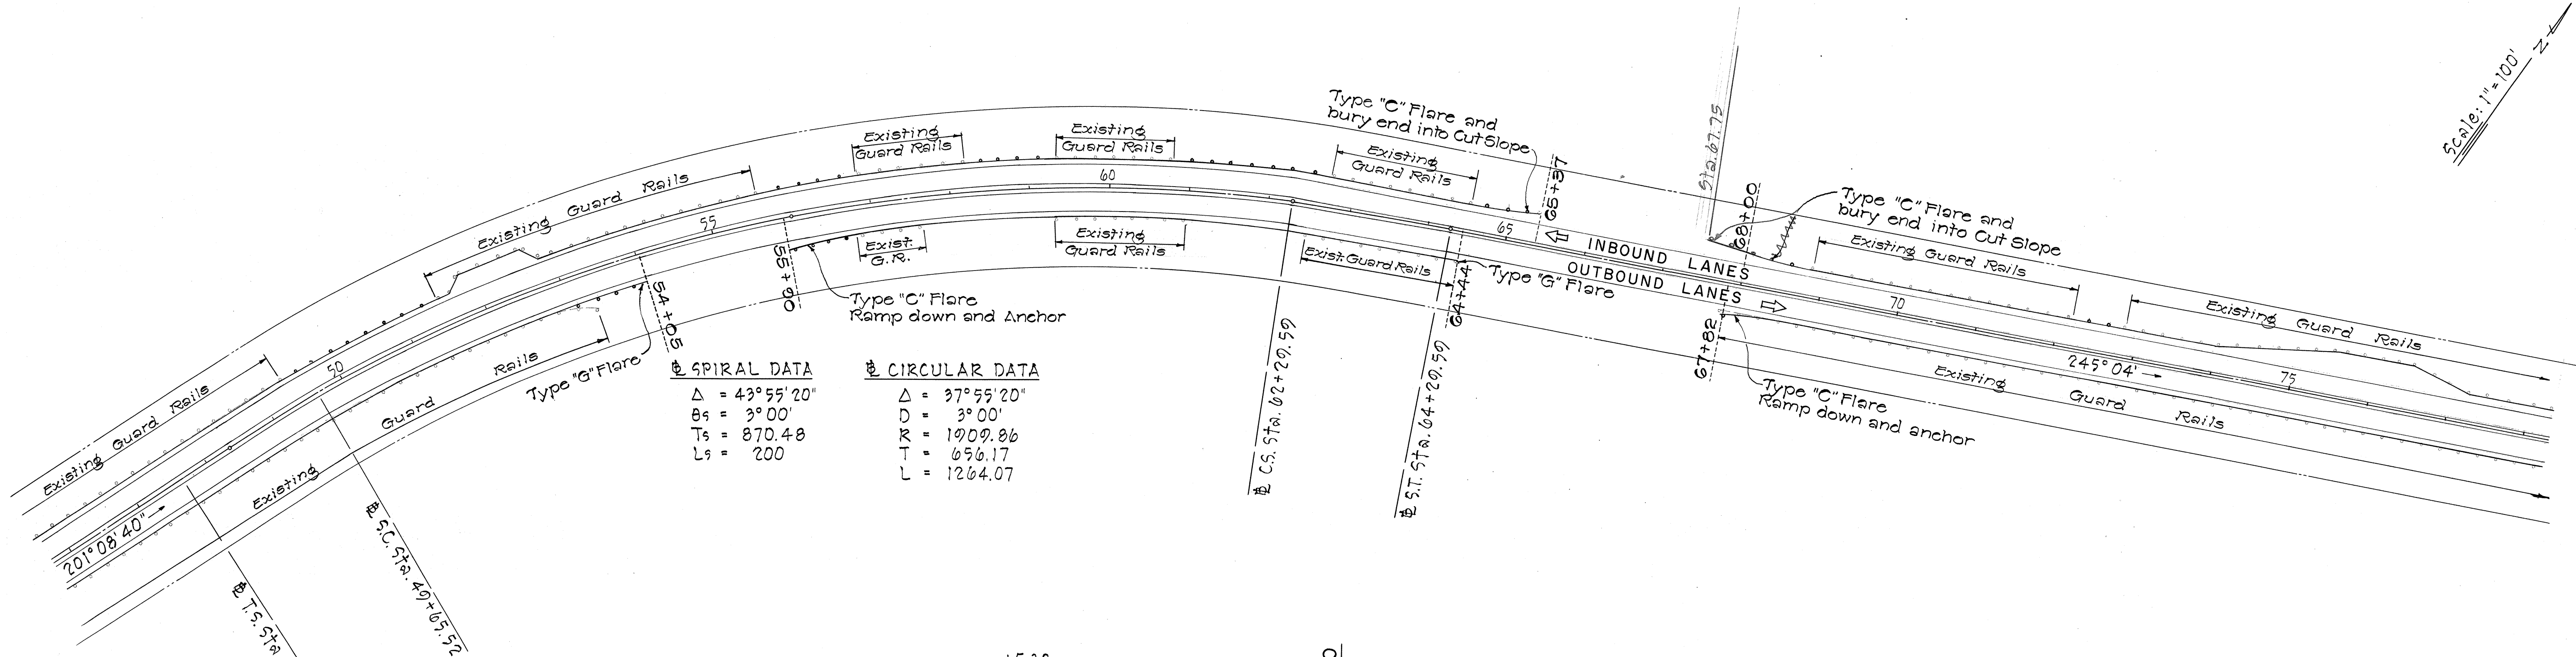

ORIGINAL PLAN	DATE
DRAWN BY	"
CHECKED BY	"
NOTED BY	"
QUANTITIES BY	"
CHECKED BY	"
No.	"

STATE OF HAWAII
DEPARTMENT OF TRANSPORTATION
HIGHWAYS DIVISION

PLAN

PROJ. NO. 61B-05-70